


DATE REVISED	DATE FILMED	DATE REVISED	DATE FILMED	FED. RD. DIST. NO.	STATE	FED. AID PROJ. NO.	SHEET NO.	TOTAL SHEETS
				6	ARK.			
				JOB NO.		080517	1	182
				I-40/6TH ST. OVERPASS (CONWAY) (S)				

**PROJECT LOCATION**

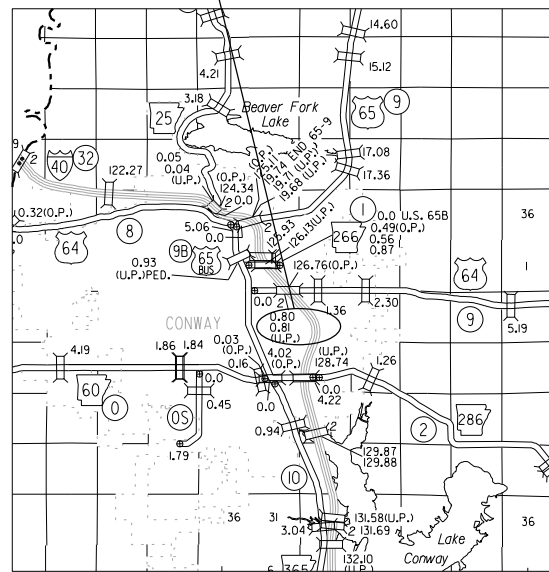

**VICINITY MAP**

**BRIDGE DATA**

- ① STA. 38+89.88 BRIDGE END  
BRIDGE NO. 07345 OVER INTERSTATE 40  
212'-0" CONT. COMP. PLATE GIRDER UNIT  
46'-0" CLEAR ROADWAY  
15°00'00" RT. FORWARD SKEW  
214'-2 7/8" BRIDGE LENGTH  
STA. 41+04.12 BRIDGE END


**CITY OF CONWAY  
CONSTRUCTION PLANS**

**I-40/6TH ST. OVERPASS  
(CONWAY) (S)  
FAULKNER COUNTY  
6TH STREET**

**JOB 080517**


BEGIN JOB 080517  
STA. 30+30.00

NOT TO SCALE

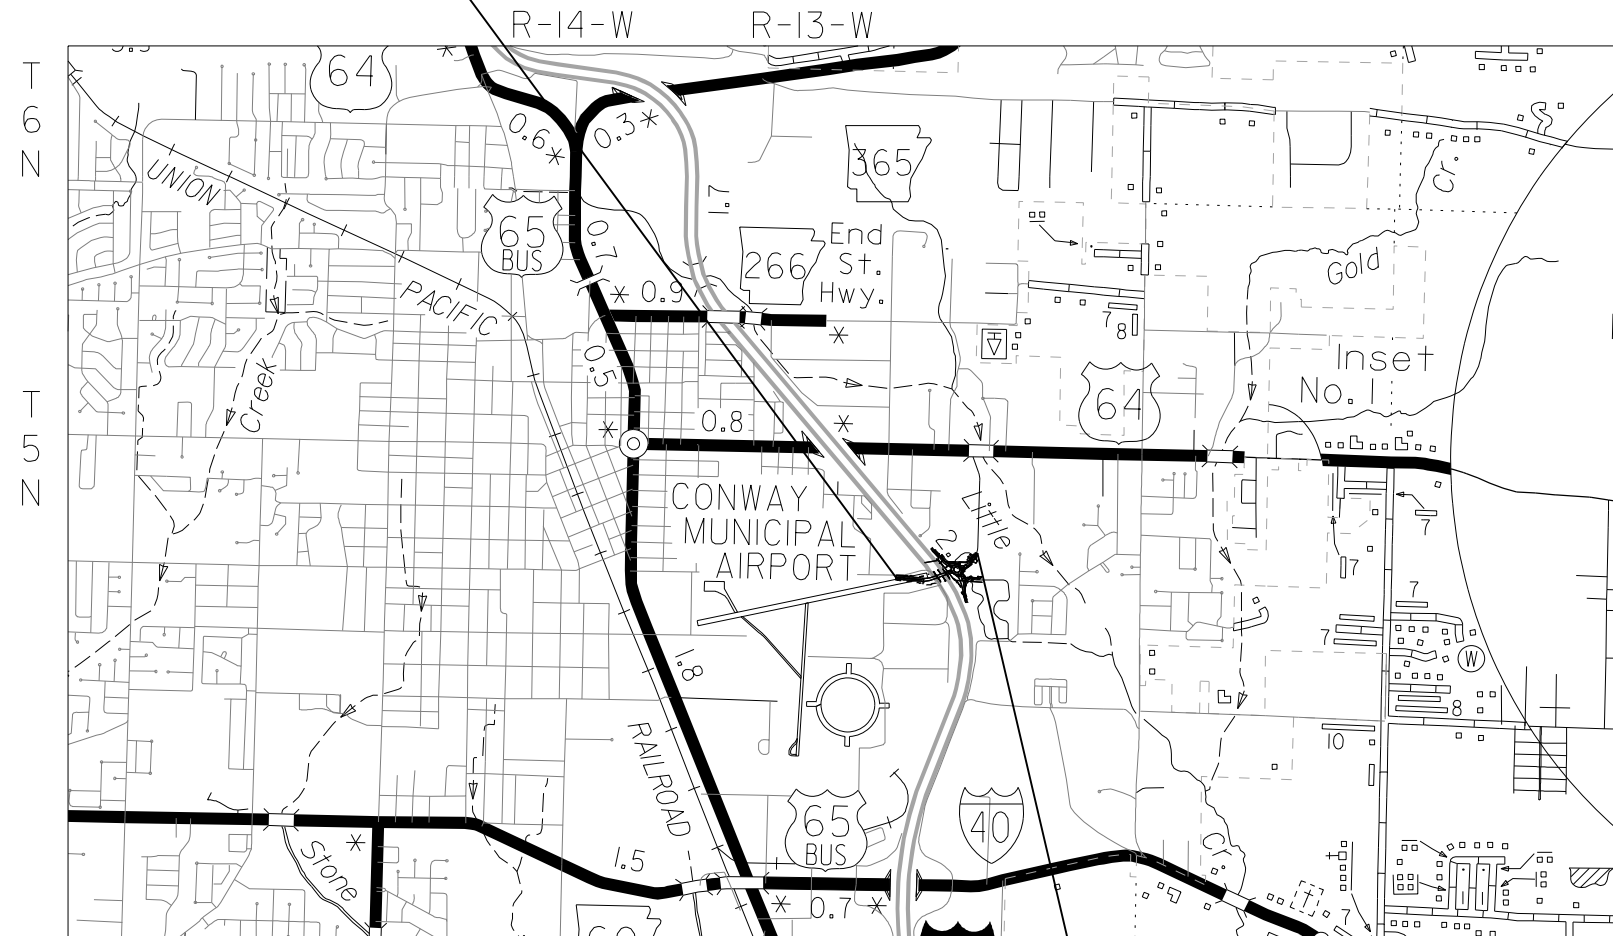

END JOB 080517  
STA. 48+40.00

**ARKANSAS HIGHWAY DISTRICT 8**

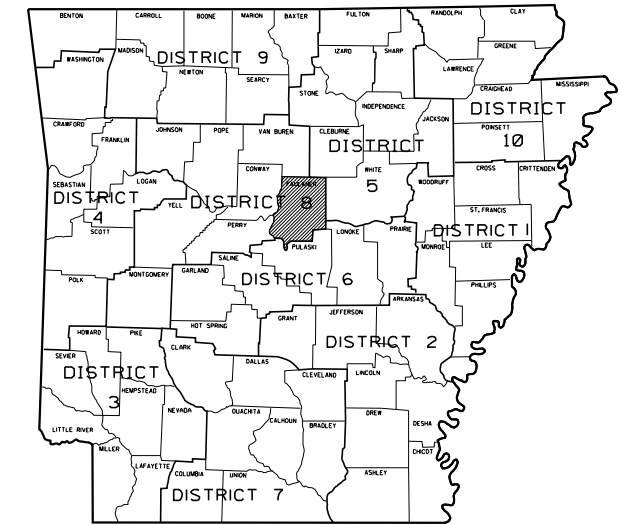

DESIGN TRAFFIC DATA · 6TH ST./ ELSINGER BLVD. AMITY RD.

DESIGN YEAR	2036	2036
2036 ADT	9,152	9,853
2036 ADT	10,242	12,390
2036 DHV	1127	1,363
DIRECTIONAL DISTRIBUTION	60%	60%
TRUCKS	4%	4%
DESIGN SPEED	30 MPH	30 MPH

**PROJECT COORDINATES**

	BEGIN	MID-POINT	END
LATITUDE	N 35°05'03"	N 35°05'03"	N 35°05'07"
LONGITUDE	W 92°25'06"	W 92°24'55"	W 92°24'46"
STATION	30+30.00	39+35.00	48+40.00

LENGTH COMPUTED ALONG C.L. MEDIAN

GROSS LENGTH OF PROJECT	1810.00 FEET OR	0.343 MILES
NET LENGTH OF ROADWAY	1595.76 FEET OR	0.302 MILES
NET LENGTH OF BRIDGES	214.24 FEET OR	0.041 MILES
NET LENGTH OF PROJECT	1810.00 FEET OR	0.343 MILES



Digitally Signed 05/20/2015

P.E. JOB 080517

9/27/2016 2:38:00 PM  
 R:\CORBYN\WORKSPACE\AHTD\LY2012\201550 - Contr-ellField Access\Drawings\6TH ST\6TH INDEX.dgn  
 REVISION DATE:

INDEX OF SHEETS				
SHEET NO.	TITLE	BRIDGE NO.	DRAWING NO.	DATE
1	TITLE SHEET			
2	INDEX OF SHEETS AND GENERAL NOTES			
3-13	TYPICAL SECTIONS OF IMPROVEMENT			
14-15	INTERSECTION DETAILS			
16-22	SPECIAL DETAILS			
23-29	TEMPORARY EROSION CONTROL DETAILS			
30-37	MAINTENANCE OF TRAFFIC			
38-42	PERMANENT PAVEMENT MARKINGS			
43	SOIL BORING LOGS			
44-45	SURVEY CONTROL DETAILS			
46	PLAN AND PROFILE - I-40			
47	PLAN AND PROFILE - 6TH ST.			
48	PLAN AND PROFILE - 6TH ST.			
49	PLAN AND PROFILE - 6TH ST./ELSINGER BLVD.			
50	PLAN AND PROFILE - 6TH ST./ELSINGER BLVD.			
51	PLAN AND PROFILE - AMITY RD.			
52	PLAN AND PROFILE - AMITY RD.			
53	PLAN AND PROFILE - CIRCULATORY ROADWAY			
54	PLAN AND PROFILE - DRIVEWAY 1			
55	DRIVEWAY PROFILES			
56	PLAN AND PROFILE - MOT			
57	PLAN AND PROFILE - MOT			
58-59	SIGNING QUANTITIES			
60-62	PERMANENT SIGNING PLANS			
63	SCHEDULE OF BRIDGE QUANTITIES	07345	57062	
64	SHEET 1 OF 4 - LAYOUT OF BRIDGE OVER I-40	07345	57063	
65	SHEET 2 OF 4 - LAYOUT OF BRIDGE OVER I-40	07345	57064	
66	SHEET 3 OF 4 - LAYOUT OF BRIDGE OVER I-40	07345	57065	
67	SHEET 4 OF 4 - LAYOUT OF BRIDGE OVER I-40	07345	57066	
68	SHEET 1 OF 3 - BORING LOG DETAILS	07345	57067	
69	SHEET 2 OF 3 - BORING LOG DETAILS	07345	57068	
70	SHEET 3 OF 3 - BORING LOG DETAILS	07345	57069	
71	SHEET 1 OF 4 - DETAILS OF END BENT NO. 1	07345	57070	
72	SHEET 2 OF 4 - DETAILS OF END BENT NO. 3	07345	57071	
73	SHEET 3 OF 4 - DETAILS OF END BENTS	07345	57072	
74	SHEET 4 OF 4 - DETAILS OF END BENTS	07345	57073	
75	DETAILS OF TRANSITIONAL APPROACH RAILING	07345	57074	
76	SHEET 1 OF 3 - DETAILS OF INTERMEDIATE BENT NO. 2	07345	57075	
77	SHEET 2 OF 3 - DETAILS OF INTERMEDIATE BENT NO. 2	07345	57076	
78	SHEET 3 OF 3 - DETAILS OF INTERMEDIATE BENT NO. 2	07345	57077	
79	SHEET 1 OF 11 - DETAILS OF 212'-0" CONTINUOUS COMPOSITE PLATE GIRDER UNIT	07345	57078	
80	SHEET 2 OF 11 - DETAILS OF 212'-0" CONTINUOUS COMPOSITE PLATE GIRDER UNIT	07345	57079	
81	SHEET 3 OF 11 - DETAILS OF 212'-0" CONTINUOUS COMPOSITE PLATE GIRDER UNIT	07345	57080	
82	SHEET 4 OF 11 - DETAILS OF 212'-0" CONTINUOUS COMPOSITE PLATE GIRDER UNIT	07345	57081	
83	SHEET 5 OF 11 - DETAILS OF 212'-0" CONTINUOUS COMPOSITE PLATE GIRDER UNIT	07345	57082	
84	SHEET 6 OF 11 - DETAILS OF 212'-0" CONTINUOUS COMPOSITE PLATE GIRDER UNIT	07345	57083	
85	SHEET 7 OF 11 - DETAILS OF 212'-0" CONTINUOUS COMPOSITE PLATE GIRDER UNIT	07345	57084	
86	SHEET 8 OF 11 - DETAILS OF 212'-0" CONTINUOUS COMPOSITE PLATE GIRDER UNIT	07345	57085	
87	SHEET 9 OF 11 - DETAILS OF 212'-0" CONTINUOUS COMPOSITE PLATE GIRDER UNIT	07345	57086	
88	SHEET 10 OF 11 - DETAILS OF 212'-0" CONTINUOUS COMPOSITE PLATE GIRDER UNIT	07345	57087	
89	SHEET 11 OF 11 - -- DETAILS OF 212'-0" CONTINUOUS COMPOSITE PLATE GIRDER UNIT	07345	57088	
90	DETAILS OF ELASTOMERIC BEARINGS	07345	57089	
91	ELECTRICAL LEGEND	07345	57090	
92	BRIDGE LIGHTING INSTALLATION PLAN	07345	57091	
93	SHEET 1 OF 2 - ELECTRICAL DETAILS	07345	57092	
94	SHEET 2 OF 2 - ELECTRICAL DETAILS	07345	57093	
95	SHEET 1 OF 5 - DETAILS OF RETAINING WALLS	07345	57094	
96	SHEET 2 OF 5 - DETAILS OF RETAINING WALLS	07345	57095	
97	SHEET 3 OF 5 - DETAILS OF RETAINING WALLS	07345	57096	
98	SHEET 4 OF 5 - DETAILS OF RETAINING WALLS	07345	57097	
99	SHEET 5 OF 5 - DETAILS OF RETAINING WALLS	07345	57098	
100	SHEET 1 OF 4 - BORING LOG DETAILS RETAINING WALL NOS. 3 & 4	07345	57099	
101	SHEET 2 OF 4 - BORING LOG DETAILS RETAINING WALL NOS. 3 & 4	07345	57100	
102	SHEET 3 OF 4 - BORING LOG DETAILS RETAINING WALL NOS. 3 & 4	07345	57101	
103	SHEET 4 OF 4 - BORING LOG DETAILS RETAINING WALL NOS. 3 & 4	07345	57102	
104	STANDARD DETAILS FOR EMBANKMENT CONSTRUCTION AND BACKFILL AT BRIDGE ENDS		55000	2/27/14
105	STANDARD DETAILS FOR CONCRETE RIPRAP		55002	2/27/14
106	STANDARD DETAILS FOR PERMANENT STEEL BRIDGE DECK FORMS FOR STEEL & CONCRETE GIRDER SPANS		55005	2/27/14
107	STANDARD DETAILS FOR TYPE D BRIDGE NAME PLATE		55010	2/27/14
108	STANDARD DETAILS FOR STEEL H-PILES AND PILE ENCASEMENTS		55020	2/27/14
109	CONCRETE DITCH PAVING		CDP-1	11/17/10
110	CURBING DETAILS		CG-1	11/29/07
111	DETAILS OF DRIVEWAYS & ISLANDS		DR-1	2/27/14
112	FLARED END SECTION		FES-1	10/18/96

DATE REVISED	DATE FILMED	DATE REVISED	DATE FILMED	FED. RD. DIST. NO.	STATE	FED. AID PROJ. NO.	SHEET NO.	TOTAL SHEETS
6-1-2015		5-24-2016		6	ARK.			
2-10-2016		8-10-2016				080517	2	182
3-10-2016		9-27-2016						

2 INDEX OF SHEETS AND GENERAL NOTES



Digitally Signed 09/29/2016

INDEX OF SHEETS				
SHEET NO.	TITLE	BRIDGE NO.	DRAWING NO.	DATE
113	FLARED END SECTION		FES-2	10/18/96
114	DETAILS OF DROP INLETS & JUNCTION BOXES		FPC-9	11/16/01
115	DETAILS OF DROP INLETS		FPC-9D	8/22/02
116	DETAILS OF DROP INLETS (TYPE C)		FPC-9E	8/22/02
117	DETAILS OF DROP INLET (TYPE MO)		FPC-9M	8/22/02
118	DETAILS OF DROP INLET & JUNCTION BOX (TYPE ST)		FPC-9S	7/26/12
119	CONCRETE PIPE CULVERT FILL HEIGHTS & BEDDING		PCC-1	2/27/14
120	METAL PIPE CULVERT FILL HEIGHTS & BEDDING		PCM-1	2/27/14
121	PLASTIC PIPE CULVERT (PVC F949) (NOT USED)		PCP-2	2/27/14
122	PAVEMENT MARKING DETAILS		PM-1	9/12/13
123	STANDARD HIGHWAY SIGNS AND SUPPORT ASSEMBLIES		SHS-1	9/12/13
124	U-CHANNEL POST ASSEMBLIES		SHS-2	2/27/14
125	DETAIL OF BREAKAWAY SIGN SUPPORTS FOR GUIDE SIGNS		SHS-3	9/12/13
126	DETAIL OF BREAKAWAY SIGN SUPPORTS FOR STANDARD SIGNS		SHS-4	9/12/13
127	DETAILS OF GUIDE SIGN PANELS		SHS-5	9/12/13
128	MOUNTING DETAILS FOR DEMOUNTABLE LEGEND ON GUIDE SIGNS		SHS-6	9/12/13
129	DETAILS OF SPECIAL ITEMS		SI-1	9/12/13
130	REINFORCED CONCRETE RETAINING WALL (WITHOUT LIVE LOAD SURCHARGE)		SI-2	2/27/14
131	STANDARD TRAFFIC CONTROLS FOR HIGHWAY CONSTRUCTION		TC-1	12/15/11
132	STANDARD TRAFFIC CONTROLS FOR HIGHWAY CONSTRUCTION		TC-2	9/12/13
133	STANDARD TRAFFIC CONTROLS FOR HIGHWAY CONSTRUCTION		TC-3	10/15/09
134	STANDARD TRAFFIC CONTROLS FOR HIGHWAY CONSTRUCTION - TEMPORARY PRECAST BARRIER		TC-4	2/27/14
135	STANDARD TRAFFIC CONTROLS FOR HIGHWAY CONSTRUCTION - TEMPORARY PRECAST BARRIER		TC-5	10/15/09
136	TEMPORARY EROSION CONTROL DEVICES		TEC-1	12/15/11
137	TEMPORARY EROSION CONTROL DEVICES		TEC-3	11/3/94
138	TEMPORARY EROSION CONTROL DEVICES		TEC-4	7/26/12
139	WIRE FENCE TYPE A AND B		WF-1	8/22/02
140	WIRE FENCE WATER GAPS		WF-2	4/20/79
141	WHEELCHAIR RAMPS NEW CONSTRUCTION AND ALTERATIONS		WR-1	11/10/05
142-182	CROSS SECTIONS			

GENERAL NOTES:


- GRADE LINE DENOTES FINISHED GRADE WHERE SHOWN ON PLANS.
- ALL PIPE LINES, POWER, TELEPHONE, AND TELEGRAPH LINES TO BE MOVED OR LOWERED BY THE RESPECTIVE OWNERS AS PER AGREEMENT WITH SUCH OWNERS.
- ANY EQUIPMENT OR APPURTENANCE THAT INTERFERES WITH THE PROPOSED CONSTRUCTION AND WHICH MAY BE THE PROPERTY OF UTILITY SERVICE ORGANIZATIONS SHALL BE MOVED BY THE OWNERS UNLESS OTHERWISE PROVIDED.
- THE CONTRACTOR SHALL BE RESPONSIBLE FOR MAINTAINING U.S. MAILBOXES WITHIN THE PROJECT LIMITS IN SUCH A MANNER THAT THE PUBLIC MAY RECEIVE CONTINUED MAIL SERVICE. PAYMENT WILL BE CONSIDERED INCLUDED IN THE PRICE BID FOR THE VARIOUS BID ITEMS.
- ALL LAND MONUMENTS LOCATED WITHIN THE CONSTRUCTION AREA SHALL BE PROTECTED IN ACCORDANCE WITH SECTION 107.12 OF THE STANDARD SPECIFICATIONS.
- ALL TREES THAT DO NOT DIRECTLY INTERFERE WITH THE PROPOSED CONSTRUCTION SHALL BE SPARED AS DIRECTED BY THE ENGINEER. CARE AND DISCRETION SHALL BE USED TO INSURE THAT ALL TREES NOT TO BE REMOVED SHALL BE HARMED AS LITTLE AS POSSIBLE DURING THE CONSTRUCTION OPERATIONS.
- THE CONTRACTOR SHALL BE RESPONSIBLE FOR PROVIDING A FENCE TO CONTROL LIVESTOCK IN AREAS WHERE PASTURES ARE SEVERED. WIRE FENCE MAY BE CONSTRUCTED INITIALLY, OR IN LIEU THEREOF, THE CONTRACTOR AT HIS OWN EXPENSE, MAY ELECT TO PROVIDE TEMPORARY FENCING SUITABLE TO CONTAIN LIVESTOCK.
- THE EXISTING ASPHALT PAVEMENT TO BE REMOVED FROM THE REMAINING PAVEMENT SHALL BE SEPARATED BY SAWING ALONG A NEAT LINE. AFTER SAWING, THE PAVEMENT TO BE REMOVED SHALL BE CAREFULLY REMOVED IN A MANNER THAT WILL NOT DAMAGE THE PAVEMENT THAT IS TO REMAIN. ANY DAMAGE OF THE ASPHALT PAVEMENT THAT IS TO REMAIN IN PLACE SHALL BE REPAIRED AT THE CONTRACTOR'S EXPENSE.
- ALL FLEXIBLE BASE AND ASPHALTIC PAVEMENT REMOVED SHALL BE PAID FOR UNDER PAY ITEM 210 - EXCAVATION AND EMBANKMENT, UNLESS OTHERWISE NOTED.
- ALL PIPE SHALL BE CLASS III WITH TYPE 3 BEDDING UNLESS NOTED OTHERWISE.

REVISIONS		
DATE	REVISION	SHEET NUMBER
6/1/2015	ADDED REVISION BOX	2
6/1/2015	REVISED CONSTRUCT NOTES TO INCLUDE DISTANCE FROM CENTERLINE, INLET LOCATION	50
6/1/2015	REVISED CONSTRUCT NOTES TO INCLUDE DISTANCE FROM CENTERLINE	52
6/1/2015	REVISED REINFORCING STEEL IN BENT NO. 2	63
6/1/2015	REPLACED "M53" WITH "M322 TYPE A"	71
6/1/2015	REVISED B501 BAR LENGTH	77
2/10/2016	REVISED DRAINAGE LAYOUT ON AMITY RD. BETWEEN STA. 19+00 AND 23+60, AND REVISED BOX CULVERT TO REFLECT AS-BUILT GRADES. REVISED TEMPORARY DRAINAGE ON AMITY RD. DETOUR BETWEEN STA. 13+20 AND 13+70. REVISED ALIGNMENT OF AMITY RD. DETOUR FROM STA. 9+70.31 TO STA. 16+61.63. REVISED DRAINAGE ON AMITY RD. FROM STA. 10+46 TO STA. 12+00 AND FROM STA. 13+91 TO STA. 14+75. MOVED THE PROPOSED AMITY RD. CONNECTION FROM AMITY RD. DETOUR STA. 22+62.75 TO AMITY RD. DETOUR STA. 24+45.04. REVISED THE MAINTENANCE OF TRAFFIC STAGING FOR ELSINGER BLVD. STA. 46+00 TO STA. 48+40 TO BE CONSTRUCTED IN STAGE 3. REVISED THE ALIGNMENT OF DRIVEWAY 1 AND TEMPORARY DRIVEWAY TO AVOID ELECTRIC SWITCHGEAR AND SANITARY SEWER MANHOLES. ADDED REINFORCED CONCRETE RETAINING WALL AND PIPE BOLLARDS AT DRIVEWAY 1 STA. 11+75 ON LEFT.	2, 12, 13, 17, 19, 20, 23, 24, 26-29, 31, 32, 34-37, 44-46, 49-52, 54-57, 154, 155, 157, 161, 162, 164, 165, 170-175, 181, 182
3/10/2016	REVISED DRAINAGE ON AMITY RD. RT FROM STA. 14+70 TO 14+75	2, 52, 157
5/24/2016	REVISED THE DIMENSIONS OF THE GUIDE SIGN ON ELSINGER AVE. AND REVISED THE LOCATION OF THE SIGN TO STA. 46+30	2, 60, 62
8/10/2016	REVISED INLET LOCATION ON ELSINGER BLVD. AT STA. 43+90 AND REVISED THE TOP ELEVATION SHOWN IN THE PROFILE ON AMITY RD. AT STA. 19+12 RT.	2, 50, 52, 168
9/27/2016	REVISED PATTERNS ON CONCRETE ISLANDS AND TRUCK APRONS	2, 20

INDEX OF SHEETS AND GENERAL NOTES

DATE REVISED	DATE FILMED	DATE REVISED	DATE FILMED	FED. RD. DIST. NO.	STATE	FED. AID PROJ. NO.	SHEET NO.	TOTAL SHEETS
				6	ARK.			
				JOB NO.	080517	3	182	


2 TYPICAL SECTIONS OF IMPROVEMENT

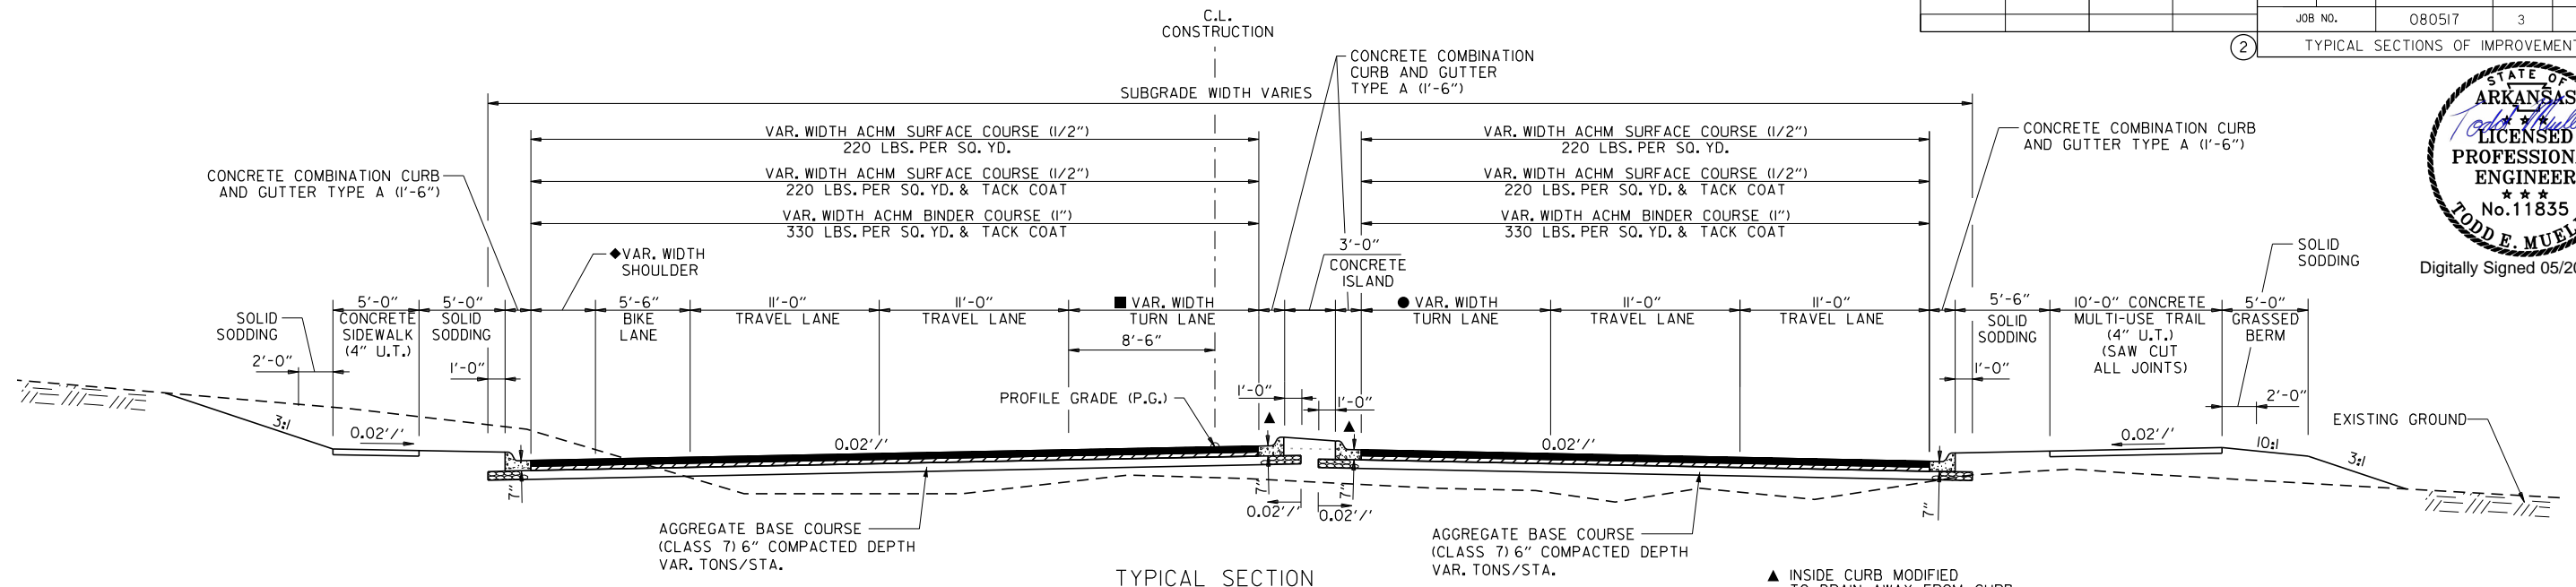

TYPICAL SECTION  
6TH ST.  
STA. 30+30.00 TO STA. 31+11.00

- ▲ INSIDE CURB MODIFIED TO DRAIN AWAY FROM CURB
- TRANSITION TURN LANE FROM 11'-0" @ STA. 30+31.00 TO 0'-0" @ STA. 31+11.00
- TRANSITION TURN LANE FROM 0'-0" @ STA. 30+31.00 TO 11'-0" @ STA. 31+11.00
- ◆ TRANSITION SHOULDER FROM 0'-0" @ STA. 30+53.50 TO 3'-9" @ STA. 31+11.00

NOTE:  
CONCRETE MULTI-USE TRAIL SHALL BE MEASURED AND PAID FOR AS "SIDEWALK".

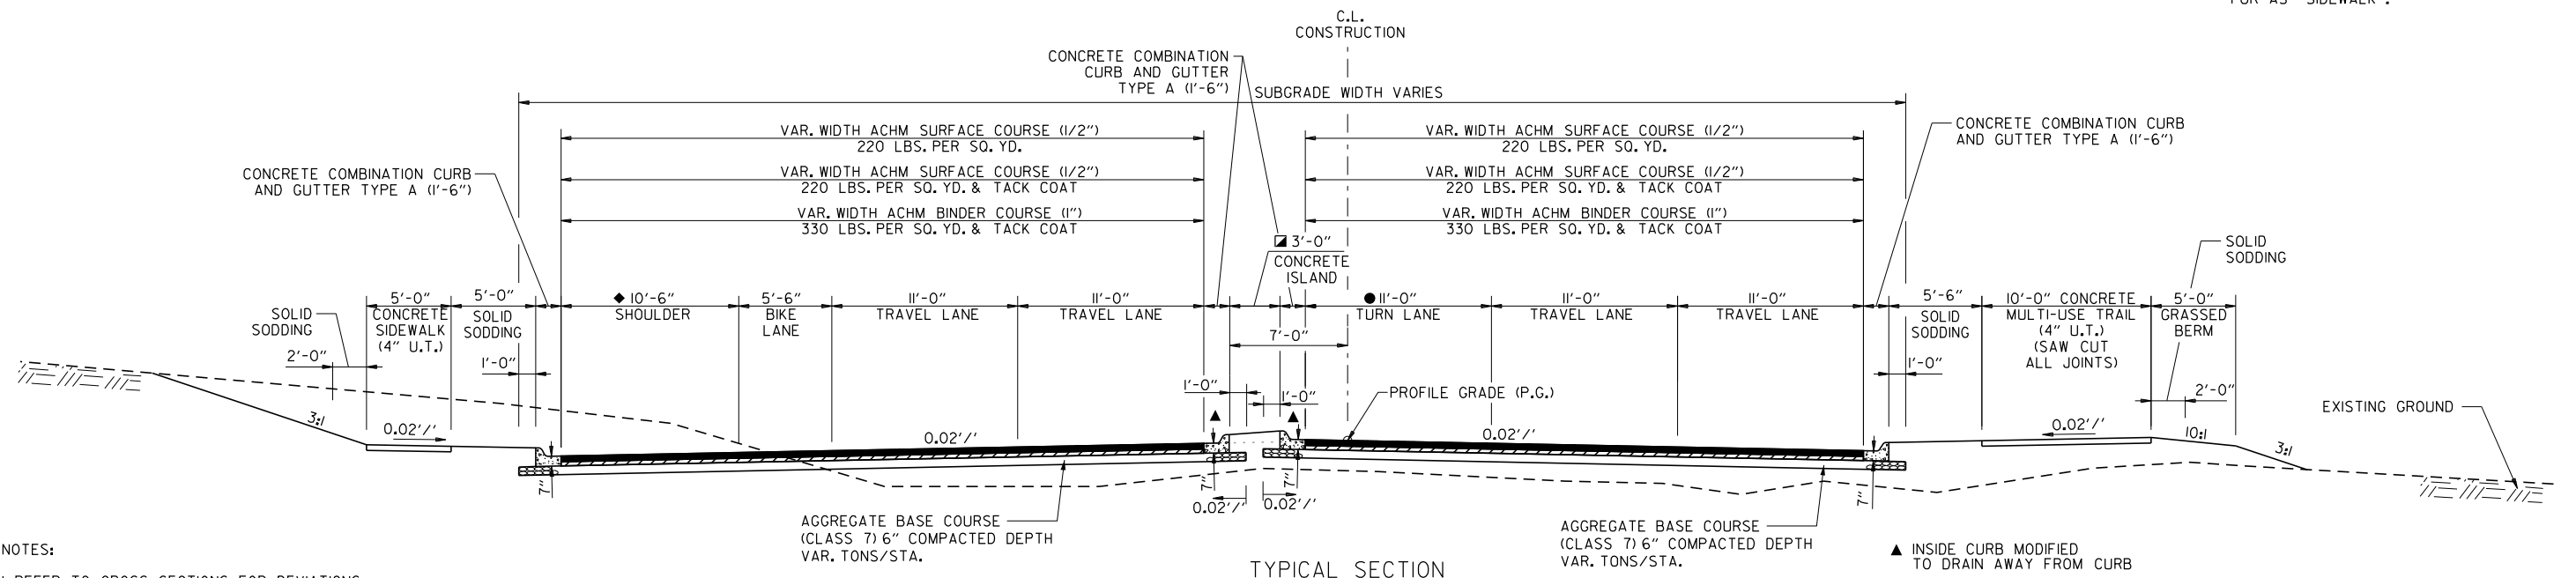

TYPICAL SECTION  
6TH ST.  
STA. 31+11.00 TO STA. 32+93.50


- ▲ INSIDE CURB MODIFIED TO DRAIN AWAY FROM CURB
- ◆ TRANSITION SHOULDER FROM 3'-9" @ STA. 31+11.00 TO 10'-6" @ STA. 32+13.50
- TRANSITION SHOULDER FROM 10'-6" @ STA. 32+78.50 TO 0'-0" @ STA. 32+93.50
- TRANSITION MEDIAN FROM 3'-0" CONCRETE ISLAND TO 14'-0" GRASSED MEDIAN @ STA. 32+13.50
- TRANSITION TURN LANE FROM 11'-0" TO 0'-0" @ STA. 32+13.50

- NOTES:
1. REFER TO CROSS SECTIONS FOR DEVIATIONS FROM NORMAL SLOPES. NO CHANGES SHALL BE MADE FROM THE PLANNED SLOPES WITHOUT THE APPROVAL OF THE ENGINEER.
  2. THE THICKNESS OF AGGREGATE BASE COURSE SHALL BE WITHIN PLUS OR MINUS ONE INCH OF THE PLAN THICKNESS SHOWN. THE CONTRACTOR WILL CORRECT ANY DEFICIENT THICKNESS THAT DOES NOT MEET THE TOLERANCE INDICATED. PAYMENT WILL NOT BE MADE FOR MATERIAL PLACED IN EXCESS OF THE TOLERANCE INDICATED.
  3. THE FINAL 2" OF SURFACE COURSE IS TO BE PLACED AFTER ALL OTHER COURSES HAVE BEEN LAID. LONGITUDINAL JOINTS SHALL BE AT LANE LINES.

5/20/2015 7:12:14 AM  
 WORKSPACE: AHTD  
 L:\2012\12015590 - ConrailField Access\Drawings\6TH\_ST\6TH\_TYP\_ALL.dgn  
 REVISION DATE:

DATE REVISED	DATE FILMED	DATE REVISED	DATE FILMED	FED. RD. DIST. NO.	STATE	FED. AID PROJ. NO.	SHEET NO.	TOTAL SHEETS
				6	ARK.			
				JOB NO.	080517	4	182	


2 TYPICAL SECTIONS OF IMPROVEMENT

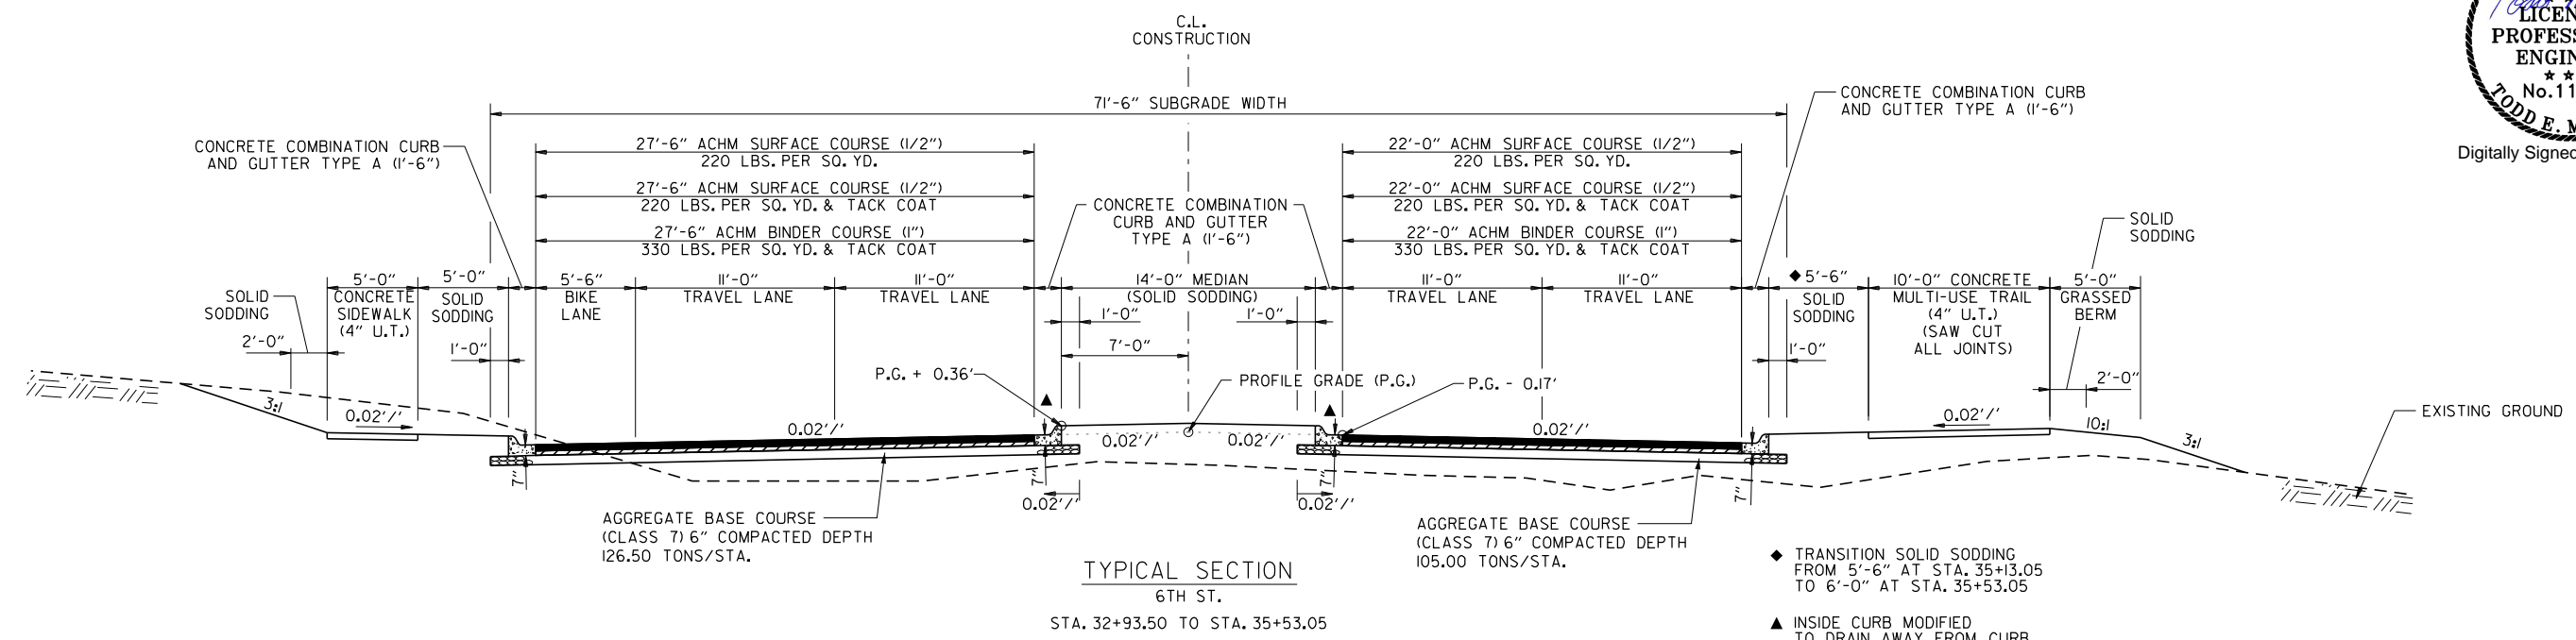

TYPICAL SECTION  
6TH ST.  
STA. 32+93.50 TO STA. 35+53.05

- ◆ TRANSITION SOLID SODDING FROM 5'-6" AT STA. 35+13.05 TO 6'-0" AT STA. 35+53.05
- ▲ INSIDE CURB MODIFIED TO DRAIN AWAY FROM CURB

NOTE:  
CONCRETE MULTI-USE TRAIL SHALL BE MEASURED AND PAID FOR AS "SIDEWALK".

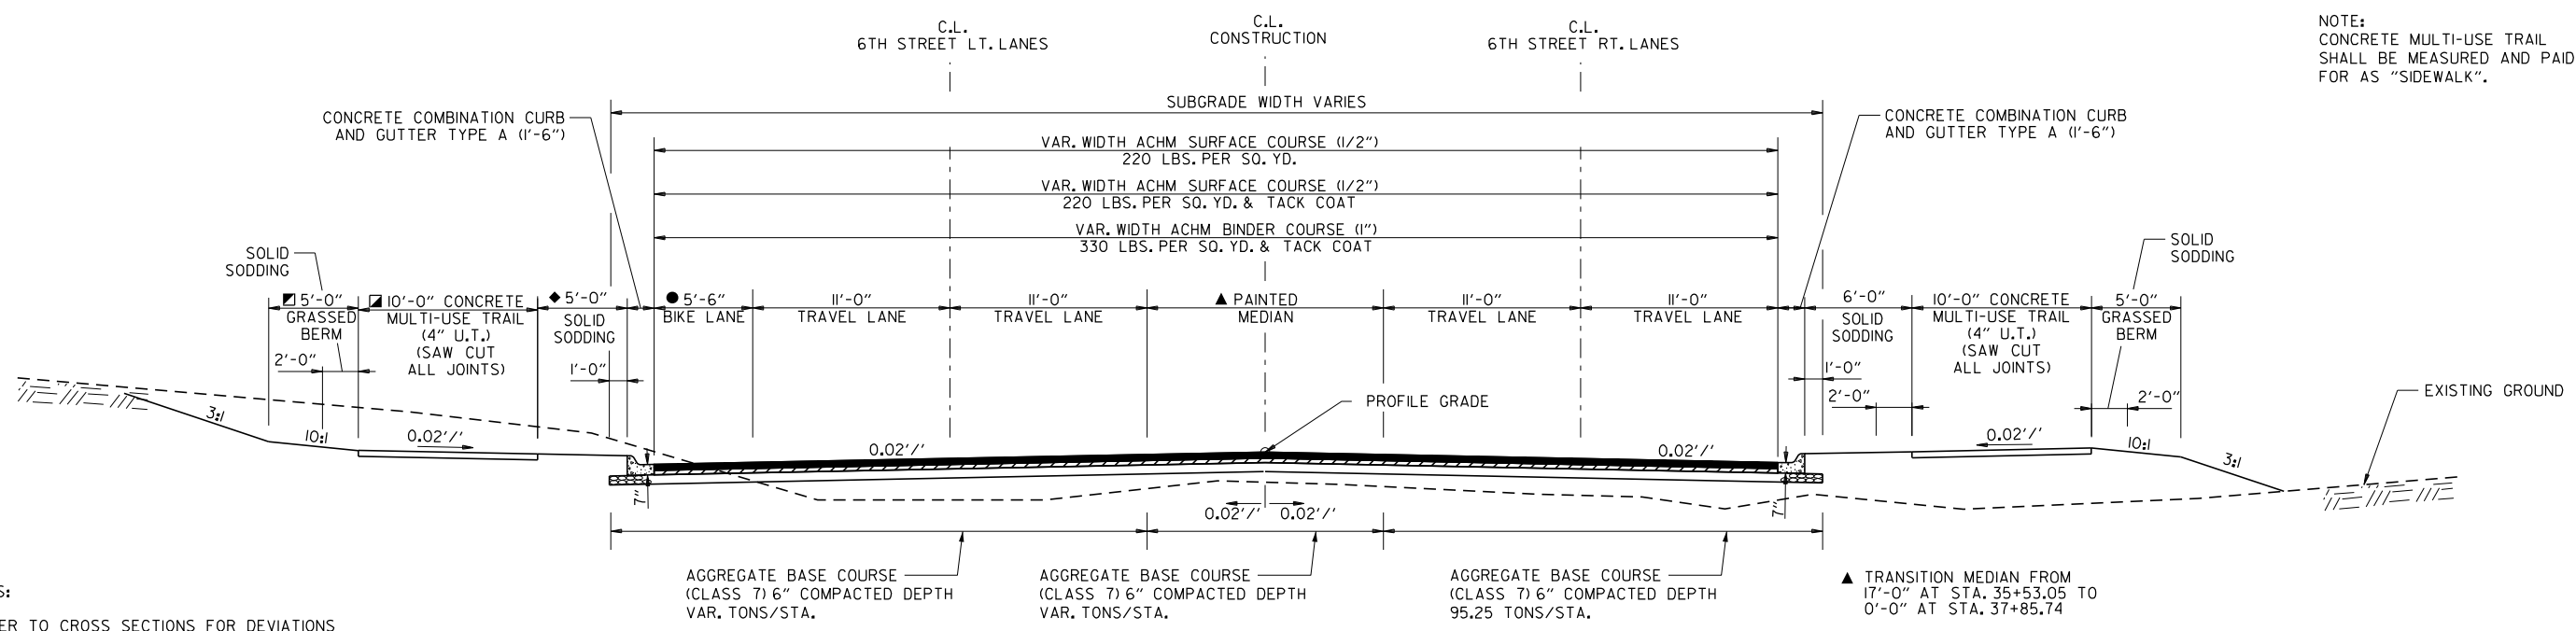

TYPICAL SECTION  
6TH ST.  
STA. 35+53.05 TO STA. 38+17.66

- ▲ TRANSITION MEDIAN FROM 17'-0" AT STA. 35+53.05 TO 0'-0" AT STA. 37+85.74
- TRANSITION BIKE LANE FROM 5'-6" AT STA. 35+55.44 TO 0'-0" AT STA. 35+95.44
- ◆ TRANSITION SOLID SODDING FROM 5'-0" AT STA. 35+55.44 TO 6'-0" AT STA. 35+95.44
- TRANSITION FROM 5'-0" SIDEWALK AT STA. 35+55.44 TO 10'-0" MULTI-USE TRAIL AT STA. 35+95.44
- TRANSITION GRASSED BERM FROM 0'-0" AT STA. 35+55.44 TO 5'-0" AT STA. 35+95.44

- NOTES:
1. REFER TO CROSS SECTIONS FOR DEVIATIONS FROM NORMAL SLOPES. NO CHANGES SHALL BE MADE FROM THE PLANNED SLOPES WITHOUT THE APPROVAL OF THE ENGINEER.
  2. THE THICKNESS OF AGGREGATE BASE COURSE SHALL BE WITHIN PLUS OR MINUS ONE INCH OF THE PLAN THICKNESS SHOWN. THE CONTRACTOR WILL CORRECT ANY DEFICIENT THICKNESS THAT DOES NOT MEET THE TOLERANCE INDICATED. PAYMENT WILL NOT BE MADE FOR MATERIAL PLACED IN EXCESS OF THE TOLERANCE INDICATED.
  3. THE FINAL 2" OF SURFACE COURSE IS TO BE PLACED AFTER ALL OTHER COURSES HAVE BEEN LAID. LONGITUDINAL JOINTS SHALL BE AT LANE LINES.

TYPICAL SECTIONS OF IMPROVEMENT


5/20/2015 7:12:15 AM  
 WORKSPACE: AHTD  
 L:\2012\1201590 - Contr\field Access\Drawings\6TH\_ST\6TH\_TYP\_ALL.dgn  
 REVISION DATE:

DATE REVISED	DATE FILMED	DATE REVISED	DATE FILMED	FED. RD. DIST. NO.	STATE	FED. AID PROJ. NO.	SHEET NO.	TOTAL SHEETS
				6	ARK.			
				JOB NO.		080517	5	182

2 TYPICAL SECTIONS OF IMPROVEMENT



Digitally Signed 05/20/2015

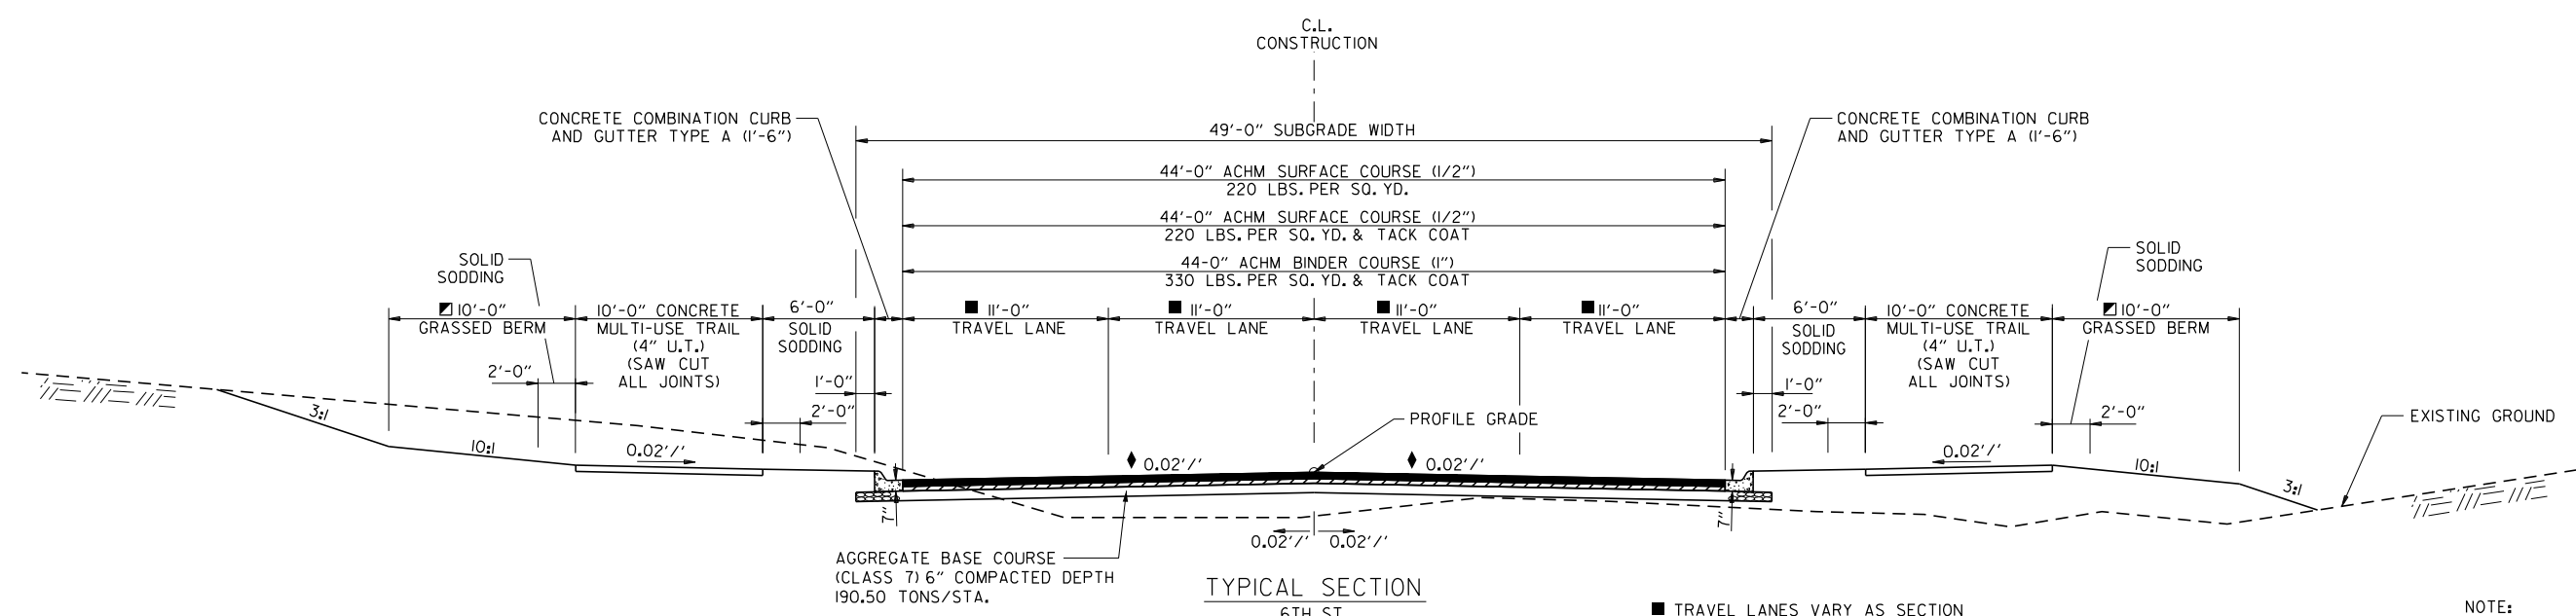

TYPICAL SECTION  
6TH ST.  
STA. 38+17.66 TO STA. 42+34.92

- TRAVEL LANES VARY AS SECTION APPROACHES ROUNDABOUT (SEE SPECIAL DETAILS)
- ◆ CROSS SLOPES VARY AS SECTION APPROACHES ROUNDABOUT TO MATCH CIRCULATORY ROADWAY VERTICAL PROFILE (SEE FORM GRADE DETAILS)
- ▣ TRANSITION GRASSED BERM FROM 0'-0" AT STA. 41+04.12 TO 10'-0" AT STA. 41+30.00

NOTE:  
CONCRETE MULTI-USE TRAIL SHALL BE MEASURED AND PAID FOR AS "SIDEWALK".

- NOTES:
1. REFER TO CROSS SECTIONS FOR DEVIATIONS FROM NORMAL SLOPES. NO CHANGES SHALL BE MADE FROM THE PLANNED SLOPES WITHOUT THE APPROVAL OF THE ENGINEER.
  2. THE THICKNESS OF AGGREGATE BASE COURSE SHALL BE WITHIN PLUS OR MINUS ONE INCH OF THE PLAN THICKNESS SHOWN. THE CONTRACTOR WILL CORRECT ANY DEFICIENT THICKNESS THAT DOES NOT MEET THE TOLERANCE INDICATED. PAYMENT WILL NOT BE MADE FOR MATERIAL PLACED IN EXCESS OF THE TOLERANCE INDICATED.
  3. THE FINAL 2" OF SURFACE COURSE IS TO BE PLACED AFTER ALL OTHER COURSES HAVE BEEN LAID. LONGITUDINAL JOINTS SHALL BE AT LANE LINES.


5/20/2015 11:21AM  
 WORKSPACE: AHTD  
 L:\2012\12015590 - Contr\ell\field Access\Drawings\6TH\_ST\6TH\_TYP\_ALL.dgn  
 REVISION DATE:

DATE REVISED	DATE FILMED	DATE REVISED	DATE FILMED	FED. RD. DIST. NO.	STATE	FED. AID PROJ. NO.	SHEET NO.	TOTAL SHEETS
				6	ARK.			
				JOB NO.	080517	6	182	

2 TYPICAL SECTIONS OF IMPROVEMENT



Digitally Signed 05/20/2015

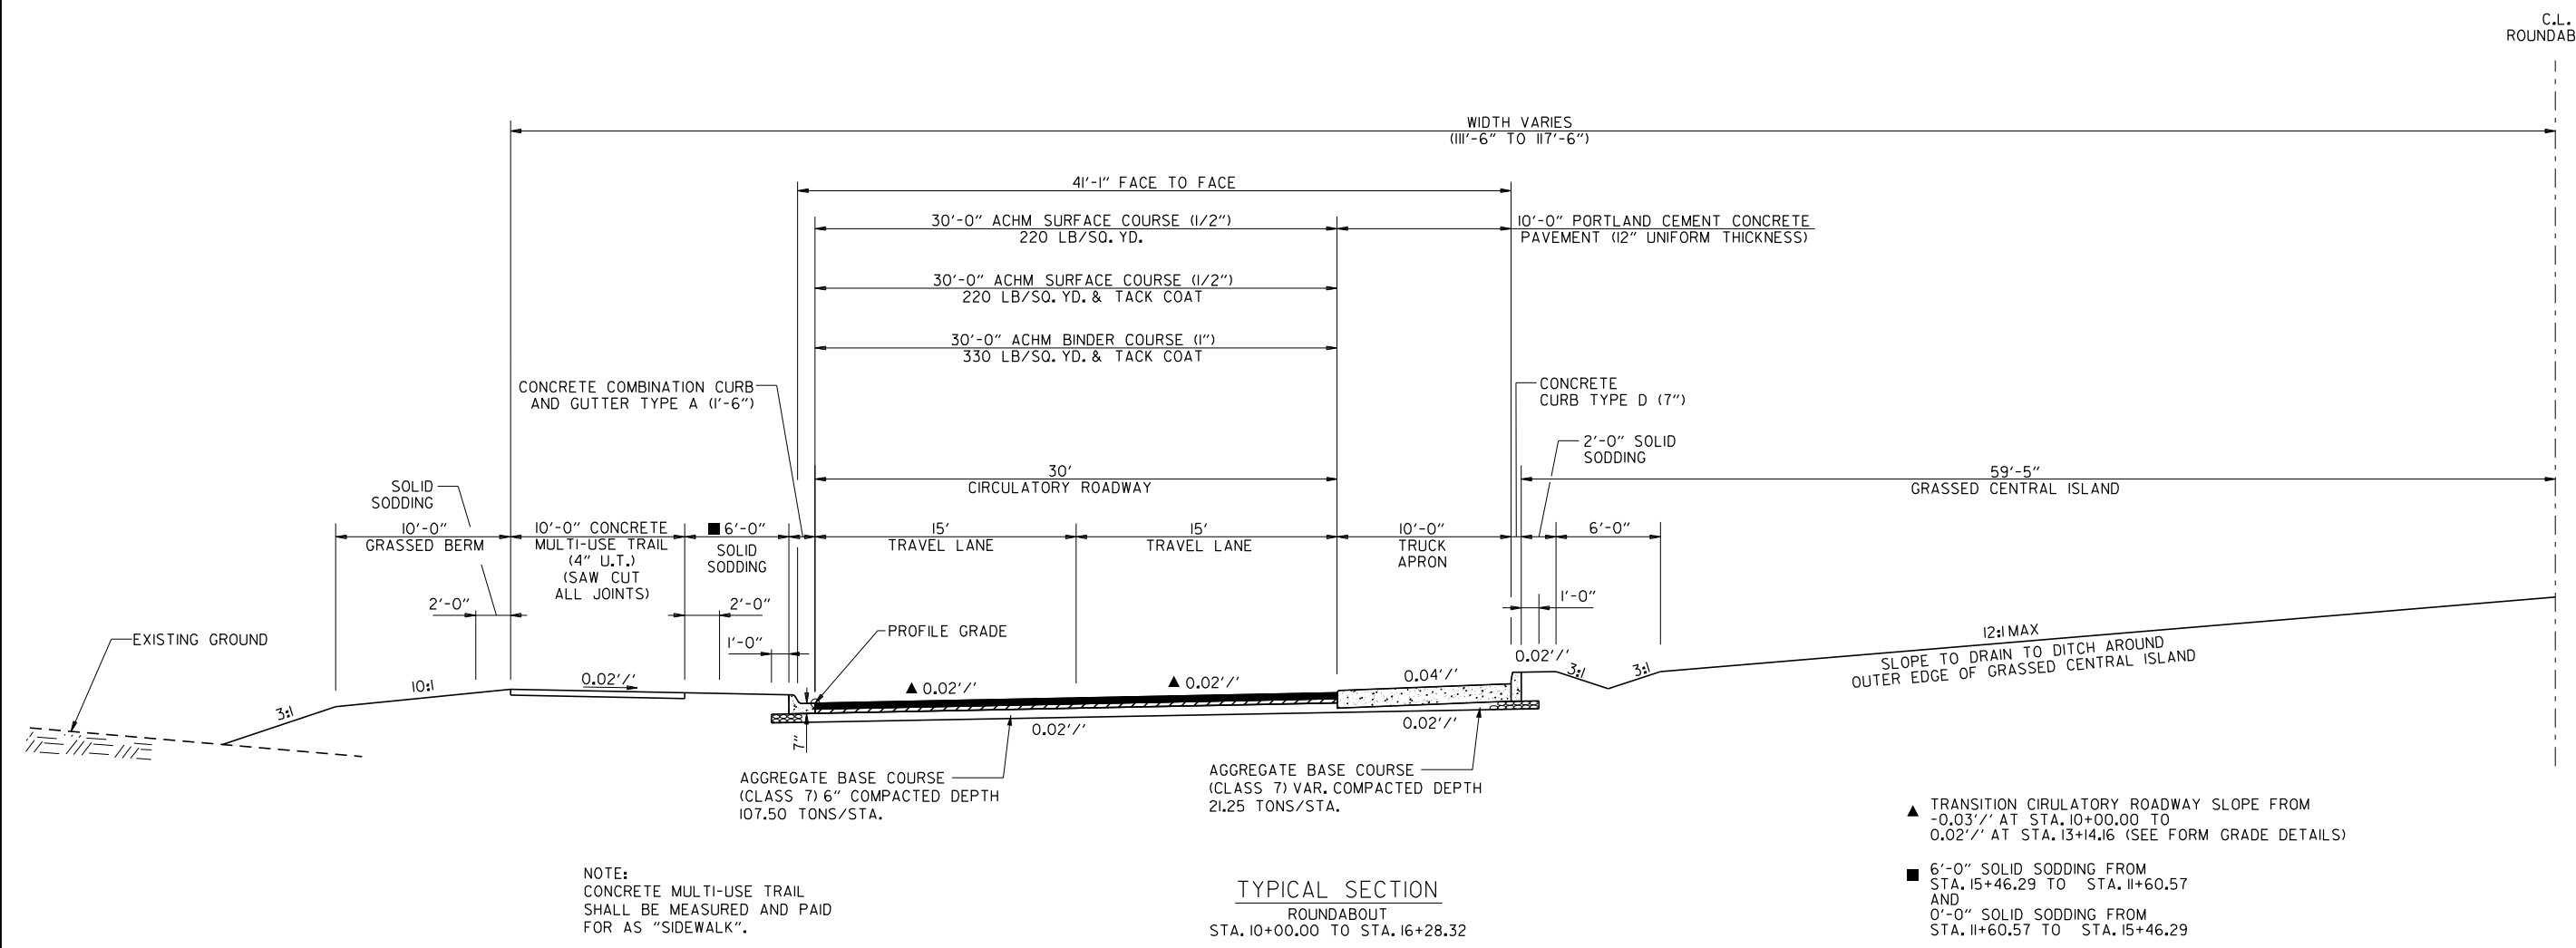

TYPICAL SECTION  
 ROUNDABOUT  
 STA. 10+00.00 TO STA. 16+28.32

NOTE:  
 CONCRETE MULTI-USE TRAIL  
 SHALL BE MEASURED AND PAID  
 FOR AS "SIDEWALK".

- ▲ TRANSITION CIRCULATORY ROADWAY SLOPE FROM -0.03'/' AT STA. 10+00.00 TO 0.02'/' AT STA. 13+14.16 (SEE FORM GRADE DETAILS)
- 6'-0" SOLID SODDING FROM STA. 15+46.29 TO STA. 11+60.57 AND 0'-0" SOLID SODDING FROM STA. 11+60.57 TO STA. 15+46.29

- NOTES:
- REFER TO CROSS SECTIONS FOR DEVIATIONS FROM NORMAL SLOPES. NO CHANGES SHALL BE MADE FROM THE PLANNED SLOPES WITHOUT THE APPROVAL OF THE ENGINEER.
  - THE THICKNESS OF AGGREGATE BASE COURSE SHALL BE WITHIN PLUS OR MINUS ONE INCH OF THE PLAN THICKNESS SHOWN. THE CONTRACTOR WILL CORRECT ANY DEFICIENT THICKNESS THAT DOES NOT MEET THE TOLERANCE INDICATED. PAYMENT WILL NOT BE MADE FOR MATERIAL PLACED IN EXCESS OF THE TOLERANCE INDICATED.
  - THE FINAL 2" OF SURFACE COURSE IS TO BE PLACED AFTER ALL OTHER COURSES HAVE BEEN LAID. LONGITUDINAL JOINTS SHALL BE AT LANE LINES.


5/20/2015 7:12:26 AM  
 WORKSPACE: AHTD  
 L:\2012\12015590 - Contr\field\Access\Drawings\6TH\_ST\6TH\_TYP\_ALL.dgn  
 REVISION DATE:

DATE REVISED	DATE FILMED	DATE REVISED	DATE FILMED	FED. RD. DIST. NO.	STATE	FED. AID PROJ. NO.	SHEET NO.	TOTAL SHEETS
				6	ARK.			
				JOB NO.	080517	7	182	

2 TYPICAL SECTIONS OF IMPROVEMENT



Digitally Signed 05/20/2015

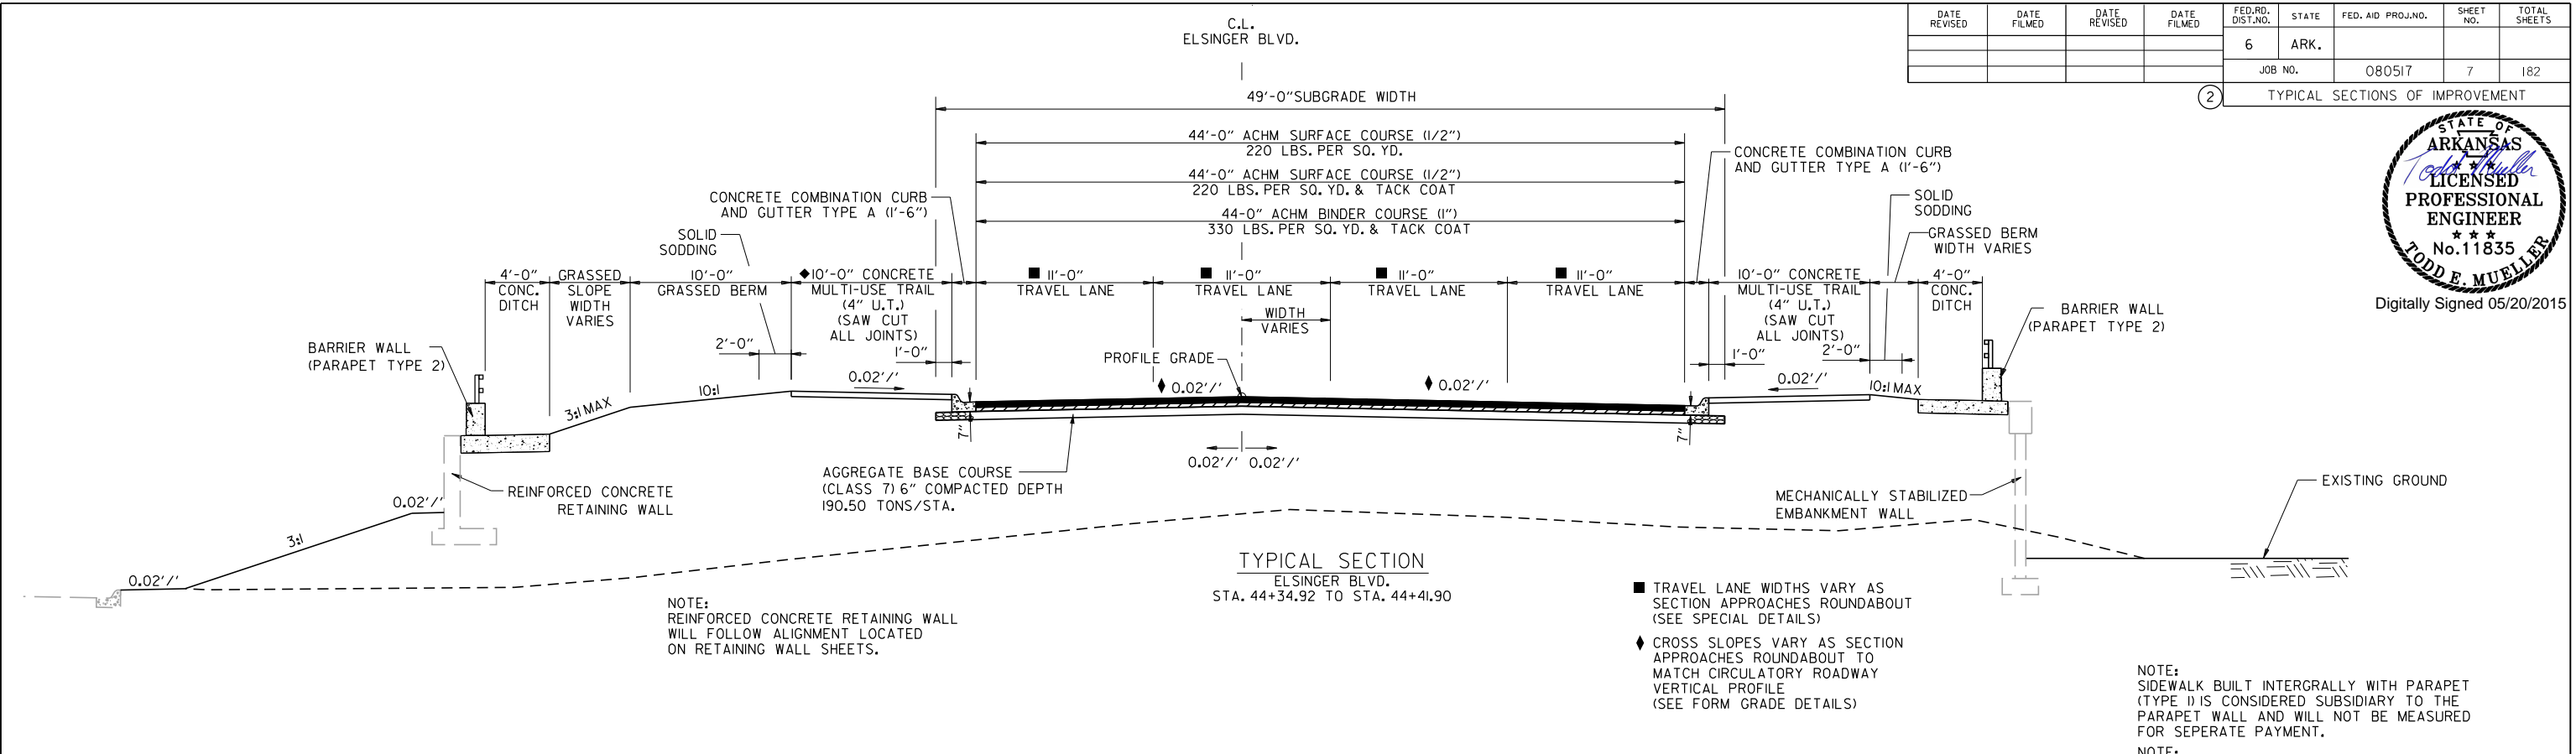

TYPICAL SECTION  
ELSINGER BLVD.  
STA. 44+34.92 TO STA. 44+41.90

- TRAVEL LANE WIDTHS VARY AS SECTION APPROACHES ROUNDABOUT (SEE SPECIAL DETAILS)
- ◆ CROSS SLOPES VARY AS SECTION APPROACHES ROUNDABOUT TO MATCH CIRCULATORY ROADWAY VERTICAL PROFILE (SEE FORM GRADE DETAILS)


NOTE:  
REINFORCED CONCRETE RETAINING WALL  
WILL FOLLOW ALIGNMENT LOCATED  
ON RETAINING WALL SHEETS.

NOTE:  
SIDEWALK BUILT INTERGRALLY WITH PARAPET  
(TYPE 1) IS CONSIDERED SUBSIDIARY TO THE  
PARAPET WALL AND WILL NOT BE MEASURED  
FOR SEPERATE PAYMENT.

NOTE:  
MECHANICALLY STABILIZED EMBANKMENT  
WALL WILL FOLLOW ALIGNMENT LOCATED  
ON MSE WALL SHEETS.

NOTE:  
ELSINGER ALIGNMENT OFFSET TO  
ACCOMMODATE ROUNDABOUT APPROACH  
AND MATCH EXISTING AT THE END  
OF PROJECT.

NOTE:  
CONCRETE MULTI-USE TRAIL  
SHALL BE MEASURED AND PAID  
FOR AS "SIDEWALK".

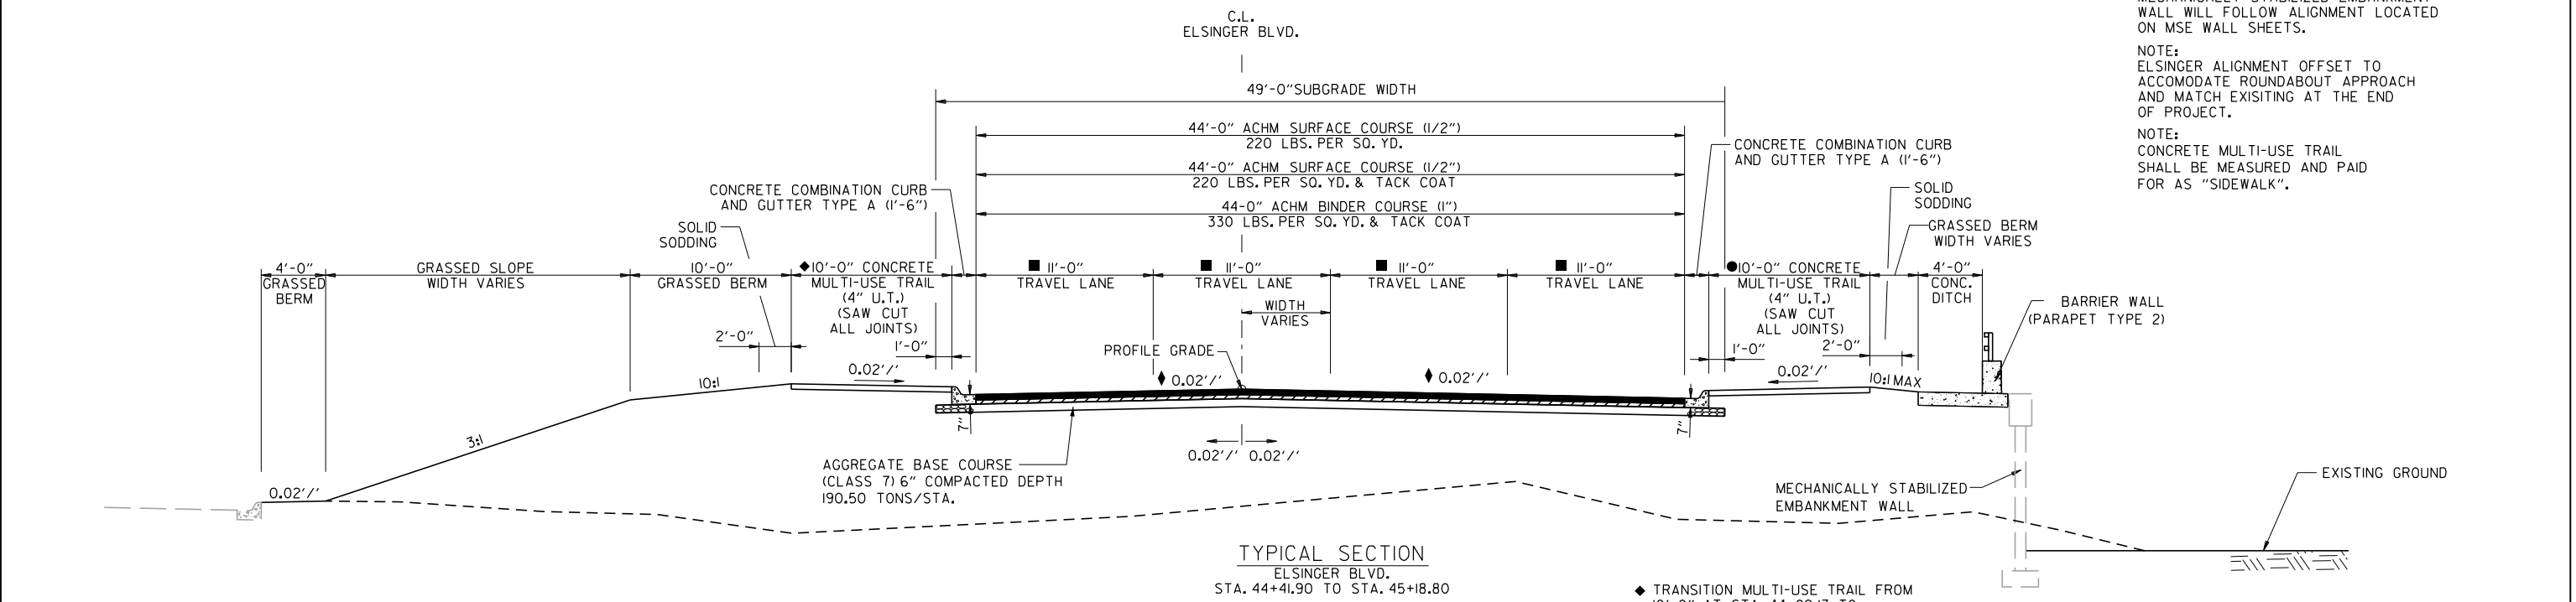

TYPICAL SECTION  
ELSINGER BLVD.  
STA. 44+41.90 TO STA. 45+18.80

- ◆ TRANSITION MULTI-USE TRAIL FROM 10'-0" AT STA. 44+82.13 TO 6'-0" AT STA. 45+17.13
- TRANSITION MULTI-USE TRAIL FROM 10'-0" AT STA. 44+77.84 TO 6'-0" SIDEWALK AT STA. 45+12.84
- TRAVEL LANE WIDTHS VARY AS SECTION APPROACHES ROUNDABOUT (SEE SPECIAL DETAILS)
- ◆ CROSS SLOPES VARY AS SECTION APPROACHES ROUNDABOUT TO MATCH CIRCULATORY ROADWAY VERTICAL PROFILE (SEE FORM GRADE DETAILS)

- NOTES:
1. REFER TO CROSS SECTIONS FOR DEVIATIONS FROM NORMAL SLOPES. NO CHANGES SHALL BE MADE FROM THE PLANNED SLOPES WITHOUT THE APPROVAL OF THE ENGINEER.
  2. THE THICKNESS OF AGGREGATE BASE COURSE SHALL BE WITHIN PLUS OR MINUS ONE INCH OF THE PLAN THICKNESS SHOWN. THE CONTRACTOR WILL CORRECT ANY DEFICIENT THICKNESS THAT DOES NOT MEET THE TOLERANCE INDICATED. PAYMENT WILL NOT BE MADE FOR MATERIAL PLACED IN EXCESS OF THE TOLERANCE INDICATED.
  3. THE FINAL 2" OF SURFACE COURSE IS TO BE PLACED AFTER ALL OTHER COURSES HAVE BEEN LAID. LONGITUDINAL JOINTS SHALL BE AT LANE LINES.

TYPICAL SECTIONS OF IMPROVEMENT


5/20/2015 7:12:27 AM  
 WORKSPACE: AHTD  
 L:\2012\12015590 - Contr-Field Access\Drawings\6TH\_ST\6TH\_TYP\_ALL.dgn  
 REVISION DATE:

DATE REVISED	DATE FILMED	DATE REVISED	DATE FILMED	FED. RD. DIST. NO.	STATE	FED. AID PROJ. NO.	SHEET NO.	TOTAL SHEETS
				6	ARK.			
				JOB NO.	080517	8	182	

2 TYPICAL SECTIONS OF IMPROVEMENT



Digitally Signed 05/20/2015

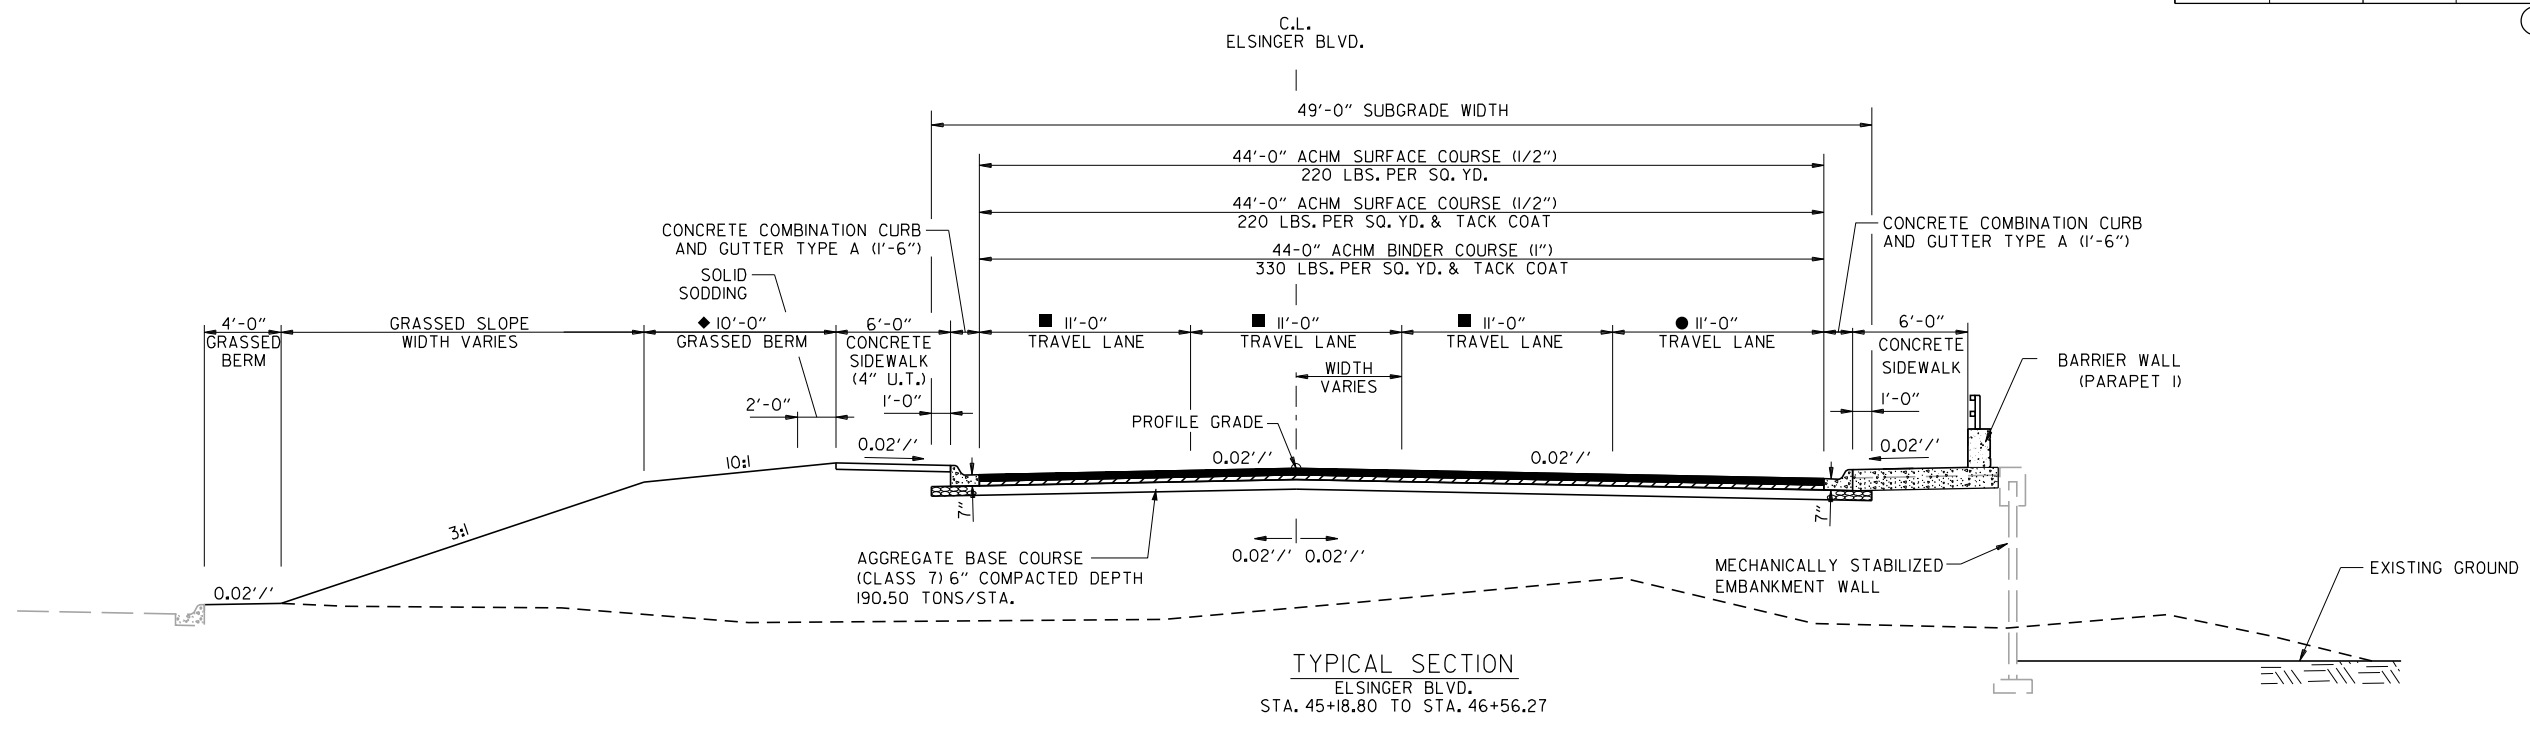


TYPICAL SECTION  
ELSINGER BLVD.  
STA. 45+18.80 TO STA. 46+56.27

- TRANSITION TRAVEL LANE FROM 11'-0" AT STA. 45+30.00 TO 0'-0" AT STA. 46+95.00
- ◆ TRANSITION GRASSED BERM FROM 10'-0" AT STA. 46+30.00 TO 0'-0" AT STA. 46+50.00
- TRAVEL LANE WIDTHS VARY AS SECTION APPROACHES ROUNDABOUT (SEE SPECIAL DETAILS)
- ◆ CROSS SLOPES VARY AS SECTION APPROACHES ROUNDABOUT TO MATCH CIRCULATORY ROADWAY VERTICAL PROFILE (SEE FORM GRADE DETAILS)

NOTE:  
SIDEWALK BUILT INTERGRALLY WITH PARAPET (TYPE I) IS CONSIDERED SUBSIDIARY TO THE PARAPET WALL AND WILL NOT BE MEASURED FOR SEPERATE PAYMENT.

NOTE:  
MECHANICALLY STABILIZED EMBANKMENT WALL WILL FOLLOW ALIGNMENT LOCATED ON MSE WALL SHEETS.

NOTE:  
ELSINGER ALIGNMENT OFFSET TO ACCOMMODATE ROUNDABOUT APPROACH AND MATCH EXISTING AT THE END OF PROJECT.

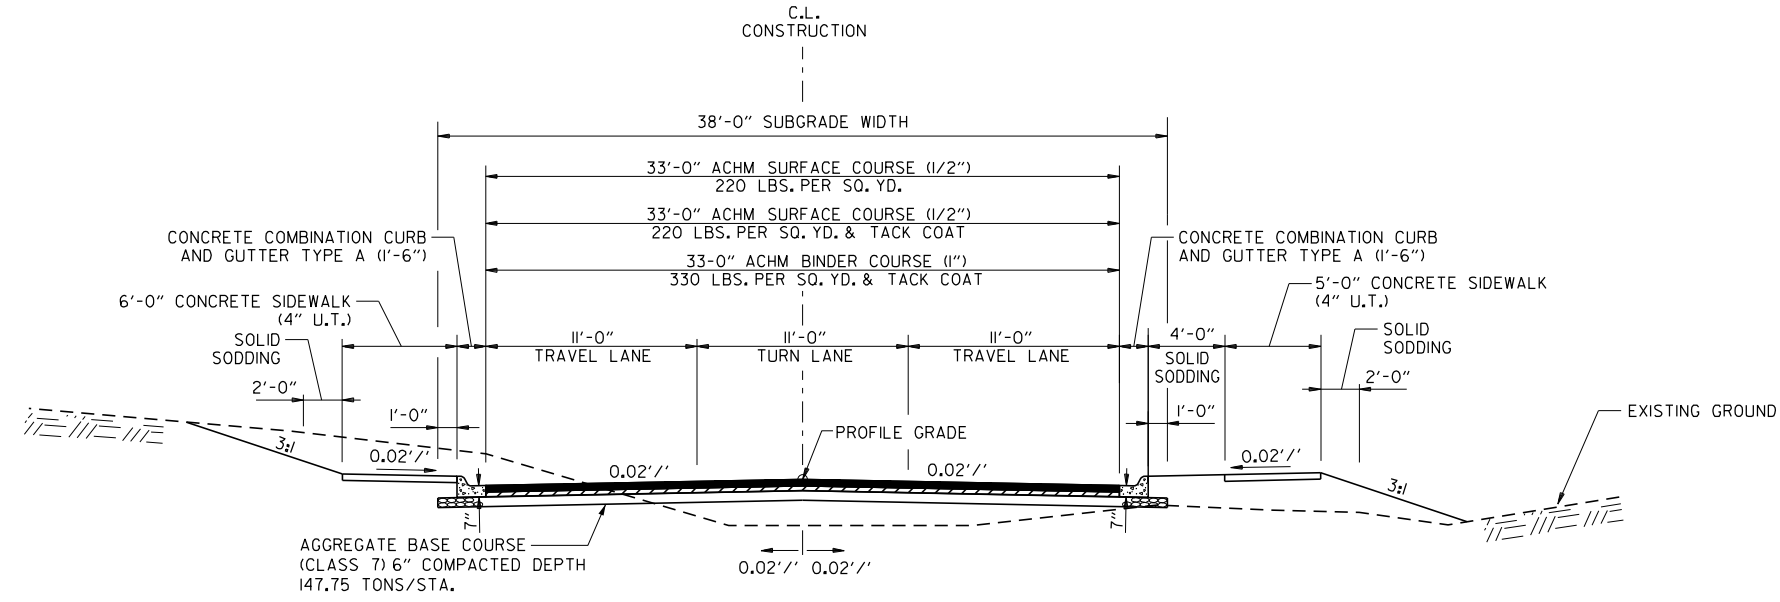

TYPICAL SECTION  
ELSINGER BLVD.  
STA. 46+56.27 TO STA. 48+40.00

- NOTES:
- REFER TO CROSS SECTIONS FOR DEVIATIONS FROM NORMAL SLOPES. NO CHANGES SHALL BE MADE FROM THE PLANNED SLOPES WITHOUT THE APPROVAL OF THE ENGINEER.
  - THE THICKNESS OF AGGREGATE BASE COURSE SHALL BE WITHIN PLUS OR MINUS ONE INCH OF THE PLAN THICKNESS SHOWN. THE CONTRACTOR WILL CORRECT ANY DEFICIENT THICKNESS THAT DOES NOT MEET THE TOLERANCE INDICATED. PAYMENT WILL NOT BE MADE FOR MATERIAL PLACED IN EXCESS OF THE TOLERANCE INDICATED.
  - THE FINAL 2" OF SURFACE COURSE IS TO BE PLACED AFTER ALL OTHER COURSES HAVE BEEN LAID. LONGITUDINAL JOINTS SHALL BE AT LANE LINES.

5/20/2015 11:27 AM  
 WORKSPACE: AHTD  
 L:\2012\12015590 - Contr-ell\field Access\Drawings\6TH\_STA\6TH\_TYP\_ALL.dgn  
 REVISED DATE:





DATE REVISED	DATE FILMED	DATE REVISED	DATE FILMED	FED. RD. DIST. NO.	STATE	FED. AID PROJ. NO.	SHEET NO.	TOTAL SHEETS
				6	ARK.			
				JOB NO.	080517	9	182	

2 TYPICAL SECTIONS OF IMPROVEMENT



Digitally Signed 05/20/2015

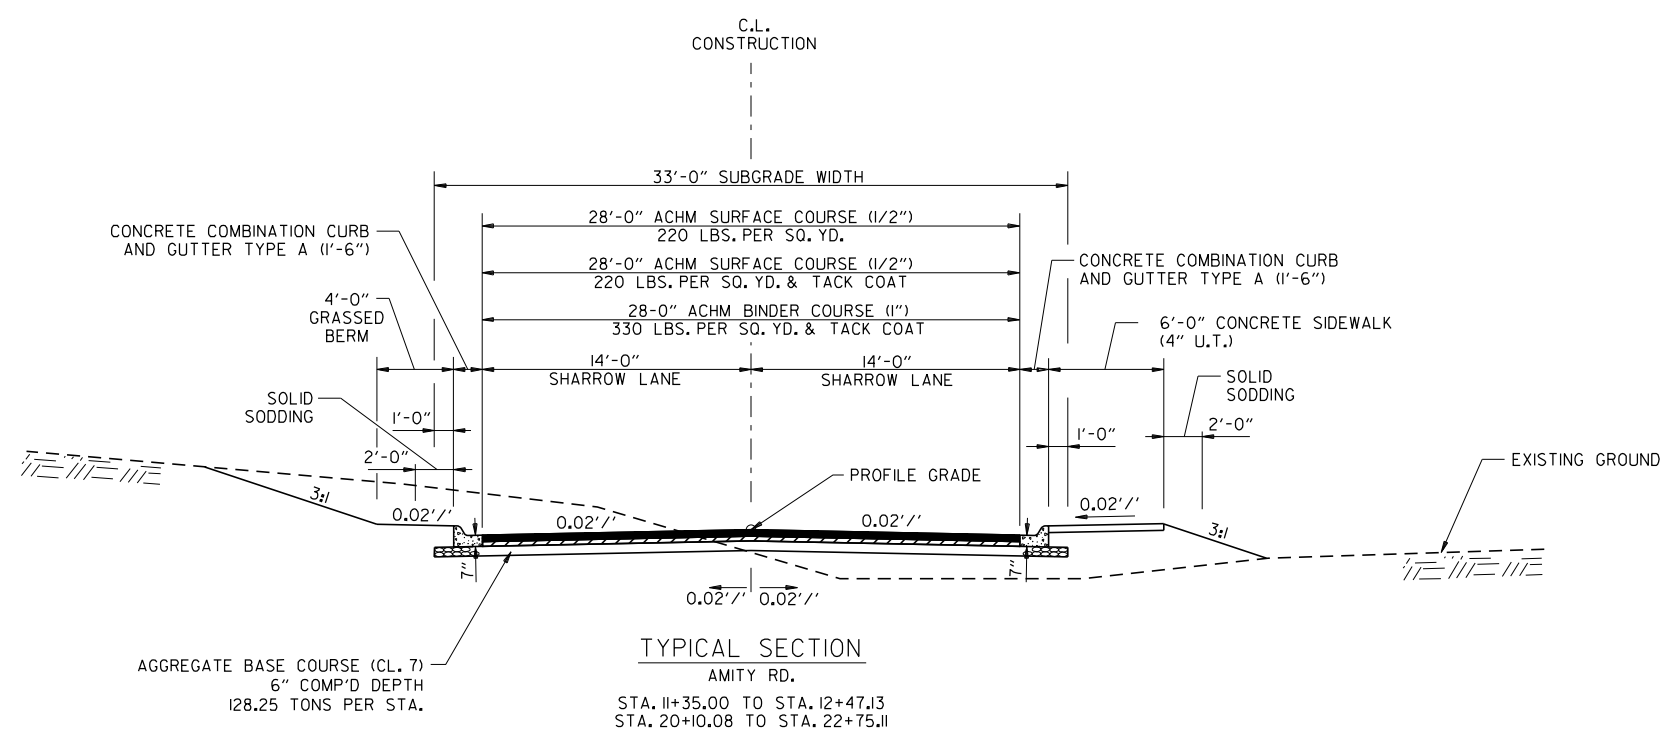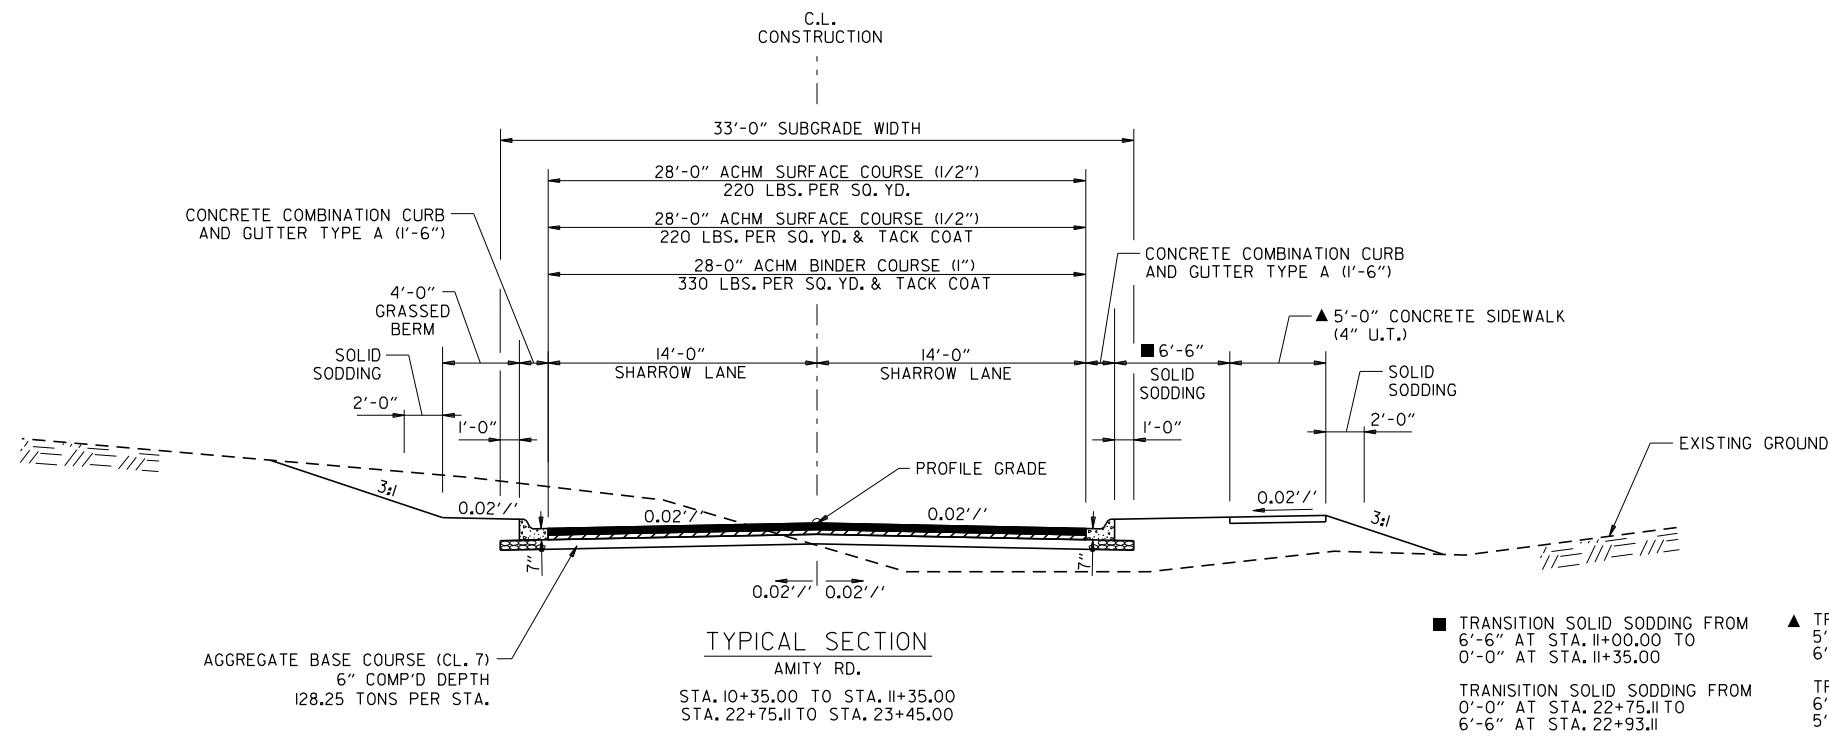

- NOTES:
- REFER TO CROSS SECTIONS FOR DEVIATIONS FROM NORMAL SLOPES. NO CHANGES SHALL BE MADE FROM THE PLANNED SLOPES WITHOUT THE APPROVAL OF THE ENGINEER.
  - THE THICKNESS OF AGGREGATE BASE COURSE SHALL BE WITHIN PLUS OR MINUS ONE INCH OF THE PLAN THICKNESS SHOWN. THE CONTRACTOR WILL CORRECT ANY DEFICIENT THICKNESS THAT DOES NOT MEET THE TOLERANCE INDICATED. PAYMENT WILL NOT BE MADE FOR MATERIAL PLACED IN EXCESS OF THE TOLERANCE INDICATED.
  - THE FINAL 2" OF SURFACE COURSE IS TO BE PLACED AFTER ALL OTHER COURSES HAVE BEEN LAID. LONGITUDINAL JOINTS SHALL BE AT LANE LINES.

TYPICAL SECTIONS OF IMPROVEMENT


5/20/2015 7:12:28 AM  
 WORKSPACE: AHTD  
 L:\2012\12015590 - ContrRailField Access\Drawings\6TH\_ST\6TH\_TYP\_ALL.dgn  
 REVISED DATE:

DATE REVISED	DATE FILMED	DATE REVISED	DATE FILMED	FED. RD. DIST. NO.	STATE	FED. AID PROJ. NO.	SHEET NO.	TOTAL SHEETS
				6	ARK.			
				JOB NO.	080517	10	182	

2 TYPICAL SECTIONS OF IMPROVEMENT




Digitally Signed 05/20/2015

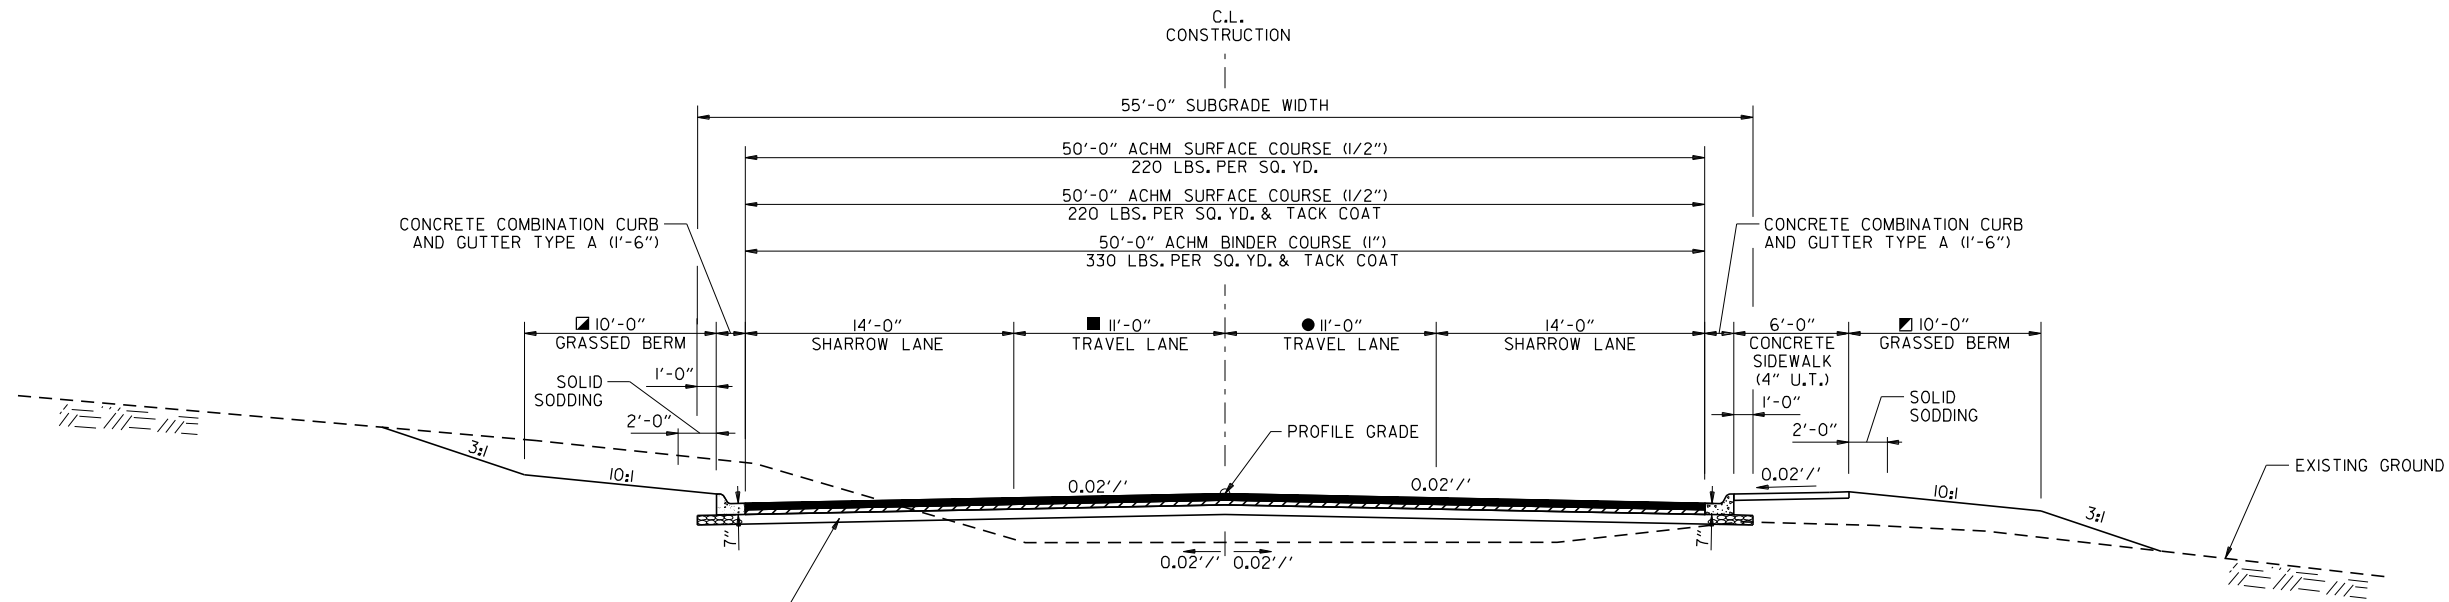

TYPICAL SECTION  
AMITY RD.  
STA. 12+47.13 TO STA. 15+00.31

- TRANSITION TRAVEL LANE FROM 0'-0" AT STA. 12+47.13 TO 11'-0" AT STA. 14+12.13
- TRANSITION TRAVEL LANE FROM 0'-0" AT STA. 12+75.06 TO 11'-0" AT STA. 13+75.06
- TRANSITION GRASSED BERM FROM 4'-0" AT STA. 14+50.00 TO 10'-0" AT STA. 15+00.00
- TRANSITION GRASSED BERM FROM 0'-0" AT STA. 14+51.36 TO 10'-0" AT STA. 14+88.16

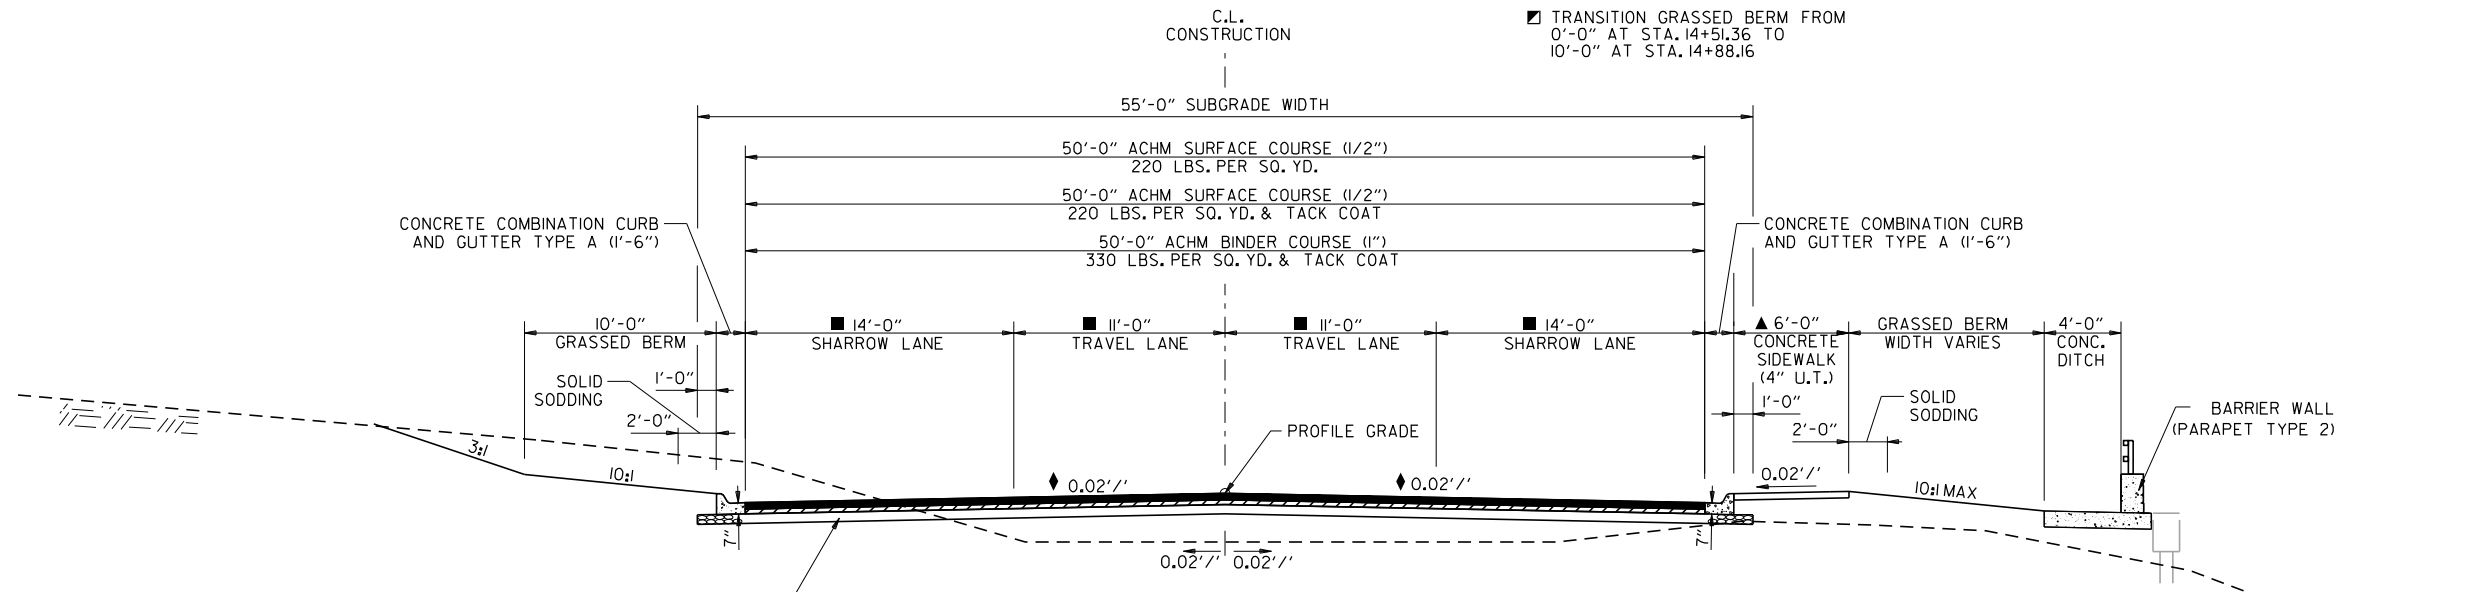

TYPICAL SECTION  
AMITY RD.  
STA. 15+00.31 TO STA. 16+00.00

- ◆ CROSS SLOPES VARY AS SECTION APPROACHES ROUNDABOUT TO MATCH CIRCULATORY ROADWAY VERTICAL PROFILE
- TRAVEL LANE WIDTHS VARY AS SECTION APPROACHES ROUNDABOUT (SEE SPECIAL DETAILS)
- ▲ TRANSITION SIDEWALK FROM 6'-0" AT STA. 15+19.87 TO 10'-0" AT STA. 15+54.87


NOTE:  
MECHANICALLY STABILIZED EMBANKMENT WALL WILL FOLLOW ALIGNMENT LOCATED ON MSE WALL SHEETS.

- NOTES:
1. REFER TO CROSS SECTIONS FOR DEVIATIONS FROM NORMAL SLOPES. NO CHANGES SHALL BE MADE FROM THE PLANNED SLOPES WITHOUT THE APPROVAL OF THE ENGINEER.
  2. THE THICKNESS OF AGGREGATE BASE COURSE SHALL BE WITHIN PLUS OR MINUS ONE INCH OF THE PLAN THICKNESS SHOWN. THE CONTRACTOR WILL CORRECT ANY DEFICIENT THICKNESS THAT DOES NOT MEET THE TOLERANCE INDICATED. PAYMENT WILL NOT BE MADE FOR MATERIAL PLACED IN EXCESS OF THE TOLERANCE INDICATED.
  3. THE FINAL 2" OF SURFACE COURSE IS TO BE PLACED AFTER ALL OTHER COURSES HAVE BEEN LAID. LONGITUDINAL JOINTS SHALL BE AT LANE LINES.

5/20/2015 7:12:28 AM  
 WORKSPACE: AHTD  
 L:\2012\1201590 - Conrail\field Access\Drawings\6TH\_ST\6TH\_TYP\_ALL.dgn  
 REVISED DATE:

DATE REVISED	DATE FILMED	DATE REVISED	DATE FILMED	FED. RD. DIST. NO.	STATE	FED. AID PROJ. NO.	SHEET NO.	TOTAL SHEETS
				6	ARK.			
				JOB NO.	080517	II	182	


2 TYPICAL SECTIONS OF IMPROVEMENT

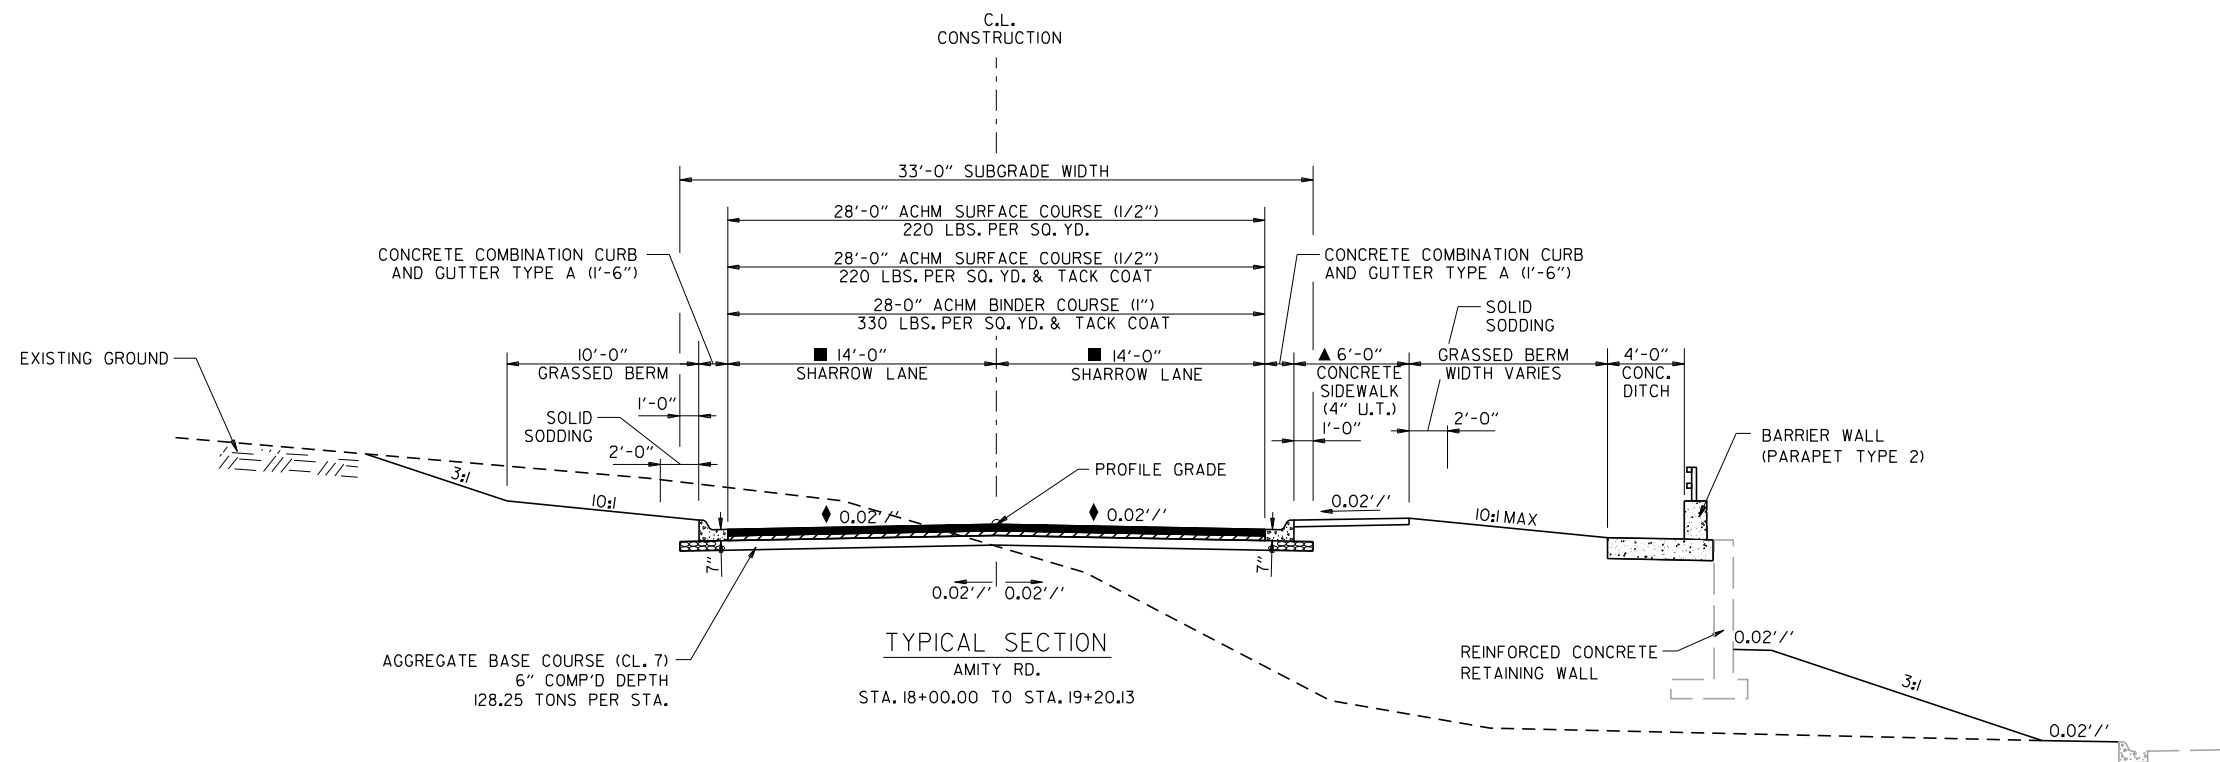

- ▲ TRANSITION SIDEWALK FROM 10'-0" AT STA. 18+44.23 TO 6'-0" AT STA. 18+79.23
- ◆ CROSS SLOPES VARY AS SECTION APPROACHES ROUNDABOUT TO MATCH CIRCULATORY ROADWAY VERTICAL PROFILE
- TRAVEL LANE WIDTHS VARY AS SECTION APPROACHES ROUNDABOUT (SEE SPECIAL DETAILS)

NOTE:  
REINFORCED CONCRETE RETAINING WALL WILL FOLLOW ALIGNMENT LOCATED ON RETAINING WALL SHEETS.

NOTE:  
SIDEWALK BUILT INTERGRALLY WITH PARAPET (TYPE II) IS CONSIDERED SUBSIDIARY TO THE PARAPET WALL AND WILL NOT BE MEASURED FOR SEPERATE PAYMENT.

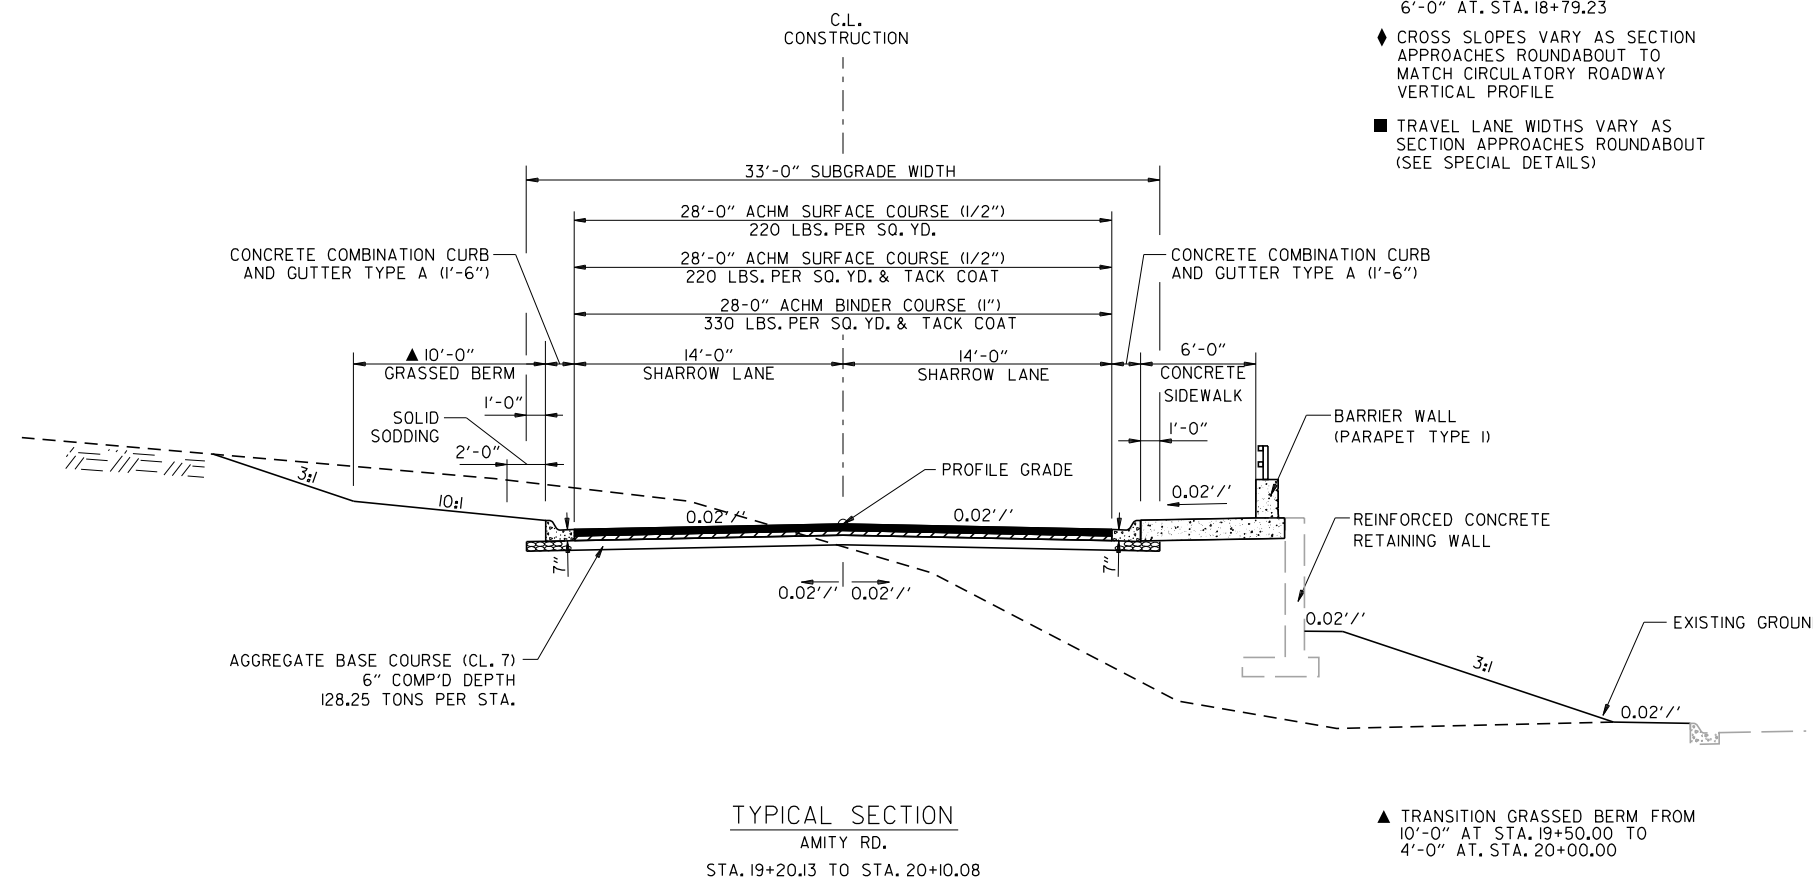

- ▲ TRANSITION GRASSED BERM FROM 10'-0" AT STA. 19+50.00 TO 4'-0" AT STA. 20+00.00

- NOTES:
1. REFER TO CROSS SECTIONS FOR DEVIATIONS FROM NORMAL SLOPES. NO CHANGES SHALL BE MADE FROM THE PLANNED SLOPES WITHOUT THE APPROVAL OF THE ENGINEER.
  2. THE THICKNESS OF AGGREGATE BASE COURSE SHALL BE WITHIN PLUS OR MINUS ONE INCH OF THE PLAN THICKNESS SHOWN. THE CONTRACTOR WILL CORRECT ANY DEFICIENT THICKNESS THAT DOES NOT MEET THE TOLERANCE INDICATED. PAYMENT WILL NOT BE MADE FOR MATERIAL PLACED IN EXCESS OF THE TOLERANCE INDICATED.
  3. THE FINAL 2" OF SURFACE COURSE IS TO BE PLACED AFTER ALL OTHER COURSES HAVE BEEN LAID. LONGITUDINAL JOINTS SHALL BE AT LANE LINES.


TYPICAL SECTIONS OF IMPROVEMENT

DATE REVISED	DATE FILMED	DATE REVISED	DATE FILMED	FED. RD. DIST. NO.	STATE	FED. AID PROJ. NO.	SHEET NO.	TOTAL SHEETS
2-10-2016				6	ARK.			
						080517	12	182

2 TYPICAL SECTIONS OF IMPROVEMENT



Digitally Signed 02/10/2016

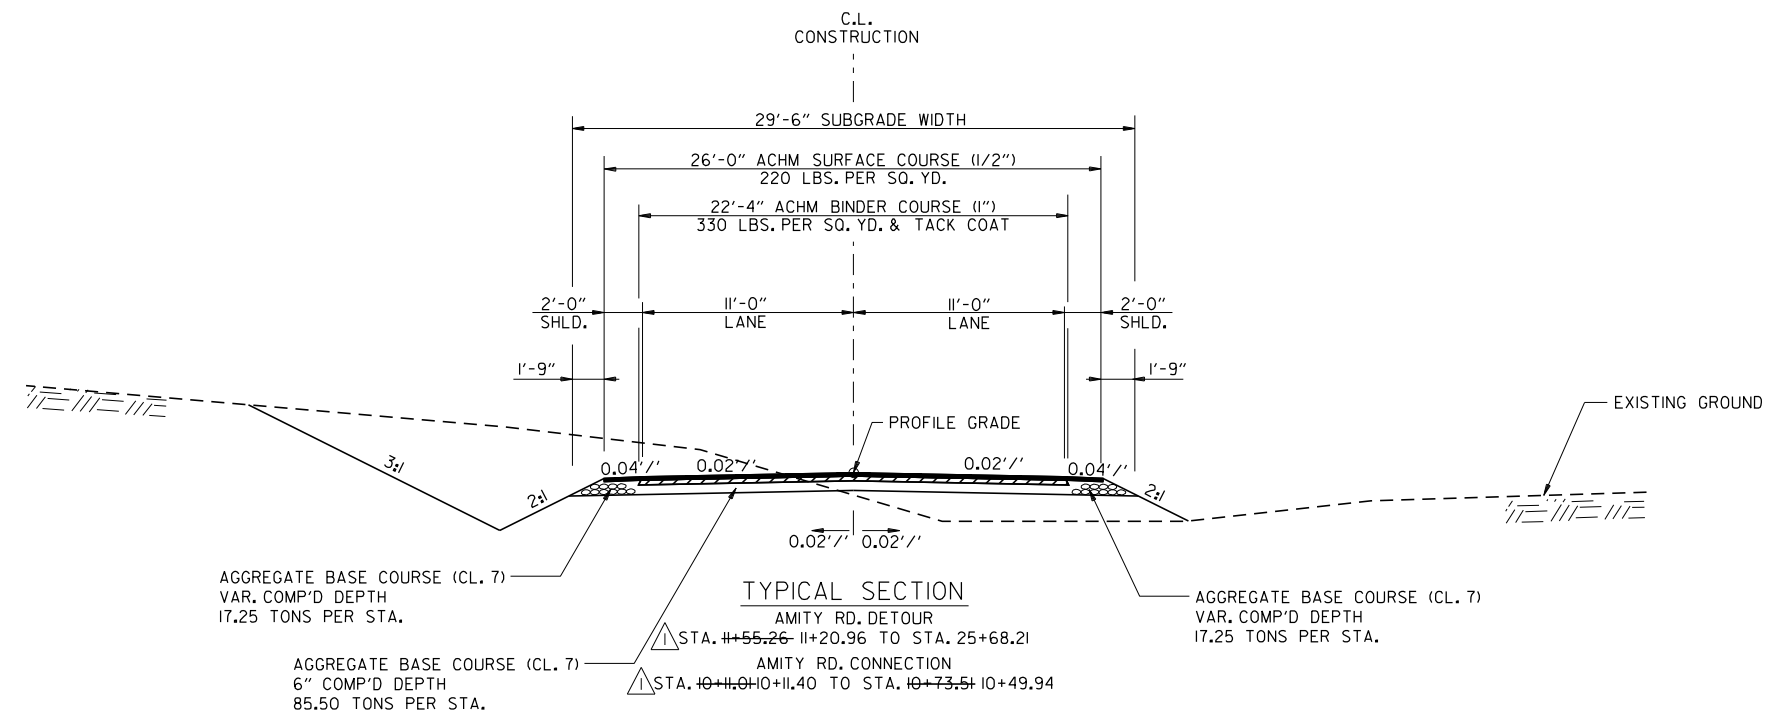

NOTES:


1. REFER TO CROSS SECTIONS FOR DEVIATIONS FROM NORMAL SLOPES. NO CHANGES SHALL BE MADE FROM THE PLANNED SLOPES WITHOUT THE APPROVAL OF THE ENGINEER.
2. THE THICKNESS OF AGGREGATE BASE COURSE SHALL BE WITHIN PLUS OR MINUS ONE INCH OF THE PLAN THICKNESS SHOWN. THE CONTRACTOR WILL CORRECT ANY DEFICIENT THICKNESS THAT DOES NOT MEET THE TOLERANCE INDICATED. PAYMENT WILL NOT BE MADE FOR MATERIAL PLACED IN EXCESS OF THE TOLERANCE INDICATED.
3. THE FINAL 2" OF SURFACE COURSE IS TO BE PLACED AFTER ALL OTHER COURSES HAVE BEEN LAID. LONGITUDINAL JOINTS SHALL BE AT LANE LINES.

DATE REVISED	DATE FILMED	DATE REVISED	DATE FILMED	FED. RD. DIST. NO.	STATE	FED. AID PROJ. NO.	SHEET NO.	TOTAL SHEETS
2-10-2016				6	ARK.			
				JOB NO.	080517	13	182	


2 TYPICAL SECTIONS OF IMPROVEMENT




Digitally Signed 02/10/2016

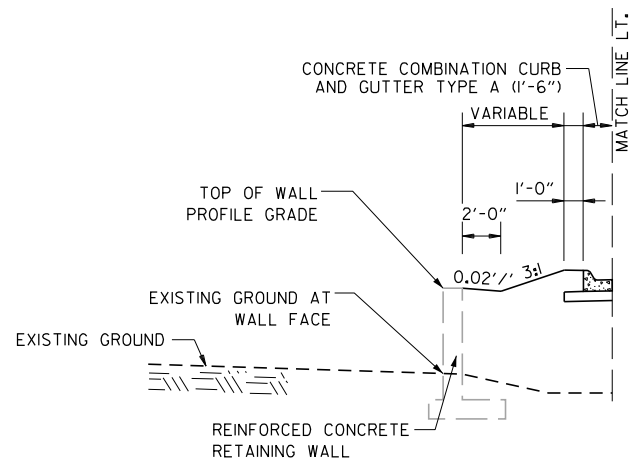

TYPICAL SECTION  
REINFORCED CONCRETE RETAINING WALL NO. 5  
STA. 11+61.61 TO STA. 11+78.00

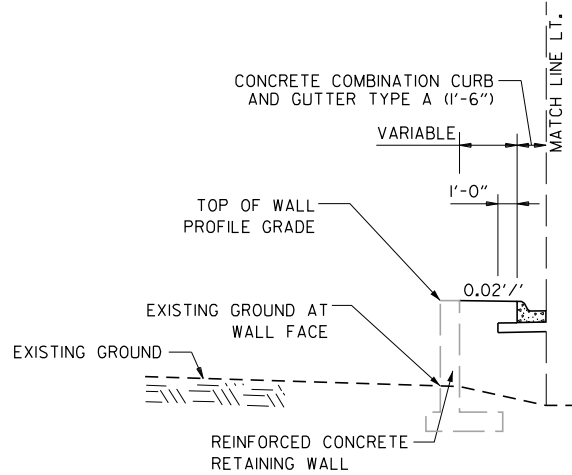


TYPICAL SECTION  
REINFORCED CONCRETE RETAINING WALL NO. 5  
STA. 11+78.00 TO STA. 11+90.66

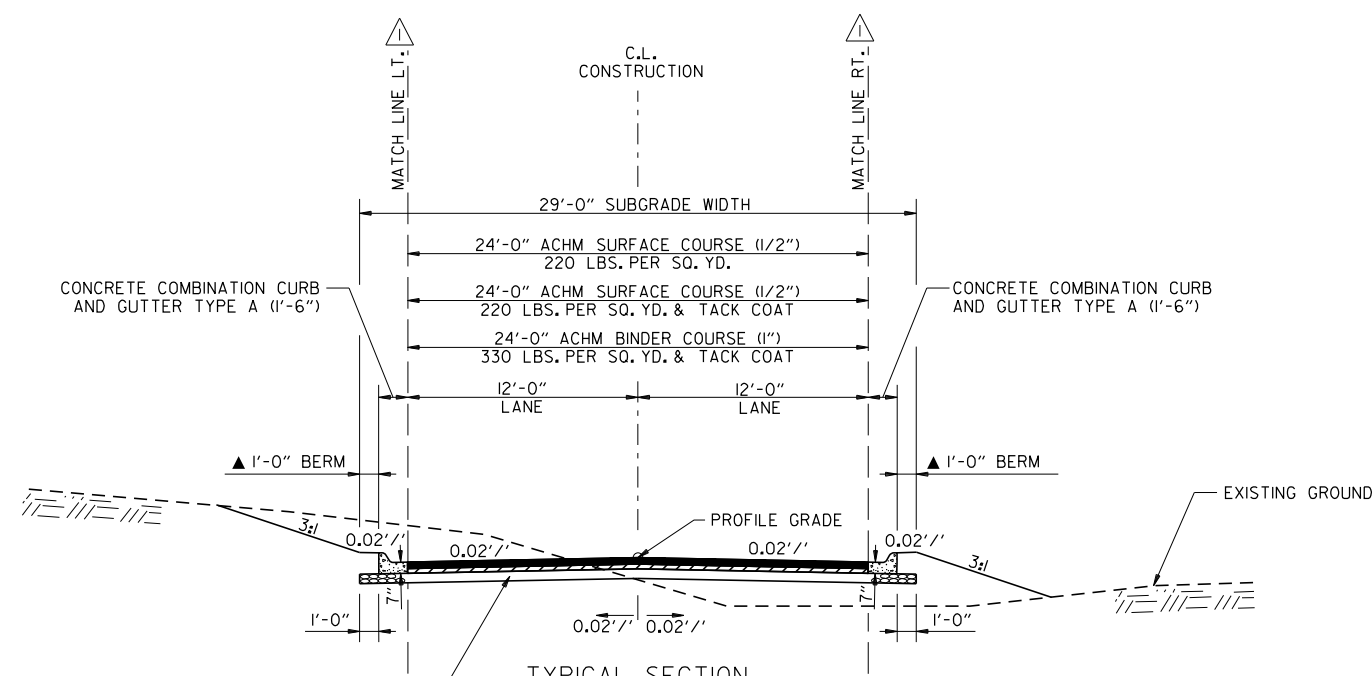


TYPICAL SECTION  
DRIVEWAY 1  
STA. 10+25.96 TO STA. 14+13.75

▲ TRANSITION BERM FROM 1'-0" AT STA. 13+25.00 TO 4'-0" AT STA. 13+35.00  
NOTE: DRIVEWAY 1 STA. 12+30.00 TO STA. 14+13.75 TO BE CONSTRUCTED AT END OF TEMPORARY DRIVEWAY AS SHOWN IN PLANS

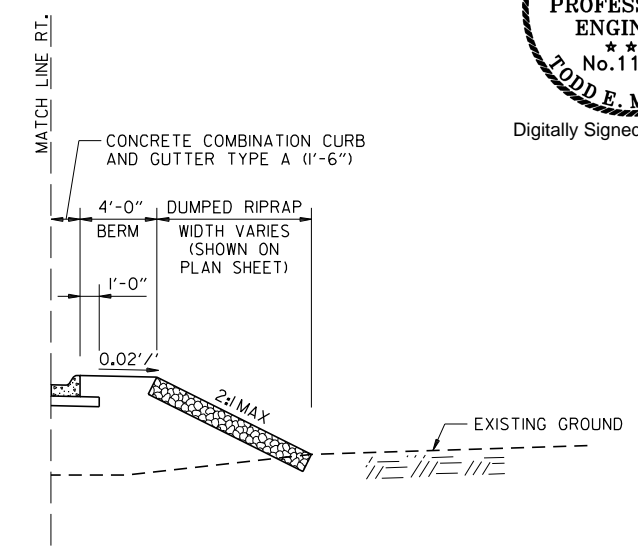

TYPICAL SECTION  
STA. 11+40.00 TO STA. 12+25.00

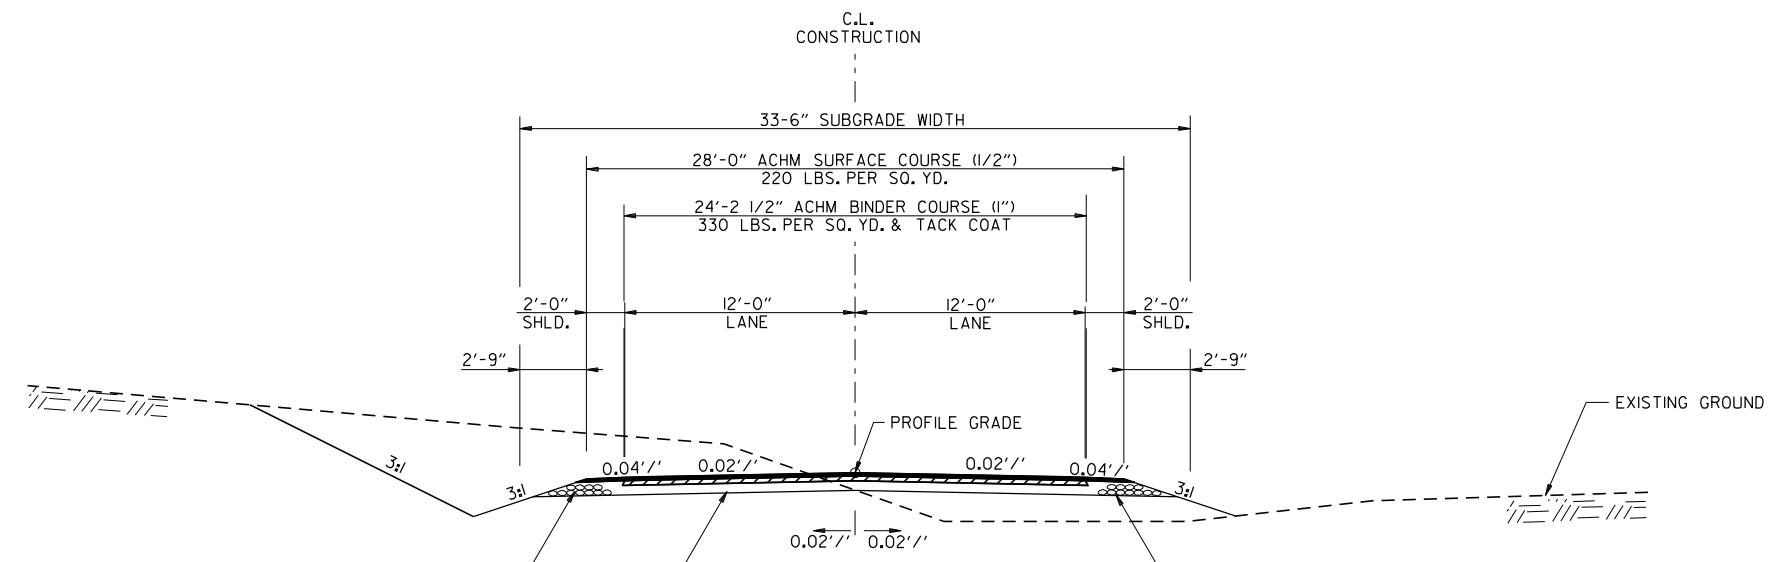

TYPICAL SECTION  
TEMPORARY DRIVEWAY  
STA. 8+82.42 TO STA. 12+31.36


- NOTES:
- REFER TO CROSS SECTIONS FOR DEVIATIONS FROM NORMAL SLOPES. NO CHANGES SHALL BE MADE FROM THE PLANNED SLOPES WITHOUT THE APPROVAL OF THE ENGINEER.
  - THE THICKNESS OF AGGREGATE BASE COURSE SHALL BE WITHIN PLUS OR MINUS ONE INCH OF THE PLAN THICKNESS SHOWN. THE CONTRACTOR WILL CORRECT ANY DEFICIENT THICKNESS THAT DOES NOT MEET THE TOLERANCE INDICATED. PAYMENT WILL NOT BE MADE FOR MATERIAL PLACED IN EXCESS OF THE TOLERANCE INDICATED.
  - THE FINAL 2" OF SURFACE COURSE IS TO BE PLACED AFTER ALL OTHER COURSES HAVE BEEN LAID. LONGITUDINAL JOINTS SHALL BE AT LANE LINES.

2/10/2016 4:33:37 PM  
 WORKSPACE: AHTD  
 L:\2012\12017590 - Contr-ell\field Access\Drawings\6TH STA\6TH.TYP.ALL.dgn  
 REVISED DATE:



	RADIUS	STATION	OFFSET
R1	35'	42+02.38	70.12' LT.
R2	100'	41+85.45	132.88' LT.
R3	278'	40+85.22	300.00' LT.
R4	300'	41+00.72	278.00' LT.
R5	300'	41+40.53	320.68' RT.
R6	120'	41+67.49	142.71' RT.
R7	120'	15+41.46	152.53' LT.
R8	300'	14+89.95	325.00' LT.
R9	300'	15+06.97	325.00' RT.
R10	120'	15+36.75	147.48' RT.
R11	120'	44+85.95	151.97' RT.
R12	300'	46+06.63	316.50' LT.
R13	140'	45+44.24	163.58' LT.
R14	140'	18+75.49	163.71' RT.
R15	300'	20+47.02	314.00' RT.
R16	64'	18+44.26	78.00' LT.

\*R1-R6 AND R11-R13 ARE BASED OFF OF SIXTH ST./ELSINGER BLVD. ALIGNMENT  
 \*R7-R10 AND R14-R16 ARE BASED OFF OF AMITY RD. ALIGNMENT

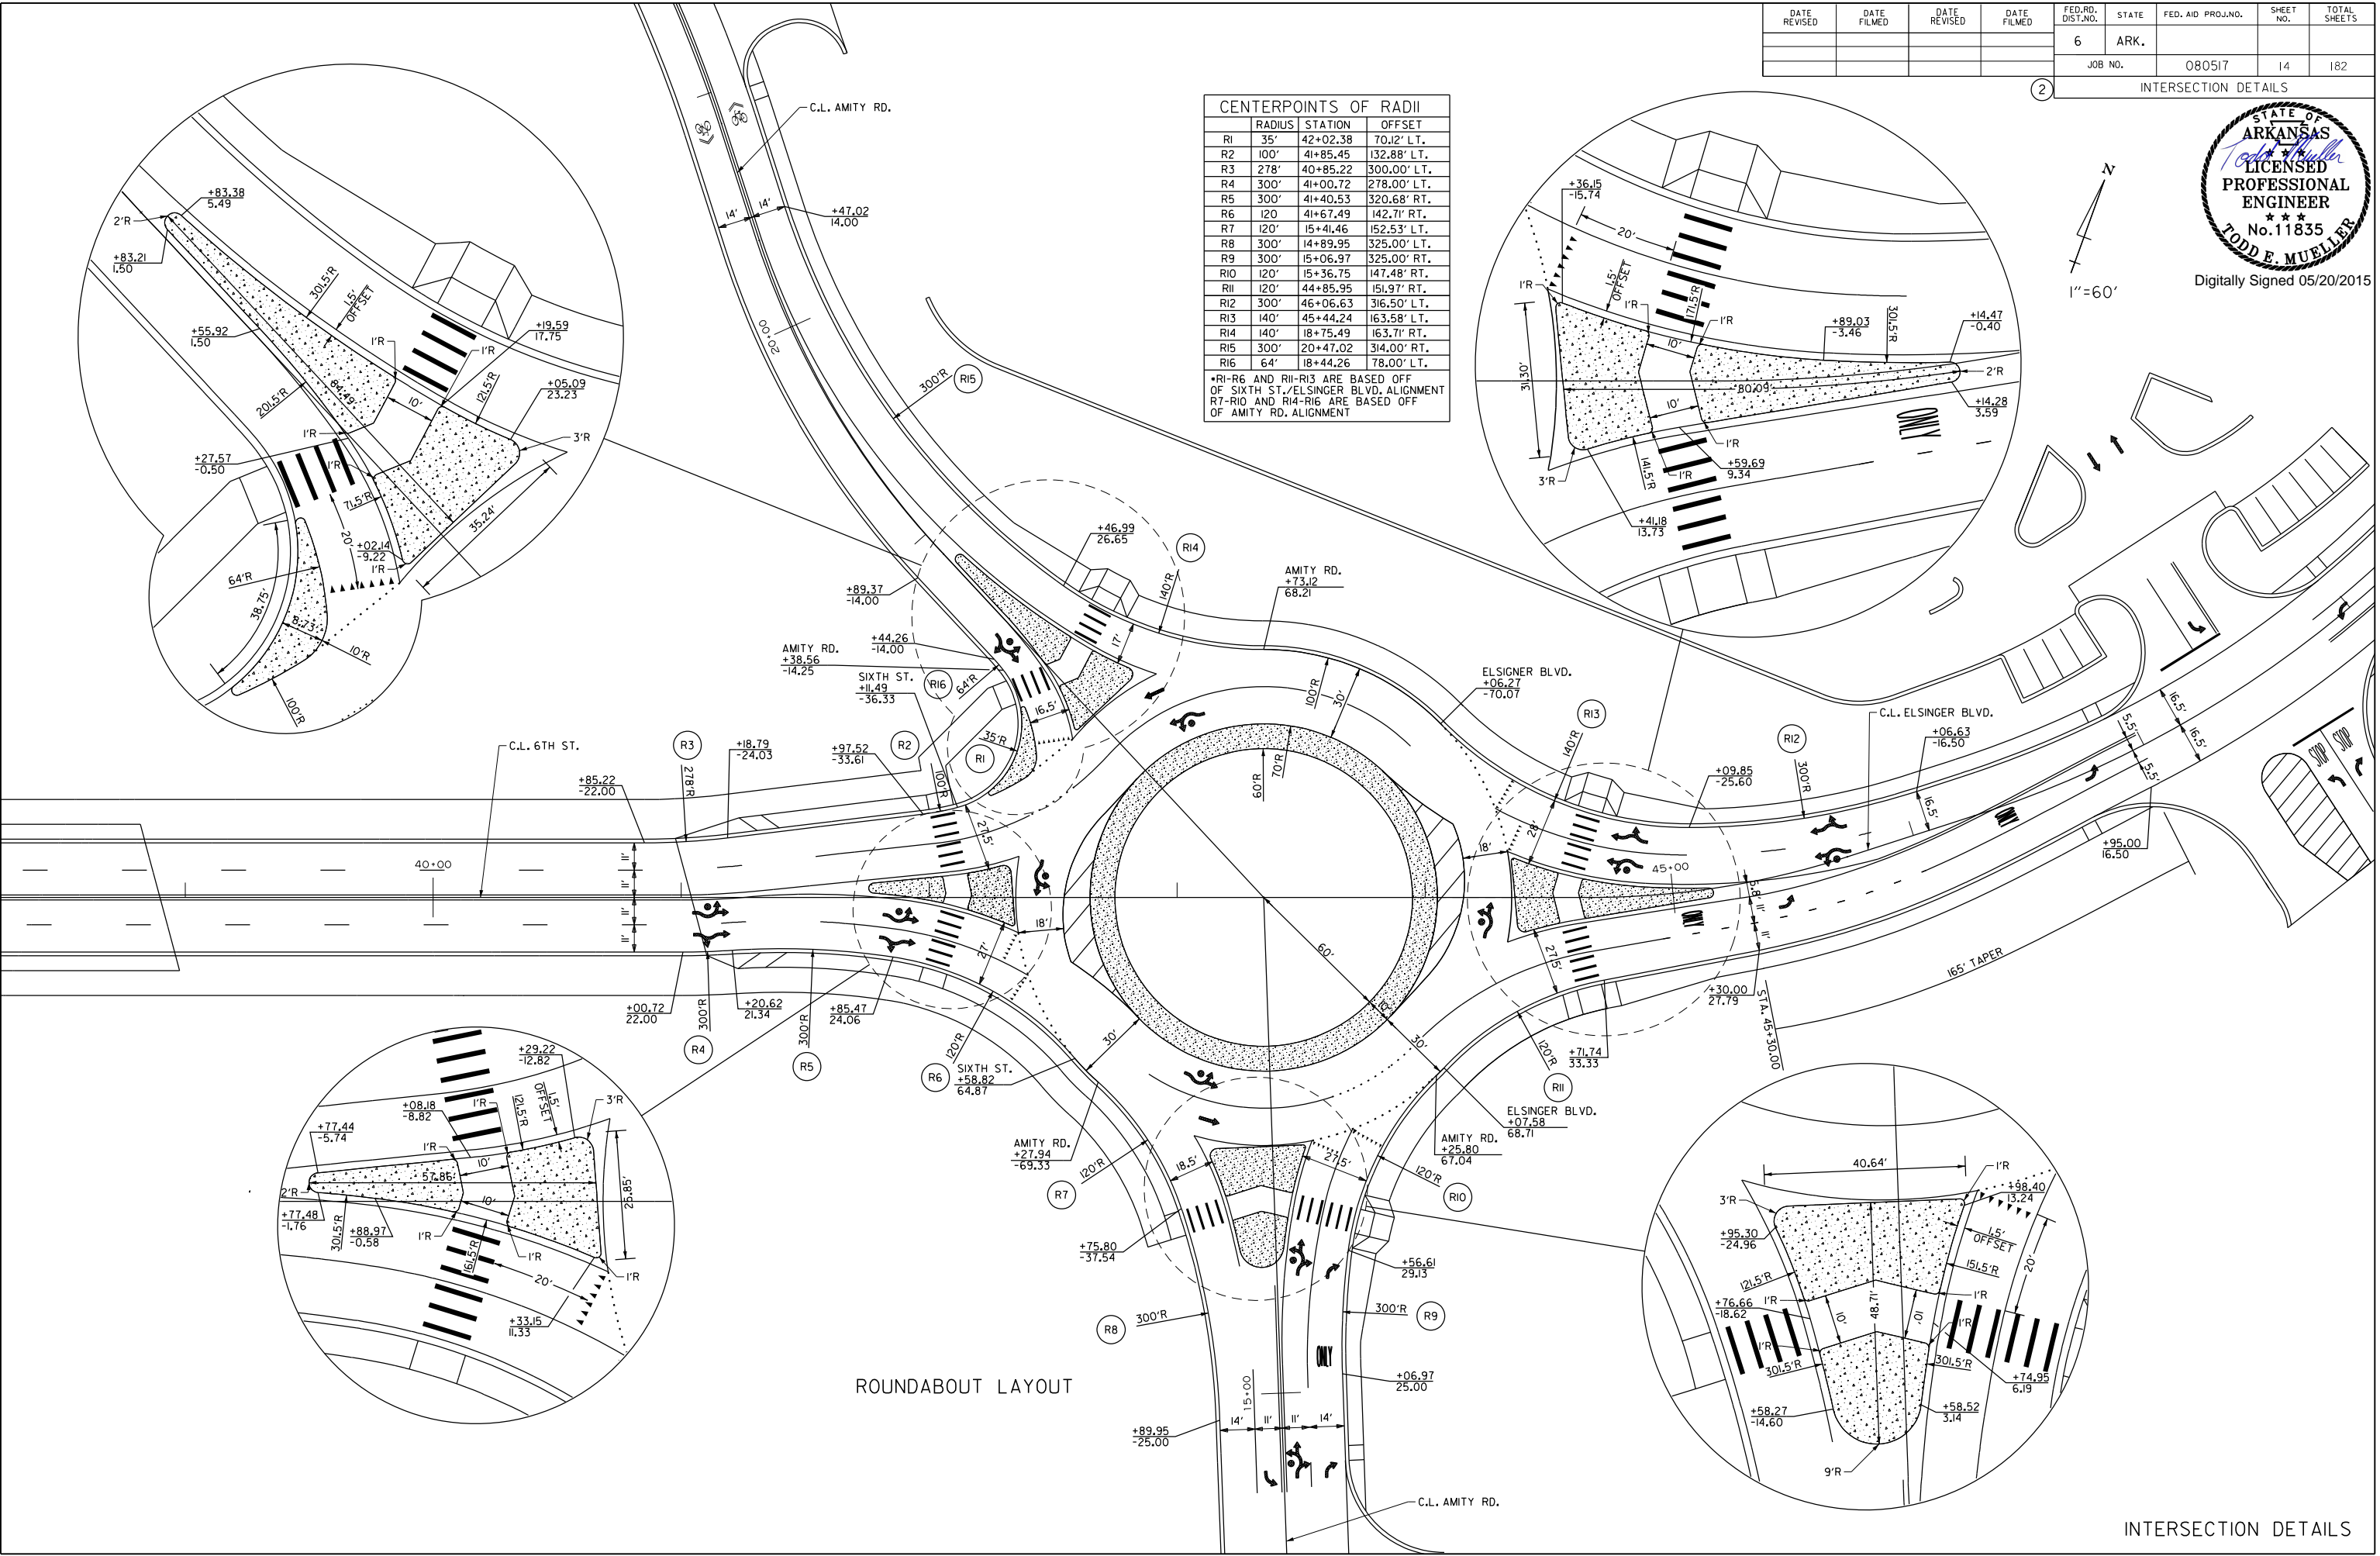



ROUNDABOUT LAYOUT

INTERSECTION DETAILS

5/20/2015 7:12:30 AM  
 WORKSPACE: AHTD  
 L:\2012\201550 - Contrail\field Access\Drawings\6TH\_ST\_6TH\_ST\_SD\_ROBT\_02.dgn  
 REVISED DATE:

DATE REVISED	DATE FILMED	DATE REVISED	DATE FILMED	FED. RD. DIST. NO.	STATE	FED. AID PROJ. NO.	SHEET NO.	TOTAL SHEETS
				6	ARK.			
				JOB NO.		080517	15	182

RADIUS	STATION	OFFSET
R1 50'	31+95.71	54.00' LT.
R2 0.5'	32+22.40	6.50' RT.
R3 0.5'	32+14.08	6.50' LT.
R4 40'	32+23.49	34.50' LT.
R5 2'	32+56.40	5.00' LT.

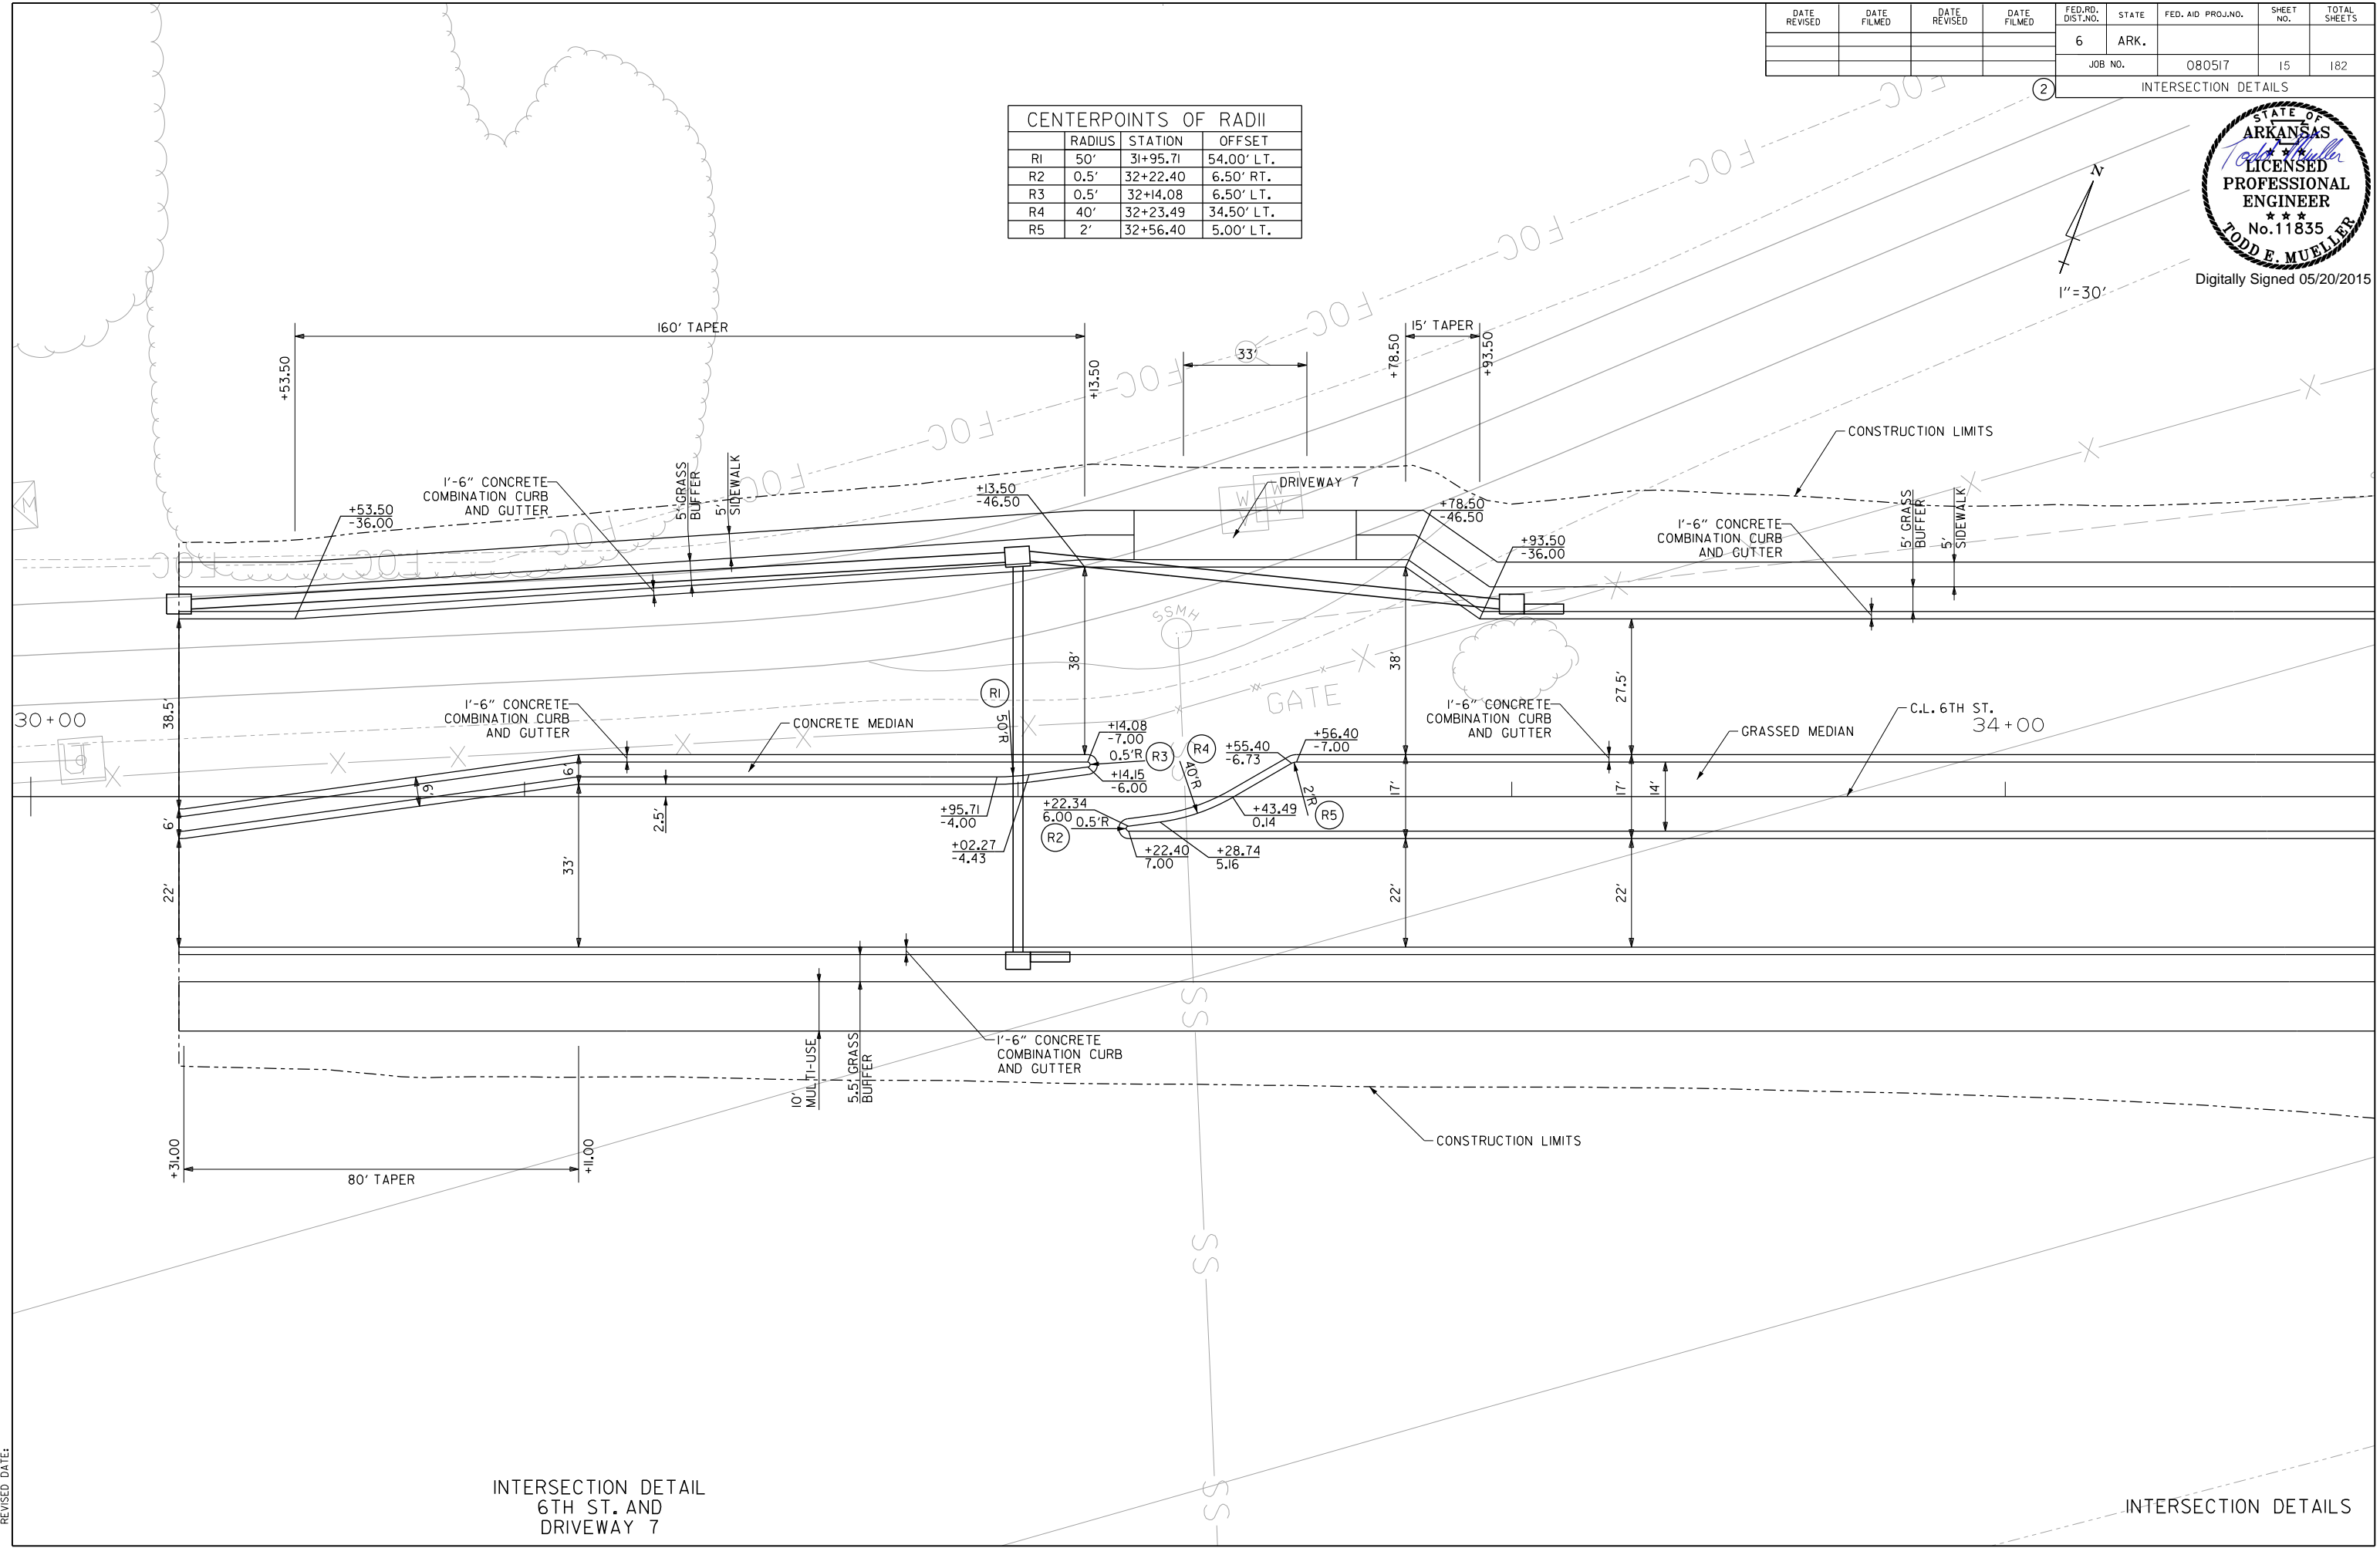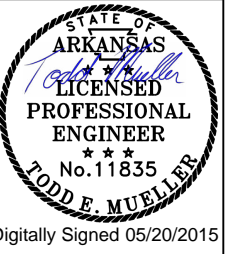


INTERSECTION DETAIL  
6TH ST. AND  
DRIVEWAY 7

INTERSECTION DETAILS


5/20/2015 7:12:36 AM  
 WORKSPACE: AHTD  
 L:\2012\201590 - Contra-Field Access\Drawings\6TH\_ST\_6TH\_ID\_01.dgn  
 REVISED DATE:

DATE REVISED	DATE FILMED	DATE REVISED	DATE FILMED	FED. RD. DIST. NO.	STATE	FED. AID PROJ. NO.	SHEET NO.	TOTAL SHEETS
				6	ARK.			
				JOB NO.	080517	16	182	

2 SPECIAL DETAILS

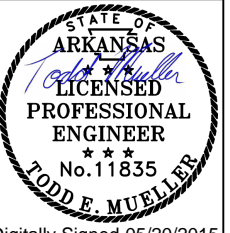

Digitally Signed 05/20/2015

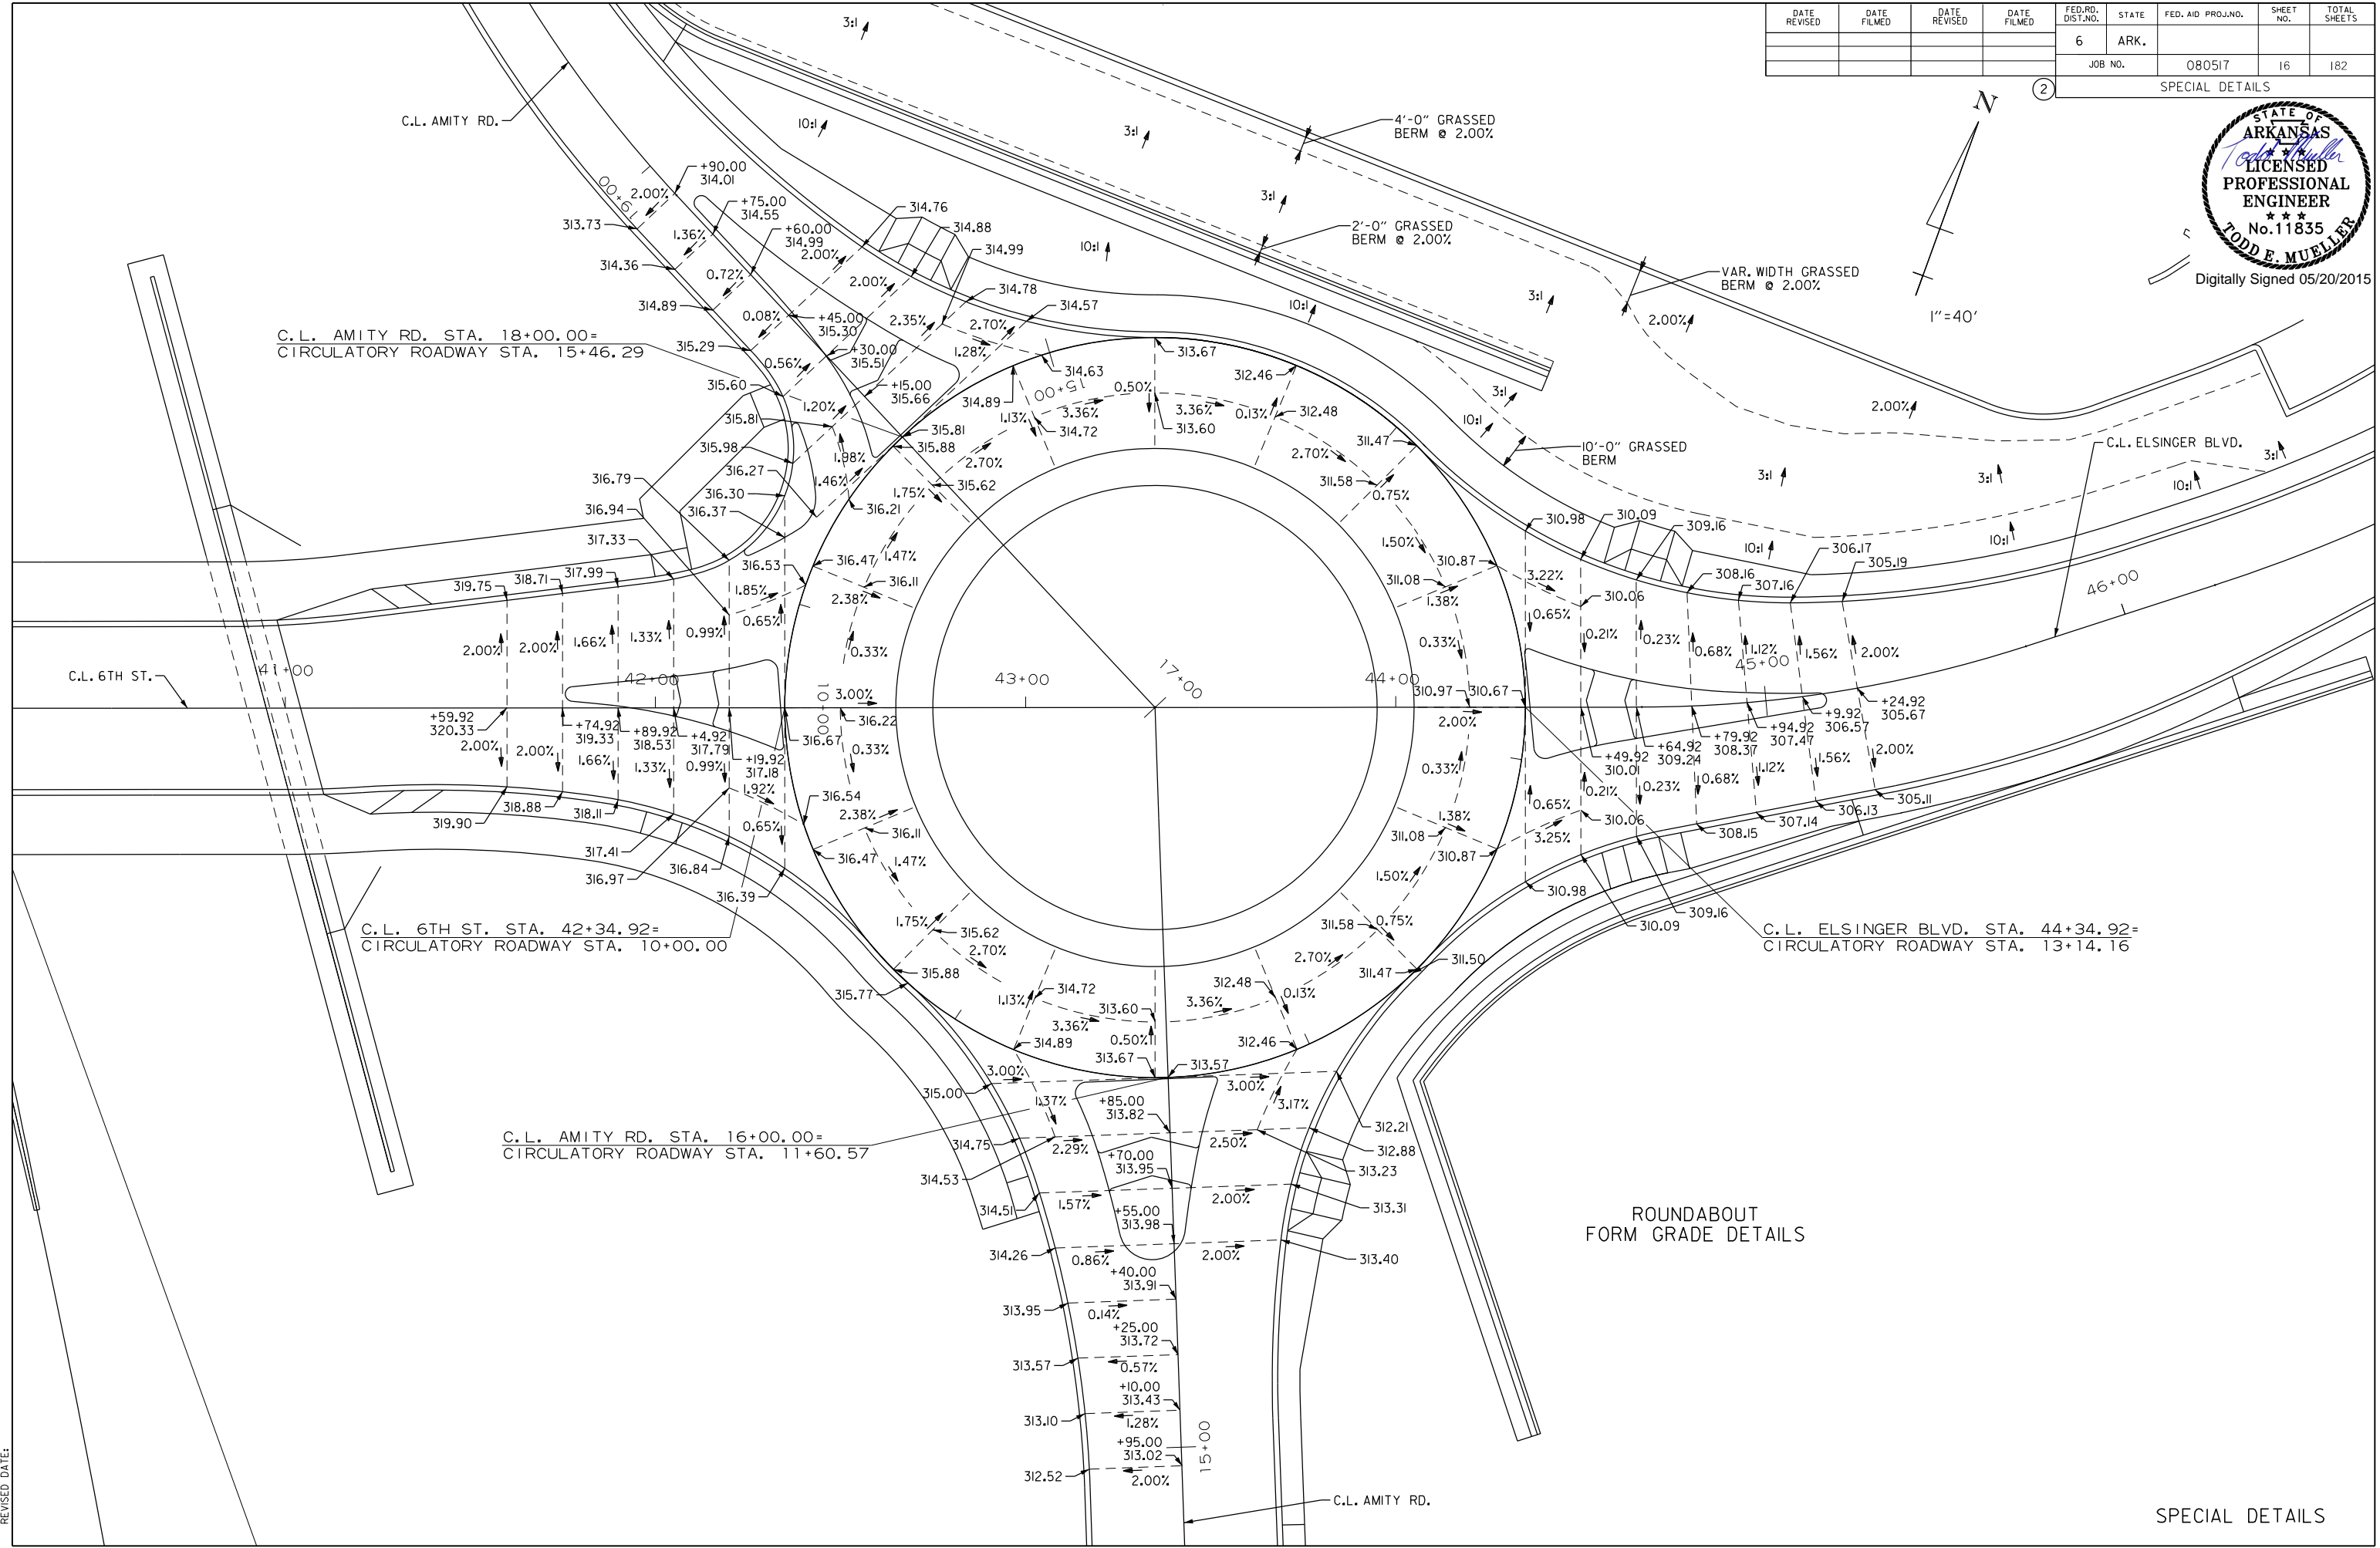

ROUNDABOUT  
FORM GRADE DETAILS


SPECIAL DETAILS

5/20/2015 7:12:41AM  
 WORKSPACE: AHTD  
 L:\2012\201590 - Contrail\field Access\Drawings\6TH\_ST\6TH\_ROBT\_GRADES\_01.dgn  
 REVISED DATE:



DATE REVISED	DATE FILMED	DATE REVISED	DATE FILMED	FED. RD. DIST. NO.	STATE	FED. AID PROJ. NO.	SHEET NO.	TOTAL SHEETS
2-10-2016				6	ARK.			
				JOB NO.		080517	17	182


2 SPECIAL DETAILS

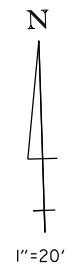

	RADIUS	STATION	OFFSET
R1	50'	19+80.83	104.78' RT.
R2	40'	46+08.10	96.30' LT.

•R1 IS BASED OFF OF AMITY RD. ALIGNMENT  
 •R2 IS BASED OFF OF 6TH ST./ ELSINGER BLVD. ALIGNMENT

NOTE: DRAINAGE STRUCTURES ARE SHOWN ON THE APPROPRIATE PROFILE.

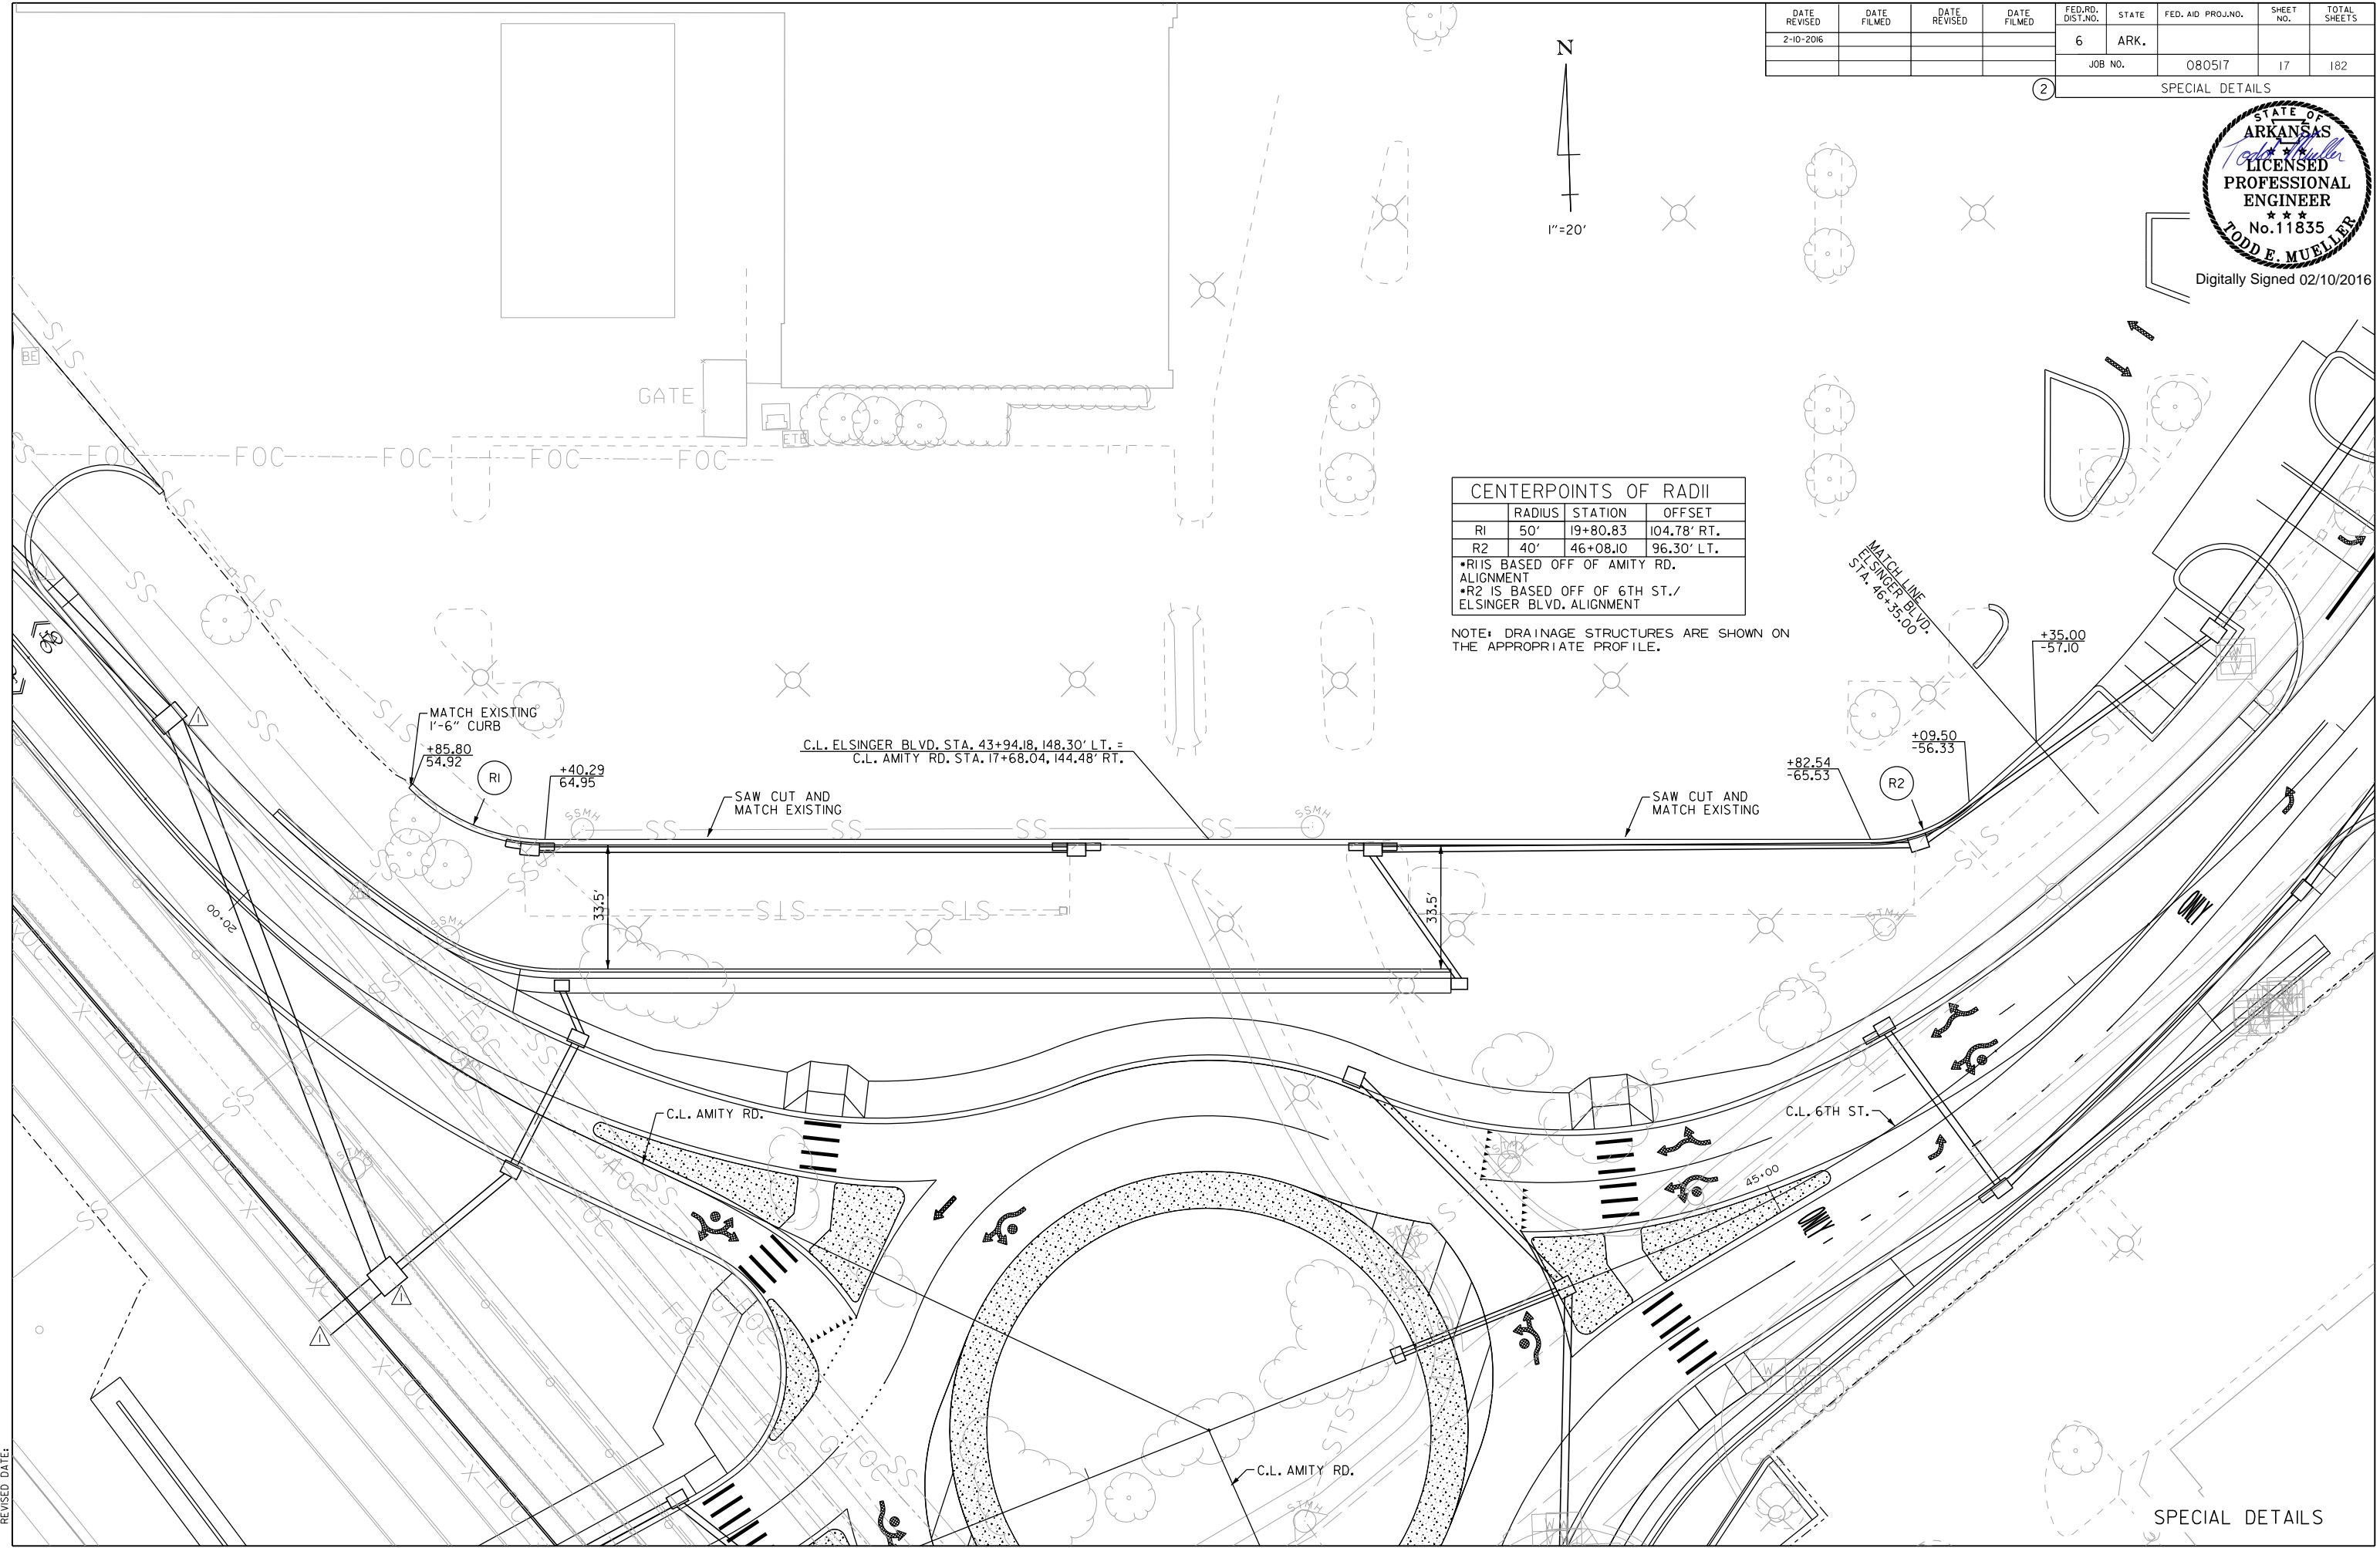

rccorbyn 2/10/2016 8:34:27 AM  
 WORKSPACE: AHTD  
 L:\2012\1201590 - ConrailField Access\Drawings\6TH\_ST\6TH\_SD\_PARK\_02.dgn  
 REVISED DATE:



SPECIAL DETAILS

DATE REVISED	DATE FILMED	DATE REVISED	DATE FILMED	FED. RD. DIST. NO.	STATE	FED. AID PROJ. NO.	SHEET NO.	TOTAL SHEETS
				6	ARK.			
				JOB NO.	080517	18	182	

2 SPECIAL DETAILS

RADIUS	STATION	OFFSET
R1	30'	46+89.85 46.50' LT.
R2	15'	47+06.52 48.01' LT.
R3	4'	47+04.28 -58.88' LT.
R4	250'	46+37.39 267.13' LT.
R5	30'	47+97.16 46.50' LT.
R6	15'	47+80.49 48.01' LT.
R7	4'	47+85.23 58.68' LT.
R8	260'	48+67.33 297.63' LT.
R9	80'	48+25.80 163.04' LT.
R10	15'	47+98.04 101.04' LT.
R11	15'	47+15.55 106.70' LT.
R12	7'	46+99.83 97.71' LT.
R13	5'	46+49.48 89.44' LT.
R14	30'	46+35.52 112.61' LT.
R15	2'	46+43.86 55.46' LT.

\*R1-R15 ARE BASED OFF OF 6TH ST./ELSINGER BLVD. ALIGNMENT

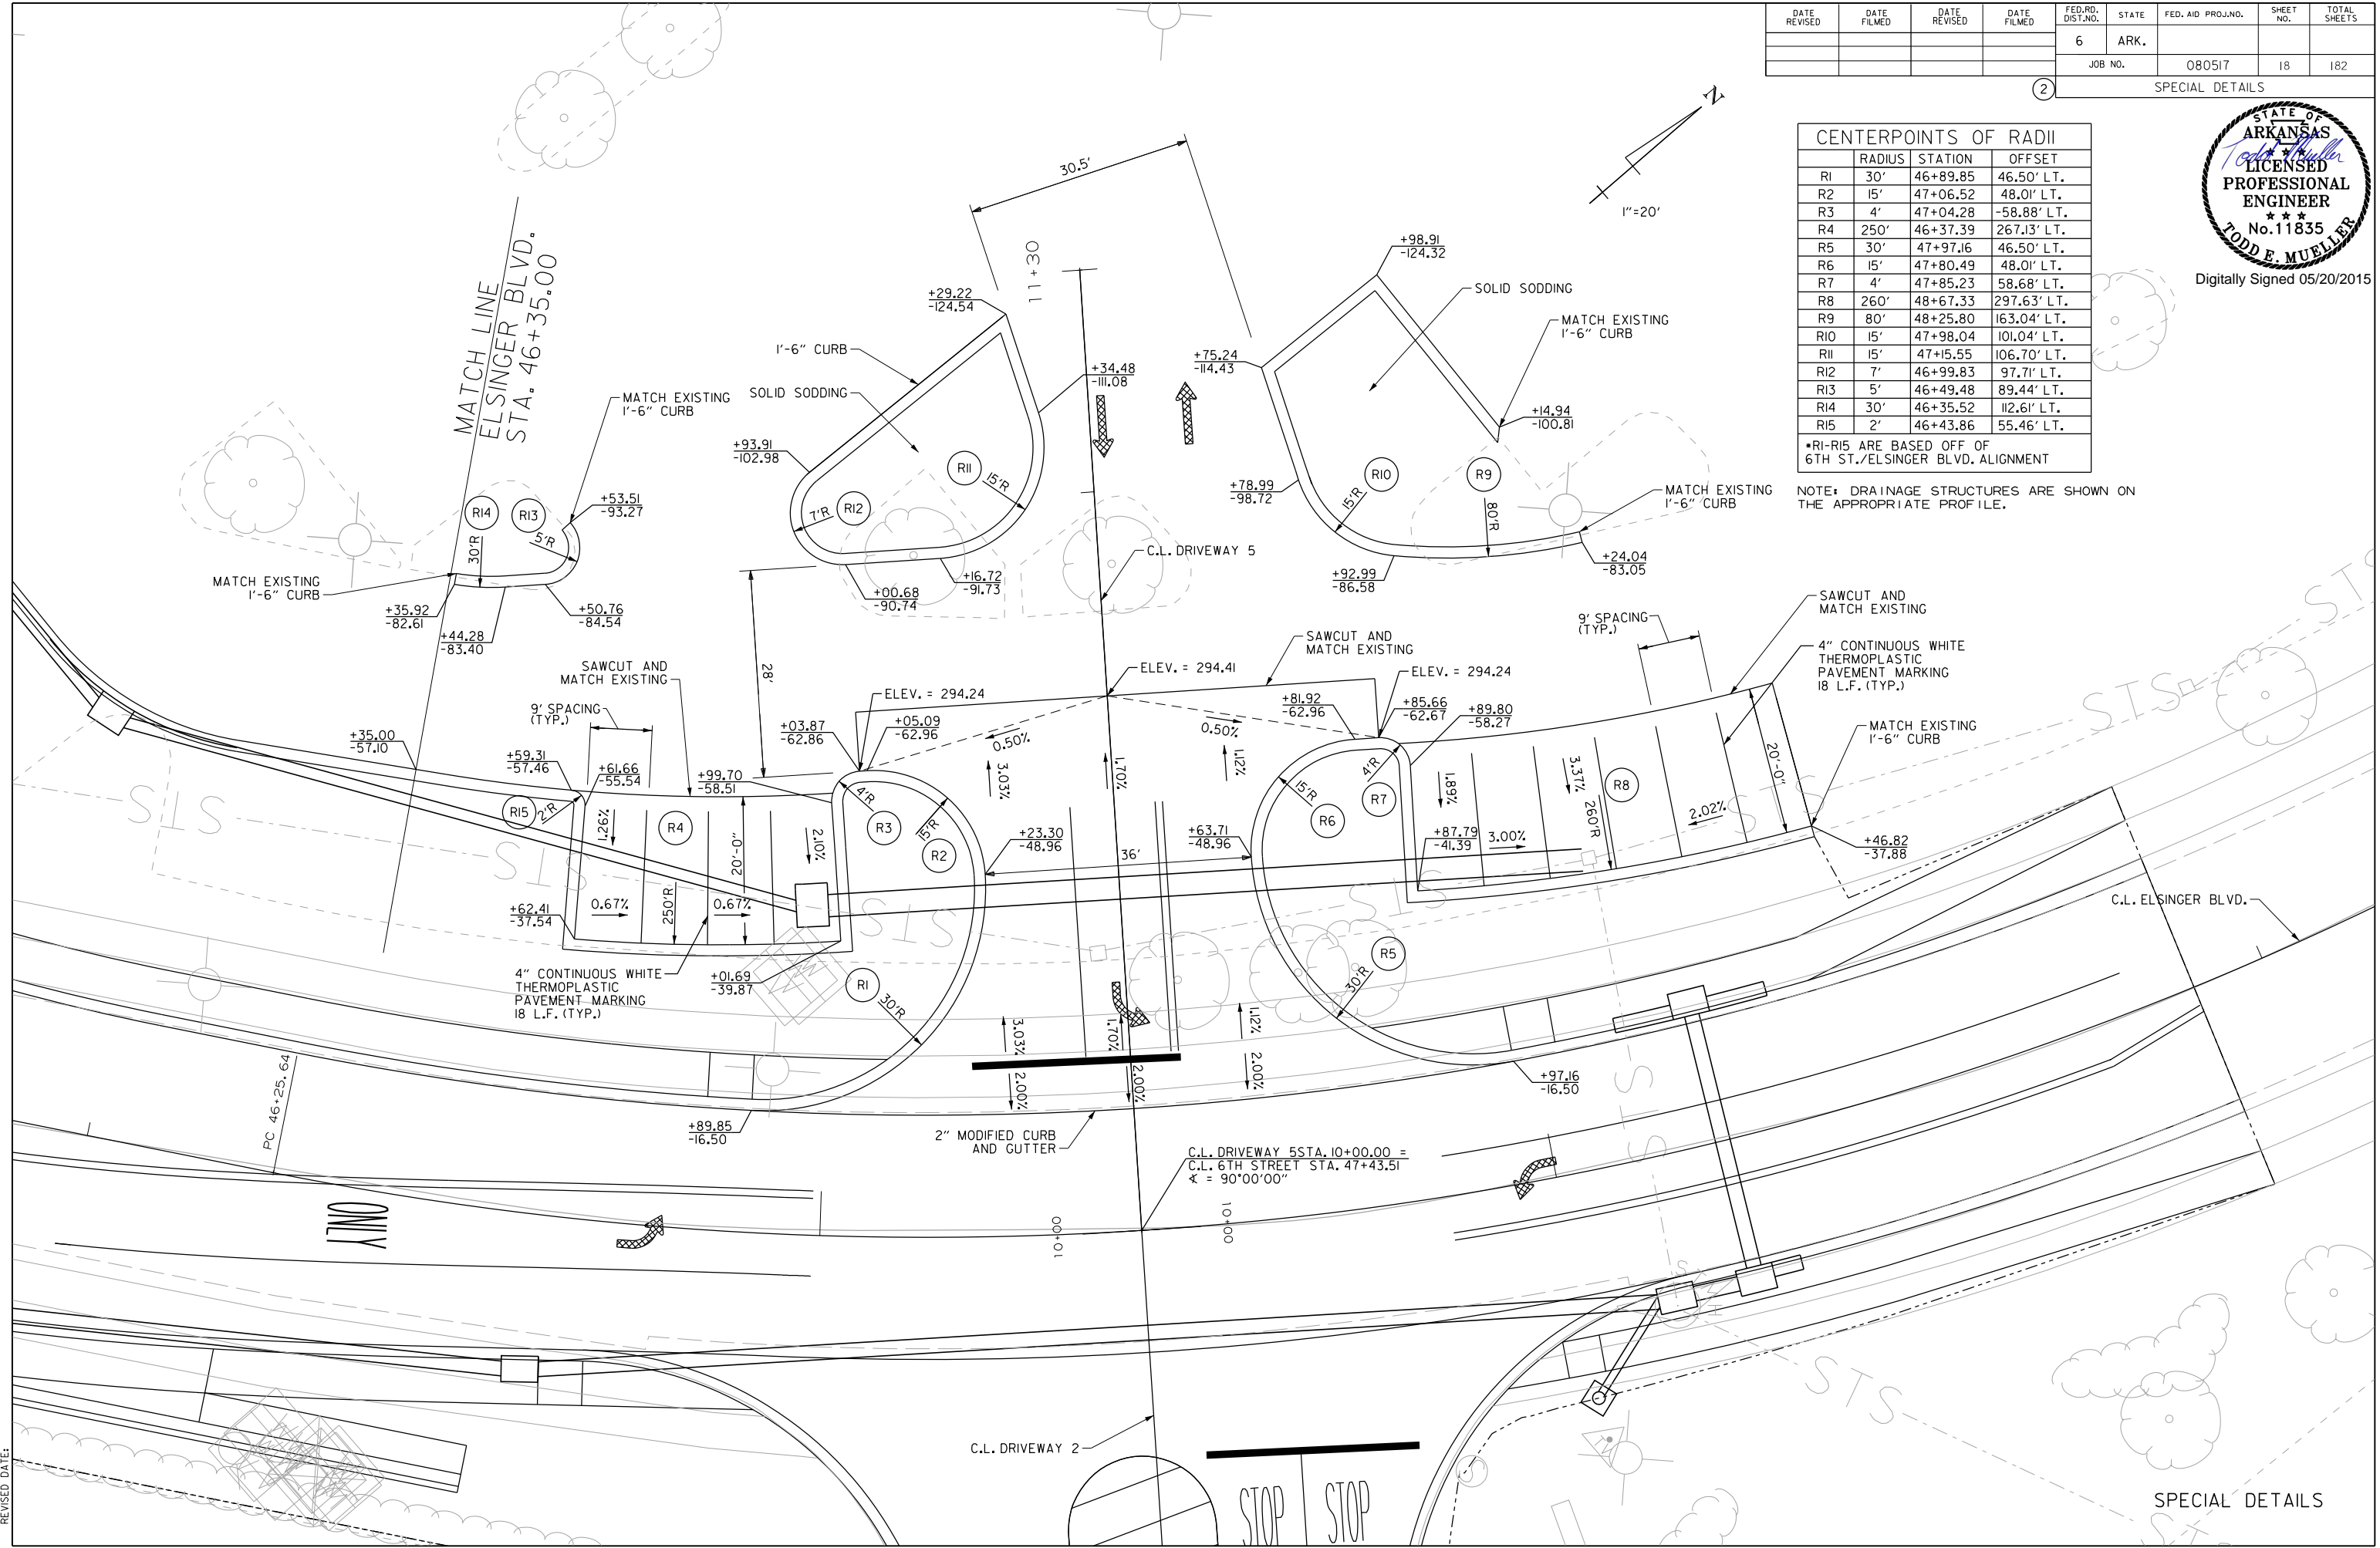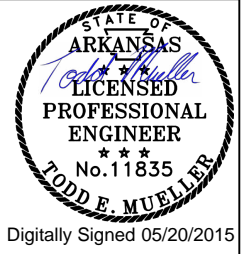

NOTE: DRAINAGE STRUCTURES ARE SHOWN ON THE APPROPRIATE PROFILE.

5/20/2015 7:12:47 AM  
 WORKSPACE: AHTD  
 L:\2012\12015590 - Contrail\field Access\Drawings\6TH\_ST\6TH\_ST.D.PARK\_01.dgn  
 REVISED DATE:


SPECIAL DETAILS

DATE REVISED	DATE FILMED	DATE REVISED	DATE FILMED	FED. RD. DIST. NO.	STATE	FED. AID PROJ. NO.	SHEET NO.	TOTAL SHEETS
2-10-2016				6	ARK.			
				JOB NO.	080517	19	182	


2 SPECIAL DETAILS



Digitally Signed 02/10/2016

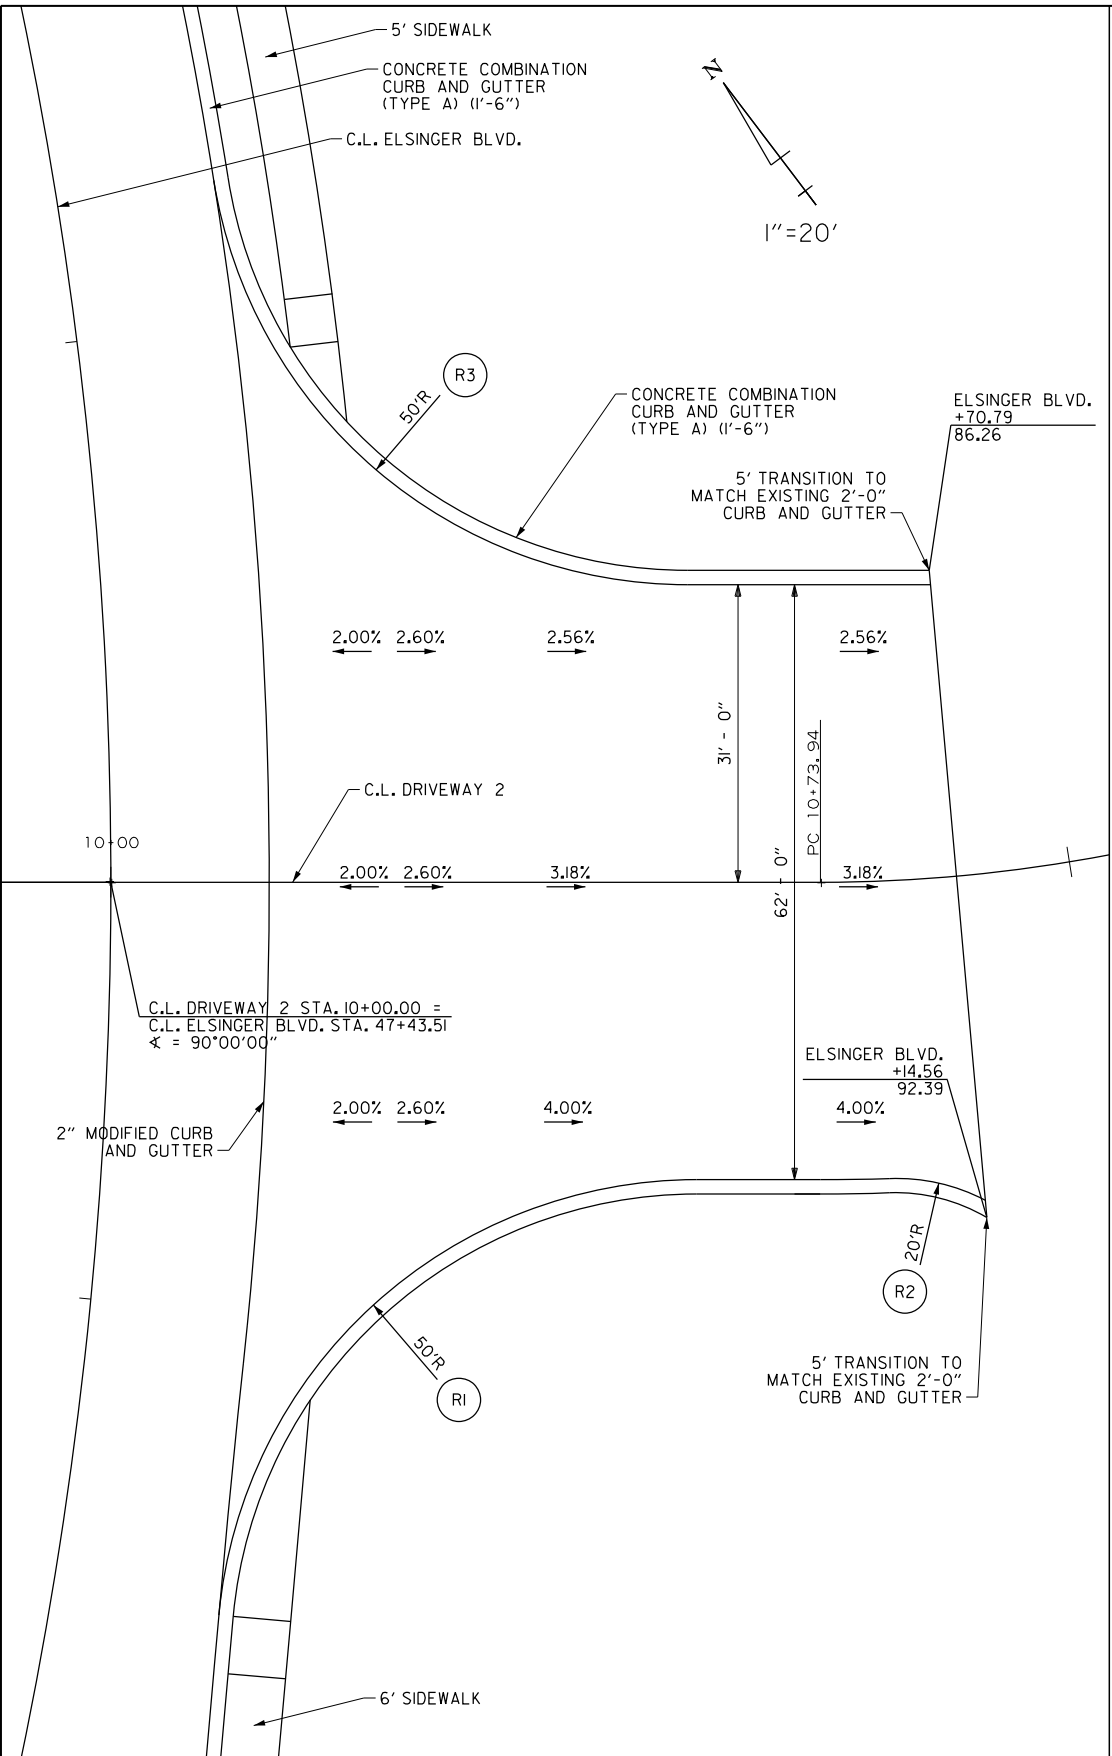


DRIVEWAY 2  
ELSINGER BLVD. STA. 47+44

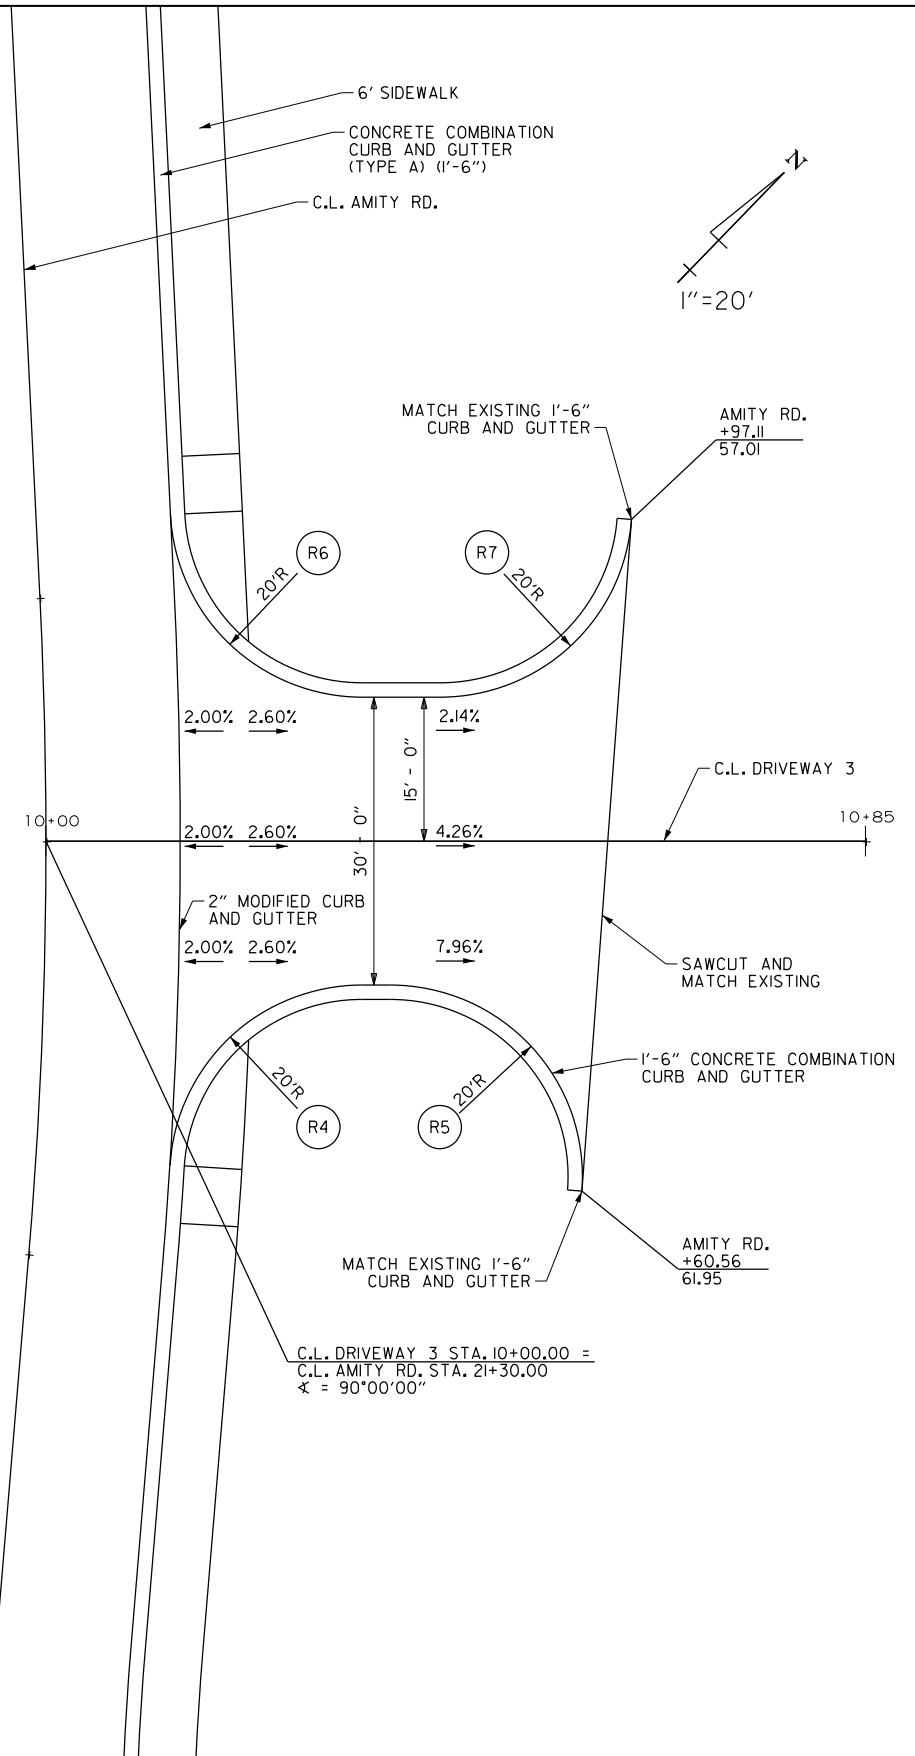

DRIVEWAY 3  
AMITY RD. STA. 21+30

DRIVEWAY SPECIAL DETAILS

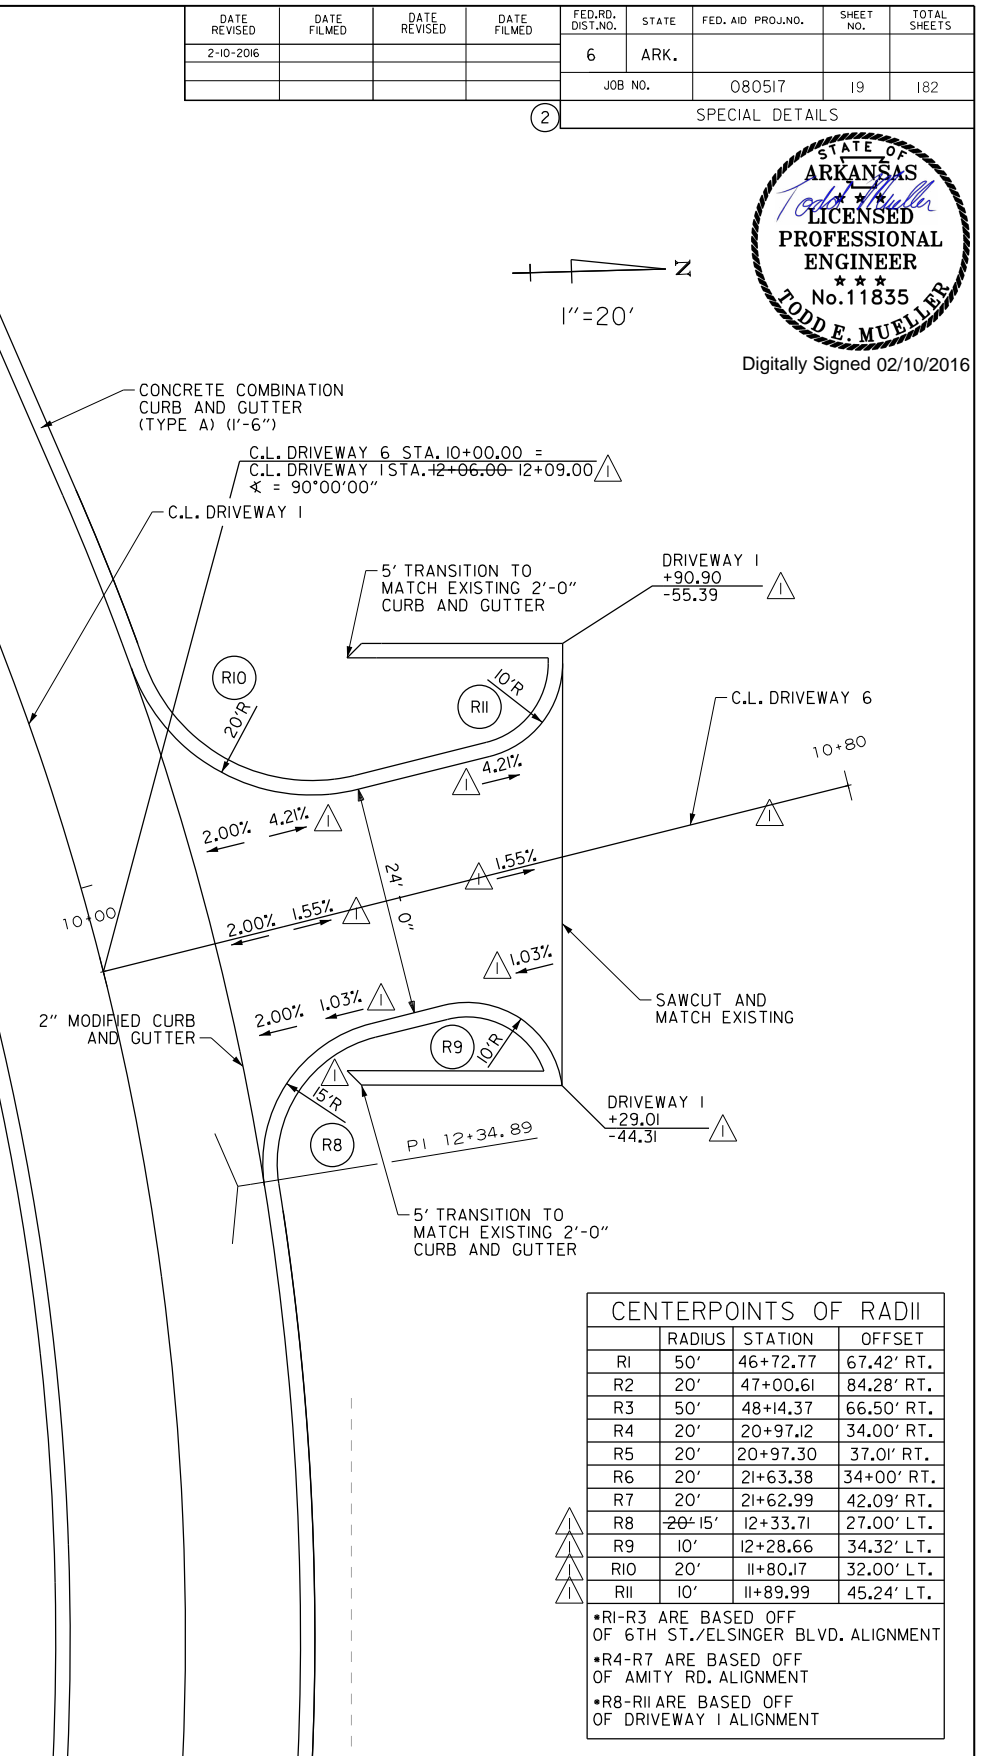

DRIVEWAY 6  
DRIVEWAY 1. STA. 12+06

SPECIAL DETAILS

CENTERPOINTS OF RADII			
RADIUS	STATION	OFFSET	
R1	50'	46+72.77	67.42' RT.
R2	20'	47+00.61	84.28' RT.
R3	50'	48+43.37	66.50' RT.
R4	20'	20+97.12	34.00' RT.
R5	20'	20+97.30	37.01' RT.
R6	20'	21+63.38	34+00' RT.
R7	20'	21+62.99	42.09' RT.
R8	20' 15'	12+33.71	27.00' LT.
R9	10'	12+28.66	34.32' LT.
R10	20'	11+80.17	32.00' LT.
R11	10'	11+89.99	45.24' LT.

- R1-R3 ARE BASED OFF OF 6TH ST./ELSINGER BLVD. ALIGNMENT
- R4-R7 ARE BASED OFF OF AMITY RD. ALIGNMENT
- R8-R11 ARE BASED OFF OF DRIVEWAY 1 ALIGNMENT



2/10/2016 4:33:44 PM  
 WORKSPACE: AHTD  
 L:\2012\1201550 - Contrail\field Access\Drawings\6TH ST\6TH ST.DLL.dgn  
 REVISED DATE:

DATE REVISED	DATE FILMED	DATE REVISED	DATE FILMED	FED. RD. DIST. NO.	STATE	FED. AID PROJ. NO.	SHEET NO.	TOTAL SHEETS
2-10-2016				6	ARK.			
9-27-2016						080517	20	182



2 SPECIAL DETAILS




Digitally Signed 09/29/2016

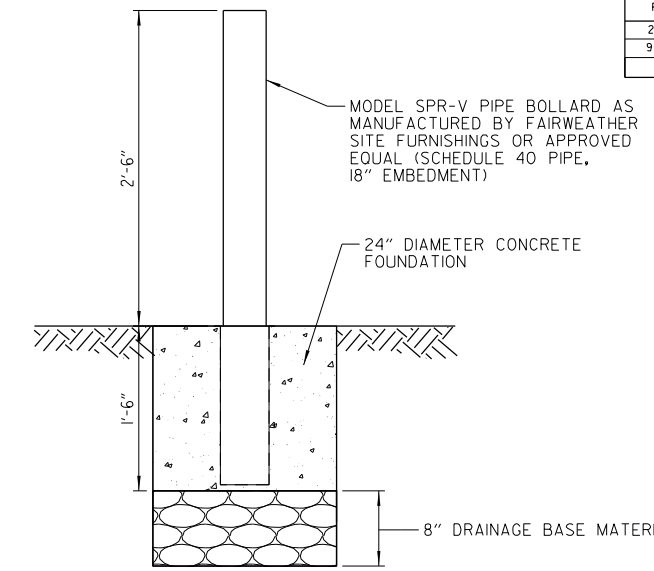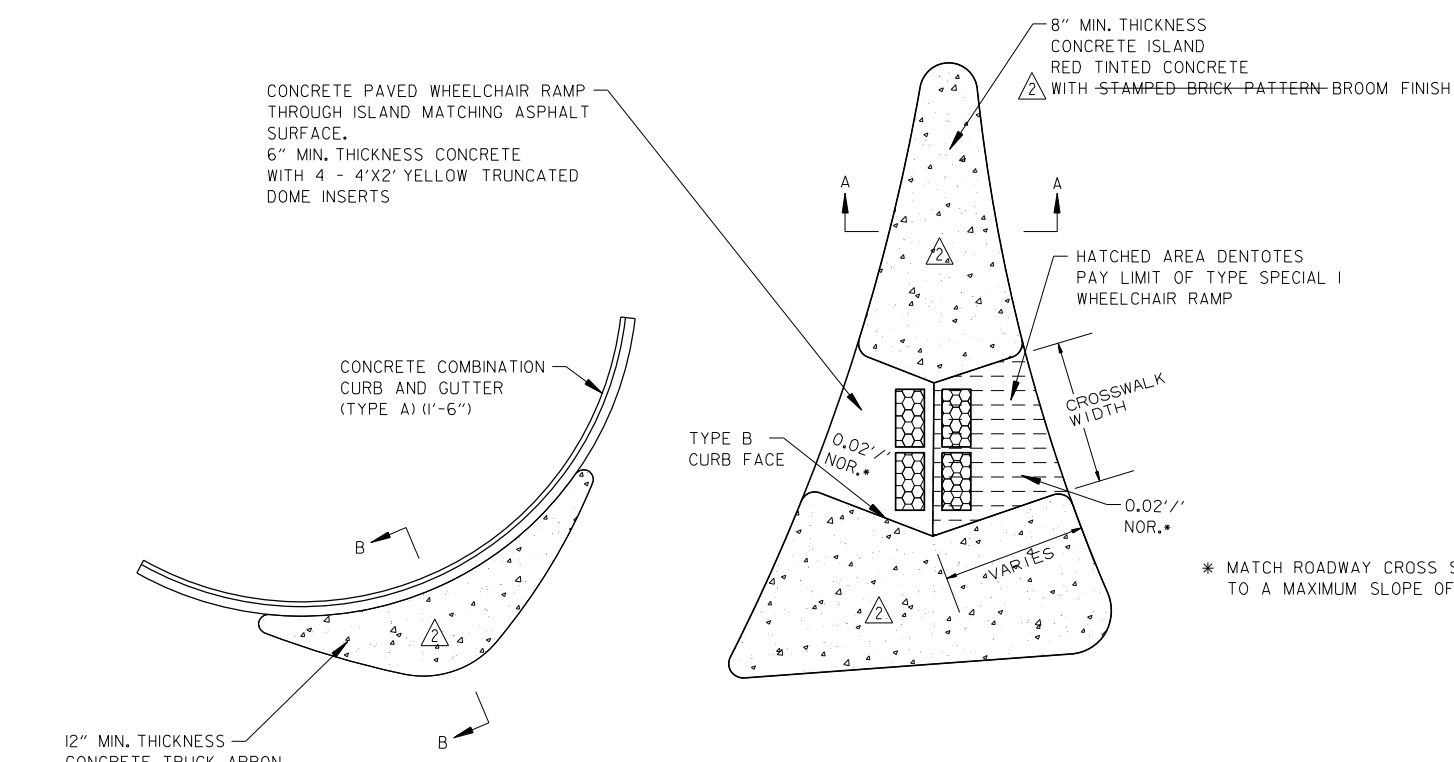


PIPE BOLLARD DETAIL

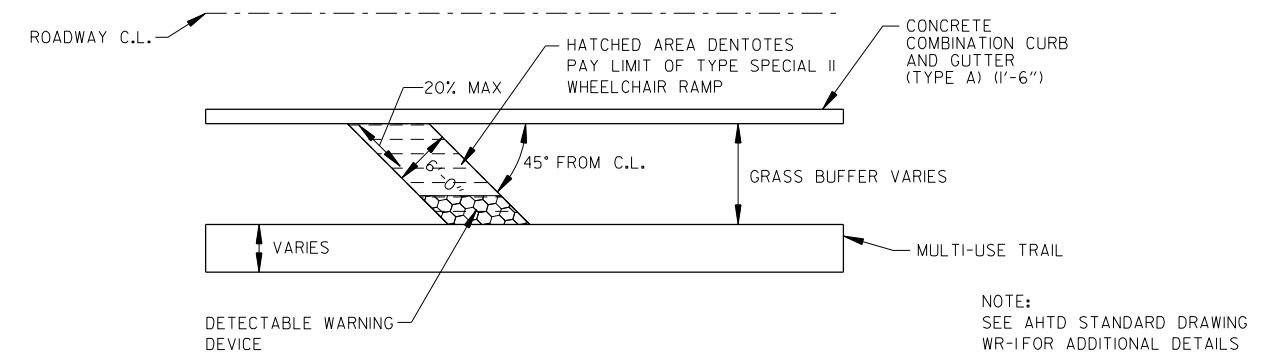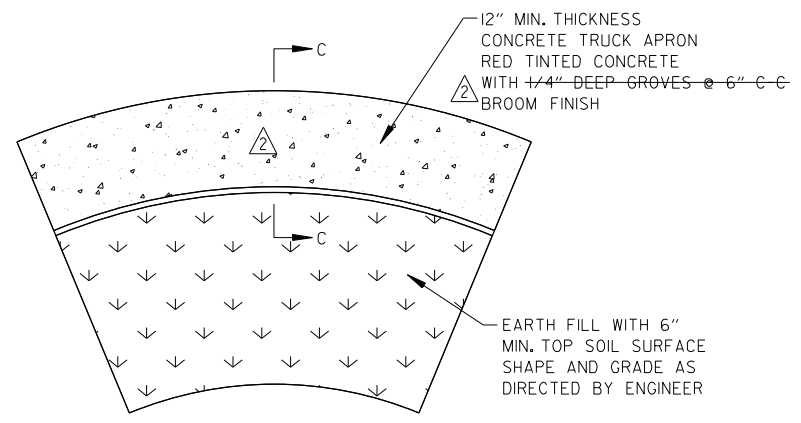


TYPE SPECIAL II BICYCLE RAMP DETAIL

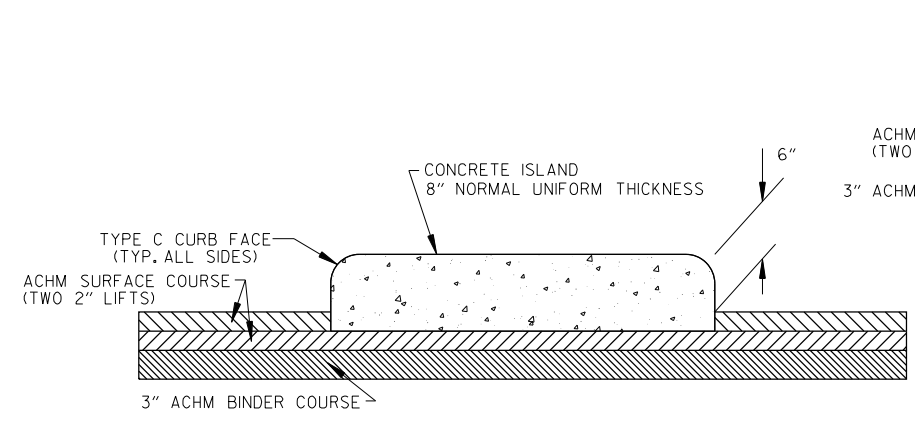

SECTION A-A

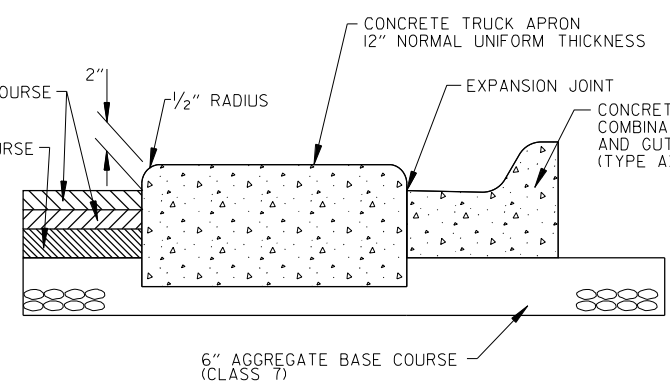

SECTION B-B

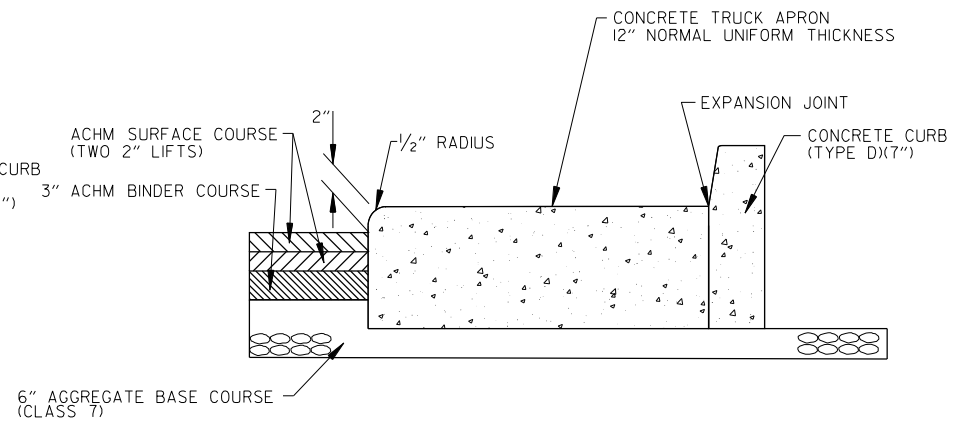

SECTION C-C



- NOTES:
- ALL WHEELCHAIR/BICYCLE RAMPS OF THE TYPE SPECIFIED SHALL BE MEASURED AND PAID FOR AS RAMPS AS SPECIFIED IN SECTION I-16 - CONCRETE SIDEWALKS AND RAMPS

DETAIL FOR CONCRETE ISLANDS, TYPE SPECIAL I WHEELCHAIR RAMPS, AND TRUCK APRONS


9/27/2016 2:24:32 PM  
 R:\Corbyn\WORKSPACE\AHTD\12017590 - ContrailField Access\Drawings\6TH\_ST\6TH\_SD.ALL.dgn  
 REVISION DATE:

DATE REVISED	DATE FILMED	DATE REVISED	DATE FILMED	FED. RD. DIST. NO.	STATE	FED. AID PROJ. NO.	SHEET NO.	TOTAL SHEETS
				6	ARK.			
				JOB NO.	080517	21	182	


2 SPECIAL DETAILS

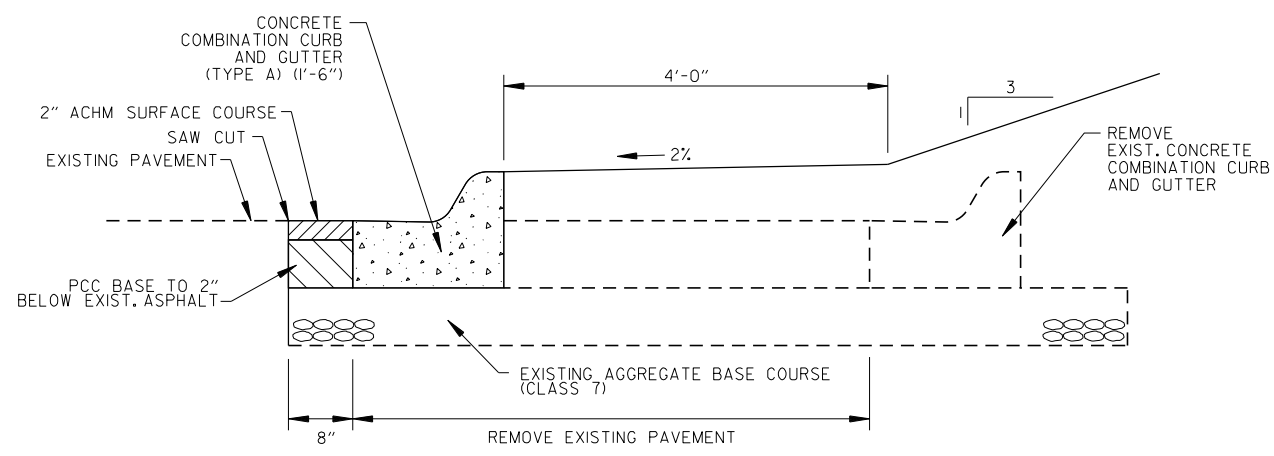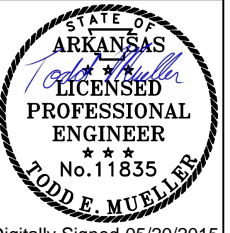


PAVEMENT REPAIR ALONG NEW PARKING LOT CURB

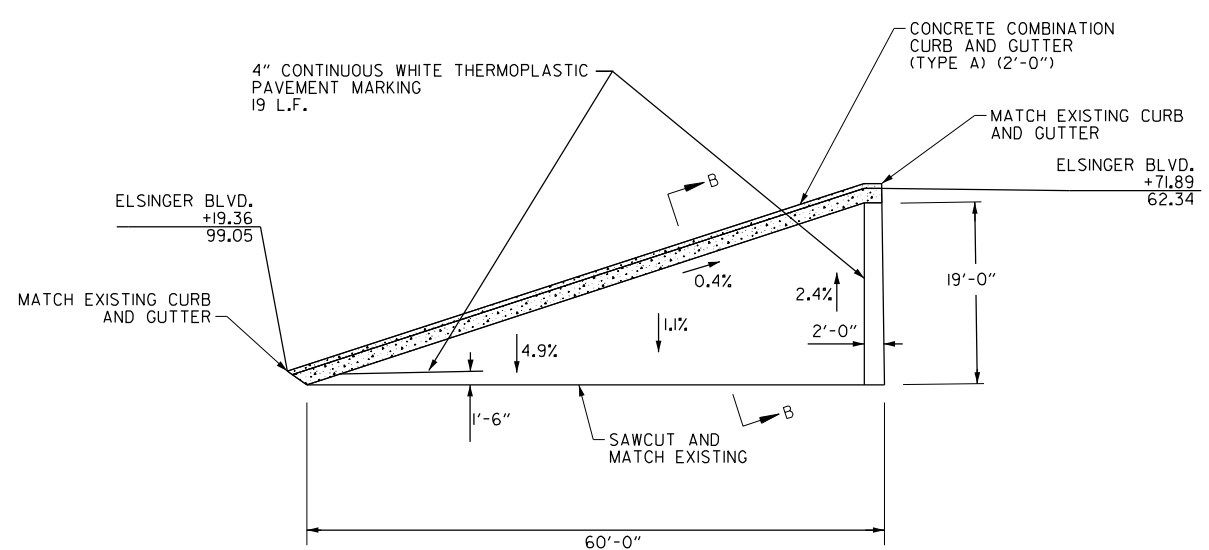

PARKING LOT REPAIR  
STA. 44+20 TO STA. 44+70 RT.

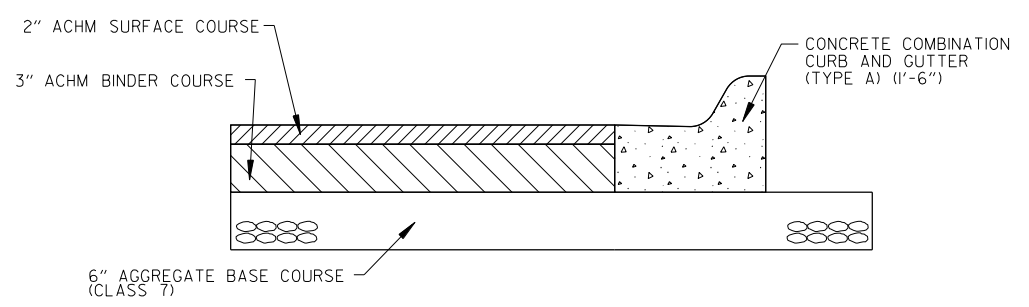


TYPICAL PARKING LOT REPAIR DETAIL

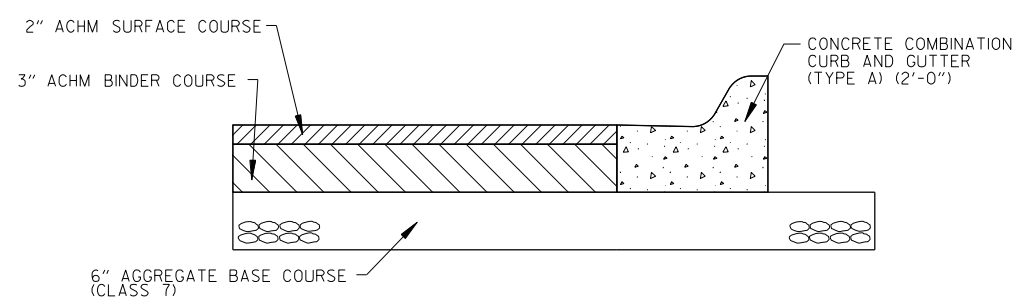


SECTION B-B

PARKING LOT REPAIR DETAILS

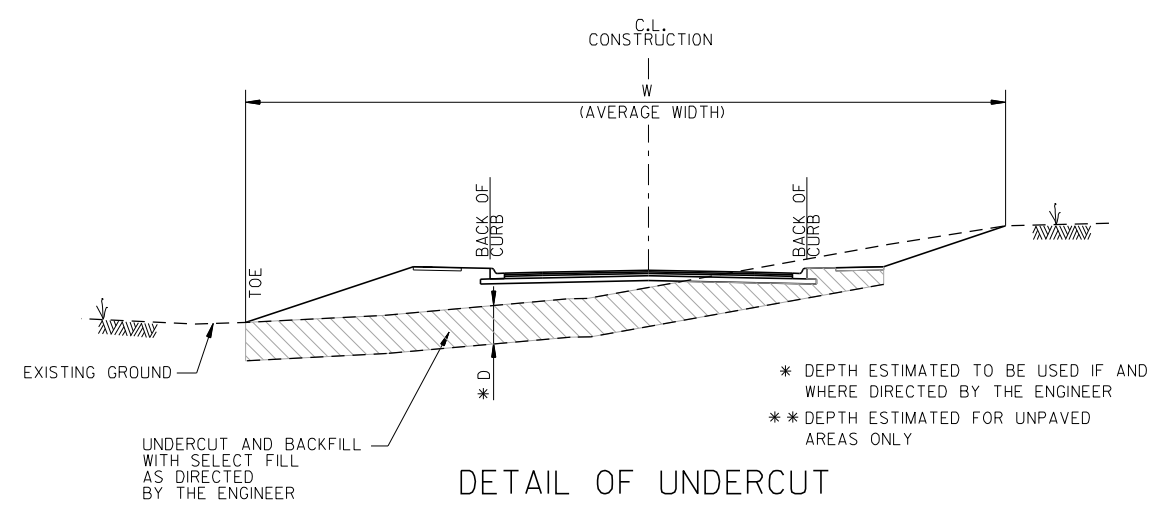

DETAIL OF UNDERCUT

6TH ST. STA. 30+30 TO STA. 38+00	D = 4'	W = 175' (AVG)
ELSINGER BLVD. STA. 42+00 TO STA. 48+40	D = 3'*	W = 175' (AVG)
AMITY RD. STA. 10+35 TO STA. 23+45	D = 3'*	W = 175' (AVG)

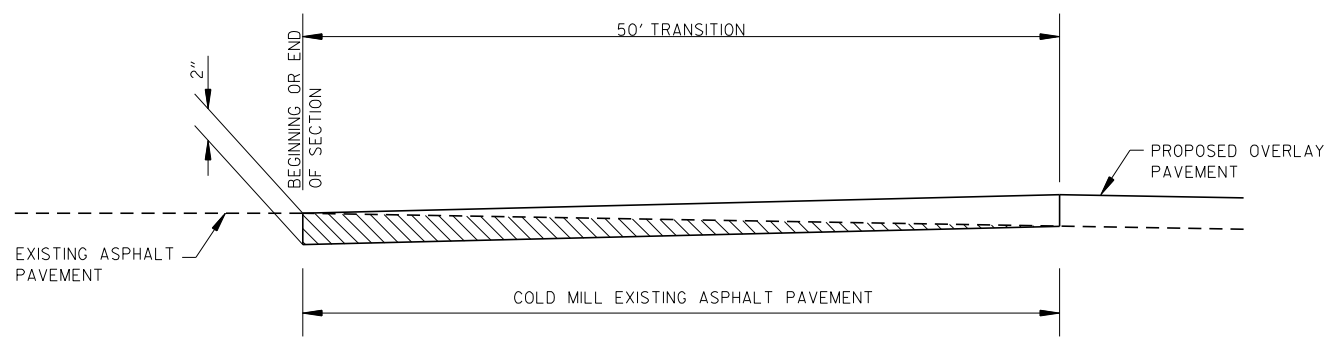


DETAIL FOR TRANSITIONS

SPECIAL DETAILS

5/20/2015 7:12:58 AM  
 WORKSPACE: AHTD  
 L:\2012\1201550 - Contrail\field Access\Drawings\6TH\_ST\6TH\_SD\_ALL.dgn  
 REVISED DATE:


DATE REVISED	DATE FILMED	DATE REVISED	DATE FILMED	FED. RD. DIST. NO.	STATE	FED. AID PROJ. NO.	SHEET NO.	TOTAL SHEETS
				6	ARK.			
				JOB NO.	080517		22	182

2 SPECIAL DETAILS

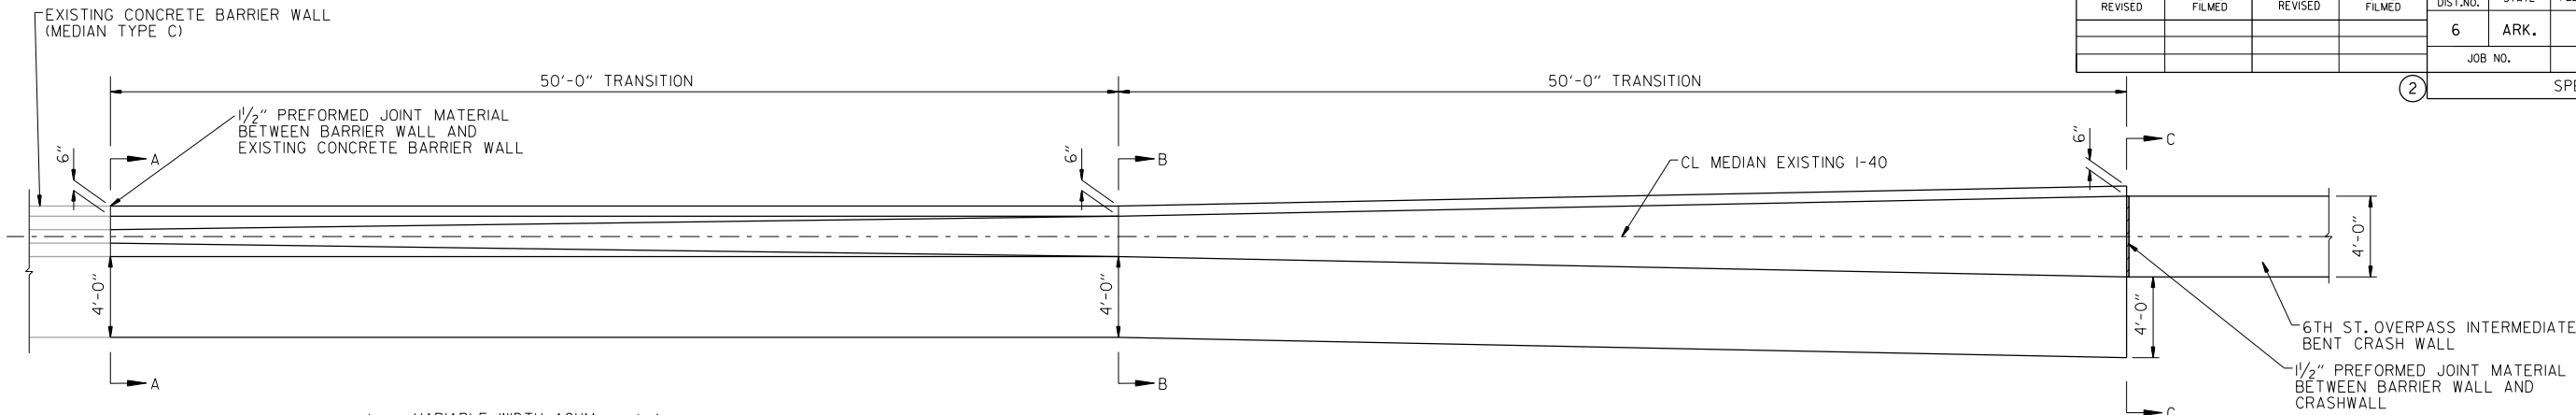

PLAN VIEW  
CONCRETE BARRIER WALL (MEDIAN TYPE C) TRANSITION

NOTE:  
FOR LOCATIONS OF TRANSITIONS,  
SEE ROADWAY PLANS.

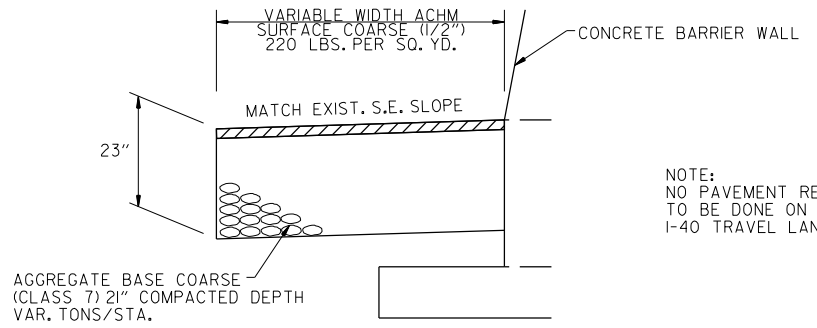

NOTE:  
NO PAVEMENT REPAIR  
TO BE DONE ON  
I-40 TRAVEL LANES




NOTE:  
MAINTAIN 3" CLEARANCE ON ALL  
FOOTING REINFORCEMENT EXCEPT  
AS NOTED AND 2" CLEARANCE ON  
ALL OTHER REINFORCEMENT.

INTERSTATE 40 SHOULDER REPAIR  
FOR CONCRETE BARRIER WALL

GENERAL NOTES

- ALL BARRIER WALLS SHALL BE CONSTRUCTED IN ACCORDANCE WITH SECTION 631 OF THE STANDARD SPECIFICATIONS, 2014 ED.
- ALL EXPOSED EDGES SHALL HAVE 3/4" CHAMFERS
- CONTRACTION JOINTS SHALL BE CONSTRUCTED AT 15'-0" MAX. SPACING IN TOP AND SIDES OF MEDIAN BARRIER AND SHALL BE FORMED IN FRESH CONCRETE
- SHOULDER REPAIR, EXCAVATION AND BACKFILL, AND REMOVAL OF EXISTING BARRIER WALL SHALL NOT BE CONSIDERED FOR SEPARATE PAYMENT BUT SHALL BE INCLUDED IN THE LINEAR FOOT BID FOR THE CONCRETE MEDIAN BARRIER WALL (MEDIAN TYPE SPECIAL)

- MATCH DEPTH OF PAVEMENT
- LONG. BARS SHALL BE ADDED IN THE LAST 40' OF THE BARRIER WALL TRANSITION

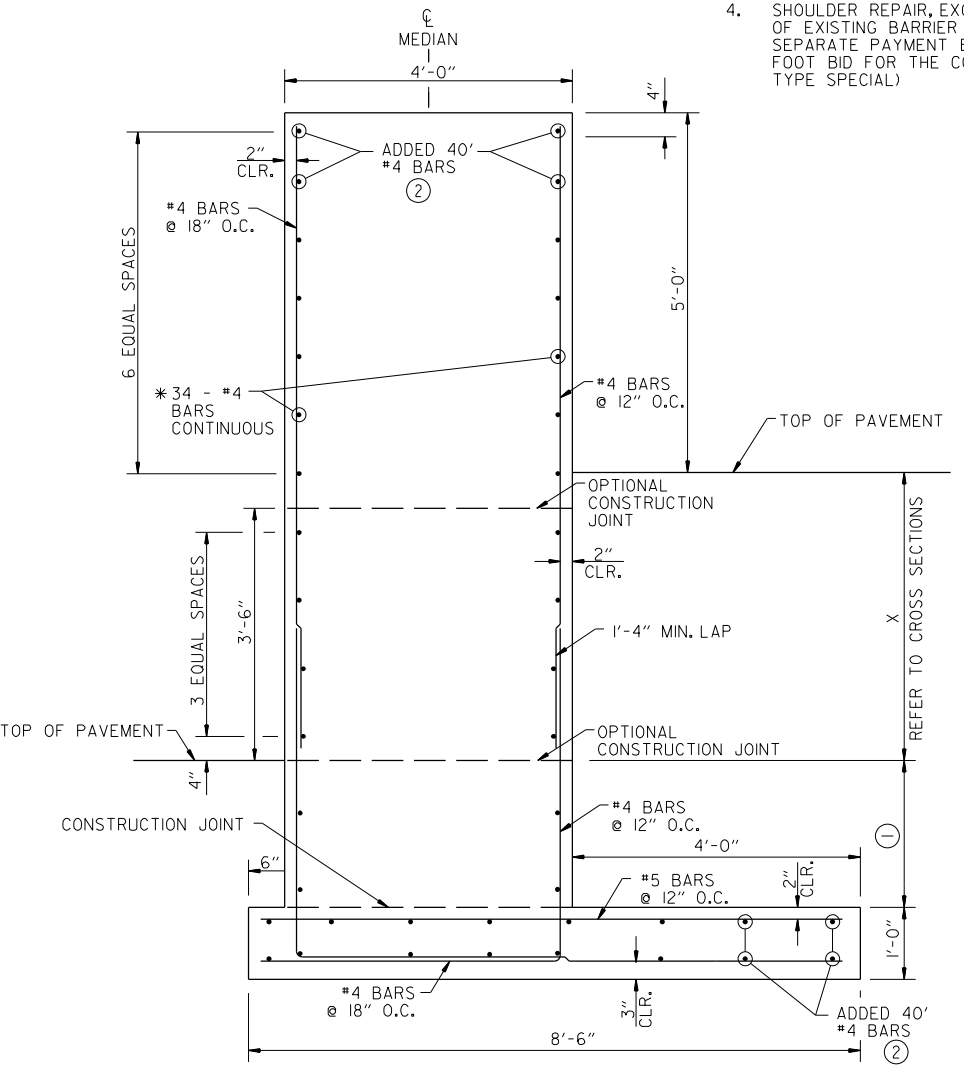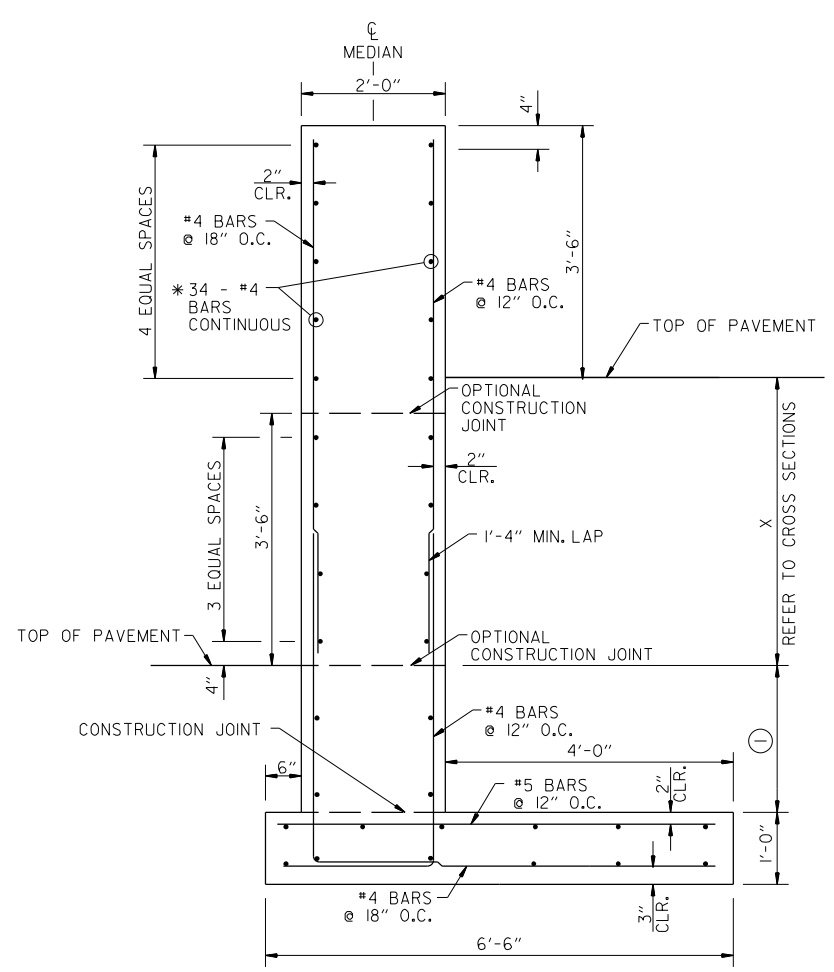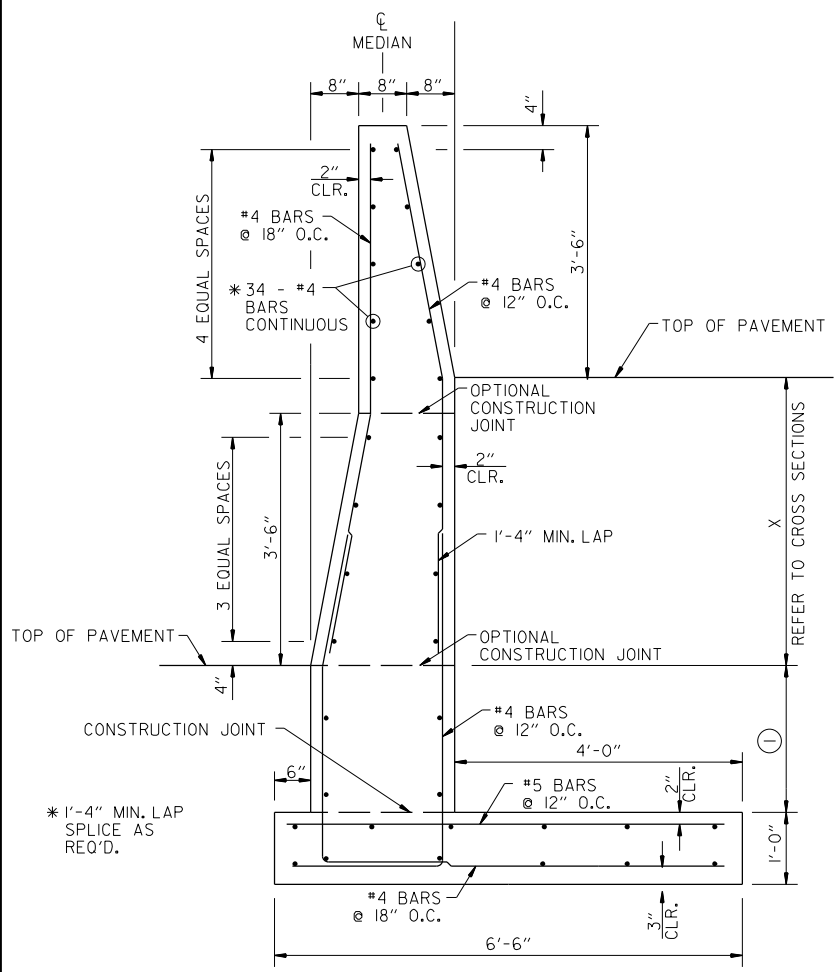

CONCRETE BARRIER WALL (MEDIAN TYPE SPECIAL)  
(SECTION A-A)  
X = 1'-0" TO 5'-0" MAX.

CONCRETE BARRIER WALL (MEDIAN TYPE SPECIAL)  
(SECTION B-B)  
X = 1'-0" TO 5'-0" MAX.

CONCRETE BARRIER WALL (MEDIAN TYPE SPECIAL)  
(SECTION C-C)  
X = 1'-0" TO 5'-0" MAX.

SPECIAL DETAILS

5/20/2015 7:12:58 AM  
 WORKSPACE: AHTD  
 L:\2012\12015590 - Contrail\field Access\Drawings\6TH\_ST\6TH\_SD\_ALL.dgn  
 REVISED DATE:

DATE REVISED	DATE FILMED	DATE REVISED	DATE FILMED	FED. RD. DIST. NO.	STATE	FED. AID PROJ. NO.	SHEET NO.	TOTAL SHEETS
2-10-2016				6	ARK.		23	182
						JOB NO.	080517	
						TEMPORARY EROSION CONTROL DETAILS		



Digitally Signed 02/10/2016

AMITY RD.

SILT FENCE	RT.	LT.	LIN. FT.
STA. 9+85 TO STA. 13+65	RT.	LT.	495
STA. 21+63 TO STA. 23+54	RT.	LT.	200

SAND BAG DITCH CHECK INSTALLATION

STA.	RT.	LT.
STA. 12+45	RT.	LT.
STA. 14+18	RT.	LT.
STA. 17+37	RT.	LT.

ROCK DITCH CHECK INSTALLATION

STA.	RT.	LT.
STA. 13+78	RT.	LT.
STA. 14+20	RT.	LT.
STA. 15+51	RT.	LT.
STA. 20+67	RT.	LT.

DROP INLET SILT FENCE

STA.	RT.	LT.	LIN. FT.
STA. 21+78	RT.	LT.	1

AMITY RD. DETOUR

SAND BAG DITCH CHECK INSTALLATION

STA.	RT.	LT.
STA. 15+98	RT.	LT.
STA. 20+00	RT.	LT.
STA. 23+26	RT.	LT.
STA. 24+03	RT.	LT.

ROCK DITCH CHECK INSTALLATION

STA.	RT.	LT.
STA. 12+98	RT.	LT.
STA. 17+95	RT.	LT.
STA. 25+17	RT.	LT.

ELSINGER BLVD.

DROP INLET SILT FENCE

STA.	RT.	LT.	LIN. FT.
STA. 45+93	RT.	LT.	20
STA. 46+62	RT.	LT.	20
STA. 46+98	RT.	LT.	20
STA. 48+12	RT.	LT.	20
STA. 48+23	RT.	LT.	20
STA. 48+23	RT.	LT.	20


REVISIONS

DATE OF REVISION	REVISION

LEGEND

(E-5) = SAND BAG DITCH CHECK  
(E-6) = ROCK DITCH CHECK  
(E-7) = DROP INLET SILT FENCE  
(E-11) = SILT FENCE


EROSION CONTROL MEASURES TO BE PLACED DURING APPROPRIATE STAGES. THESE DEVICES SHALL BE LEFT IN PLACE AS LONG AS REQUIRED TO CONTROL EROSION.

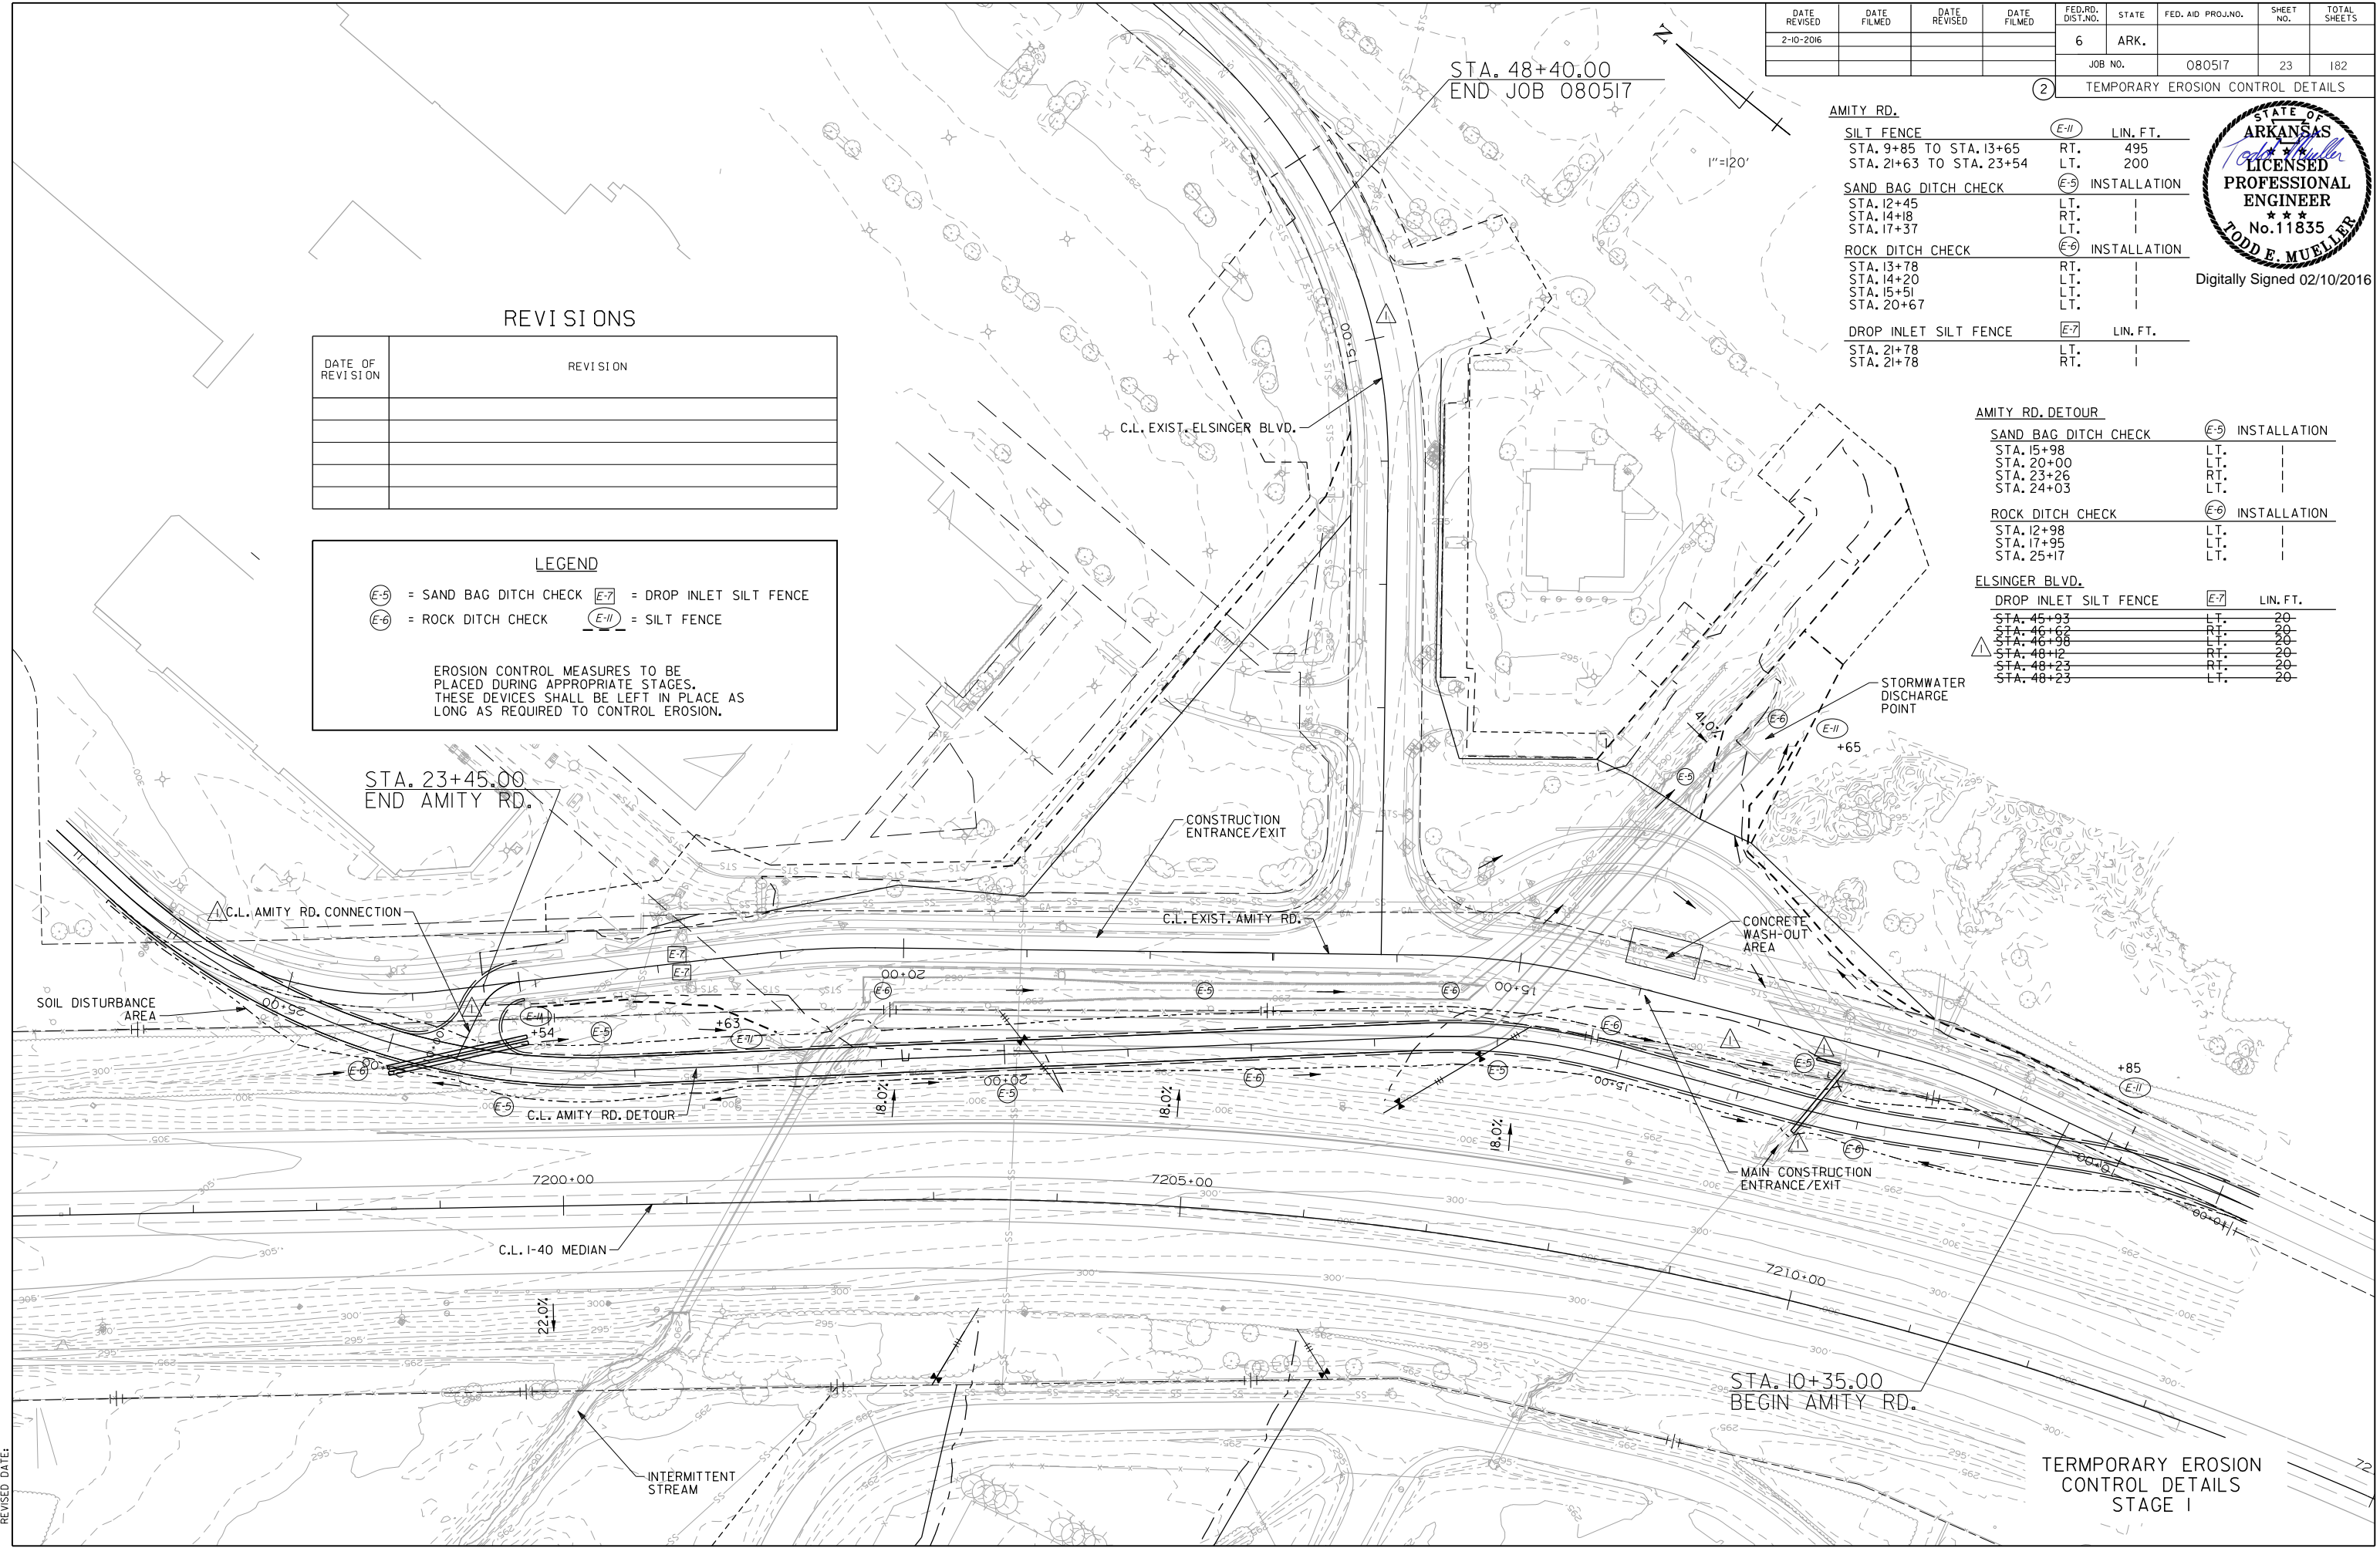

2/10/2016 4:33:51 PM  
 WORKSPACE: AHTD  
 L:\2012\1201590 - Contr-ell\field Access\Drawings\6TH\_ST\6TH\_EC\_PRJ2\_STG1\_6TH\_01.dgn  
 REVISED DATE:

TEMPORARY EROSION CONTROL DETAILS  
STAGE I

DATE REVISED	DATE FILMED	DATE REVISED	DATE FILMED	FED. RD. DIST. NO.	STATE	FED. AID PROJ. NO.	SHEET NO.	TOTAL SHEETS
2-10-2016				6	ARK.		24	182
							JOB NO.	080517
							TEMPORARY EROSION CONTROL DETAILS	

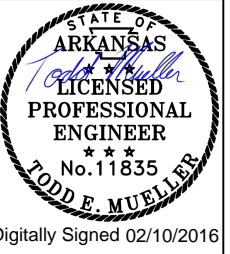

AMITY RD.		
SILT FENCE	(E-11)	LIN. FT.
STA. 9+85 TO STA. 13+65	RT.	RETAIN
STA. 21+63 TO STA. 23+54	LT.	RETAIN
SAND BAG DITCH CHECK	(E-5)	INSTALLATION
STA. 17+37	LT.	RETAIN
ROCK DITCH CHECK	(E-6)	INSTALLATION
STA. 13+78	RT.	RETAIN
STA. 14+20	LT.	RETAIN
STA. 20+67	LT.	RETAIN
DROP INLET SILT FENCE	(E-7)	LIN. FT.
STA. 22+28	LT.	RETAIN
STA. 22+28	RT.	RETAIN

AMITY RD. DETOUR		
SILT FENCE	(E-11)	LIN. FT.
STA. 13+74 TO STA. 14+87	RT.	115
STA. 15+38 TO STA. 16+68	RT.	140
SAND BAG DITCH CHECK	(E-5)	INSTALLATION
STA. 15+98	LT.	RETAIN
STA. 20+00	LT.	RETAIN
STA. 23+26	RT.	RETAIN
STA. 24+03	LT.	RETAIN
ROCK DITCH CHECK	(E-6)	INSTALLATION
STA. 12+98	LT.	RETAIN
STA. 17+95	LT.	RETAIN
STA. 25+17	LT.	RETAIN
TEMP. DRIVEWAY		
SILT FENCE	(E-11)	LIN. FT.
STA. 9+11 TO STA. 10+64	RT.	155
STA. 9+07 TO STA. 13+43	LT.	450
STA. 12+00 TO STA. 13+48	RT.	145
ROCK DITCH CHECK	(E-6)	INSTALLATION
STA. 13+32	RT.	1
STA. 13+58	RT.	1
DROP INLET SILT FENCE	(E-7)	LIN. FT.
STA. 11+37	LT.	20
STA. 13+50 13+45	LT.	20
STA. 13+50 13+45	RT.	20
ELSINGER BLVD.		
DROP INLET SILT FENCE	(E-7)	LIN. FT.
STA. 45+93	LT.	RETAIN
STA. 46+63	RT.	RETAIN
STA. 48+88	LT.	RETAIN
STA. 48+12	RT.	RETAIN
STA. 48+23	RT.	RETAIN
STA. 48+23	LT.	RETAIN


### REVISIONS

DATE OF REVISION	REVISION

### LEGEND

(E-5) = SAND BAG DITCH CHECK    (E-7) = DROP INLET SILT FENCE  
(E-6) = ROCK DITCH CHECK        (E-11) = SILT FENCE

EROSION CONTROL MEASURES TO BE PLACED DURING APPROPRIATE STAGES. THESE DEVICES SHALL BE LEFT IN PLACE AS LONG AS REQUIRED TO CONTROL EROSION.

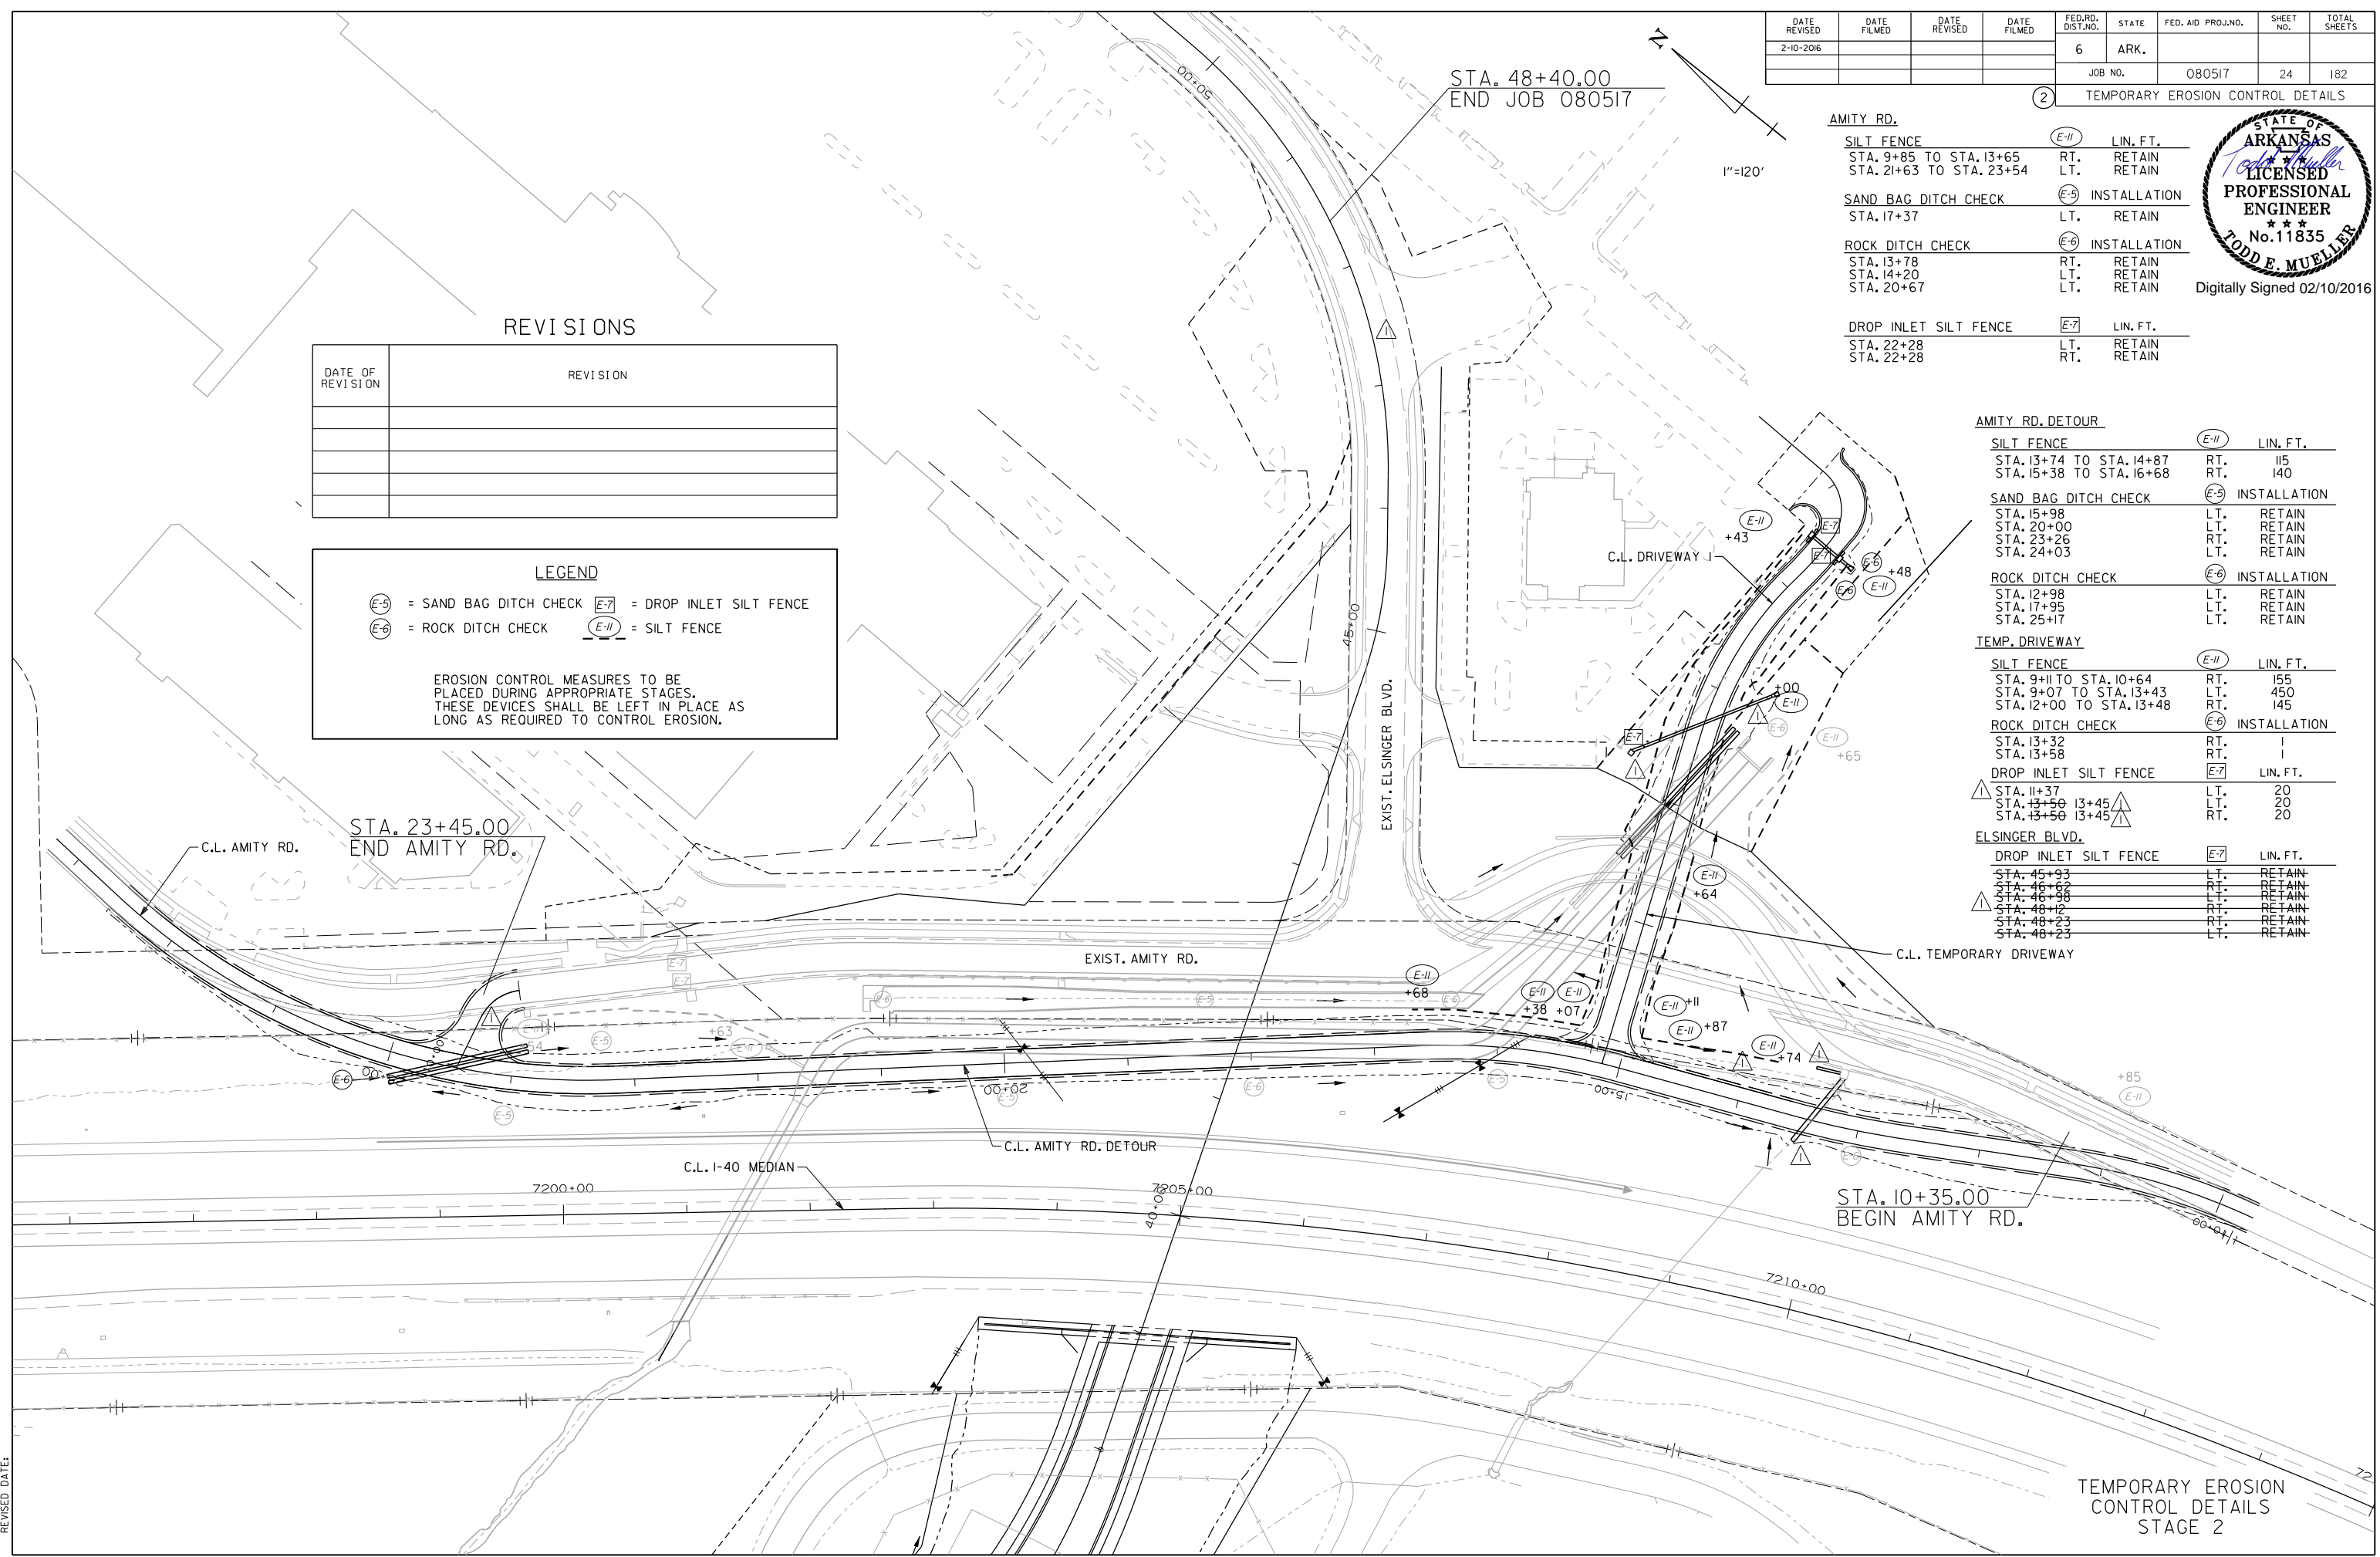



TEMPORARY EROSION CONTROL DETAILS  
STAGE 2

2/10/2016 4:33:51 PM  
 WORKSPACE: AHTD  
 L:\2012\1201590 - Contr-ell\field Access\Drawings\6TH\_ST\6TH\_EC\_P2\2-STG2\_6TH\_01.dgn  
 REVISED DATE:



DATE REVISED	DATE FILMED	DATE REVISED	DATE FILMED	FED. RD. DIST. NO.	STATE	FED. AID PROJ. NO.	SHEET NO.	TOTAL SHEETS
				6	ARK.			
				JOB NO.	080517	25	182	

TEMPORARY EROSION CONTROL DETAILS

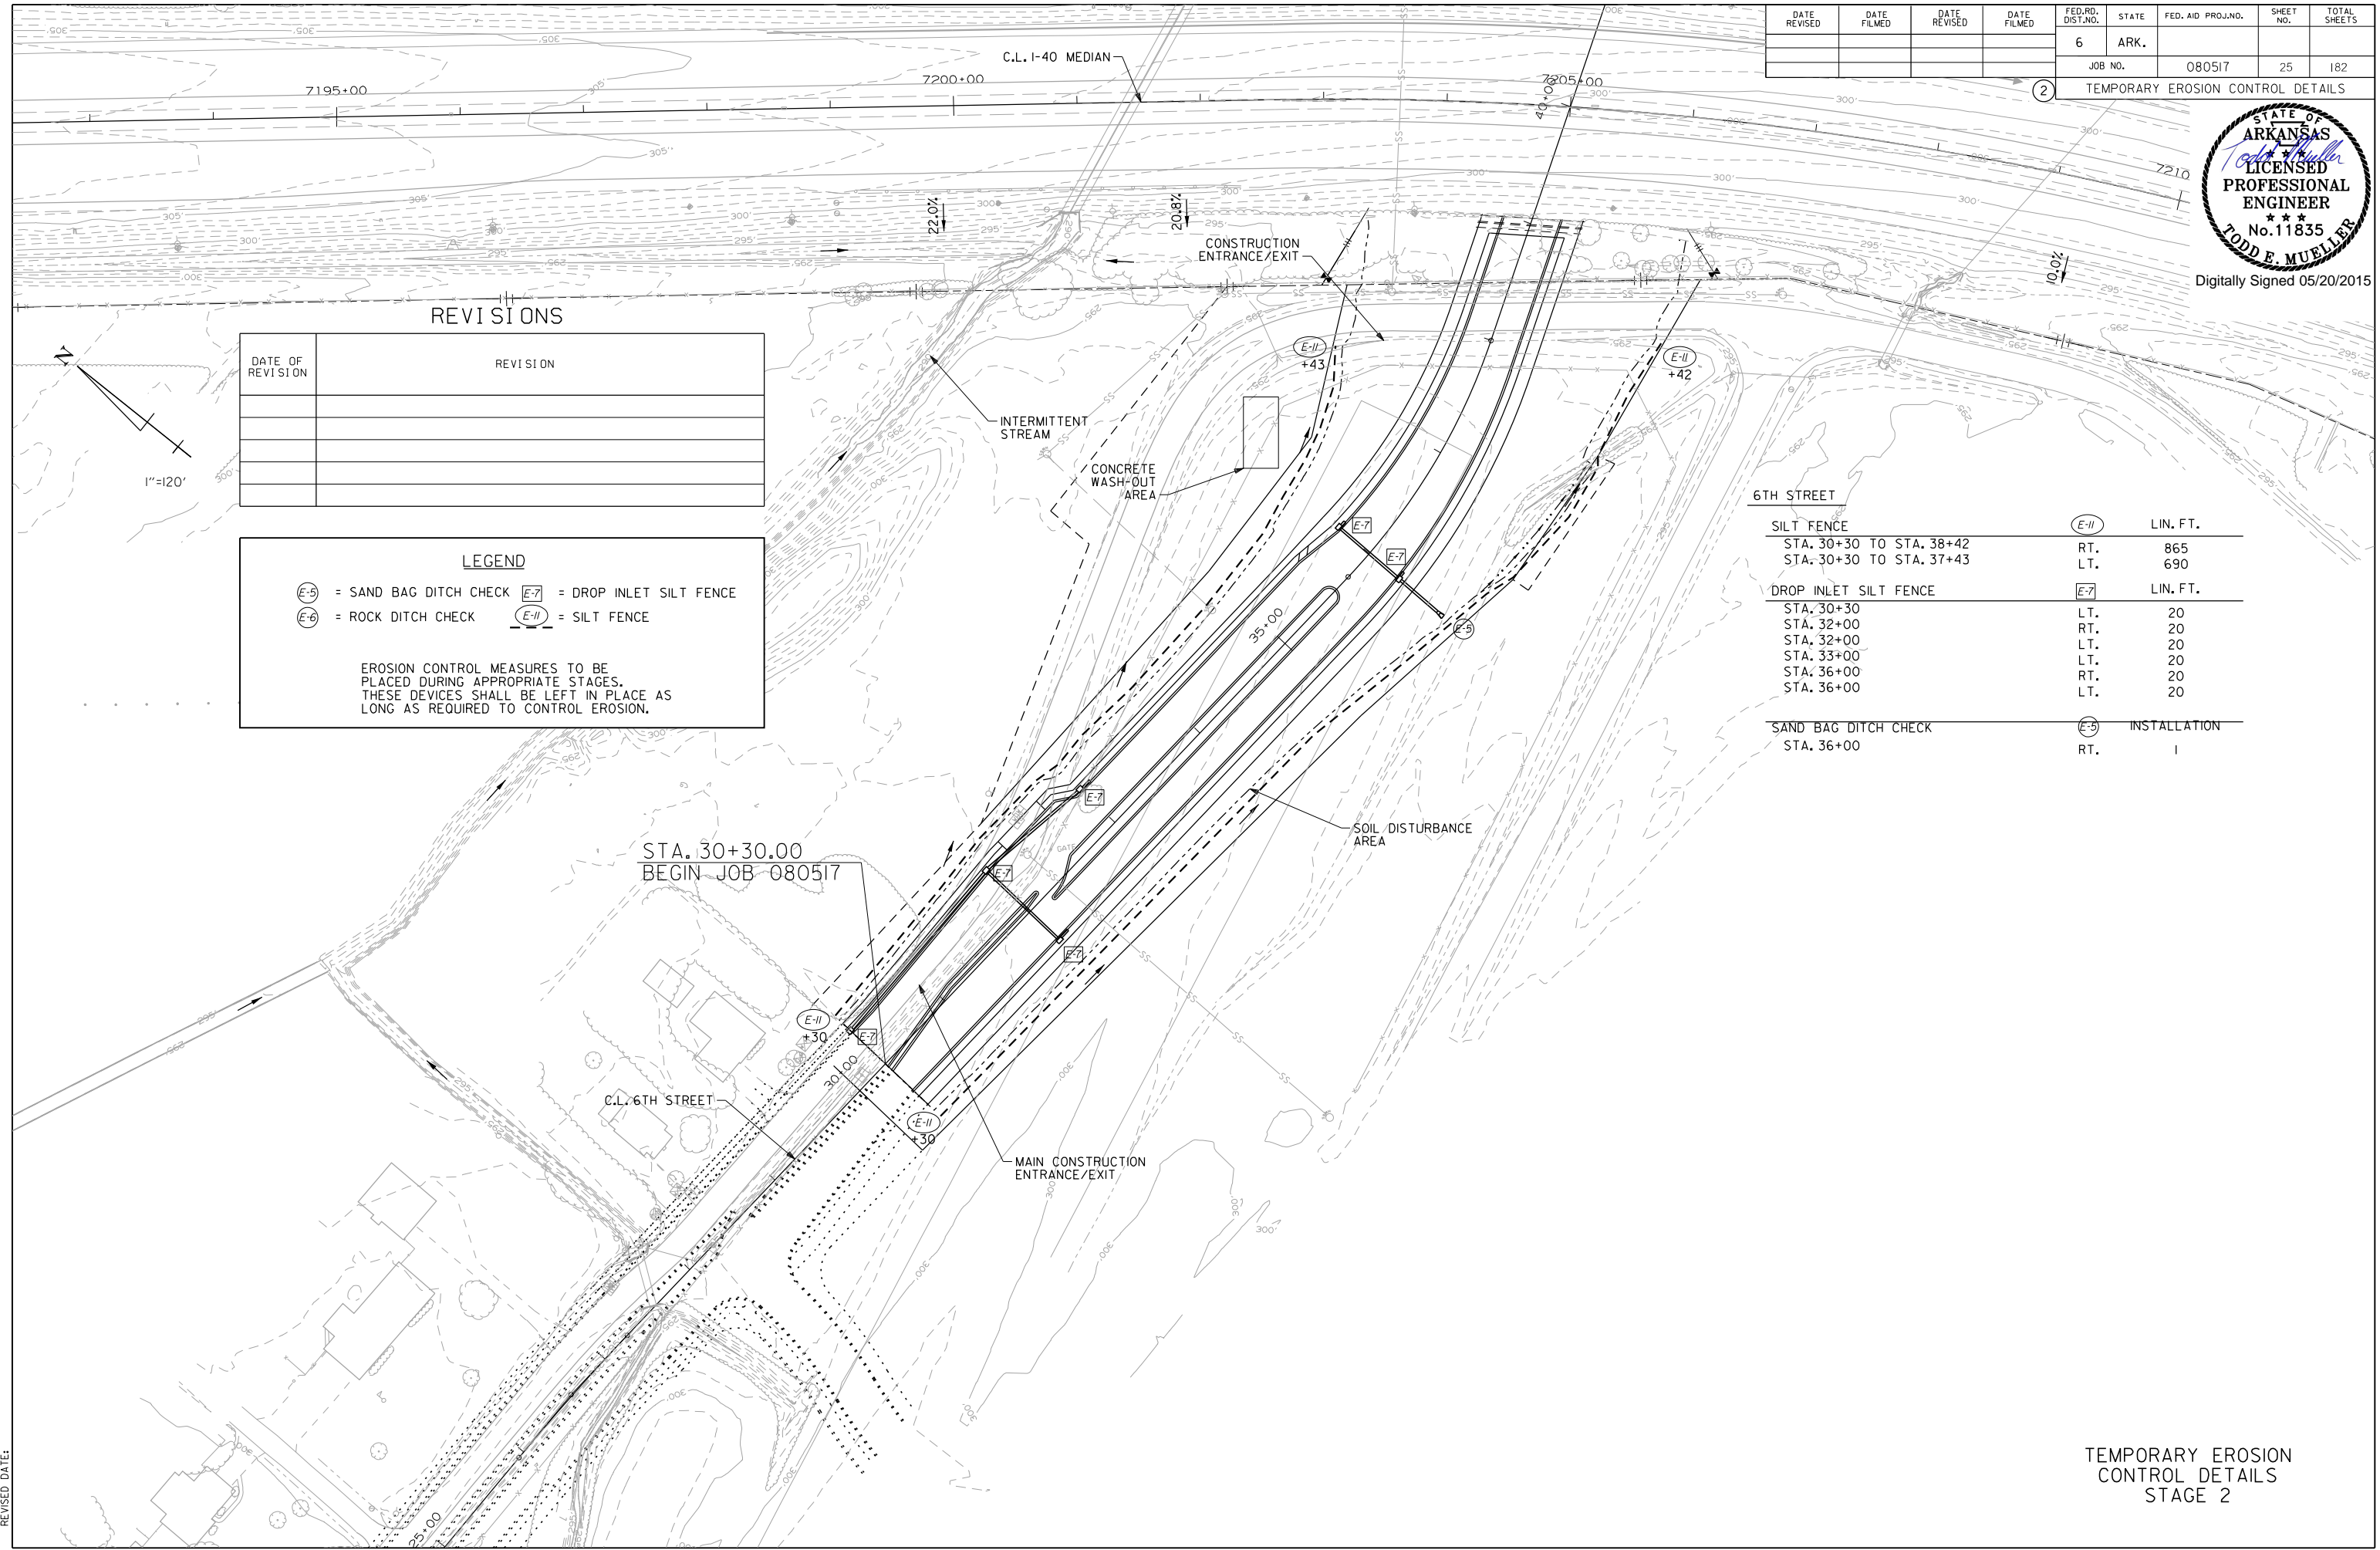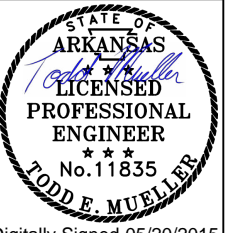

REVISIONS

DATE OF REVISION	REVISION

LEGEND

- (E-5) = SAND BAG DITCH CHECK
- (E-6) = ROCK DITCH CHECK
- (E-7) = DROP INLET SILT FENCE
- (E-11) = SILT FENCE

EROSION CONTROL MEASURES TO BE PLACED DURING APPROPRIATE STAGES. THESE DEVICES SHALL BE LEFT IN PLACE AS LONG AS REQUIRED TO CONTROL EROSION.

SILT FENCE	(E-11)	LIN. FT.
STA. 30+30 TO STA. 38+42	RT.	865
STA. 30+30 TO STA. 37+43	LT.	690
DROP INLET SILT FENCE	(E-7)	LIN. FT.
STA. 30+30	LT.	20
STA. 32+00	RT.	20
STA. 32+00	LT.	20
STA. 33+00	LT.	20
STA. 36+00	RT.	20
STA. 36+00	LT.	20
SAND BAG DITCH CHECK	(E-5)	INSTALLATION
STA. 36+00	RT.	1

5/20/2015 7:13:06 AM  
 WORKSPACE: AHTD  
 L:\2012\1201590 - Contrail\field Access\Drawings\6TH\_ST\6TH.LC.PRJ2\_STG2\_6TH.02.dgn  
 REVISED DATE:

TEMPORARY EROSION CONTROL DETAILS  
STAGE 2

DATE REVISED	DATE FILMED	DATE REVISED	DATE FILMED	FED. RD. DIST. NO.	STATE	FED. AID PROJ. NO.	SHEET NO.	TOTAL SHEETS
2-10-2016				6	ARK.		26	182
							JOB NO. 080517	
							TEMPORARY EROSION CONTROL DETAILS	



Digitally Signed 02/10/2016

**AMITY RD.**

SILT FENCE	RT.	LT.	LIN. FT.
STA. 9+85 TO STA. 13+65			RETAIN
STA. 18+00 TO STA. 21+13			310
STA. 21+63 TO STA. 22+28			75
STA. 22+61 TO STA. 23+54			95

SAND BAG DITCH CHECK	RT.	LT.	INSTALLATION
STA. 17+37			RETAIN

ROCK DITCH CHECK	RT.	LT.	INSTALLATION
STA. 13+78			RETAIN

DROP INLET SILT FENCE	RT.	LT.	LIN. FT.
STA. 18+00			20
STA. 19+00			20
STA. 19+00			20
STA. 19+12			20
STA. 19+15			20
STA. 19+44			20
STA. 20+50			20
STA. 22+08			20
STA. 22+30			20
STA. 22+80			20
STA. 22+80			20

**AMITY RD. DETOUR**

SILT FENCE	RT.	LT.	LIN. FT.
STA. 13+74 TO STA. 14+87			RETAIN
STA. 15+38 TO STA. 16+68			RETAIN

**SAND BAG DITCH CHECK**

RT.	LT.	INSTALLATION
STA. 15+98		RETAIN
STA. 20+00		RETAIN
STA. 23+26		RETAIN
STA. 24+03		RETAIN

**ROCK DITCH CHECK**

RT.	LT.	INSTALLATION
STA. 12+98		RETAIN
STA. 17+95		RETAIN
STA. 25+17		RETAIN

**TEMP. DRIVEWAY**

SILT FENCE	RT.	LT.	LIN. FT.
STA. 9+11 TO STA. 10+64			RETAIN
STA. 9+07 TO STA. 13+43			RETAIN
STA. 12+00 TO STA. 13+48			RETAIN

ROCK DITCH CHECK	RT.	LT.	INSTALLATION
STA. 13+32			RETAIN
STA. 13+58			RETAIN

DROP INLET SILT FENCE	RT.	LT.	LIN. FT.
STA. 11+37			RETAIN
STA. 13+50			RETAIN
STA. 13+50			RETAIN

**ELSINGER BLVD.**

DROP INLET SILT FENCE	RT.	LT.	LIN. FT.
STA. 46+93			20
STA. 46+23			20
STA. 46+98			20
STA. 48+12			20
STA. 48+23			20
STA. 48+23			20

SILT FENCE	RT.	LT.	LIN. FT.
STA. 46+00 TO STA. 47+10			125

**I-40 MEDIAN**

DROP INLET SILT FENCE	RT.	LT.	LIN. FT.
STA. 7206+42			20
STA. 7206+42			20


**REVISIONS**

DATE OF REVISION	REVISION

**LEGEND**

(E-5) = SAND BAG DITCH CHECK    (E-7) = DROP INLET SILT FENCE  
 (E-6) = ROCK DITCH CHECK        (E-11) = SILT FENCE

EROSION CONTROL MEASURES TO BE PLACED DURING APPROPRIATE STAGES. THESE DEVICES SHALL BE LEFT IN PLACE AS LONG AS REQUIRED TO CONTROL EROSION.

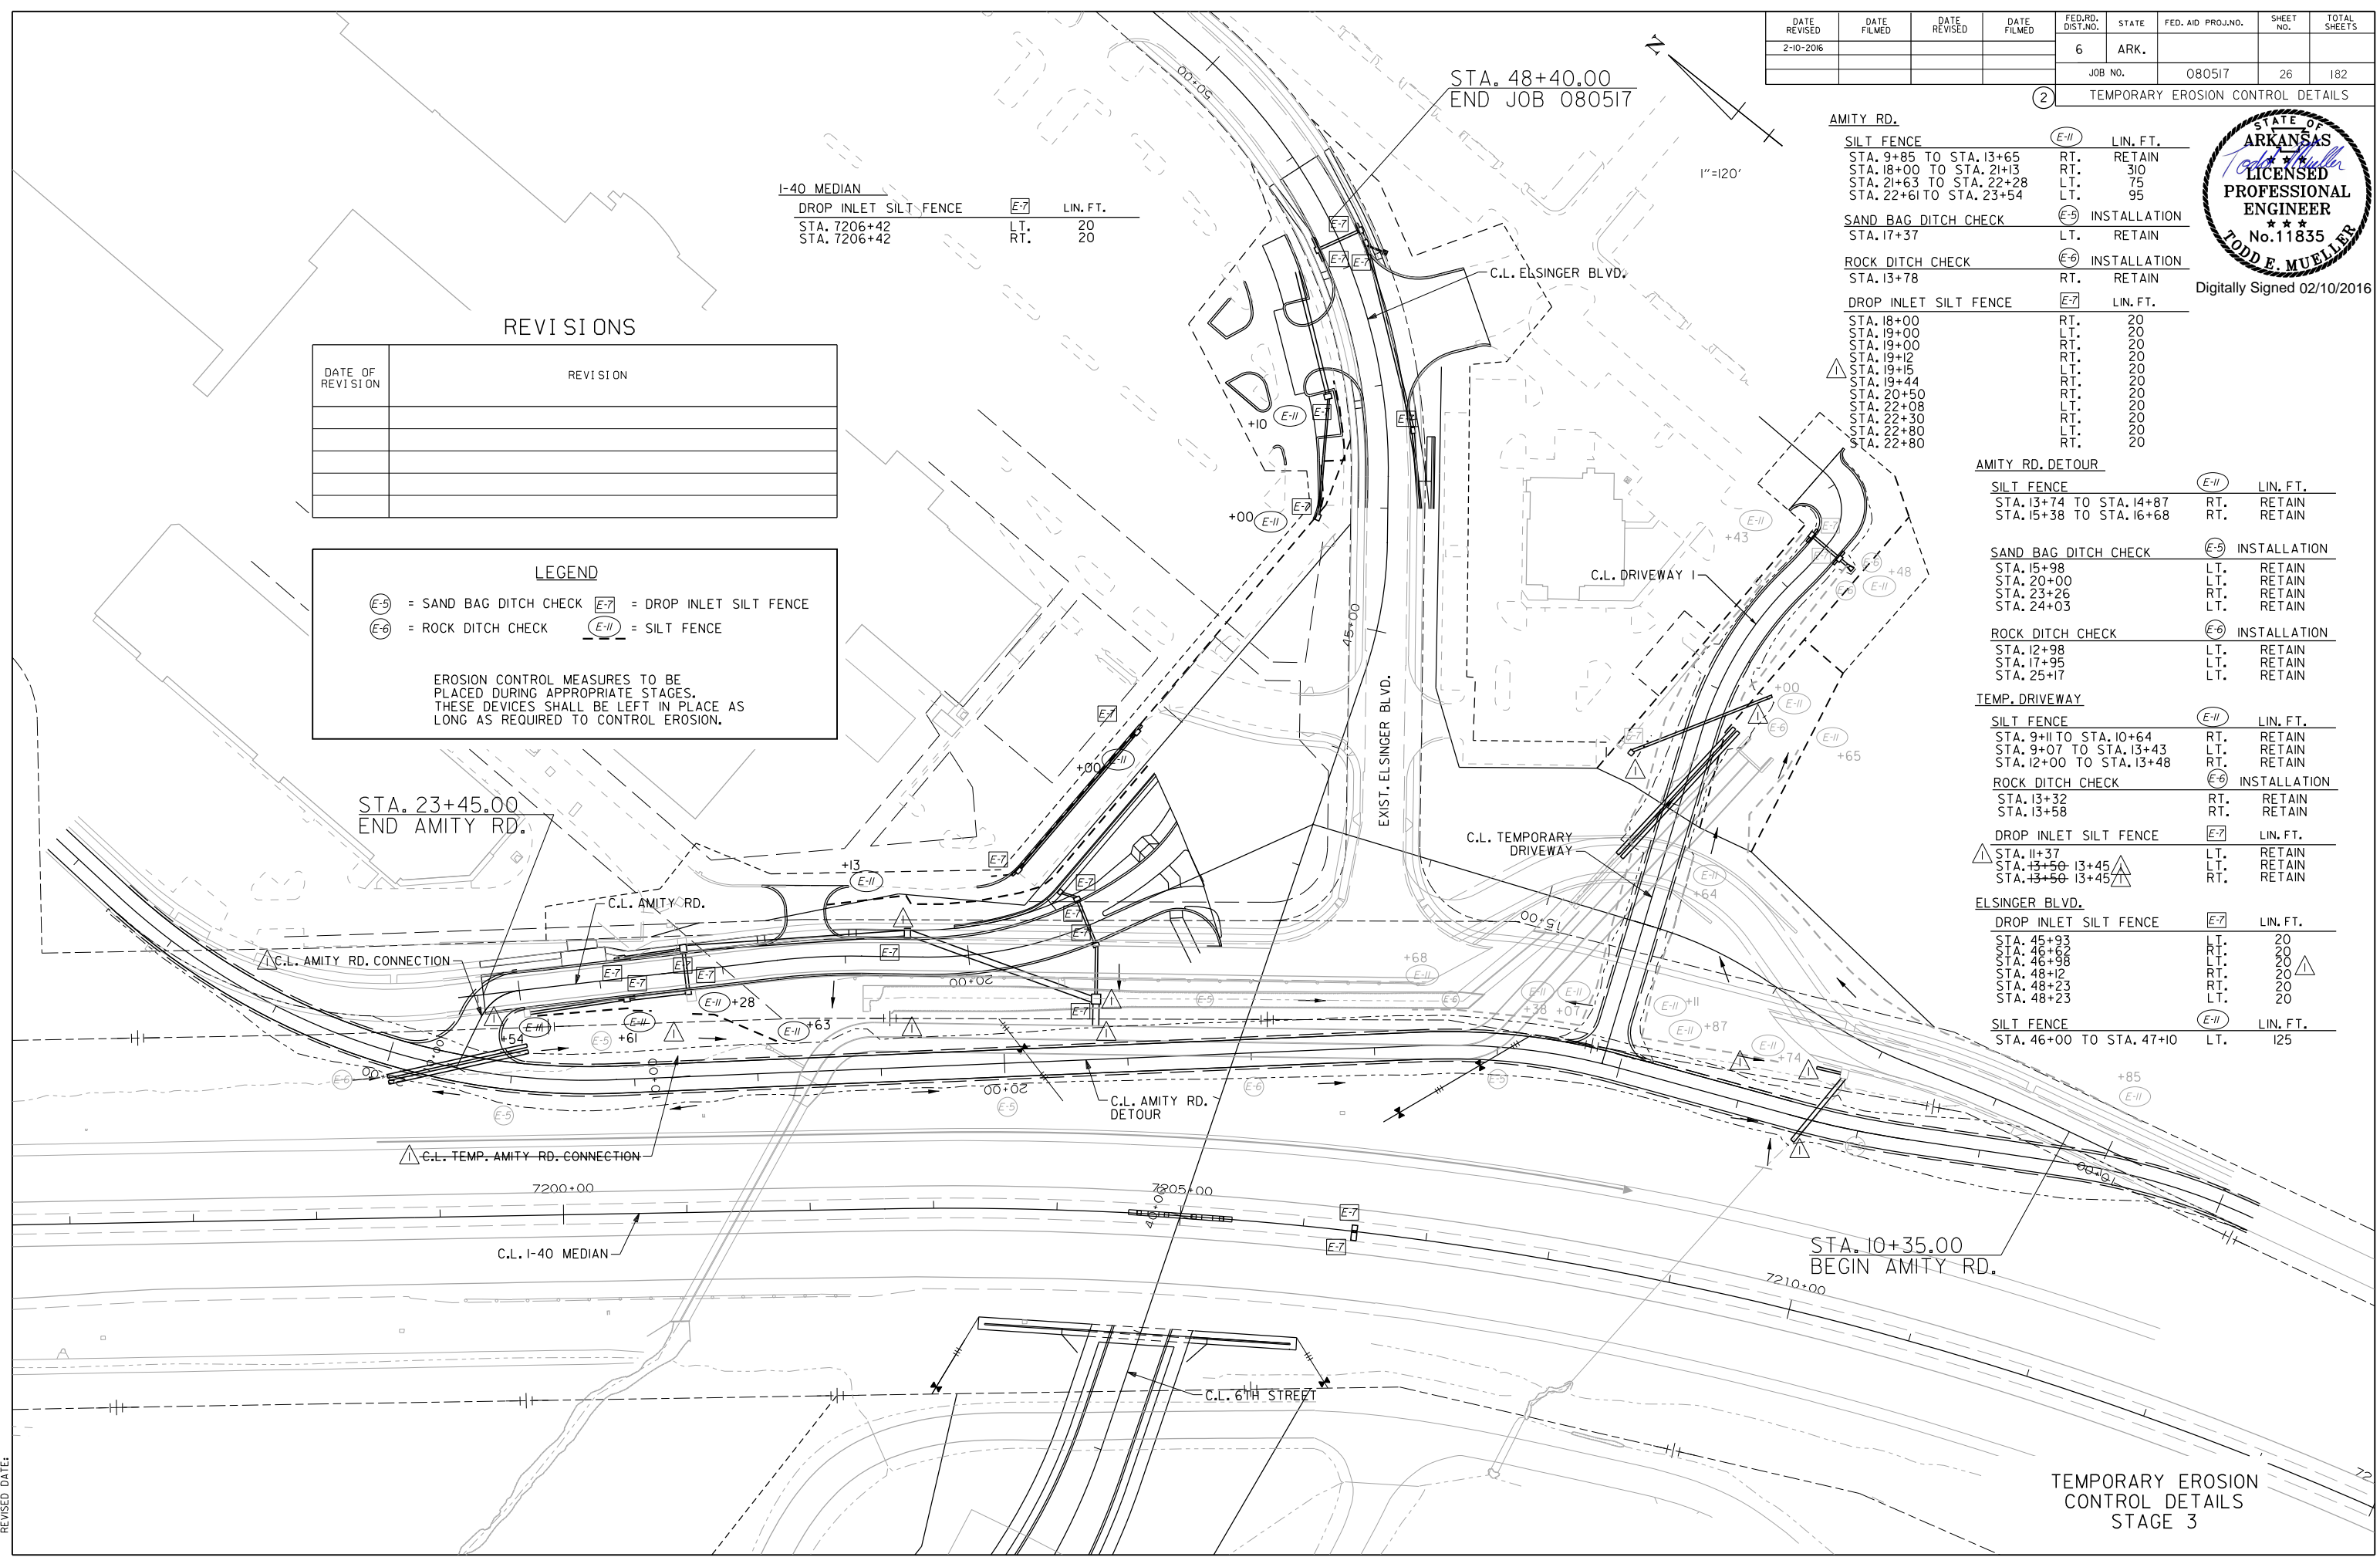

TEMPORARY EROSION CONTROL DETAILS  
STAGE 3

2/10/2016 4:33:52 PM  
 WORKSPACE: AHTD  
 L:\2012\1201590 - Contr-ell\field Access\Drawings\6TH\_ST\6TH\_EC\_PRRJ2\_STG3\_6TH\_01.dgn  
 REVISION DATE:

DATE REVISED	DATE FILMED	DATE REVISED	DATE FILMED	FED. RD. DIST. NO.	STATE	FED. AID PROJ. NO.	SHEET NO.	TOTAL SHEETS
2-10-2016				6	ARK.	080517	27	182

AMITY RD. (2) TEMPORARY EROSION CONTROL DETAILS



Digitally Signed 02/10/2016

6TH STREET

DROP INLET SILT FENCE	E-7	LIN. FT.
STA. 42+50	RT.	20

I-40 MEDIAN

DROP INLET SILT FENCE	E-7	LIN. FT.
STA. 7206+42	LT.	RETAIN
STA. 7206+42	RT.	RETAIN

STA. 48+40.00  
END JOB 080517

AMITY RD.

SILT FENCE	E-11	LIN. FT.
STA. 9+85 TO STA. 13+65	RT.	RETAIN
STA. 18+00 TO STA. 21+13	RT.	RETAIN
STA. 21+63 TO STA. 22+28	LT.	RETAIN
STA. 22+61 TO STA. 23+54	LT.	RETAIN
ROCK DITCH CHECK	E-6	INSTALLATION
STA. 13+78	RT.	RETAIN
STA. 14+52	RT.	RETAIN
DROP INLET SILT FENCE	E-7	LIN. FT.
STA. 14+75	RT.	20
STA. 15+50	RT.	20
STA. 15+50	LT.	20
STA. 18+00	RT.	RETAIN
STA. 19+00	LT.	RETAIN
STA. 19+00	RT.	RETAIN
STA. 19+12	RT.	RETAIN
STA. 19+15	LT.	RETAIN
STA. 19+44	RT.	RETAIN
STA. 20+50	LT.	RETAIN
STA. 22+08	LT.	RETAIN
STA. 22+30	LT.	RETAIN
STA. 22+80	LT.	RETAIN
STA. 22+80	RT.	RETAIN

REVISIONS

DATE OF REVISION	REVISION

LEGEND

- (E-5) = SAND BAG DITCH CHECK
- (E-6) = ROCK DITCH CHECK
- (E-7) = DROP INLET SILT FENCE
- (E-11) = SILT FENCE

EROSION CONTROL MEASURES TO BE PLACED DURING APPROPRIATE STAGES. THESE DEVICES SHALL BE LEFT IN PLACE AS LONG AS REQUIRED TO CONTROL EROSION.

AMITY RD. DETOUR

SILT FENCE	E-11	LIN. FT.
STA. 13+74 TO STA. 14+87	RT.	RETAIN

SAND BAG DITCH CHECK

(E-5) INSTALLATION	
STA. 15+98	RT.
STA. 15+98	LT.
STA. 20+00	LT.
STA. 23+26	LT.
STA. 24+03	LT.

ROCK DITCH CHECK

(E-6) INSTALLATION	
STA. 12+98	LT.
STA. 17+95	LT.
STA. 25+17	LT.

TEMP. DRIVEWAY

SILT FENCE	E-11	LIN. FT.
STA. 9+11 TO STA. 10+64	RT.	RETAIN
STA. 11+20 TO STA. 13+43	LT.	RETAIN
STA. 12+00 TO STA. 13+48	RT.	RETAIN

DROP INLET SILT FENCE

(E-7) LIN. FT.	
STA. 11+37	LT.
STA. 13+50	LT.
STA. 13+50	RT.

ROCK DITCH CHECK

(E-6) INSTALLATION	
STA. 13+32	RT.
STA. 13+58	RT.


ELSINGER BLVD.

DROP INLET SILT FENCE	E-7	LIN. FT.
STA. 43+93	CL.	20
STA. 44+06	RT.	20
STA. 44+06	LT.	20
STA. 44+35	LT.	20
STA. 44+38	CL.	20
STA. 44+42	LT.	20
STA. 45+52	RT.	20
STA. 45+52	LT.	20
STA. 45+93	LT.	RETAIN
STA. 46+62	RT.	RETAIN
STA. 46+98	LT.	RETAIN
STA. 48+12	RT.	RETAIN
STA. 48+23	RT.	RETAIN
STA. 48+23	LT.	RETAIN

SILT FENCE

(E-11) LIN. FT.	
STA. 43+40 TO STA. 46+00	LT.
STA. 46+00 TO STA. 47+10	LT.

2/10/2016 4:33:53 PM  
 WORKSPACE: AHTD  
 L:\2012\1201590 - Contr-ell\field Access\Drawings\6TH\_ST\6TH\_EC.PRJ\2\_STG4\_6TH.01.dgn  
 REVISION DATE:

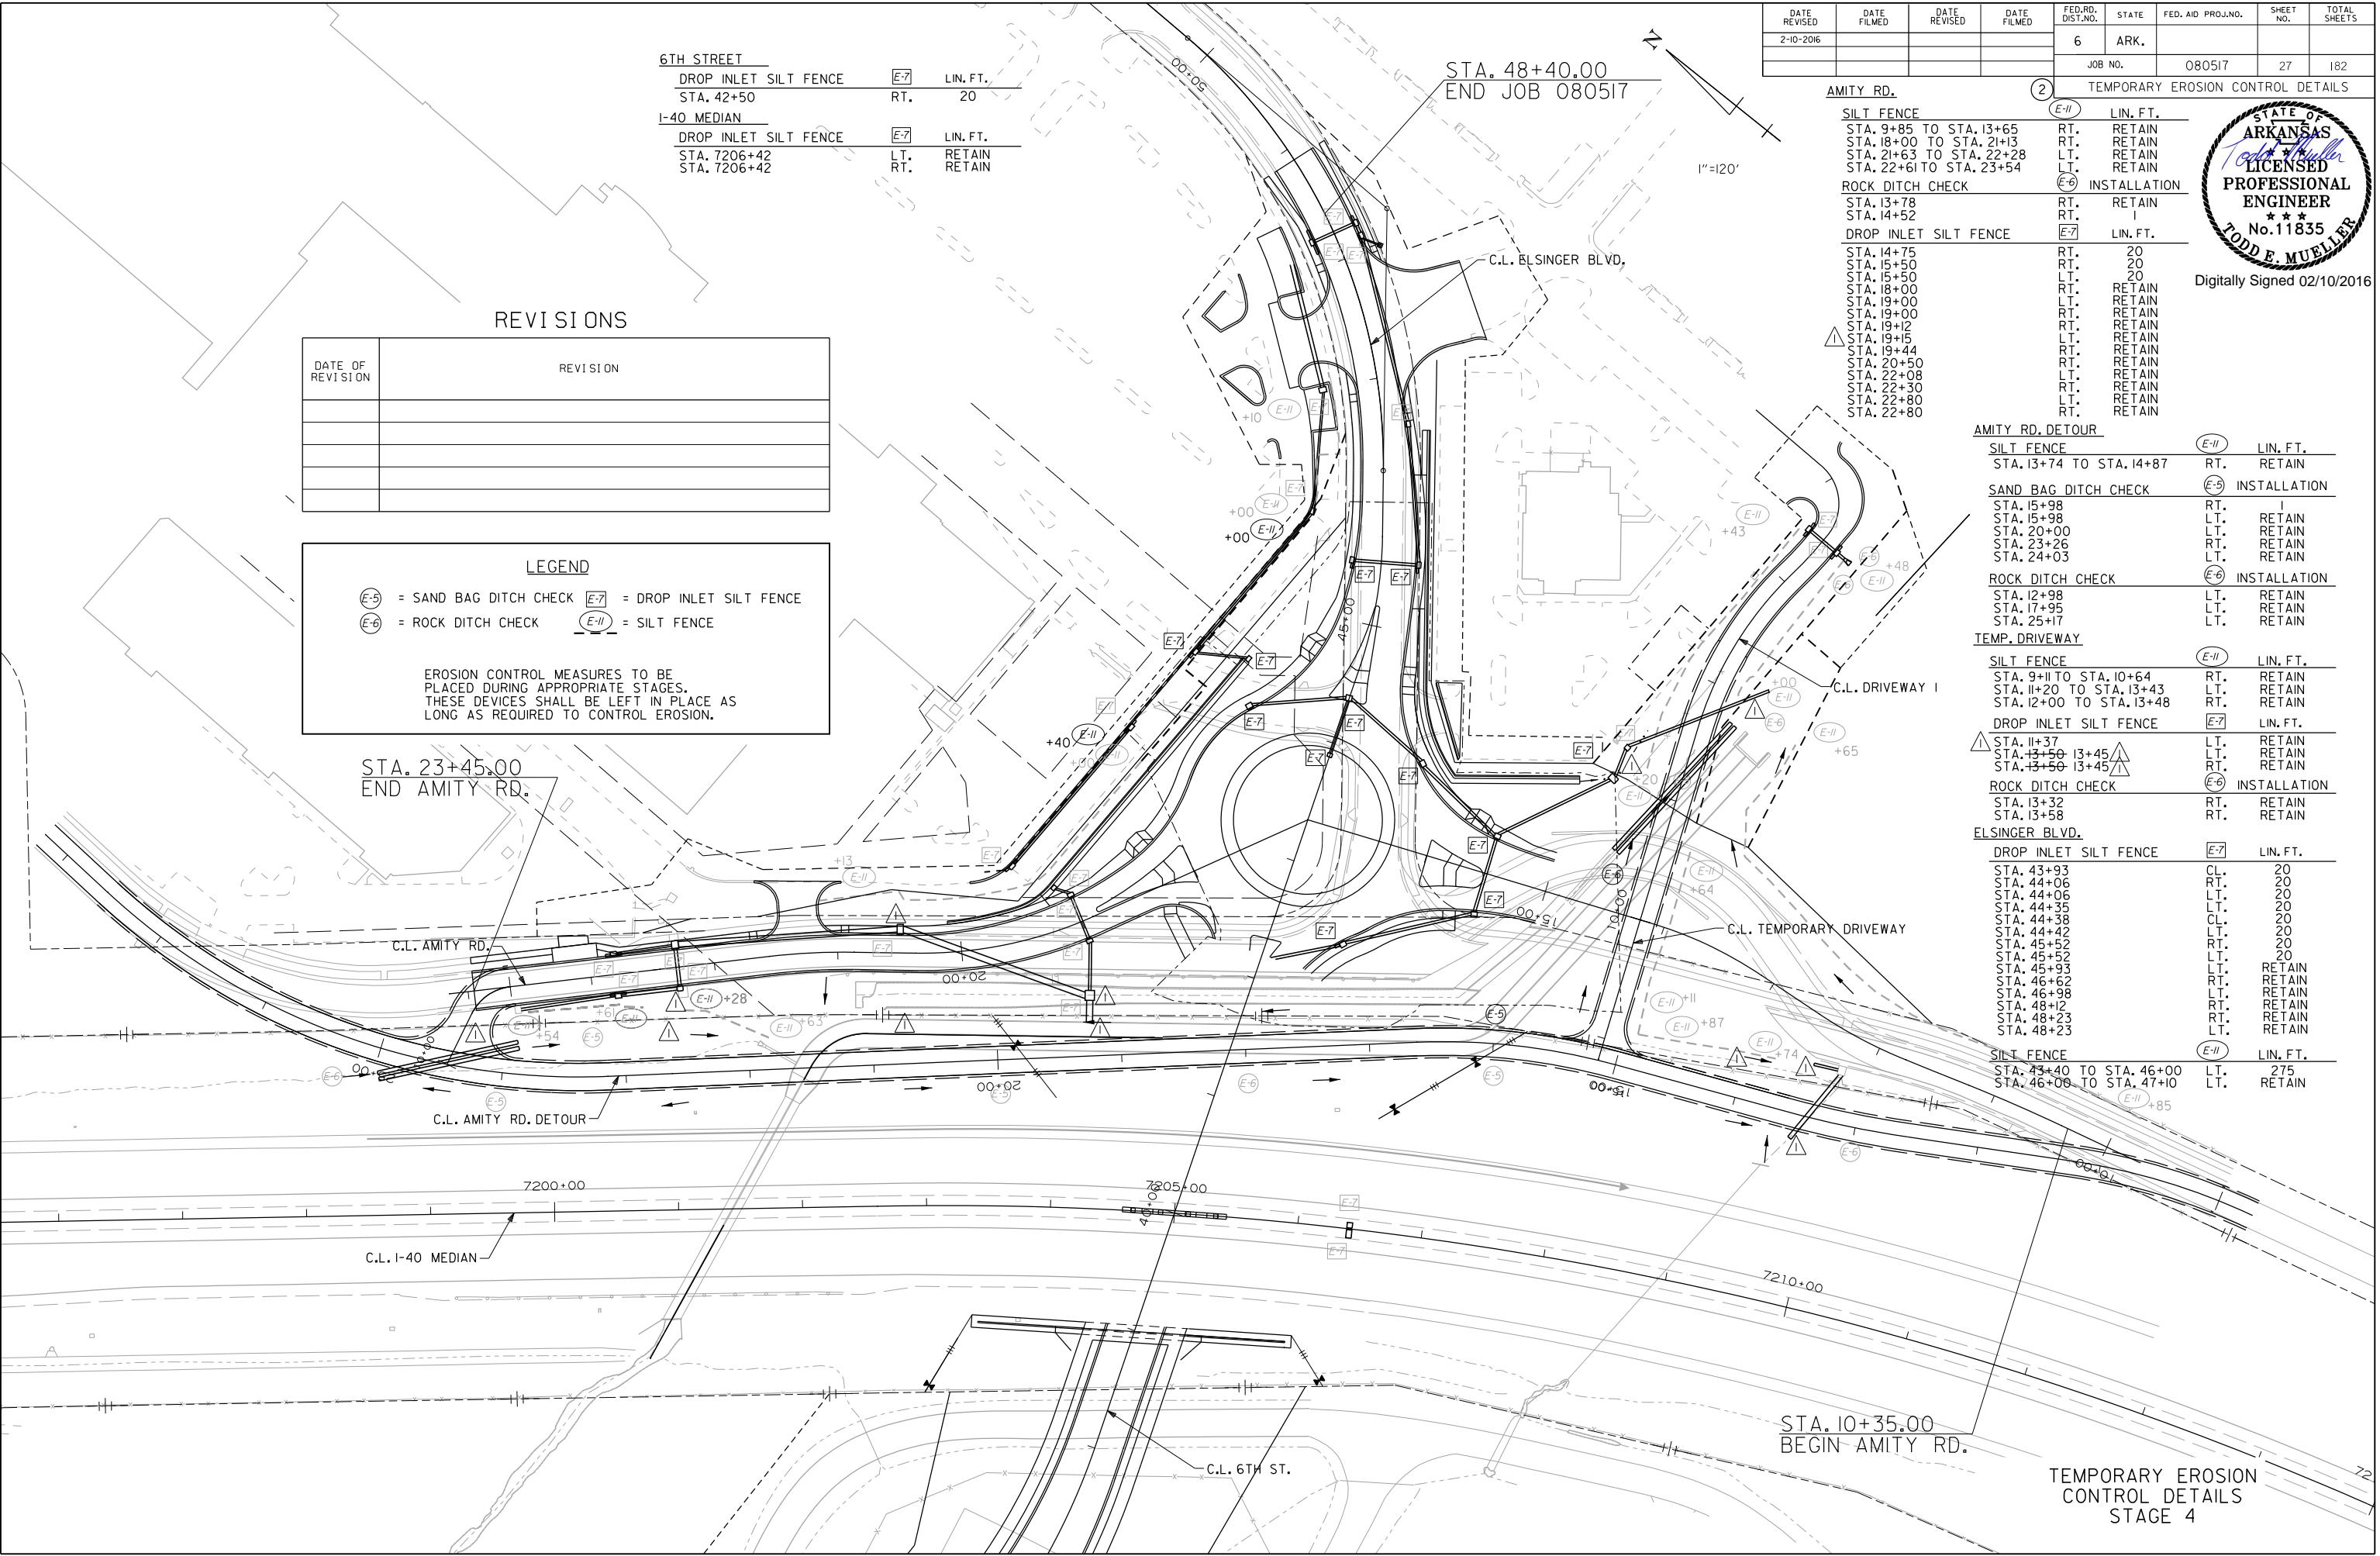

STA. 10+35.00  
BEGIN AMITY RD.

TEMPORARY EROSION CONTROL DETAILS  
STAGE 4

DATE REVISED	DATE FILMED	DATE REVISED	DATE FILMED	FED. RD. DIST. NO.	STATE	FED. AID PROJ. NO.	SHEET NO.	TOTAL SHEETS
2-10-2016				6	ARK.	080517	28	182

AMITY RD. DETOUR (2) TEMPORARY EROSION CONTROL DETAILS



INSTALLATION	RT.	LT.	RETAIN
SAND BAG DITCH CHECK (E-5)	STA. 15+98	RT.	RETAIN
	STA. 15+98	LT.	RETAIN
	STA. 20+00	LT.	RETAIN
	STA. 23+26	RT.	RETAIN
ROCK DITCH CHECK (E-6)	STA. 24+03	LT.	RETAIN
	STA. 12+98	LT.	RETAIN
	STA. 17+95	LT.	RETAIN
INSTALLATION	STA. 25+17	LT.	RETAIN

6TH STREET	I-40 MEDIAN
DROP INLET SILT FENCE (E-7) LIN. FT.	DROP INLET SILT FENCE (E-7) LIN. FT.
STA. 42+50 RT. RETAIN	STA. 7206+42 LT. RETAIN
	STA. 7206+42 RT. RETAIN
	DRIVEWAY I (E-11) LIN. FT.
	SILT FENCE (E-11) LIN. FT.
	STA. 11+01 TO STA. 12+00 RT. 95
	STA. 11+22 TO STA. 11+83 LT. 80
	STA. 12+00 TO STA. 13+48 RT. RETAIN
	STA. 12+26 TO STA. 13+43 LT. RETAIN
	DROP INLET SILT FENCE (E-7) LIN. FT.
	STA. 11+37 LT. RETAIN
	STA. 13+50 13+45 LT. RETAIN
	STA. 13+50 13+45 RT. RETAIN
	ROCK DITCH CHECK (E-6) INSTALLATION
	STA. 13+32 RT. RETAIN
	STA. 13+58 RT. RETAIN

REVISIONS


DATE OF REVISION	REVISION

**LEGEND**

(E-5) = SAND BAG DITCH CHECK (E-7) = DROP INLET SILT FENCE  
(E-6) = ROCK DITCH CHECK (E-11) = SILT FENCE

EROSION CONTROL MEASURES TO BE PLACED DURING APPROPRIATE STAGES. THESE DEVICES SHALL BE LEFT IN PLACE AS LONG AS REQUIRED TO CONTROL EROSION.

AMITY RD.	RT.	LT.	RETAIN
SILT FENCE (E-11) LIN. FT.	STA. 9+85 TO STA. 13+65	RT.	RETAIN
	STA. 18+00 TO STA. 21+13	RT.	RETAIN
	STA. 21+63 TO STA. 22+28	LT.	RETAIN
	STA. 22+61 TO STA. 23+54	LT.	RETAIN
SAND BAG DITCH CHECK (E-5) INSTALLATION	STA. 12+90	LT.	RETAIN
DROP INLET SILT FENCE (E-7) LIN. FT.	STA. 10+46	LT.	20
	STA. 10+46	RT.	20
SILT FENCE (E-11) LIN. FT.	STA. 11+00 10+75	LT.	20
	STA. 11+00 10+77	RT.	20
SILT FENCE (E-11) LIN. FT.	STA. 12+00	LT.	20
	STA. 12+00	RT.	20
SILT FENCE (E-11) LIN. FT.	STA. 14+82	RT.	20
	STA. 14+75	RT.	RETAIN
SILT FENCE (E-11) LIN. FT.	STA. 14+75	RT.	RETAIN
	STA. 15+50	LT.	RETAIN
SILT FENCE (E-11) LIN. FT.	STA. 18+00	LT.	RETAIN
	STA. 19+00	LT.	RETAIN
SILT FENCE (E-11) LIN. FT.	STA. 19+00	RT.	RETAIN
	STA. 19+12	RT.	RETAIN
SILT FENCE (E-11) LIN. FT.	STA. 19+15	LT.	RETAIN
	STA. 19+44	RT.	RETAIN
SILT FENCE (E-11) LIN. FT.	STA. 20+50	RT.	RETAIN
	STA. 22+08	RT.	RETAIN
SILT FENCE (E-11) LIN. FT.	STA. 22+30	RT.	RETAIN
	STA. 22+80	LT.	RETAIN
SILT FENCE (E-11) LIN. FT.	STA. 22+80	RT.	RETAIN
ELSINGER BLVD.			
DROP INLET SILT FENCE (E-7) LIN. FT.	STA. 43+93	CL.	RETAIN
	STA. 44+06	RT.	RETAIN
DROP INLET SILT FENCE (E-7) LIN. FT.	STA. 44+06	LT.	RETAIN
	STA. 44+35	LT.	RETAIN
DROP INLET SILT FENCE (E-7) LIN. FT.	STA. 44+38	CL.	RETAIN
	STA. 44+42	LT.	RETAIN
DROP INLET SILT FENCE (E-7) LIN. FT.	STA. 45+52	RT.	RETAIN
	STA. 45+52	LT.	RETAIN
DROP INLET SILT FENCE (E-7) LIN. FT.	STA. 45+93	LT.	RETAIN
	STA. 46+92	RT.	RETAIN
DROP INLET SILT FENCE (E-7) LIN. FT.	STA. 46+98	LT.	RETAIN
	STA. 48+12	RT.	RETAIN
DROP INLET SILT FENCE (E-7) LIN. FT.	STA. 48+23	RT.	RETAIN
	STA. 48+23	LT.	RETAIN
SILT FENCE (E-11) LIN. FT.	STA. 43+40 TO STA. 47+10	LT.	RETAIN

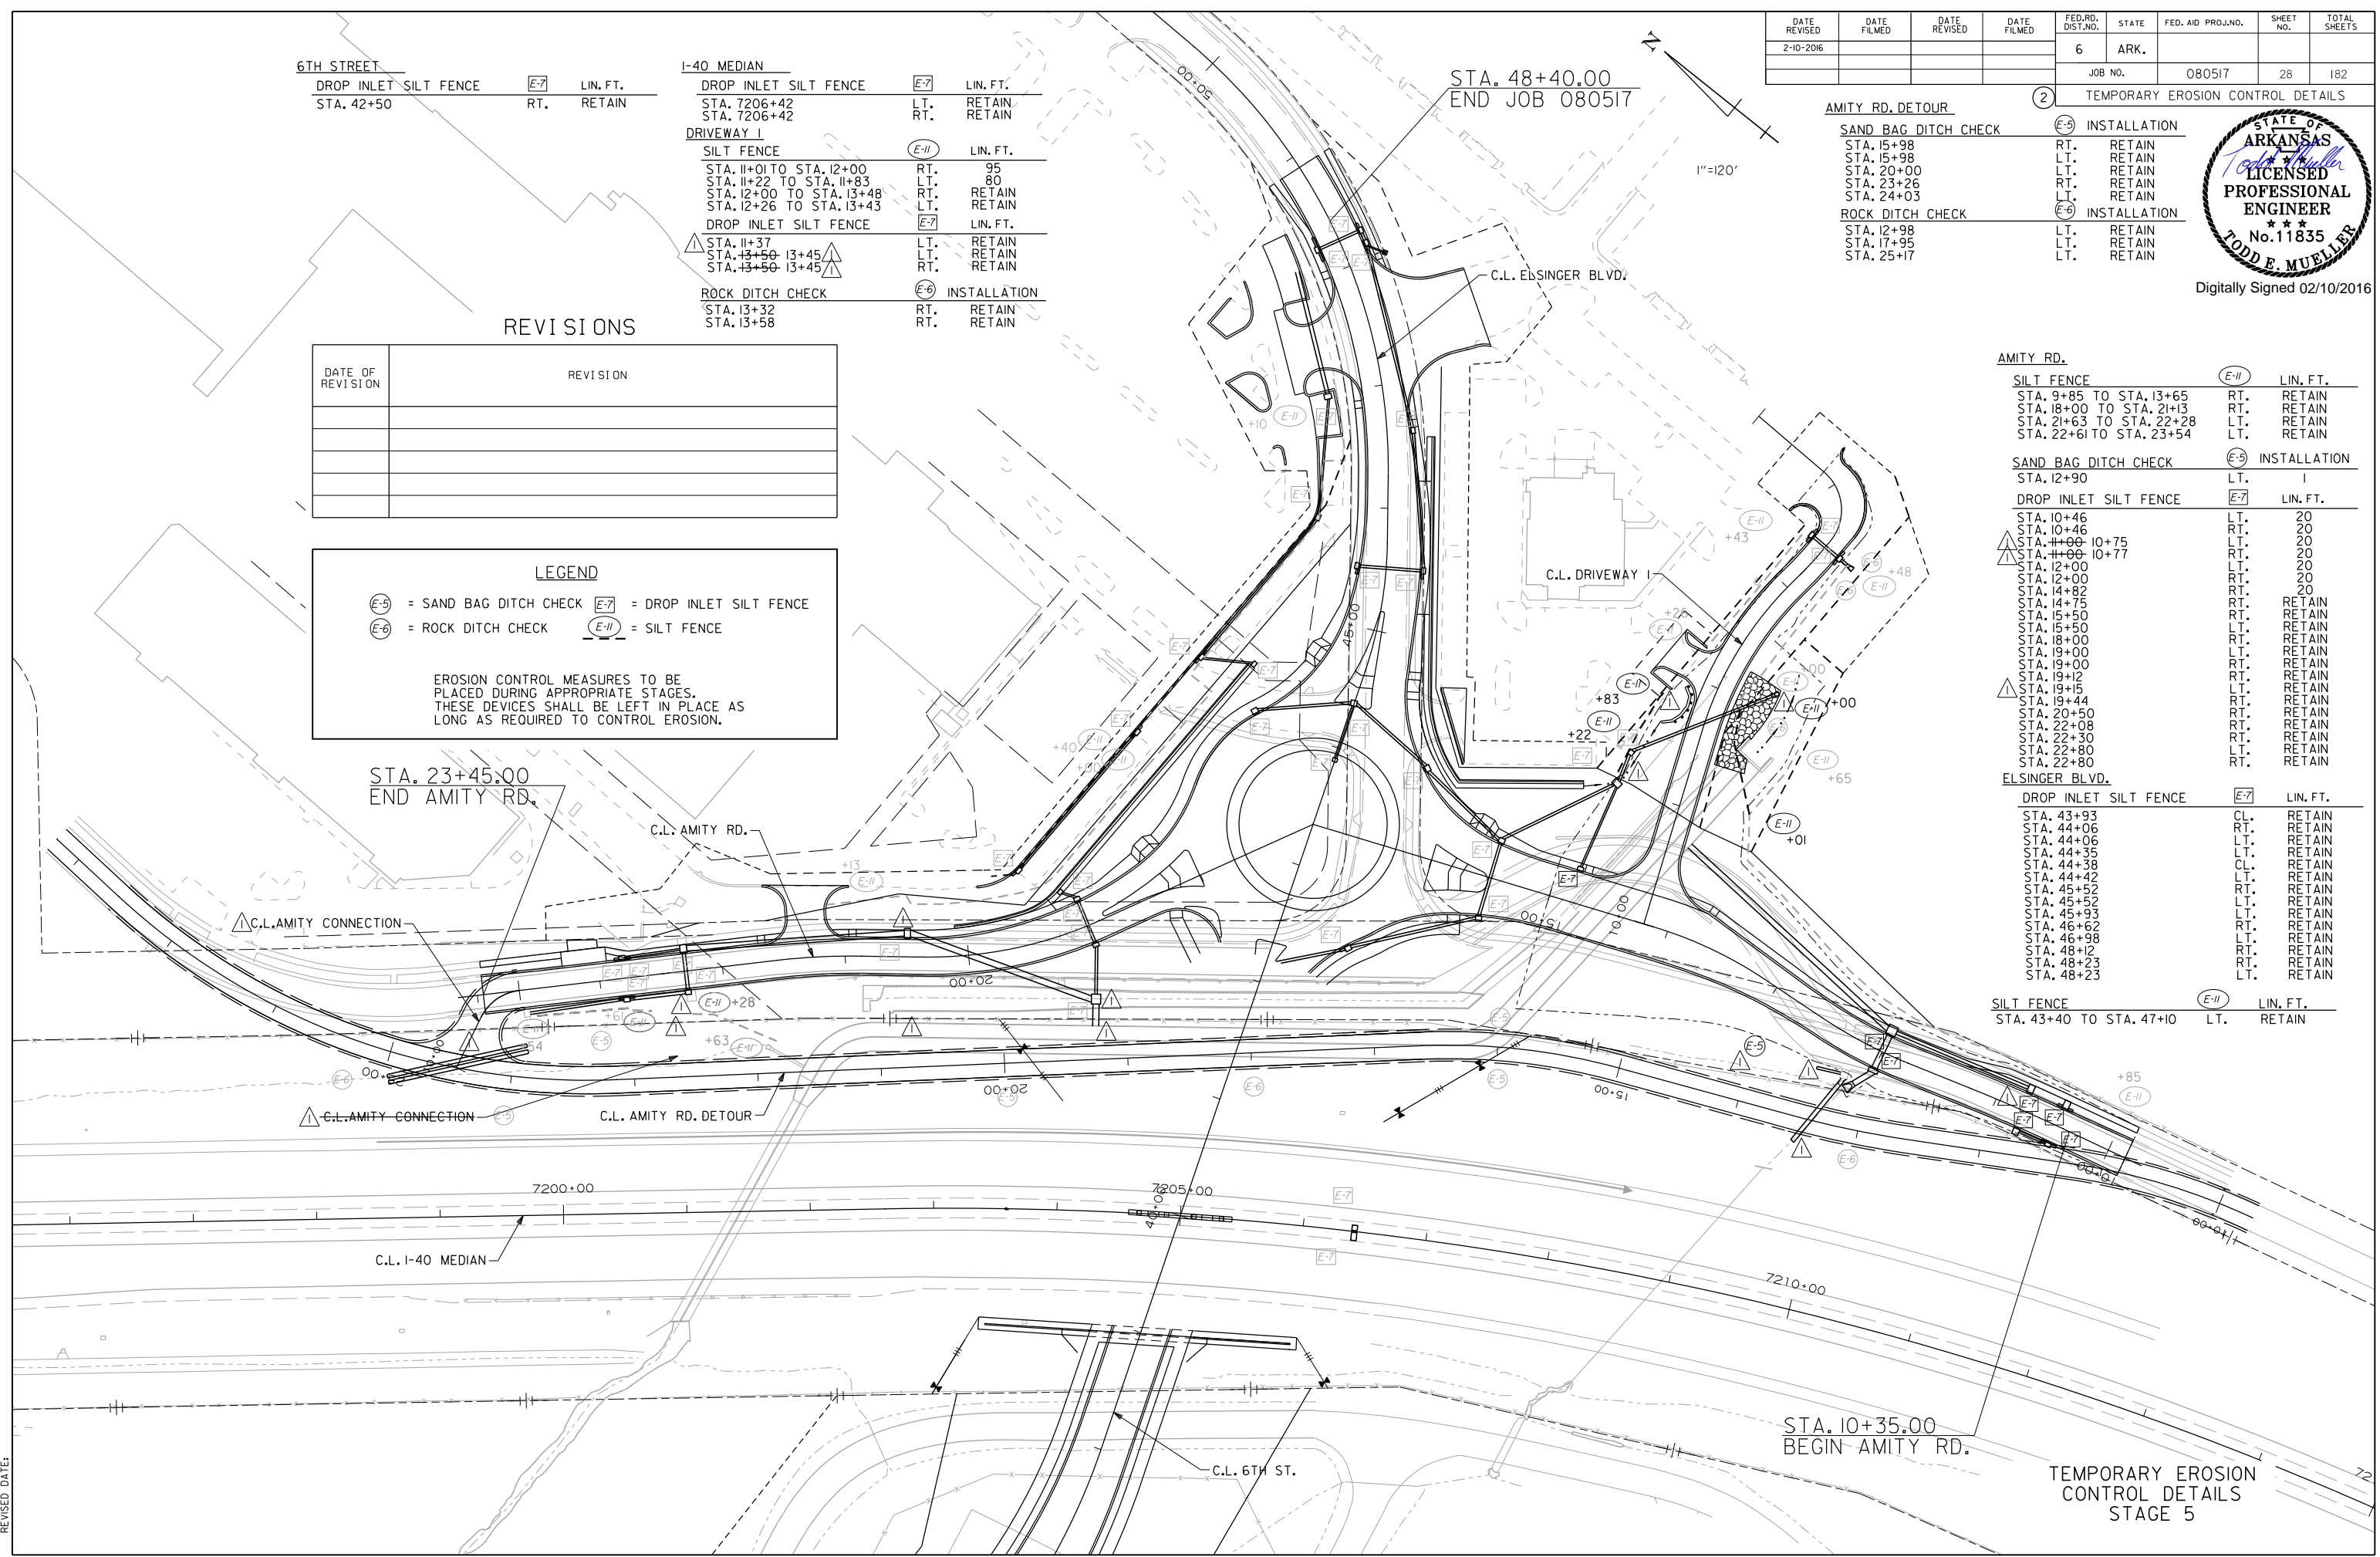

2/10/2016 4:33:54 PM  
 WORKSPACE: AHTD  
 L:\2012\1201590 - Contr-ell\field Access\Drawings\6TH\_ST\6TH\_EC\_PRJ2\_ST05\_6TH\_01.dgn  
 REVISION DATE:

DATE REVISED	DATE FILMED	DATE REVISED	DATE FILMED	FED. RD. DIST. NO.	STATE	FED. AID PROJ. NO.	SHEET NO.	TOTAL SHEETS
2-10-2016				6	ARK.	080517	29	182

AMITY RD. DETOUR		TEMPORARY EROSION CONTROL DETAILS	
SAND BAG DITCH CHECK	(E-5) INSTALLATION	RT.	RETAIN
STA. 15+98		LT.	RETAIN
STA. 15+98		LT.	RETAIN
STA. 20+00		RT.	RETAIN
STA. 23+26		LT.	RETAIN
STA. 24+03		LT.	RETAIN
ROCK DITCH CHECK	(E-6) INSTALLATION	LT.	RETAIN
STA. 12+98		LT.	RETAIN
STA. 25+17			



Digitally Signed 02/10/2016


6TH STREET				I-40 MEDIAN			
DROP INLET SILT FENCE	(E-7)	LIN. FT.		DROP INLET SILT FENCE	(E-7)	LIN. FT.	
STA. 41+50		LT.	20	STA. 7206+42		LT.	RETAIN
STA. 41+50		RT.	20	STA. 7206+42		RT.	RETAIN
STA. 41+95		LT.	20				
STA. 42+50		RT.	RETAIN				

DATE OF REVISION	REVISION

**LEGEND**

(E-5) = SAND BAG DITCH CHECK    (E-7) = DROP INLET SILT FENCE  
(E-6) = ROCK DITCH CHECK        (E-11) = SILT FENCE

EROSION CONTROL MEASURES TO BE PLACED DURING APPROPRIATE STAGES. THESE DEVICES SHALL BE LEFT IN PLACE AS LONG AS REQUIRED TO CONTROL EROSION.

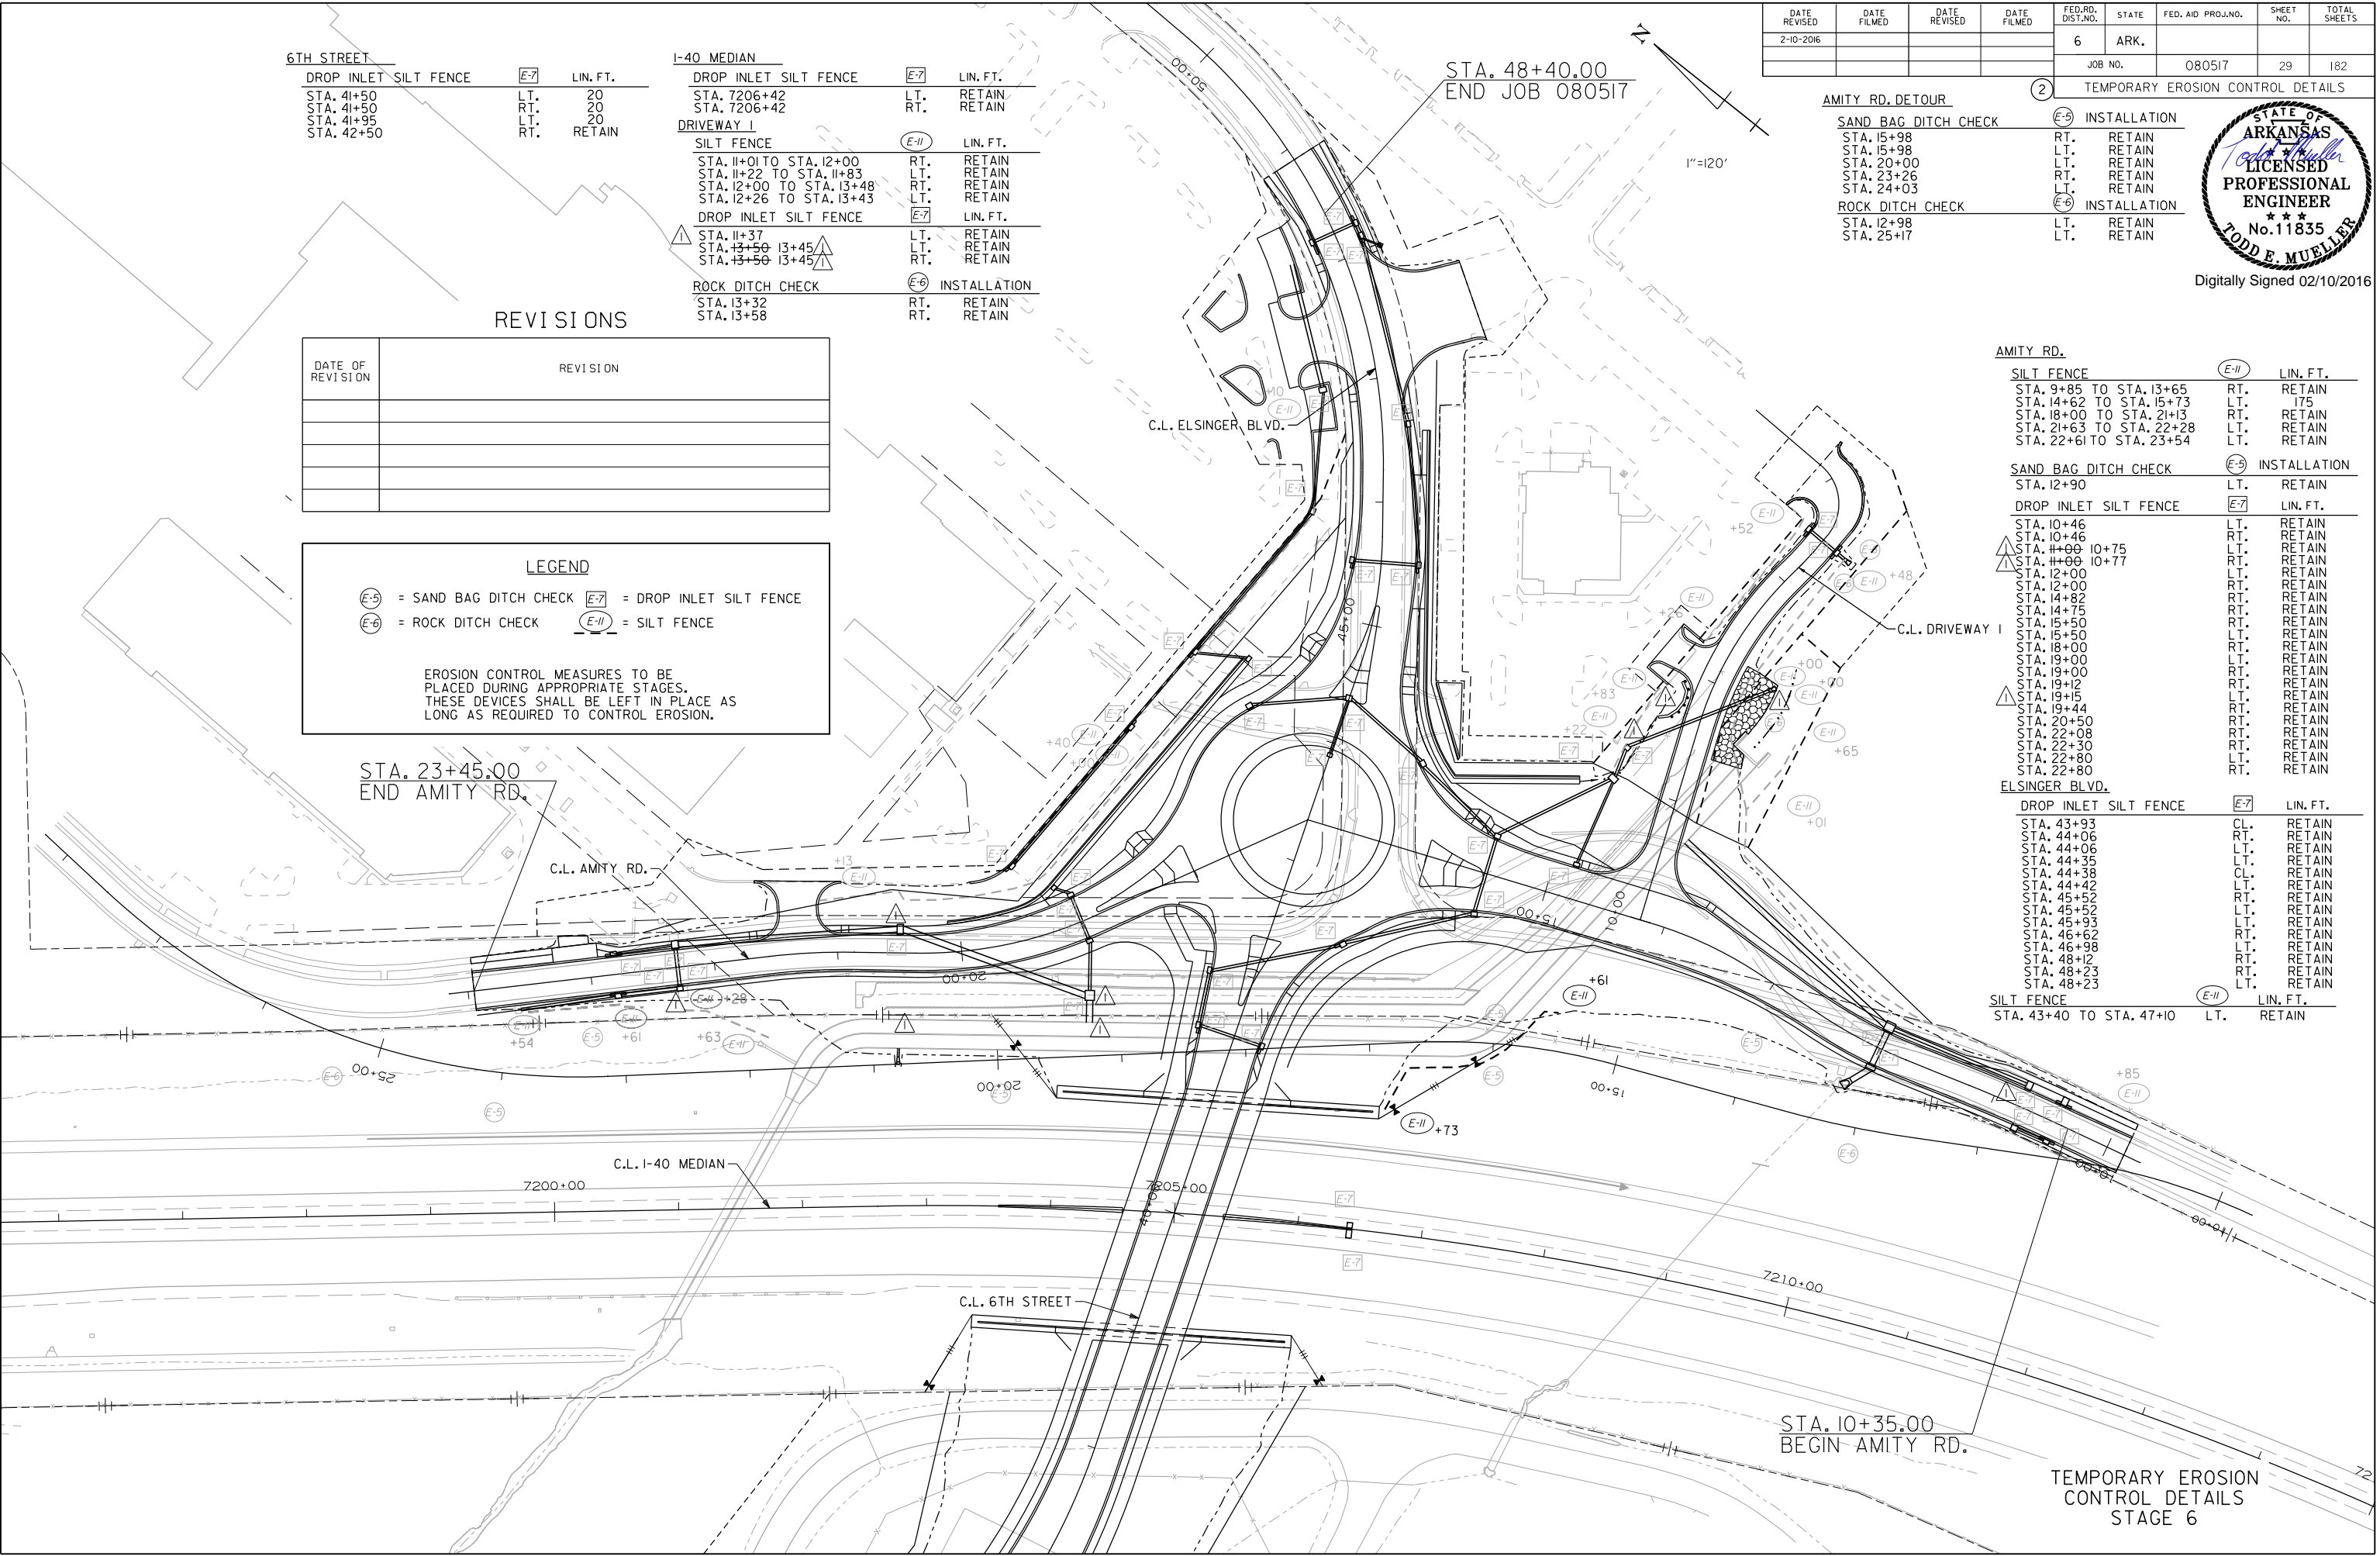


AMITY RD.			
SILT FENCE	(E-11)	LIN. FT.	
STA. 9+85 TO STA. 13+65		RT.	RETAIN
STA. 14+62 TO STA. 15+73		LT.	RETAIN
STA. 18+00 TO STA. 21+13		RT.	RETAIN
STA. 21+63 TO STA. 22+28		LT.	RETAIN
STA. 22+61 TO STA. 23+54		LT.	RETAIN
SAND BAG DITCH CHECK	(E-5) INSTALLATION	LT.	RETAIN
STA. 12+90			
DROP INLET SILT FENCE	(E-7)	LIN. FT.	
STA. 10+46		LT.	RETAIN
STA. 10+46		RT.	RETAIN
STA. 11+00		LT.	RETAIN
STA. 11+00		RT.	RETAIN
STA. 12+00		LT.	RETAIN
STA. 12+00		RT.	RETAIN
STA. 14+82		RT.	RETAIN
STA. 14+75		RT.	RETAIN
STA. 15+50		LT.	RETAIN
STA. 15+50		RT.	RETAIN
STA. 18+00		LT.	RETAIN
STA. 19+00		LT.	RETAIN
STA. 19+00		RT.	RETAIN
STA. 19+12		RT.	RETAIN
STA. 19+15		LT.	RETAIN
STA. 19+44		RT.	RETAIN
STA. 20+50		RT.	RETAIN
STA. 22+08		RT.	RETAIN
STA. 22+30		RT.	RETAIN
STA. 22+80		LT.	RETAIN
STA. 22+80		RT.	RETAIN
ELSINGER BLVD.			
DROP INLET SILT FENCE	(E-7)	LIN. FT.	
STA. 43+93		CL.	RETAIN
STA. 44+06		RT.	RETAIN
STA. 44+06		LT.	RETAIN
STA. 44+35		LT.	RETAIN
STA. 44+38		CL.	RETAIN
STA. 44+42		LT.	RETAIN
STA. 45+52		RT.	RETAIN
STA. 45+52		LT.	RETAIN
STA. 45+93		LT.	RETAIN
STA. 46+62		RT.	RETAIN
STA. 46+98		LT.	RETAIN
STA. 48+12		RT.	RETAIN
STA. 48+23		RT.	RETAIN
STA. 48+23		LT.	RETAIN
SILT FENCE	(E-11)	LIN. FT.	
STA. 43+40 TO STA. 47+10		LT.	RETAIN

2/10/2016 4:33:55 PM  
 WORKSPACE: AHTD  
 L:\2012\1201590 - Contr-ell\field Access\Drawings\6TH\_ST\6TH\_EC\_PUJ2\_ST06\_6TH\_01.dgn  
 REVISION DATE:


TEMPORARY EROSION CONTROL DETAILS  
 STAGE 6

DATE REVISED	DATE FILMED	DATE REVISED	DATE FILMED	FED. RD. DIST. NO.	STATE	FED. AID PROJ. NO.	SHEET NO.	TOTAL SHEETS
				6	ARK.			
				JOB NO.	080517	30	182	

2 MAINTENANCE OF TRAFFIC DETAILS

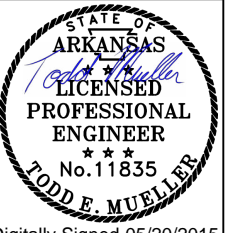

NOTE :  
W20-1 (VARIOUS DISTANCE) ADVANCE SIGNS  
TO BE REPLACED AS NEEDED BY EQUIVALENT W20-5 SIGNS  
AS WORKING AREA SHIFTS.

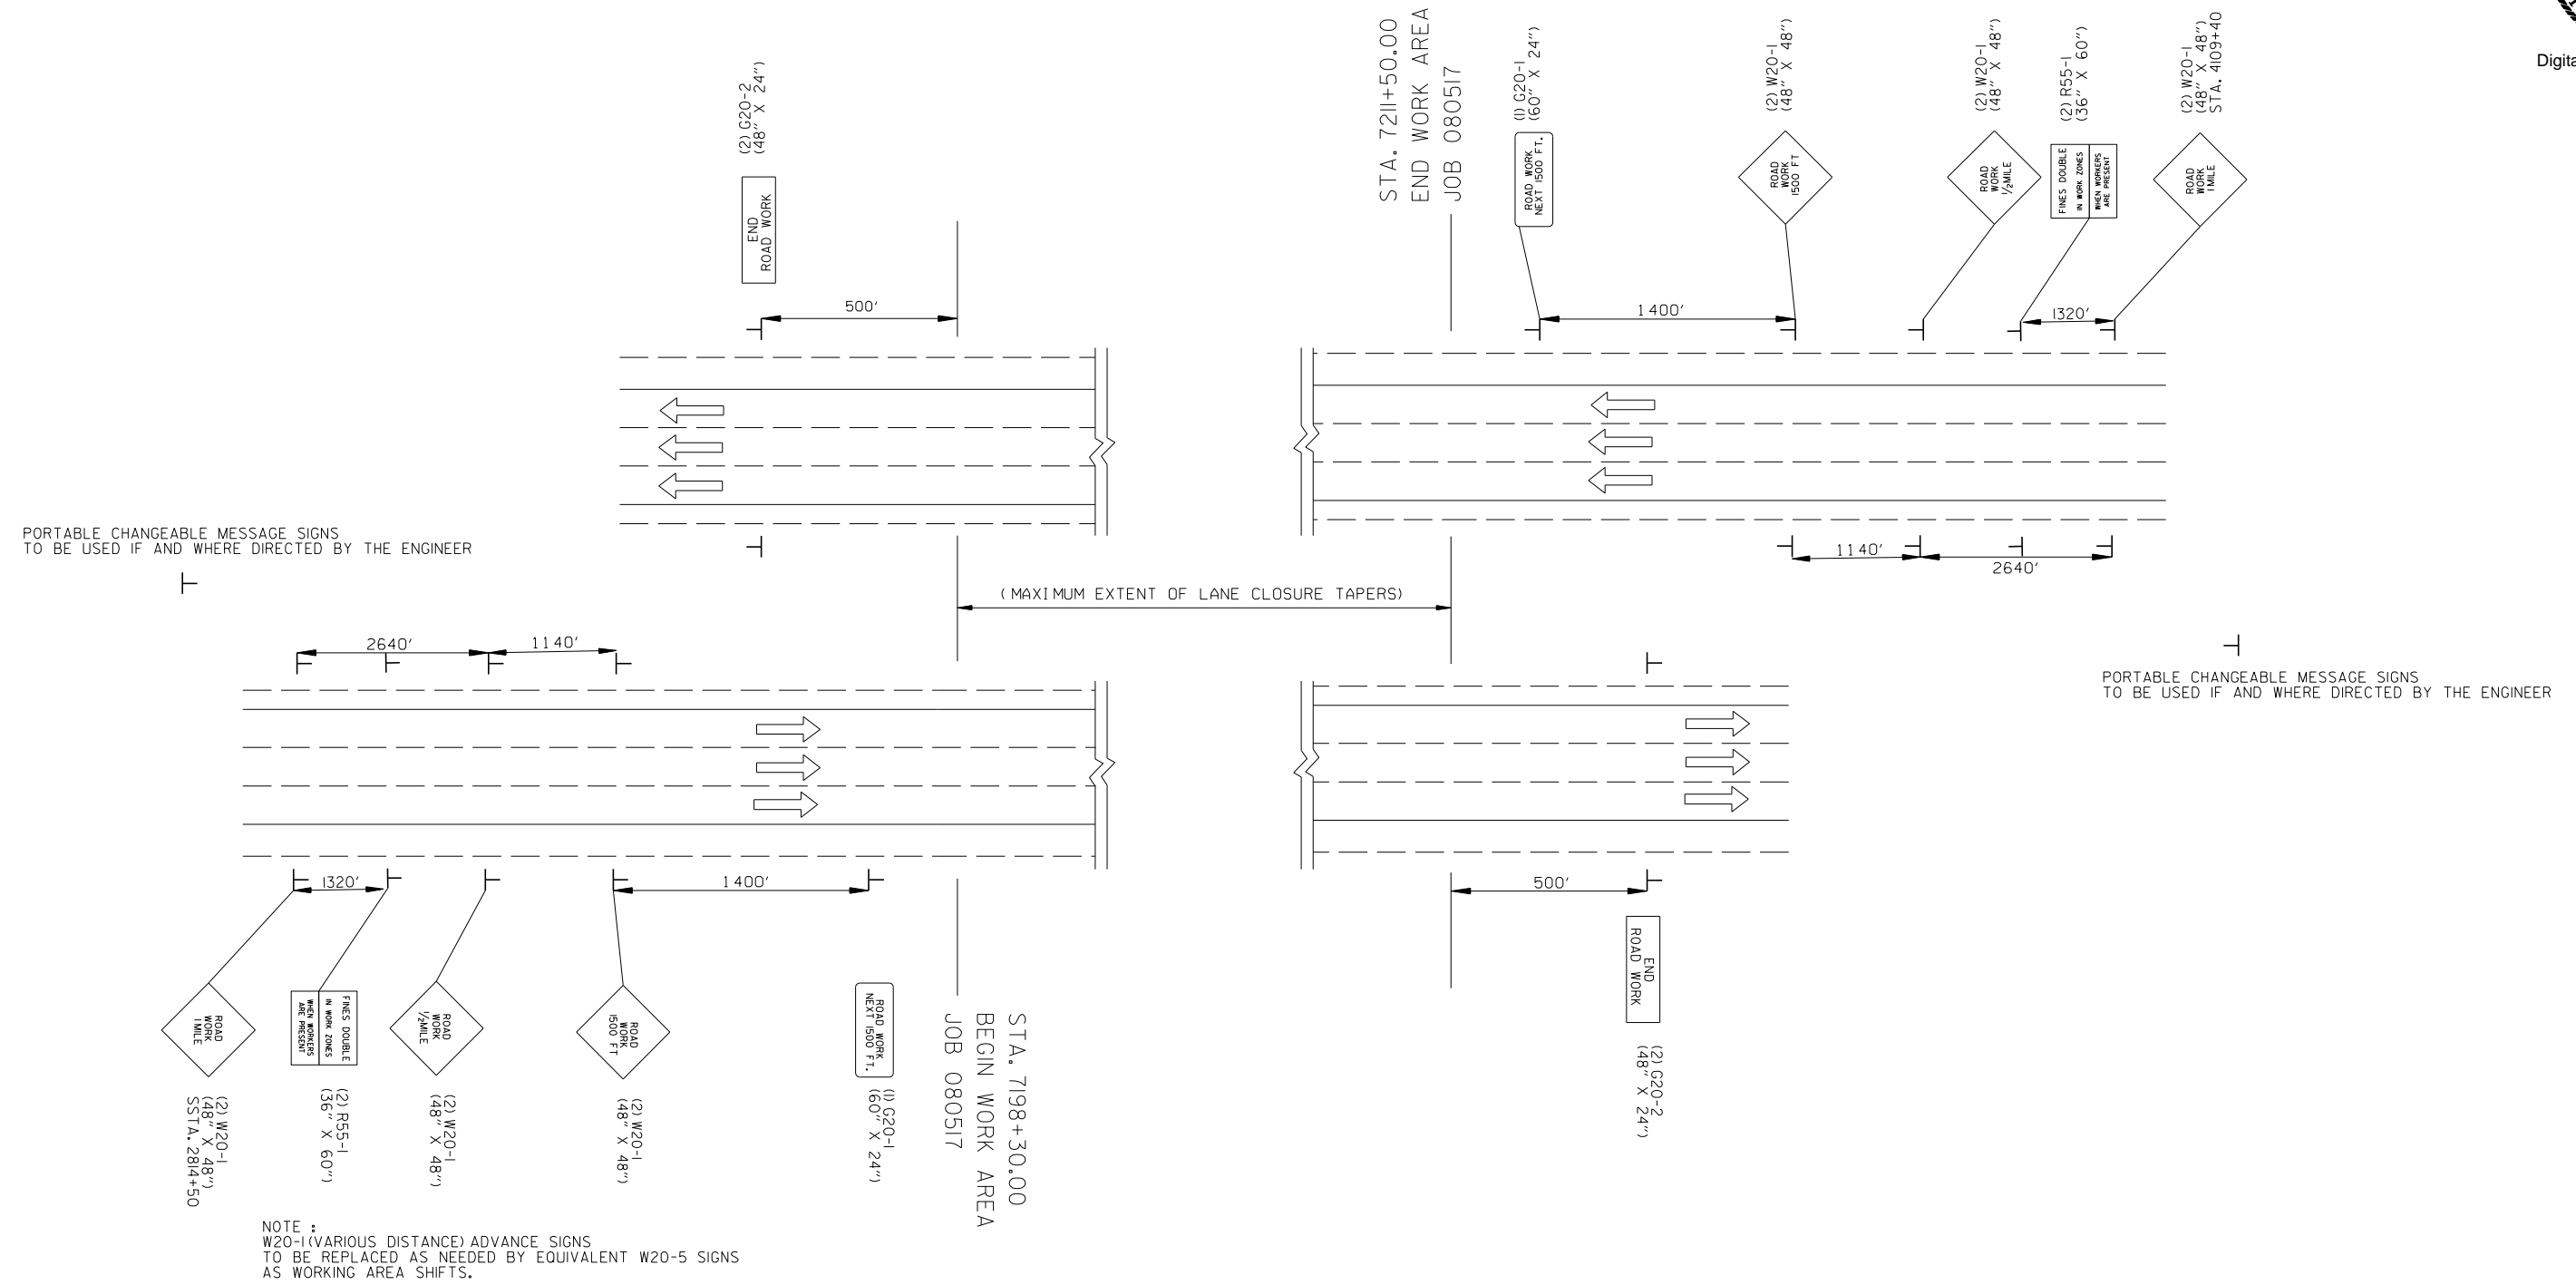

ADVANCE SIGNS AT BEGINNING AND END OF JOB  
ALL STAGES

MAINTENANCE OF TRAFFIC DETAILS  
ADVANCE SIGNS AT JOB ENDS

5/20/2015 7:13:09 AM  
 WORKSPACE: AHTD  
 L:\2012\201550 - ContrailField Access\Drawings\6TH\_ST\6TH.MOT\_PRR2\_5D\_01.dgn  
 REVISED DATE:

DATE REVISED	DATE FILMED	DATE REVISED	DATE FILMED	FED. RD. DIST. NO.	STATE	FED. AID PROJ. NO.	SHEET NO.	TOTAL SHEETS
2-10-2016				6	ARK.		31	182
				JOB NO.		080517		

2 MAINTENANCE OF TRAFFIC DETAILS



Digitally Signed 02/10/2016

- STAGE I  
CONSTRUCTION SEQUENCE NOTES**
1. MAINTAIN TRAFFIC ON EXISTING AMITY RD., AND AMITY RD. DETOUR EAST.
  2. CONSTRUCT AMITY RD. DETOUR AND ELSINGER BLVD. STA. 46+00 TO STA. 48+40 AMITY RD. CONNECTION AS SHOWN ON THE PLANS.
  3. PLACE CONSTRUCTION PAVEMENT MARKINGS AND REMOVABLE CONSTRUCTION PAVEMENT MARKINGS SHOWN FOR STAGE 2 TRAFFIC CONFIGURATION.

TRAFFIC DRUMS @ 30' O.C. = 6 EACH  
AMITY RD. STA. 24+60 TO STA. 26+00

TRAFFIC DRUMS @ 30' O.C. = 6 EACH  
AMITY RD. STA. 9+15 TO STA. 10+70


**C.L. AMITY RD. DETOUR**  
P.I. = 13+07.17  
Δ = 6°59'58" RT.  
D = 7°00'00"  
T = 50.06'  
L = 99.99'  
P.C. = 12+57.11  
P.T. = 13+57.10  
e = NO SUPER  
Ls = N/A

**C.L. AMITY RD. DETOUR**  
P.I. = 10+67.54  
Δ = 14°48'46" LT.  
D = 11°00'00"  
T = 65.40'  
L = 130.42'  
P.C. = 10+02.14  
P.T. = 11+32.25  
e = NO SUPER  
Ls = N/A

STA. 23+45.00  
END AMITY RD.

END ROAD WORK  
(I) G20-2  
(48" X 24")  
STA. 48+40.00  
END JOB 080517

STA. 10+35.00  
BEGIN AMITY RD.

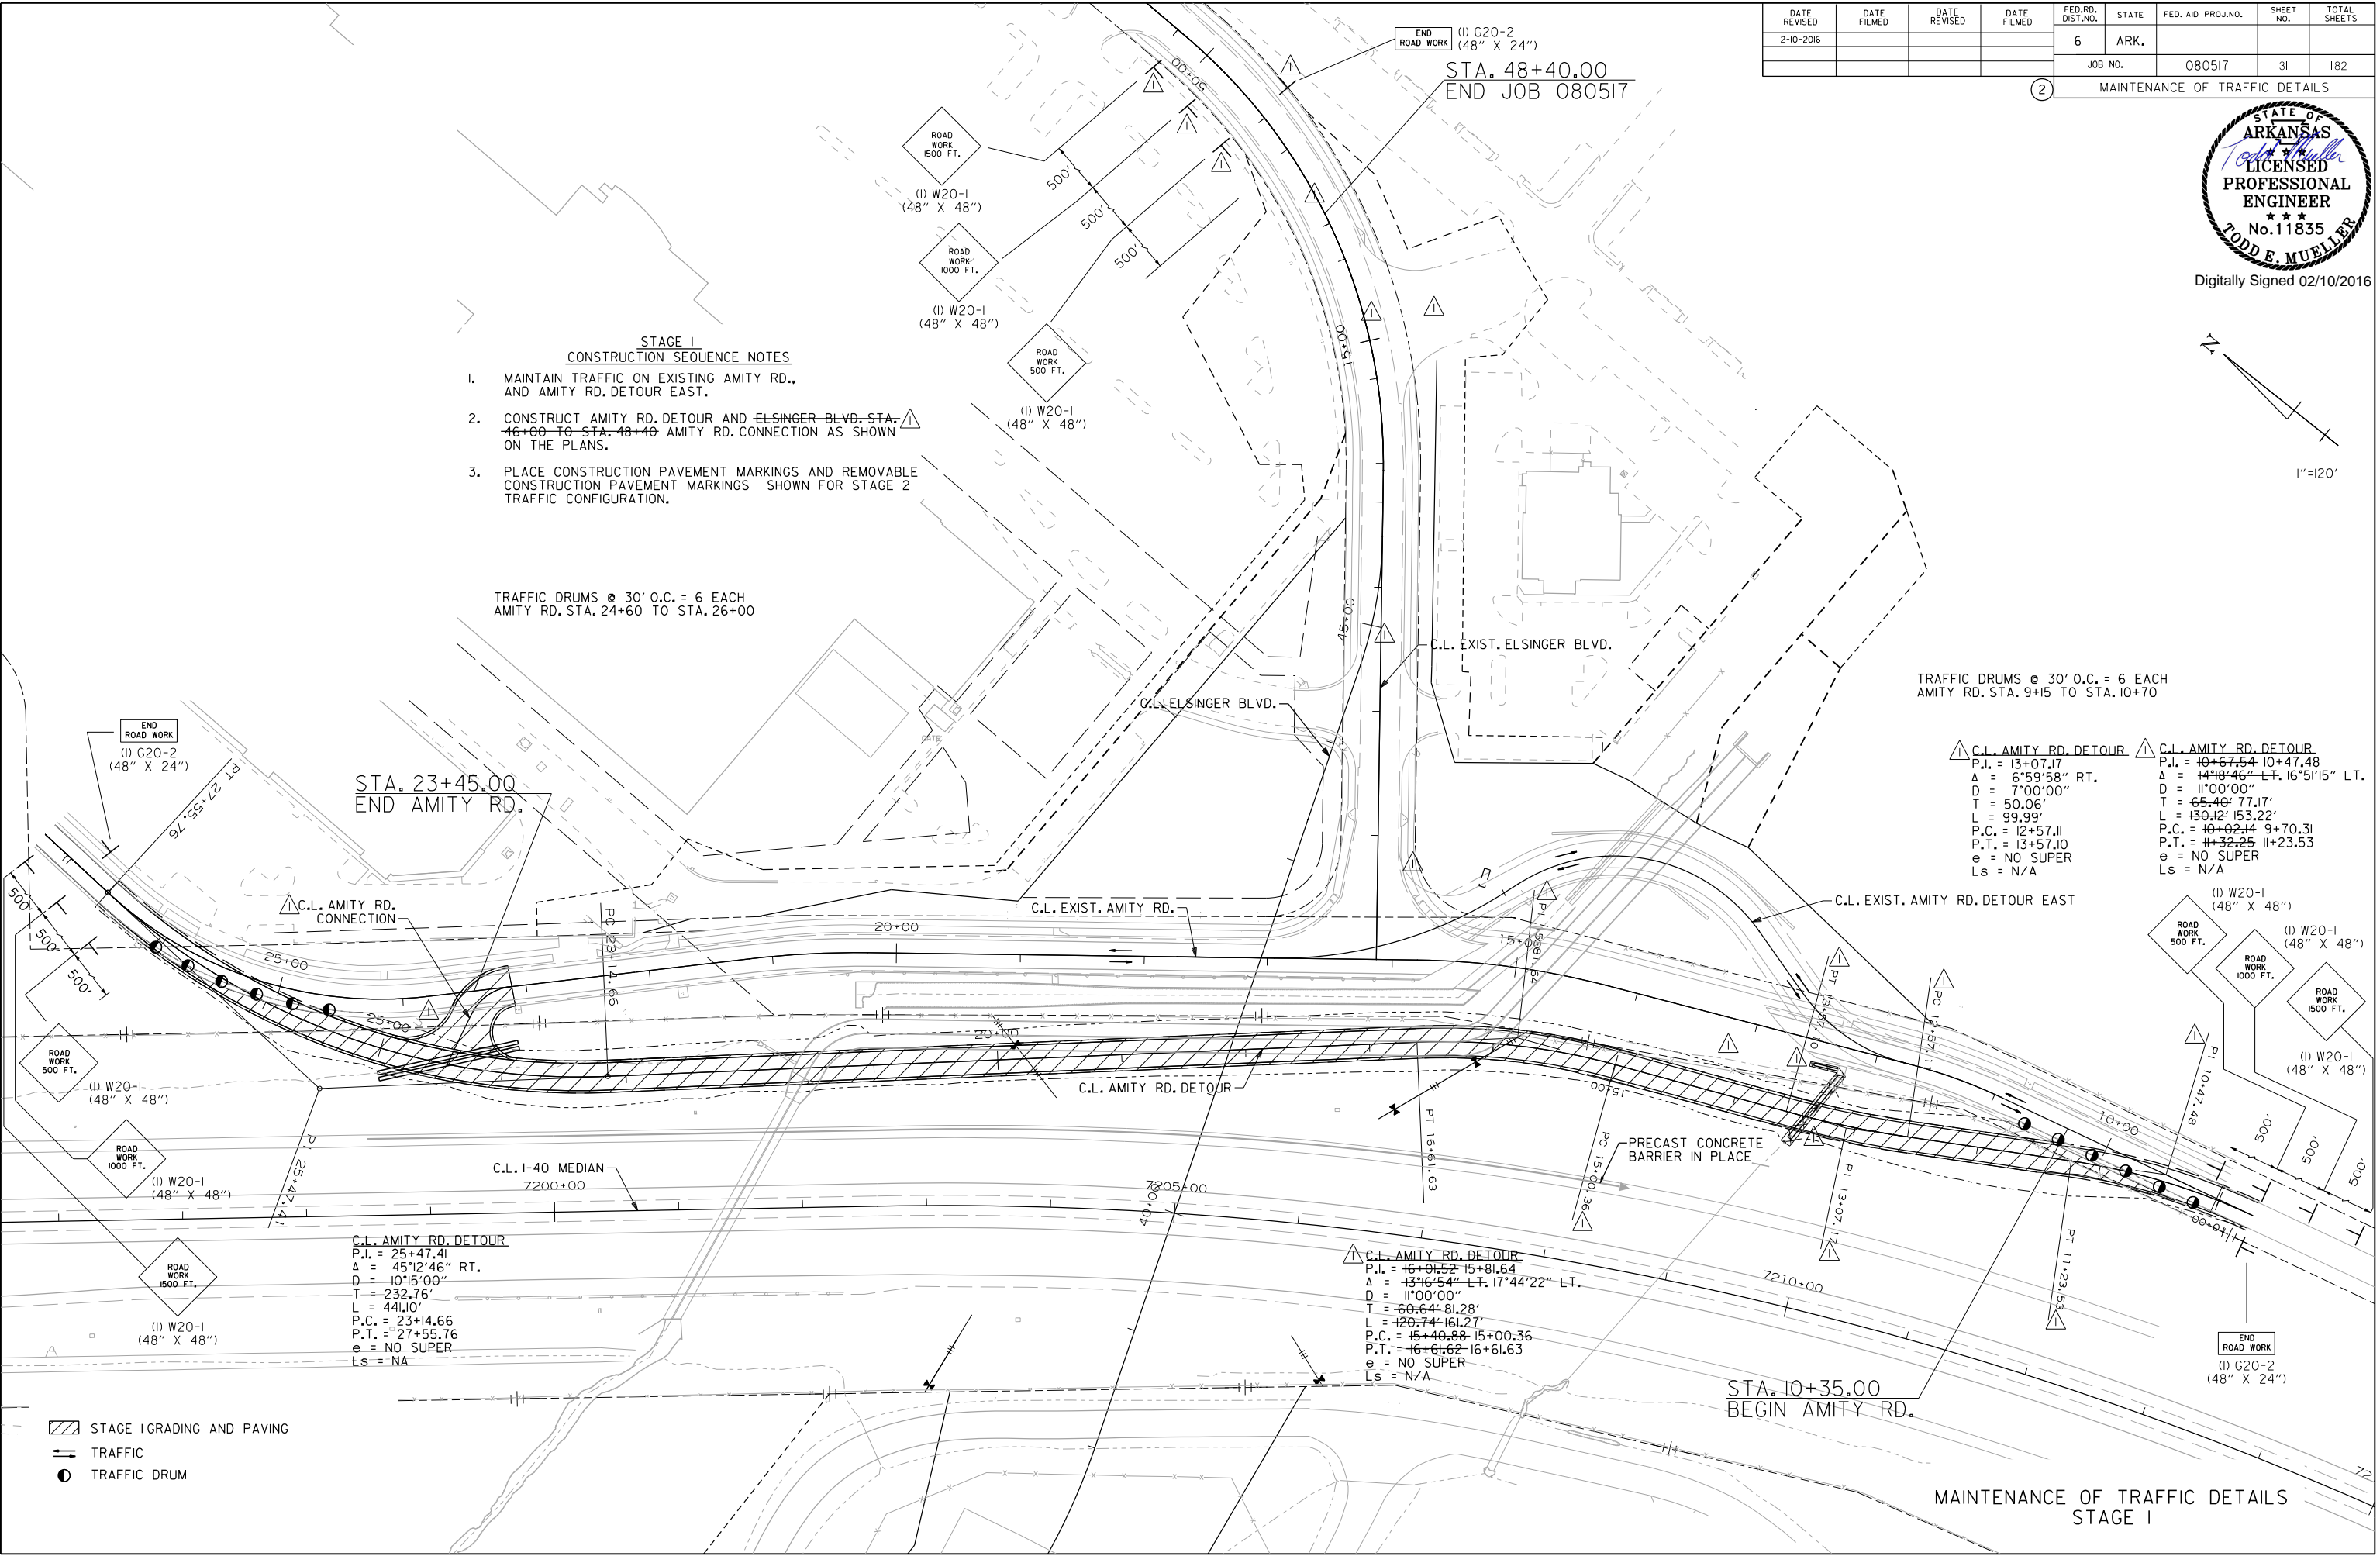

- STAGE I GRADING AND PAVING
- TRAFFIC
- TRAFFIC DRUM

**C.L. AMITY RD. DETOUR**  
P.I. = 25+47.41  
Δ = 45°12'46" RT.  
D = 10°15'00"  
T = 232.76'  
L = 441.10'  
P.C. = 23+14.66  
P.T. = 27+55.76  
e = NO SUPER  
Ls = NA

**C.L. AMITY RD. DETOUR**  
P.I. = 16+01.52  
Δ = 13°16'54" LT.  
D = 11°00'00"  
T = 60.64'  
L = 120.74'  
P.C. = 15+40.88  
P.T. = 16+61.62  
e = NO SUPER  
Ls = N/A


2/10/2016 4:33:55 PM  
 WORKSPACE: AHTD  
 L:\2012\1201550 - Contr\ell\field Access\Drawings\6TH\_ST\6TH\_MOT\_PRJ2\_STG1\_6TH\_01.dgn  
 REVISED DATE:

DATE REVISED	DATE FILMED	DATE REVISED	DATE FILMED	FED. RD. DIST. NO.	STATE	FED. AID PROJ. NO.	SHEET NO.	TOTAL SHEETS
2-10-2016				6	ARK.		32	182

2 MAINTENANCE OF TRAFFIC DETAILS



Digitally Signed 02/10/2016

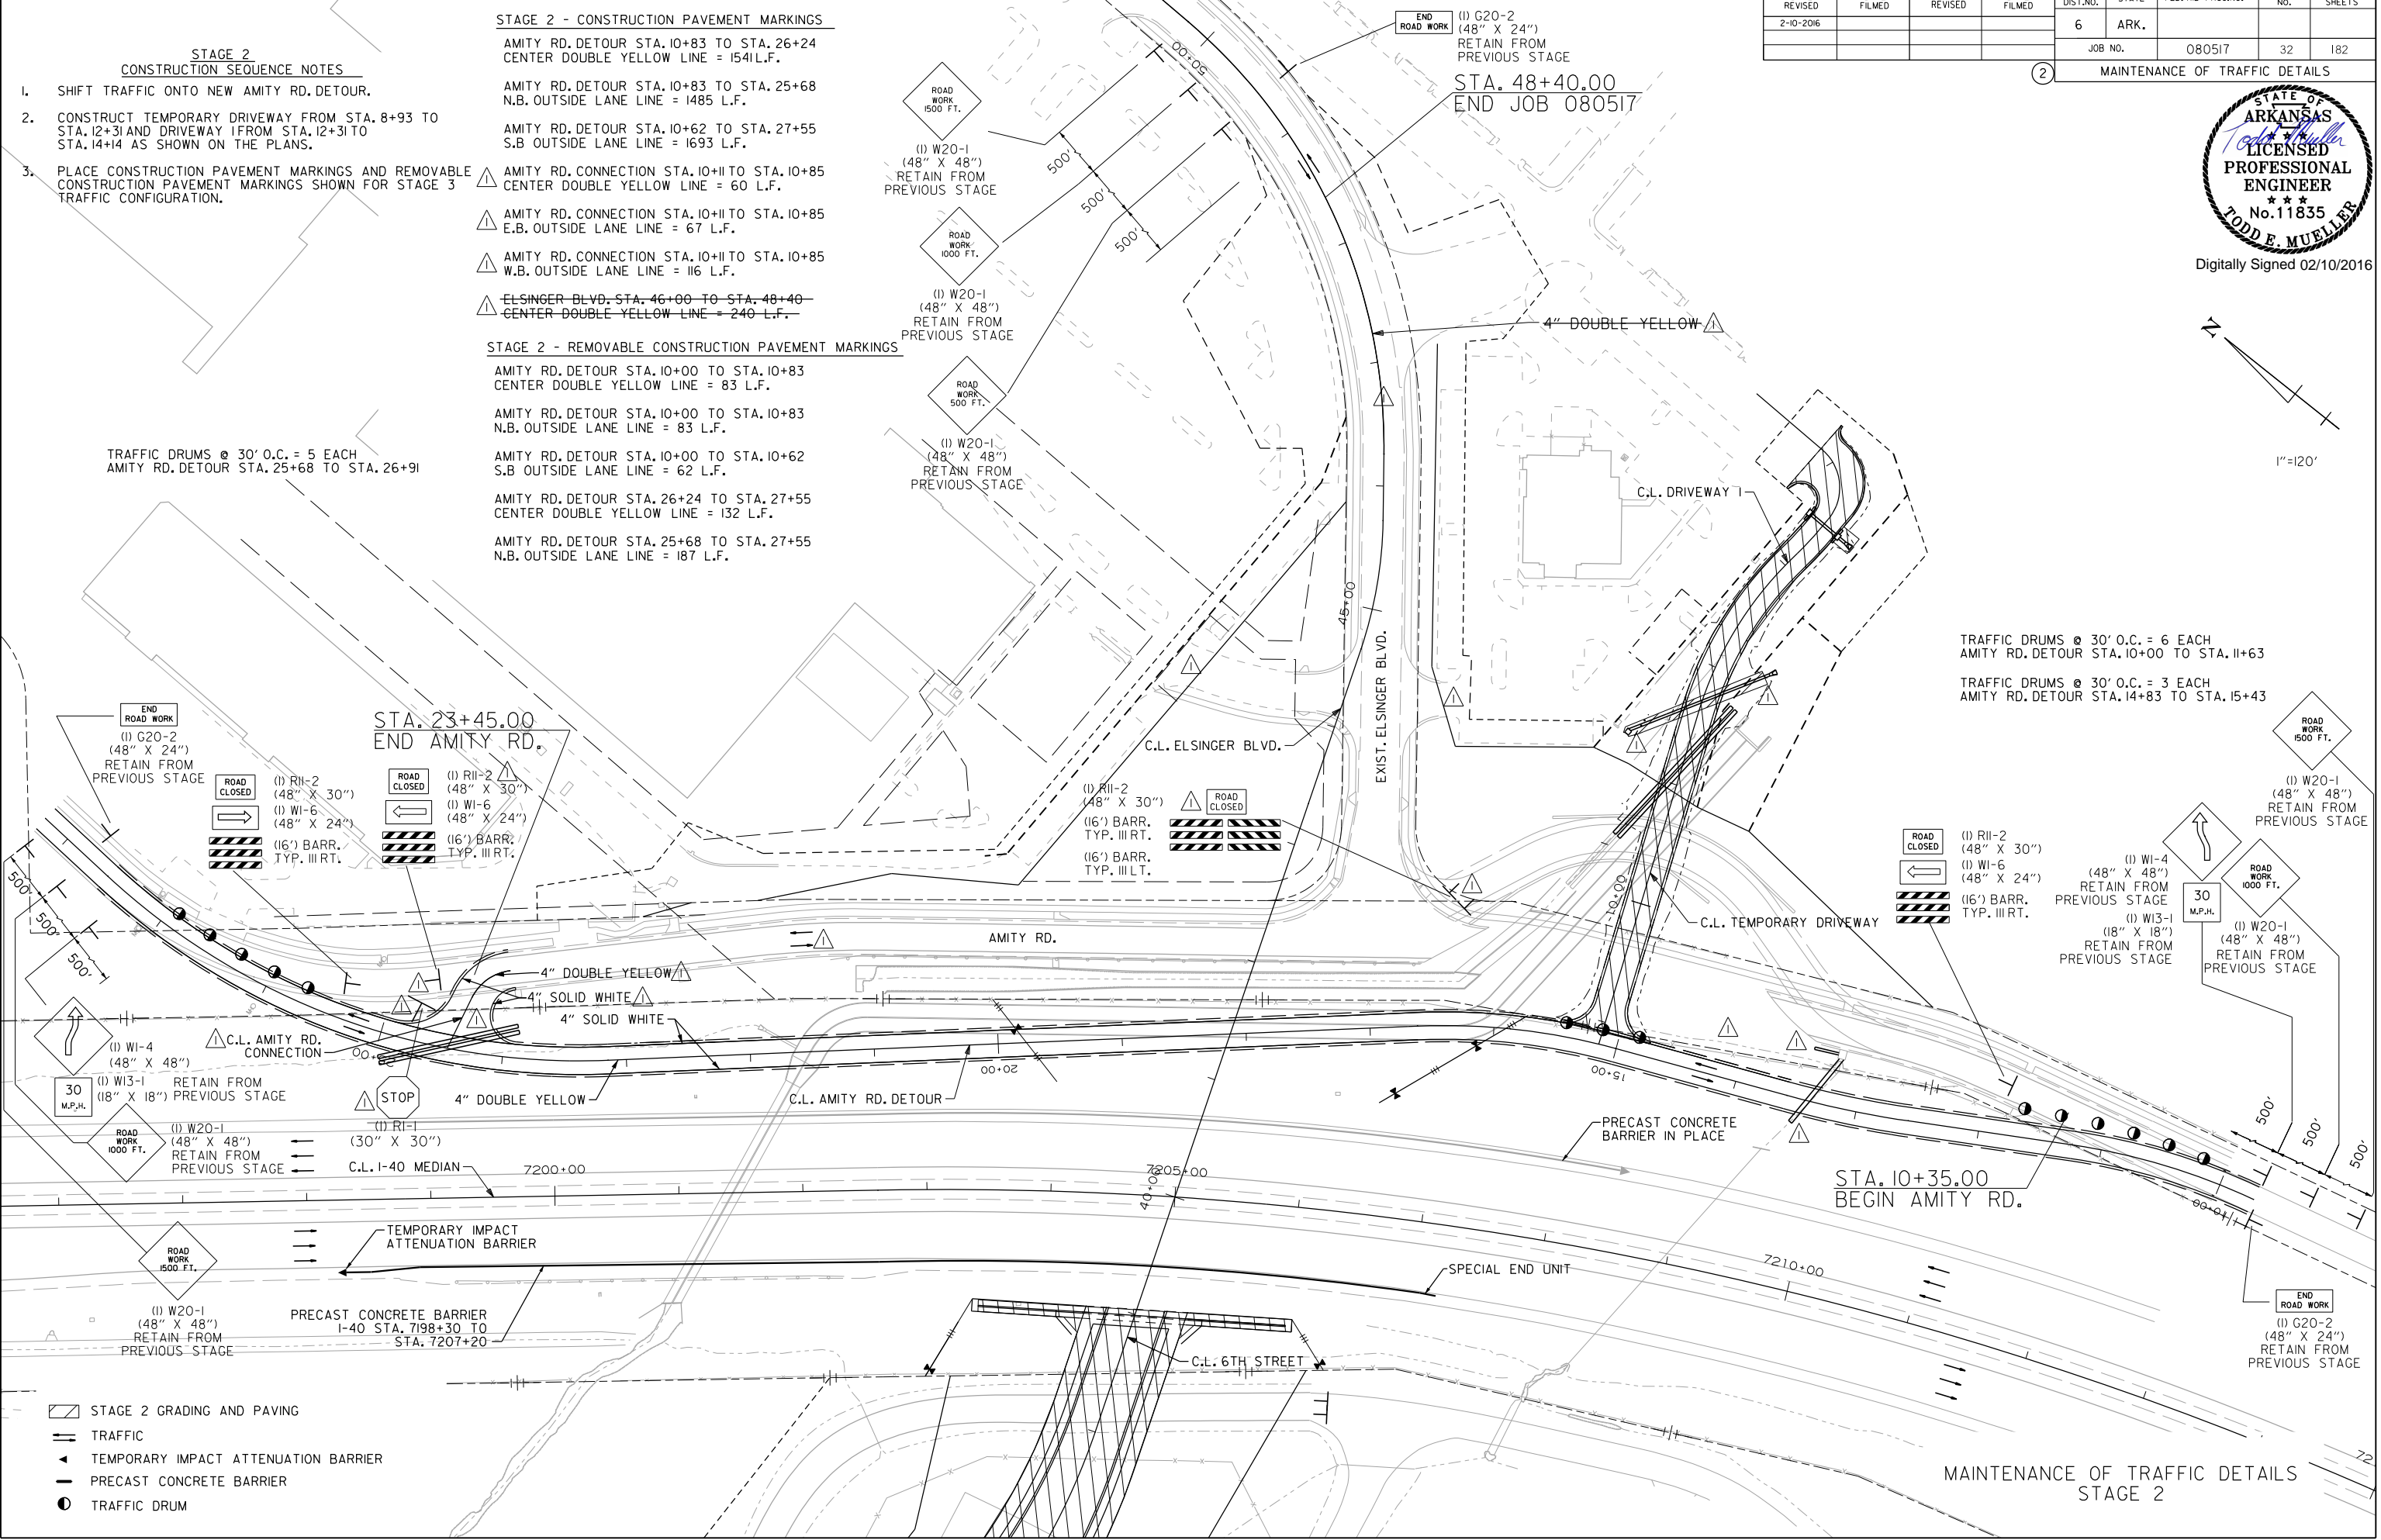

- STAGE 2 CONSTRUCTION SEQUENCE NOTES**
- SHIFT TRAFFIC ONTO NEW AMITY RD. DETOUR.
  - CONSTRUCT TEMPORARY DRIVEWAY FROM STA. 8+93 TO STA. 12+31 AND DRIVEWAY FROM STA. 12+31 TO STA. 14+14 AS SHOWN ON THE PLANS.
  - PLACE CONSTRUCTION PAVEMENT MARKINGS AND REMOVABLE CONSTRUCTION PAVEMENT MARKINGS SHOWN FOR STAGE 3 TRAFFIC CONFIGURATION.

- STAGE 2 - CONSTRUCTION PAVEMENT MARKINGS**
- AMITY RD. DETOUR STA. 10+83 TO STA. 26+24 CENTER DOUBLE YELLOW LINE = 1541 L.F.
  - AMITY RD. DETOUR STA. 10+83 TO STA. 25+68 N.B. OUTSIDE LANE LINE = 1485 L.F.
  - AMITY RD. DETOUR STA. 10+62 TO STA. 27+55 S.B. OUTSIDE LANE LINE = 1693 L.F.
  - AMITY RD. CONNECTION STA. 10+11 TO STA. 10+85 CENTER DOUBLE YELLOW LINE = 60 L.F.
  - AMITY RD. CONNECTION STA. 10+11 TO STA. 10+85 E.B. OUTSIDE LANE LINE = 67 L.F.
  - AMITY RD. CONNECTION STA. 10+11 TO STA. 10+85 W.B. OUTSIDE LANE LINE = 116 L.F.
  - ELSINGER BLVD. STA. 46+00 TO STA. 48+40 CENTER DOUBLE YELLOW LINE = 240 L.F.

- STAGE 2 - REMOVABLE CONSTRUCTION PAVEMENT MARKINGS**
- AMITY RD. DETOUR STA. 10+00 TO STA. 10+83 CENTER DOUBLE YELLOW LINE = 83 L.F.
  - AMITY RD. DETOUR STA. 10+00 TO STA. 10+83 N.B. OUTSIDE LANE LINE = 83 L.F.
  - AMITY RD. DETOUR STA. 10+00 TO STA. 10+62 S.B. OUTSIDE LANE LINE = 62 L.F.
  - AMITY RD. DETOUR STA. 26+24 TO STA. 27+55 CENTER DOUBLE YELLOW LINE = 132 L.F.
  - AMITY RD. DETOUR STA. 25+68 TO STA. 27+55 N.B. OUTSIDE LANE LINE = 187 L.F.

TRAFFIC DRUMS @ 30' O.C. = 5 EACH  
AMITY RD. DETOUR STA. 25+68 TO STA. 26+91

TRAFFIC DRUMS @ 30' O.C. = 6 EACH  
AMITY RD. DETOUR STA. 10+00 TO STA. 11+63

TRAFFIC DRUMS @ 30' O.C. = 3 EACH  
AMITY RD. DETOUR STA. 14+83 TO STA. 15+43

- STAGE 2 GRADING AND PAVING
- TRAFFIC
- TEMPORARY IMPACT ATTENUATION BARRIER
- PRECAST CONCRETE BARRIER
- TRAFFIC DRUM


2/10/2016 4:33:56 PM  
 WORKSPACE: AHTD  
 L:\2012\1201550 - Contr\ell\field Access\Drawings\6TH\_ST\6TH\_MOT\_PRJ2\_ST102\_6TH\_01.dgn  
 REVISED DATE:

MAINTENANCE OF TRAFFIC DETAILS  
STAGE 2




DATE REVISED	DATE FILMED	DATE REVISED	DATE FILMED	FED. RD. DIST. NO.	STATE	FED. AID PROJ. NO.	SHEET NO.	TOTAL SHEETS
				6	ARK.			
				JOB NO.	080517		33	182

2 MAINTENANCE OF TRAFFIC DETAILS

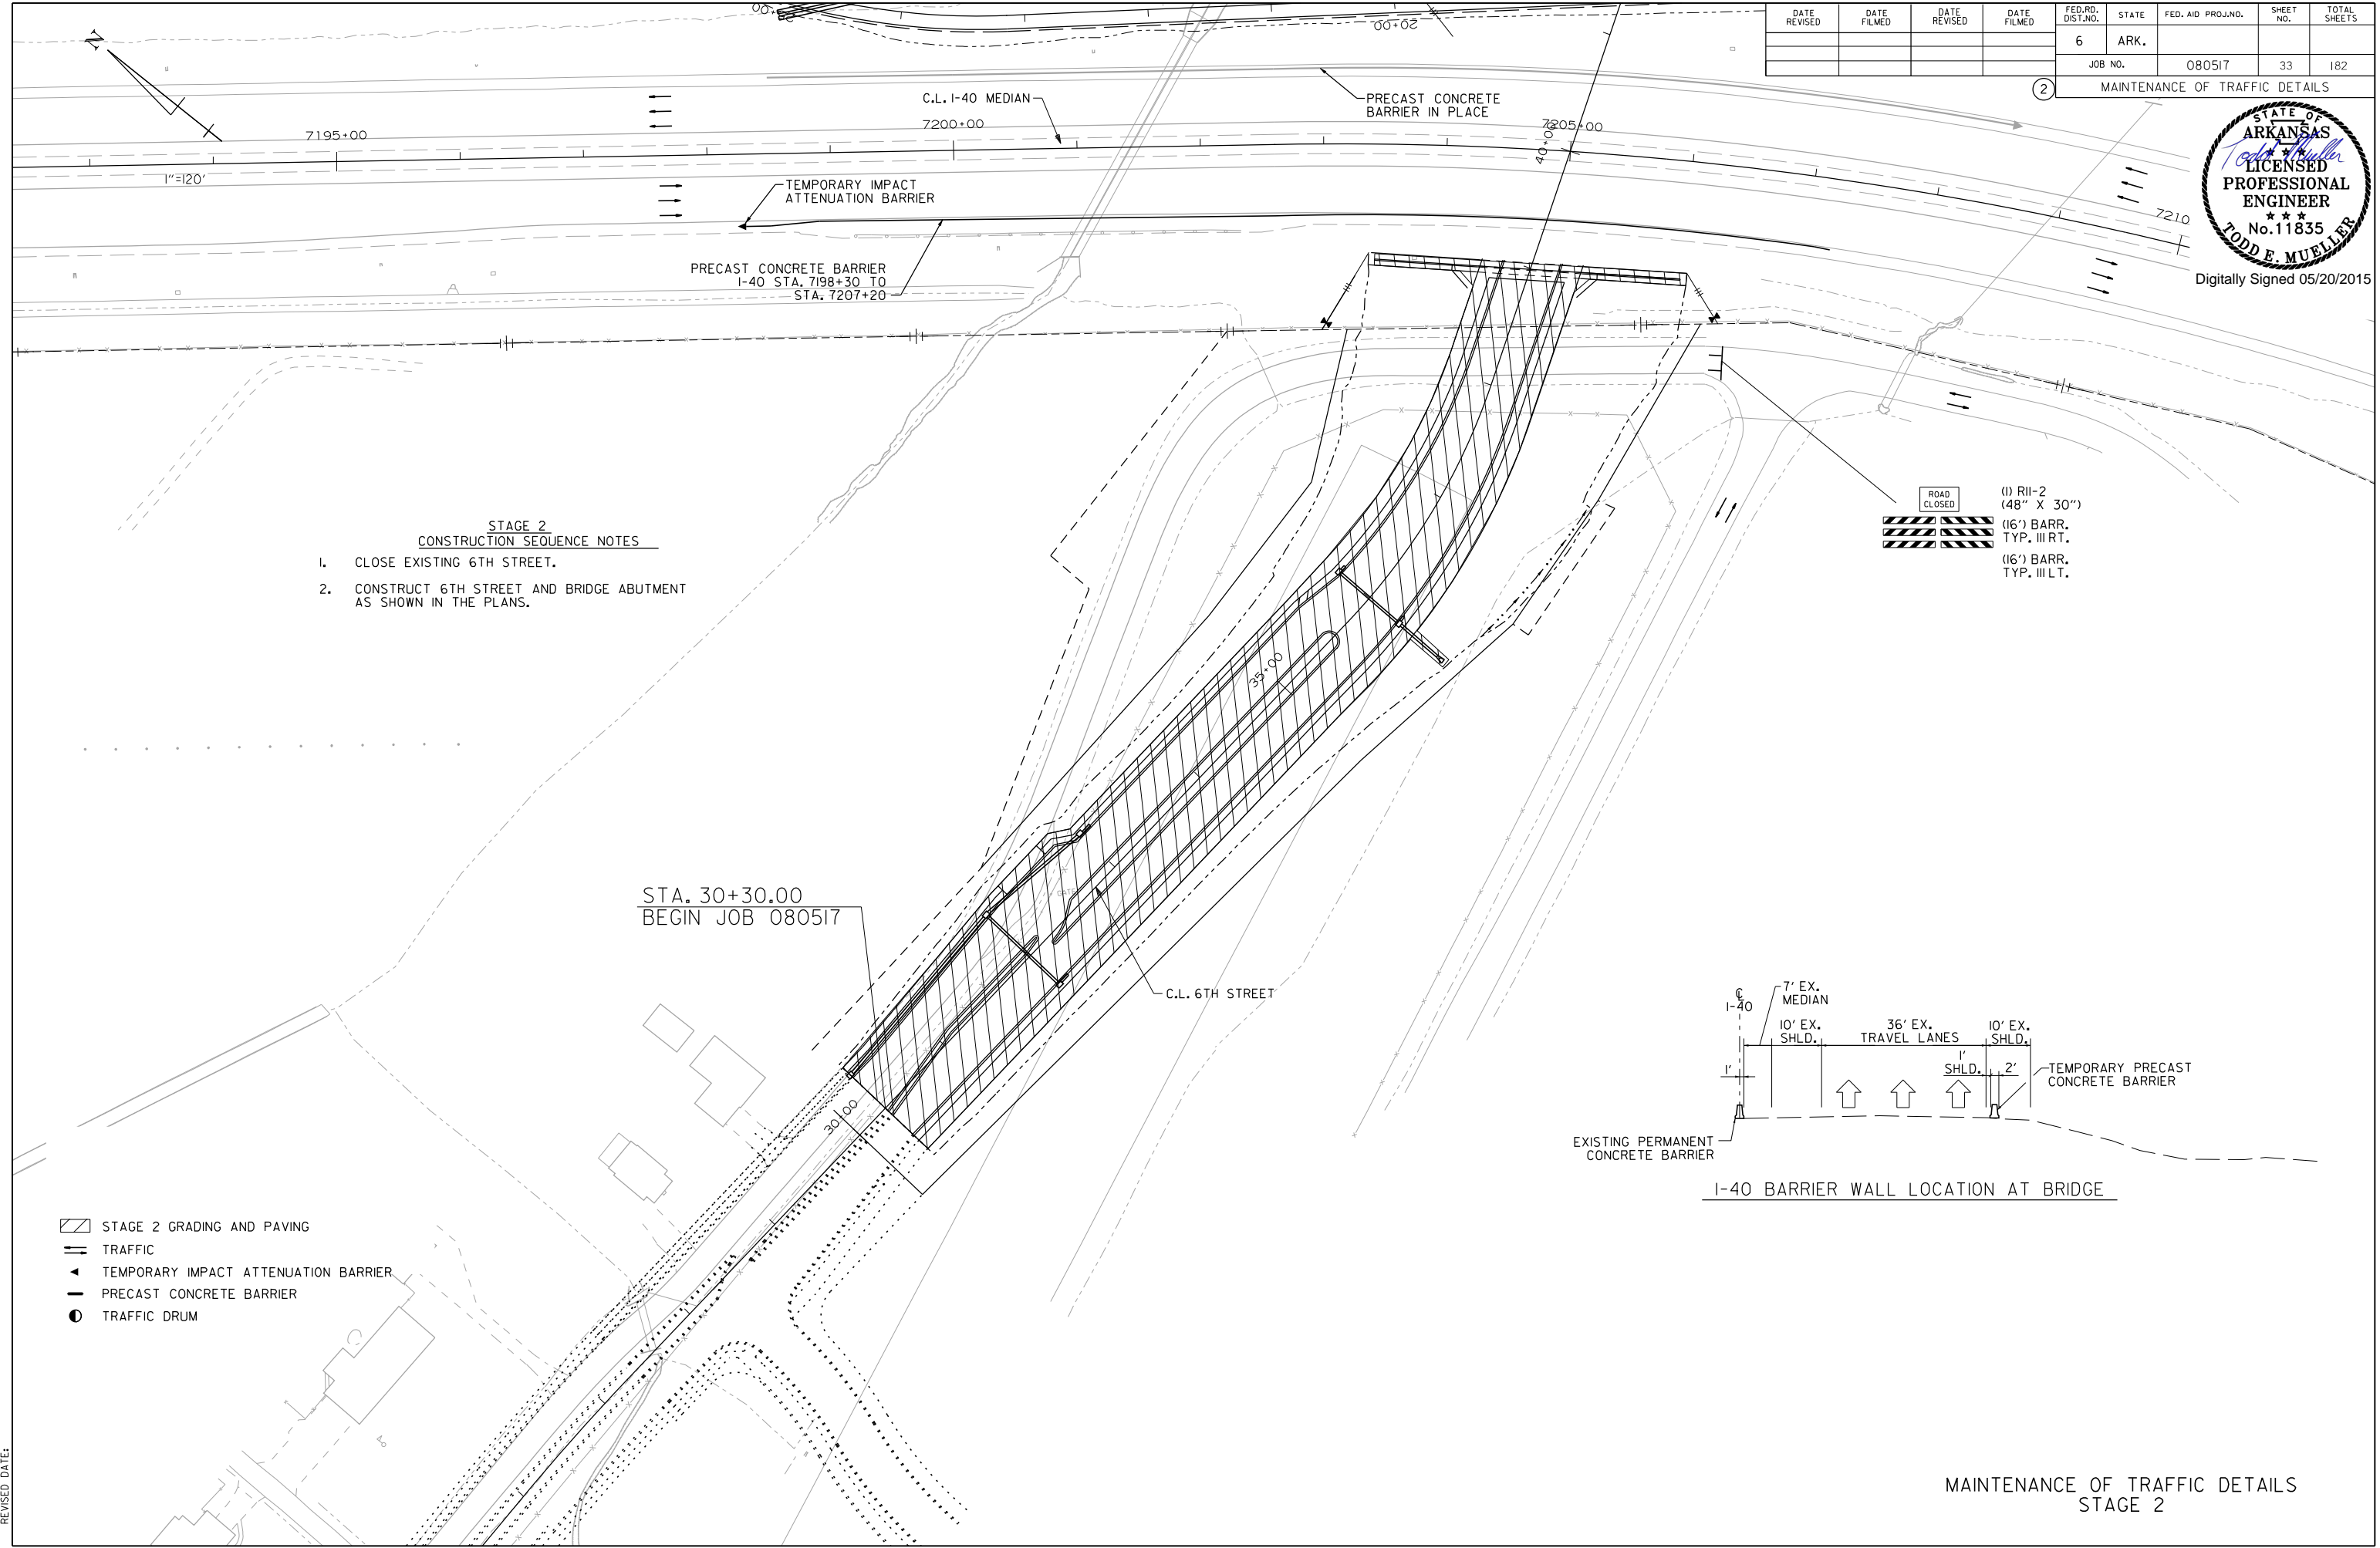

- STAGE 2 CONSTRUCTION SEQUENCE NOTES**
1. CLOSE EXISTING 6TH STREET.
  2. CONSTRUCT 6TH STREET AND BRIDGE ABUTMENT AS SHOWN IN THE PLANS.

- ROAD CLOSED**
- (1) RII-2 (48" X 30")
  - (16') BARR. TYP. III RT.
  - (16') BARR. TYP. III LT.

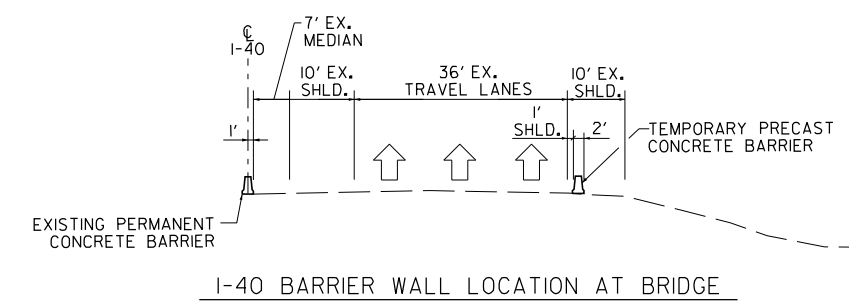

- ▨ STAGE 2 GRADING AND PAVING
- || TRAFFIC
- ▲ TEMPORARY IMPACT ATTENUATION BARRIER
- PRECAST CONCRETE BARRIER
- TRAFFIC DRUM


5/20/2015 7:51:12 AM  
 WORKSPACE: AHTD  
 L:\2012\12015590 - ContrailField Access\Drawings\6TH\_ST\6TH\_MOT\_PRJ2\_S102\_6TH\_02.dgn  
 REVISED DATE:

MAINTENANCE OF TRAFFIC DETAILS  
STAGE 2

DATE REVISED	DATE FILMED	DATE REVISED	DATE FILMED	FED. RD. DIST. NO.	STATE	FED. AID PROJ. NO.	SHEET NO.	TOTAL SHEETS
2-10-2016				6	ARK.		34	182
JOB NO. 080517							MAINTENANCE OF TRAFFIC DETAILS	



Digitally Signed 02/10/2016

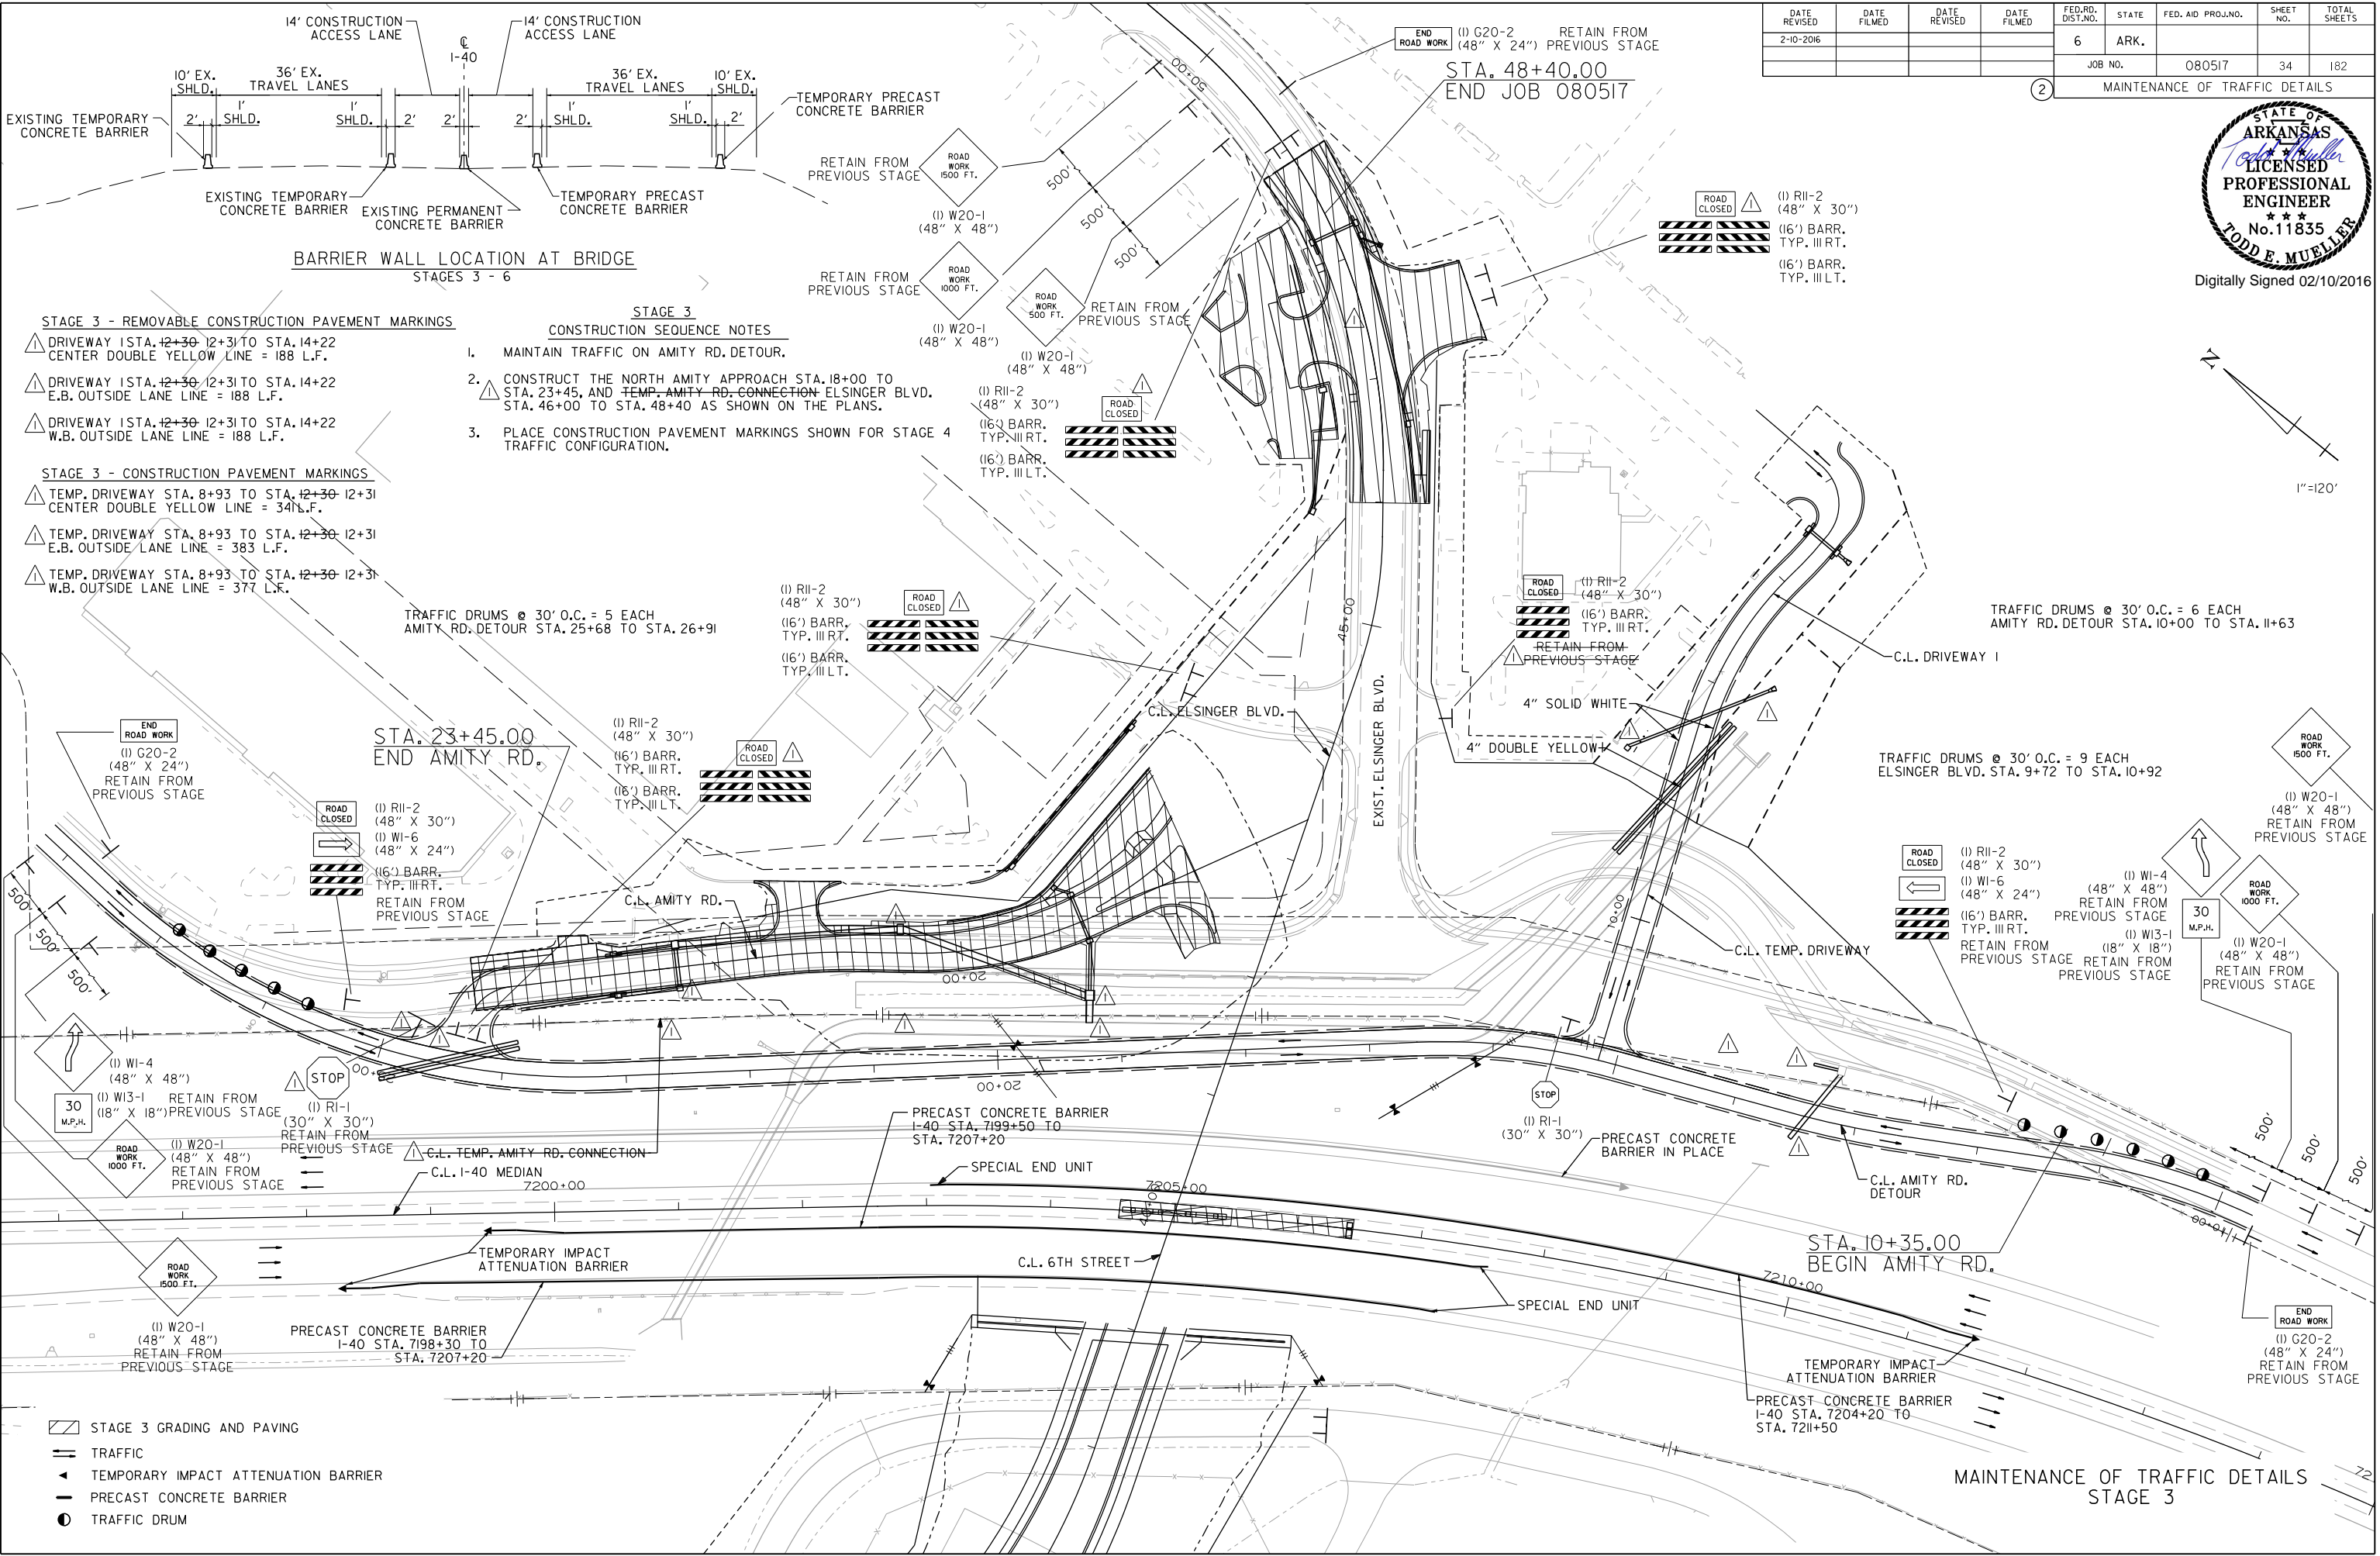

**BARRIER WALL LOCATION AT BRIDGE**  
STAGES 3 - 6

**STAGE 3 - REMOVABLE CONSTRUCTION PAVEMENT MARKINGS**

- ▲ DRIVEWAY STA. 12+30 TO STA. 14+22 CENTER DOUBLE YELLOW LINE = 188 L.F.
- ▲ DRIVEWAY STA. 12+30 TO STA. 14+22 E.B. OUTSIDE LANE LINE = 188 L.F.
- ▲ DRIVEWAY STA. 12+30 TO STA. 14+22 W.B. OUTSIDE LANE LINE = 188 L.F.

**STAGE 3 - CONSTRUCTION PAVEMENT MARKINGS**

- ▲ TEMP. DRIVEWAY STA. 8+93 TO STA. 12+31 CENTER DOUBLE YELLOW LINE = 341 L.F.
- ▲ TEMP. DRIVEWAY STA. 8+93 TO STA. 12+31 E.B. OUTSIDE LANE LINE = 383 L.F.
- ▲ TEMP. DRIVEWAY STA. 8+93 TO STA. 12+31 W.B. OUTSIDE LANE LINE = 377 L.F.

**STAGE 3 CONSTRUCTION SEQUENCE NOTES**

1. MAINTAIN TRAFFIC ON AMITY RD. DETOUR.
2. CONSTRUCT THE NORTH AMITY APPROACH STA. 18+00 TO STA. 23+45, AND TEMP. AMITY RD. CONNECTION ELSINGER BLVD. STA. 46+00 TO STA. 48+40 AS SHOWN ON THE PLANS.
3. PLACE CONSTRUCTION PAVEMENT MARKINGS SHOWN FOR STAGE 4 TRAFFIC CONFIGURATION.

TRAFFIC DRUMS @ 30' O.C. = 5 EACH  
AMITY RD. DETOUR STA. 25+68 TO STA. 26+91

TRAFFIC DRUMS @ 30' O.C. = 6 EACH  
AMITY RD. DETOUR STA. 10+00 TO STA. 11+63

TRAFFIC DRUMS @ 30' O.C. = 9 EACH  
ELSINGER BLVD. STA. 9+72 TO STA. 10+92

- ▨ STAGE 3 GRADING AND PAVING
- TRAFFIC
- ▲ TEMPORARY IMPACT ATTENUATION BARRIER
- PRECAST CONCRETE BARRIER
- TRAFFIC DRUM



2/10/2016 4:33:57 PM  
 WORKSPACE: AHTD  
 L:\2012\1201590 - Contr-ell\field Access\Drawings\6TH\_ST\6TH\_MOT\_PRJ2\_ST103\_6TH\_01.dgn  
 REVISED DATE:

DATE REVISED	DATE FILMED	DATE REVISED	DATE FILMED	FED. RD. DIST. NO.	STATE	FED. AID PROJ. NO.	SHEET NO.	TOTAL SHEETS
2-10-2016				6	ARK.		35	182

2 MAINTENANCE OF TRAFFIC DETAILS



Digitally Signed 02/10/2016

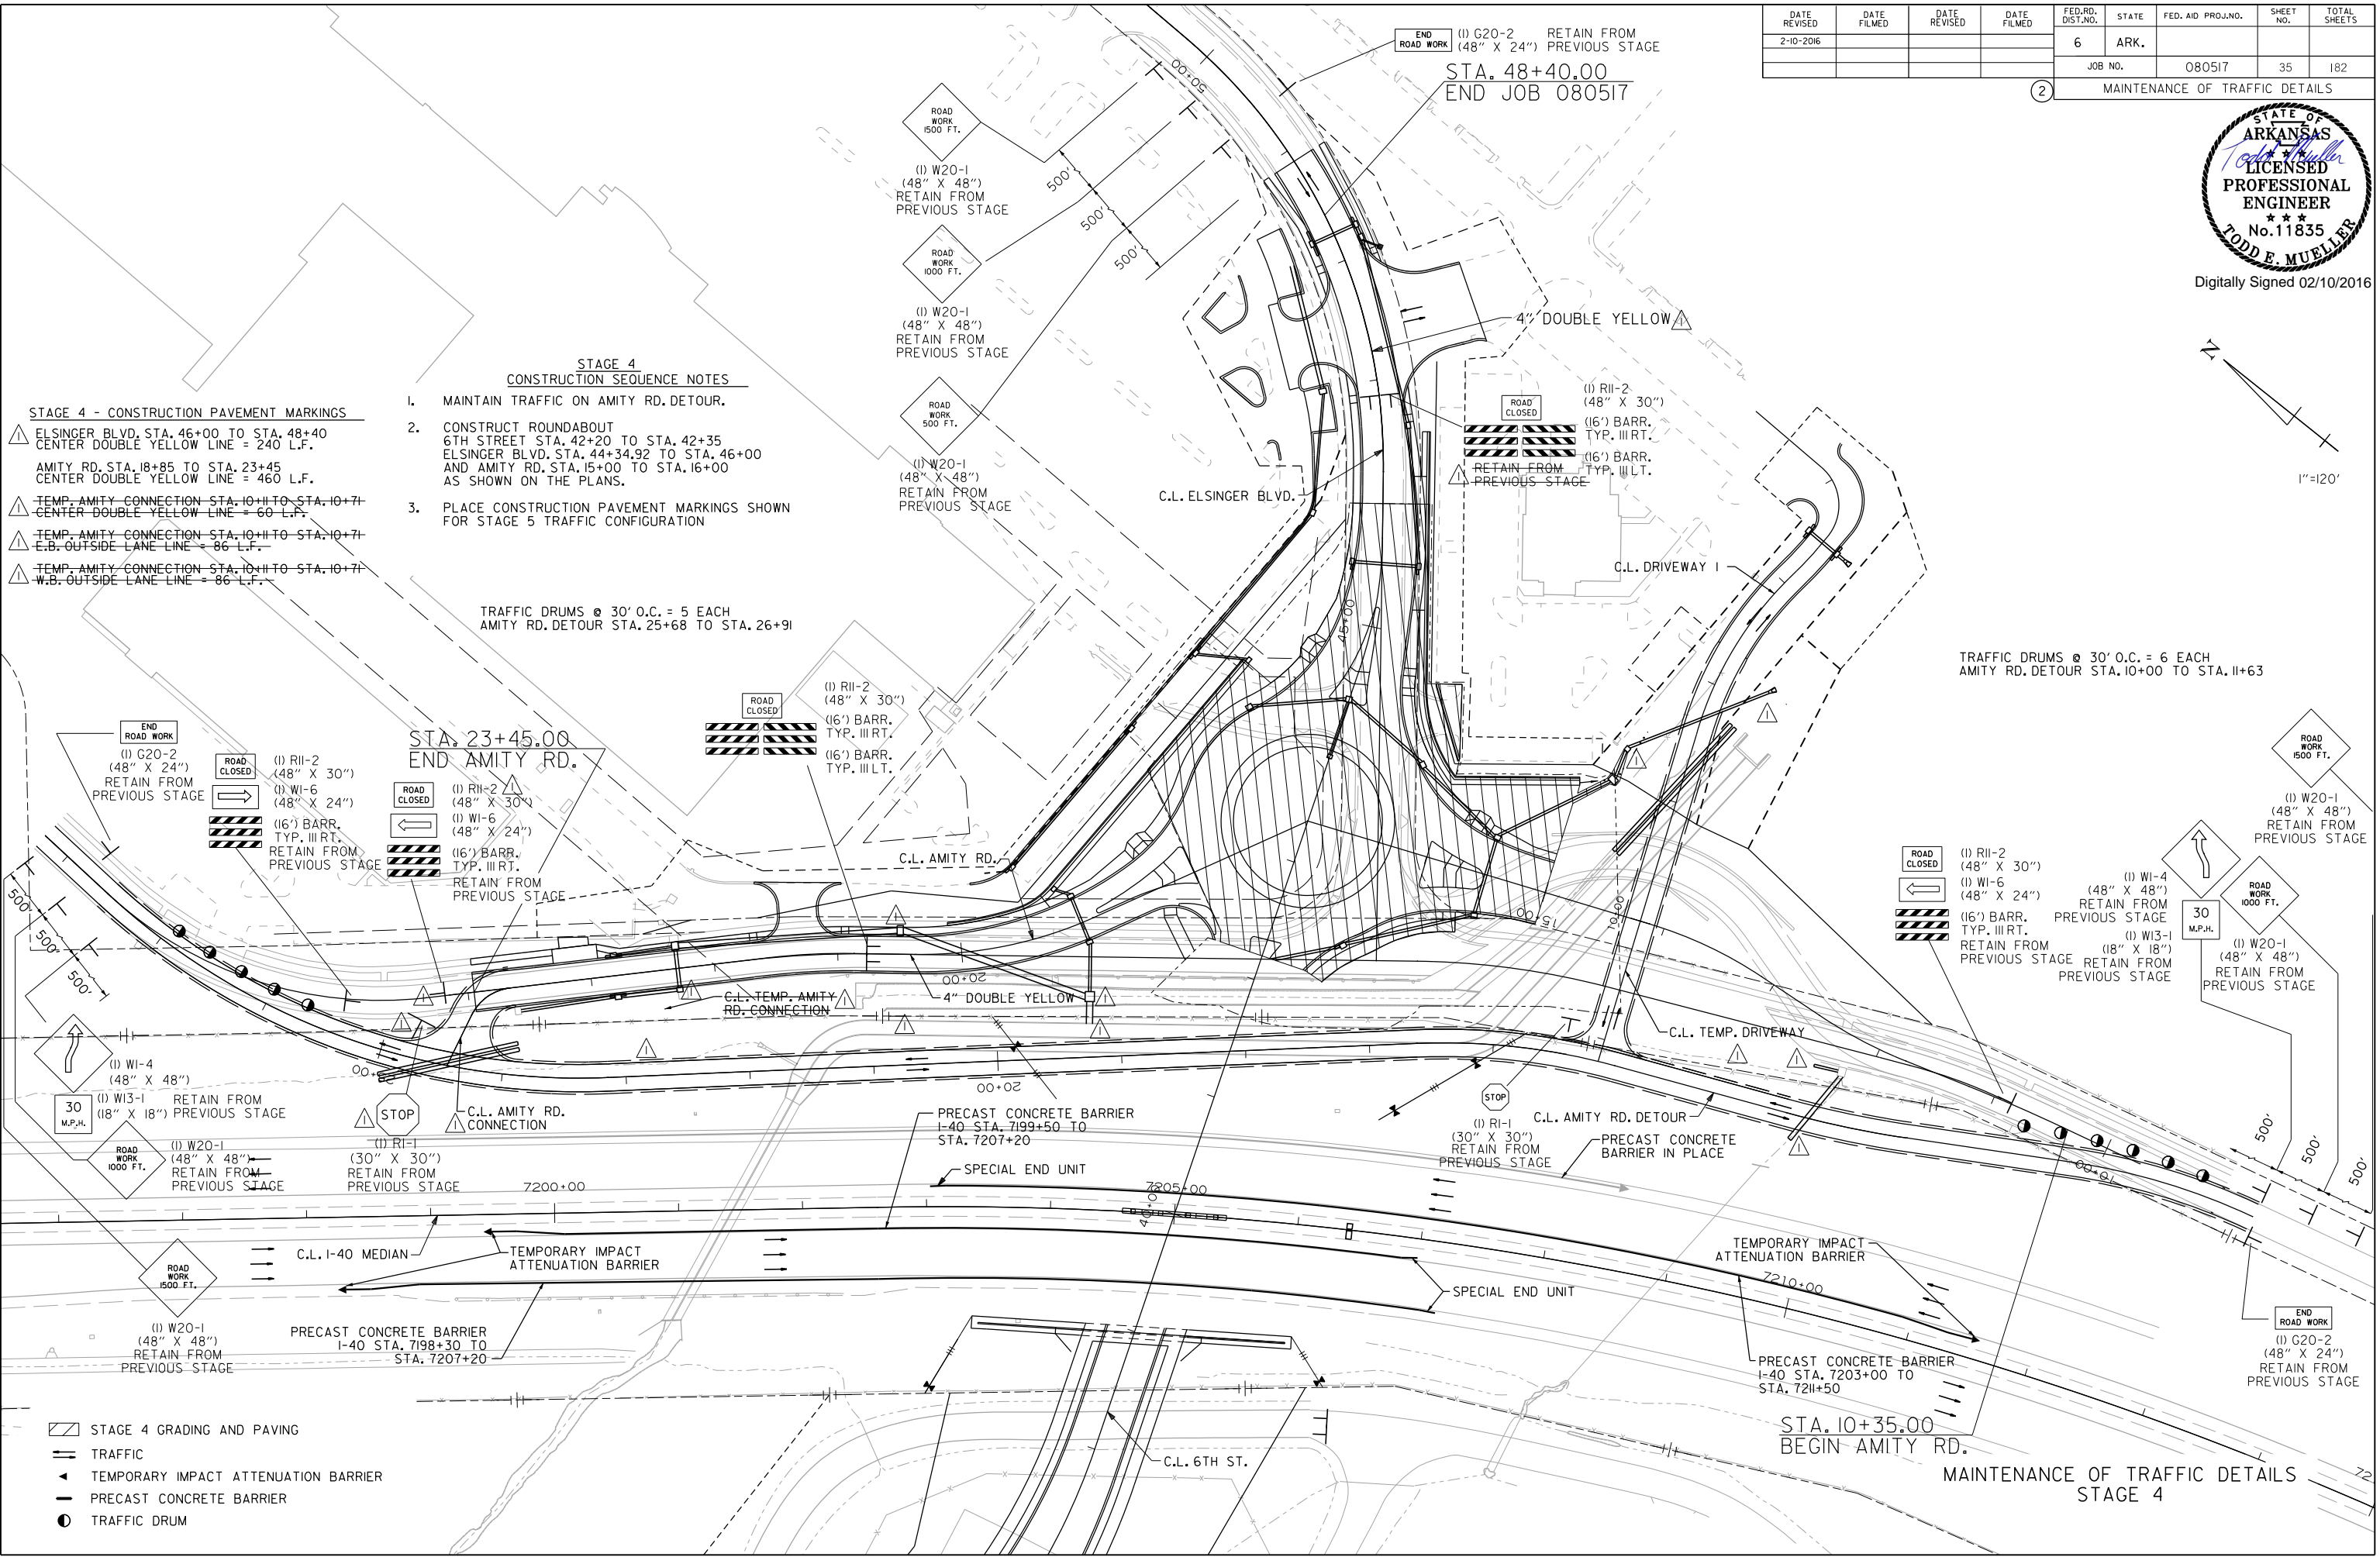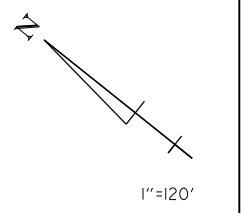

**STAGE 4 CONSTRUCTION SEQUENCE NOTES**

1. MAINTAIN TRAFFIC ON AMITY RD. DETOUR.
2. CONSTRUCT ROUNDABOUT 6TH STREET STA. 42+20 TO STA. 42+35 ELSINGER BLVD. STA. 44+34.92 TO STA. 46+00 AND AMITY RD. STA. 15+00 TO STA. 16+00 AS SHOWN ON THE PLANS.
3. PLACE CONSTRUCTION PAVEMENT MARKINGS SHOWN FOR STAGE 5 TRAFFIC CONFIGURATION

**STAGE 4 - CONSTRUCTION PAVEMENT MARKINGS**

- ▲ ELSINGER BLVD. STA. 46+00 TO STA. 48+40 CENTER DOUBLE YELLOW LINE = 240 L.F.
- ▲ AMITY RD. STA. 18+85 TO STA. 23+45 CENTER DOUBLE YELLOW LINE = 460 L.F.
- ▲ TEMP. AMITY CONNECTION STA. 10+11 TO STA. 10+71 CENTER DOUBLE YELLOW LINE = 60 L.F.
- ▲ TEMP. AMITY CONNECTION STA. 10+11 TO STA. 10+71 E.B. OUTSIDE LANE LINE = 86 L.F.
- ▲ TEMP. AMITY CONNECTION STA. 10+11 TO STA. 10+71 W.B. OUTSIDE LANE LINE = 86 L.F.

TRAFFIC DRUMS @ 30' O.C. = 5 EACH  
AMITY RD. DETOUR STA. 25+68 TO STA. 26+91

TRAFFIC DRUMS @ 30' O.C. = 6 EACH  
AMITY RD. DETOUR STA. 10+00 TO STA. 11+63

STA. 23+45.00  
END AMITY RD.

STA. 10+35.00  
BEGIN AMITY RD.

- ▨ STAGE 4 GRADING AND PAVING
- TRAFFIC
- ▲ TEMPORARY IMPACT ATTENUATION BARRIER
- PRECAST CONCRETE BARRIER
- TRAFFIC DRUM

2/10/2016 4:33:58 PM  
 WORKSPACE: AHTD  
 L:\2012\201590 - Contr-ell\field Access\Drawings\6TH\_ST\6TH\_MOT\_PRJ2\_ST04\_6TH\_01.dgn  
 REVISED DATE:

DATE REVISED	DATE FILMED	DATE REVISED	DATE FILMED	FED. RD. DIST. NO.	STATE	FED. AID PROJ. NO.	SHEET NO.	TOTAL SHEETS
2-10-2016				6	ARK.		36	182
				JOB NO.		080517		
						2 MAINTENANCE OF TRAFFIC DETAILS		



Digitally Signed 02/10/2016


- STAGE 5 CONSTRUCTION SEQUENCE NOTES**
1. MAINTAIN TRAFFIC ON AMITY RD. DETOUR. SHIFT TRAFFIC ONTO ELSINGER BLVD., ROUNDABOUT, NORTH AMITY APPROACH, AND AMITY RD. CONNECTION.
  2. CONSTRUCT AMITY RD. STA. 10+35 TO STA. 15+00, AND DRIVEWAY 1 STA. 10+25 TO 12+30.

- STAGE 5 - CONSTRUCTION PAVEMENT MARKINGS**
- ROUNDABOUT SOLID YELLOW LEFT LANE LINE = 534 L.F.
  - ELSINGER BLVD. STA. 45+16 TO STA. 46+00 E.B. SOLID YELLOW LEFT LANE LINE = 84 L.F.
  - ELSINGER BLVD. STA. 45+16 TO STA. 46+00 W.B. SOLID YELLOW LEFT LANE LINE = 84 L.F.
  - ELSINGER BLVD. STA. 45+85 TO STA. 46+95 E.B. SOLID WHITE LEFT TURN LANE LINE = 110 L.F.
  - YIELD BARS: ELSINGER BLVD. = 12 L.F., AMITY RD. = 12 L.F.
  - ARROWS = 1 EACH
  - WORDS = 1 EACH
  - TRAFFIC DRUMS @ 30' O.C. = 5 EACH AMITY RD. DETOUR STA. 25+68 TO STA. 26+91

TRAFFIC DRUMS @ 30' O.C. = 18 EACH ROUNDABOUT INSIDE LANE

TRAFFIC DRUMS @ 30' O.C. = 16 EACH ELSINGER BLVD. STA. 44+26 TO STA. 46+95

TRAFFIC DRUMS @ 30' O.C. = 6 EACH AMITY RD. DETOUR STA. 10+00 TO STA. 11+63

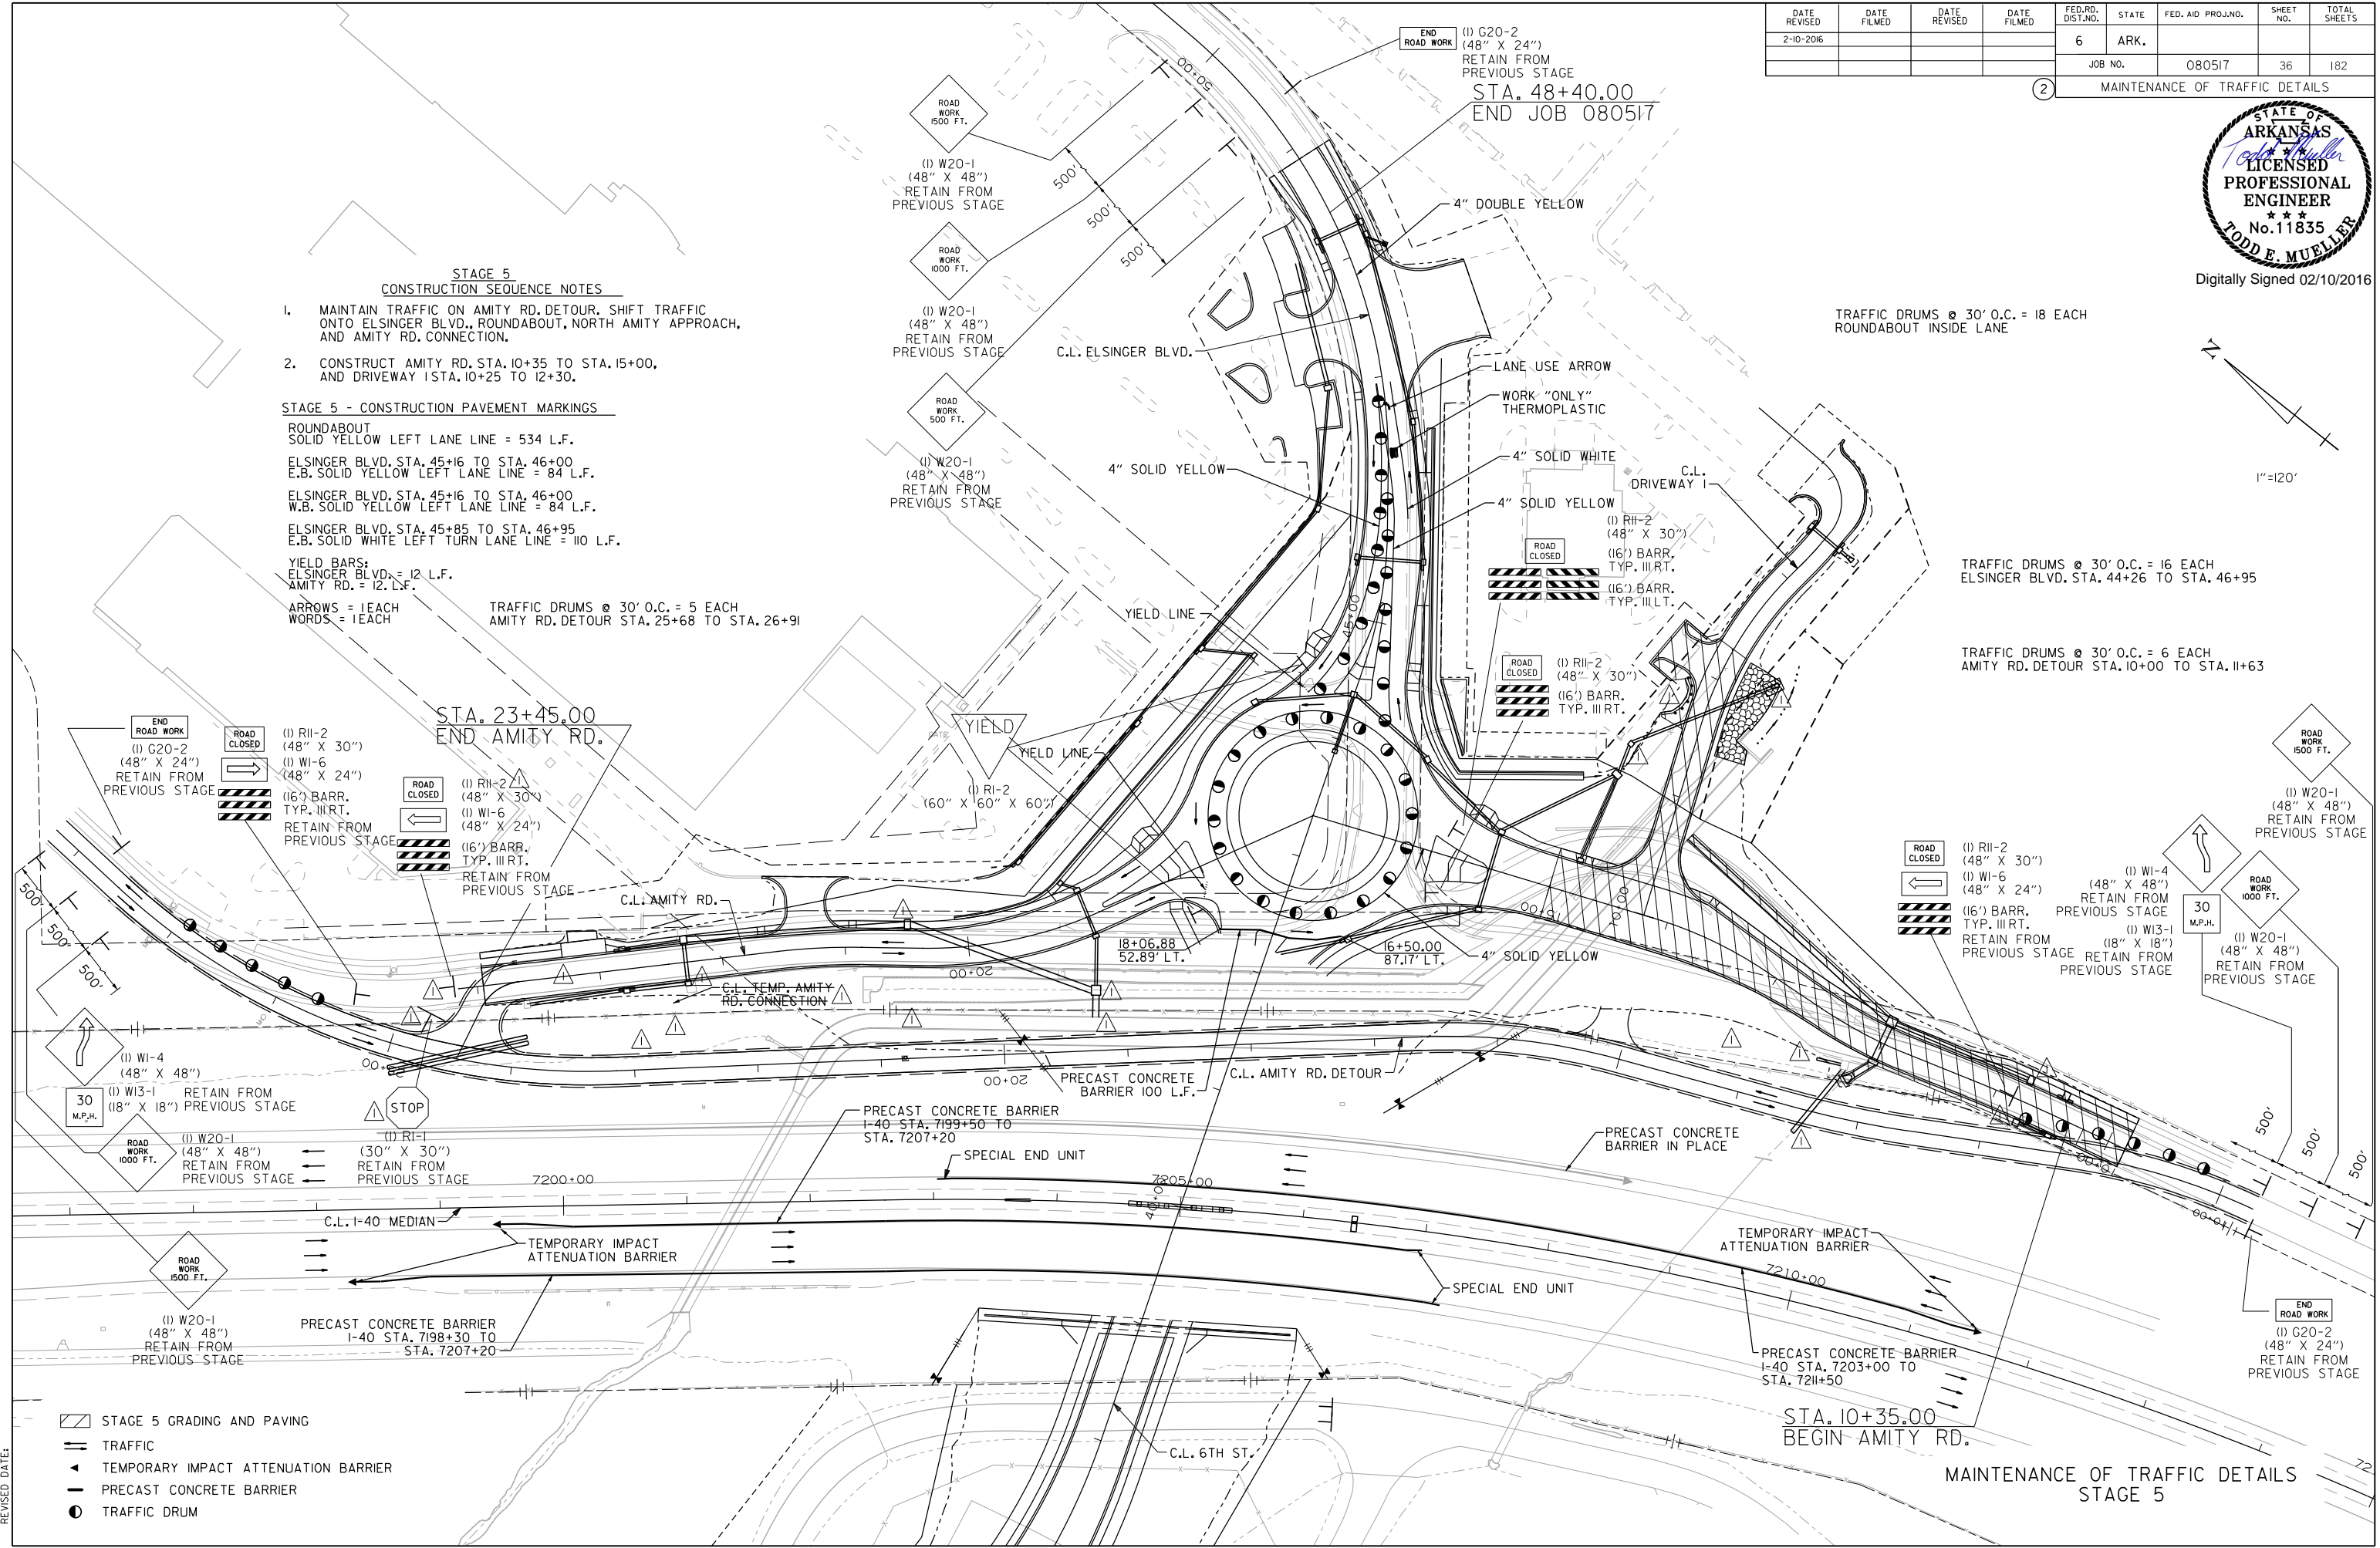

- STAGE 5 GRADING AND PAVING
- TRAFFIC
- TEMPORARY IMPACT ATTENUATION BARRIER
- PRECAST CONCRETE BARRIER
- TRAFFIC DRUM

2/10/2016 4:33:58 PM  
 WORKSPACE: AHTD  
 L:\2012\201550 - Contr-ell\field Access\Drawings\6TH\_ST\6TH\_MOT\_PRJ2\_ST105\_6TH\_01.dgn  
 REVISED DATE:

DATE REVISED	DATE FILMED	DATE REVISED	DATE FILMED	FED. RD. DIST. NO.	STATE	FED. AID PROJ. NO.	SHEET NO.	TOTAL SHEETS
2-10-2016				6	ARK.		37	182
						JOB NO.	080517	
						2 MAINTENANCE OF TRAFFIC DETAILS		



Digitally Signed 02/10/2016

STA. 48+40.00  
END JOB 080517

**STAGE 6 - CONSTRUCTION PAVEMENT MARKINGS**

AMITY RD. STA. 14+12 TO STA. 16+00  
N.B. SOLID YELLOW LEFT LANE LINE = 188 L.F.  
AMITY RD. STA. 10+35 TO STA. 15+00  
CENTER DOUBLE YELLOW LINE = 465 L.F.  
YIELD BARS:  
AMITY RD. = 12 L.F.

**STAGE 6  
CONSTRUCTION SEQUENCE NOTES**



1. SHIFT TRAFFIC ONTO NEW APPROACH LEGS AND ROUNDABOUT.
2. REMOVE AMITY RD. DETOUR AND TEMPORARY DRAINAGE.
3. CONSTRUCT REMAINING BRIDGE AND CONNECT FES AT AMITY RD. STA. 20+50 TO RCB.
4. CONSTRUCT CURB AND GUTTER ALONG EXISTING AMITY RD. STA. 9+00 8+70 TO STA. 10+85 AND STA. 24+70 23+95 TO STA. 26+60.
5. PLACE FINAL 2" ACHM SURFACE COURSE ON ALL ALIGNMENTS.

TRAFFIC DRUMS @ 30' O.C. = 18 EACH  
ROUNDBOUT INSIDE LANE

TRAFFIC DRUMS @ 30' O.C. = 16 EACH  
ELSINGER BLVD. STA. 44+26 TO STA. 46+95

TRAFFIC DRUMS @ 30' O.C. = 7 EACH  
AMITY RD. STA. 14+12 TO STA. 16+00

1" = 120'

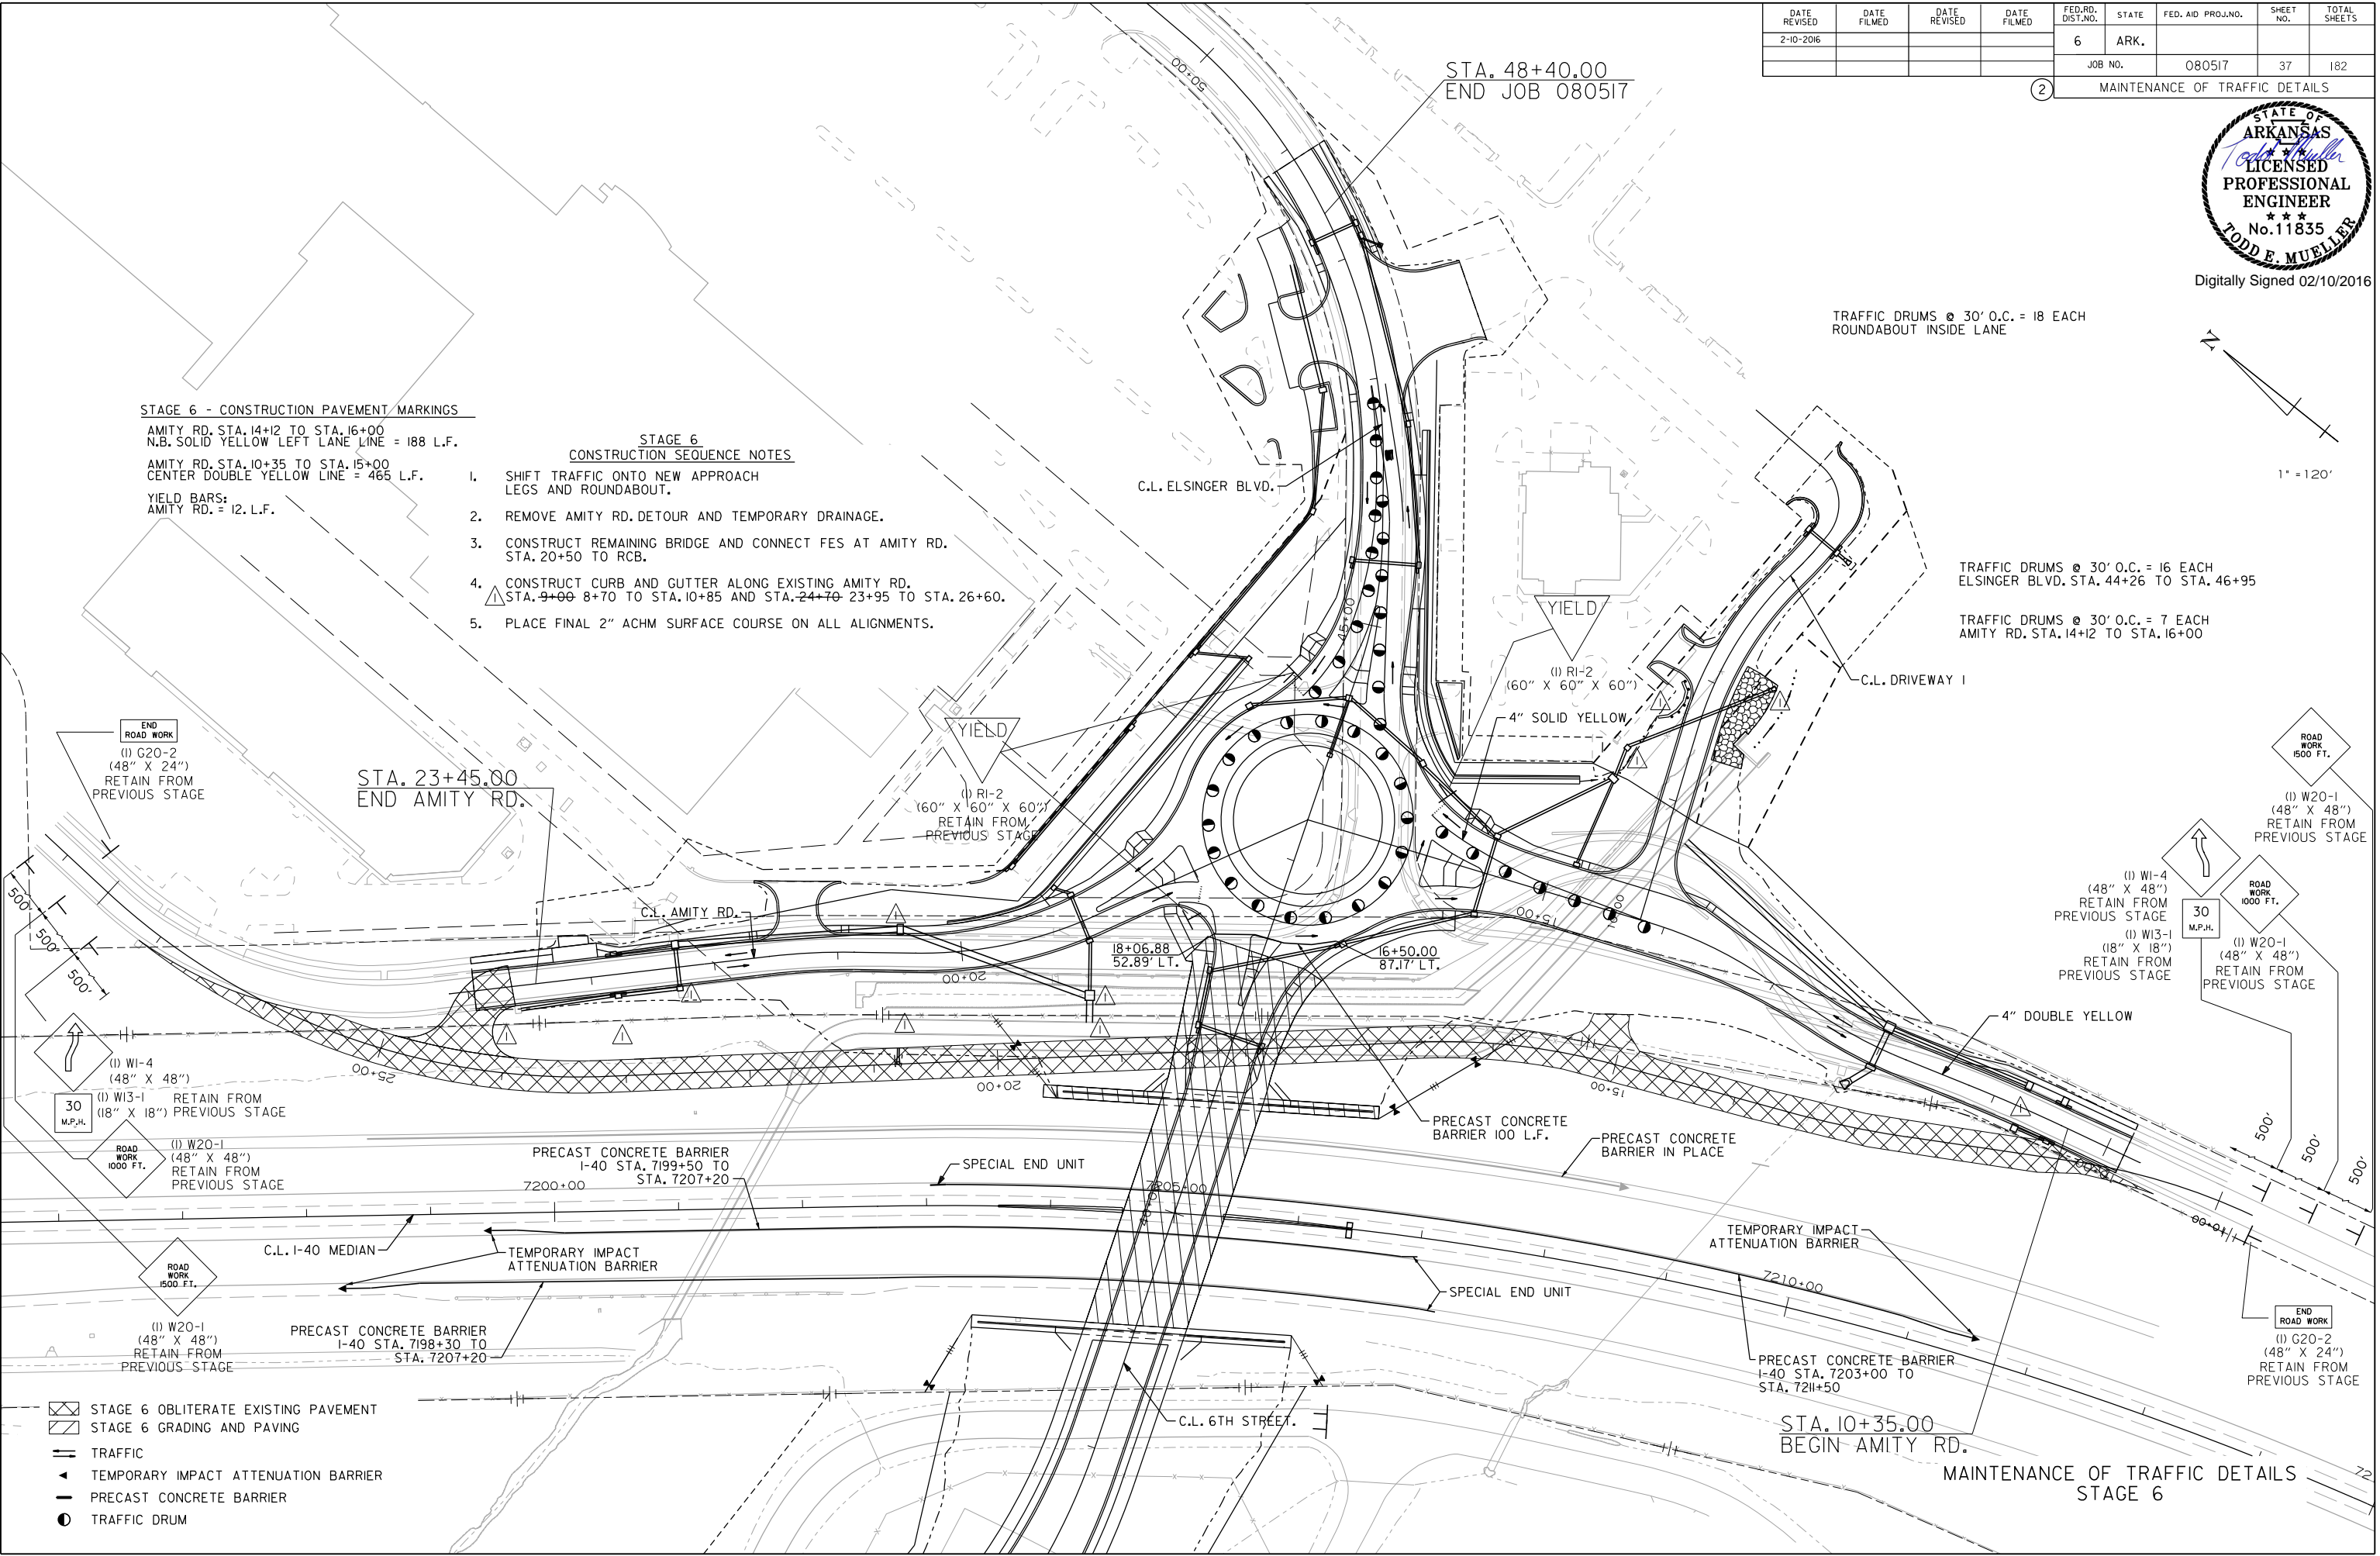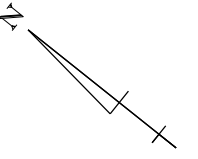

2/10/2016 4:33:59 PM  
 WORKSPACE: AHTD  
 L:\2012\201550 - Contr-ell\field Access\Drawings\6TH\_ST\6TH\_MOT\_PRJ2\_ST06\_6TH\_01.dgn  
 REVISED DATE:

- STAGE 6 OBLITERATE EXISTING PAVEMENT
- STAGE 6 GRADING AND PAVING
- TRAFFIC
- TEMPORARY IMPACT ATTENUATION BARRIER
- PRECAST CONCRETE BARRIER
- TRAFFIC DRUM





MAINTENANCE OF TRAFFIC DETAILS  
STAGE 6

DATE REVISED	DATE FILMED	DATE REVISED	DATE FILMED	FED. RD. DIST. NO.	STATE	FED. AID PROJ. NO.	SHEET NO.	TOTAL SHEETS
				6	ARK.			
				JOB NO.		080517	38	182

2 PERMANENT PAVEMENT MARKINGS



Digitally Signed 05/20/2015

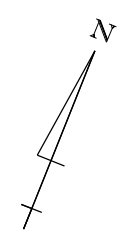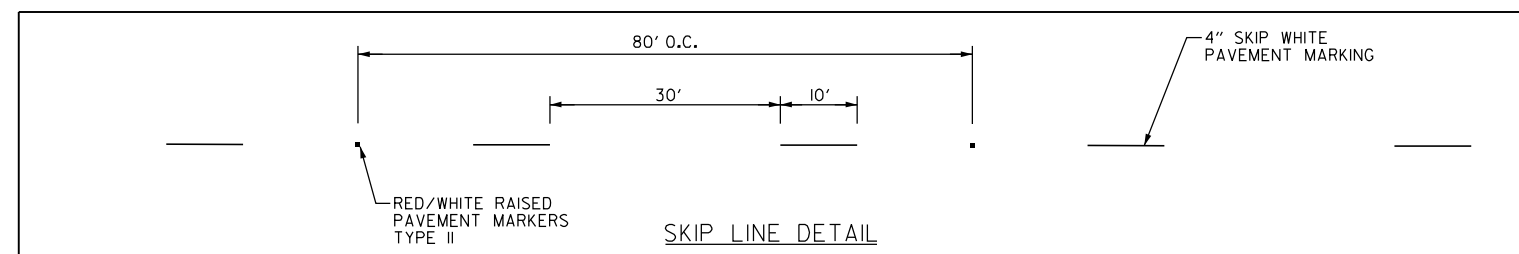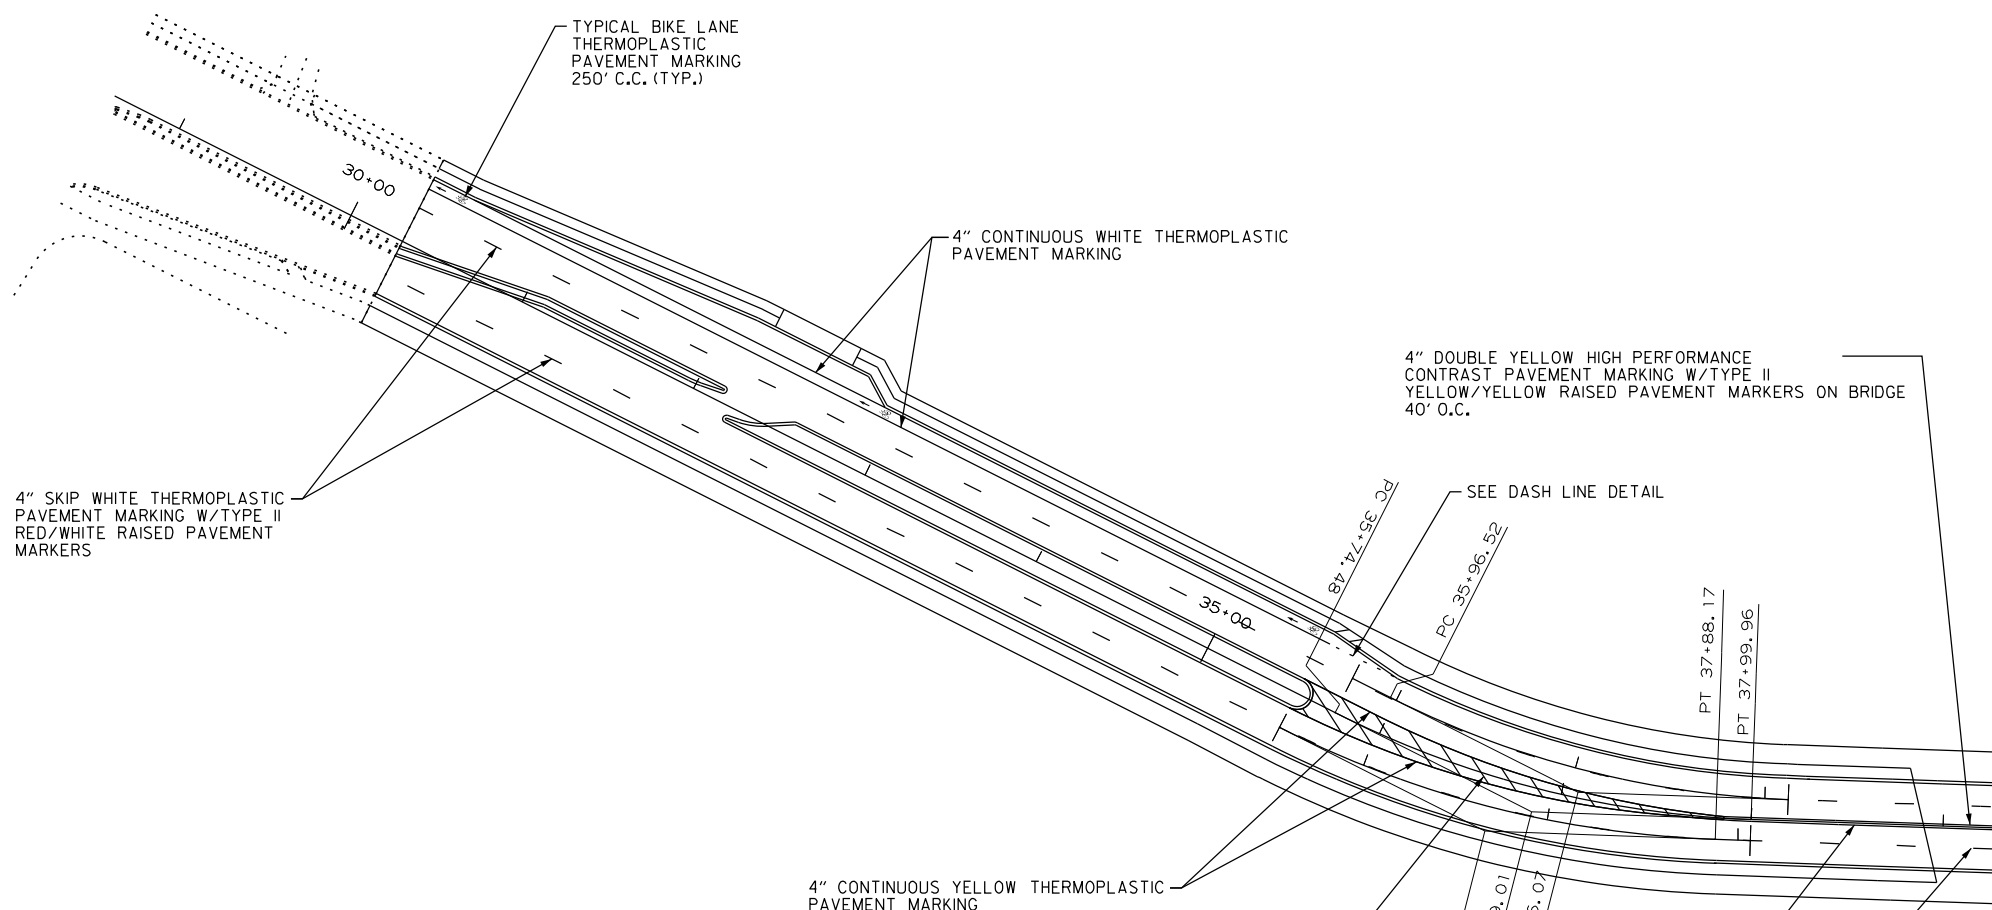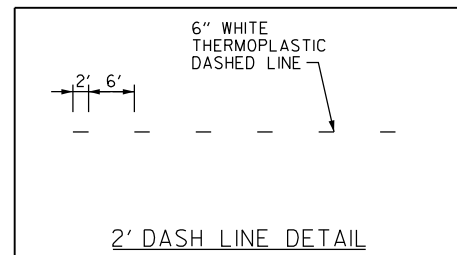





1"=100'

PERMANENT PAVEMENT MARKINGS

5/20/2015 7:54 AM  
 WORKSPACE: AHTD  
 L:\2012\201590 - Contrail\field Access\Drawings\6TH\_ST\6TH\_PM\_01.dgn  
 REVISED DATE:

DATE REVISED	DATE FILMED	DATE REVISED	DATE FILMED	FED. RD. DIST. NO.	STATE	FED. AID PROJ. NO.	SHEET NO.	TOTAL SHEETS
				6	ARK.			
				JOB NO.	080517	39	182	

PERMANENT PAVEMENT MARKINGS

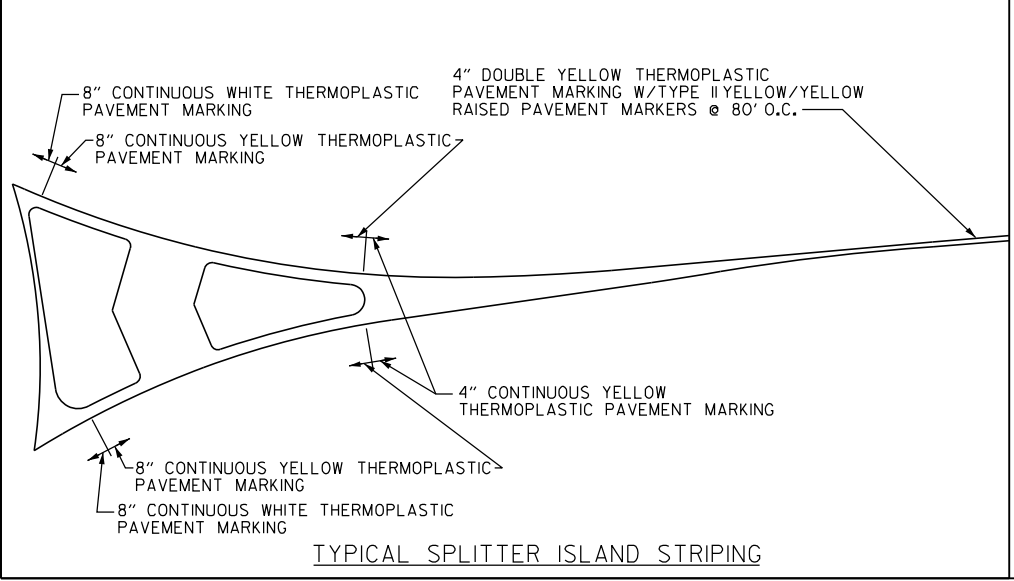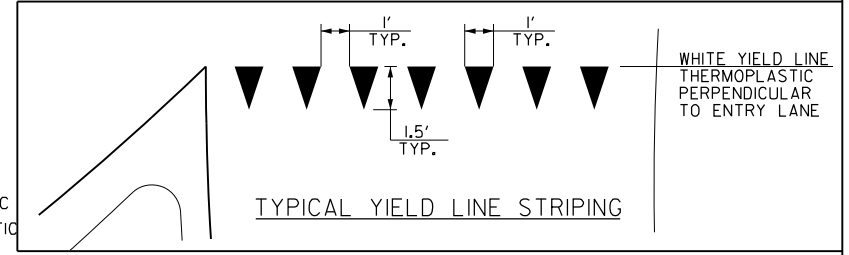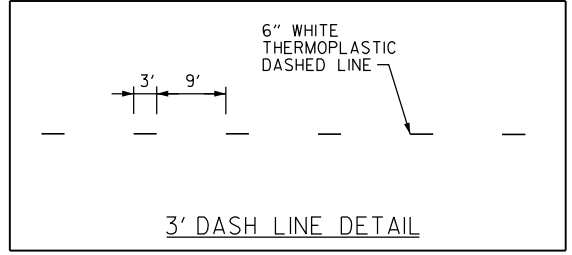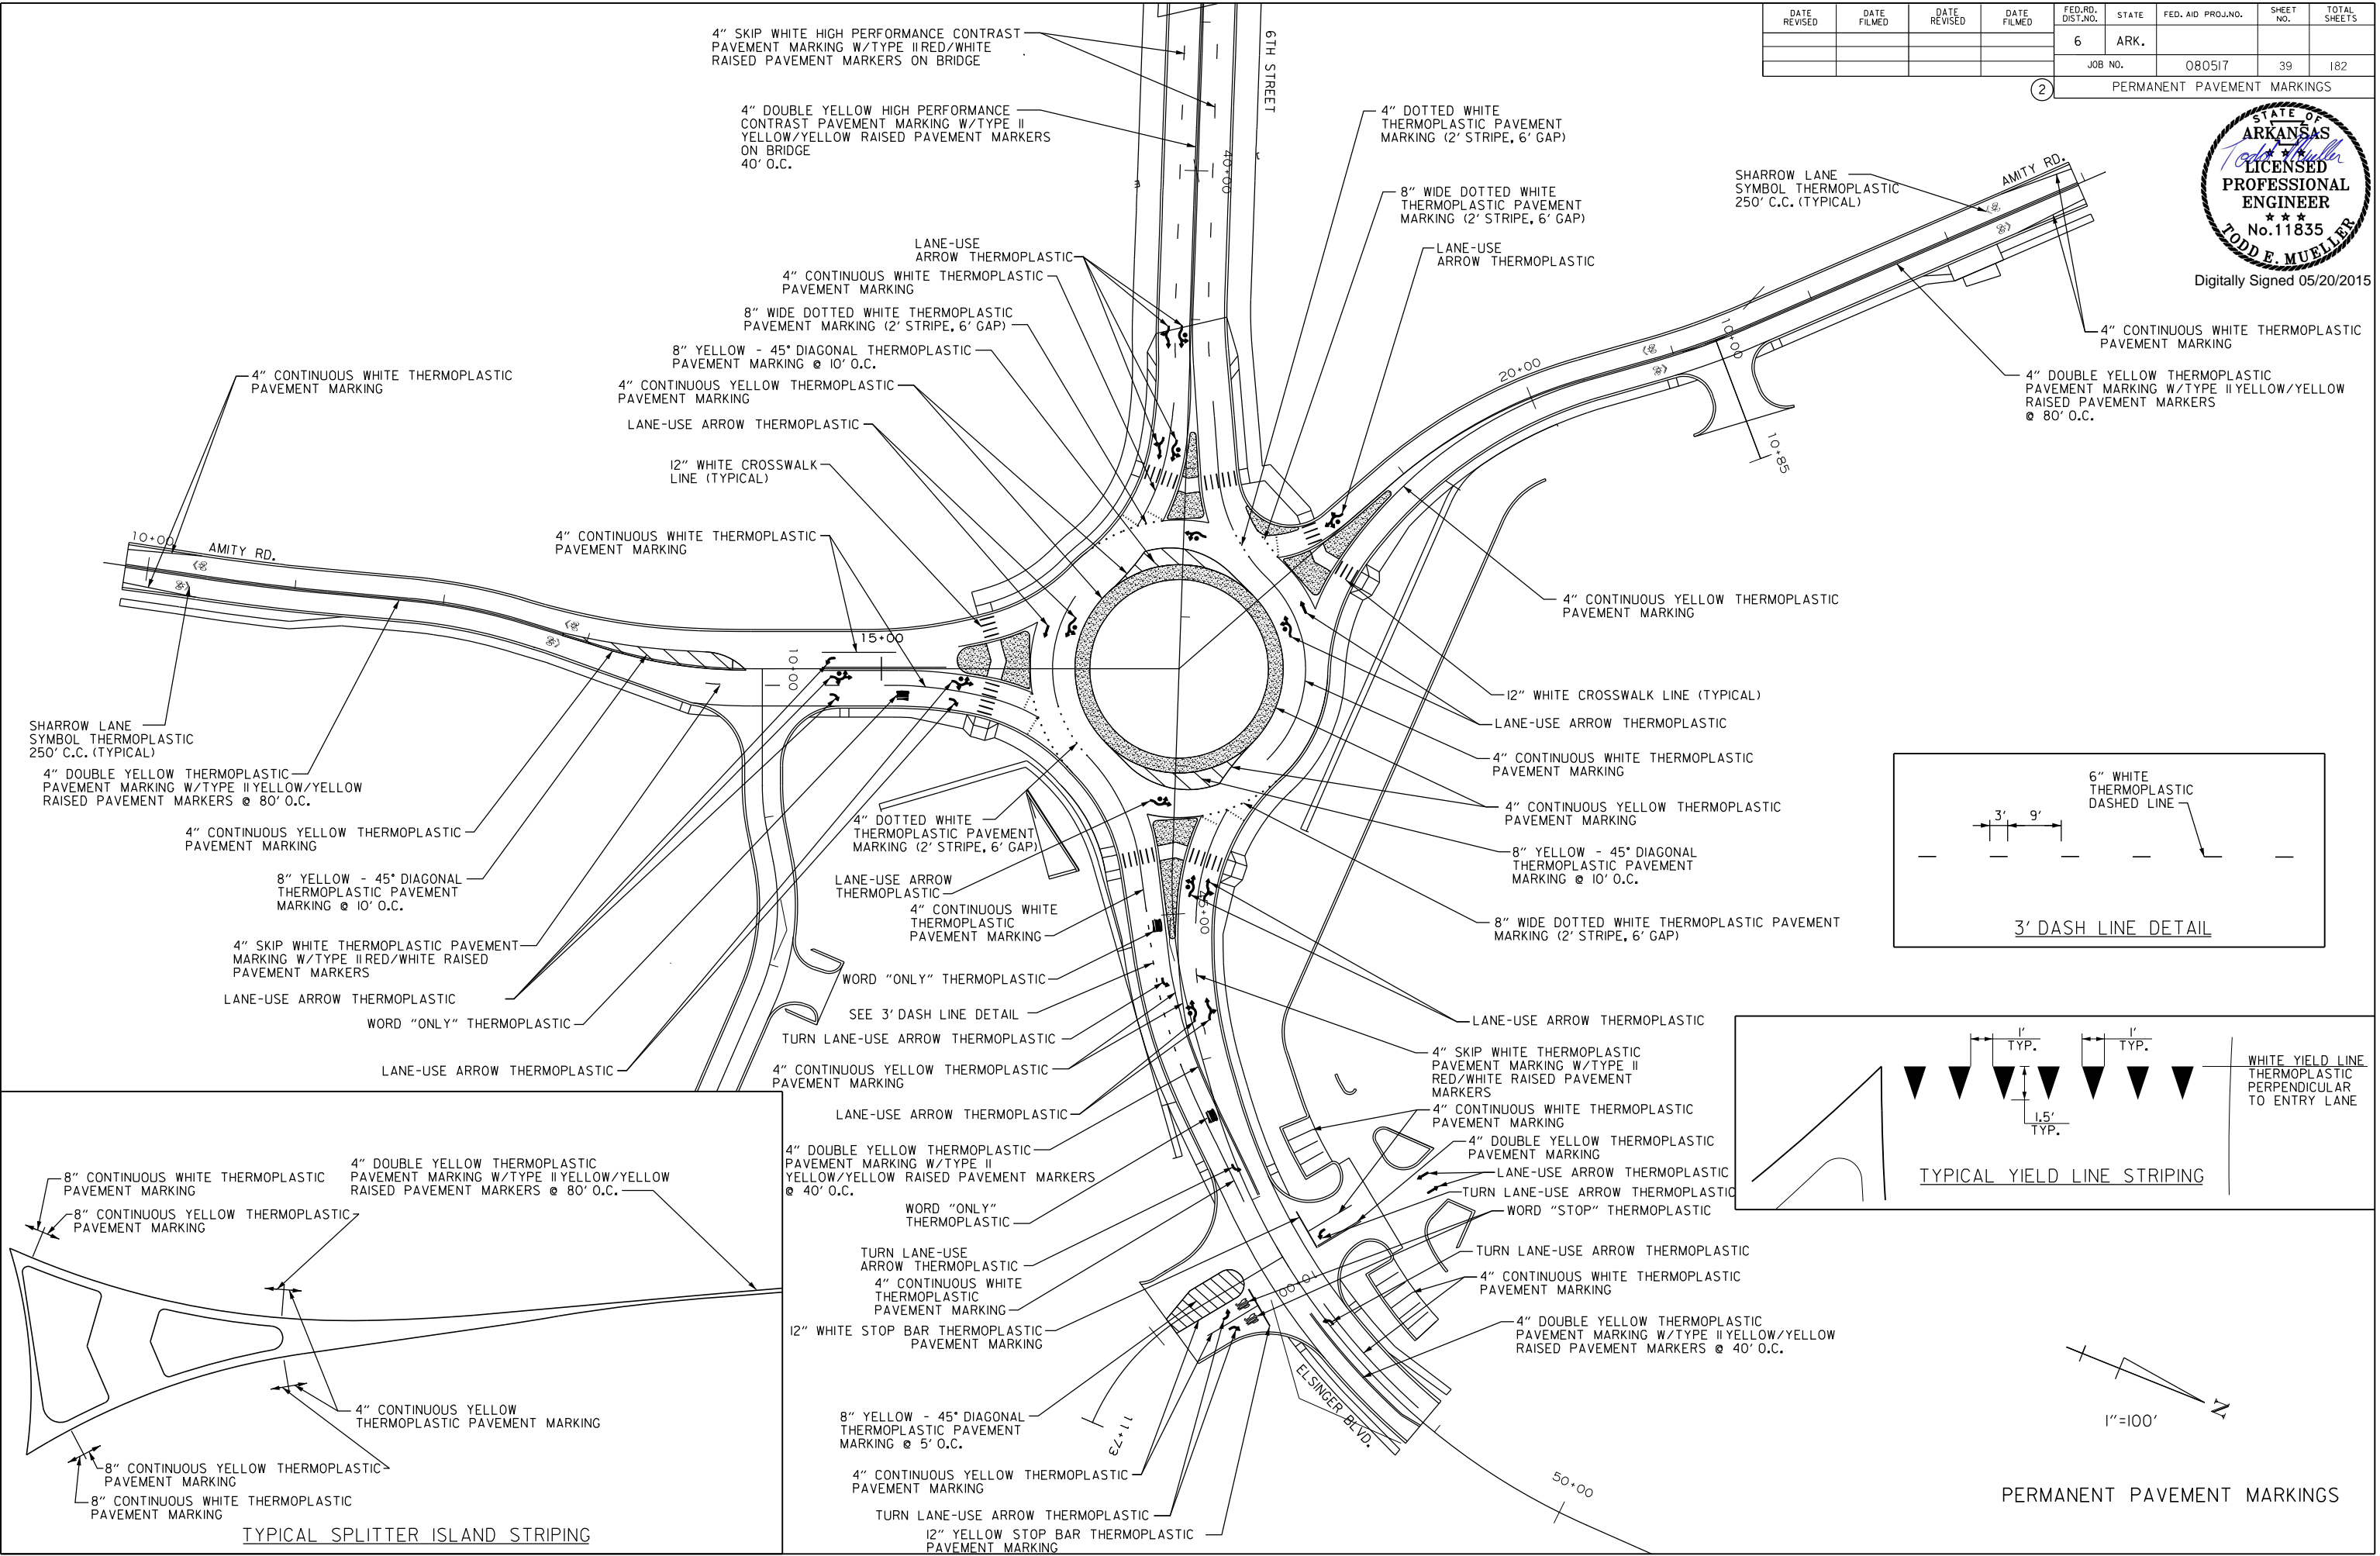

5/20/2015 7:15:15 AM  
 WORKSPACE: AHTD  
 L:\2012\12015590 - Contrail\field Access\Drawings\6TH\_ST\6TH.PM.02.dgn  
 REVISED DATE:



PERMANENT PAVEMENT MARKINGS

DATE REVISED	DATE FILMED	DATE REVISED	DATE FILMED	FED. RD. DIST. NO.	STATE	FED. AID PROJ. NO.	SHEET NO.	TOTAL SHEETS
				6	ARK.			
				JOB NO.		080517	40	182

2 PERMANENT PAVEMENT MARKINGS



Digitally Signed 05/20/2015

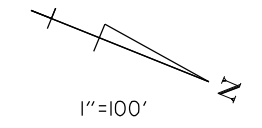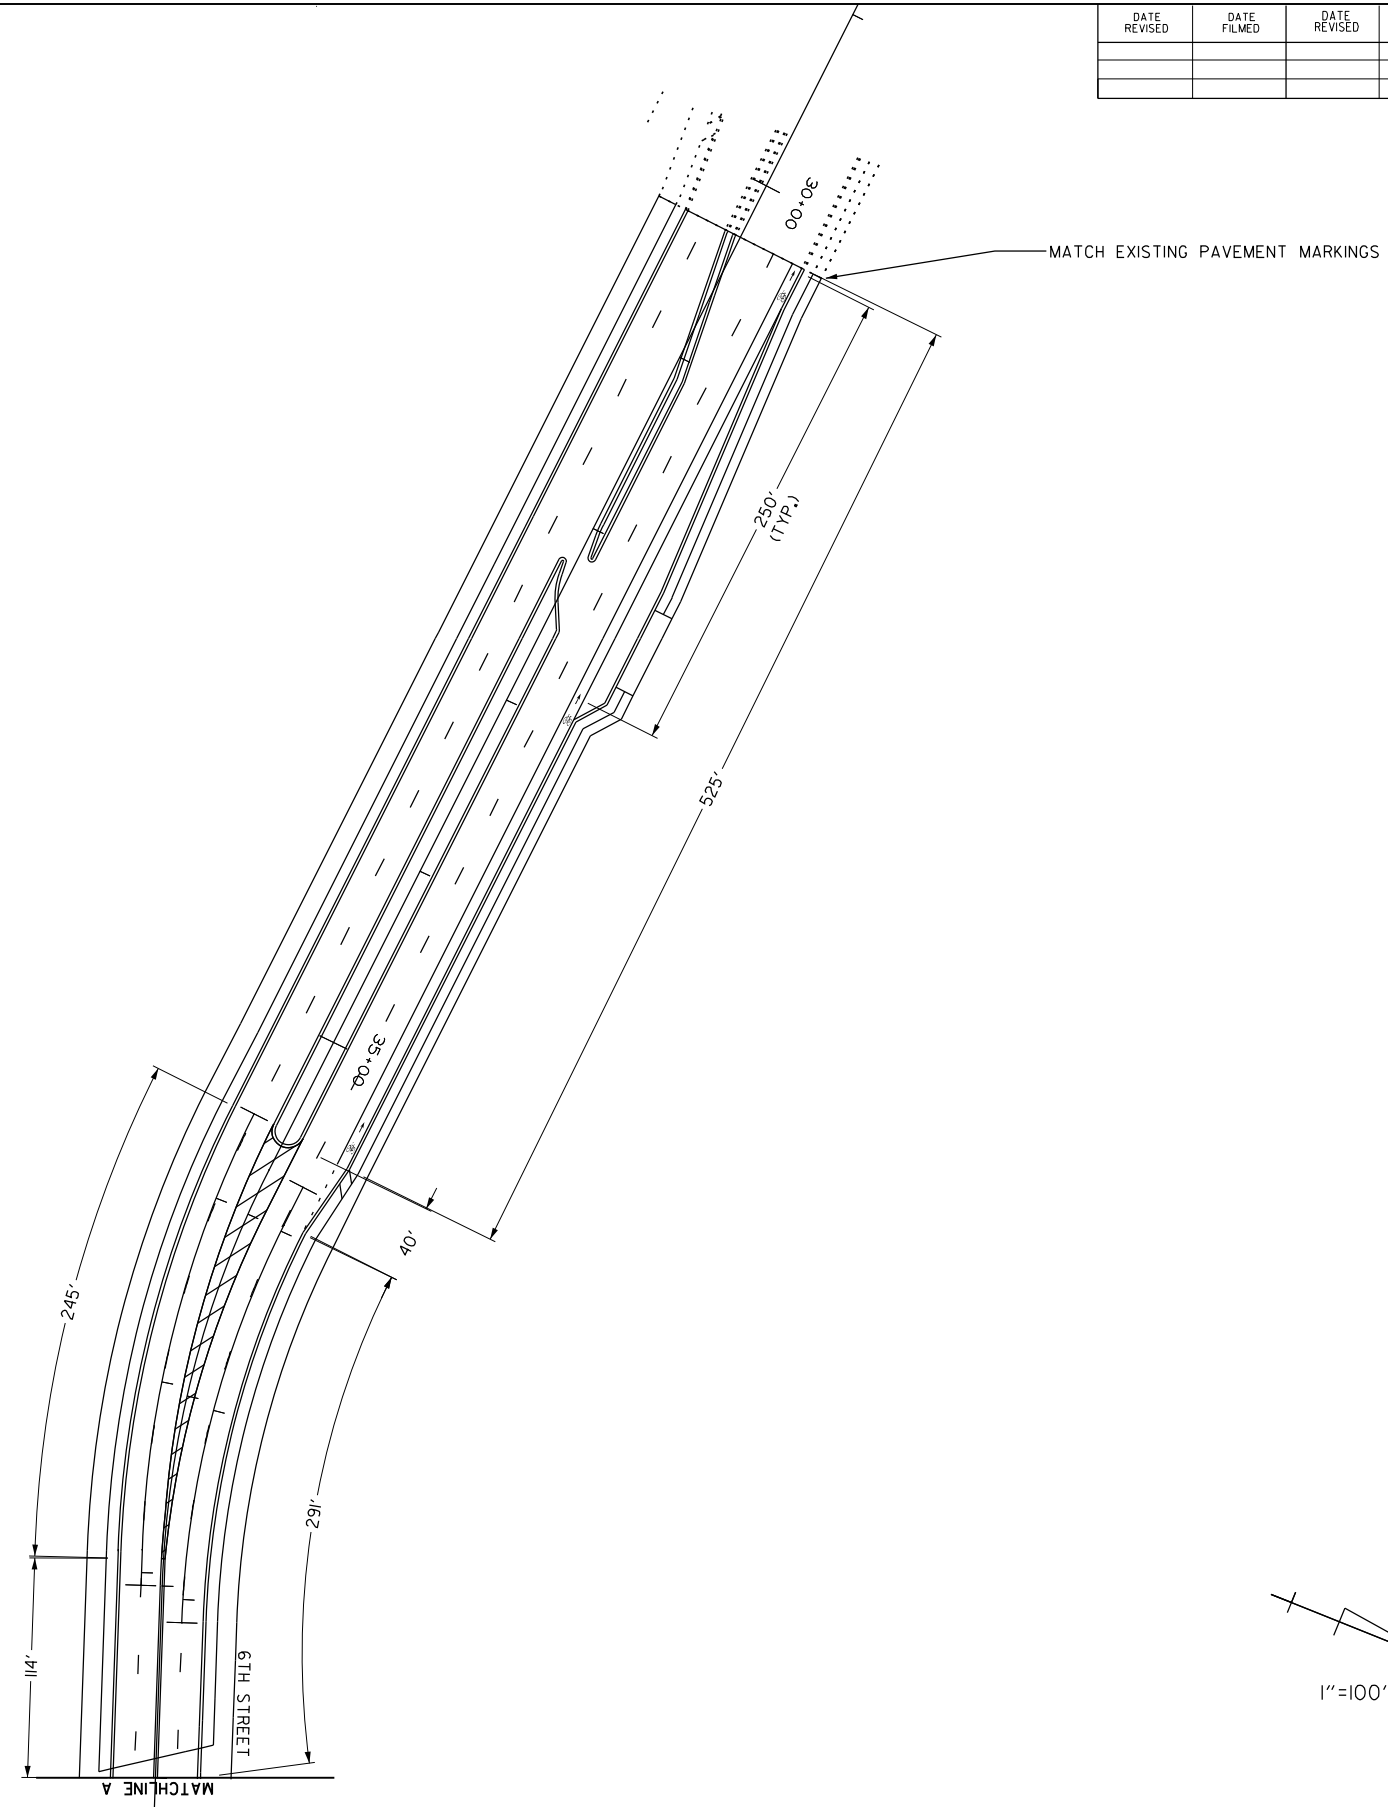


PERMANENT PAVEMENT MARKINGS




DATE REVISED	DATE FILMED	DATE REVISED	DATE FILMED	FED. RD. DIST. NO.	STATE	FED. AID PROJ. NO.	SHEET NO.	TOTAL SHEETS
				6	ARK.			
				JOB NO.	080517		41	182

PERMANENT PAVEMENT MARKINGS

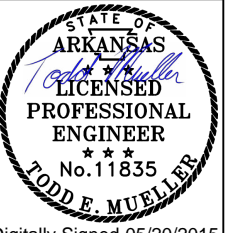


Digitally Signed 05/20/2015

MATCH EXISTING PAVEMENT MARKINGS

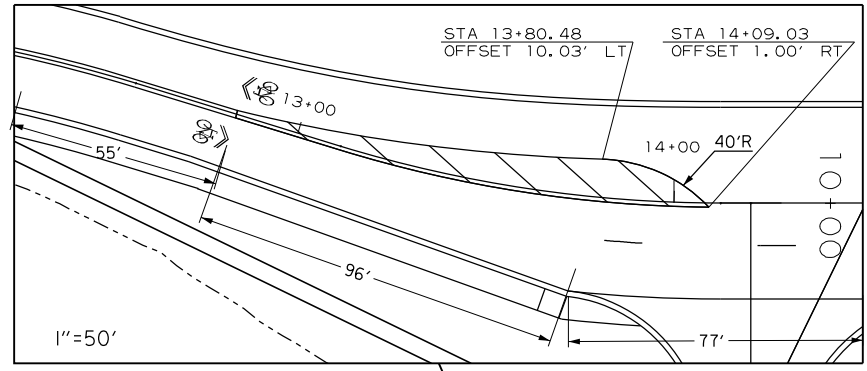

FOR DIMENSIONS INSIDE ROUNDABOUT SEE ROUNDABOUT PERMANENT PAVEMENT MARKINGS

1"=100'

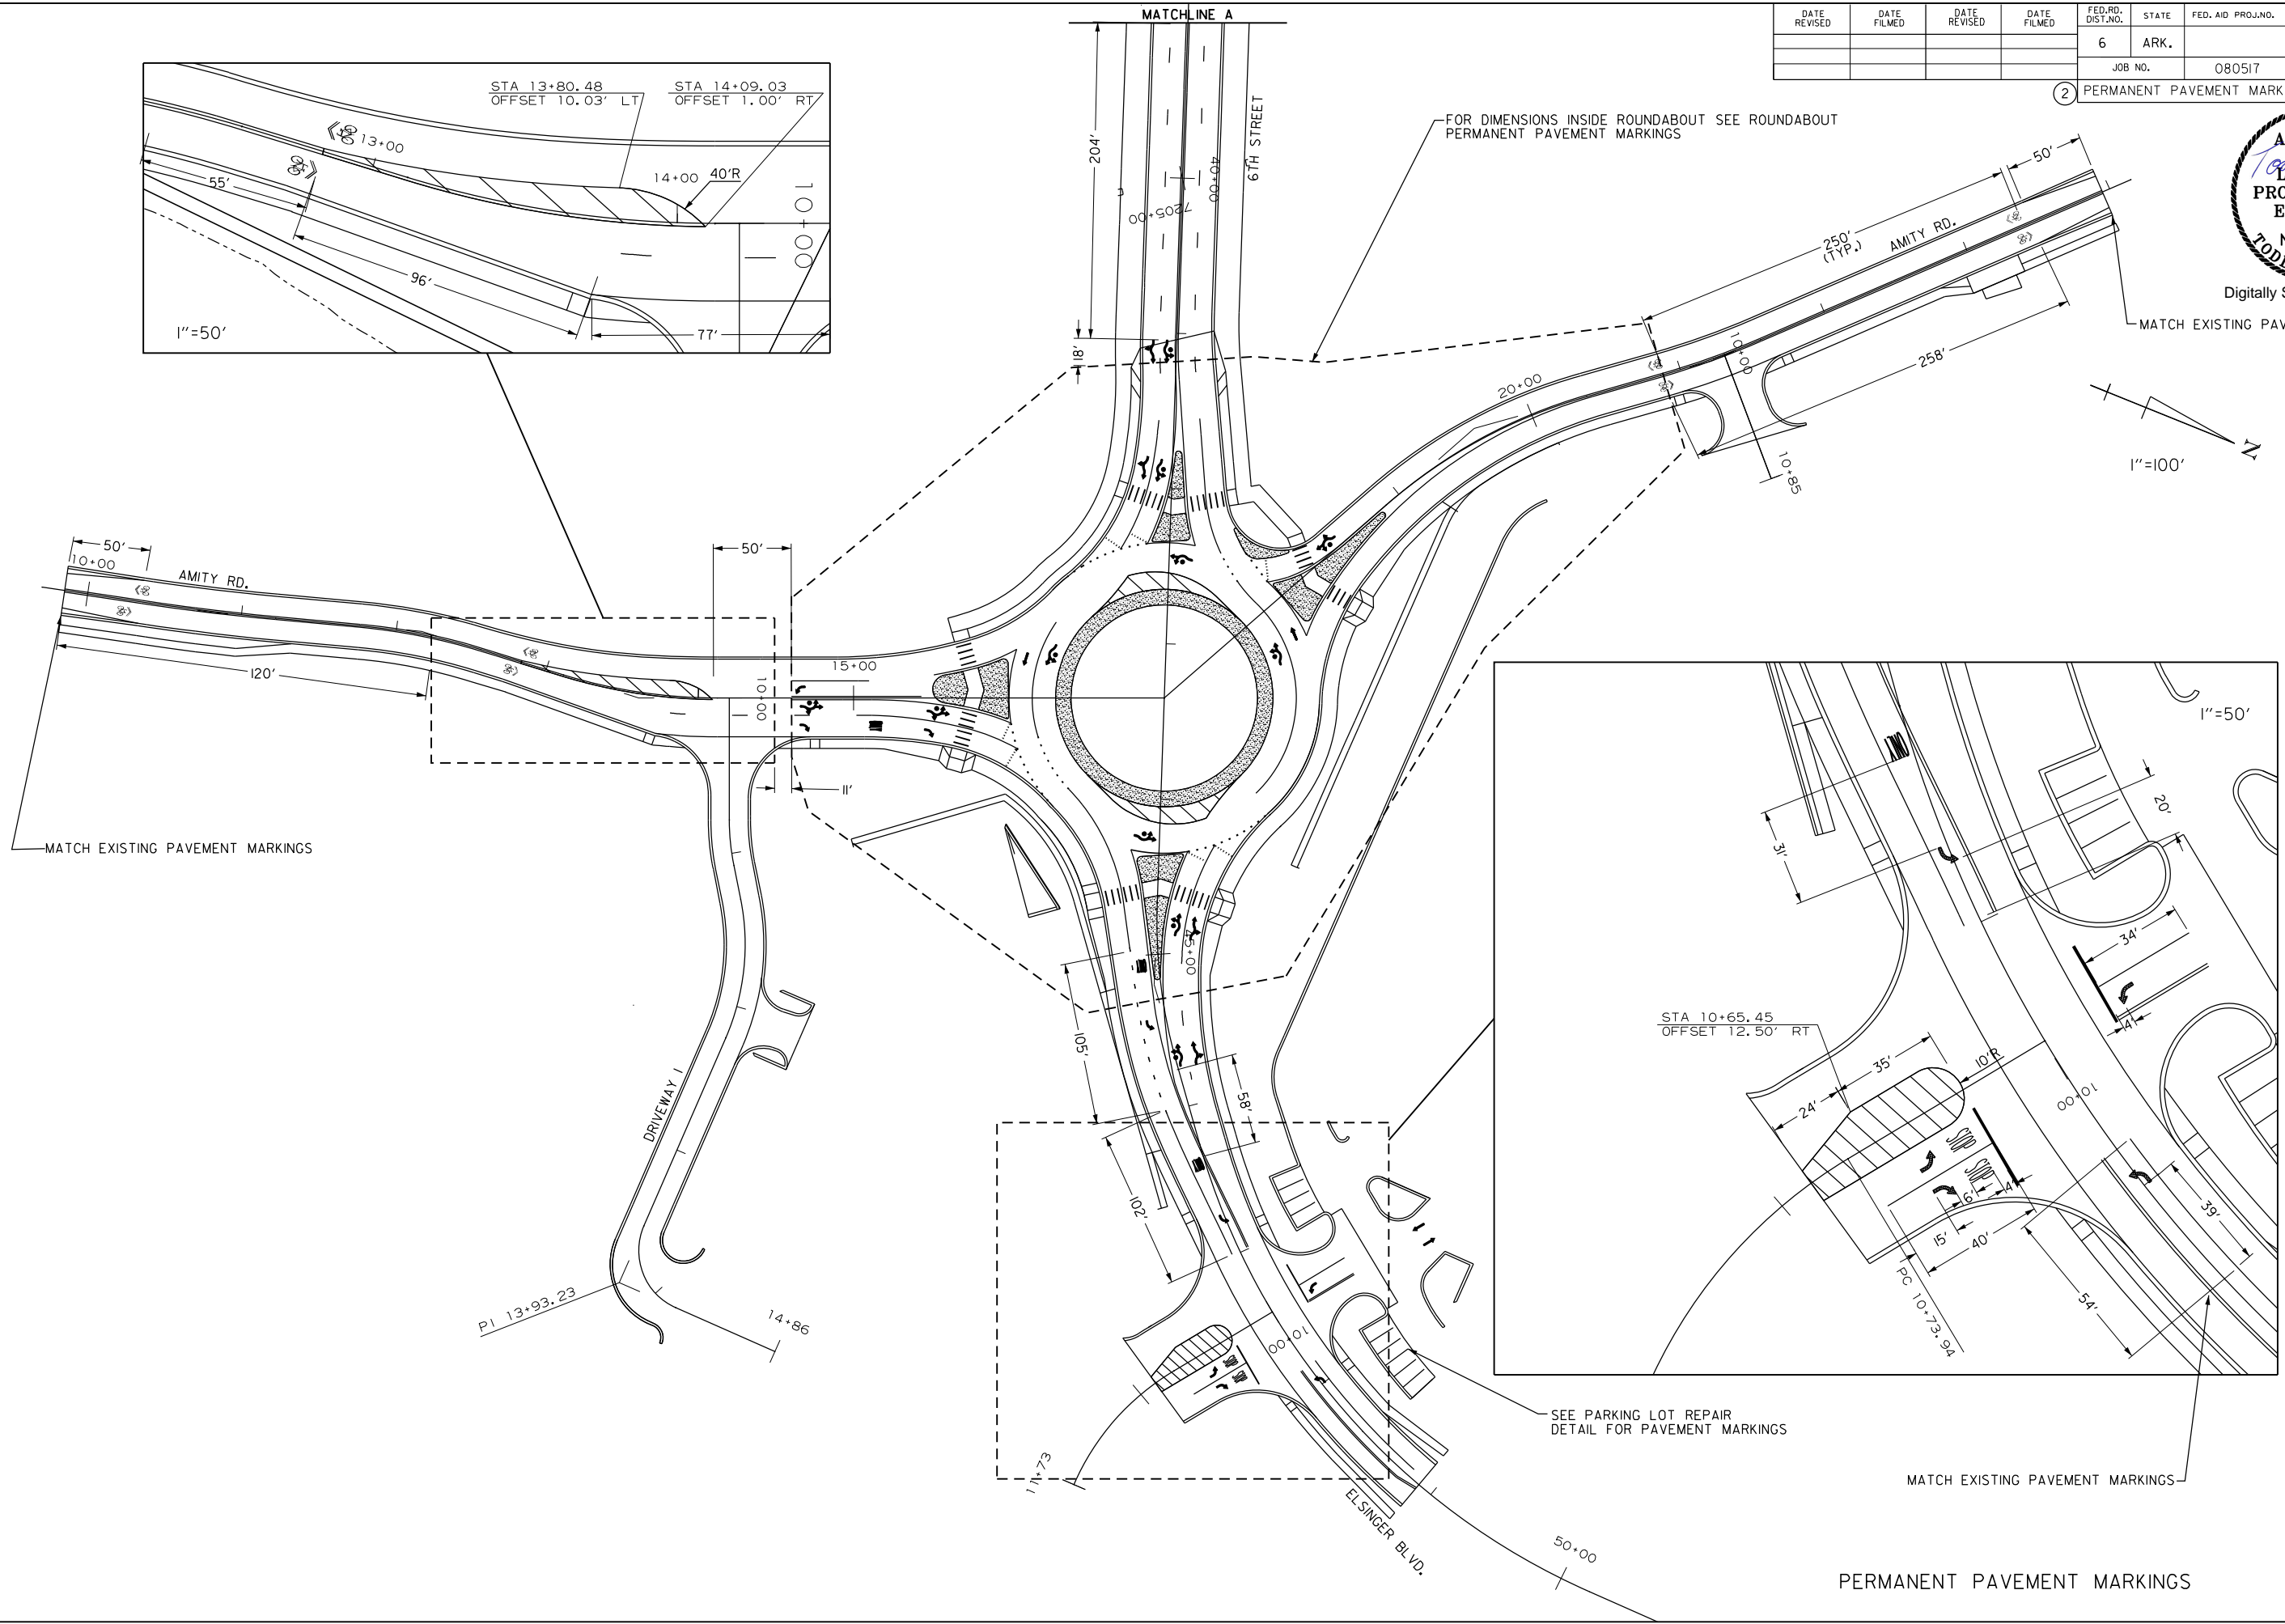


5/20/2015 7:15:15 AM  
 WORKSPACE: AHTD  
 L:\2012\201590 - Conrail\field Access\Drawings\6TH\_ST\6TH.PM\_04.dgn  
 REVISED DATE:


PERMANENT PAVEMENT MARKINGS

DATE REVISED	DATE FILMED	DATE REVISED	DATE FILMED	FED. RD. DIST. NO.	STATE	FED. AID PROJ. NO.	SHEET NO.	TOTAL SHEETS
				6	ARK.			
				JOB NO.		080517	42	182

2 PERMANENT PAVEMENT MARKINGS

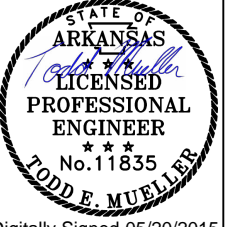

Digitally Signed 05/20/2015

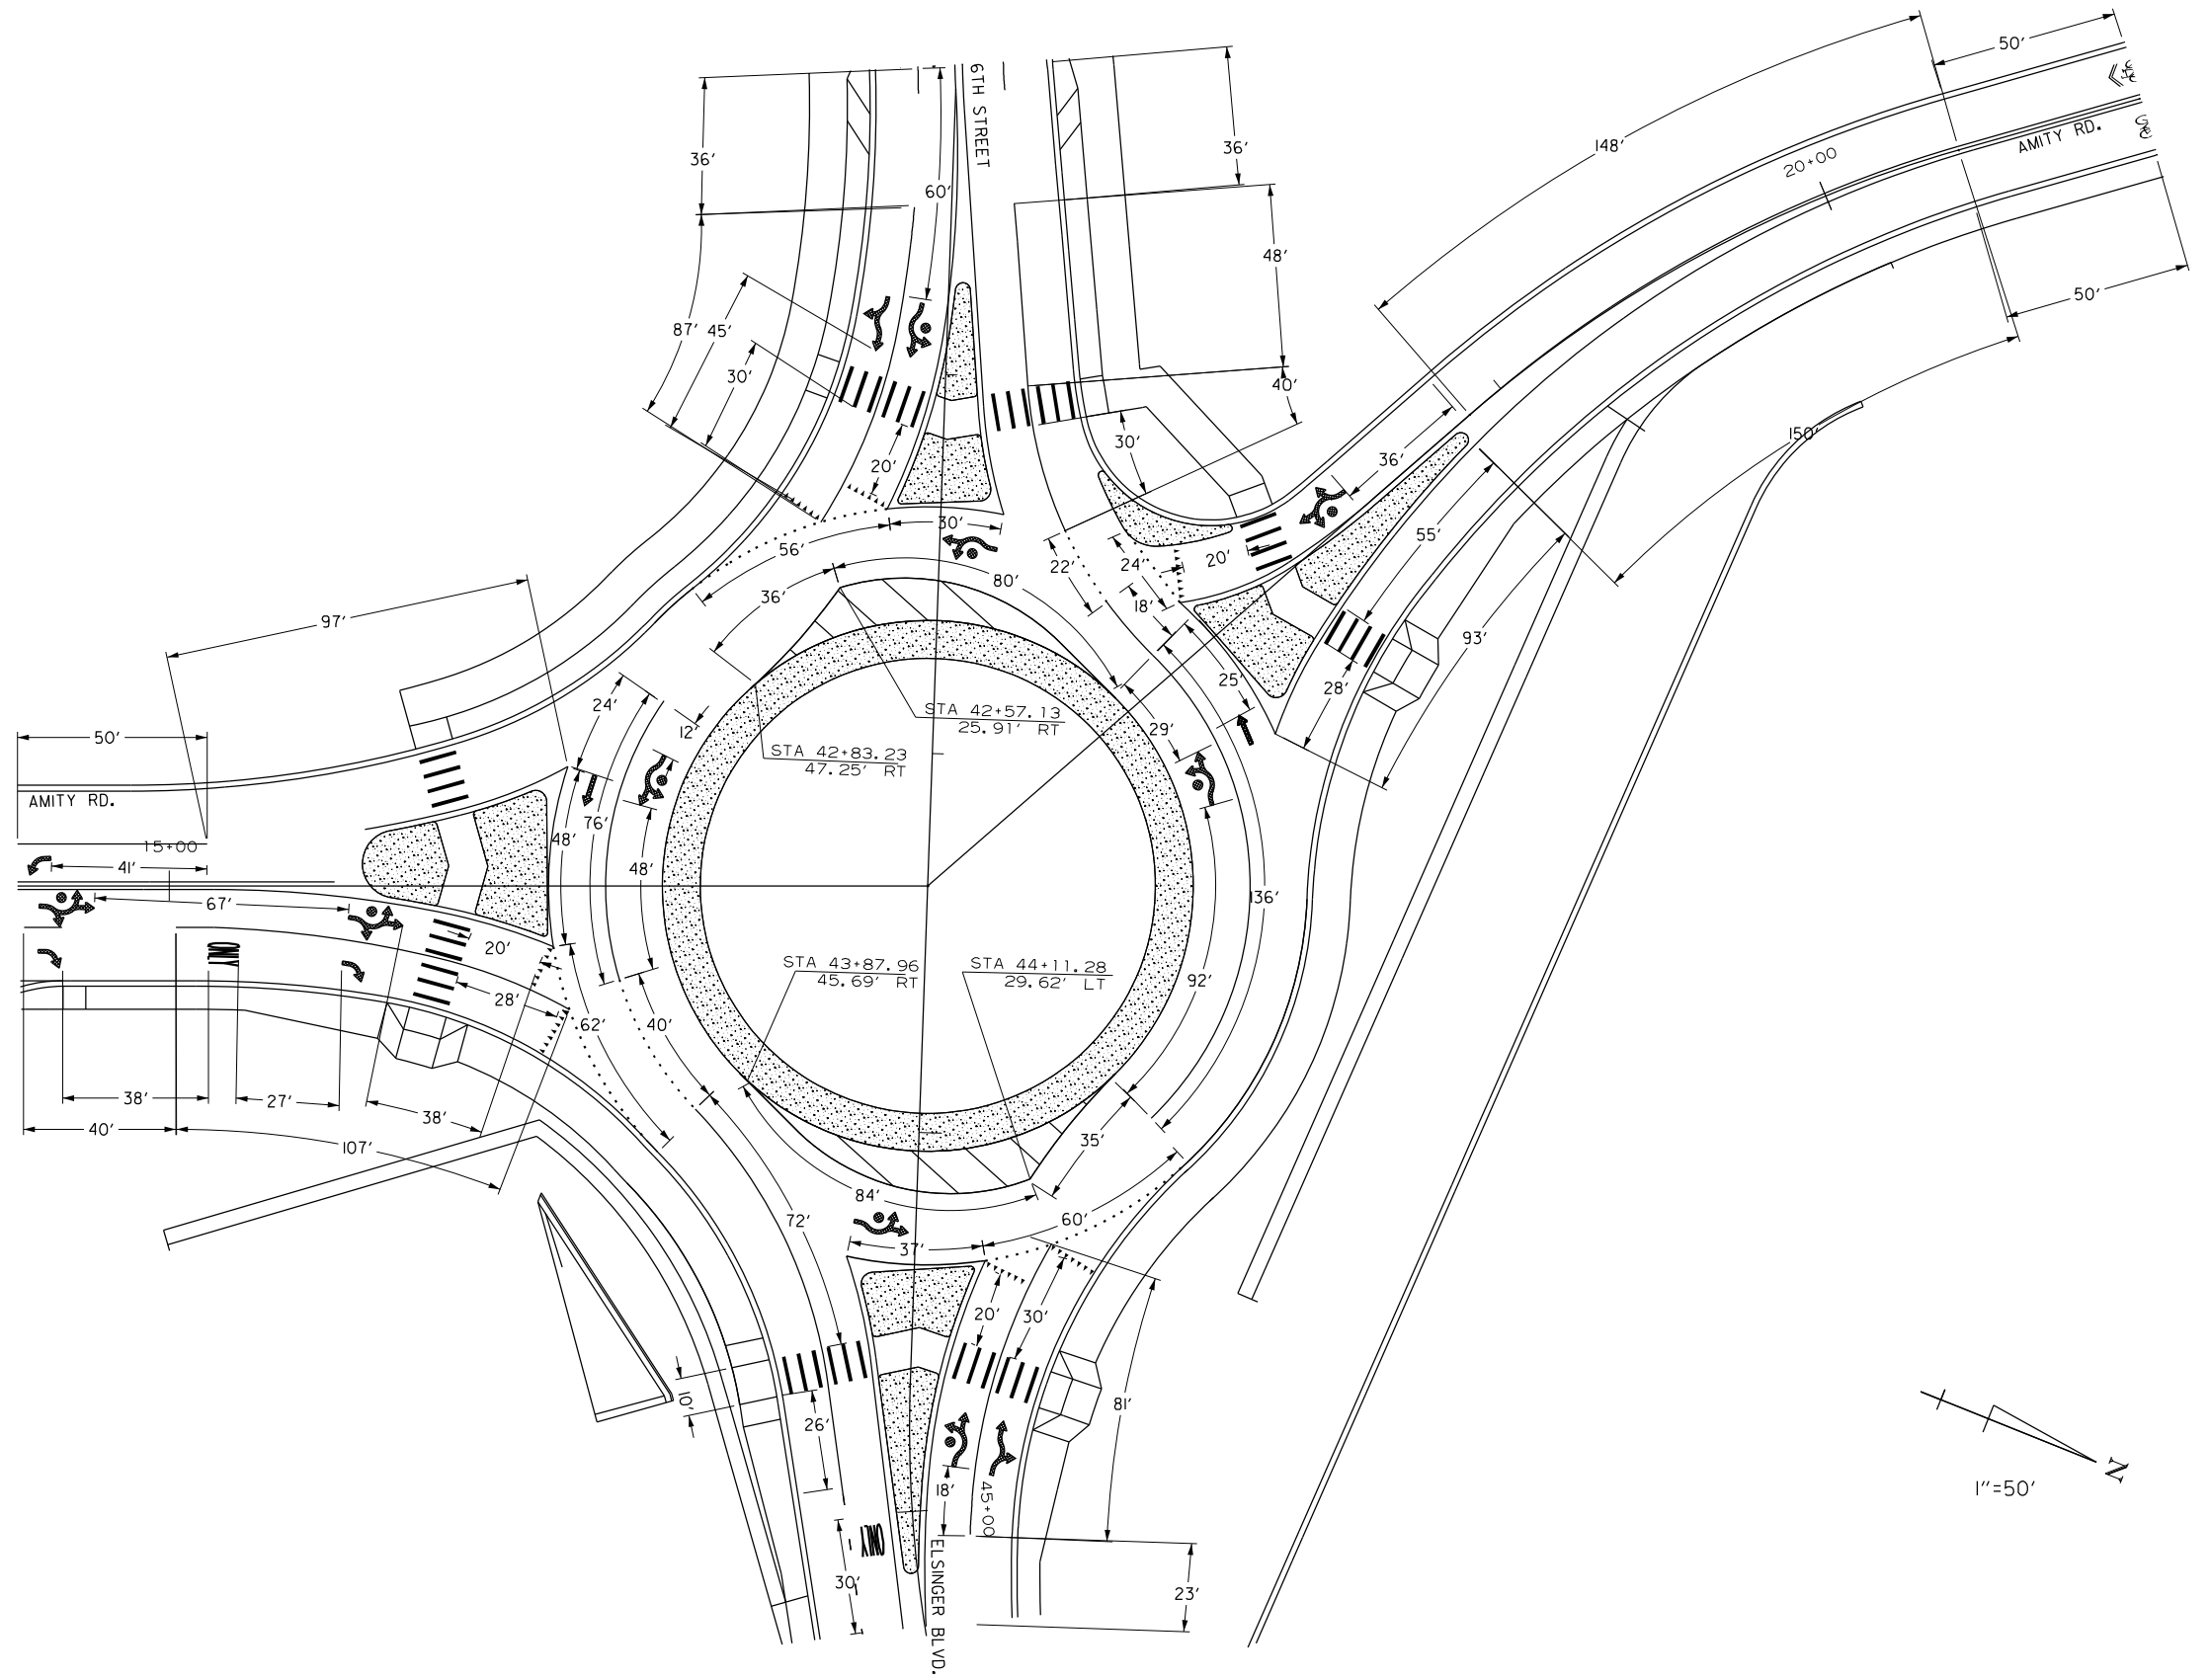

PERMANENT PAVEMENT MARKINGS

5/20/2015 7:15:16 AM  
 WORKSPACE: AHTD  
 L:\2012\201590 - Conrail\field Access\Drawings\6TH\_ST\6TH\_PM\_05.dgn  
 REVISED DATE:

DATE REVISED	DATE FILMED	DATE REVISED	DATE FILMED	FED. RD. DIST. NO.	STATE	FED. AID PROJ. NO.	SHEET NO.	TOTAL SHEETS
				6	ARK.			
						080517	43	182

2 SOIL BORING LOG



Digitally Signed 05/20/2015



SOIL BORING LOG											
BORING NO.	APPROX. STATION (ft)	OFFSET (ft)	SAMPLE DEPTH (ft)	WATER CONTENT (%)	ATTERBERG LIMITS			SIEVE ANALYSIS		UNIFIED CLASS.	AASHTO CLASS.
					LIQUID LIMIT	PLASTIC LIMIT	PLASTICITY INDEX	#4, %	#200, %		
R1	28+38	3' RT.	2.5-3.5	24	23	19	4	----	96	CL-ML	A-4
R1	28+38	3' RT.	4.5-5.5	23	40	22	18	2	68	CL	A-6
R2	32+33	34' LT.	1-2	17	34	19	15	19	53	CL	A-6
R4	21+80	6' RT.	2.5-3.5	17	35	21	14	----	59	CL	A-6
R4	21+80	6' RT.	4.5-5.5	16	39	23	16	----	60	CL	A-6
R5	42+23	17' LT.	1.5-2.5	14	33	19	14	29	42	GC	A-6
R6	46+67	6' RT.	2.5-3.5	18	40	23	17	----	70	CL	A-6
R6	46+67	6' RT.	4-4.5	13	40	24	16	----	----	SHALE	
R7	11+96	34' RT.	1-2	8	25	16	9	----	23	GC	A-2-4
R7	11+96	34' RT.	2.5-3.5	17	35	18	17	----	50	SC	A-6

5/20/2015 7:18:24 AM  
 WORKSPACE: AHTD  
 L:\2012\201590 - ConrailField Access\Drawings\6TH.\$T\6TH.SBL\_02.dgn  
 REVISED DATE:



DATE REVISED	DATE FILMED	DATE REVISED	DATE FILMED	FED. RD. DIST. NO.	STATE	FED. AID PROJ. NO.	SHEET NO.	TOTAL SHEETS
2-10-2016				6	ARK.		45	182
				JOB NO.		080517		

CURVE	PC	PI	PT	Δ	D	TANGENT	LENGTH	e	Ls	DESIGN SPEED
						FEET	FEET	FT./FT.	FEET	
I-40-1	7202+60.36	7220+17.86	7234+13.20	63°03'25" RT.	02°00'00"	1757.50	3152.84	MATCH EXIST.	MATCH EXIST.	70 MPH
6TH-1	25+94.08	26+60.31	27+26.49	03°58'20" RT.	03°00'00"	66.23	132.40	N.C.	N.A.	30 MPH
6TH-2	35+74.48	36+89.01	37+99.96	24°48'07" LT.	11°00'00"	114.53	225.47	N.C.	N.A.	30 MPH
6TH-3	44+66.48	45+19.64	45+71.94	17°55'42" LT.	17°00'00"	53.16	105.46	N.C.	N.A.	30 MPH
6TH-4	46+25.64	48+36.66	50+20.28	50°14'50" LT.	12°43'57"	211.02	394.64	N.C.	N.A.	30 MPH
6TH-RT-1	35+51.96	36+71.94	37+88.17	24°48'07" LT.	10°30'00"	119.98	236.21	N.C.	N.A.	30 MPH
6TH-LT-1	35+96.52	37+06.07	38+12.19	24°48'07" LT.	11°30'00"	109.55	215.67	N.C.	N.A.	30 MPH
AMTY-1	10+40.61	10+81.32	11+22.01	03°15'23" LT.	04°00'00"	40.71	81.41	N.C.	N.A.	30 MPH
AMTY-2	11+76.65	12+16.43	12+55.93	11°53'28" RT.	15°00'00"	39.78	79.27	N.C.	N.A.	30 MPH
AMTY-3	13+11.71	13+62.29	14+12.13	17°04'21" RT.	17°00'00"	50.59	100.43	N.C.	N.A.	30 MPH
AMTY-4	18+89.37	19+64.48	20+37.17	25°07'38" RT.	17°00'00"	75.11	147.81	N.C.	N.A.	30 MPH
AMTY-5	20+86.72	21+21.00	21+55.17	07°31'45" LT.	11°00'00"	34.27	68.45	N.C.	N.A.	30 MPH
DRWYI-1	11+61.59	12+34.89	13+05.11	28°42'15" RT.	20°00'00"	73.30	143.52	N.C.	N.A.	30 MPH
DRWYI-2	13+13.71	13+26.71	13+39.69	5°11'45" RT.	20°00'00"	13.00	25.98	N.C.	N.A.	30 MPH
DRWYI-3	13+50.50	13+90.27	14+13.10	89°40'44" LT.	143°14'22"	39.78	62.61	N.C.	N.A.	30 MPH
ADET-1	9+70.31	10+47.48	11+23.53	16°51'15" LT.	11°00'00"	77.17	153.22	N.C.	N.A.	30 MPH
ADET-2	12+57.11	13+07.17	13+57.10	6°59'58" RT.	7°00'00"	50.06	99.99	N.C.	N.A.	30 MPH
ADET-3	15+00.36	15+81.64	16+61.63	17°44'22" LT.	11°00'00"	81.28	161.27	N.C.	N.A.	30 MPH
ADET-4	23+14.66	25+47.41	27+55.76	45°12'46" LT.	10°15'00"	232.76	441.10	N.C.	N.A.	30 MPH

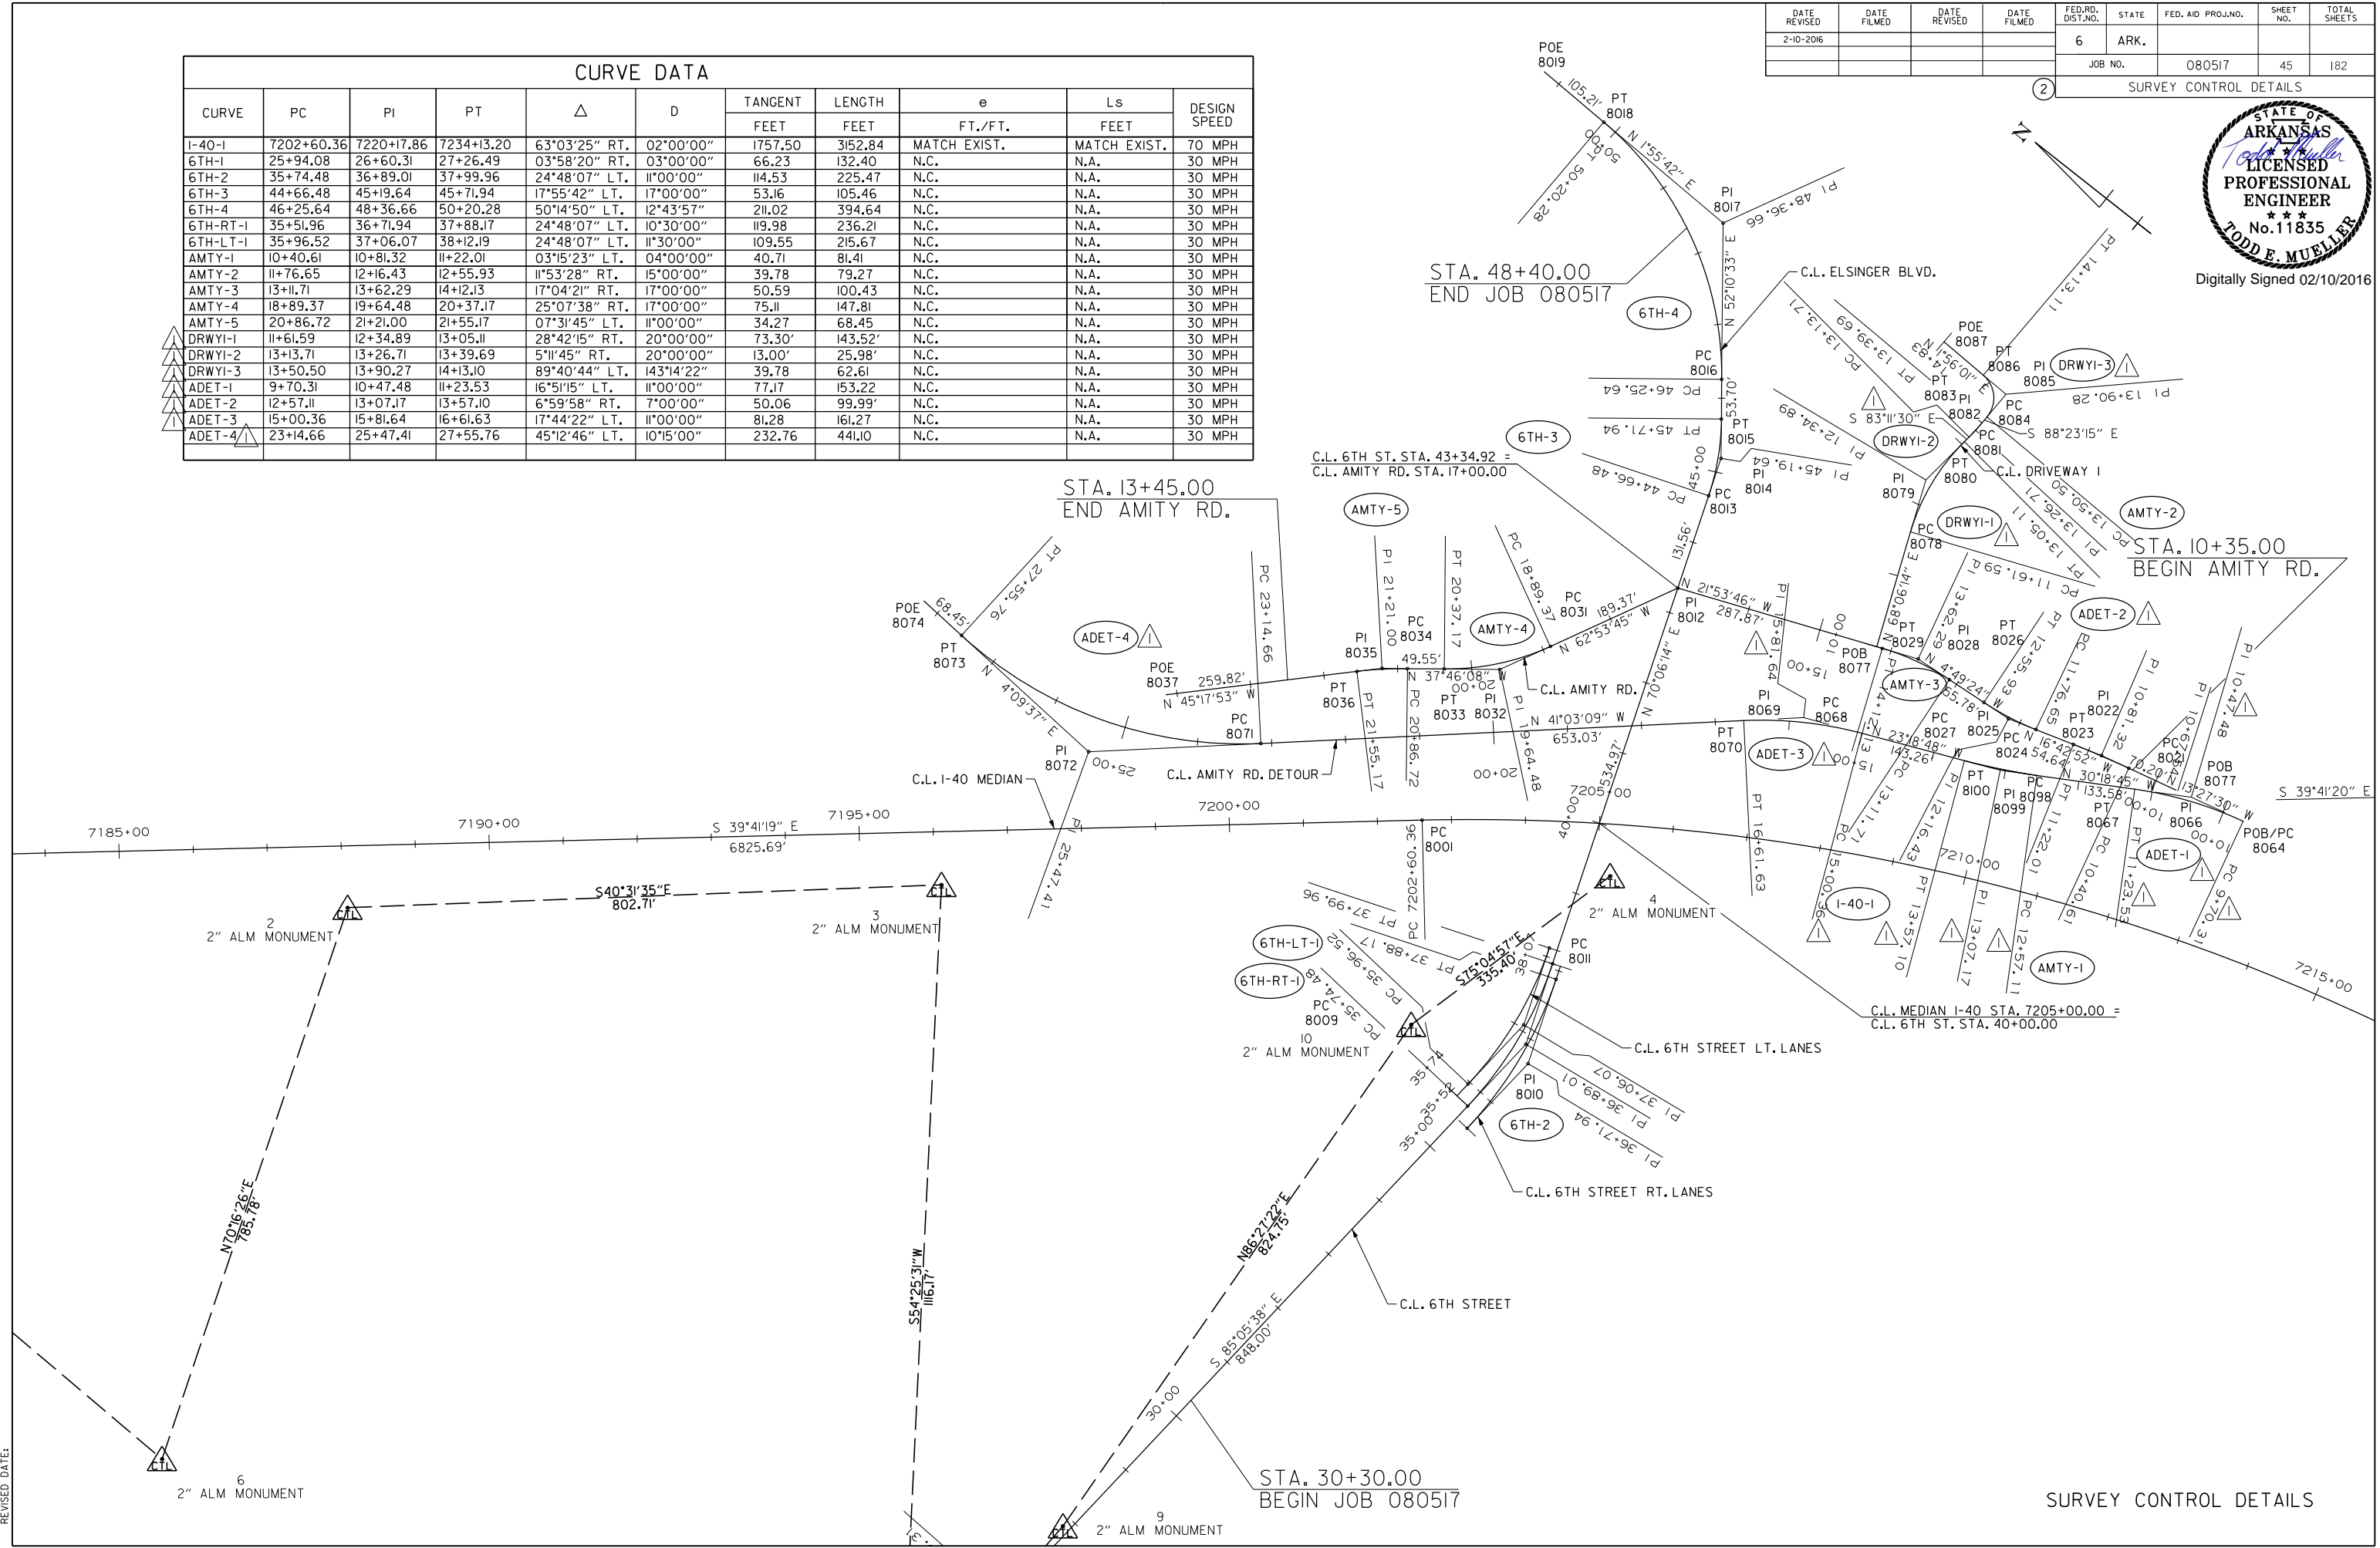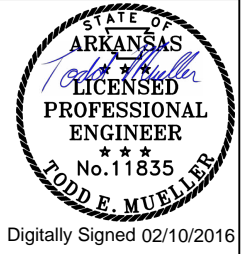


2/10/2016 4:34:01 PM  
 WORKSPACE: AHTD  
 L:\2012\1201590 - Contr-ell\field Access\Drawings\6TH\_ST\6TH\_SC\_02.dgn  
 REVISION DATE:

SURVEY CONTROL DETAILS

DATE REVISED	DATE FILMED	DATE REVISED	DATE FILMED	FED. RD. DIST. NO.	STATE	FED. AID PROJ. NO.	SHEET NO.	TOTAL SHEETS
2-10-2016				6	ARK.	080517	46	182


PLAN AND PROFILE - I-40

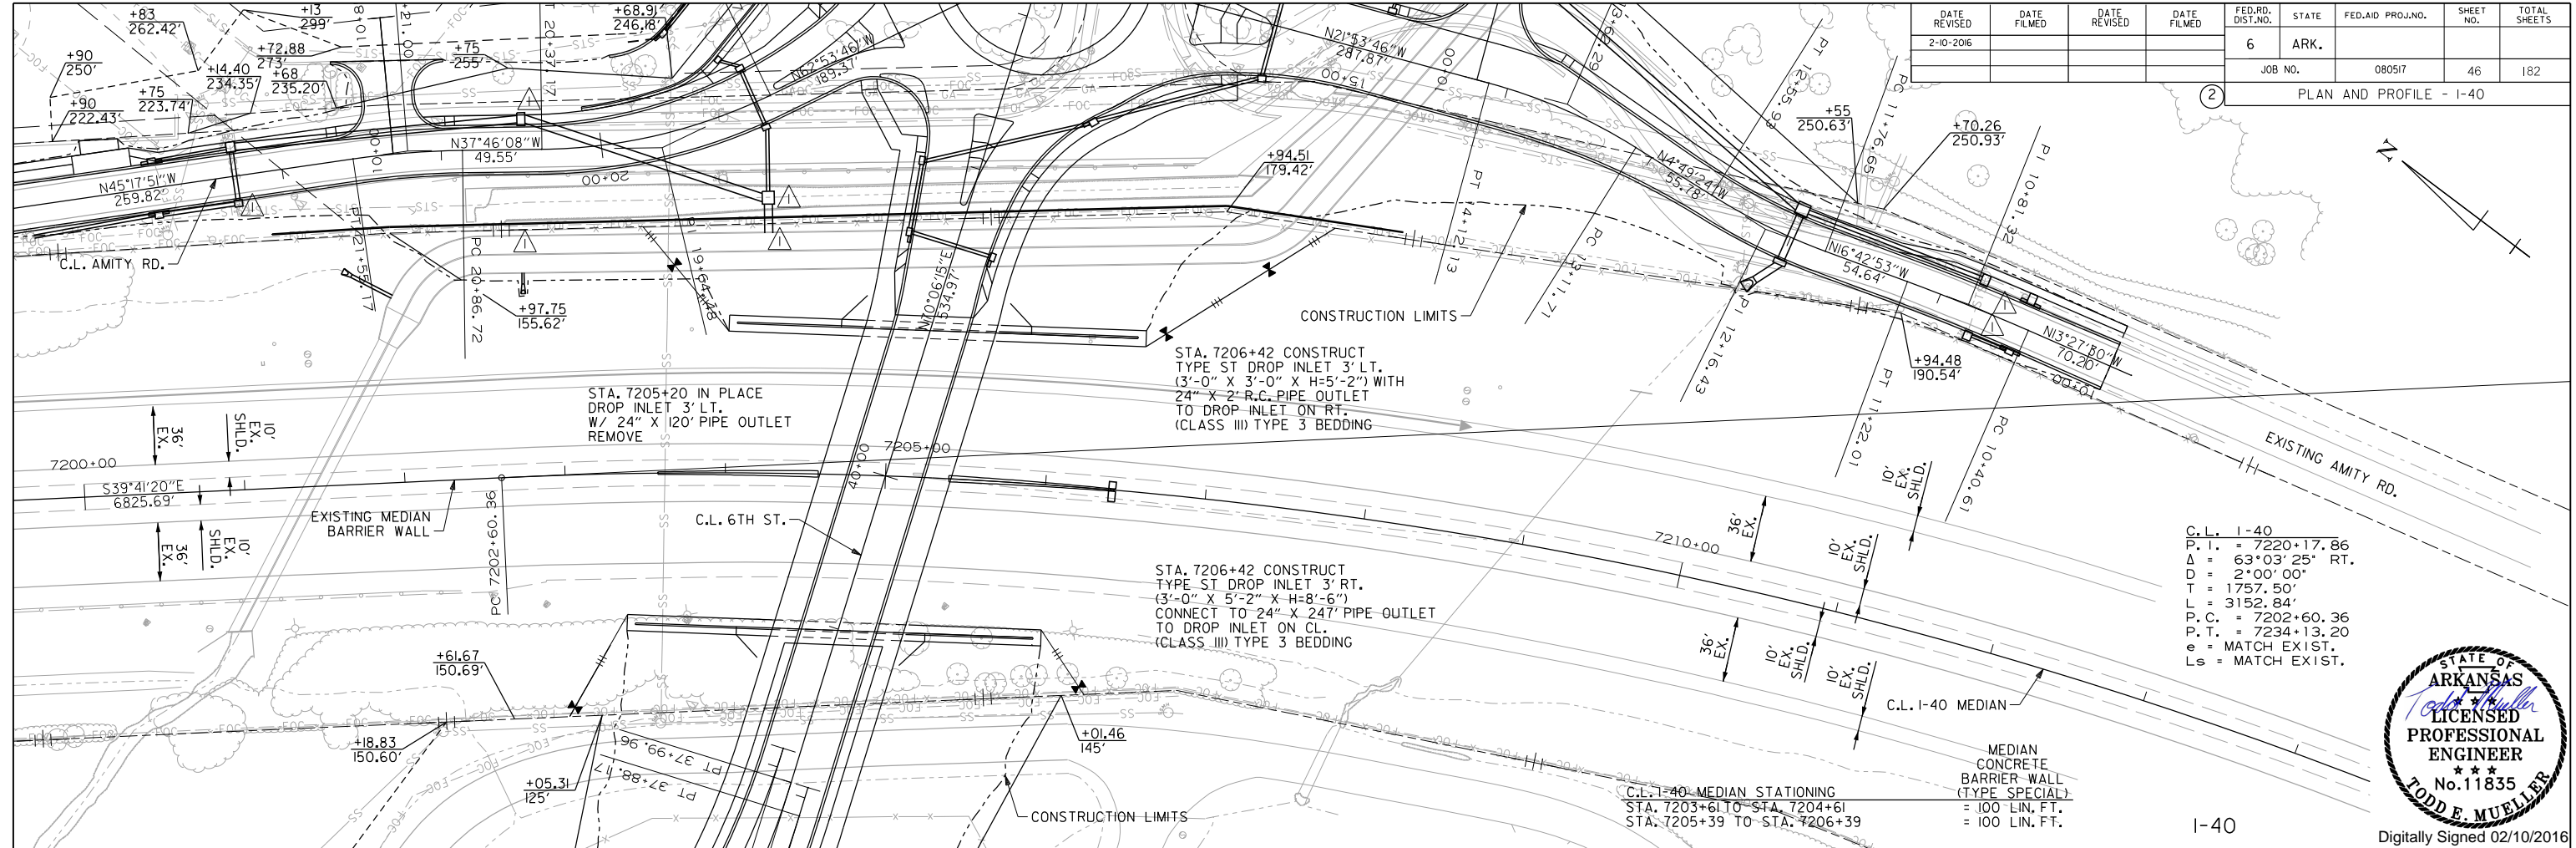

C.L. I-40  
 P. I. = 7220+17.86  
 $\Delta$  = 63°03'25" RT.  
 D = 2'00'00"  
 T = 1757.50'  
 L = 3152.84'  
 P. C. = 7202+60.36  
 P. T. = 7234+13.20  
 e = MATCH EXIST.  
 Ls = MATCH EXIST.




Digitally Signed 02/10/2016

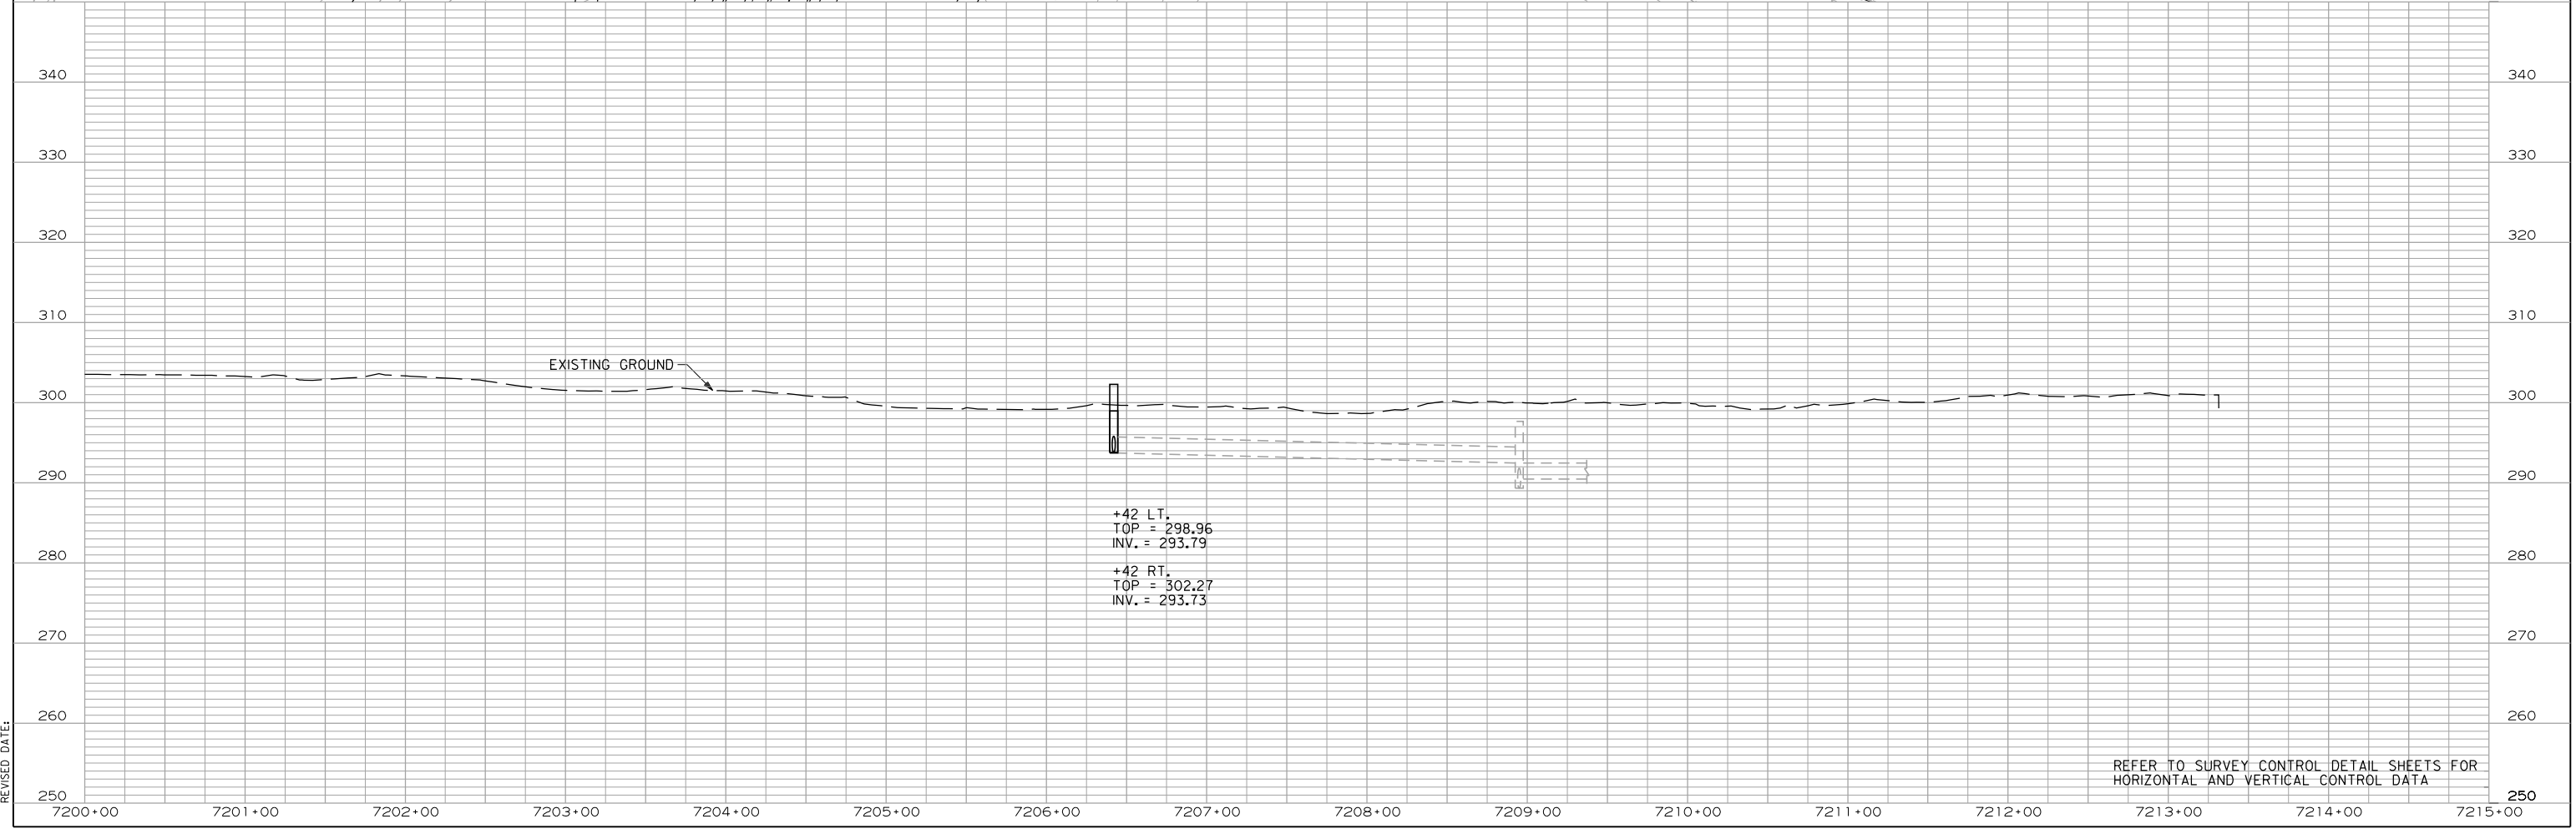


REFER TO SURVEY CONTROL DETAIL SHEETS FOR HORIZONTAL AND VERTICAL CONTROL DATA

2/10/2016 4:34:02 PM  
 WORKSPACE: AHTD  
 L:\2012\201550 - Contr-ell\field Access\Drawings\6TH\_ST\6TH\_PP\_MNL\_01.dgn  
 REVISED DATE:

DATE	DATE FILMED	DATE REVISED	DATE FILMED	FED. RD. DIST. NO.	STATE	FED. AID PROJ. NO.	SHEET NO.	TOTAL SHEETS
				6	ARK.	080517	47	182
				2 PLAN AND PROFILE - 6TH ST.				

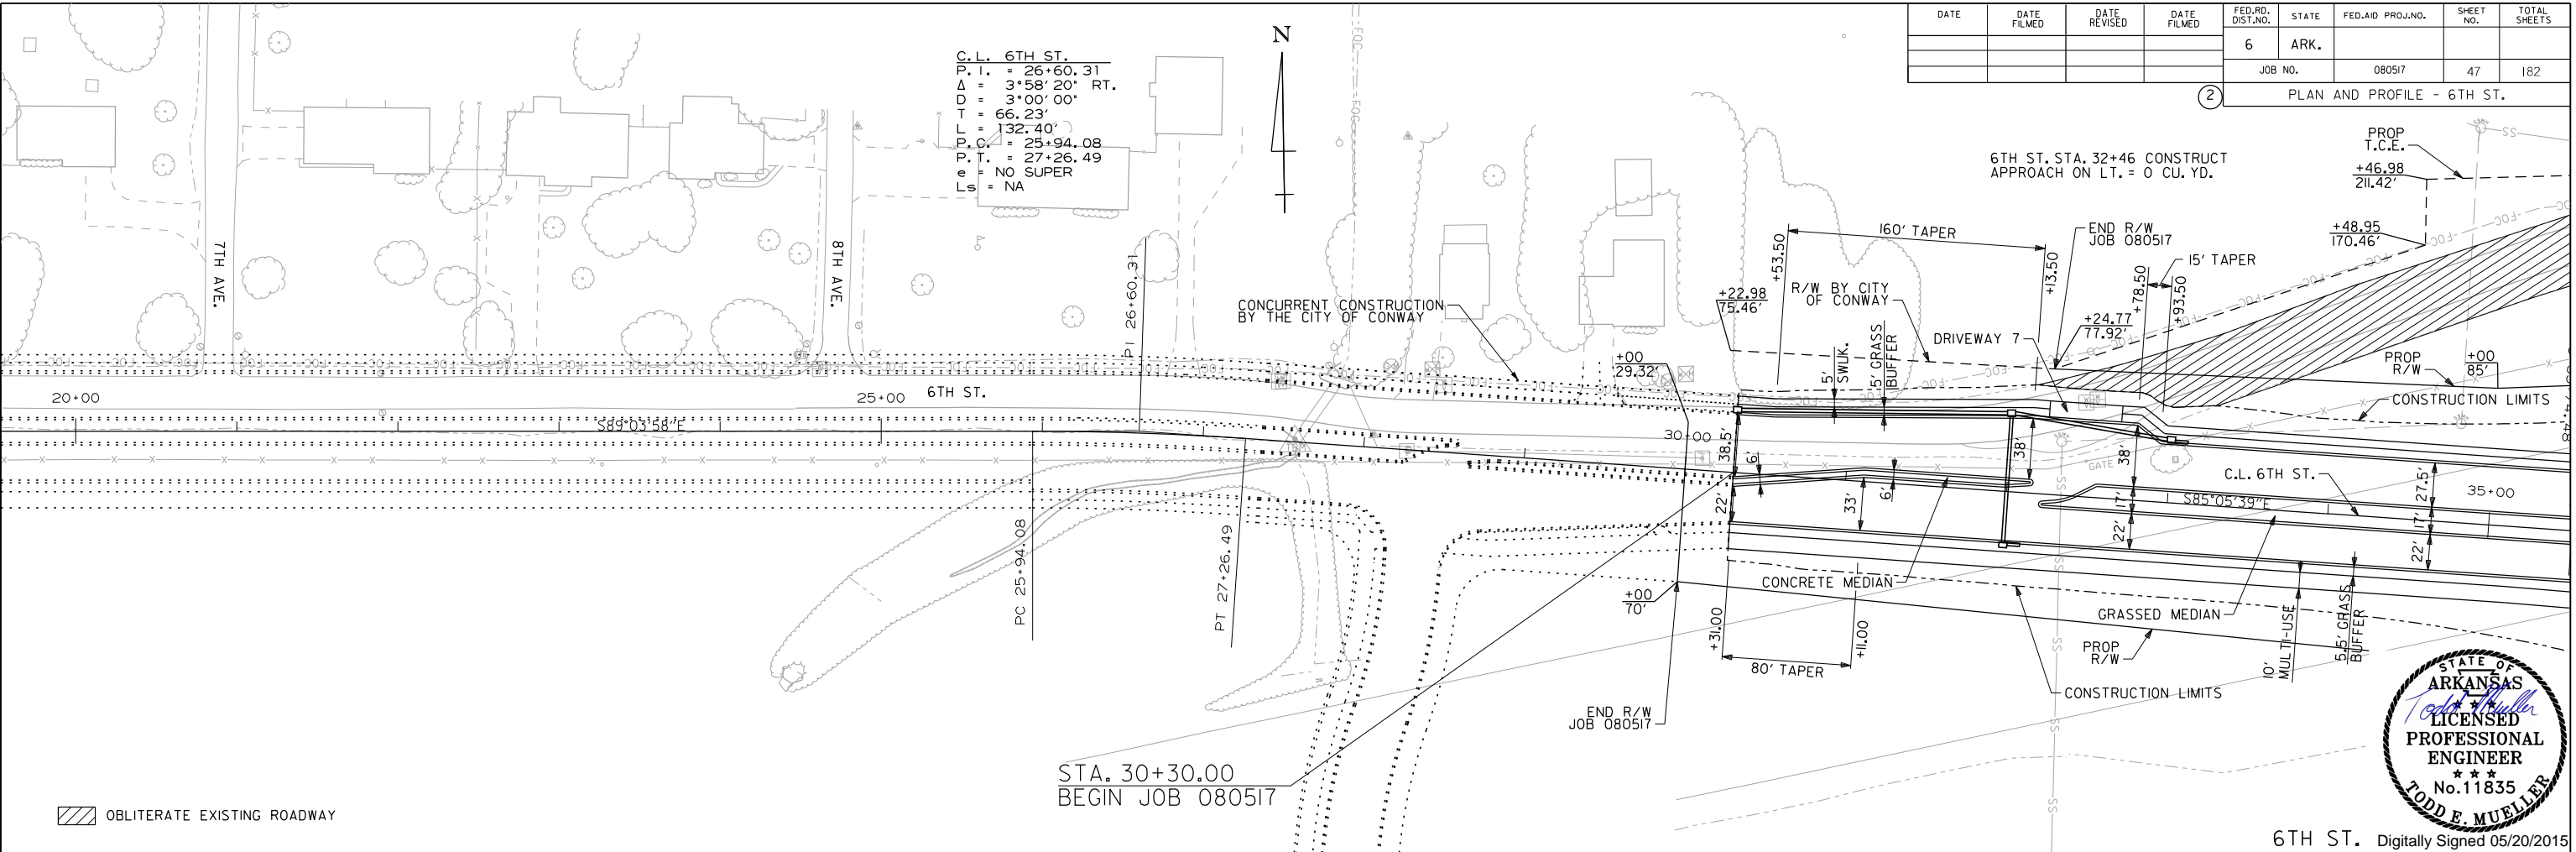

6TH ST. Digitally Signed 05/20/2015

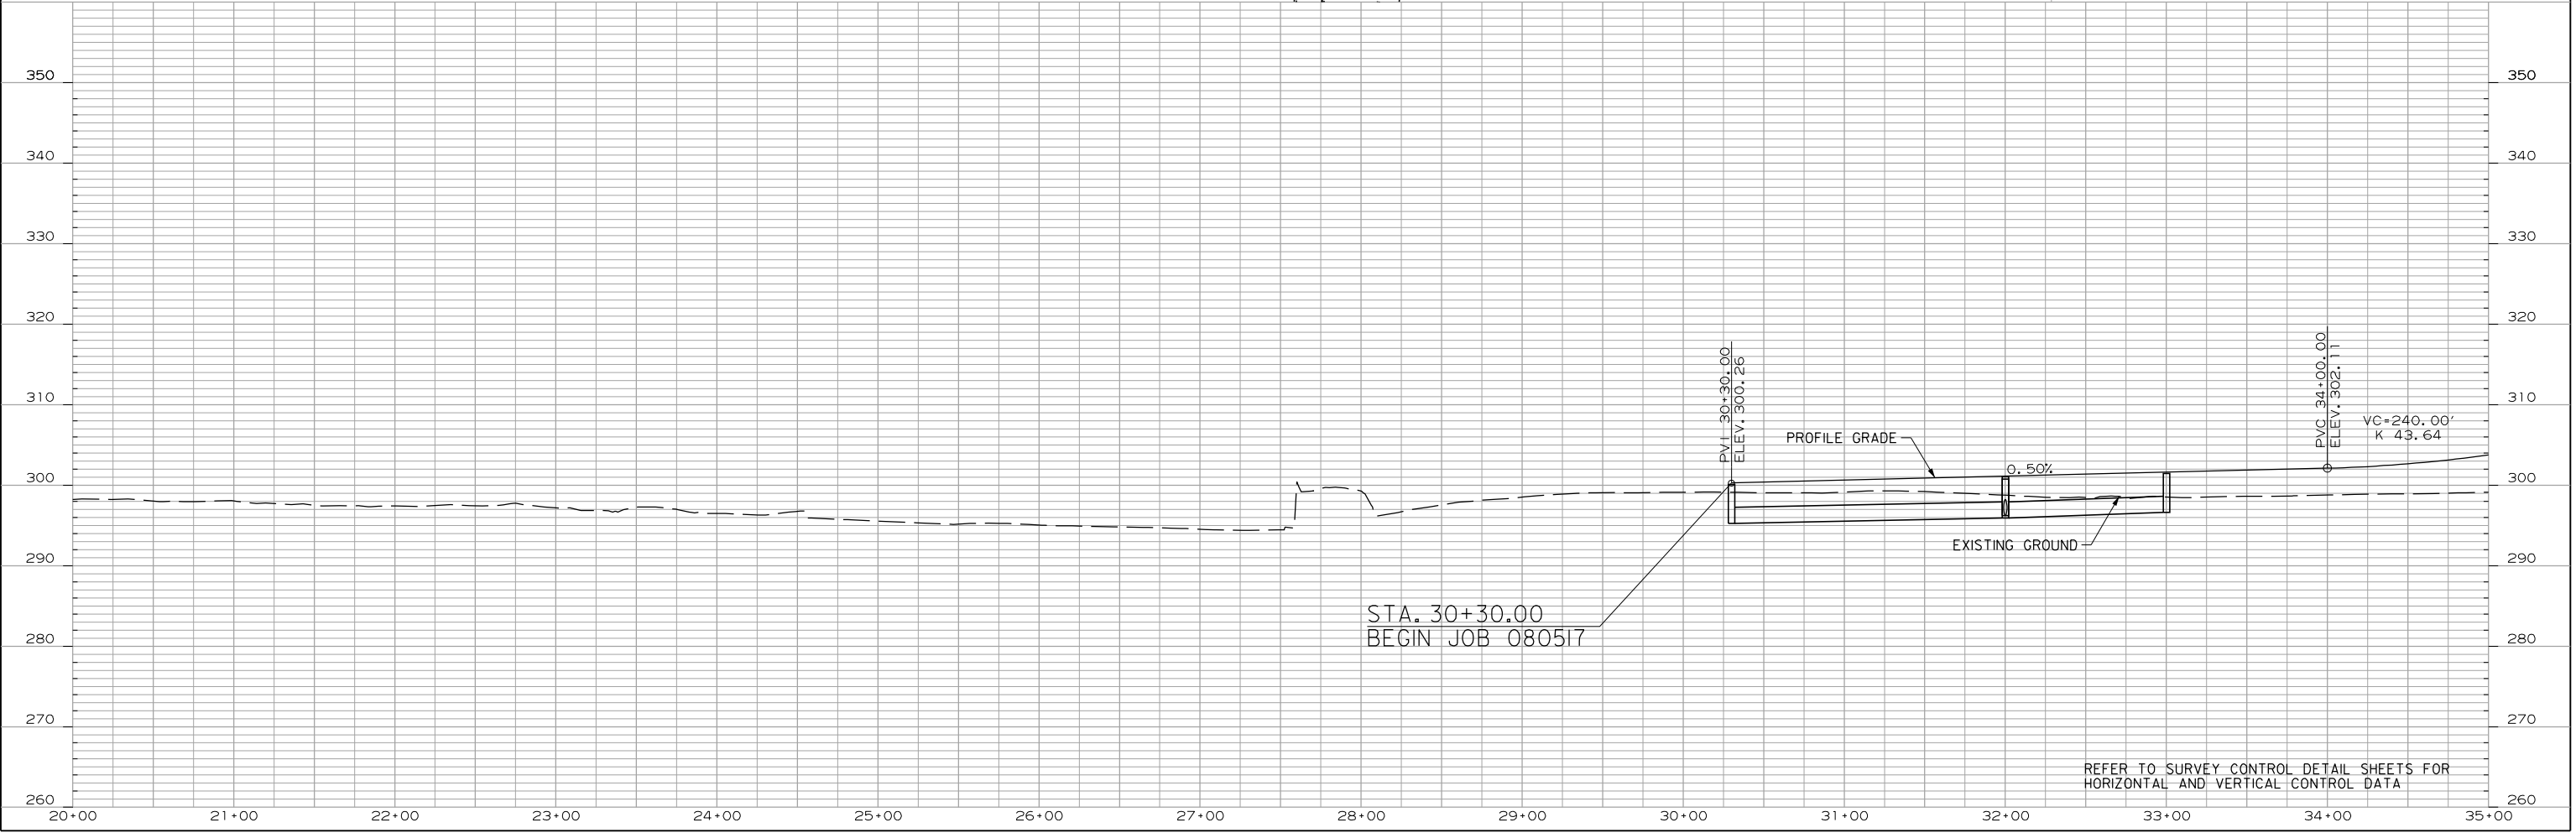


REFER TO SURVEY CONTROL DETAIL SHEETS FOR HORIZONTAL AND VERTICAL CONTROL DATA

5/20/2015 7:53:19 AM  
 WORKSPACE: AHTD  
 L:\2012\201550 - Conrail\field Access\Drawings\6TH ST\6TH\_PP\_6TH\_01.dgn  
 REVISED DATE:

OBLITERATE EXISTING ROADWAY

DATE	DATE FILMED	DATE REVISED	DATE FILMED	FED. RD. DIST. NO.	STATE	FED. AID PROJ. NO.	SHEET NO.	TOTAL SHEETS
				6	ARK.			
				JOB NO.		080517	48	182

② PLAN AND PROFILE - 6TH ST.

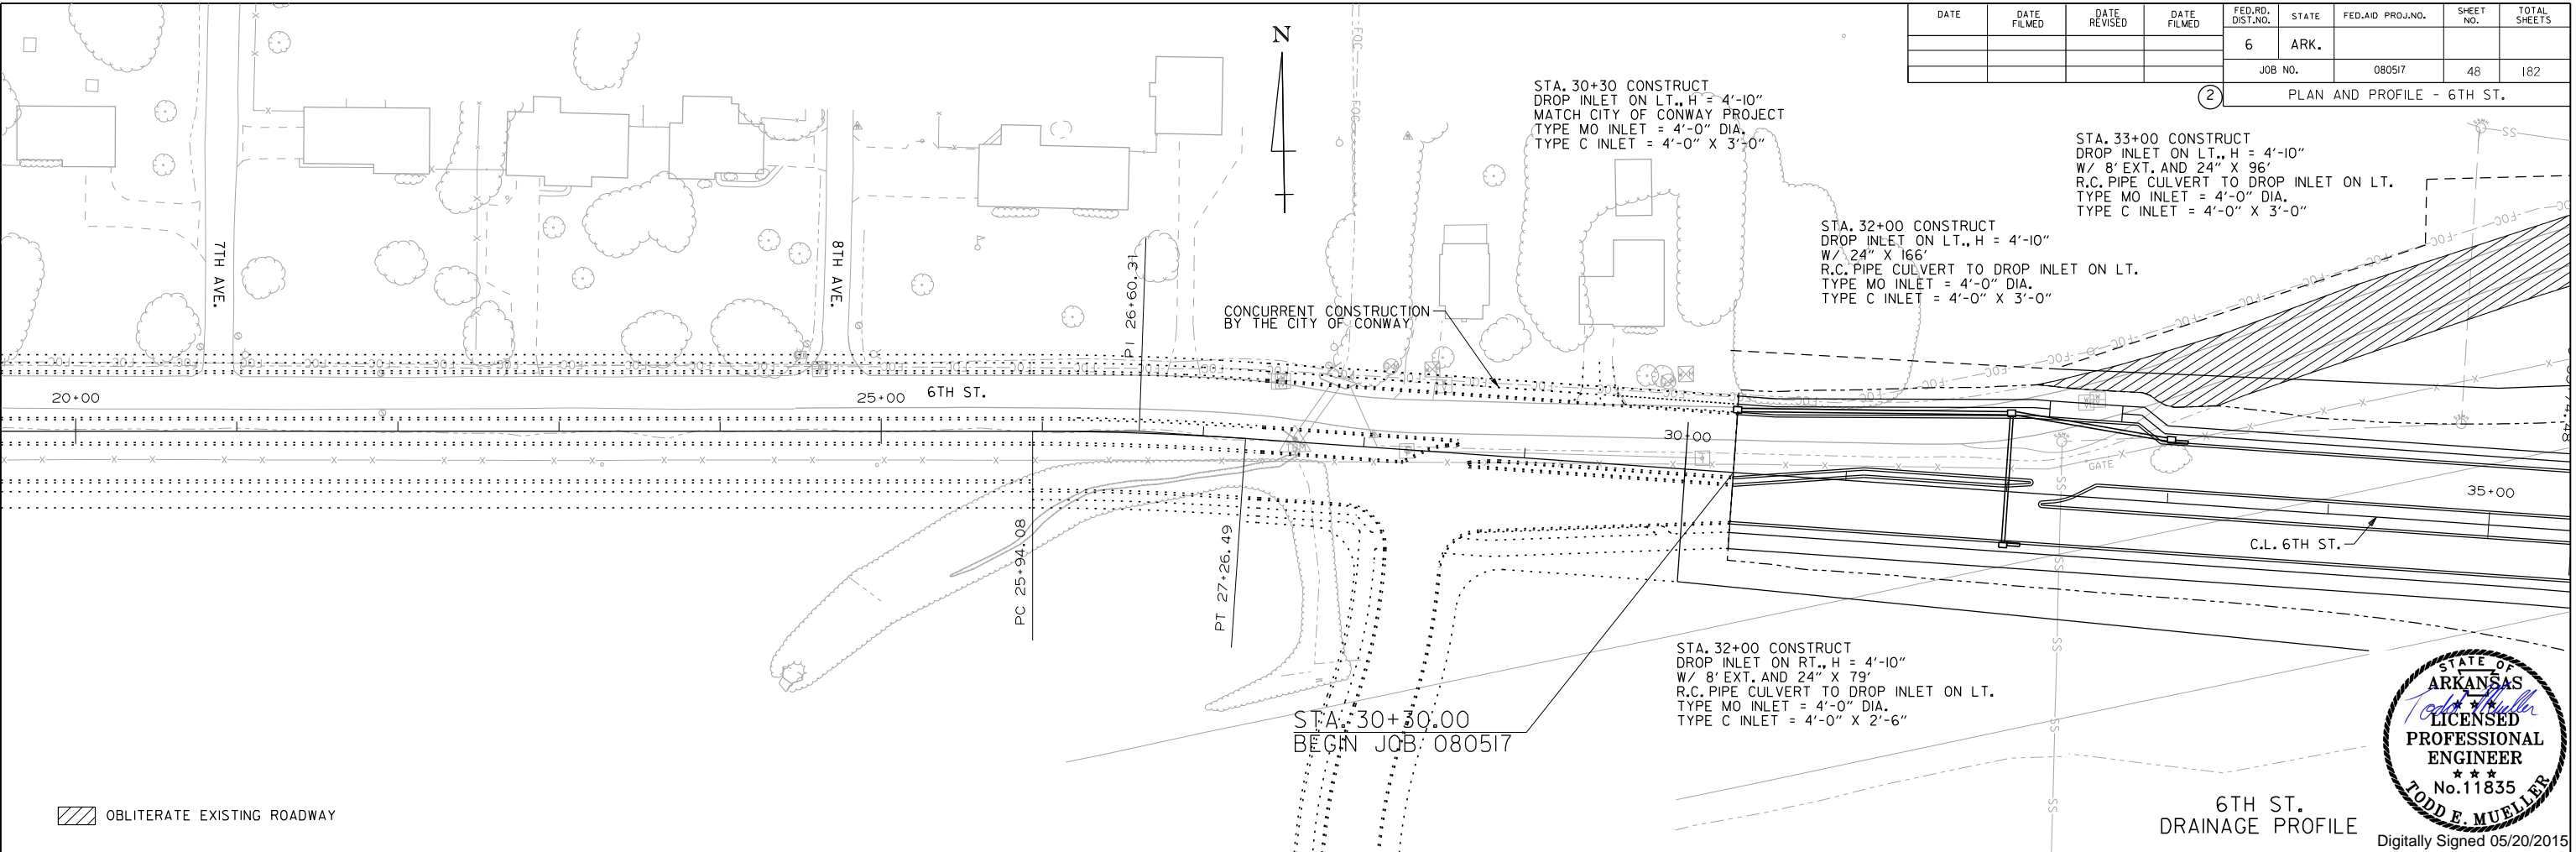

5/20/2015 7:13:20 AM  
 WORKSPACE: AHTD  
 L:\2012\01550 - Contrail\field Access\Drawings\6TH ST\6TH\_PP\_6TH\_DRAIN\_01.dgn  
 REVISED DATE:




C.L. 6TH ST.	C.L. 6TH ST. LEFT LANES	C.L. 6TH ST. RIGHT LANES
P.I. = 36+89.01	P.I. = 37+06.07	P.I. = 36+71.94
Δ = 24°48'07" LT.	Δ = 24°48'07" LT.	Δ = 24°48'07" LT.
D = 11°00'00"	D = 11°30'00"	D = 10°30'00"
T = 114.54'	T = 109.55'	T = 119.98'
L = 225.47'	L = 215.67'	L = 236.21'
P.C. = 35+74.48	P.C. = 35+96.52	P.C. = 35+51.96
P.T. = 37+99.96	P.T. = 38+12.19	P.T. = 37+88.17
e = NO SUPER	e = NO SUPER	e = NO SUPER
Ls = NA	Ls = NA	Ls = NA


C.L. ELSINGER BLVD.	C.L. ELSINGER BLVD.
P.I. = 45+19.64	P.I. = 48+36.66
Δ = 17°55'42" LT.	Δ = 50°14'50" LT.
D = 17°00'00"	D = 12°43'57"
T = 53.16'	T = 211.02'
L = 105.46'	L = 394.64'
P.C. = 44+66.48	P.C. = 46+25.64
P.T. = 45+71.94	P.T. = 50+20.28
e = NO SUPER	e = NO SUPER
Ls = NA	Ls = NA

DATE REVISED	DATE FILMED	DATE REVISED	DATE FILMED	FED. RD. DIST. NO.	STATE	FED. AID PROJ. NO.	SHEET NO.	TOTAL SHEETS
2-10-2016				6	ARK.	080517	49	182

PLAN AND PROFILE - 6TH ST./ELSINGER BLVD.

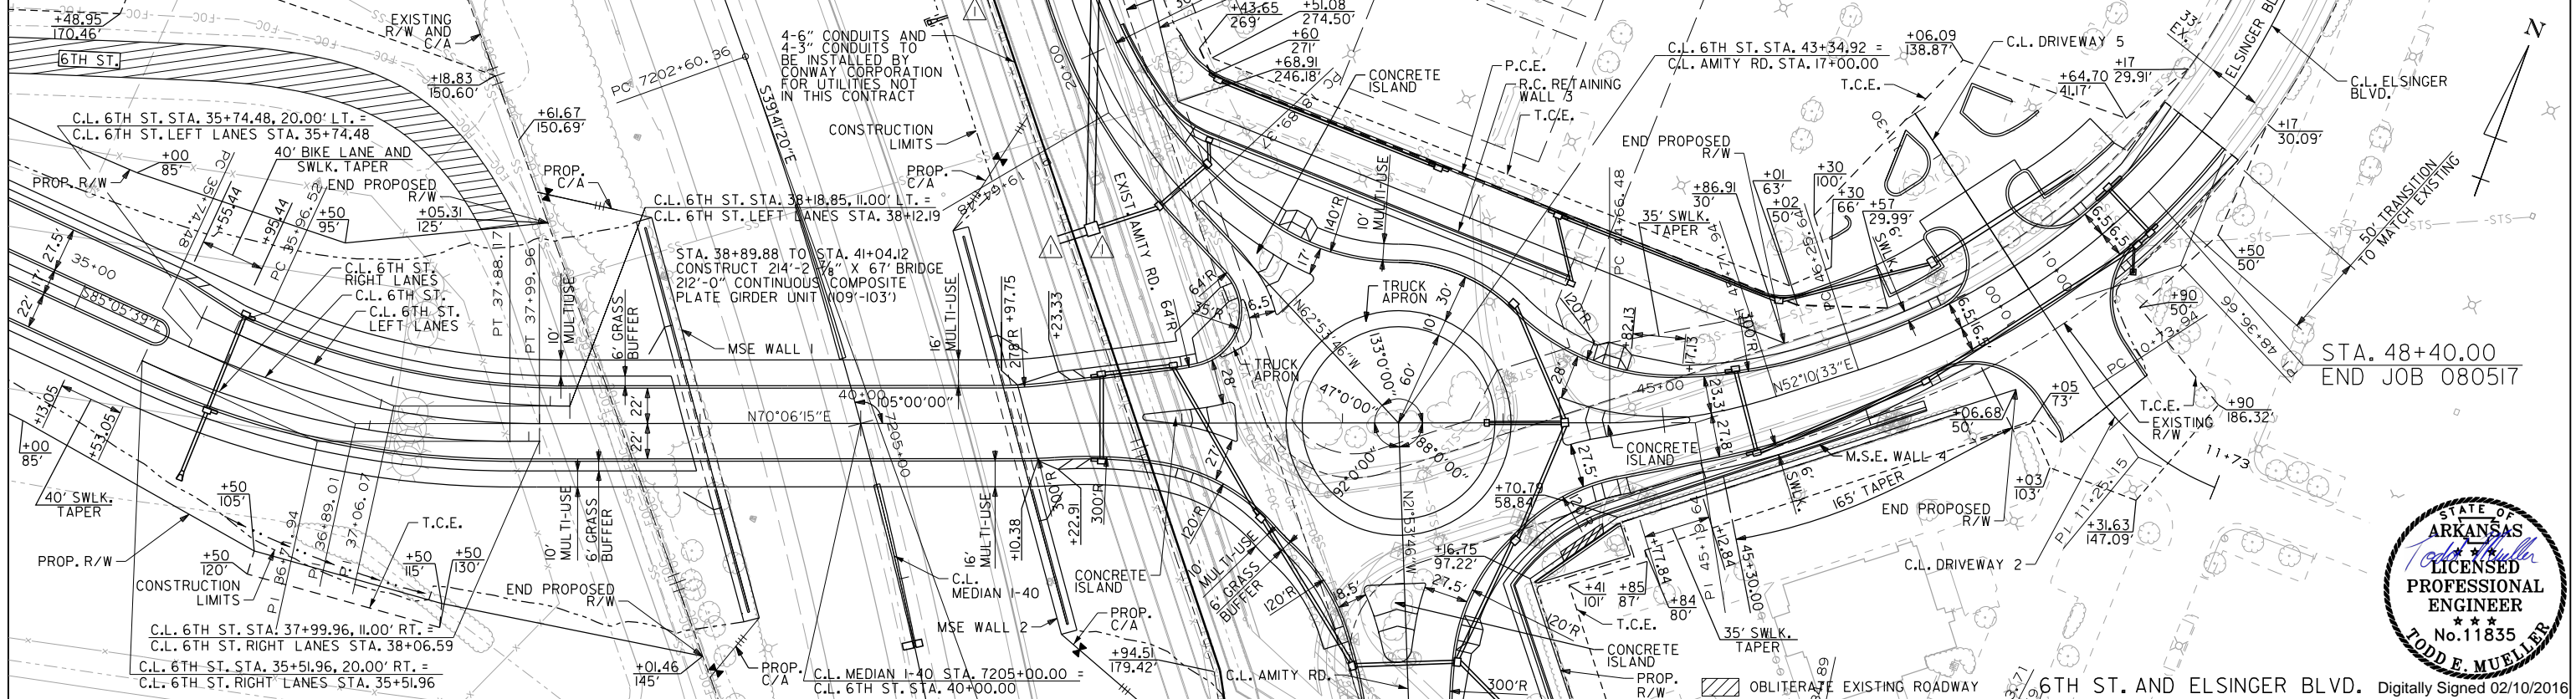


Digitally Signed 02/10/2016

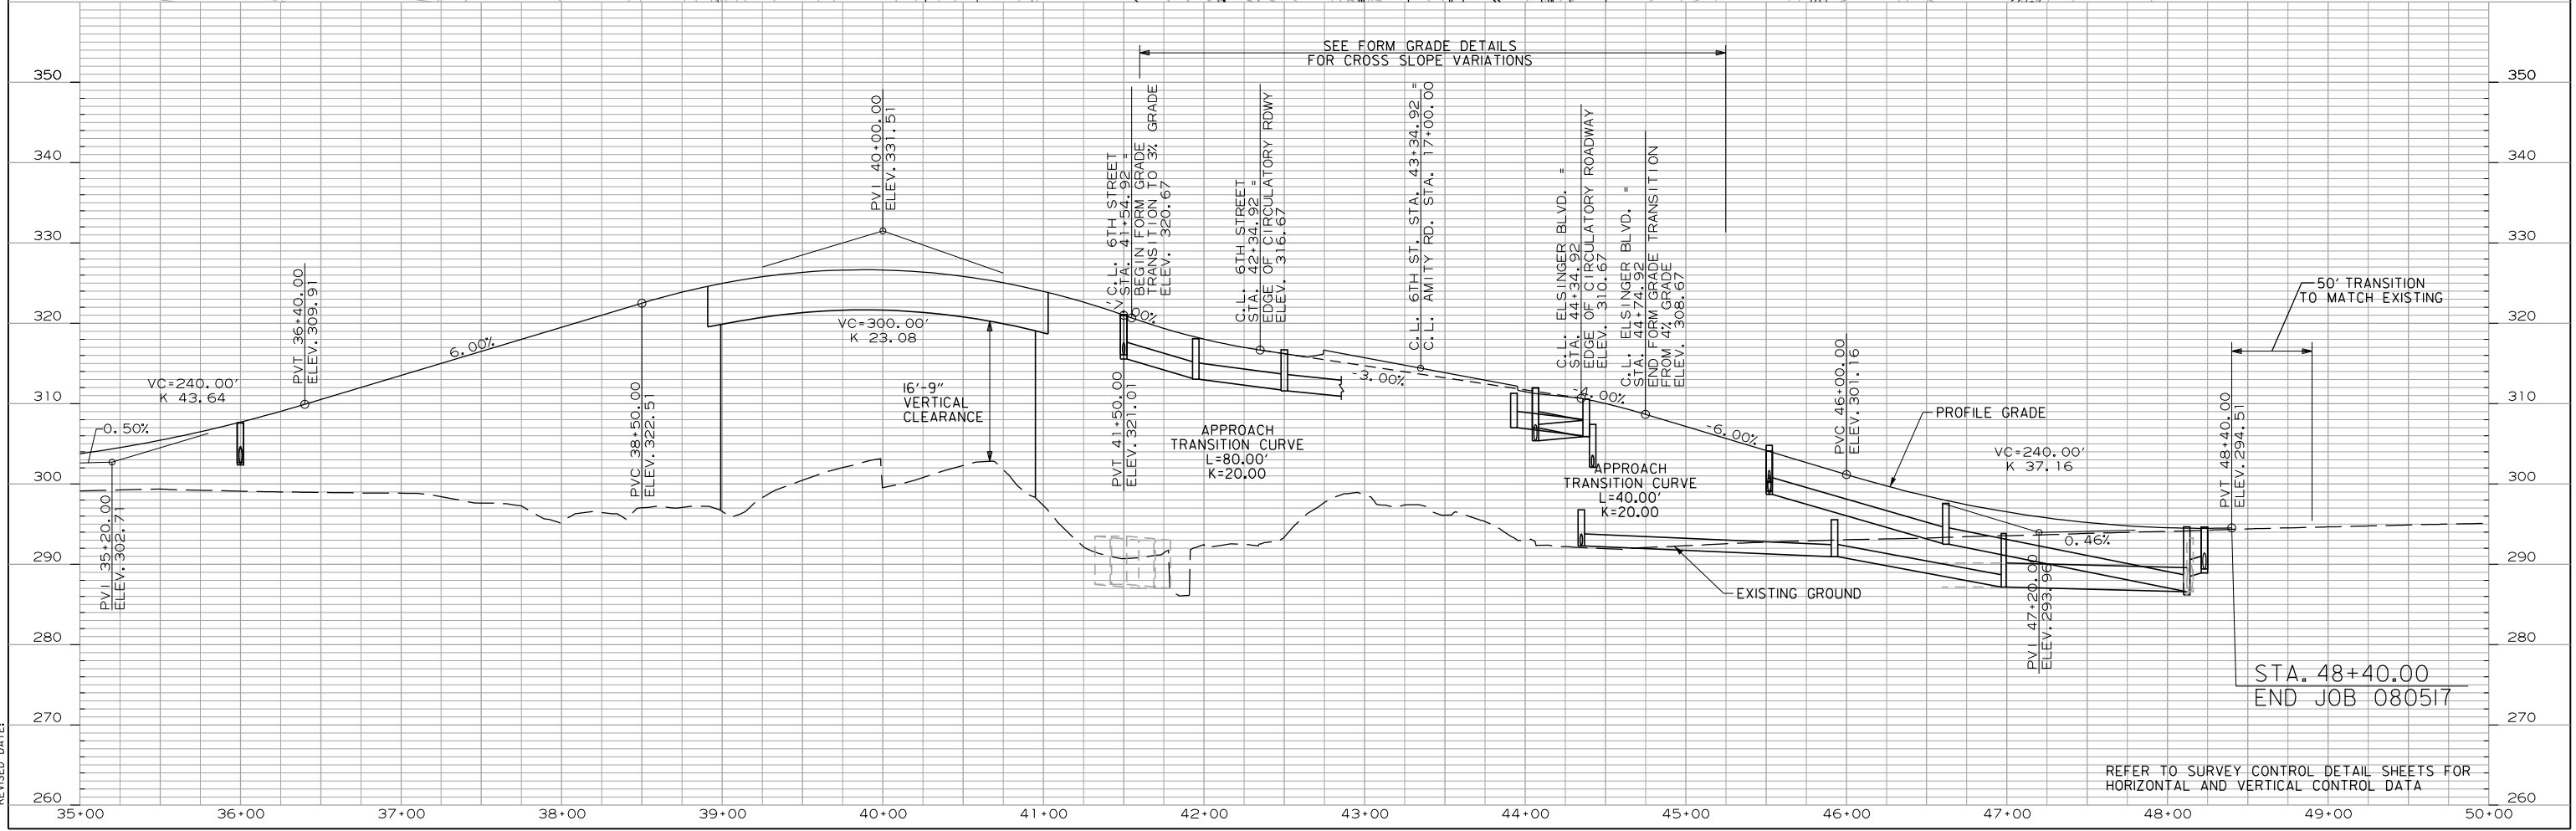

REFER TO SURVEY CONTROL DETAIL SHEETS FOR HORIZONTAL AND VERTICAL CONTROL DATA


2/10/2016 4:34:02 PM  
 WORKSPACE: AHTD  
 L:\2012\201590 - Contr-ell\field Access\Drawings\6TH ST\6TH\_PP\_6TH\_02.dgn  
 REVISION DATE:

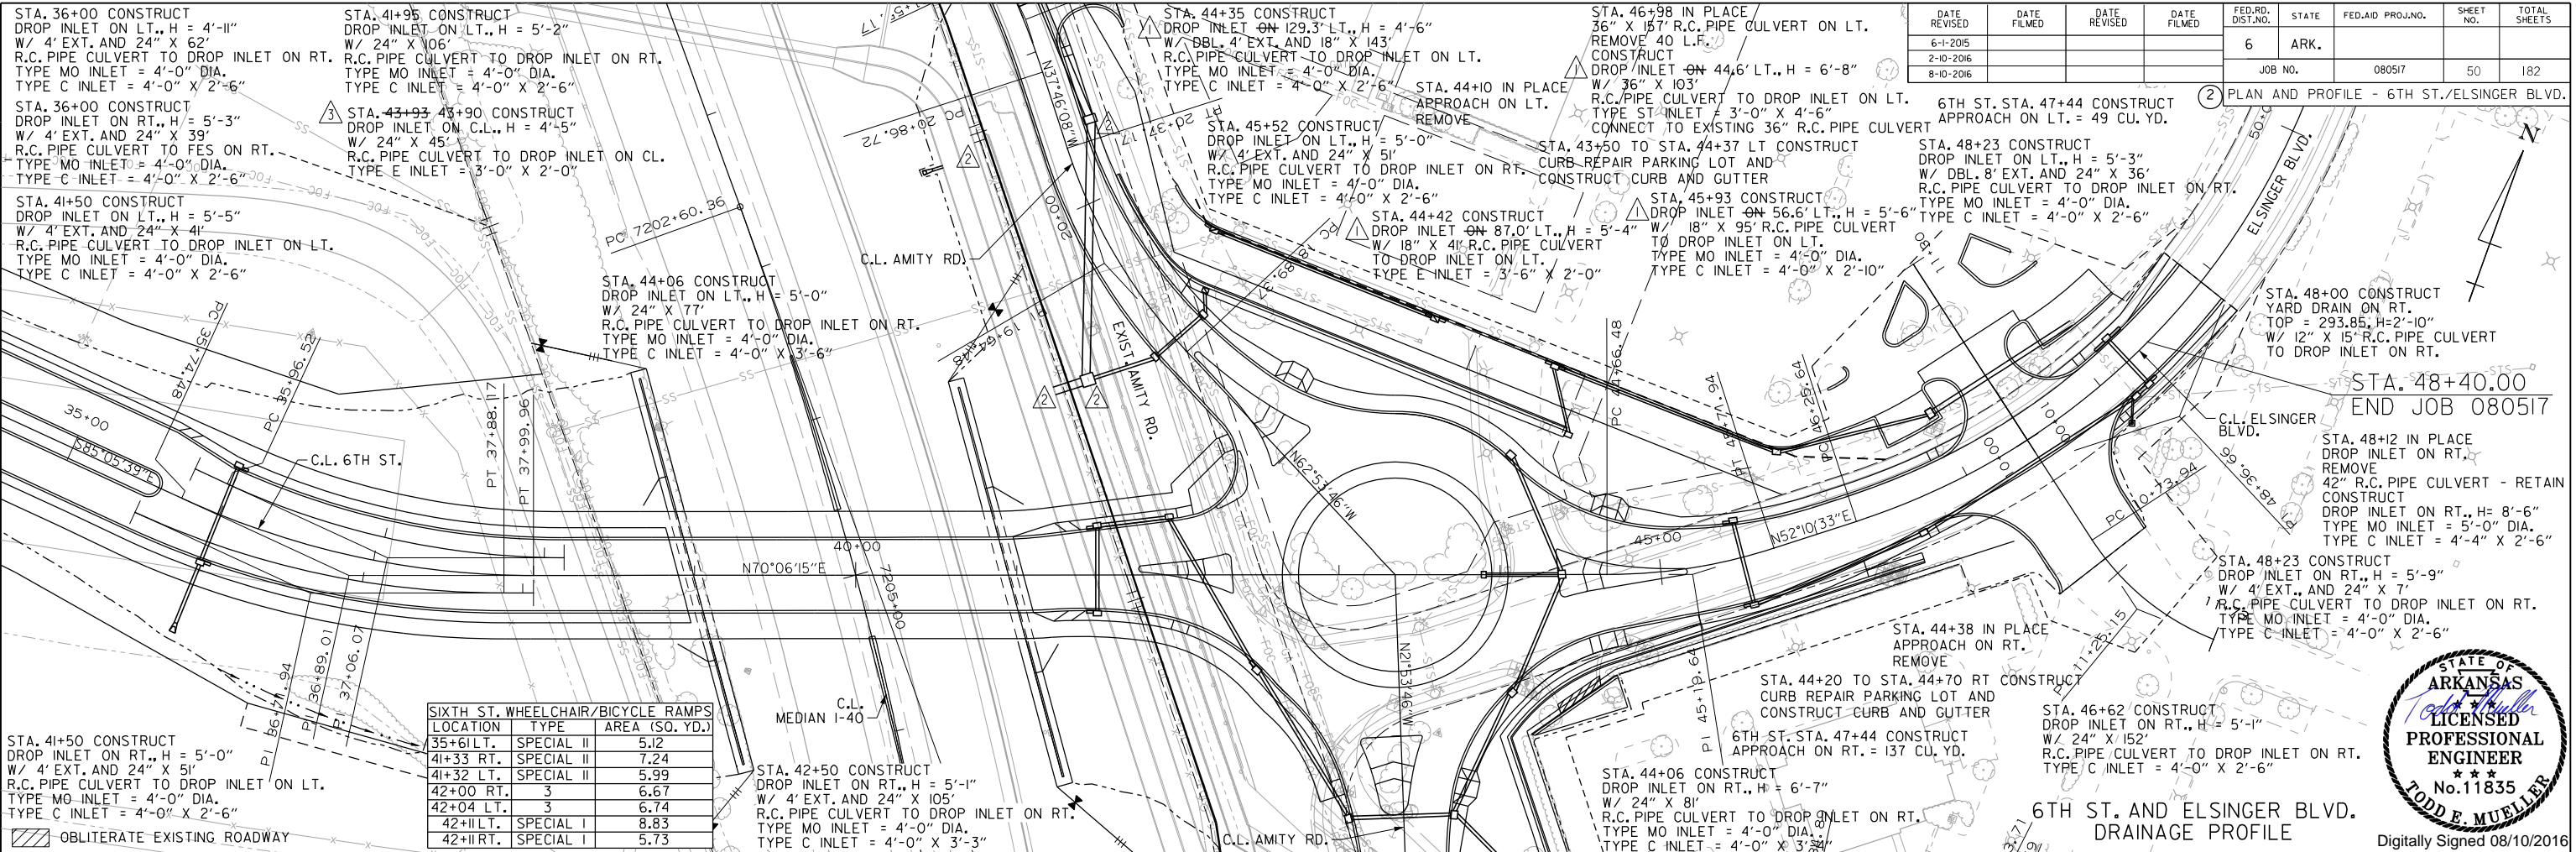


DATE REVISED	DATE FILMED	DATE REVISED	DATE FILMED	FED. RD. DIST. NO.	STATE	FED. AID PROJ. NO.	SHEET NO.	TOTAL SHEETS
6-1-2015				6	ARK.			
2-10-2016						080517	50	182
8-10-2016								

PLAN AND PROFILE - 6TH ST./ELSINGER BLVD.

SIXTH ST. WHEELCHAIR/BICYCLE RAMPS	LOCATION	TYPE	AREA (SQ. YD.)
	35+61 LT.	SPECIAL II	5.12
	41+33 RT.	SPECIAL II	7.24
	41+32 LT.	SPECIAL II	5.99
	42+00 RT.	3	6.67
	42+04 LT.	3	6.74
	42+11 LT.	SPECIAL I	8.83
	42+11 RT.	SPECIAL I	5.73

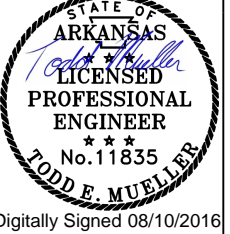

6TH ST. AND ELSINGER BLVD. DRAINAGE PROFILE  
 Digitally Signed 08/10/2016

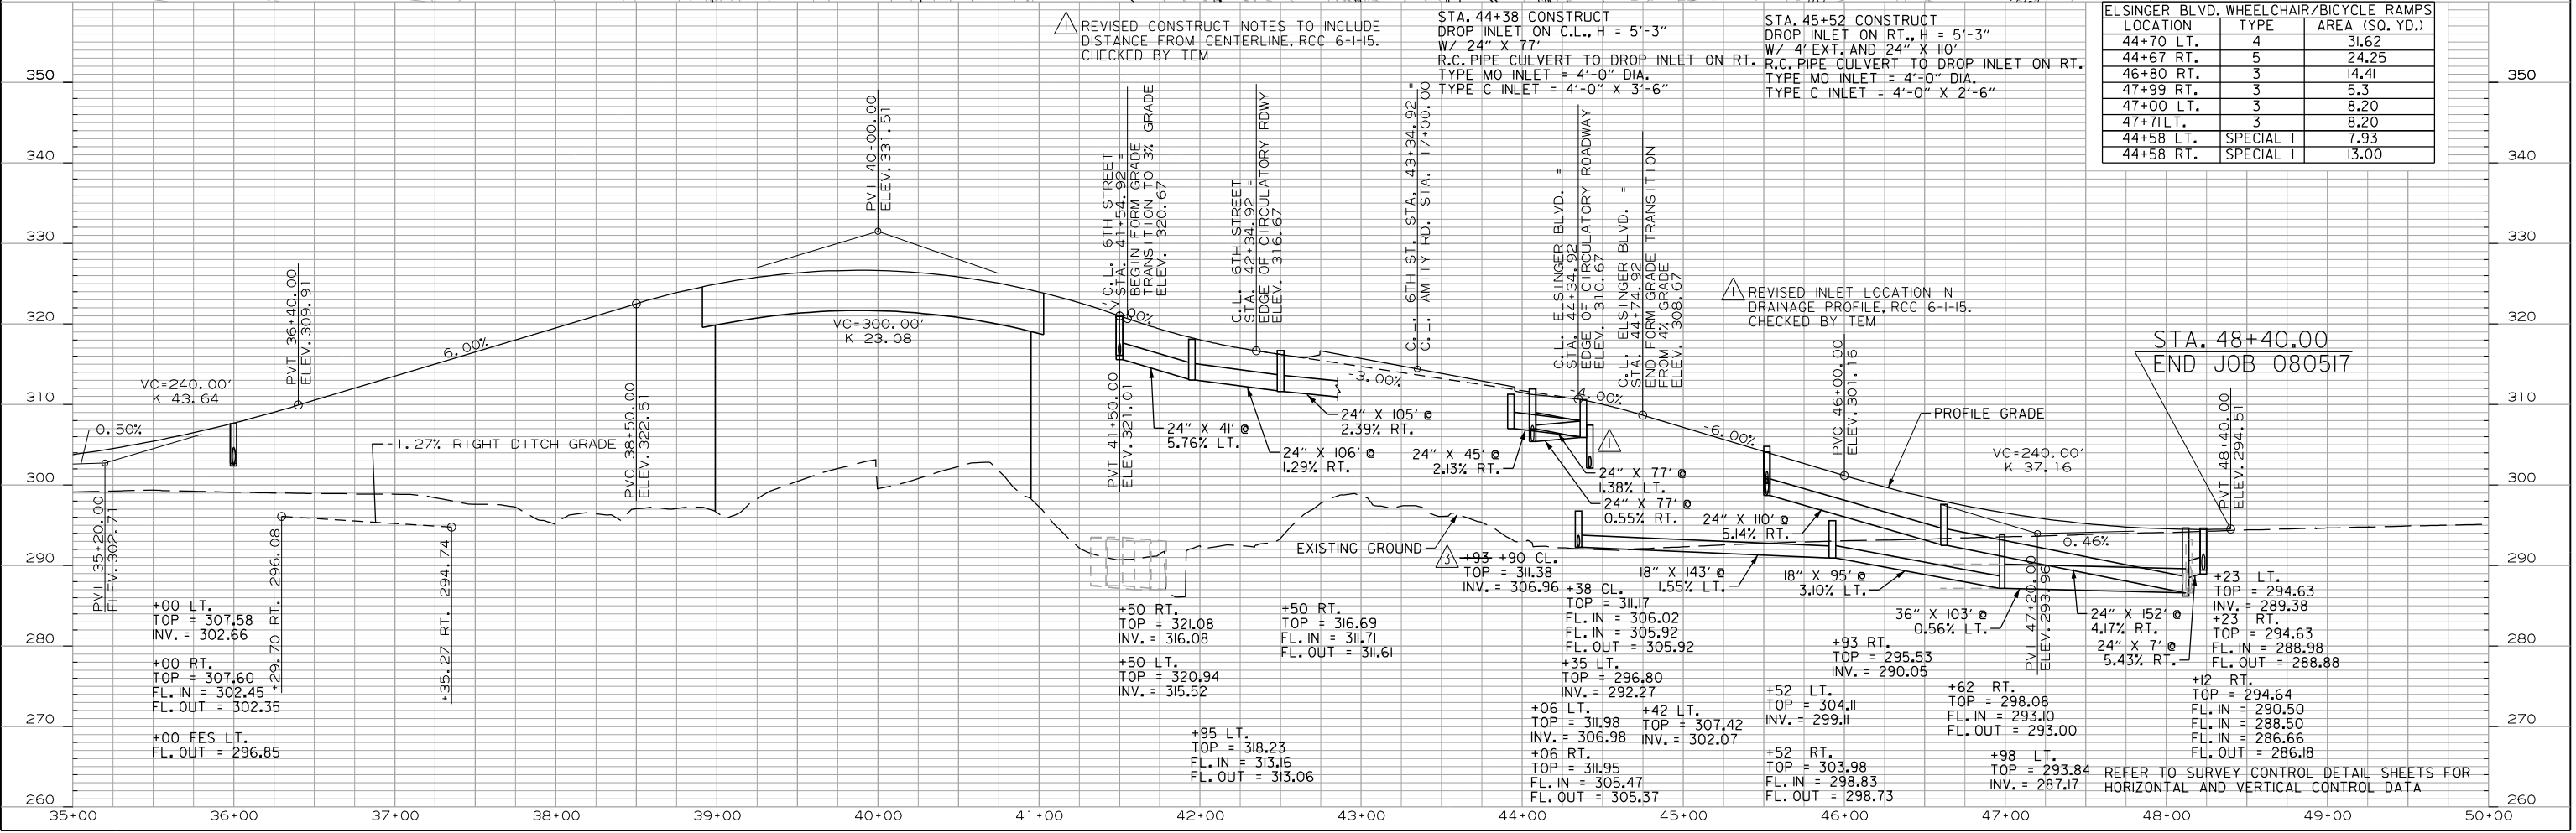


ELSINGER BLVD. WHEELCHAIR/BICYCLE RAMPS		
LOCATION	TYPE	AREA (SQ. YD.)
44+70 LT.	4	31.62
44+67 RT.	5	24.25
46+80 RT.	3	14.41
47+99 RT.	3	5.3
47+00 LT.	3	8.20
47+71 LT.	3	8.20
44+58 LT.	SPECIAL I	7.93
44+58 RT.	SPECIAL I	13.00

REVISIONS:  
 \$DATE\$ \$TIME\$  
 \$WORKSPACE\$ \$WORKSPACE\$  
 \$FILE\$ \$FILE\$  
 REVISED DATE:

REFER TO SURVEY CONTROL DETAIL SHEETS FOR HORIZONTAL AND VERTICAL CONTROL DATA

DATE REVISED	DATE FILMED	DATE REVISED	DATE FILMED	FED. RD. DIST. NO.	STATE	FED. AID PROJ. NO.	SHEET NO.	TOTAL SHEETS
2-10-2016				6	ARK.	080517	51	182

PLAN AND PROFILE - AMITY RD.

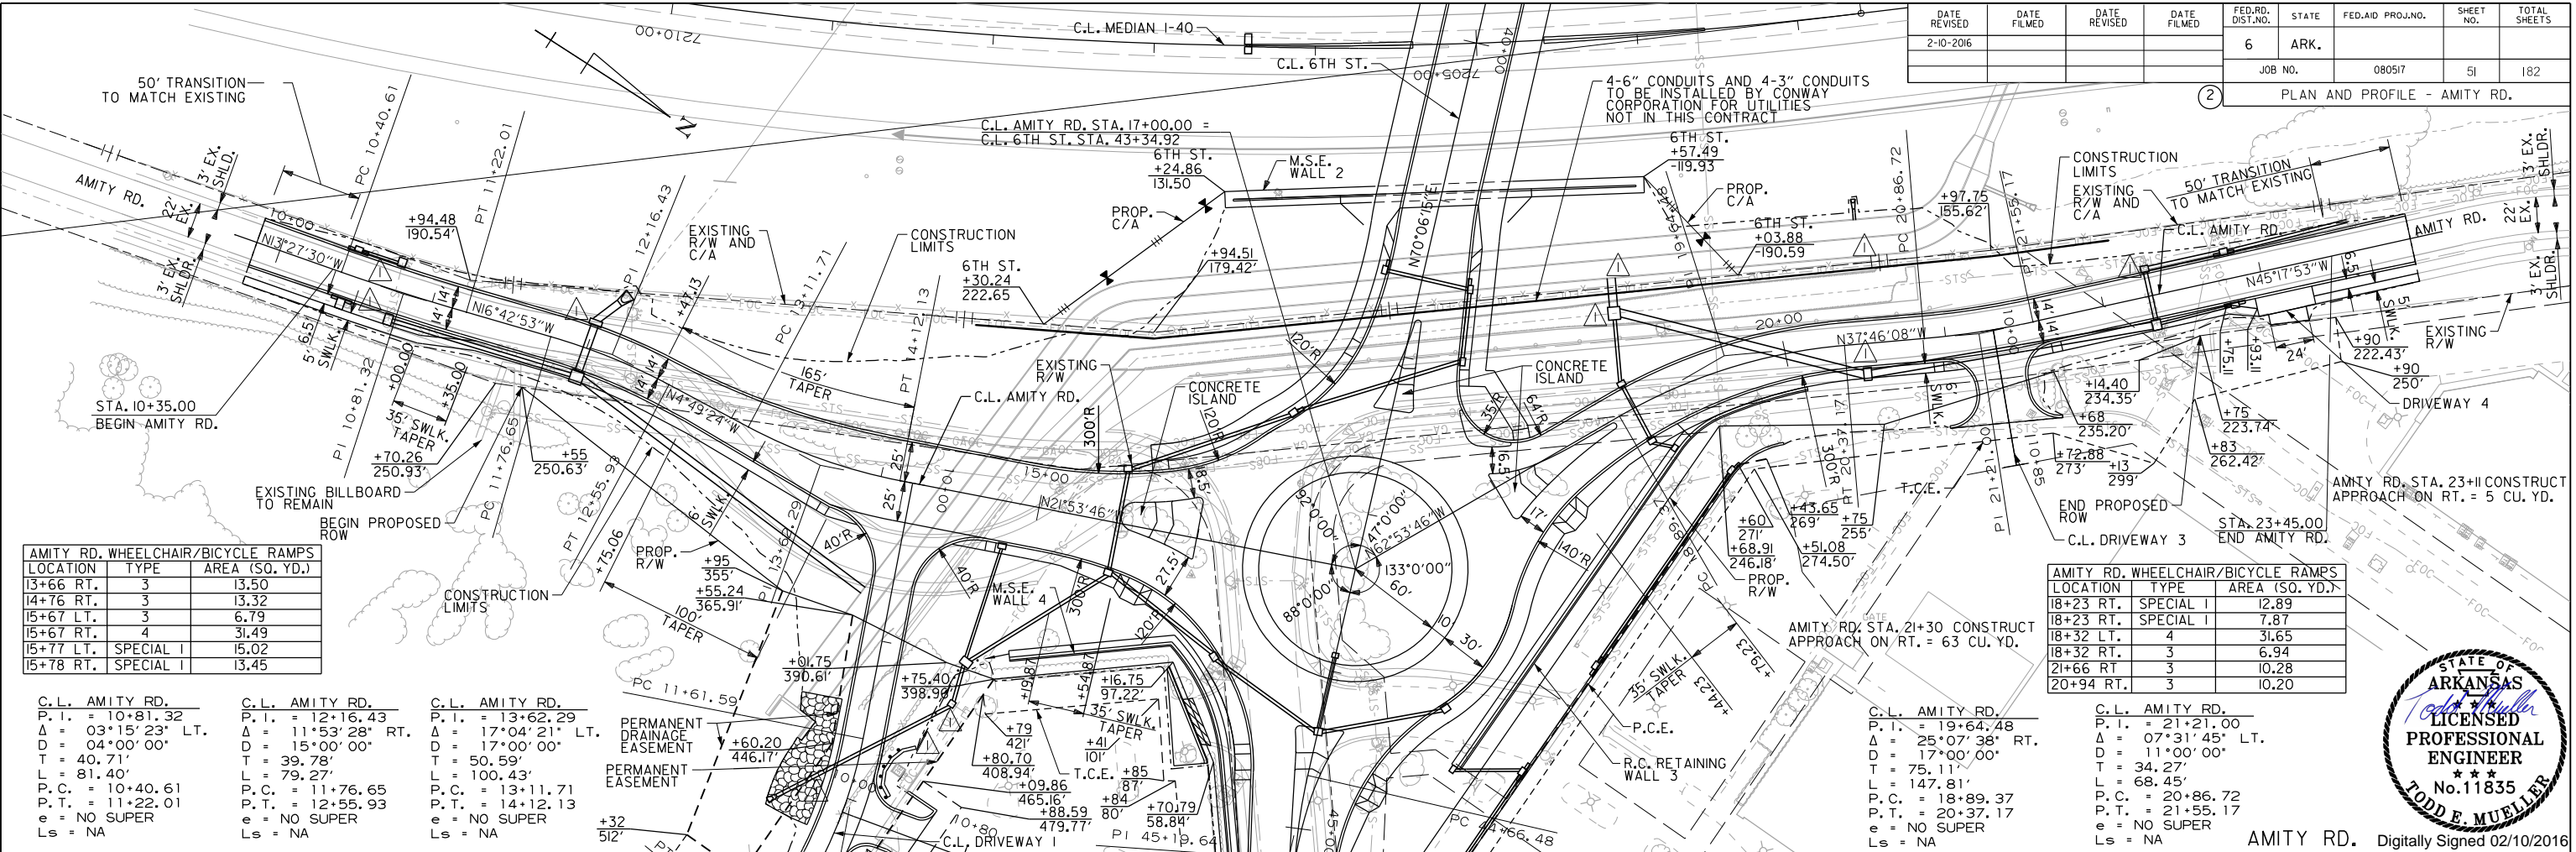

AMITY RD. WHEELCHAIR/BICYCLE RAMPS	LOCATION	TYPE	AREA (SQ. YD.)
	13+66 RT.	3	13.50
	14+76 RT.	3	13.32
	15+67 LT.	3	6.79
	15+67 RT.	4	31.49
	15+77 LT.	SPECIAL I	15.02
	15+78 RT.	SPECIAL I	13.45

AMITY RD. WHEELCHAIR/BICYCLE RAMPS	LOCATION	TYPE	AREA (SQ. YD.)
	18+23 RT.	SPECIAL I	12.89
	18+23 LT.	SPECIAL I	7.87
	18+32 LT.	4	31.65
	18+32 RT.	3	6.94
	21+66 RT.	3	10.28
	20+94 RT.	3	10.20



**C.L. AMITY RD.**  
 P.I. = 10+81.32  
 $\Delta$  = 03°15'23" LT.  
 D = 04°00'00"  
 T = 40.71'  
 L = 81.40'  
 P.C. = 10+40.61  
 P.T. = 11+22.01  
 e = NO SUPER  
 Ls = NA


**C.L. AMITY RD.**  
 P.I. = 12+16.43  
 $\Delta$  = 11°53'28" RT.  
 D = 15°00'00"  
 T = 39.78'  
 L = 79.27'  
 P.C. = 11+76.65  
 P.T. = 12+55.93  
 e = NO SUPER  
 Ls = NA

**C.L. AMITY RD.**  
 P.I. = 13+62.29  
 $\Delta$  = 17°04'21" LT.  
 D = 17°00'00"  
 T = 50.59'  
 L = 100.43'  
 P.C. = 13+11.71  
 P.T. = 14+12.13  
 e = NO SUPER  
 Ls = NA

**C.L. AMITY RD.**  
 P.I. = 19+64.48  
 $\Delta$  = 25°07'38" RT.  
 D = 17°00'00"  
 T = 75.11'  
 L = 147.81'  
 P.C. = 18+89.37  
 P.T. = 20+37.17  
 e = NO SUPER  
 Ls = NA

**C.L. AMITY RD.**  
 P.I. = 21+21.00  
 $\Delta$  = 07°31'45" LT.  
 D = 11°00'00"  
 T = 34.27'  
 L = 68.45'  
 P.C. = 20+86.72  
 P.T. = 21+55.17  
 e = NO SUPER  
 Ls = NA


AMITY RD. Digitally Signed 02/10/2016

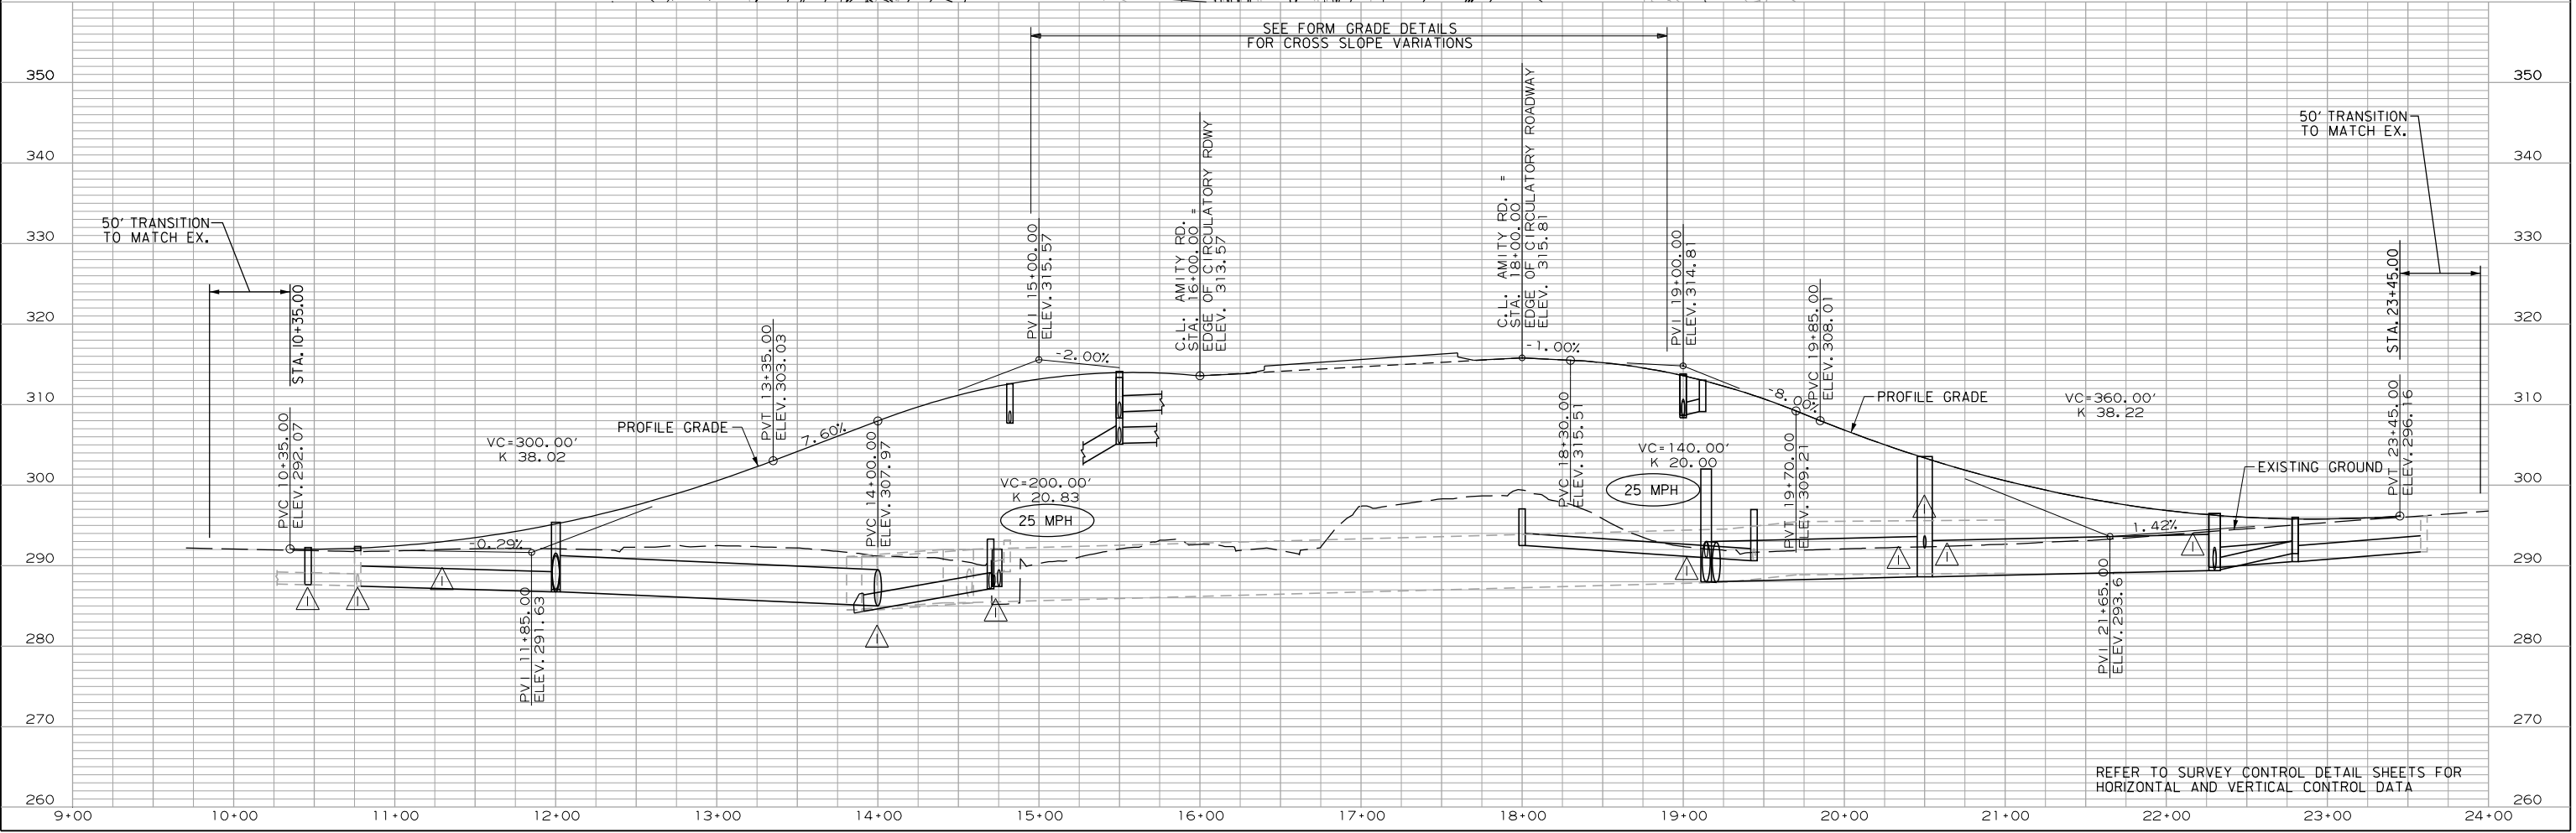


REFER TO SURVEY CONTROL DETAIL SHEETS FOR HORIZONTAL AND VERTICAL DATA

DATE REVISED	DATE FILMED	DATE REVISED	DATE FILMED	FED. RD. DIST. NO.	STATE	FED. AID PROJ. NO.	SHEET NO.	TOTAL SHEETS
6-1-2015		8-10-2016		6	ARK.			
2-10-2016							52	182
3-10-2016								

PLAN AND PROFILE - AMITY RD.

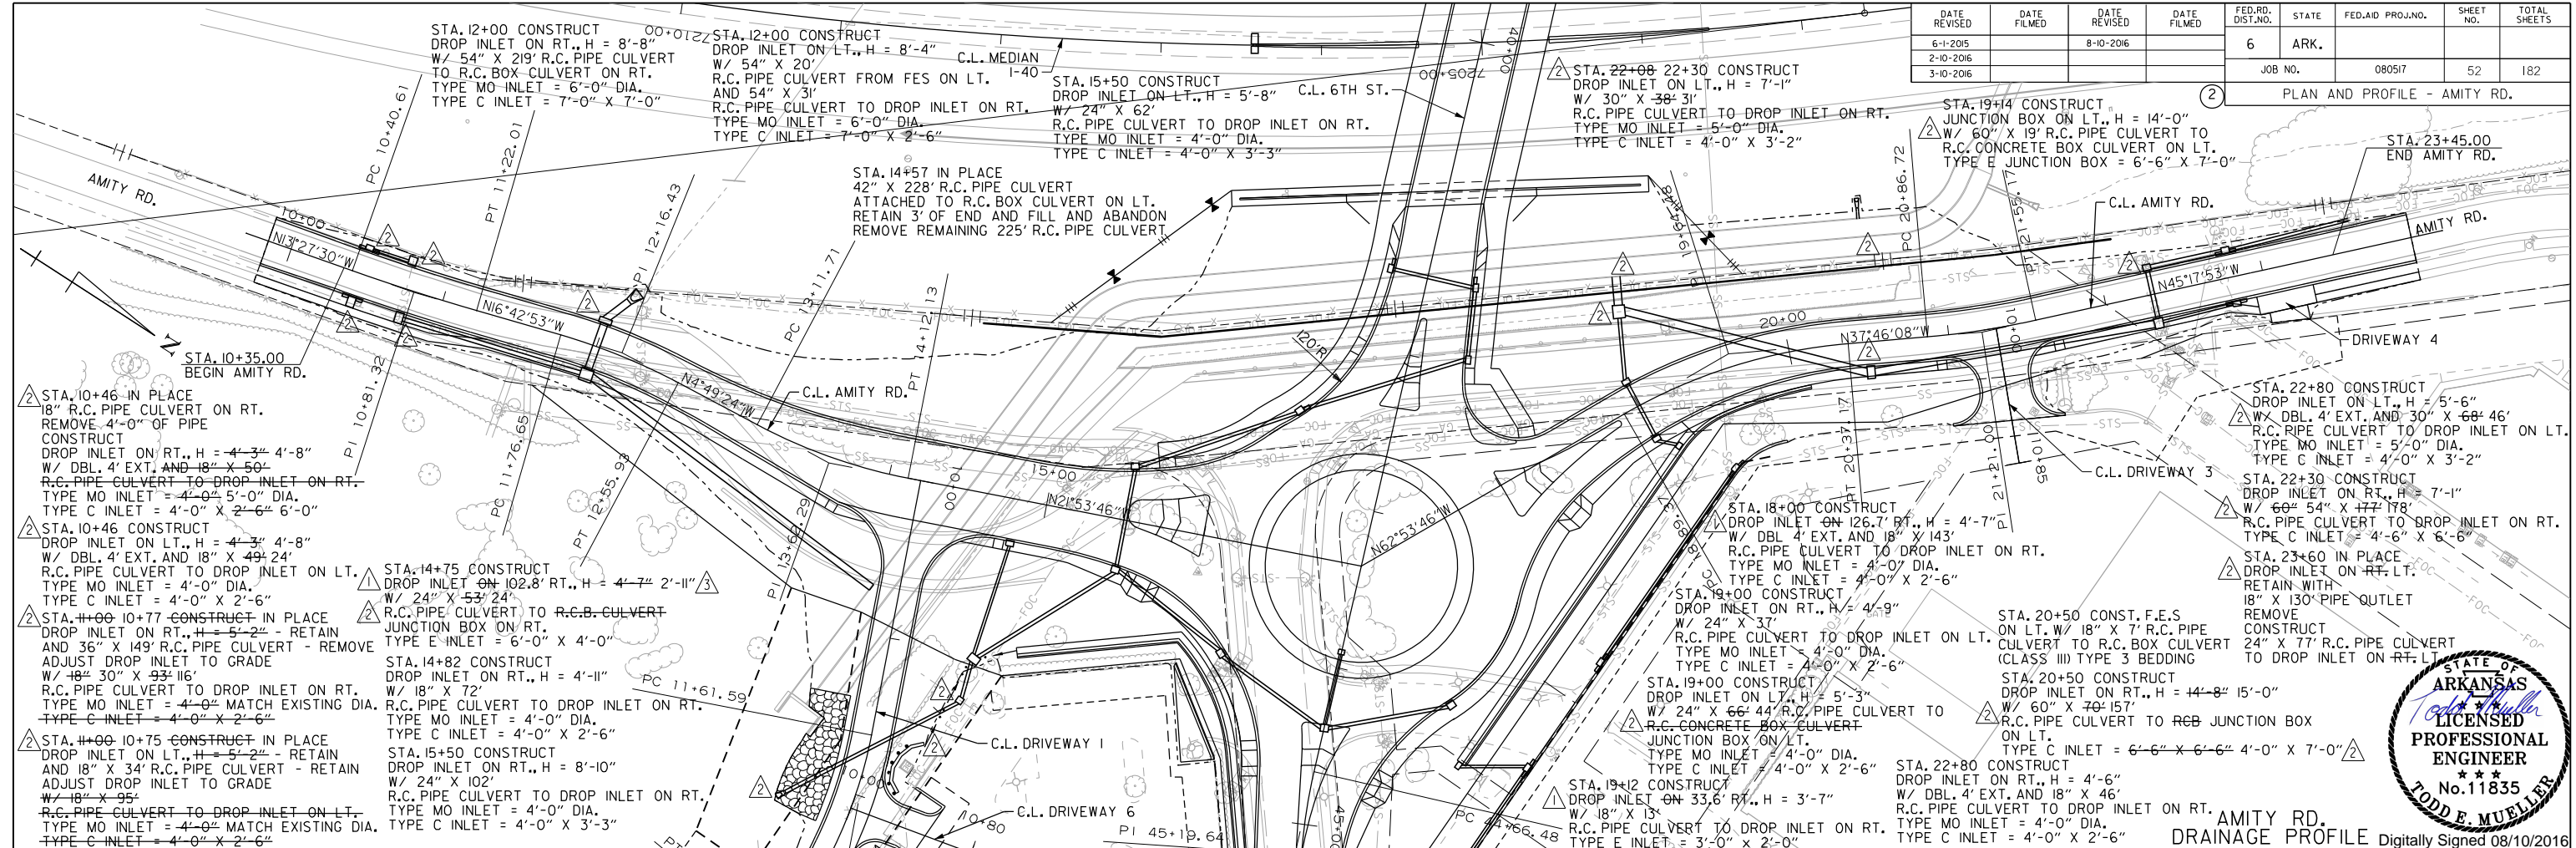




AMITY RD. DRAINAGE PROFILE Digitally Signed 08/10/2016

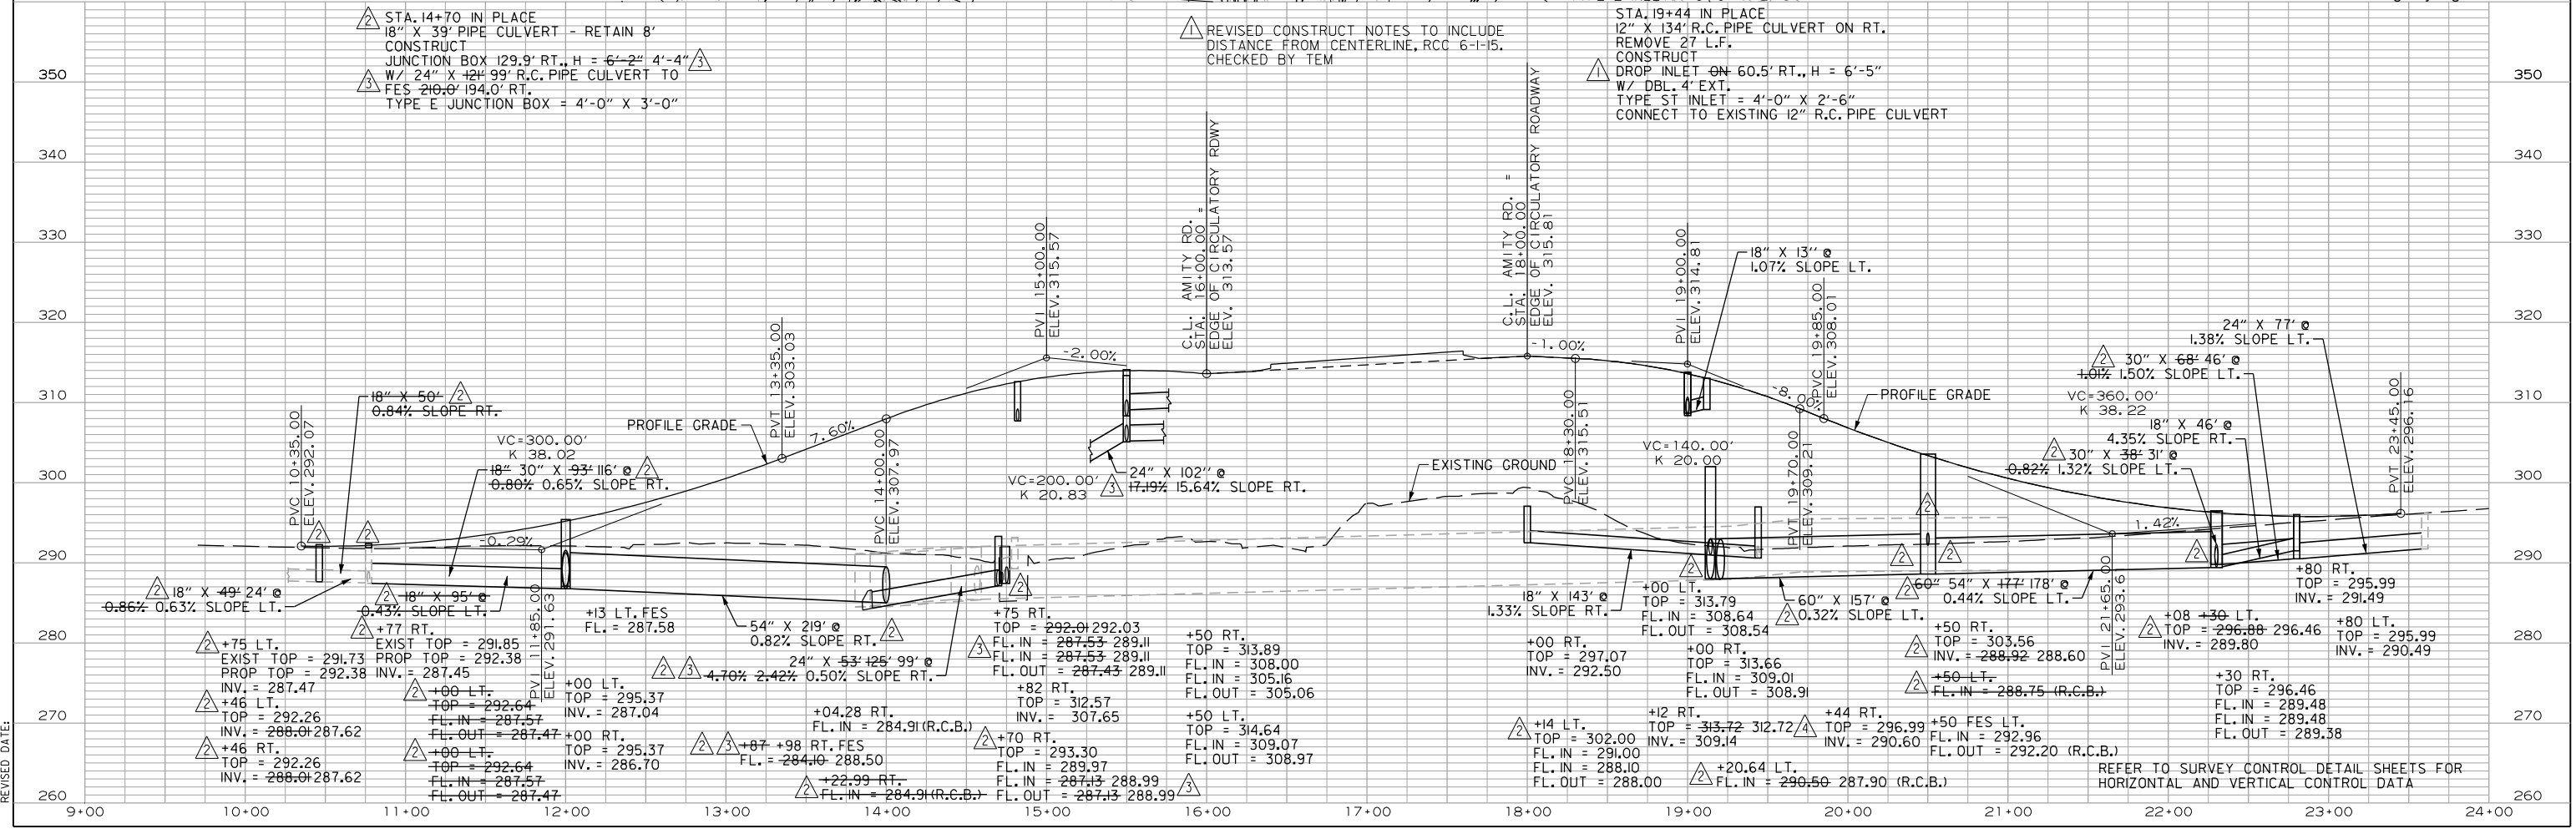


\$DATE\$\$  
 \$TIME\$\$  
 \$USER\$\$  
 \$WORKSPACE\$\$  
 \$FILES\$\$  
 \$REVISED DATE:

REFER TO SURVEY CONTROL DETAIL SHEETS FOR HORIZONTAL AND VERTICAL CONTROL DATA

DATE	DATE FILMED	DATE REVISED	DATE FILMED	FED. RD. DIST. NO.	STATE	FED. AID PROJ. NO.	SHEET NO.	TOTAL SHEETS
				6	ARK.	080517	53	182
				JOB NO. 080517				
				PLAN AND PROFILE - CIRCULATORY ROADWAY				

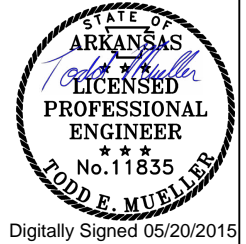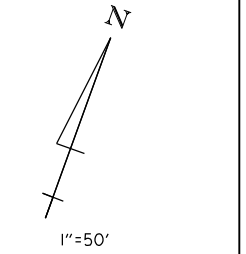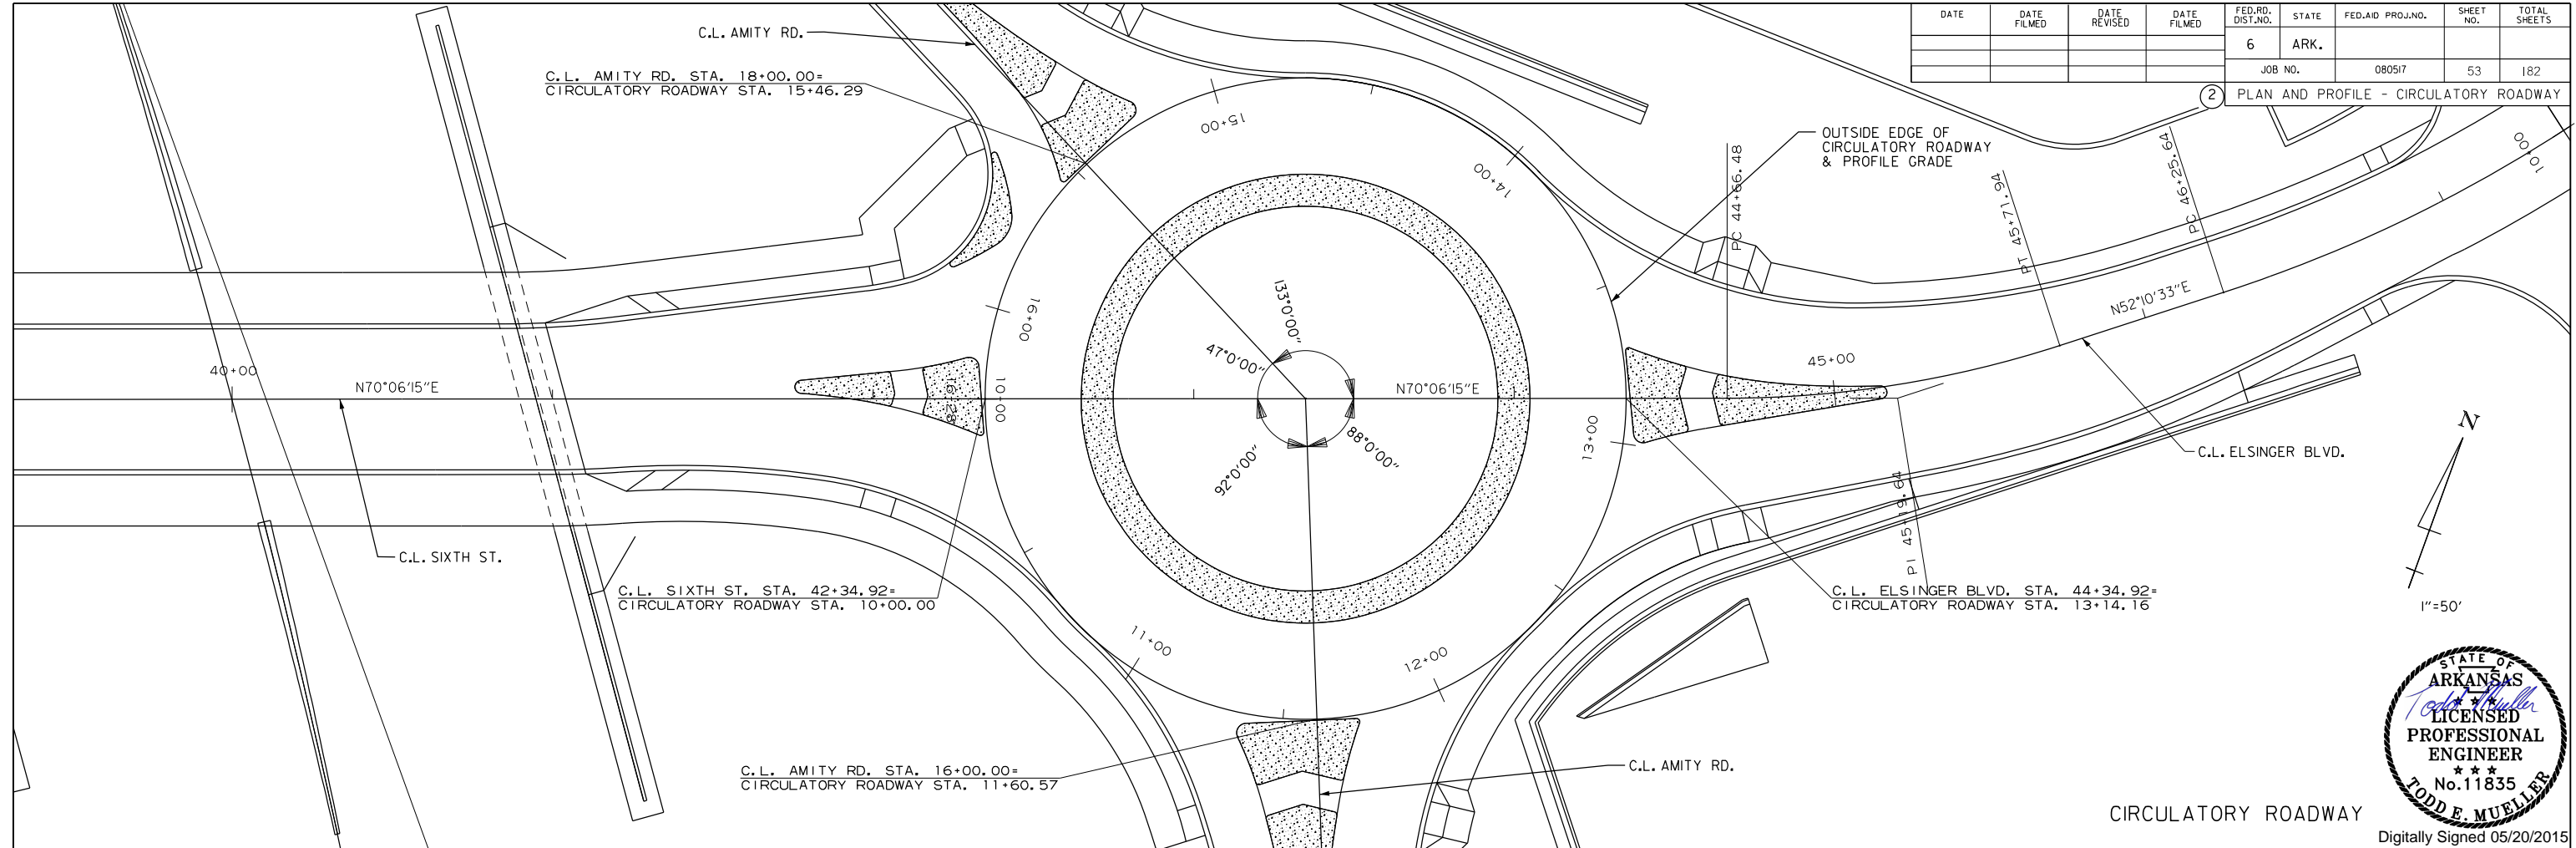


CIRCULATORY ROADWAY

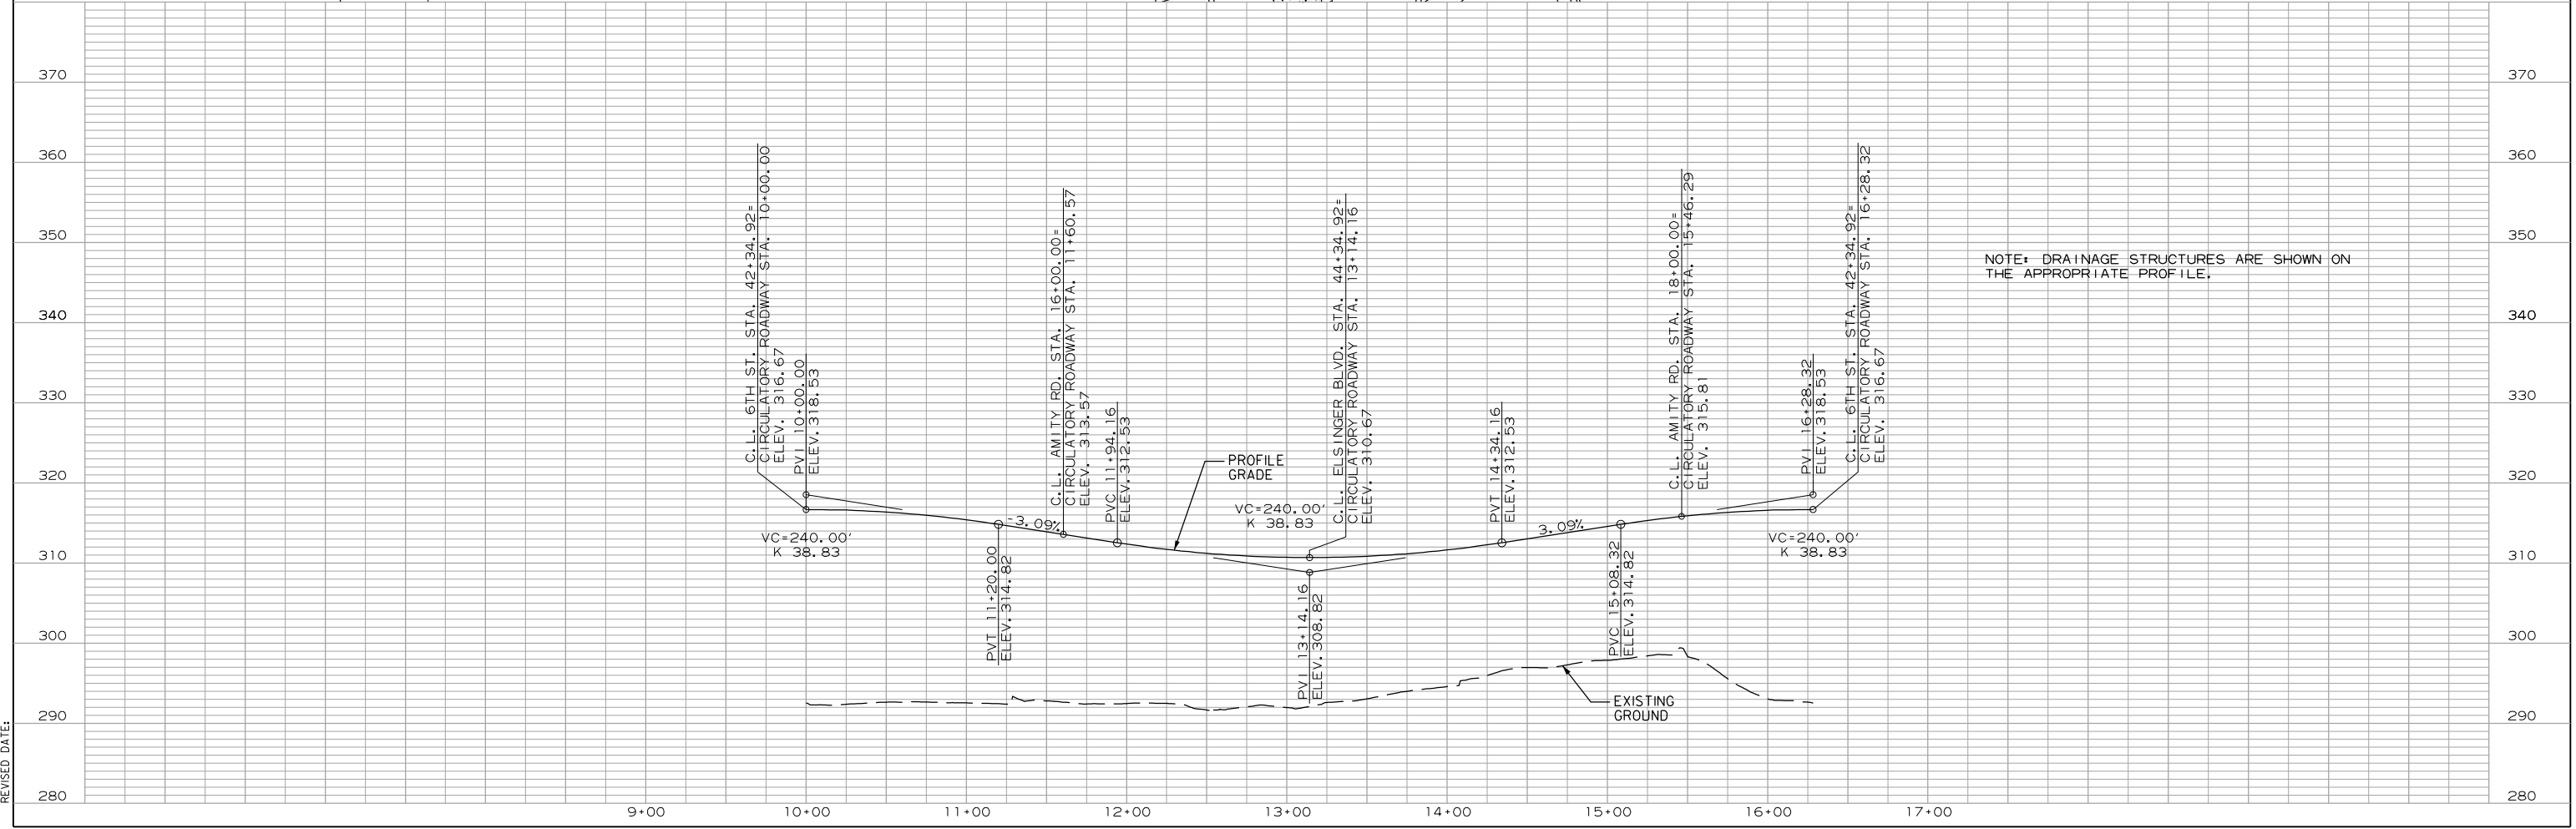

5/20/2015 7:13:23 AM  
 WORKSPACE: AHTD  
 L:\2012\201550 - Contrail\field Access\Drawings\6TH\_ST\6TH\_PP\_CIRC.01.dgn  
 REVISED DATE:

DATE REVISED	DATE FILMED	DATE REVISED	DATE FILMED	FED. RD. DIST. NO.	STATE	FED. AID PROJ. NO.	SHEET NO.	TOTAL SHEETS
2-10-2016				6	ARK.			
				JOB NO.		080517	54	182
PLAN AND PROFILE - DRIVEWAY I								

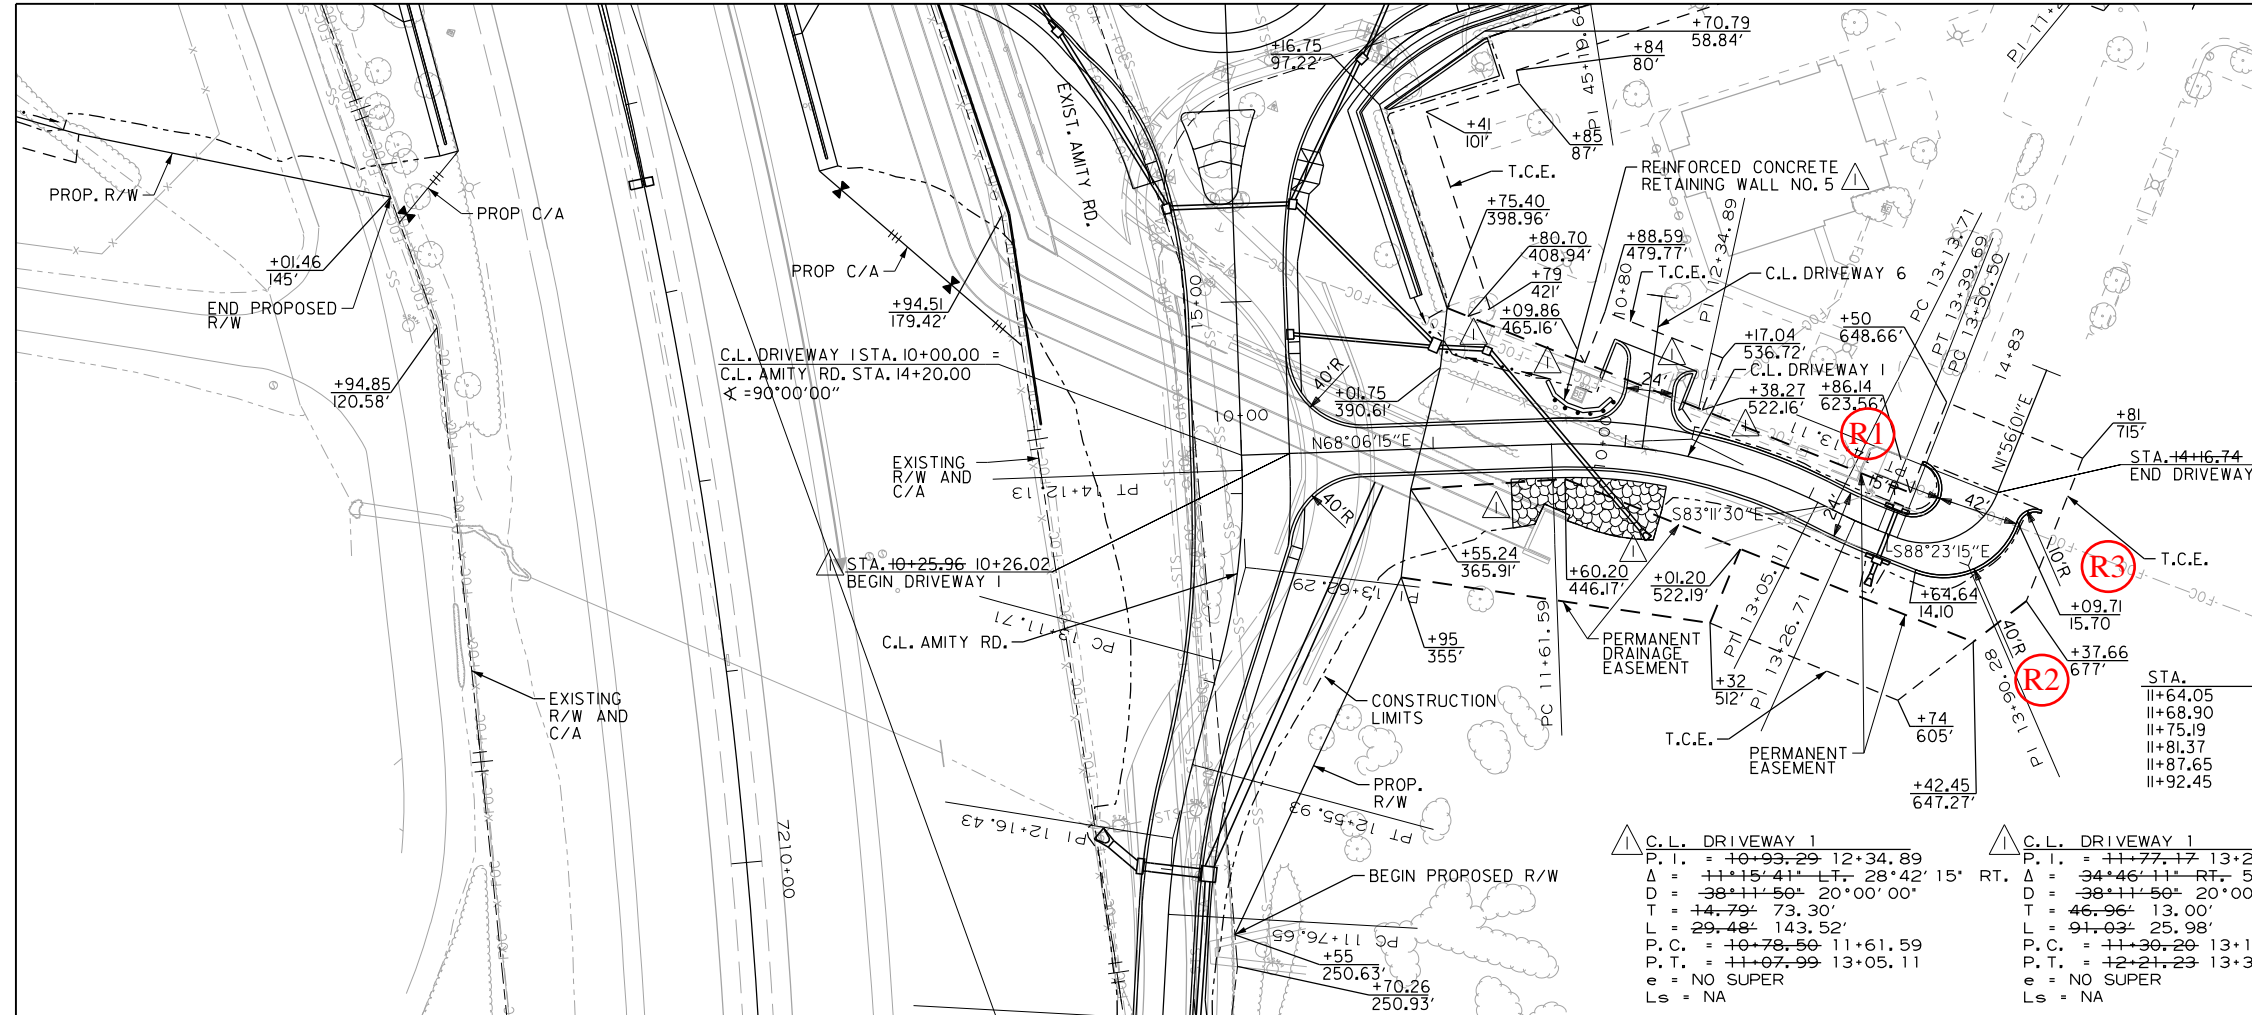

- ▲ STA. 11+40 TO 12+25 PLACE 205 TONS DUMPED RIPRAP
- ▲ STA. 13+50 13+45 CONSTRUCT DROP INLET ON LT. H = 4'-11" W/ DBL. 4' EXT. AND 24" X 27" R.C. PIPE CULVERT TO DROP INLET ON RT. TYPE MO INLET = 4'-0" DIA. TYPE C INLET = 4'-0" X 2'-6"
- ▲ STA. 13+50 13+45 CONSTRUCT DROP INLET ON RT. H = 5'-6" 5'-4" W/ DBL. 4' EXT. AND 24" X 27" R.C. PIPE CULVERT TO FES ON RT. TYPE MO INLET = 4'-0" DIA. TYPE C INLET = 4'-0" X 2'-6"
- ▲ STA. 14+06 12+03 CONSTRUCT APPROACH ON LT. = +3-10 CU. YD.

STA.	OFF.	SIDE	TYPE	UNIT
11+64.05	22.89'	LT.	30" (TYPE SPECIAL)	IEA.
11+68.90	18.65'	LT.	30" (TYPE SPECIAL)	IEA.
11+75.19	16.24'	LT.	30" (TYPE SPECIAL)	IEA.
11+81.37	15.86'	LT.	30" (TYPE SPECIAL)	IEA.
11+87.65	17.66'	LT.	30" (TYPE SPECIAL)	IEA.
11+92.45	22.48'	LT.	30" (TYPE SPECIAL)	IEA.

▲ C.L. DRIVEWAY 1



P. I.	= 10+93.29 12+34.89
Δ	= 11+15.41' LT. 28°42' 15" RT.
D	= 38+11.50' 20'00' 00"
T	= 14.79' 73.30'
L	= 29.48' 143.52'
P. C.	= 10+78.50 11+61.59
P. T.	= 11+07.99 13+05.11
e	= NO SUPER
Ls	= NA

▲ C.L. DRIVEWAY 1

P. I.	= 11+77.17 13+26.71
Δ	= 34°46' 11" RT. 5°11' 45" RT.
D	= 38+11.50' 20'00' 00"
T	= 46.96' 13.00'
L	= 91.03' 25.98'
P. C.	= 11+30.20 13+13.71
P. T.	= 12+21.23 13+39.69
e	= NO SUPER
Ls	= NA

▲ C.L. DRIVEWAY 1

P. I.	= 13+93.23 13+90.27
Δ	= 89°40' 44" LT.
D	= 143' 14' 22"
T	= 39.78'
L	= 62.61'
P. C.	= 13+59.45 13+50.50
P. T.	= 14+16.06 14+13.10
e	= NO SUPER
Ls	= NA

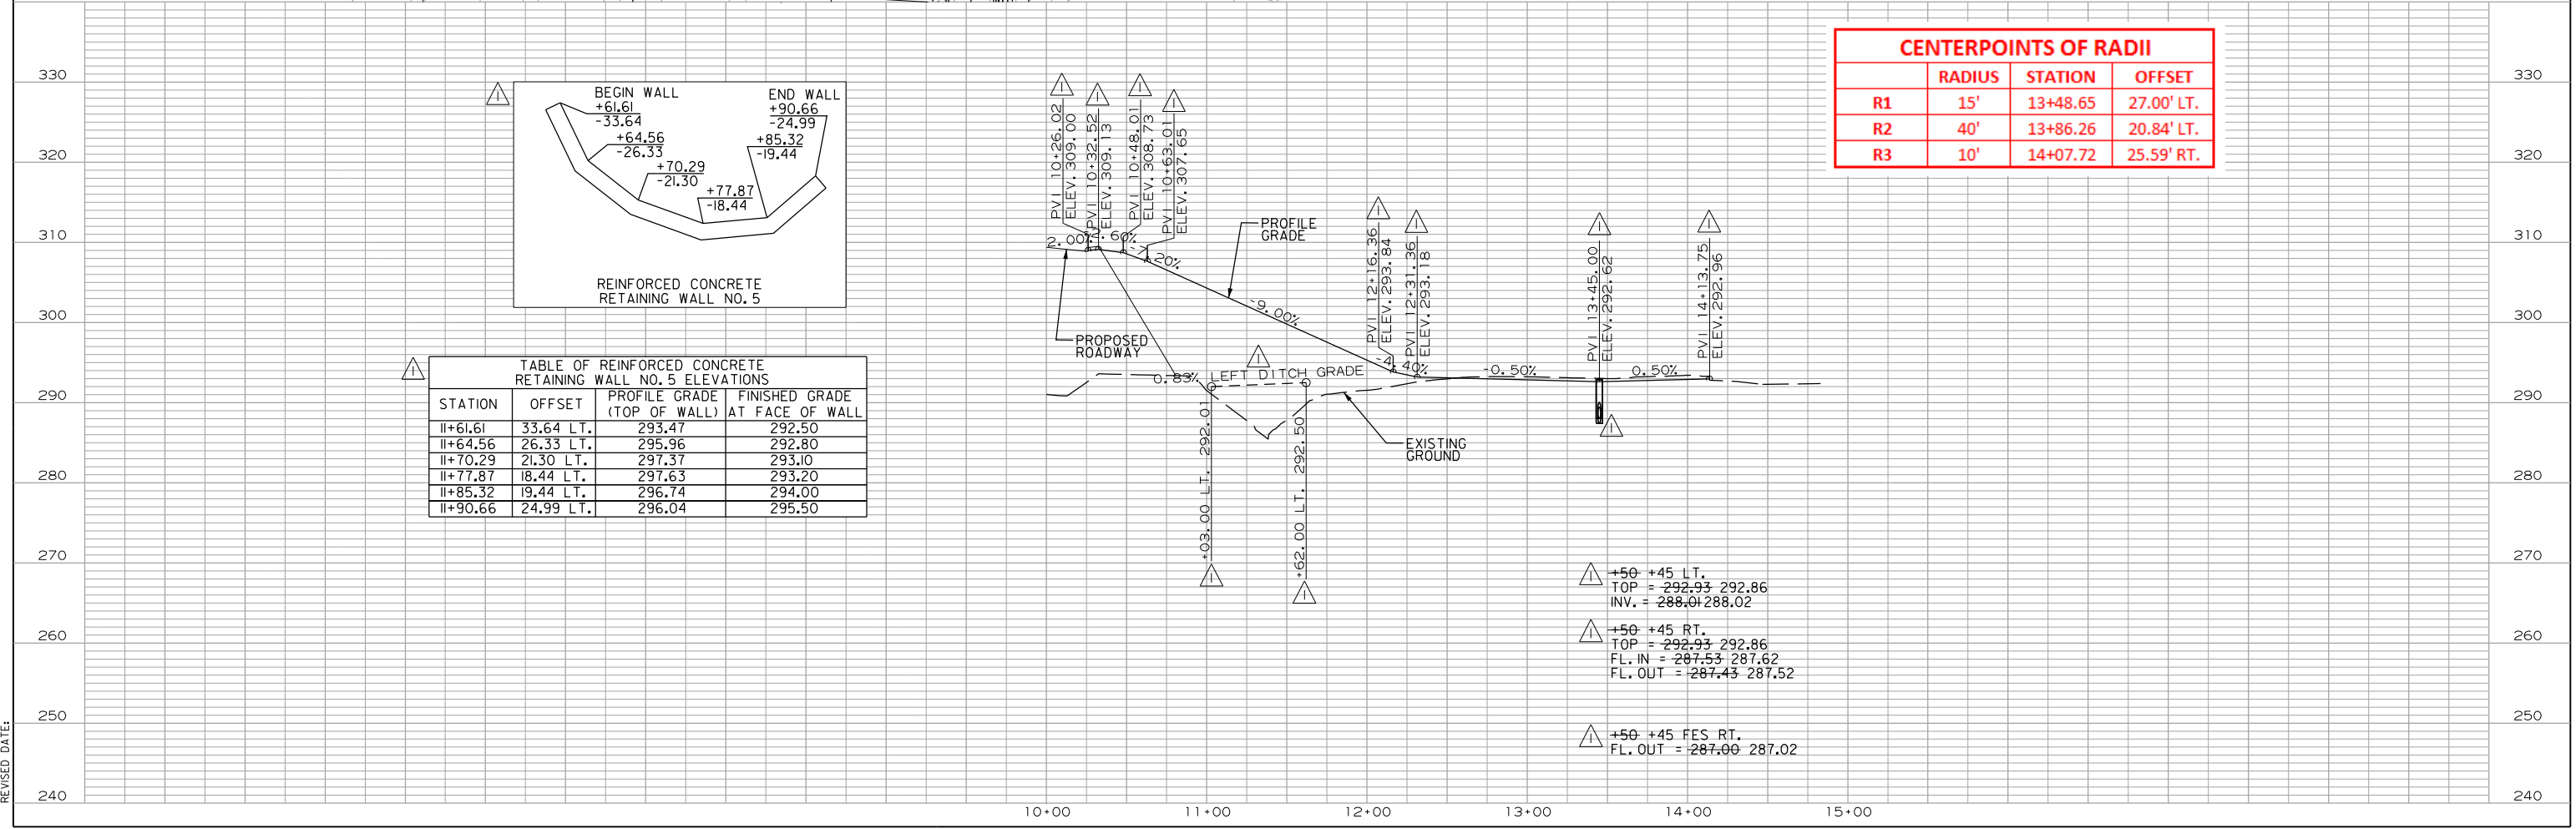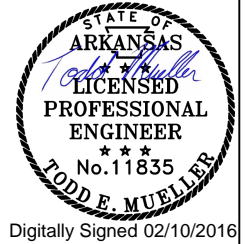


2/10/2016 4:34:06 PM  
 WORKSPACE: AHTD  
 L:\2012\1201590 - Contr-ell\field Access\Drawings\6TH\_ST\6TH\_PP\_DWY\_01.dgn  
 REVISED DATE:

DATE REVISED	DATE FILMED	DATE REVISED	DATE FILMED	FED. RD. DIST. NO.	STATE	FED. AID PROJ. NO.	SHEET NO.	TOTAL SHEETS
2-10-2016				6	ARK.			
				JOB NO.	080517		55	182


2 DRIVEWAY PROFILES




Digitally Signed 02/10/2016

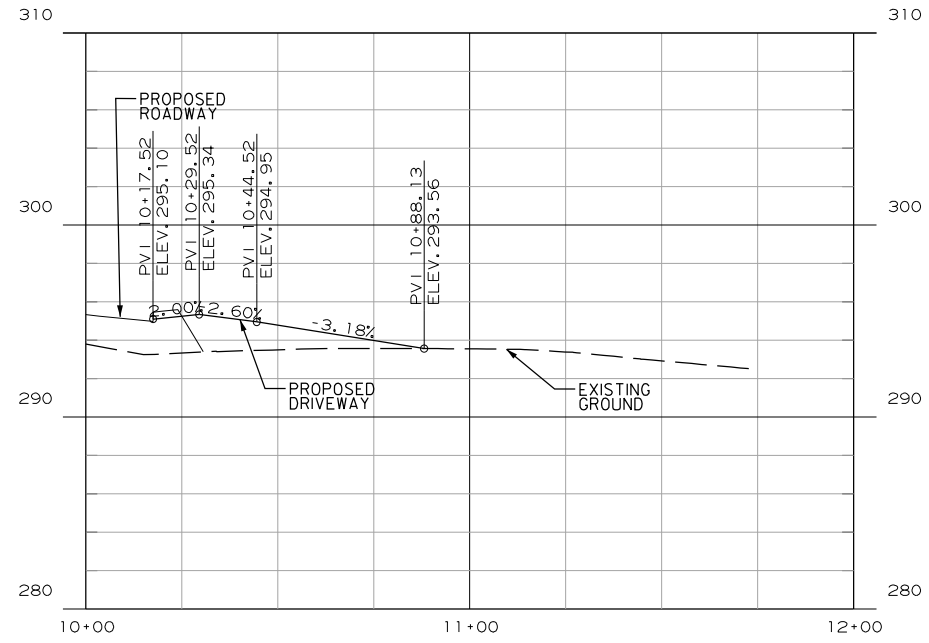


DRIVEWAY 2  
ELSINGER BLVD. STA. 47+44 RT.

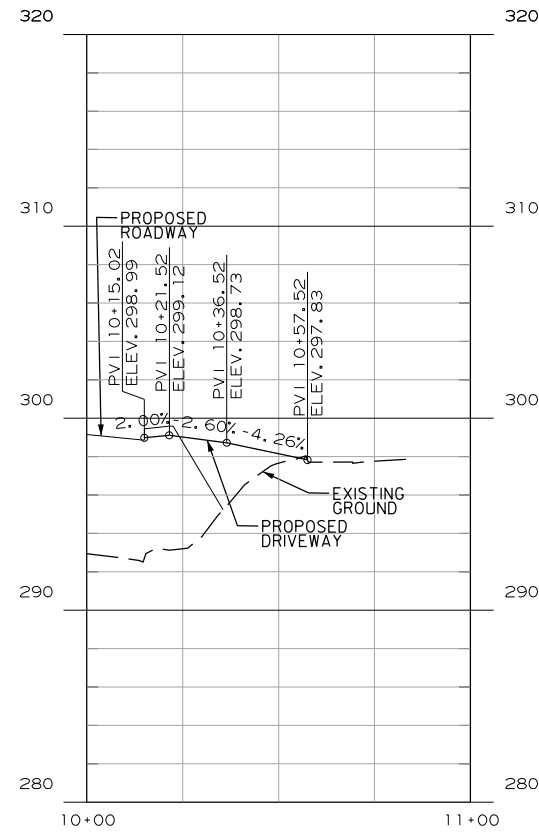


DRIVEWAY 3  
AMITY RD. STA. 21+30

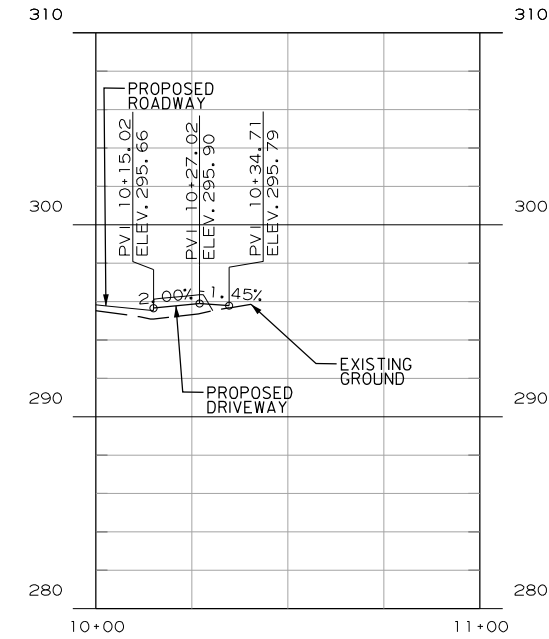


DRIVEWAY 4  
AMITY RD. STA. 23+11

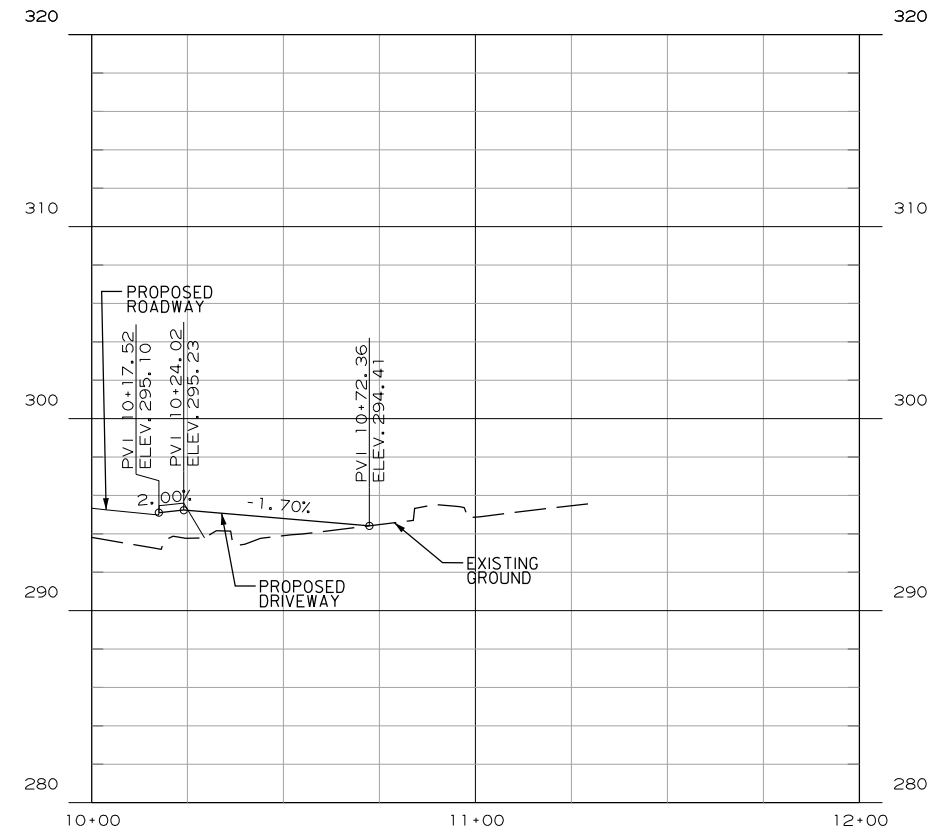

DRIVEWAY 5  
ELSINGER BLVD. STA. 47+44 LT.

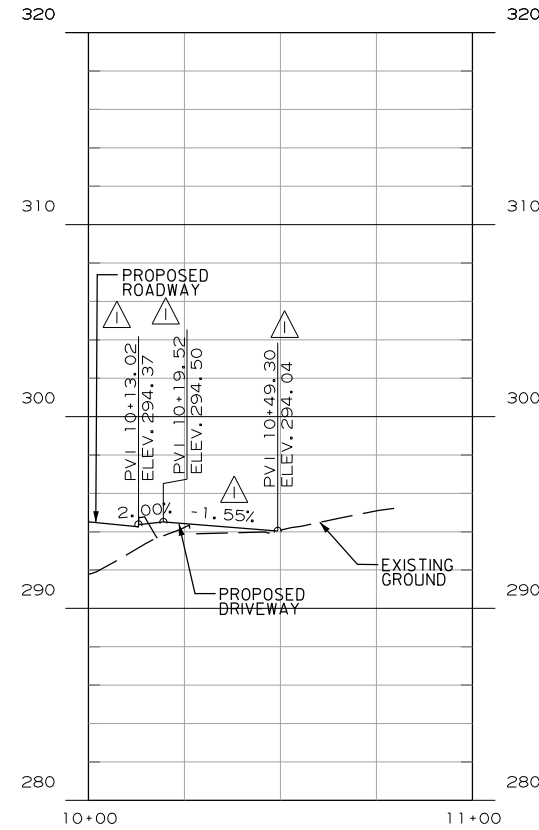

DRIVEWAY 6  
DRIVEWAY 1 STA. 12+06 12+09


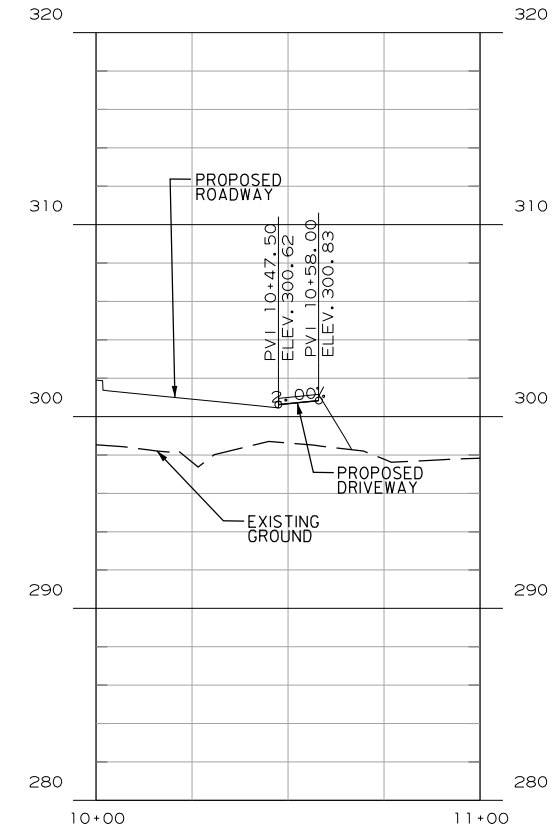


DRIVEWAY 7  
6TH ST. STA. 32+46 LT.



DRIVEWAY PROFILES

DATE REVISED	DATE FILMED	DATE REVISED	DATE FILMED	FED. RD. DIST. NO.	STATE	FED. AID PROJ. NO.	SHEET NO.	TOTAL SHEETS
2-10-2016				6	ARK.	080517	56	182

PLAN AND PROFILE - MOT

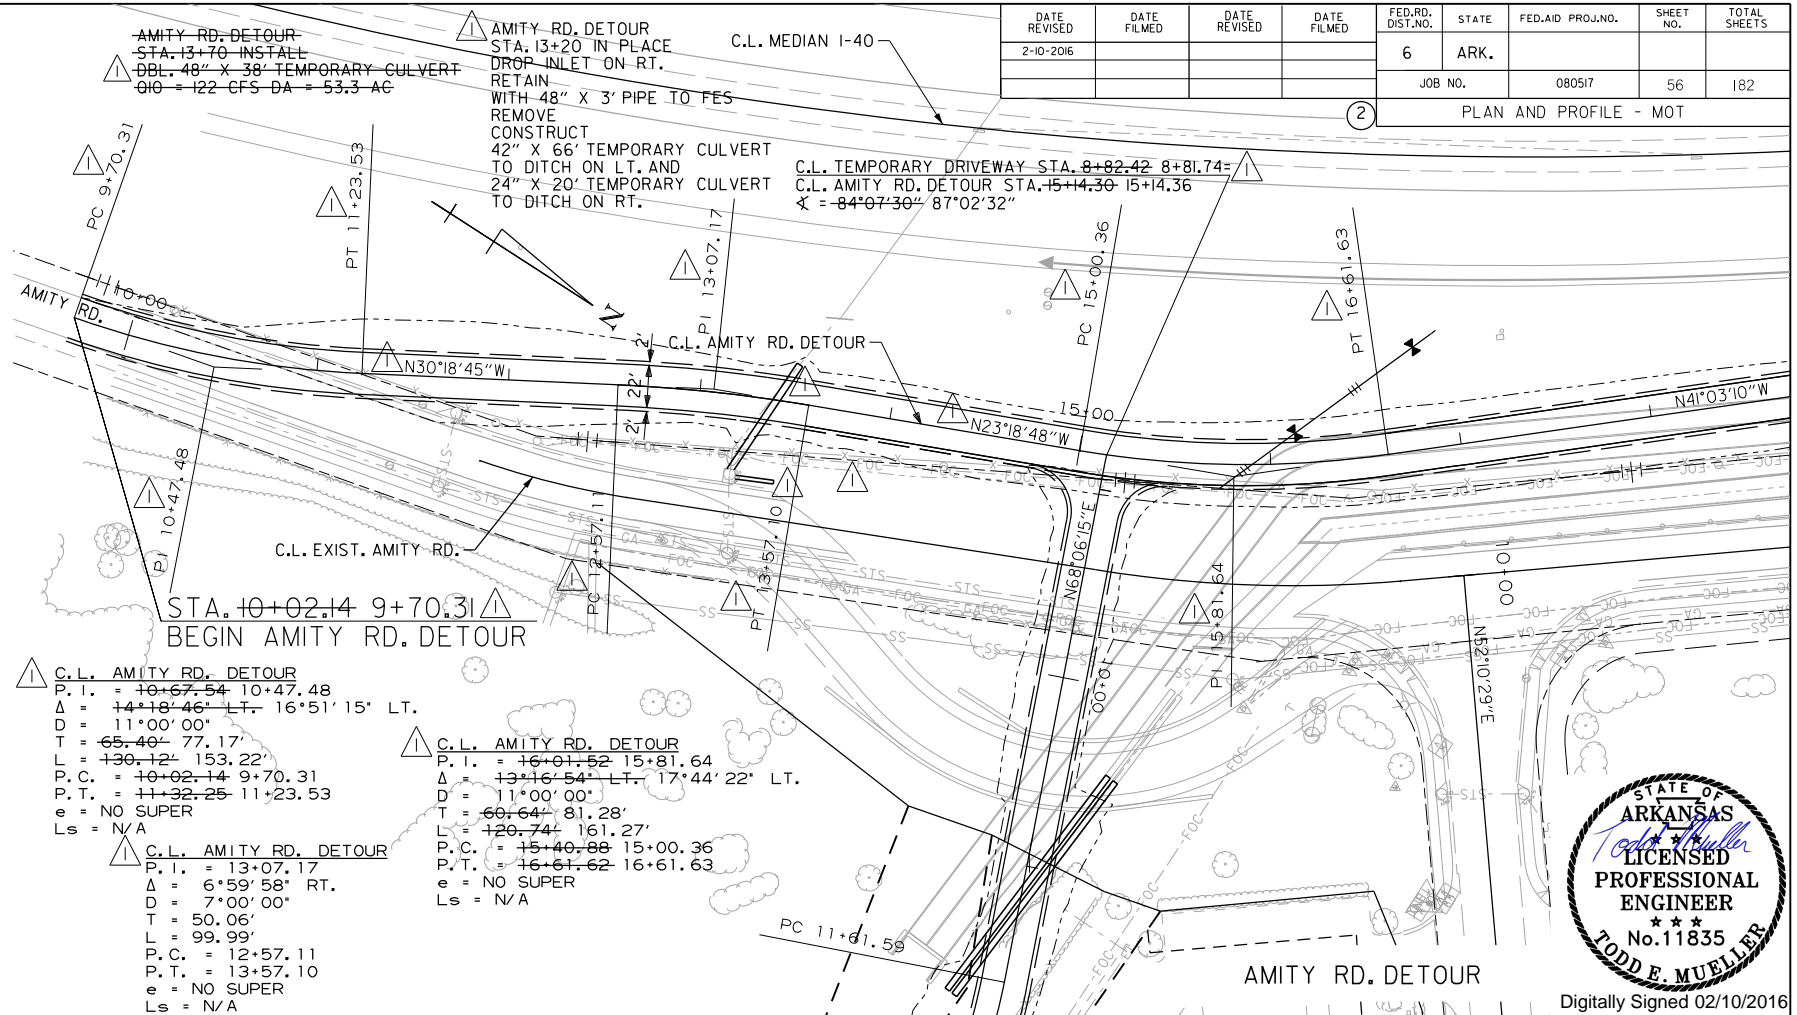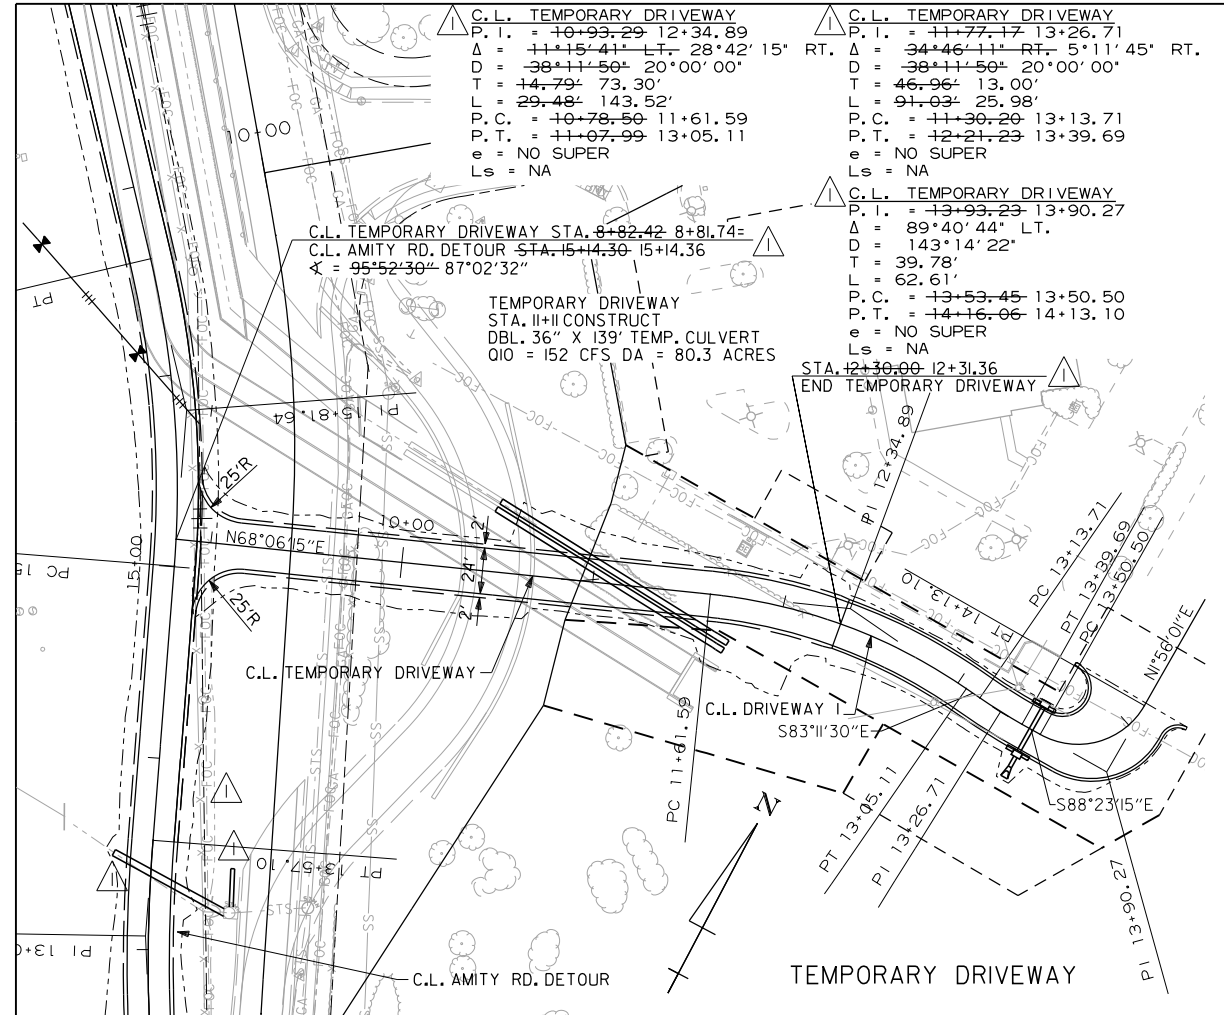


Digitally Signed 02/10/2016

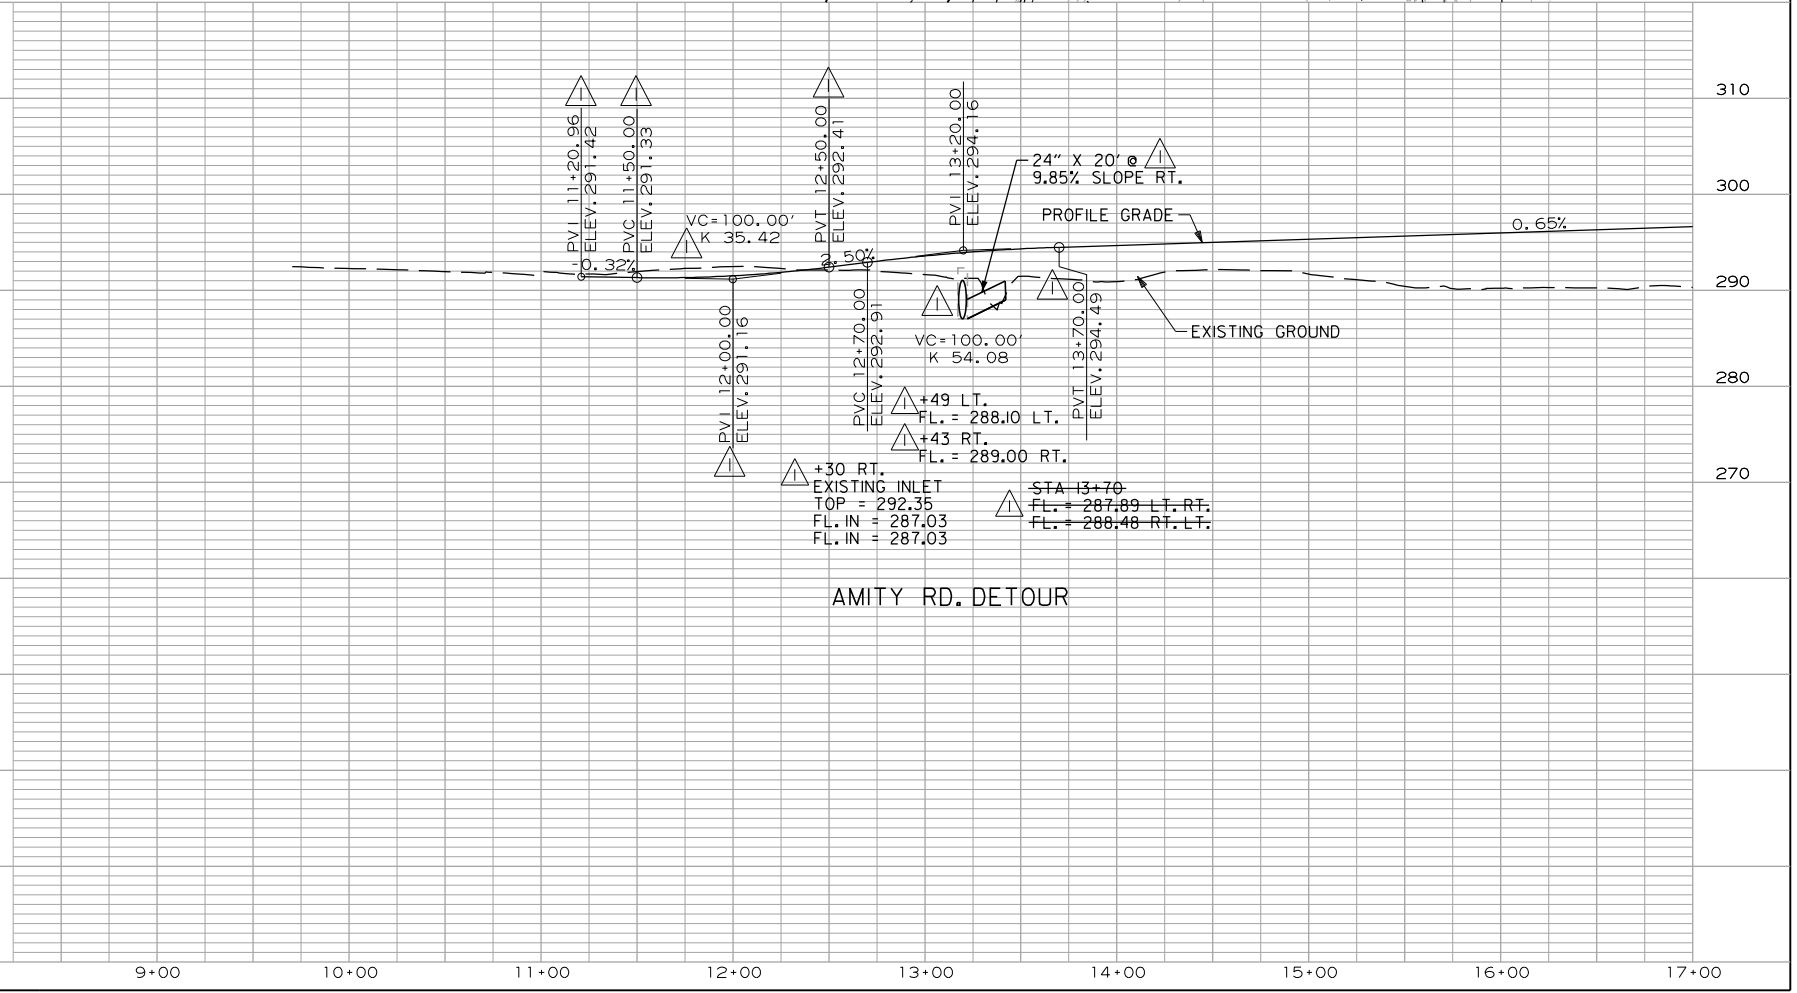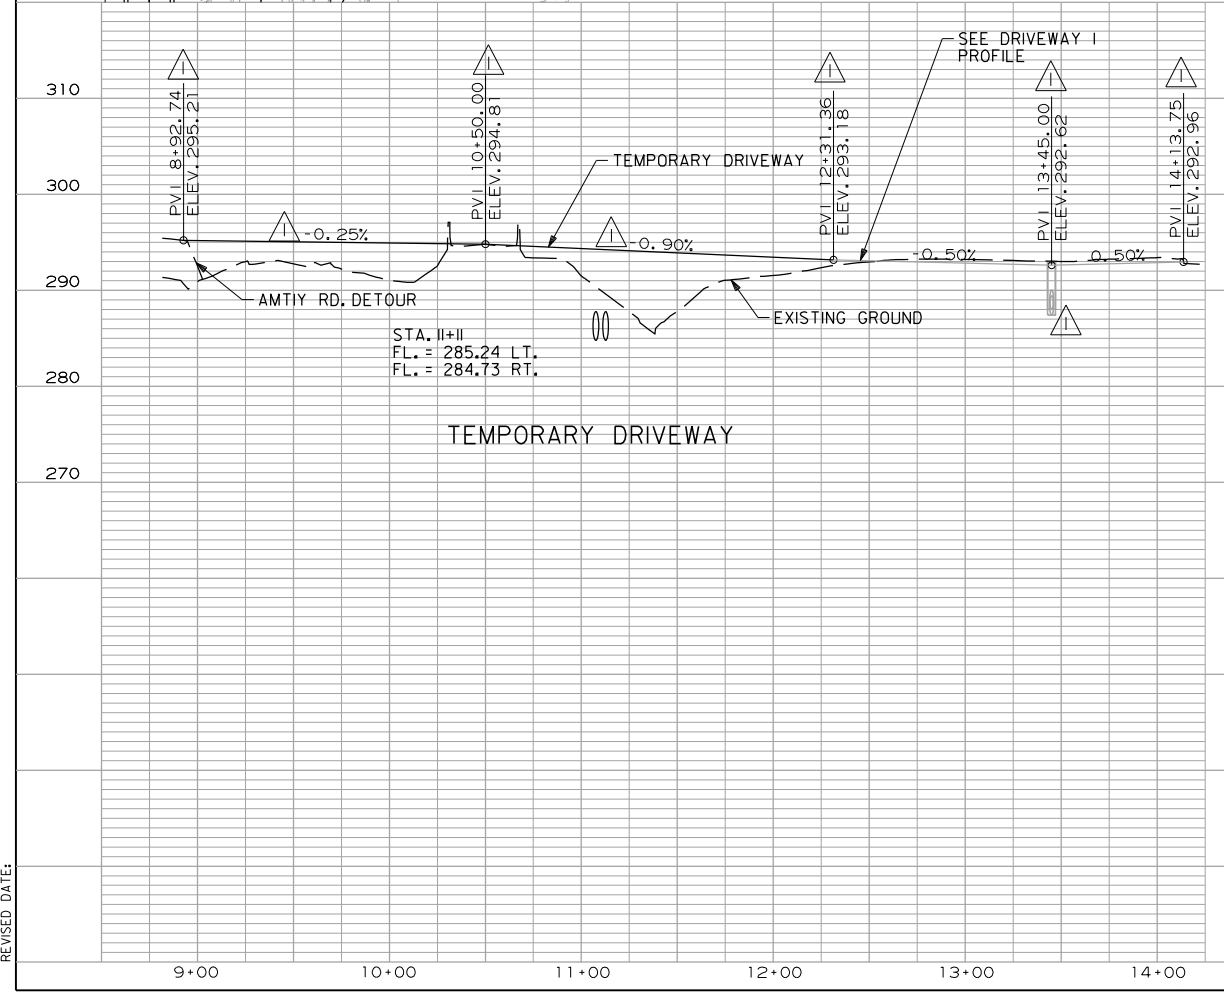




DATE REVISED	DATE FILMED	DATE REVISED	DATE FILMED	FED. RD. DIST. NO.	STATE	FED. AID PROJ. NO.	SHEET NO.	TOTAL SHEETS
2-10-2016				6	ARK.	080517	57	182

PLAN AND PROFILE - MOT

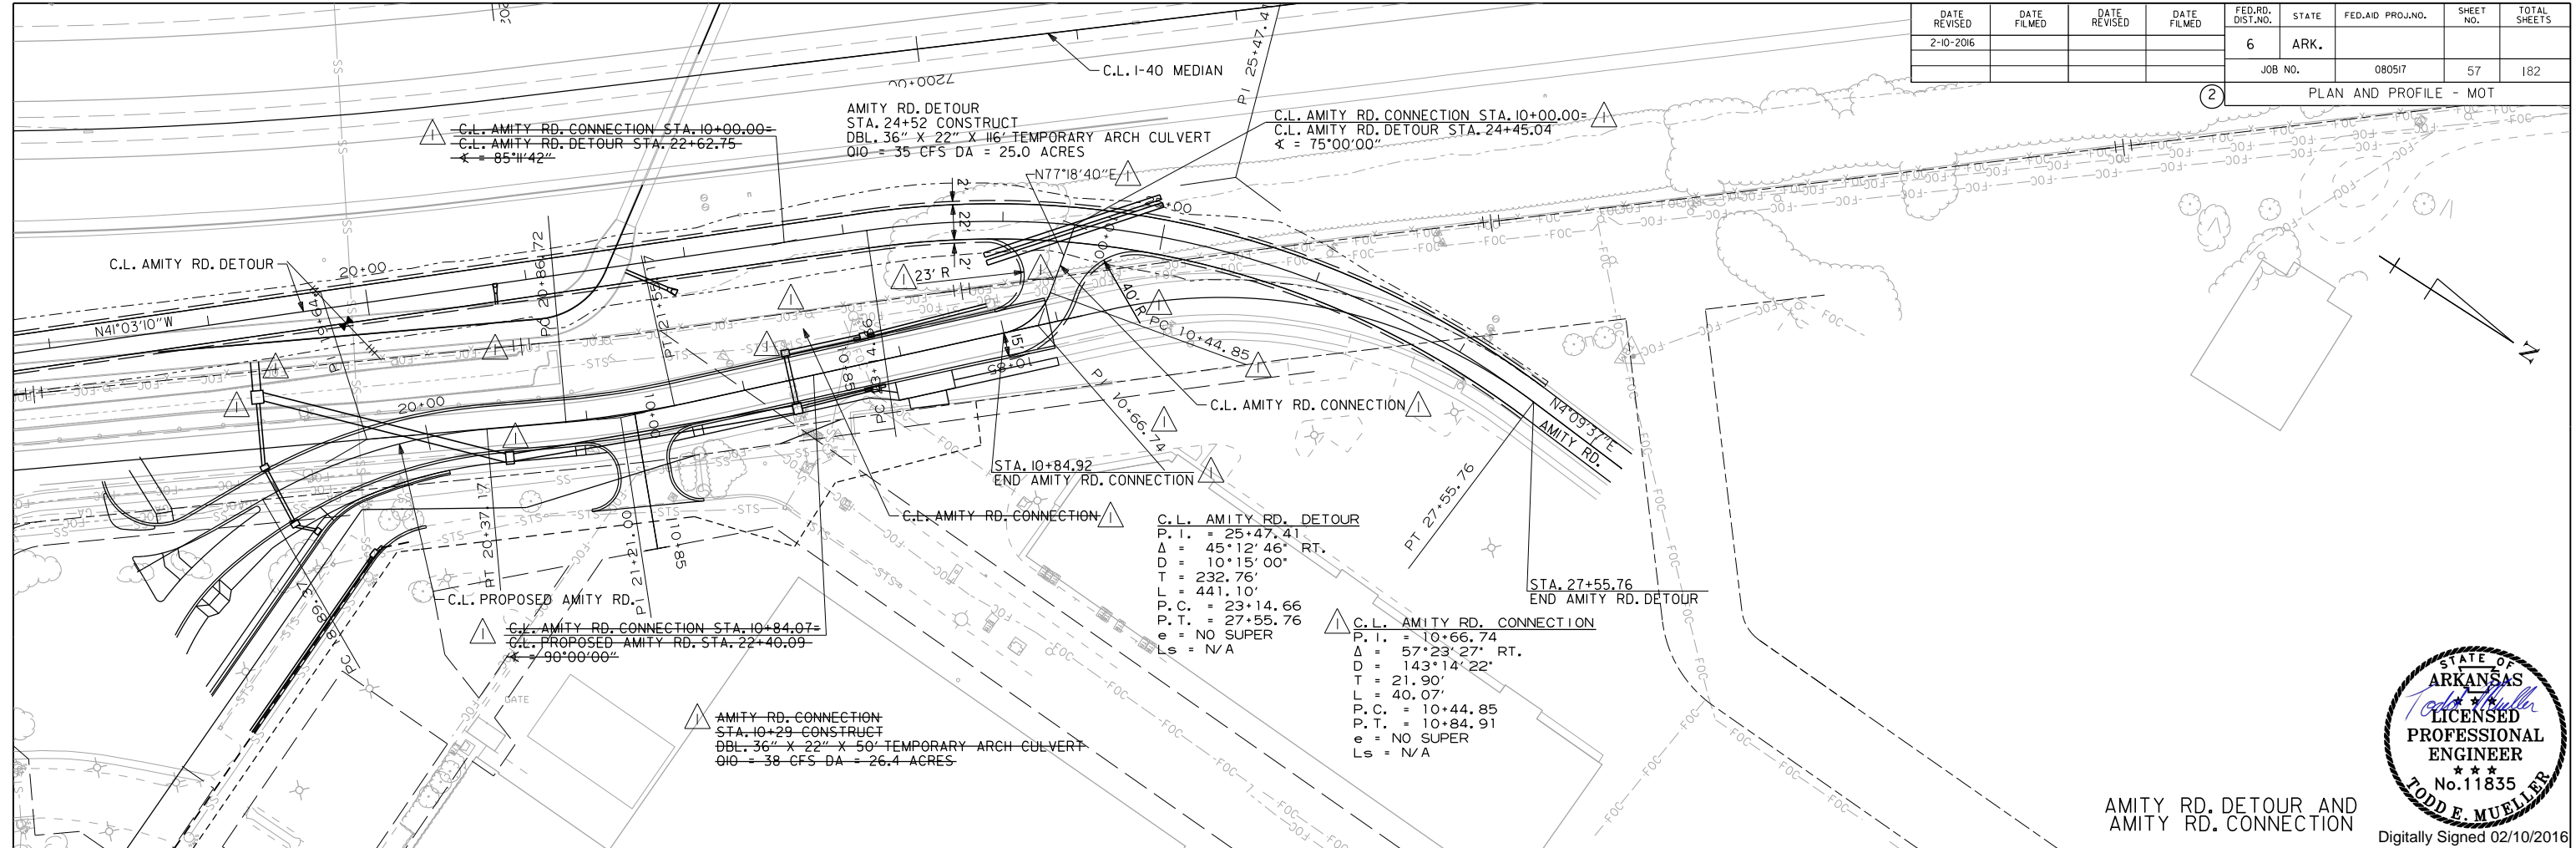

AMITY RD. DETOUR AND AMITY RD. CONNECTION  
 Digitally Signed 02/10/2016

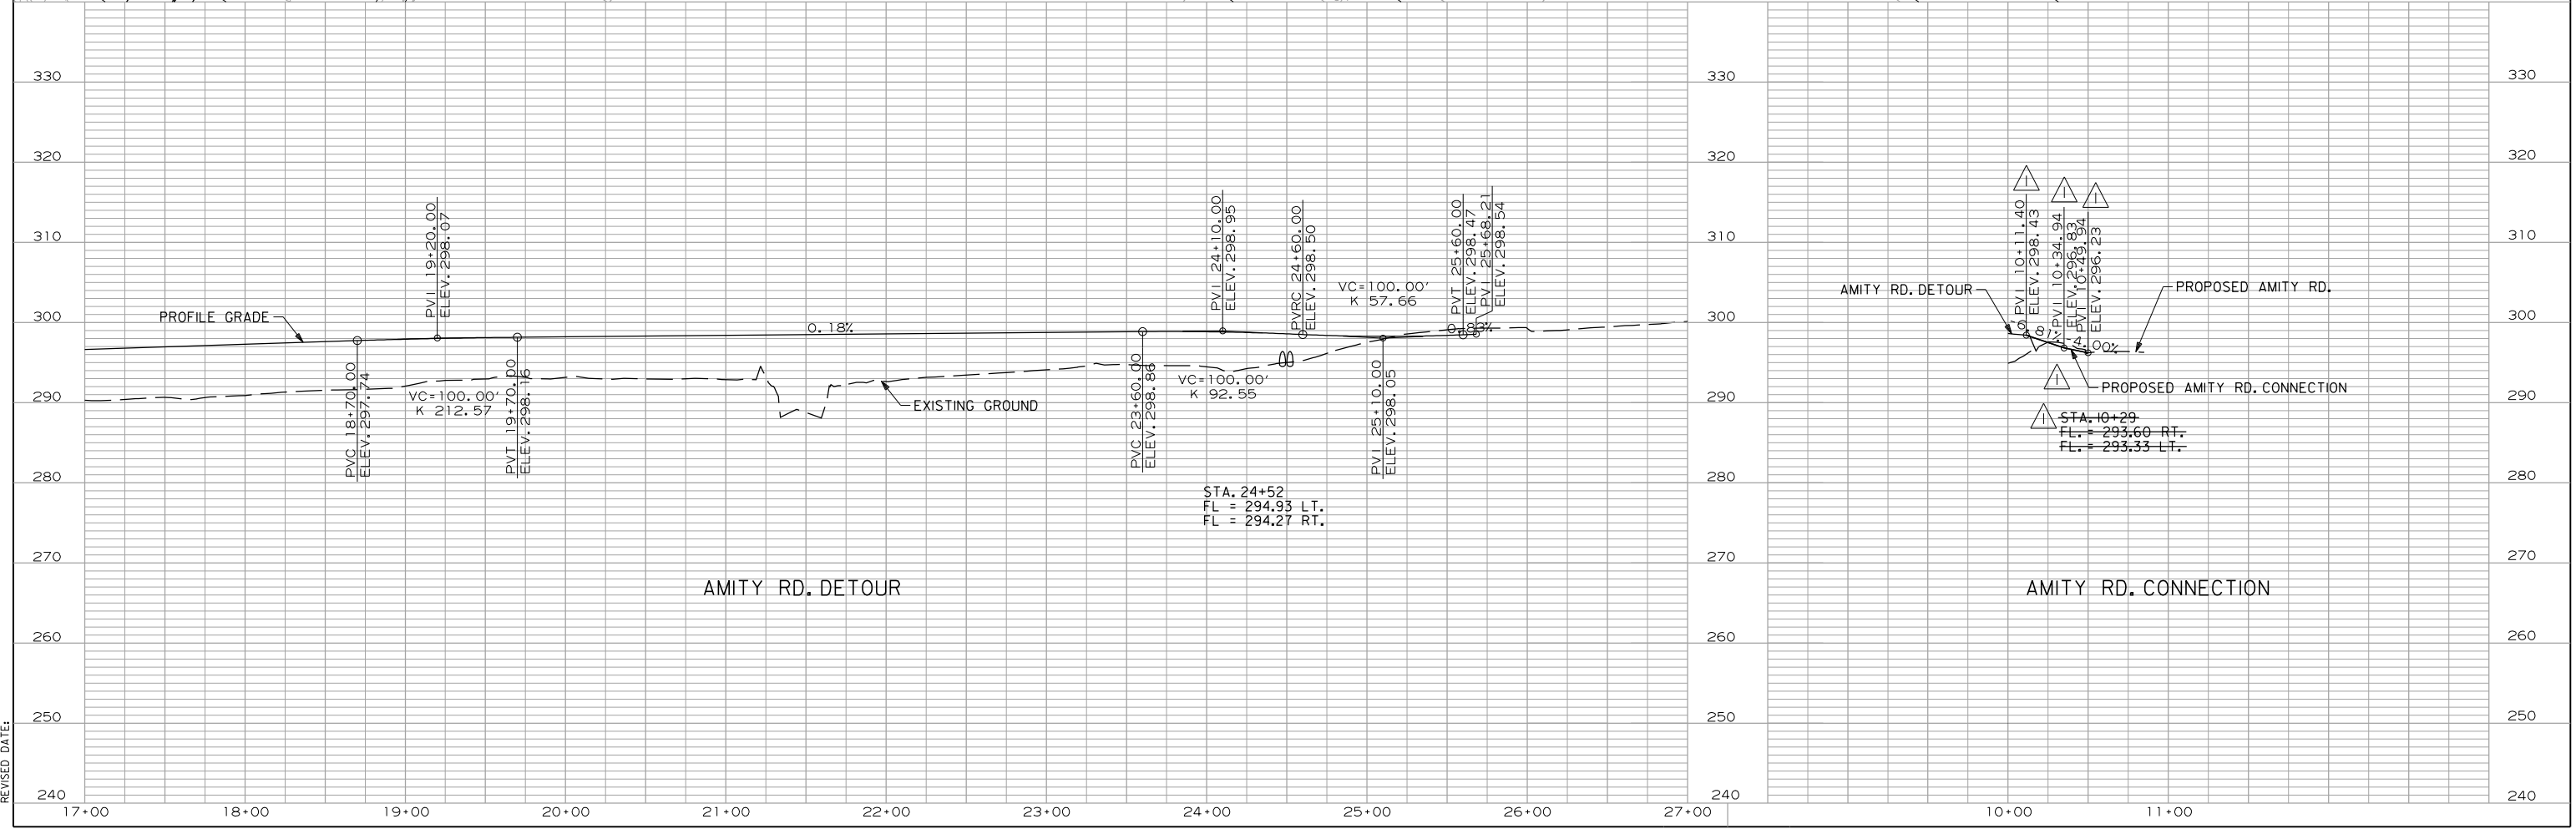

2/10/2016 4:34:17 PM  
 WORKSPACE: AHTD  
 L:\2012\201590 - ContrailField Access\Drawings\6TH\_ST\6TH\_MOT\_PP\_03.dgn  
 REVISED DATE:

DATE REVISED	DATE FILMED	DATE REVISED	DATE FILMED	FED. RD. DIST. NO.	STATE	FED. AID PROJ. NO.	SHEET NO.	TOTAL SHEETS
				6	ARK.			
				JOB NO.		080517	58	182
(2) SIGNING QUANTITIES								

STANDARD SIGN QUANTITIES  
U-CHANNEL POSTS

SIGN NO./LOCATION	U-CHANNEL POST ASSEMBLIES		
	U-1	U-2	U-2(A)
	EACH	EACH	EACH
SS-6TH-23-STA32+56SB	1		
SS-6TH-23-STA35+48WB	1		
SS-6TH-23-STA36+60WB	1		
SS-6TH-23-STA38+69EB	1		
SS-6TH-23-STA38+92EB	1		
SS-6TH-23-STA40+99WB	1		
SS-6TH-23-STA41+23WB	1		
SS-6TH-23-STA41+31EB	1		
SS-6TH-23-STA41+93EB			1
SS-6TH-23-STA42+04EB/WB			1
SS-6TH-23-STA42+13WB			1
SS-6TH-23-STA42+31EB			1
SS-6TH-23-STA42+31WB		1	
SS-6TH-23-STA42+34EB			1
SS-6TH-23-STA42+89EB		1	
SS-AMITY-23-STA9+86NB	1		
SS-AMITY-23-STA9+91SB	1		
SS-AMITY-23-STA10+49NB	1		
SS-AMITY-23-STA10+57SB	1		
SS-AMITY-23-STA11+47SB	1		
SS-AMITY-23-STA14+77NB	1		
SS-AMITY-23-STA15+54NB			1
SS-AMITY-23-STA15+69NB/SB			1
SS-AMITY-23-STA15+78SB			1
SS-AMITY-23-STA15+87NB			1
SS-AMITY-23-STA15+92SB		1	
SS-AMITY-23-STA15+95NB			1
SS-AMITY-23-STA16+48NB		1	
SS-AMITY-23-STA17+53SB		1	
SS-AMITY-23-STA18+04NB		1	
SS-AMITY-23-STA18+08SB			1
SS-AMITY-23-STA18+19SB			1
SS-AMITY-23-STA18+27NB			1
SS-AMITY-23-STA18+30NB/SB			1
SS-AMITY-23-STA18+42SB			1
SS-AMITY-23-STA21+97SB	1		
SS-AMITY-23-STA22+09NB	1		
SS-AMITY-23-STA23+43SB	1		
SS-DWY1-23-STA10+51WB	1		
SS-DWY1-23-STA14+12EB	1		
SS-DWY2-23-STA10+35WB	1		
SS-DWY3-23-STA10+24WB	1		
SS-ELSINGER-23-STA43+73WB		1	
SS-ELSINGER-23-STA44+39EB		1	
SS-ELSINGER-23-STA44+41WB			1
SS-ELSINGER-23-STA44+42WB			1
SS-ELSINGER-23-STA44+60EB			1
SS-ELSINGER-23-STA44+67EB/WB			1
SS-ELSINGER-23-STA44+79WB			1
SS-ELSINGER-23-STA45+56EB	1		
SS-ELSINGER-23-STA45+58WB	1		
<b>TOTALS</b>	<b>23</b>	<b>8</b>	<b>20</b>

STANDARD ROADSIDE SIGNS  
SHEET ALUMINUM 0.100" THICKNESS  
(5 SQ. FT. OR LESS)

STANDARD ROADSIDE SIGNS SHEET ALUMINUM 0.100" THICKNESS (5 SF OR LESS)					
SIGN NO.	SIZE OF SIGN	UNIT AREA (SQ. FT.)	QUANTITY REQUIRED	TOTAL SIGN AREA (SQ. FT.)	LEGEND/BACKGROUND
R2-1	24" x 30"	5.00	3	15.00	BLACK/WHITE
R3-17	24" x 30"	3.00	1	3.00	BLACK/WHITE
R3-17aP	24" x 30"	1.33	1	1.33	BLACK/WHITE
R4-7	24" x 30"	5.00	1	5.00	BLACK/WHITE
R6-1R	24" x 30"	3.00	1	3.00	BLACK/WHITE
W16-7pL	24" x 30"	2.00	8	16.00	BLACK/YELLOW
W16-7pR	24" x 30"	2.00	8	16.00	BLACK/YELLOW
OM3-L	24" x 30"	3.00	2	6.00	BLACK/YELLOW
OM3-R	24" x 30"	3.00	3	9.00	BLACK/YELLOW
<b>TOTAL 0.100" THICKNESS</b>				<b>74.33</b>	

STANDARD ROADSIDE SIGNS  
SHEET ALUMINUM 0.125" THICKNESS  
(GREATER THAN 5 SQ. FT.)

STANDARD ROADSIDE SIGNS SHEET ALUMINUM 0.125" THICKNESS (GREATER THAN 5 SF)					
SIGN NO.	SIZE OF SIGN	UNIT AREA (SQ. FT.)	QUANTITY REQUIRED	TOTAL SIGN AREA (SQ. FT.)	LEGEND/BACKGROUND
D1-2 (AMITY RD)	36" x 24"	6.00	2	12.00	WHITE/GREEN
D1-2 (ELSINGER BLVD)	36" x 24"	7.00	1	7.00	WHITE/GREEN
D1-2 (6TH ST)	36" x 24"	5.00	1	5.00	WHITE/GREEN
R1-1	36" x 24"	9.00	4	36.00	WHITE/RED
R1-2	36" x 24"	6.93	8	55.43	RED/WHITE
R3-8	36" x 24"	9.00	4	36.00	BLACK/WHITE
R4-11	36" x 24"	6.25	4	25.00	BLACK/WHITE
R6-4a	36" x 24"	8.00	4	32.00	BLACK/WHITE
R6-5P	36" x 24"	6.25	8	50.00	BLACK/WHITE
W11-2	36" x 24"	9.00	16	144.00	BLACK/YELLOW
<b>TOTAL 0.125" THICKNESS</b>				<b>402.43</b>	

QUANTITIES FOR  
INFORMATION ONLY



Digitally Signed 05/20/2015

DATE REVISED	DATE FILMED	DATE REVISED	DATE FILMED	FED. RD. DIST. NO.	STATE	FED. AID PROJ. NO.	SHEET NO.	TOTAL SHEETS
				6	ARK.			
				JOB NO.	080517	59	182	

2 SIGNING QUANTITIES



Digitally Signed 05/20/2015

### SIGNING QUANTITIES ROADSIDE MOUNTED I-BEAM SIGN SUPPORTS

SIGN NO./ LOCATION	STRUCTURE TYPE	SIGN				BREAKAWAY SIGN SUPPORT											EXIT NUMBER PANEL				
	TYPE	STANDARD SIGN	GUIDE SIGN			STEEL SECT.		Sign Post Length			STUB POST			FOOTINGS			SIGN POST AND STUB	LEGEND	TYPE		
			LENGTH	HEIGHT		A-572		H-1	H-2	H-3	H-1	H-2	H-3	DIA.	DEPTH	EMBED.			A	B	C
	G-2	SQ. FT.	FT.	FT.	SQ. FT.	BEAM	LBS	LIN FT			LIN FT			LIN FT			POUND	SQ. FT.			
GM-6TH-23-STA37+92EB	1		12.00	7.50	90.00	W8	18	14.25	16.5		5.33	5.33		3	7.5	5.00	745.39				
GM-AMITY-23-STA13+59NB	1		12.50	7.50	93.75	W8	18	15.5	18		5.66	5.66		3	8	5.33	806.89				
GM-AMITY-23-STA20+24SB	1		12.50	7.50	93.75	W8	18	15	16.5		5.00	5.00		2.5	7	4.67	746.89				
GM-ELSINGER-23-STA48+35WB	1		7.50	9.50	71.25	W8	18	18	18.5		5.33	5.33		3	7.5	5.00	848.89				
<b>TOTALS:</b>	<b>4</b>	<b>39.51</b>			<b>348.75</b>												<b>3148.06</b>	<b>0.00</b>	<b>0.00</b>	<b>0.00</b>	

### SIGNING SUMMARY OF QUANTITIES





ITEM NUMBER	ITEM	TOTAL	UNIT
SP & 725	GUIDE SIGN-ROADSIDE MOUNTED (DEMOUNTABLE LEGEND)	349	SQ. FT.
SP & 726	STANDARD SIGN	477	SQ. FT.
SP & 729	CHANNEL POST SIGN SUPPORT (TYPE U-1)	23	SQ. FT.
SP & 729	CHANNEL POST SIGN SUPPORT (TYPE U-2)	8	EACH
SP & 729	CHANNEL POST SIGN SUPPORT (TYPE U-2(A))	20	EACH
730	BREAKAWAY SIGN SUPPORT (TYPE G-2)	3148	POUND

QUANTITIES FOR  
INFORMATION ONLY

5/20/2015 1:20:47 AM  
WORKSPACE: AHTD  
L:\2012\201590 - ContrailField Access\Drawings\6TH\_ST\6TH\_SP\_MNL\_05.DGN  
REVISED DATE:

DATE REVISED	DATE FILMED	DATE REVISED	DATE FILMED	FED. RD. DIST. NO.	STATE	FED. AID PROJ. NO.	SHEET NO.	TOTAL SHEETS
5-24-2016				6	ARK.		60	182

PERMANENT SIGNING PLANS

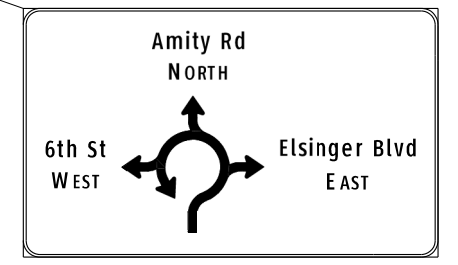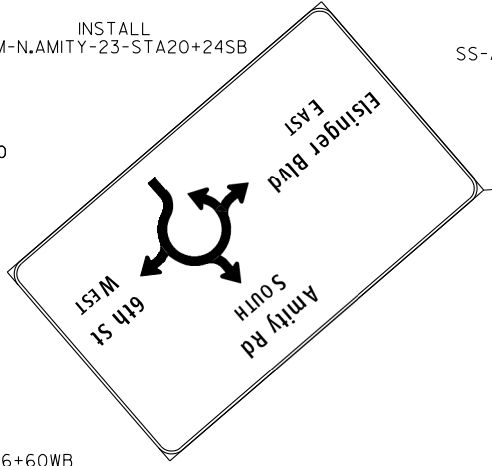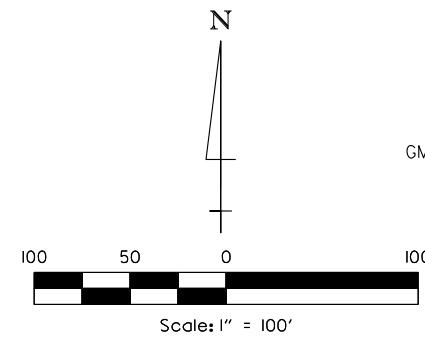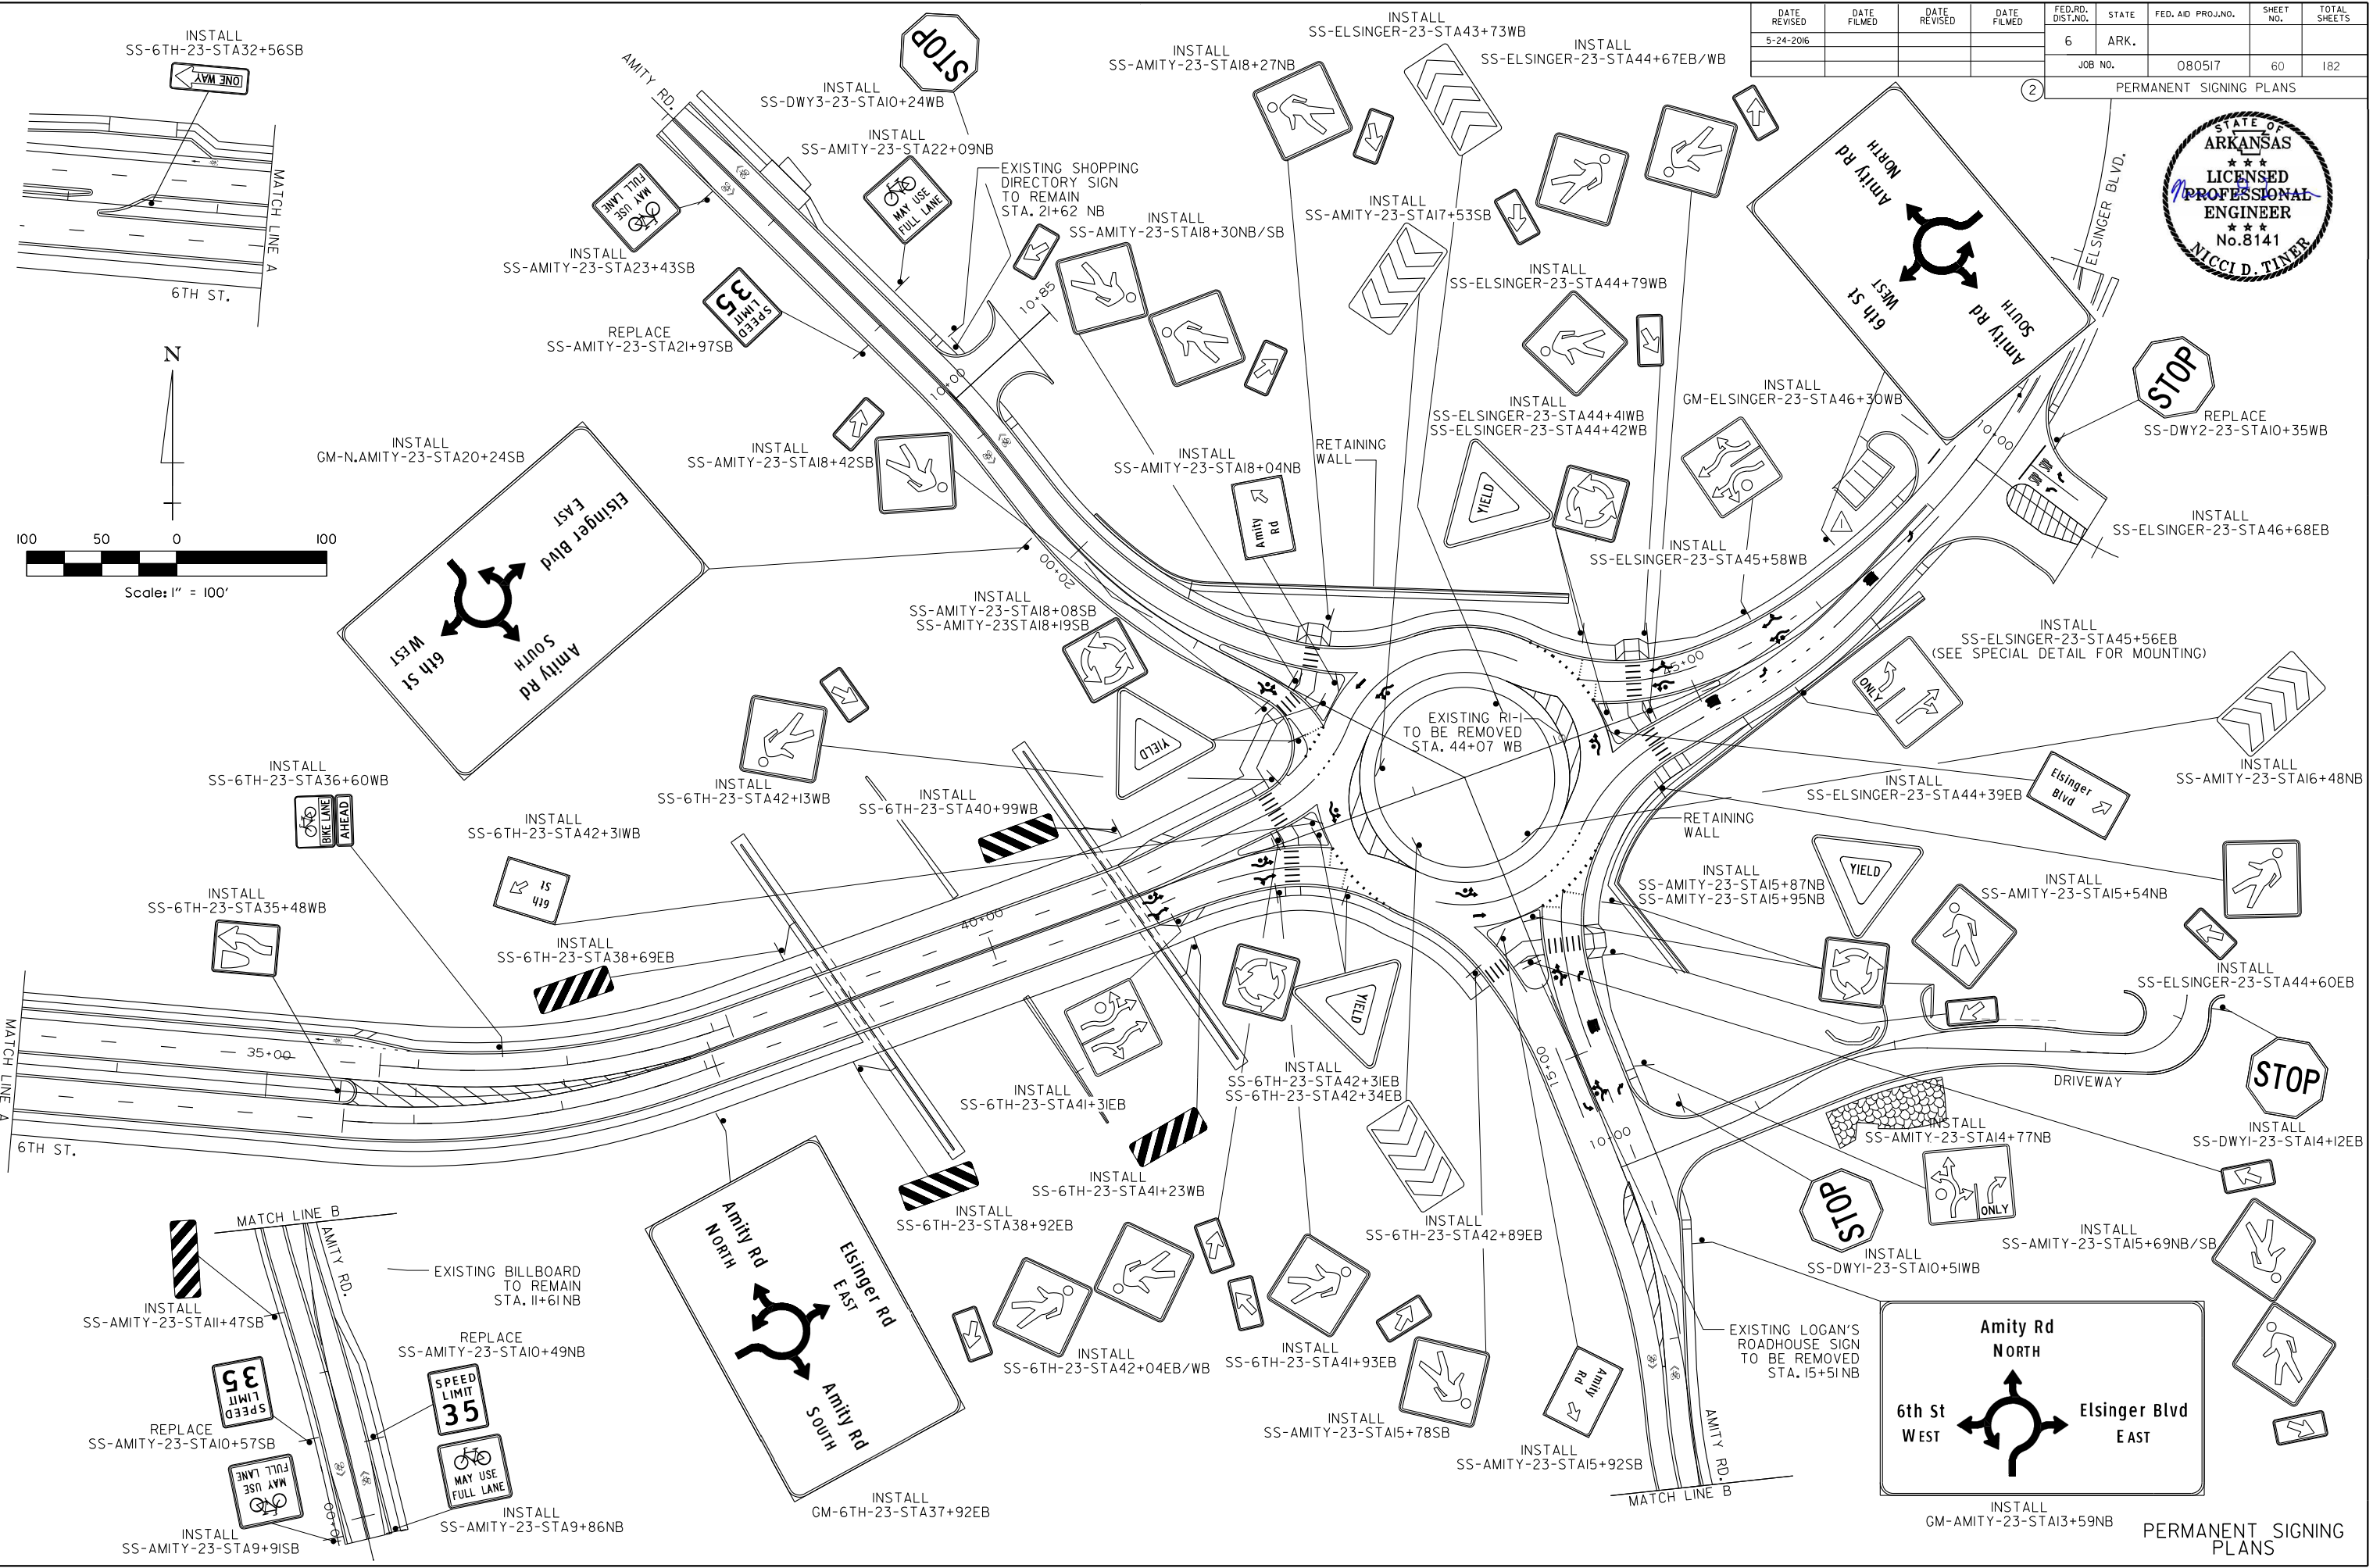

5/24/2016 2:04:00 PM  
 CEM/Kinney AHTD  
 WORKSPACE: AHTD  
 L:\2012\201550 - CentrailField Access\Drawings\6TH\_ST\6TH.SP.MNL.01.dgn  
 REVISED DATE:


PERMANENT SIGNING PLANS

DATE REVISED	DATE FILMED	DATE REVISED	DATE FILMED	FED. RD. DIST. NO.	STATE	FED. AID PROJ. NO.	SHEET NO.	TOTAL SHEETS
				6	ARK.			
						080517	61	182

2 PERMANENT SIGNING PLANS



Digitally Signed 05/20/2015

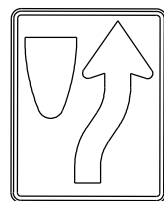


R4-7 (24"x30")  
SS-6TH-23-STA35+48WB



OM3-L (12"x36")  
SS-6TH-23-STA38+92EB  
SS-6TH-23-STA41+23WB



OM3-R (12"x36")  
SS-6TH-23-STA38+92EB  
SS-6TH-23-STA40+99WB  
SS-AMITY-23-STA11+47SB

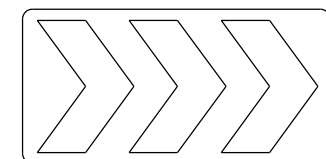


NOTE: THIS SIGN IS TO BE BLACK & WHITE  
R6-4a (48"x24")  
SS-6TH-23-STA42+89EB  
SS-AMITY-23-STA16+48NB  
SS-ELSINGER-23-STA43+73WB  
SS-AMITY-23-STA17+53SB

W16-7pR (24"x12")



W11-2 (36"x36")

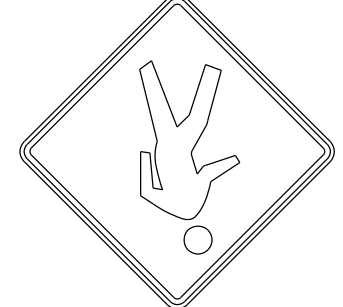

W11-2 (36"x36")




W16-7pR (24"x12")  
SS-6TH-23-STA42+04EB/WB  
SS-AMITY-23-STA15+69NB/SB  
SS-ELSINGER-23-STA44+67EB/WB  
SS-AMITY-23-STA18+30NB/SB




W11-2 (36"x36")



W16-7pL (24"x12")  
SS-6TH-23-STA42+13WB  
SS-6TH-23-STA41+93EB  
SS-AMITY-23-STA15+78SB  
SS-AMITY-23-STA15+54NB  
SS-ELSINGER-23-STA44+60EB  
SS-ELSINGER-23-STA44+79WB  
SS-AMITY-23-STA18+27NB  
SS-AMITY-23-STA18+42SB

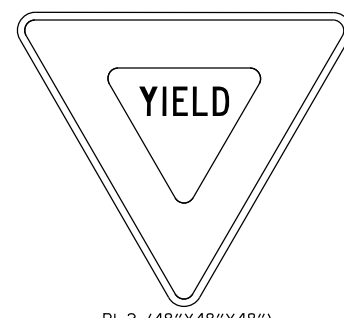


R1-2 (48"x48"x48")

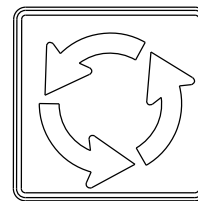


R6-5P (30"x30")  
SS-6TH-23-STA42+31EB  
SS-6TH-23-STA42+34EB  
SS-AMITY-23-STA15+87NB  
SS-AMITY-23-STA15+95NB  
SS-ELSINGER-23-STA44+41WB  
SS-ELSINGER-23-STA44+42WB  
SS-AMITY-23-STA18+08SB  
SS-AMITY-23-STA18+19SB



R2-1 (24"x30")  
SS-AMITY-23-STA21+97SB  
SS-AMITY-23-STA10+57SB  
SS-AMITY-23-STA10+49NB

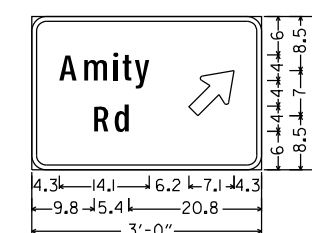


DI-2  
2.25" Radius, 0.75" Border, White on Green;  
[Amity] ClearviewHwy-2-W;  
[Rd] ClearviewHwy-2-W;  
Standard Arrow Custom 9.0" X 6.0" 45°;  
SS-AMITY-23-STA15+92SB  
SS-AMITY-23-STA18+04NB

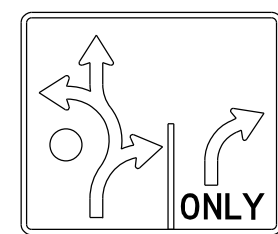


R3-8 (36"x36")  
SS-AMITY-23-STA14+77NB




R4-11 (30"x30")  
SS-AMITY-23-STA23+43SB  
SS-AMITY-23-STA22+09NB  
SS-AMITY-23-STA9+91SB  
SS-AMITY-23-STA9+86NB

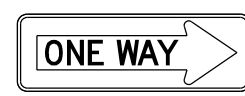


R6-1R (36"x12")  
SS-6TH-23-STA32+56SB

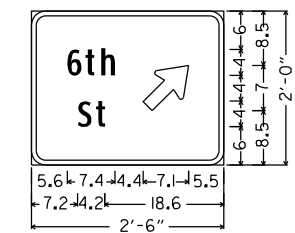

DI-2  
2.25" Radius, 0.75" Border, White on Green;  
[6th] ClearviewHwy-2-W;  
[St] ClearviewHwy-2-W;  
Standard Arrow Custom 9.0" X 6.0" 45°;  
SS-6TH-23-STA42+31WB

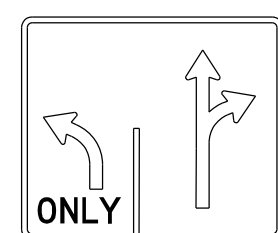

R3-8 (36"x36")  
SS-ELSINGER-23-STA45+56EB

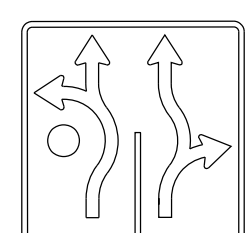

R3-8 (36"x36")  
SS-6TH-23-STA41+31EB  
SS-ELSINGER-23-STA45+58WB




R3-17 (24"x18")



R3-17aP (24"x8")  
SS-6TH-23-STA36+60WB




R1-1 (36"x36")  
SS-DWY1-23-STA10+51WB  
SS-DWY1-23-STA14+12EB  
SS-DWY2-23-STA10+35WB  
SS-DWY3-23-STA10+24WB

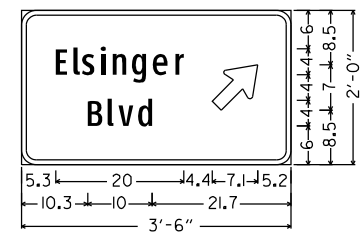


DI-2  
2.25" Radius, 0.75" Border, White on Green;  
[Elsinger] ClearviewHwy-2-W;  
[Blvd] ClearviewHwy-2-W;  
Standard Arrow Custom 9.0" X 6.0" 45°;  
SS-ELSINGER-23-STA44+39EB

DATE REVISED	DATE FILMED	DATE REVISED	DATE FILMED	FED. RD. DIST. NO.	STATE	FED. AID PROJ. NO.	SHEET NO.	TOTAL SHEETS
5-24-2016				6	ARK.			
				JOB NO.		080517	62	182
				PERMANENT SIGNING PLANS				


2

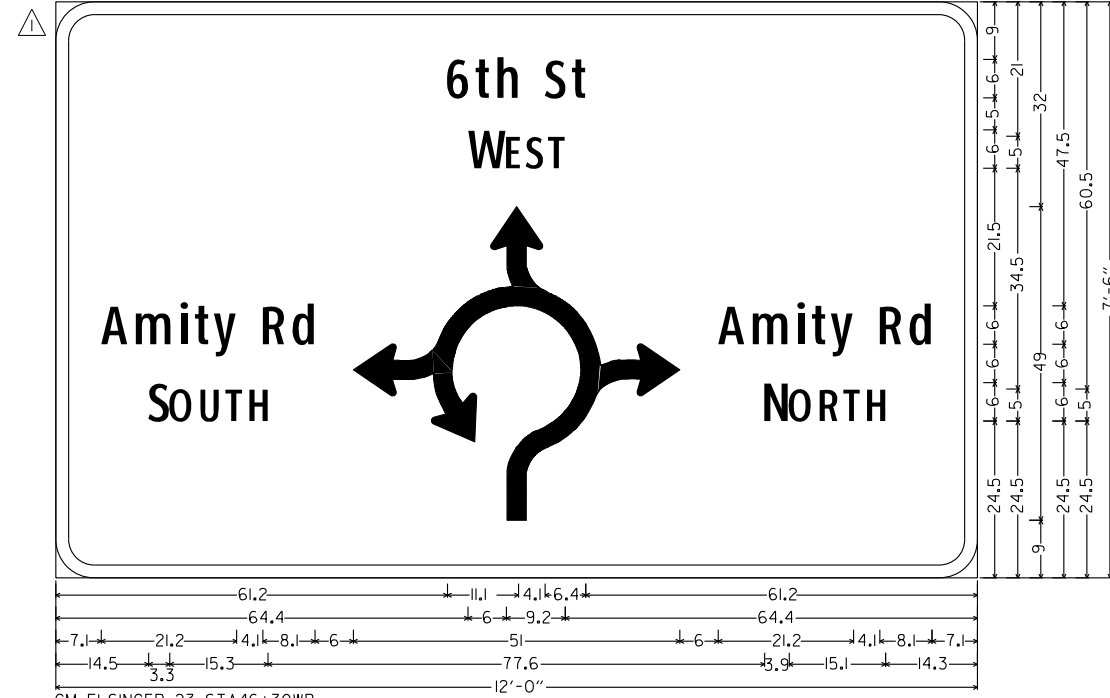


GM-ELSINGER-23-STA46+30WB  
 6.0" Radius, 2.0" Border, White on Green;  
 [6th St] ClearviewHwy-2-W;  
 [WEST] ClearviewHwy-2-W specified length;  
 [Amity Rd] ClearviewHwy-2-W;  
 [SOUTH] ClearviewHwy-2-W;  
 Circular Intersection DirectionalArrow.6" Text;  
 [Amity Rd] ClearviewHwy-2-W;  
 [NORTH] ClearviewHwy-2-W;

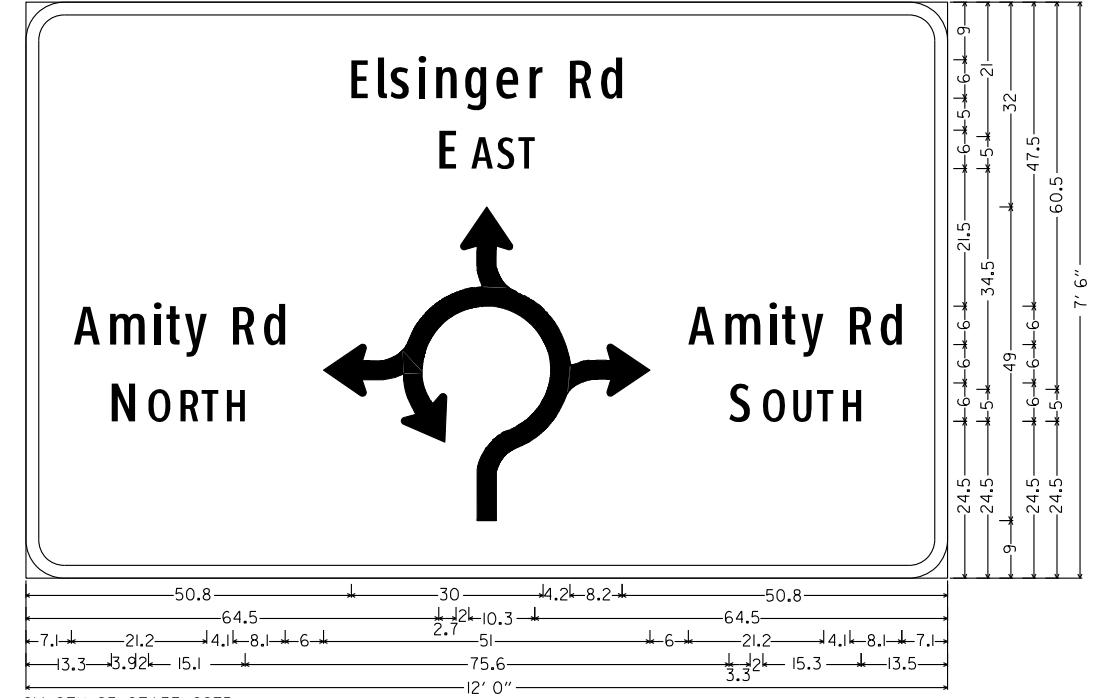

GM-6TH-23-STA37+92EB  
 6.0" Radius, 2.0" Border, White on Green;  
 [Elsinger Rd] ClearviewHwy-2-W;  
 [EAST] ClearviewHwy-2-W;  
 [Amity Rd] ClearviewHwy-2-W;  
 [NORTH] ClearviewHwy-2-W;  
 Circular Intersection DirectionalArrow.6" Text;  
 [Amity Rd] ClearviewHwy-2-W;  
 [SOUTH] ClearviewHwy-2-W;

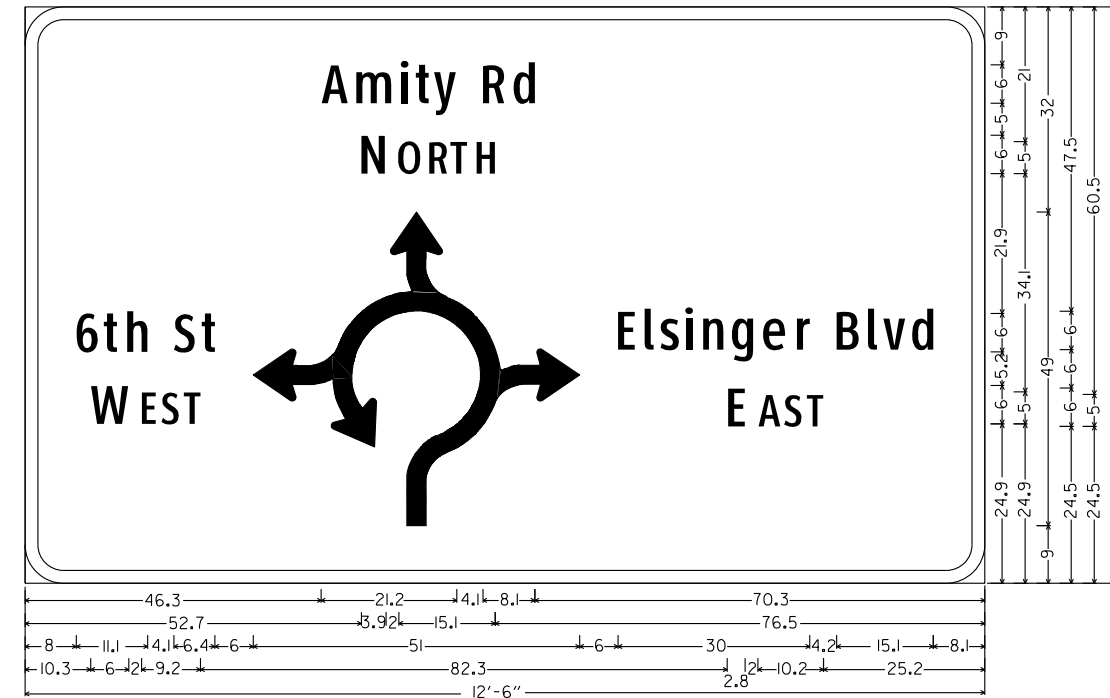

GM-AMITY-23-STA13+59NB  
 6.0" Radius, 2.0" Border, White on Green;  
 [Amity Rd] ClearviewHwy-2-W;  
 [NORTH] ClearviewHwy-2-W;  
 [6th St] ClearviewHwy-2-W;  
 [WEST] ClearviewHwy-2-W;  
 Circular Intersection DirectionalArrow.6" Text;  
 [Elsinger Blvd] ClearviewHwy-2-W;  
 [EAST] ClearviewHwy-2-W;

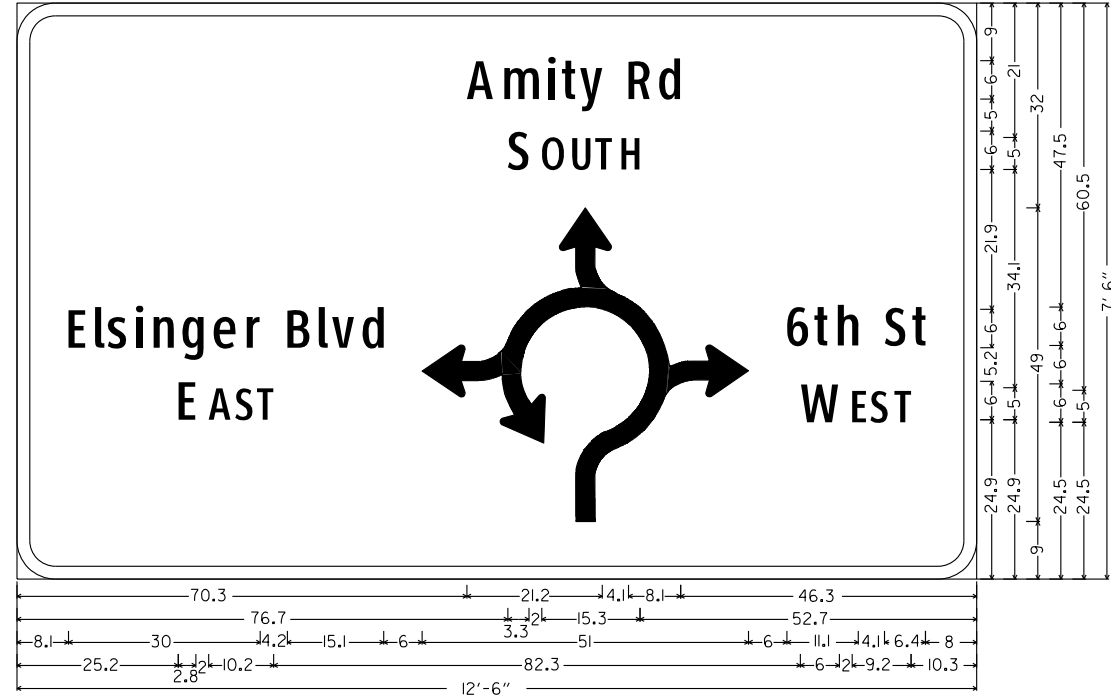

GM-AMITY-23-STA20+24SB  
 6.0" Radius, 2.0" Border, White on Green;  
 [Amity Rd] ClearviewHwy-2-W;  
 [SOUTH] ClearviewHwy-2-W;  
 [Elsinger Blvd] ClearviewHwy-2-W;  
 [EAST] ClearviewHwy-2-W;  
 Circular Intersection DirectionalArrow.6" Text;  
 [6th St] ClearviewHwy-2-W;  
 [WEST] ClearviewHwy-2-W;

5/24/2016 1:35:36 PM  
 CEMKinney AHTD  
 WORKSPACE: AHTD  
 L:\2012\201590 - Centrifield Access\Drawings\6TH\_ST\6TH.SP\_MNL\_03.dgn  
 REVISED DATE:

PERMANENT SIGNING PLANS

DATE REVISED	DATE FILMED	DATE REVISED	DATE FILMED	FED. ROAD DIST. NO.	STATE	FED. AID PROJ. NO.	SHEET NO.	TOTAL SHEETS
6-1-15				6	ARK.			
				JOB NO.		080517	63	182
				① 07345		QUANTITIES		57062

SUMMARY OF ESTIMATED QUANTITIES FOR JOB 080517							
BRIDGE NO. CODE NO. NAME PLATE TITLE	UNIT OF STRUCTURE	ITEM NO.	SP-2	SP-4	SP-5	SP-6	
		ITEM	BRIDGE CONSTRUCTION ①	STEEL PILING (HP12x53) ②	DRILLED SHAFT (78" DIA.)	CROSSHOLE SONIC LOGGING (78" DIA.)	CORING DRILLED SHAFT
		UNIT	LUMP SUM	LINEAR FOOT	LINEAR FOOT	EACH	LINEAR FOOT
07345 X771 INTERSTATE 40	BENT NO. 1			481			
	BENT NO. 2				112	4	
	BENT NO. 3			442		40	
	212'-0" CONT. COMP. PLATE GIRDER UNIT	1					
	TOTALS FOR JOB NO. 08517	1	923	112	4	40	


- ① For estimated quantities to be included in the Lump Sum Bid for the item "BRIDGE CONSTRUCTION", see Table below.
- ② Steel piles are required to be Grade 50 and have special points which will not be paid for directly but shall be considered subsidiary to the item "STEEL PILING (HP12x53)". Any preboring required for the installation of the piles shall also be considered subsidiary to the item "STEEL PILING (HP12x53)".

③ ITEM "BRIDGE CONSTRUCTION"																			
BRIDGE NO. CODE NO. NAME PLATE TITLE	UNIT OF STRUCTURE	ITEM NO.	801	802	802	803	804	804	806	806	807	SP-8 & 807	808	809	812	816	SP-3	SP-7	SP-12
		ITEM	UNCLASSIFIED EXCAVATION FOR STRUCTURES-BRIDGE	CLASS S CONCRETE - BRIDGE	CLASS (S/AE) CONCRETE - BRIDGE	CLASS I PROTECTIVE SURFACE TREATMENT	REINFORCING STEEL-BRIDGE (GRADE 60)	EPOXY COATED REINFORCING STEEL (GRADE 60)	METAL BRIDGE RAILING (TYPE H2)	TRANSITIONAL APPROACH RAILING	STRUCTURAL STEEL IN PLATE GIRDER SPANS (M270-GR. 50)	* PAINTING STRUCTURAL STEEL	ELASTOMERIC BEARINGS	SILICONE JOINT SEALANT	BRIDGE NAME PLATE (TYPE D)	CONCRETE RIPRAP	TEXTURED COATING FINISH	ARCHITECTURAL FINISH	BRIDGE LIGHTING
		UNIT	CUBIC YARD	CUBIC YARD	CUBIC YARD	GALLON	POUND	POUND	LINEAR FOOT	EACH	POUND	TON	CUBIC INCH	LINEAR FOOT	EACH	CUBIC YARD	SQUARE YARD	SQUARE YARD	LUMP SUM
07345 X771 INTERSTATE 40	BENT NO. 1			95.16		0.2	11,332		16.0	2	1,421	0.7	5400.0	83		7	61.2	6.0	
	BENT NO. 2	92.0		220.64		0.2	44,216	44,856	16.0	2	1,421	0.7	7313.0			7	388.1	44.0	
	BENT NO. 3			96.00		0.2	11,332		16.0	2	1,421	0.7	5400.0	83		7	61.2	6.0	
	212'-0" CONT. COMP. PLATE GIRDER UNIT				719.60	37.1		154,810	394.0		540,438	270.2			1		526.5	106.0	1
	TOTALS FOR JOB NO. 08517	92.0	411.80	719.60	37.5		<del>66,880</del> 67,520	154,810	426.0	4	543,280	271.6	18,113.0	166	1	14	1,037.0	162.0	1

\* Paint shall conform to Federal Standard 595B, Color Chip No. 27038, Black.

- ③ The Summary of Estimated Bridge Quantities is provided for informational purposes only. This Summary is to be used only as a comparison to the Contractor's independent material take-off. The Contractor may not rely upon or make any claim against the Owner or the Engineer with respect to the accuracy of the estimated Bridge Quantities. The Contractor will remain solely responsible for the estimation of the materials necessary to complete the project.

△ Revised reinforcing steel in Bent No. 2, DRG 6-1-15. Checked by JHR

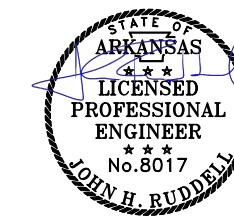

Digitally Signed 06/01/2015  
BRIDGE ENGINEER

SCHEDULE OF BRIDGE QUANTITIES  
I-40/6TH ST. OVERPASS  
(CONWAY) (S)  
FAULKNER COUNTY  
ROUTE SEC.  
ARKANSAS STATE HIGHWAY COMMISSION  
LITTLE ROCK, ARK.

DRAWN BY: DRG DATE: MAR. 2015 FILENAME: B080517\_0.dgn  
CHECKED BY: JHR DATE: MAY 2015 SCALE: No Scale  
DESIGNED BY: DRG DATE: MAR. 2015  
BRIDGE NO. 07345 DRAWING NO. 57062

DATE REVISED	DATE FILMED	DATE REVISED	DATE FILMED	FED. ROAD DIST. NO.	STATE	FED. AID PROJ. NO.	SHEET NO.	TOTAL SHEETS
				6	ARK.	080517	64	182
				07345	LAYOUT	57063		

**GENERAL NOTES**

BENCH MARK: PN: 4, PD: 9/8" Rebar With 2" Cap, ST: 39+36.75 OF: 36.35' RT. ZC: 298.242

CONSTRUCTION SPECIFICATIONS: Arkansas State Highway and Transportation Department Standard Specifications For Highway Construction (2014 Edition) with applicable Supplemental Specifications and Special Provisions. Unless otherwise noted in the plans, Section and Subsection refer to the Standard Construction Specifications.

DESIGN SPECIFICATIONS: AASHTO LRFD Bridge Design Specifications 6th Edition (2012).

LIVE LOADING: HL93

SEISMIC PERFORMANCE ZONE: I  $S_D = 0.093$  SITE CLASS: B

OPERATIONAL IMPORTANCE CATEGORY: TYPICAL

MATERIALS AND STRENGTHS:  
 Class S(AE) - Bridge Concrete (Superstructure)  $f'_c = 4,000$  psi  
 Class S - Bridge Concrete (Substructure)  $f'_c = 3,500$  psi  
 Reinforcing Steel (AASHTO M31 Or M322, Type A Gr. 60)  $f_y = 60,000$  psi  
 Structural Steel (AASHTO M270, Gr. 50)  $F_y = 50,000$  psi  
 Structural Steel (AASHTO M270, Gr. 36)  $F_y = 36,000$  psi

FORM INSERT: State of Arkansas form insert shall be used on MSE walls (4 Locations). See Dwg. No. 57066.

PAINT: All structural steel except galvanized members, some surfaces in contact with concrete and as otherwise noted, shall be painted as specified in Subsection 807.75. The color of the paint shall be Black and shall match Federal Standard 595B, Color Chip No. 27038.

BORING LOGS: Boring logs may be obtained from the Engineer/Owner.

STEEL PILING: All Piling shall be HPI2x53 (Grade 50) and shall be driven with an approved air, steam or diesel hammer to a minimum safe bearing capacity of 95 tons. Drive all piles to a minimum penetration of 10' below leveling pad. Lengths of piling shown are for estimating quantities and for use in determining payment for cut-off and build-up in accordance with Section 805. Actual lengths are to be determined in the field. The Contractor shall use approved steel H-pile driving points.

The Contractor may drive the piling in Bents 1 and 3 in one of the following sequences:

Piling may be driven after excavation to bottom of leveling pad is complete, after any required preboring and prior to backfilling.

Piling may be driven after embankment construction. Pile casings shall be used for all piling and shall be installed prior to or during embankment construction extending from bottom of leveling pad to bottom of cap. Pile casing material shall have sufficient strength to retain its original form free from harmful distortions after compaction of the fill material surrounding it. The minimum inside diameter of the casing shall be 18". Piles shall be driven through the open casings after embankment to bottom of cap is in place. After driving is completed, the pile casing shall be backfilled with an approved non-shrink grout or other approved material in a single continuous operation to completely fill voids. Pile casings and backfill will not be paid for directly but shall be considered subsidiary to the item "STEEL PILING (HPI2x53)".

PREBORING: Preboring will be required at Bents 1 & 3 to obtain the minimum pile penetration requirements. Preboring shall take place after excavation to the top of leveling pad is complete. The size and depth of preboring will be determined by the Engineer. Preboring will be measured from bottom of leveling pad. The Contractor shall be responsible for keeping the prebored holes free from debris prior to backfilling which may require the use of temporary casings or other methods. After driving is completed, the prebored hole shall be backfilled with Class S Concrete to the top of rock and the remaining length of prebored holes shall be backfilled with an approved non-shrink grout, or other approved material to completely fill voids. The cost of preboring, temporary casings and backfill will be included in the item "STEEL PILING (HPI2x53)".

DRILLED SHAFTS: All drilled shafts shall be founded a minimum of 13'-0" into moderately hard to hard dark gray shale as in the boring legend. No adjustment in plan tip elevation shall be made without prior approval from the Engineer. Methods of construction of the drilled shafts shall be in accordance with SP "DRILLED SHAFT FOUNDATIONS".

BRIDGE DECK: The concrete bridge deck shall be given a fine finish as specified for final finishing in Subsection 802.19 for Class 5 Tined Bridge Roadway Surface Finish. Sidewalk shall be given a broomed finish as specified for Class 6 Broomed Finish.

CLASS I PROTECTIVE SURFACE TREATMENT: Class I Protective Surface Treatment shall be applied to the roadway surface, face of curb and sidewalk surface.

TEXTURED COATING FINISH: Class 3 Textured Coating Finish shall be applied to all areas as specified in SP "TEXTURED COATING FINISH" and in accordance with Subsection 802.19(b)(3). Texture Coating Finish shall not be applied on surfaces where Class I Protective Surface Treatment is applied.


FOR R/W DATA, SEE ROADWAY PLANS

SHEET 1 OF 4  
 LAYOUT OF BRIDGE OVER I-40  
 I-40/6TH ST. OVERPASS  
 (CONWAY) (S)  
 FAULKNER COUNTY  
 ROUTE SEC.  
 ARKANSAS STATE HIGHWAY COMMISSION  
 LITTLE ROCK, ARK.



Digitally Signed 05/19/2015  
 BRIDGE ENGINEER

DRAWN BY: HEW DATE: SEPT. 2014 FILENAME: B080517\_LL.dgn  
 CHECKED BY: DRG DATE: MAR. 2015 SCALE: 1" = 20'  
 DESIGNED BY: SRY DATE: SEPT. 2014  
 BRIDGE NO. 07345 DRAWING NO. 57063

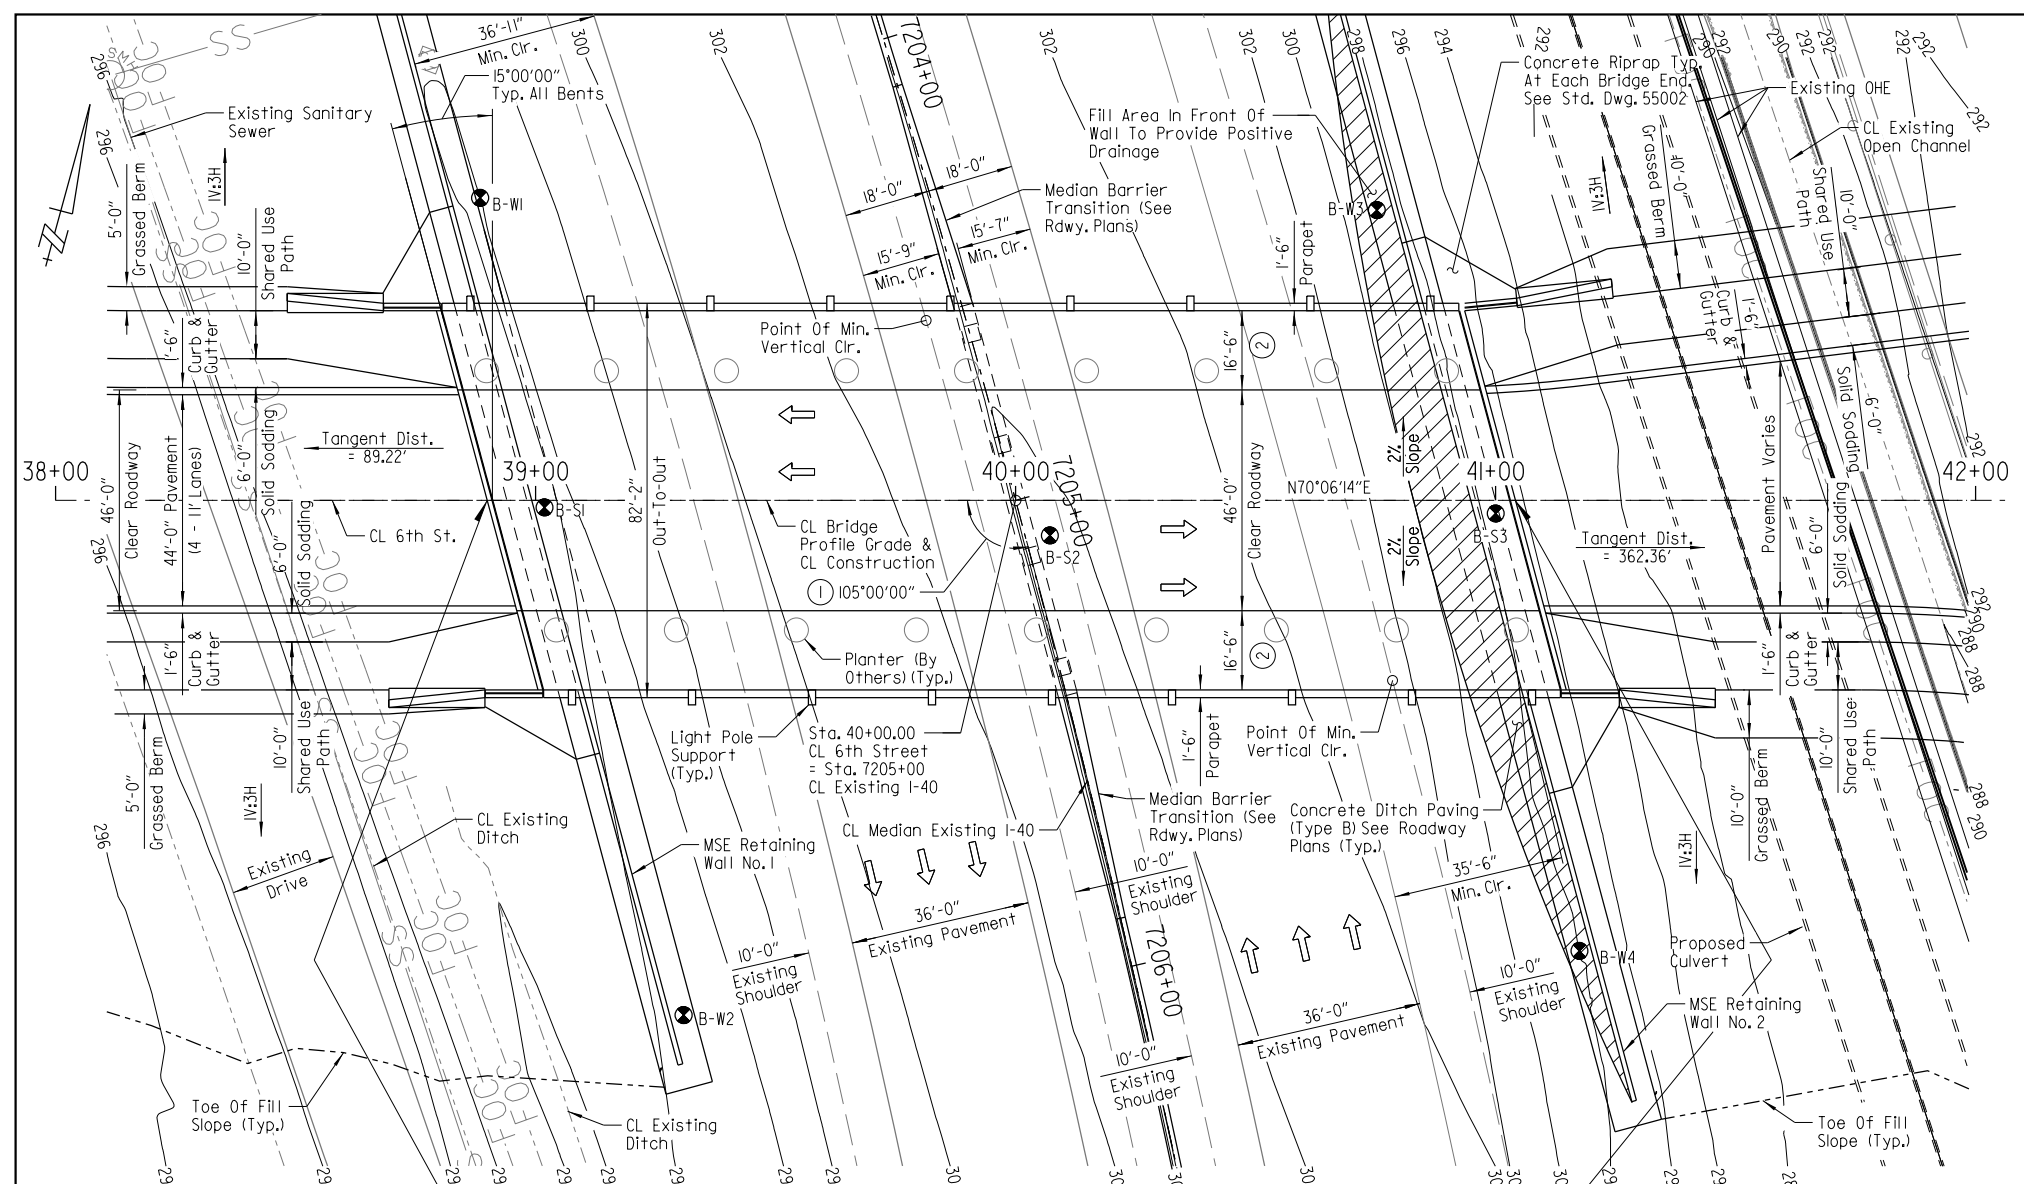


**HORIZONTAL CURVE DATA**

I-40  
 PI = 7220+17.86  
 $\Delta = 63^\circ 03' 24.6''$  Rt.  
 D = 02°00'00"  
 T = 1757.50'  
 L = 3152.84'  
 e = NA  
 R = 2864.79'

**VERTICAL CURVE DATA**

6th Street  
 (Profile Grade Along CL Bridge)  
 +6.00%  
 -7.00%

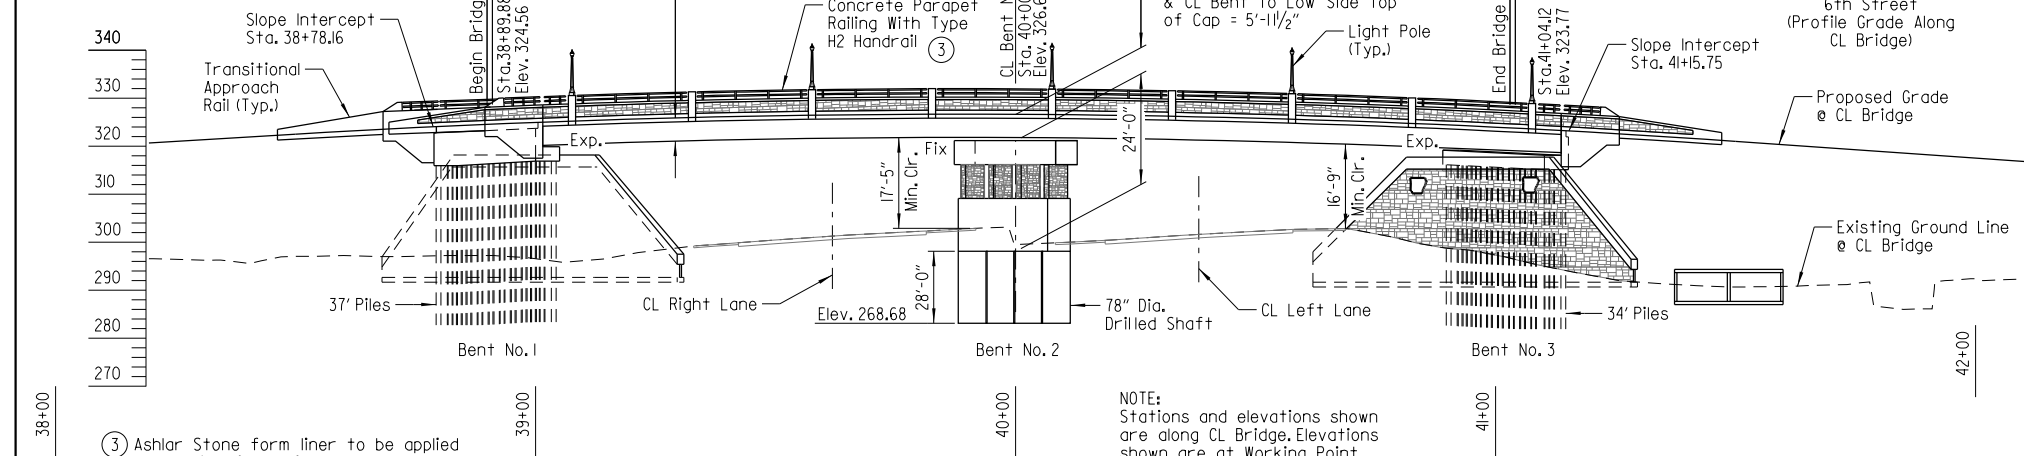

**LEGEND**

SS = Sanitary Sewer  
 OHE = Overhead Electric  
 FOC = Fiber Optic Line

**ELEVATION**

NOTE:  
 Stations and elevations shown are along CL Bridge. Elevations shown are at Working Point.


DETAIL DRAWINGS:  
 End Bents  
 Intermediate Bent  
 212' Cont. Comp. Plate Girder Unit  
 Elastomeric Bearings  
 Concrete Riprap  
 Steel Piling

DRAWING NO:  
 57070-57073  
 57075-57077  
 57078-57088  
 57089  
 55002  
 55020


5/19/2015 1:27:16 PM  
 WORKSPACE: AHTD Bridge  
 L:\2012\201590 - ConrailField Access\Drawings\6TH\_ST\B080517\_LL.dgn  
 REVISED DATE:



DATE REVISED	DATE FILMED	DATE REVISED	DATE FILMED	FED. ROAD DIST. NO.	STATE	FED. AID PROJ. NO.	SHEET NO.	TOTAL SHEETS
				6	ARK.			
				JOB NO.		080517	65	182
				07345	LAYOUT			57064

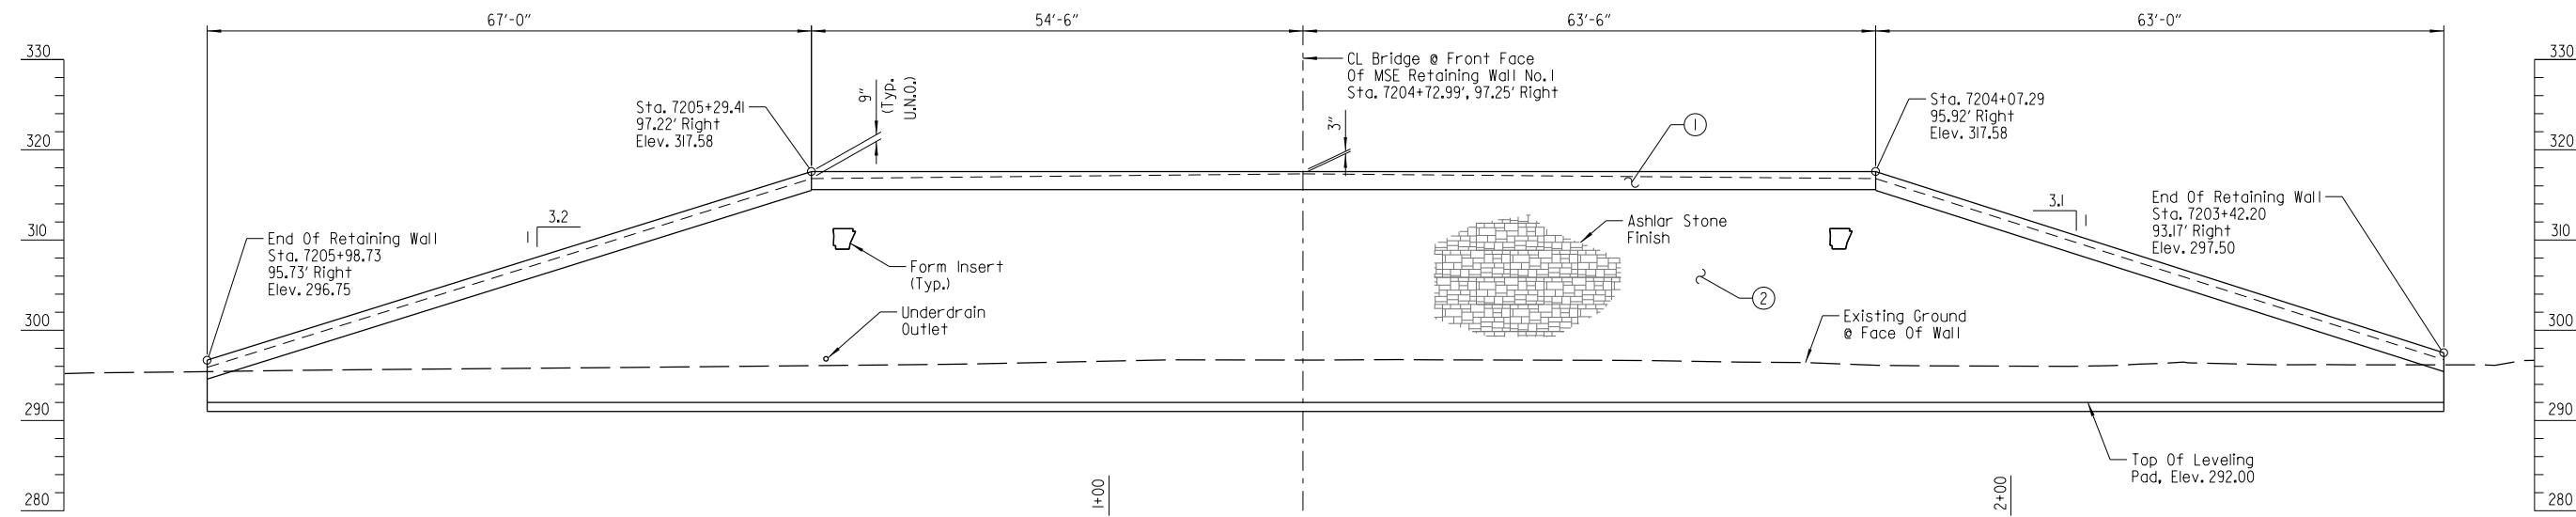

**ELEVATION - MSE RETAINING WALL NO. 1**  
(Looking At Front Face of Wall)  
Scale: NTS

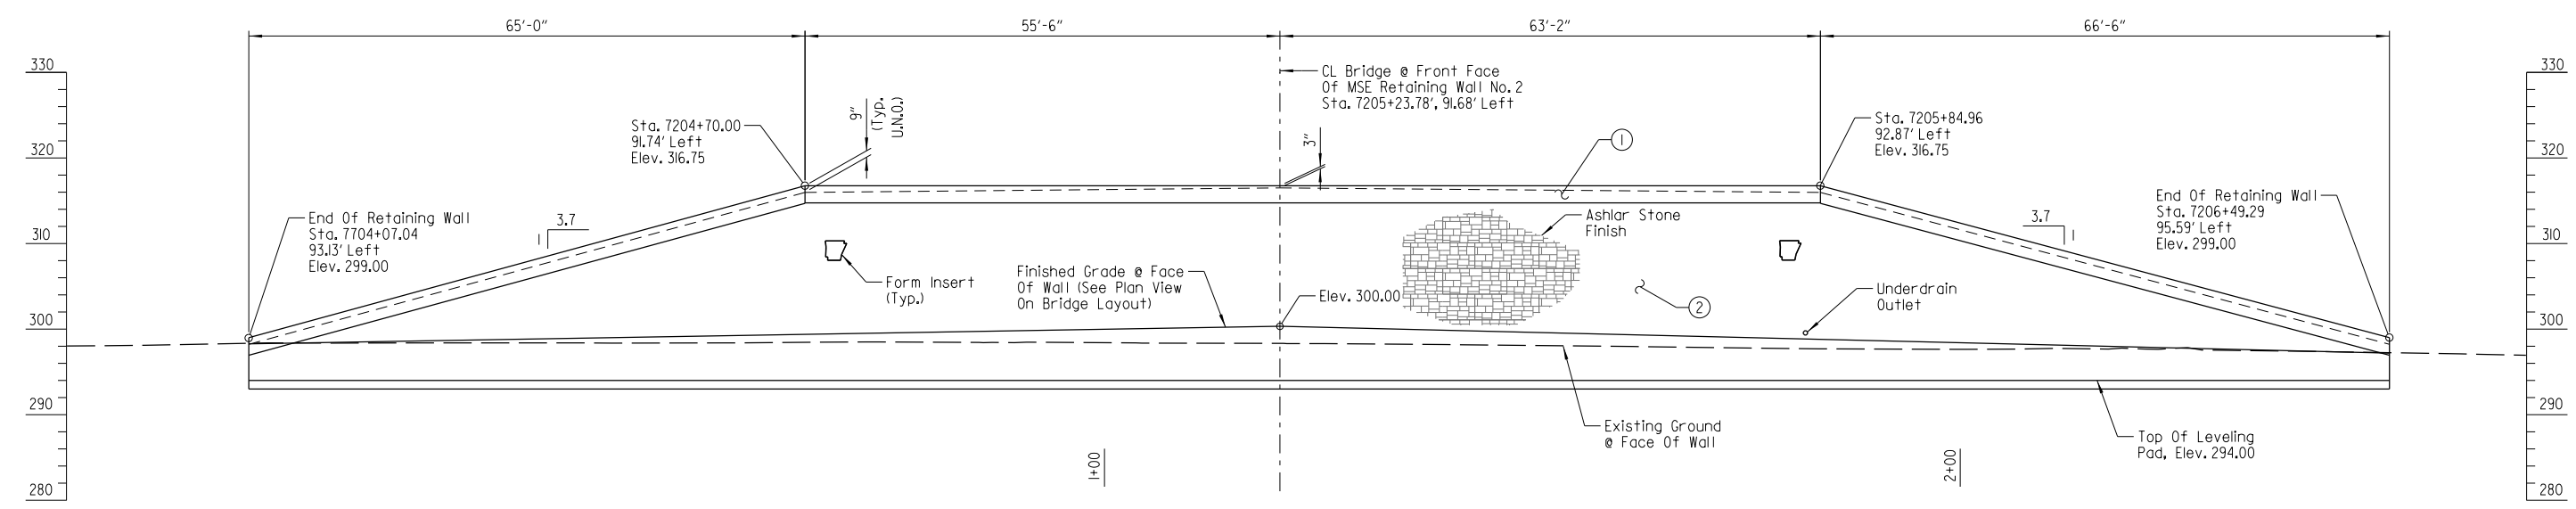


**ELEVATION - MSE RETAINING WALL NO. 2**  
(Looking At Front Face of Wall)  
Scale: NTS

NOTES:  
For "SECTION A-A" & "SECTION B-B", see Dwg. No. 57065.  
Stationing shown is along CL Median I-40 U.N.O.  
Offset dimensions are measured from CL Median I-40 to outside vertical face of MSE Retaining Wall.  
For "FORM INSERT DETAILS", see Dwg. No. 57066.  
Underdrain outlet shall penetrate front face of MSE Retaining Wall.  
For "GENERAL NOTES", see Dwg. No. 57065.

**LEGEND**  
U.N.O. = Unless Noted Otherwise

- ① Class 3 Textured Coating Finish  
(Color = Brown, Color Chip No. 33522)
- ② "Ashlar Stone" Pattern & Class 3 Textured Coating Finish  
(Color = Brown, Color Chip No. 30219)

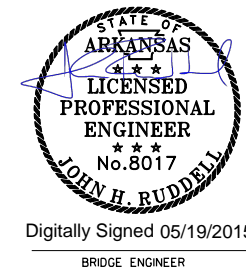

Digitally Signed 05/19/2015  
BRIDGE ENGINEER






SHEET 2 OF 4  
LAYOUT OF BRIDGE OVER I-40  
I-40/6TH ST. OVERPASS  
(CONWAY) (S)  
FAULKNER COUNTY  
ROUTE SEC.  
ARKANSAS STATE HIGHWAY COMMISSION  
LITTLE ROCK, ARK.  
DRAWN BY: HEW DATE: SEPT. 2014 FILENAME: B080517.L2.dgn  
CHECKED BY: DRG DATE: MAR. 2015 SCALE: As Shown  
DESIGNED BY: SRY DATE: SEPT. 2014  
BRIDGE NO. 07345 DRAWING NO. 57064

D:\ROAD 5/19/2015 1:27:17 PM  
 WORKSPACE: AHTD Bridge  
 L:\2012\201590 - Centrell\field Access\Drawings\6TH ST.\B080517.L2.dgn  
 REVISED DATE:

DATE REVISED	DATE FILMED	DATE REVISED	DATE FILMED	FED. ROAD DIST. NO.	STATE	FED. AID PROJ. NO.	SHEET NO.	TOTAL SHEETS
				6	ARK.	080517	66	182
				07345	LAYOUT			57065



**GENERAL NOTES:**  
DESIGN SPECIFICATIONS: AASHTO LRFD Bridge Design Specifications 6th Edition (2012) with Current Interim Revisions  
SEISMIC PERFORMANCE ZONE: I SDI = 0.093 SITE CLASS: B  
4" pipe underdrain shall maintain a minimum slope of 1/8" per foot toward nearest outlet.  
Elevations are approximate. Wall dimensions may vary depending on wall design selected.  
Placement of reinforcing straps for retaining walls may be affected by end bent construction. See Dwg. Nos. 57070-57073 for pile locations and wingwall details.  
For ditch paving, see Standard Dwg. No. CDP-1.  
See SP "RETAINING WALLS" for additional information.  
Boring logs, including laboratory results, may be obtained from Programs and Contracts Division.  
Joint filler, joint sealer, polystyrene foam board and rodent screen will not be paid for directly but will be considered subsidiary to SP "RETAINING WALLS".  
A Class 3 Textured Coating Finish shall be applied to surfaces as specified in SP "TEXTURED COATING FINISH" and in accordance with Subsection 802.19.

- ① Excavation required for reinforcing zone, leveling pad and placement of SM-I material will be paid for under the pay item "UNCLASSIFIED EXCAVATION". See SP "RETAINING WALLS".
- ② The concrete ditch paving shall be constructed without the 3" weep holes shown on Standard Dwg. CDP-1.
- ③ Varies From 3" To 9", See ELEVATIONS.
- ④ 1/2" Joint Filler (AASHTO M53, Type 1 Per Subsection 501.02(h)(1)) With 1/2" x 1" Type 3 or 4 Joint Sealer Per Subsection 501.02(h)(2)
- ⑤ For MSE Wall Nos. 1 & 2, SM-I material shall be placed as undercut backfill. Excavation and backfill material for the undercut area shall be paid for under the pay item "MSE WALL UNDERCUT AND BACKFILL". See SP "RETAINING WALLS" for details.
- ⑥ Depth of undercut varies from 1' to 9' as directed by the Engineer.

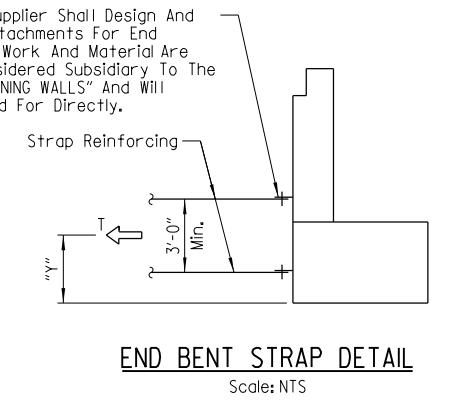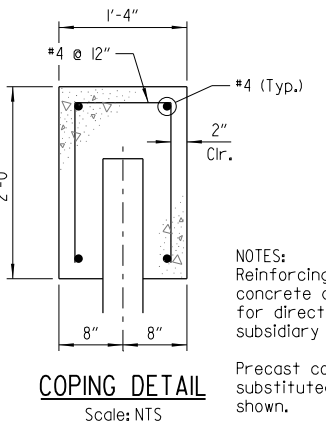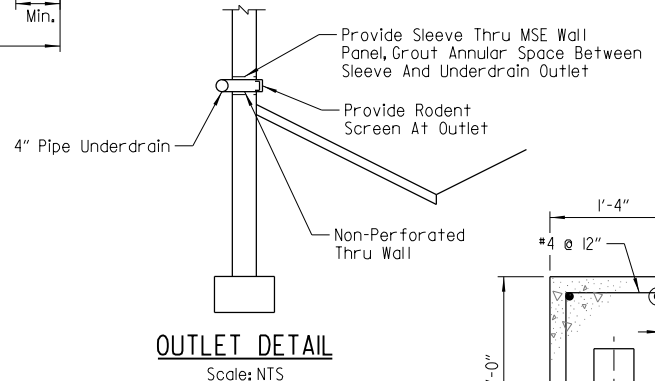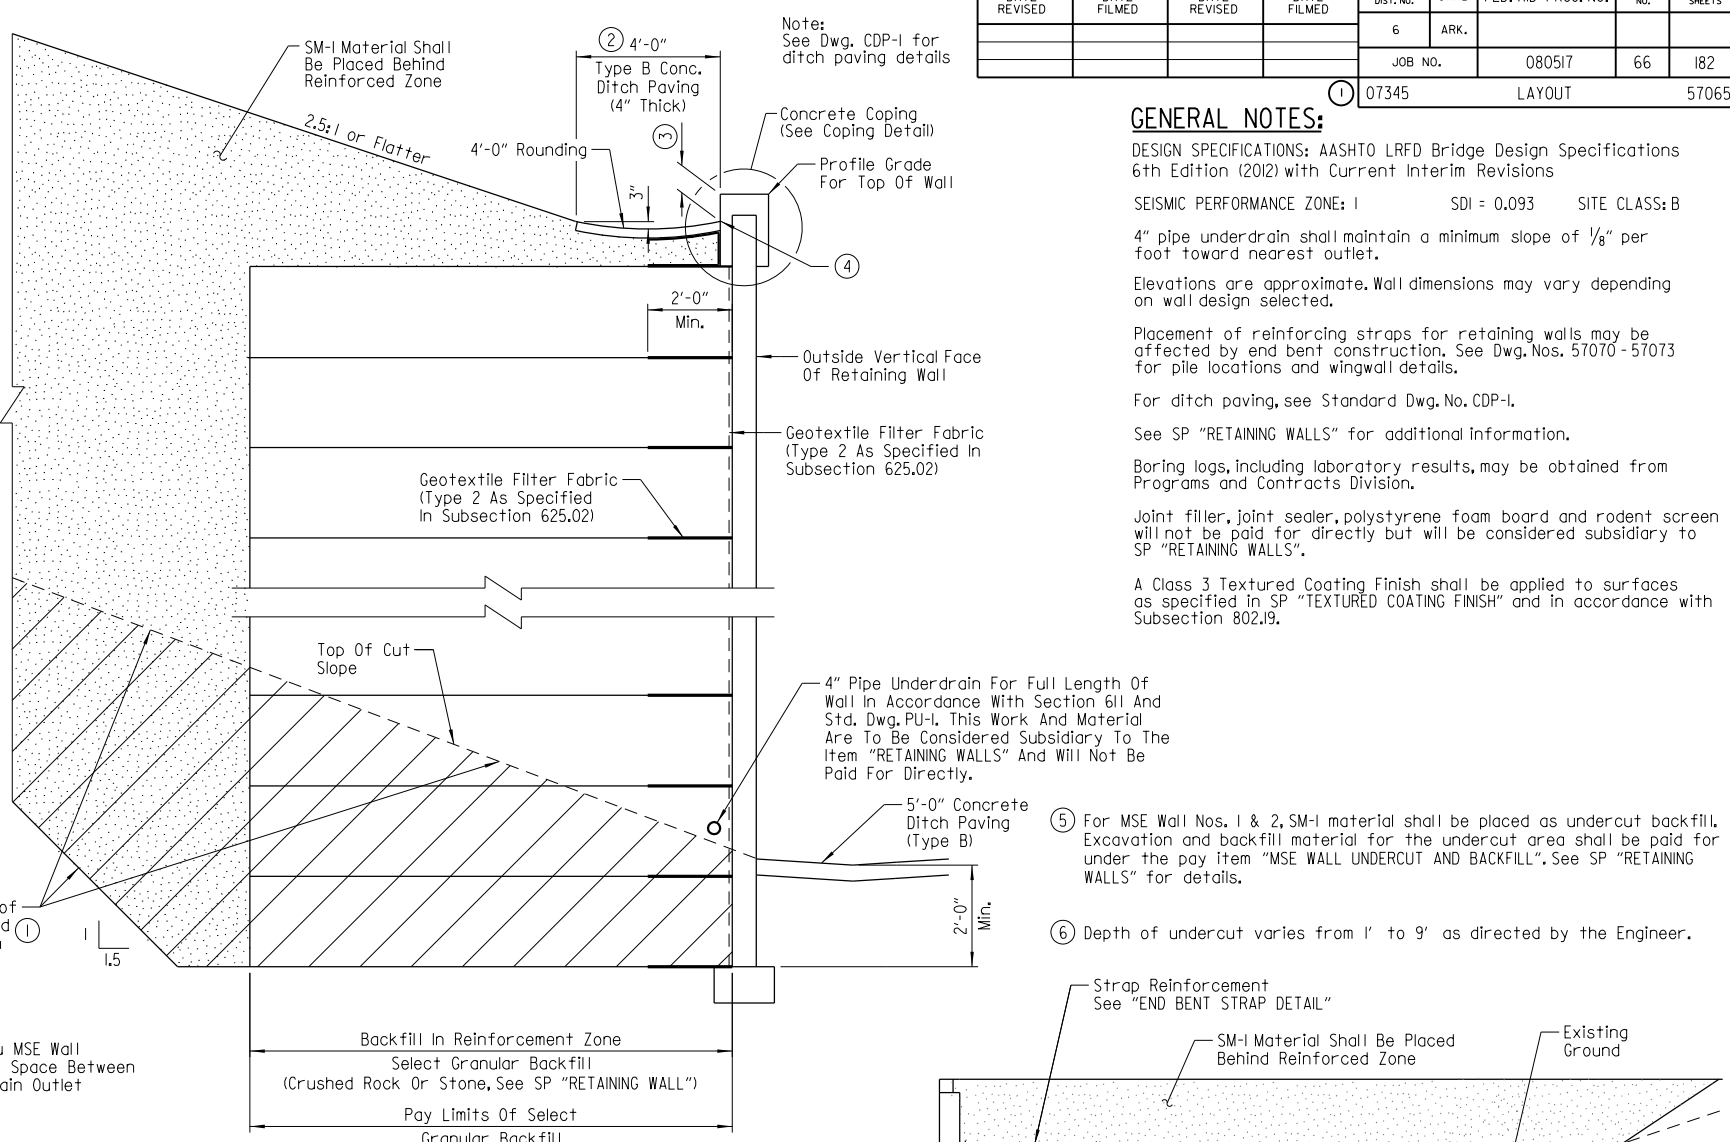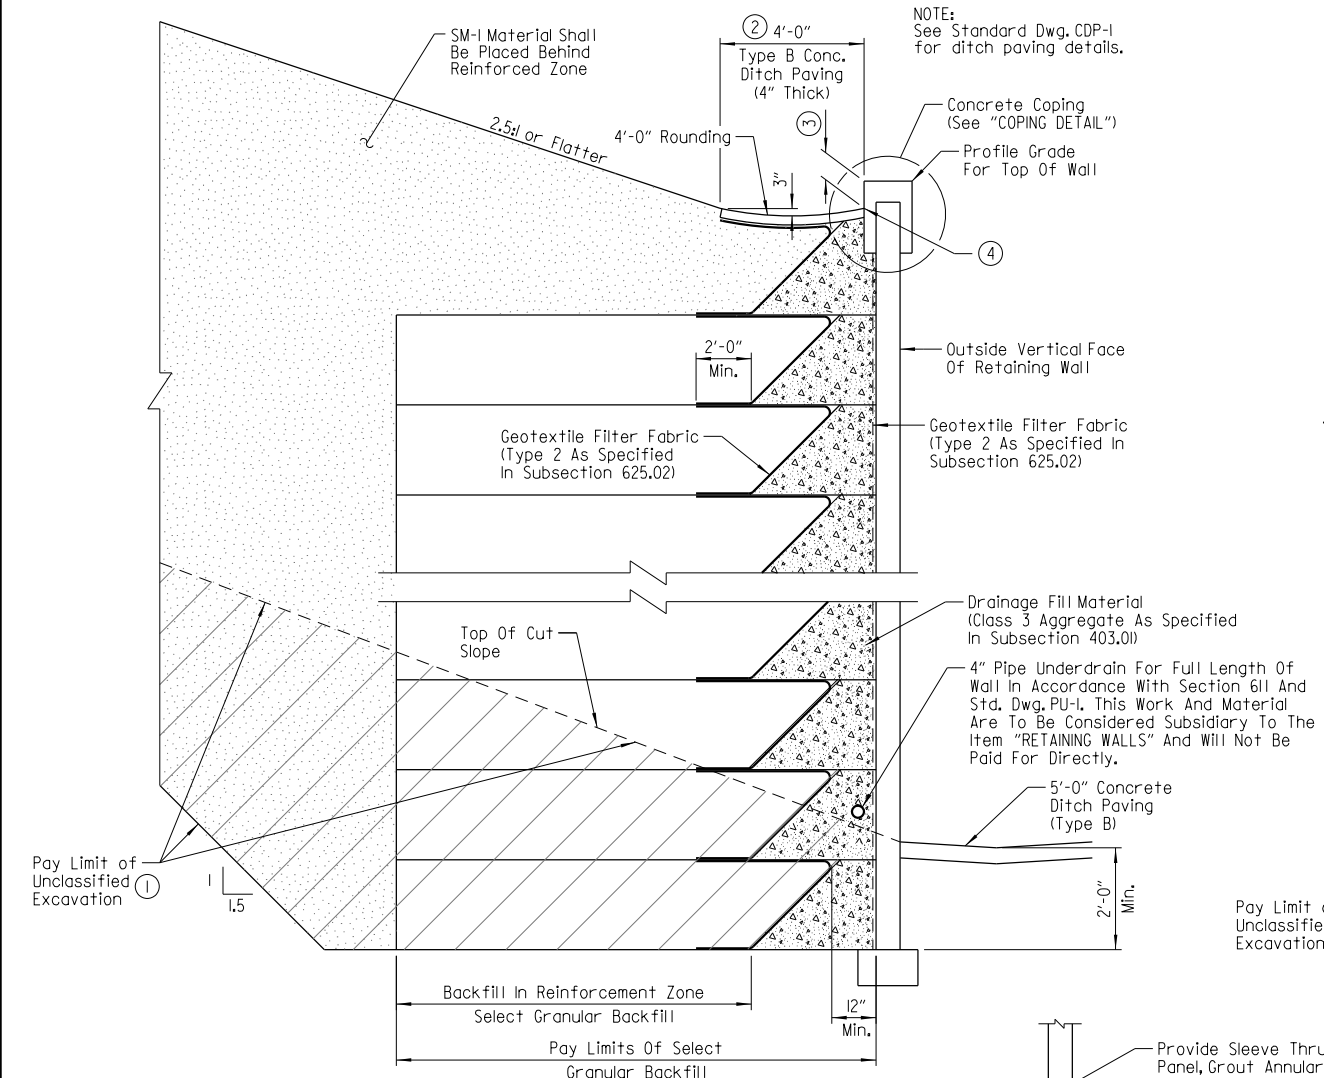

T = Resultant Force Required To Be Resisted By Strap Reinforcing  
Y = Centroid Of Strap Reinforcing

LIMIT STATE	T	Y
Service	3.9	3.0
Strength	6.2	

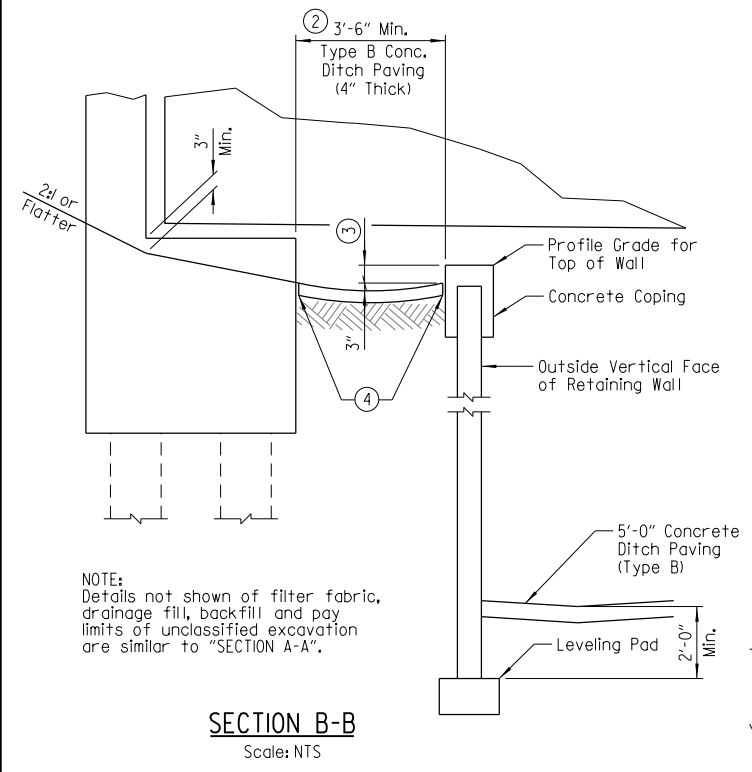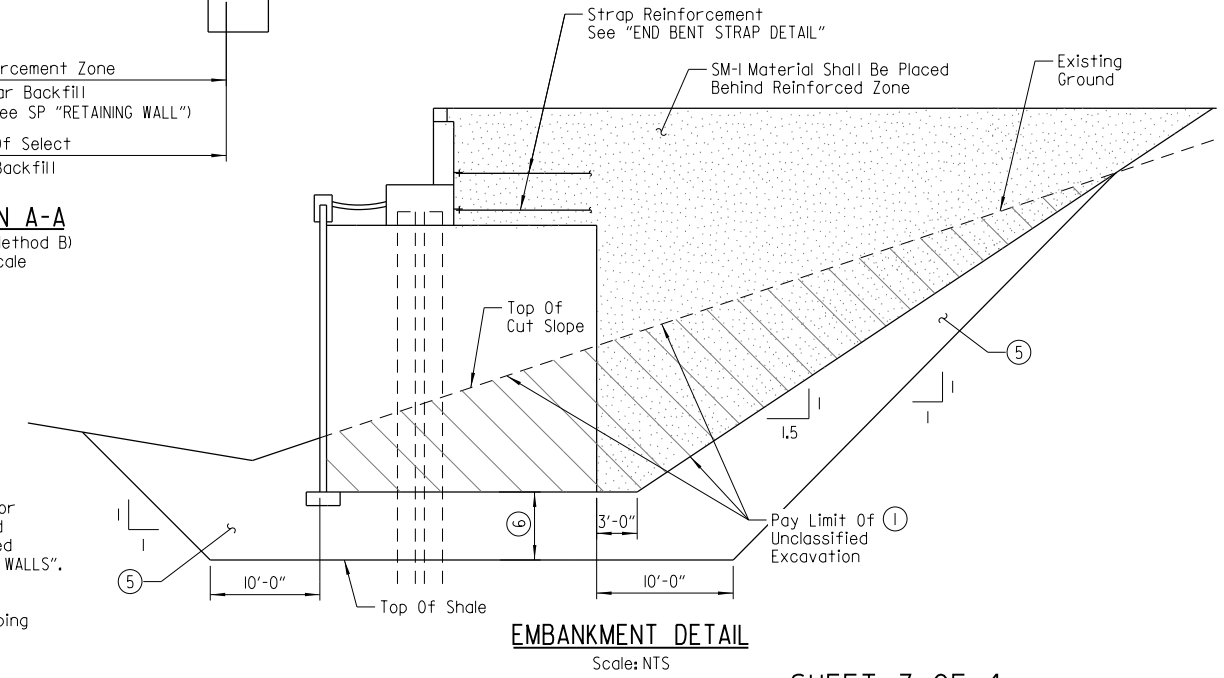


STATE OF ARKANSAS  
**LICENSED PROFESSIONAL ENGINEER**  
No. 8017  
**JOHN H. RUELLE**  
Digitally Signed 05/19/2015  
BRIDGE ENGINEER

SHEET 3 OF 4  
LAYOUT OF BRIDGE OVER I-40  
I-40/6TH ST. OVERPASS  
(CONWAY) (S)  
FAULKNER COUNTY  
ROUTE SEC.  
ARKANSAS STATE HIGHWAY COMMISSION  
LITTLE ROCK, ARK.  
DRAWN BY: DRG DATE: MAR. 2015 FILENAME: B080517\_L3.dgn  
CHECKED BY: SRY DATE: MAY 2015 SCALE: As Shown  
DESIGNED BY: DRG DATE: MAR. 2015  
BRIDGE NO. 07345 DRAWING NO. 57065


DRG04D 5/19/2015 1:27:18 PM  
WORKSPACE: AHTD Bridge  
L:\2012\201590 - Centrefield Access\Drawings\6TH\_ST\B080517\_L3.dgn  
REVISED DATE:

DATE REVISED	DATE FILMED	DATE REVISED	DATE FILMED	FED. ROAD DIST. NO.	STATE	FED. AID PROJ. NO.	SHEET NO.	TOTAL SHEETS
				6	ARK.			
				JOB NO.		080517	67	182
				① 07345	LAYOUT			57066

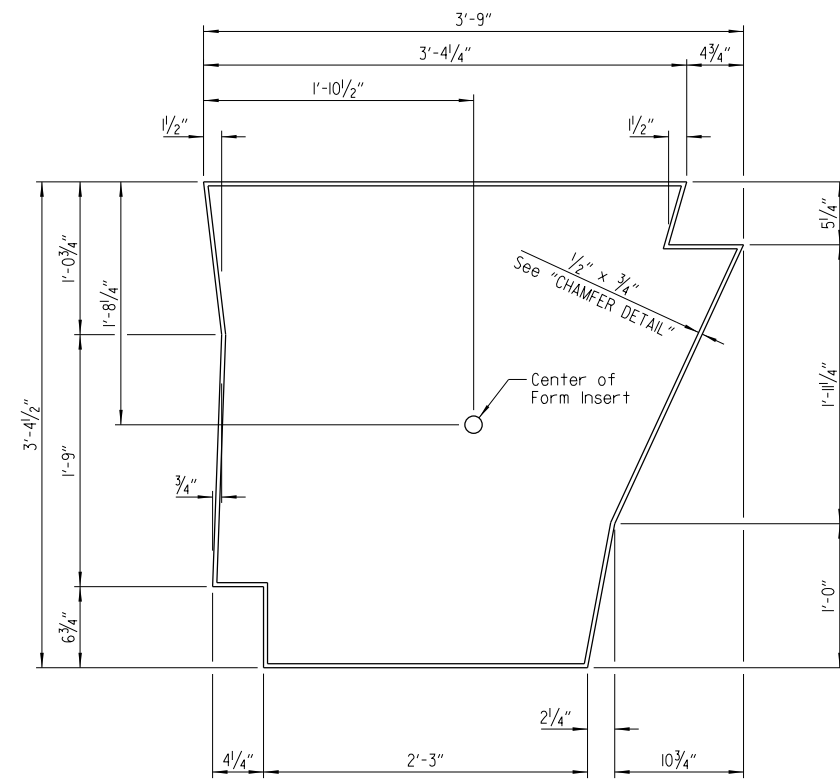


NOTE:  
Use form insert on designated walls  
as noted on Dwg. No. 57064.

**FORM INSERT DETAILS AT MSE WALL**  
Scale: 1/2" = 1'-0"

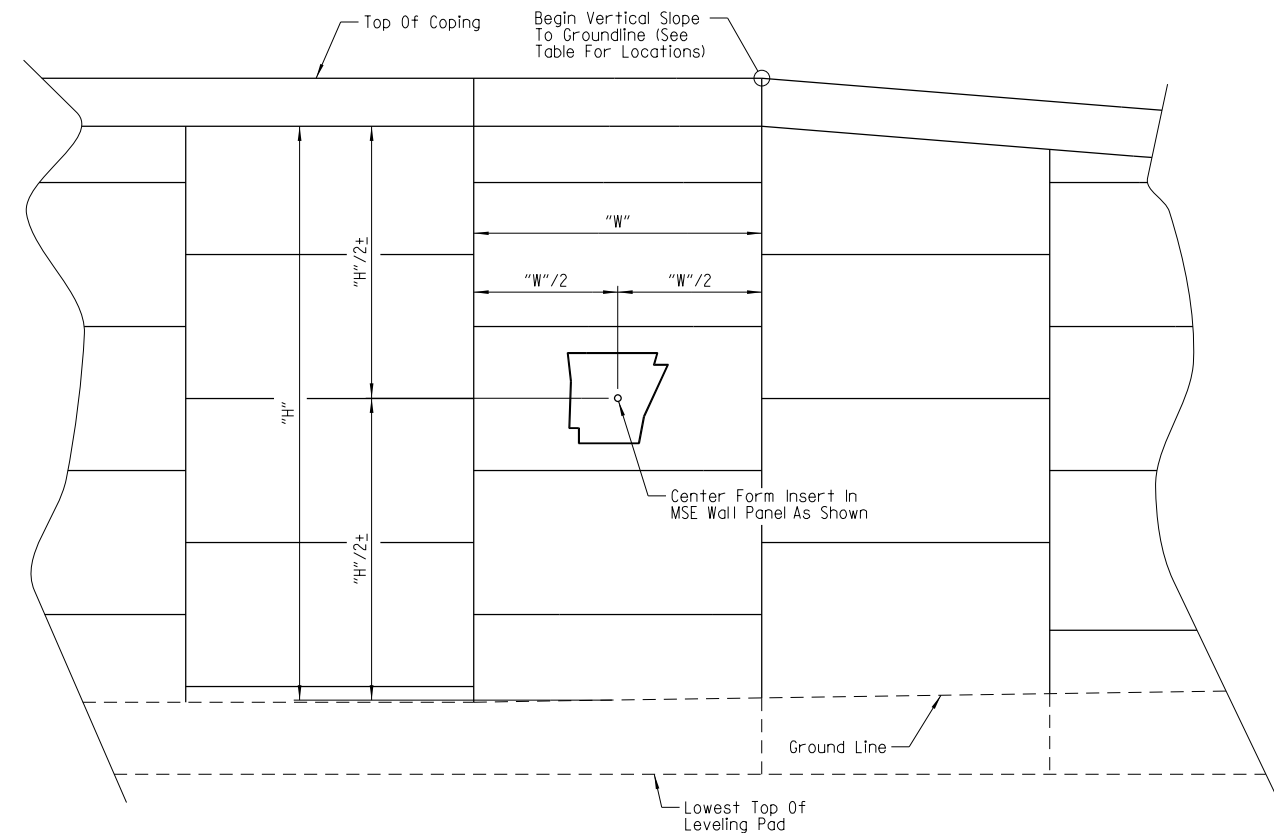

**DEVELOPED ELEVATION AT MSE WALL**  
Scale: NTS

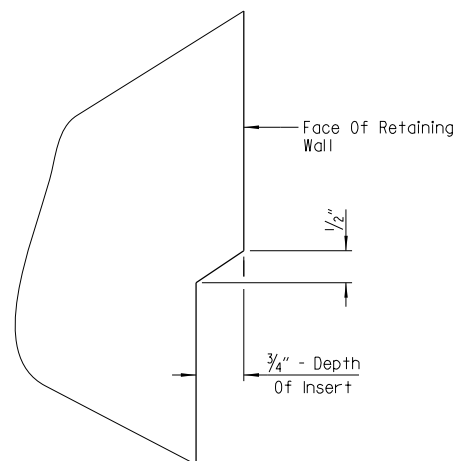

**CHAMFER DETAIL**  
Scale: NTS

NOTES:  
Fabricate form insert as a one piece unit, without the use of splices, joints or glue.

Wash and clean multi-use form inserts before each use.

All work and materials for inserts shall be included in the unit price bid for the item "RETAINING WALLS".


Damaged or worn form inserts shall be replaced at the Contractor's expense.

The form shall be approved by the Engineer before its use.

Recessed image (including chamfers) of State of Arkansas insert shall be given a Class 3 Textured Coating Finish as specified in SP "TEXTURED COATING FINISH."

LOCATION OF FORM INSERT	
Location	Station ①
Retaining Wall 1	7205+29.41 And 7204+07.29
Retaining Wall 2	7204+70.00 And 7205+84.96

① Stations shown are along CL Median I-40.



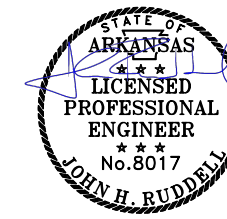


Digitally Signed 05/19/2015  
BRIDGE ENGINEER


SHEET 4 OF 4  
LAYOUT OF BRIDGE OVER I-40  
I-40/6TH ST. OVERPASS  
(CONWAY) (S)  
FAULKNER COUNTY  
ROUTE SEC.  
ARKANSAS STATE HIGHWAY COMMISSION  
LITTLE ROCK, ARK.

DRAWN BY: DRG DATE: MAR. 2015 FILENAME: B080517\_L4.dgn  
CHECKED BY: SRY DATE: MAY 2015 SCALE: As Shown  
DESIGNED BY: DRG DATE: MAR. 2015  
BRIDGE NO. 07345 DRAWING NO. 57066

DATE REVISED	DATE FILMED	DATE REVISED	DATE FILMED	FED. ROAD DIST. NO.	STATE	FED. AID PROJ. NO.	SHEET NO.	TOTAL SHEETS
				6	ARK.			
				JOB NO.		080517	68	182
				07345	BORING LOGS			57067

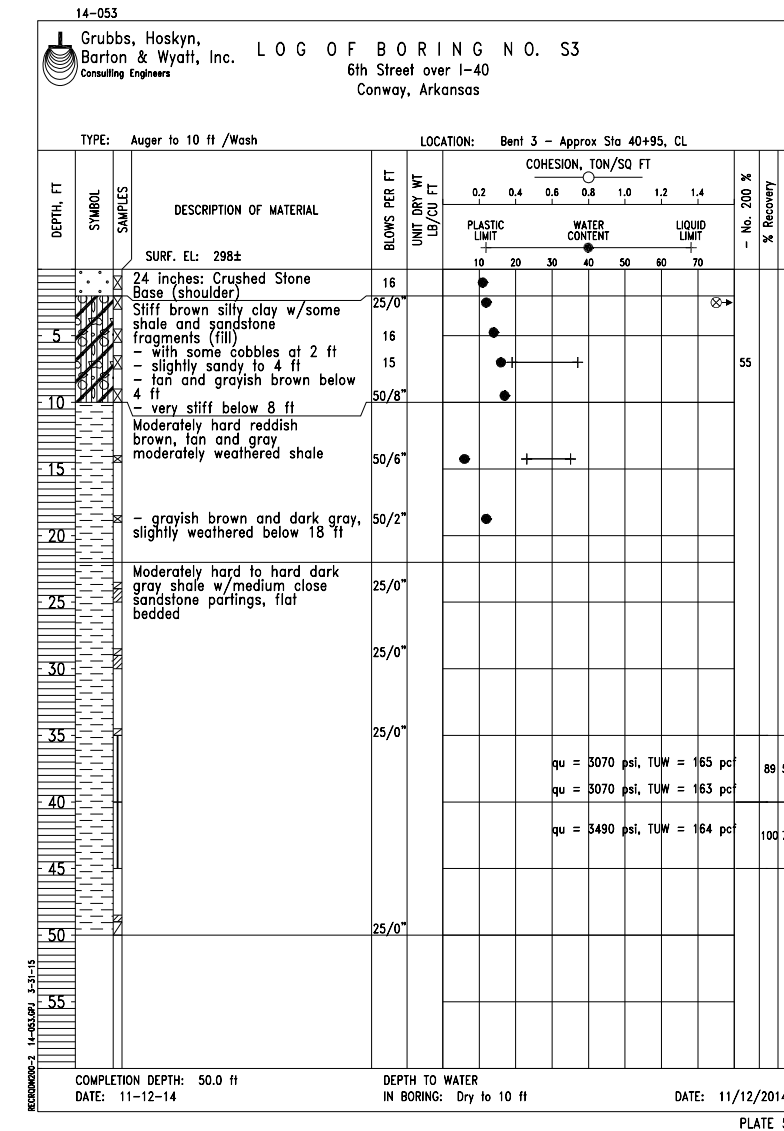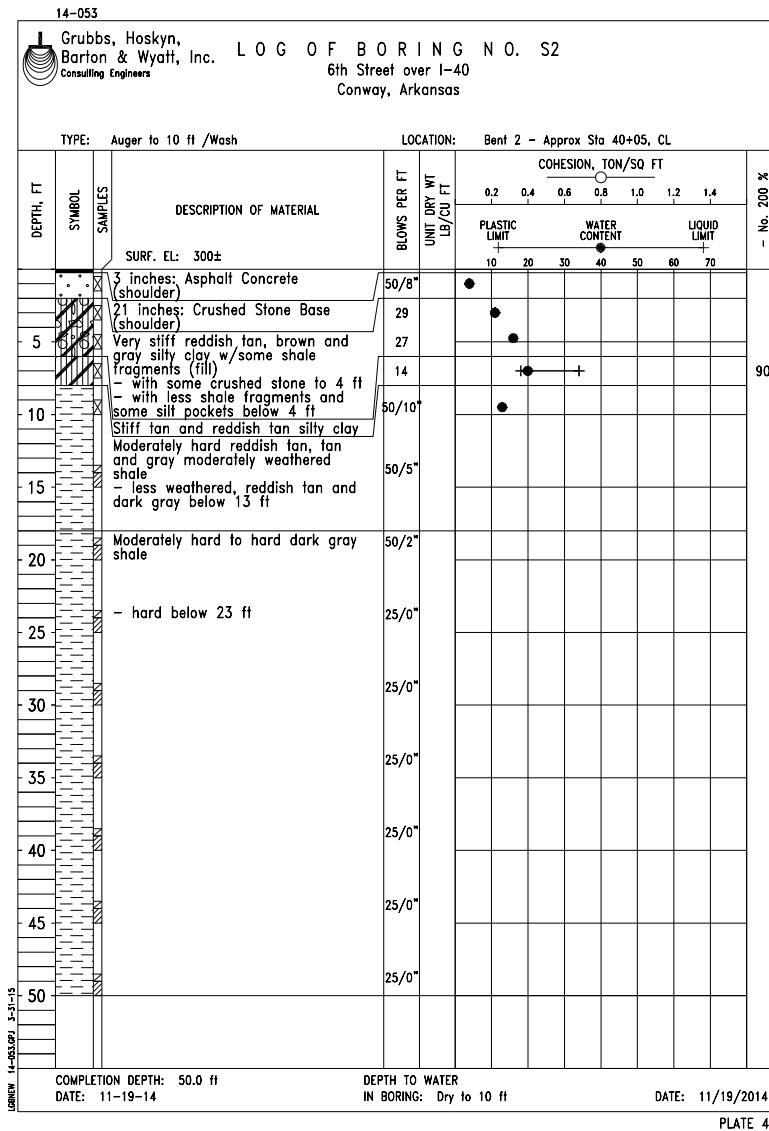
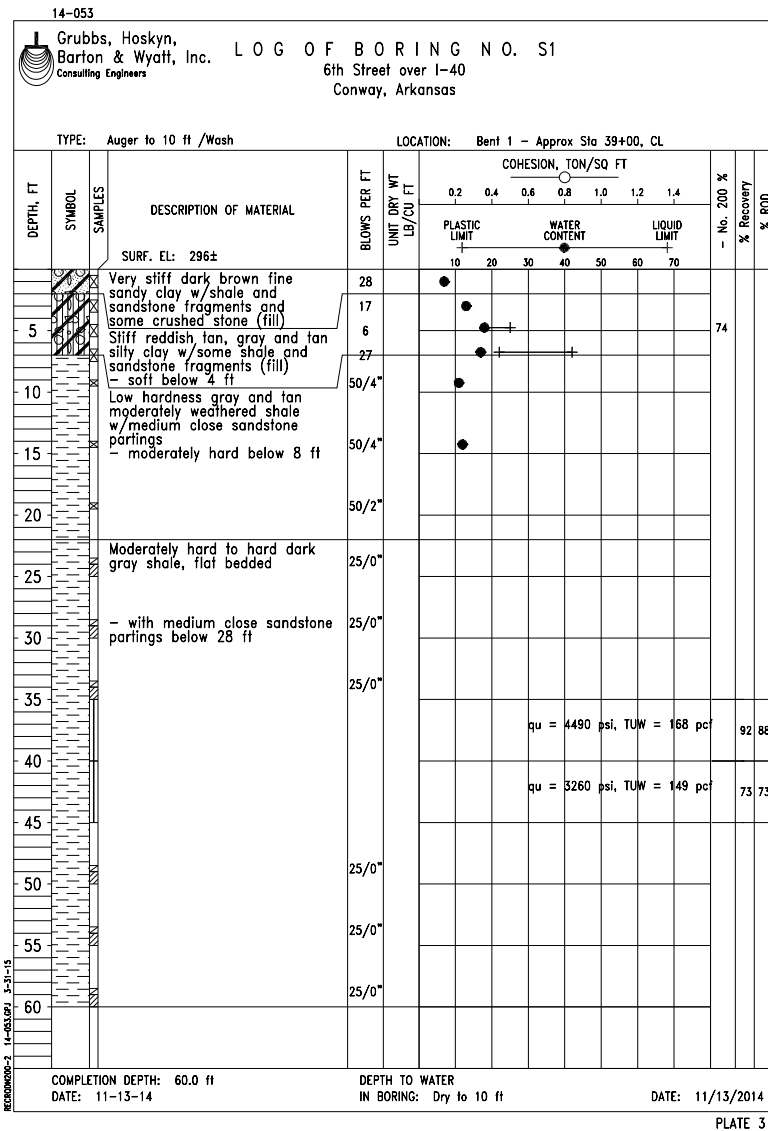


DRGNO: 5/19/2015 1:27:27 PM  
 WORKSPACE: AHTD Bridge  
 L:\2012\201590 - Centrefield Access\Drawings\6TH\_ST\B080517\_BLI.dgn  
 REVISED DATE:

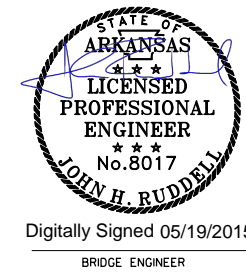


SHEET 1 OF 3  
 BORING LOG DETAILS  
 ROUTE SEC.  
 ARKANSAS STATE HIGHWAY COMMISSION  
 LITTLE ROCK, ARK.  
 DRAWN BY: HEW DATE: MAR. 2015 FILENAME: B080517\_BLI.dgn  
 CHECKED BY: DRG DATE: MAR. 2015 SCALE: As Shown  
 DESIGNED BY: DATE: BRIDGE NO. 07345 DRAWING NO. 57067

DATE REVISED	DATE FILMED	DATE REVISED	DATE FILMED	FED. ROAD DIST. NO.	STATE	FED. AID PROJ. NO.	SHEET NO.	TOTAL SHEETS
				6	ARK.			
				JOB NO.		080517	69	182
				07345		BORING LOGS		57068

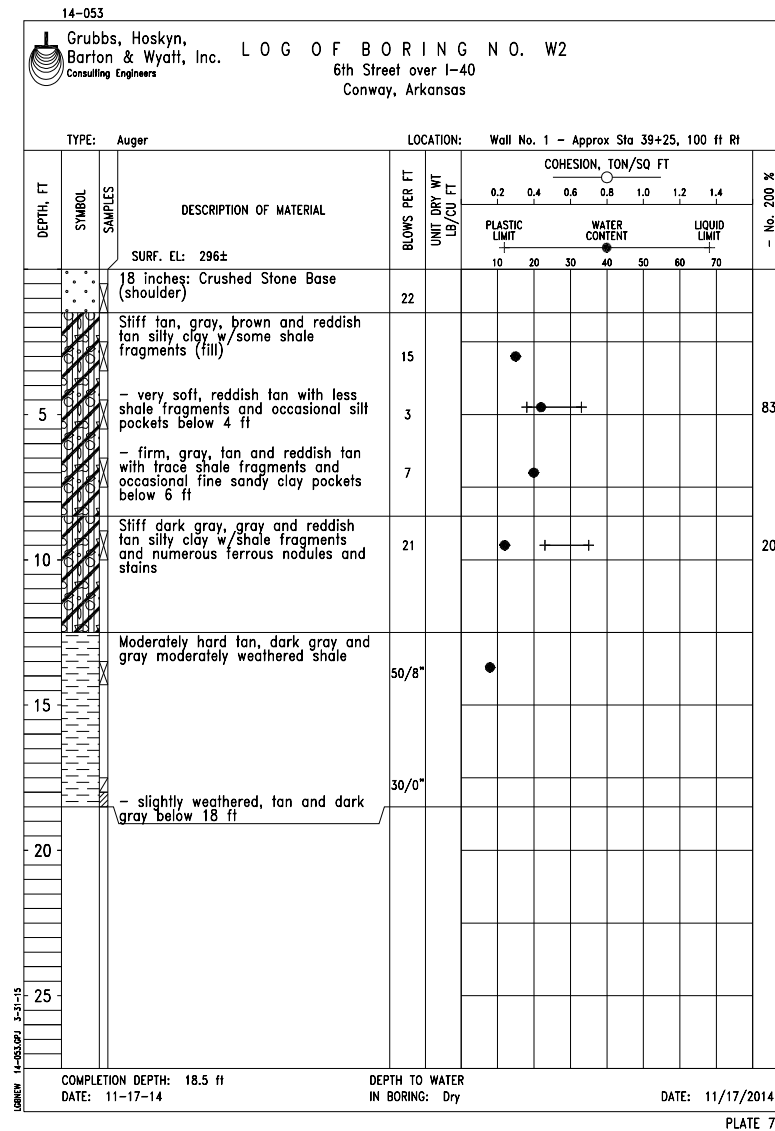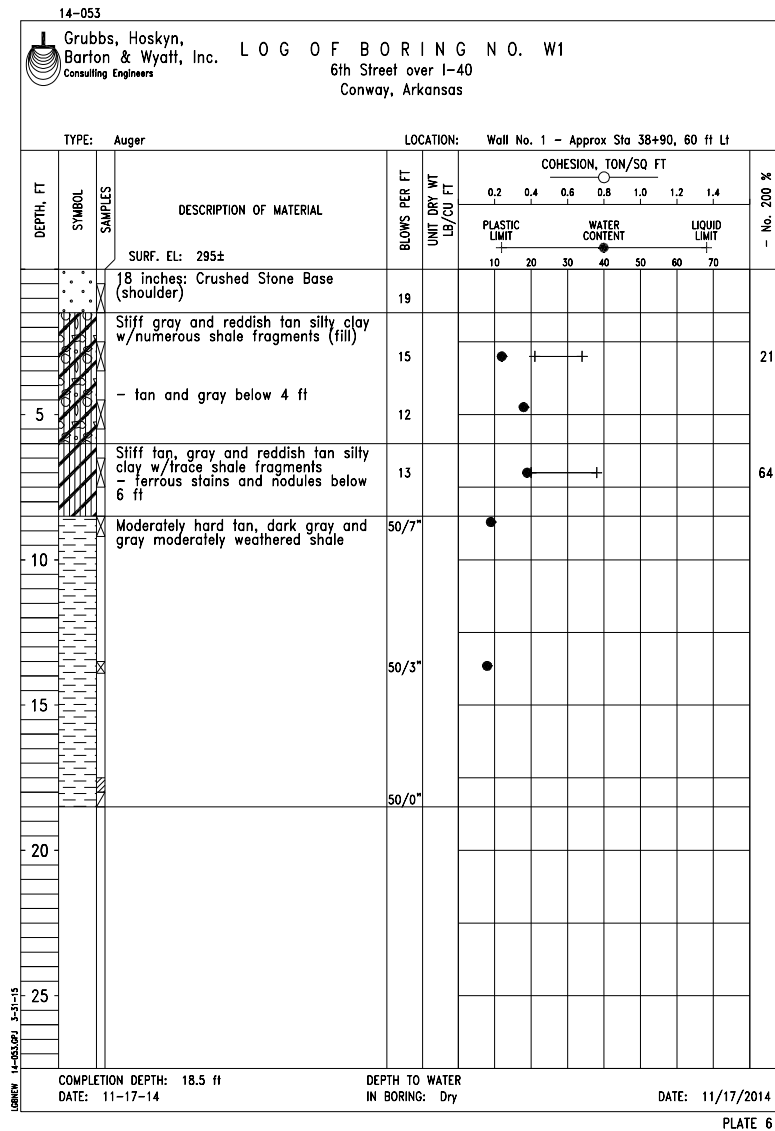

DRGNO: 14-053-01  
 5/19/2015 1:27:28 PM  
 WORKSPACE: AHTD Bridge  
 L:\2012\201590 - Centrefield Access\Drawings\6TH\_ST\B080517\_BL2.dgn  
 REVISED DATE:

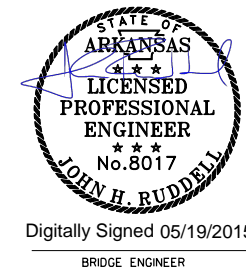



Digitally Signed 05/19/2015  
BRIDGE ENGINEER

SHEET 2 OF 3  
 BORING LOG DETAILS  
 ROUTE SEC.  
 ARKANSAS STATE HIGHWAY COMMISSION  
 LITTLE ROCK, ARK.


DRAWN BY: HEW DATE: MAR. 2015 FILENAME: B080517\_BL2.dgn  
 CHECKED BY: DRG DATE: MAR. 2015 SCALE: As Shown  
 DESIGNED BY: DATE:

BRIDGE NO. 07345 DRAWING NO. 57068

DATE REVISED	DATE FILMED	DATE REVISED	DATE FILMED	FED. ROAD DIST. NO.	STATE	FED. AID PROJ. NO.	SHEET NO.	TOTAL SHEETS
				6	ARK.			
				JOB NO.		080517	70	182
				07345		BORING LOGS		57069

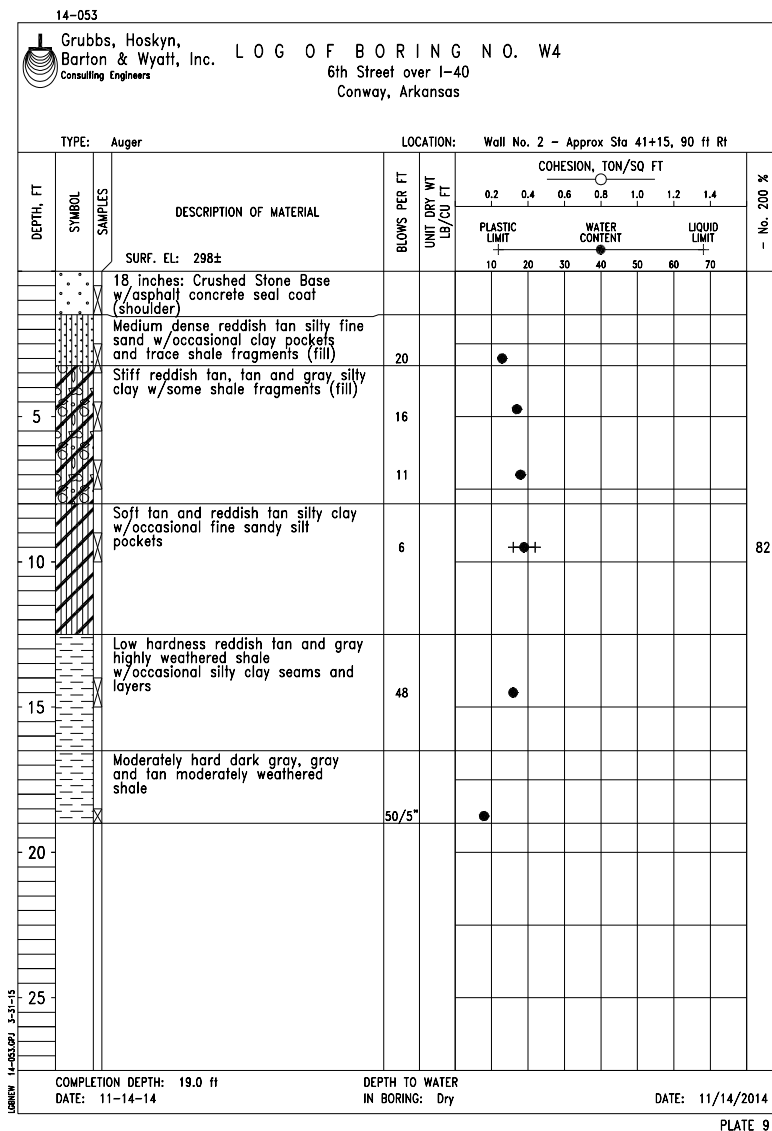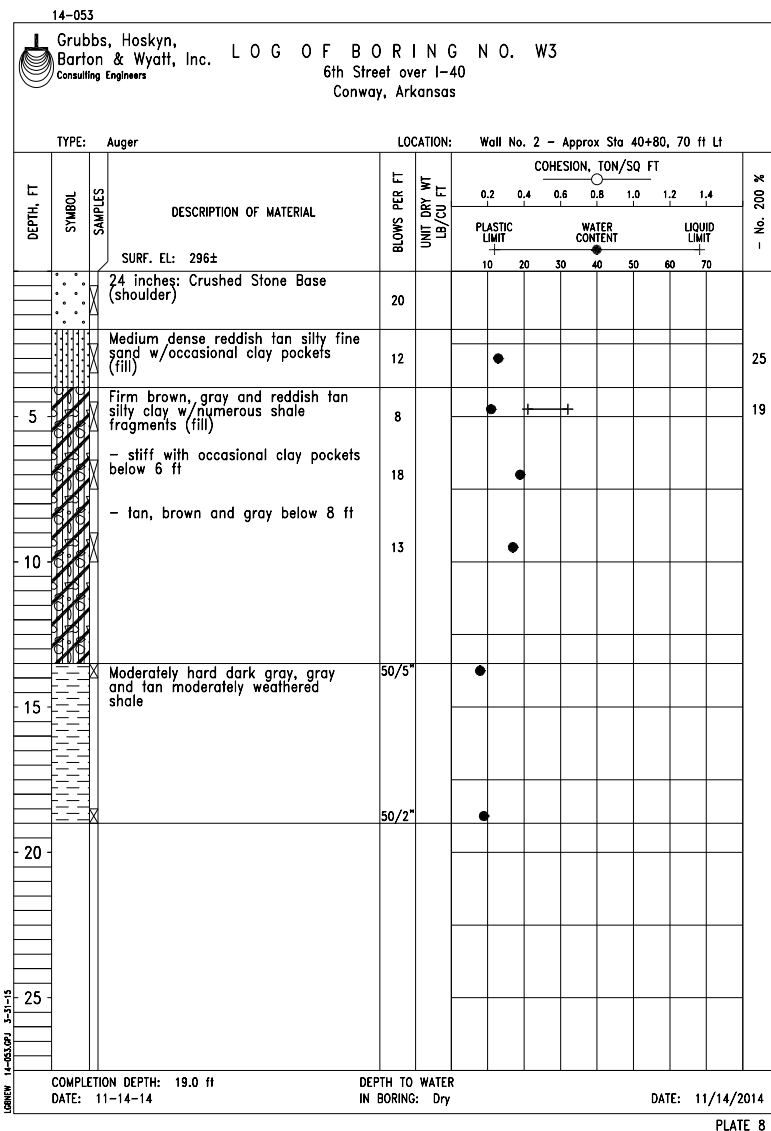

DRGNO: 14-053-01  
 5/19/2015 1:27:33 PM  
 WORKSPACE: AHTD Bridge  
 L:\2012\201590 - Centrefield Access\Drawings\6TH\_ST\B080517\_BL3.dgn  
 REVISED DATE:

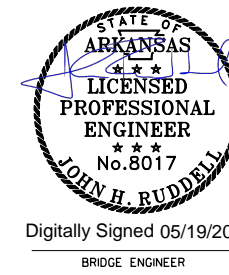


Digitally Signed 05/19/2015  
BRIDGE ENGINEER


SHEET 3 OF 3  
 BORING LOG DETAILS  
 ROUTE SEC.  
 ARKANSAS STATE HIGHWAY COMMISSION  
 LITTLE ROCK, ARK.

DRAWN BY: HEW DATE: MAR. 2015 FILENAME: B080517\_BL3.dgn  
 CHECKED BY: DRG DATE: MAR. 2015 SCALE: As Shown  
 DESIGNED BY: DATE:   
 BRIDGE NO. 07345 DRAWING NO. 57069

DATE REVISED	DATE FILMED	DATE REVISED	DATE FILMED	FED. ROAD DIST. NO.	STATE	FED. AID PROJ. NO.	SHEET NO.	TOTAL SHEETS
6-1-15				6	ARK.			
						JOB NO.	080517	71
						07345	END BENT DETAILS	57070

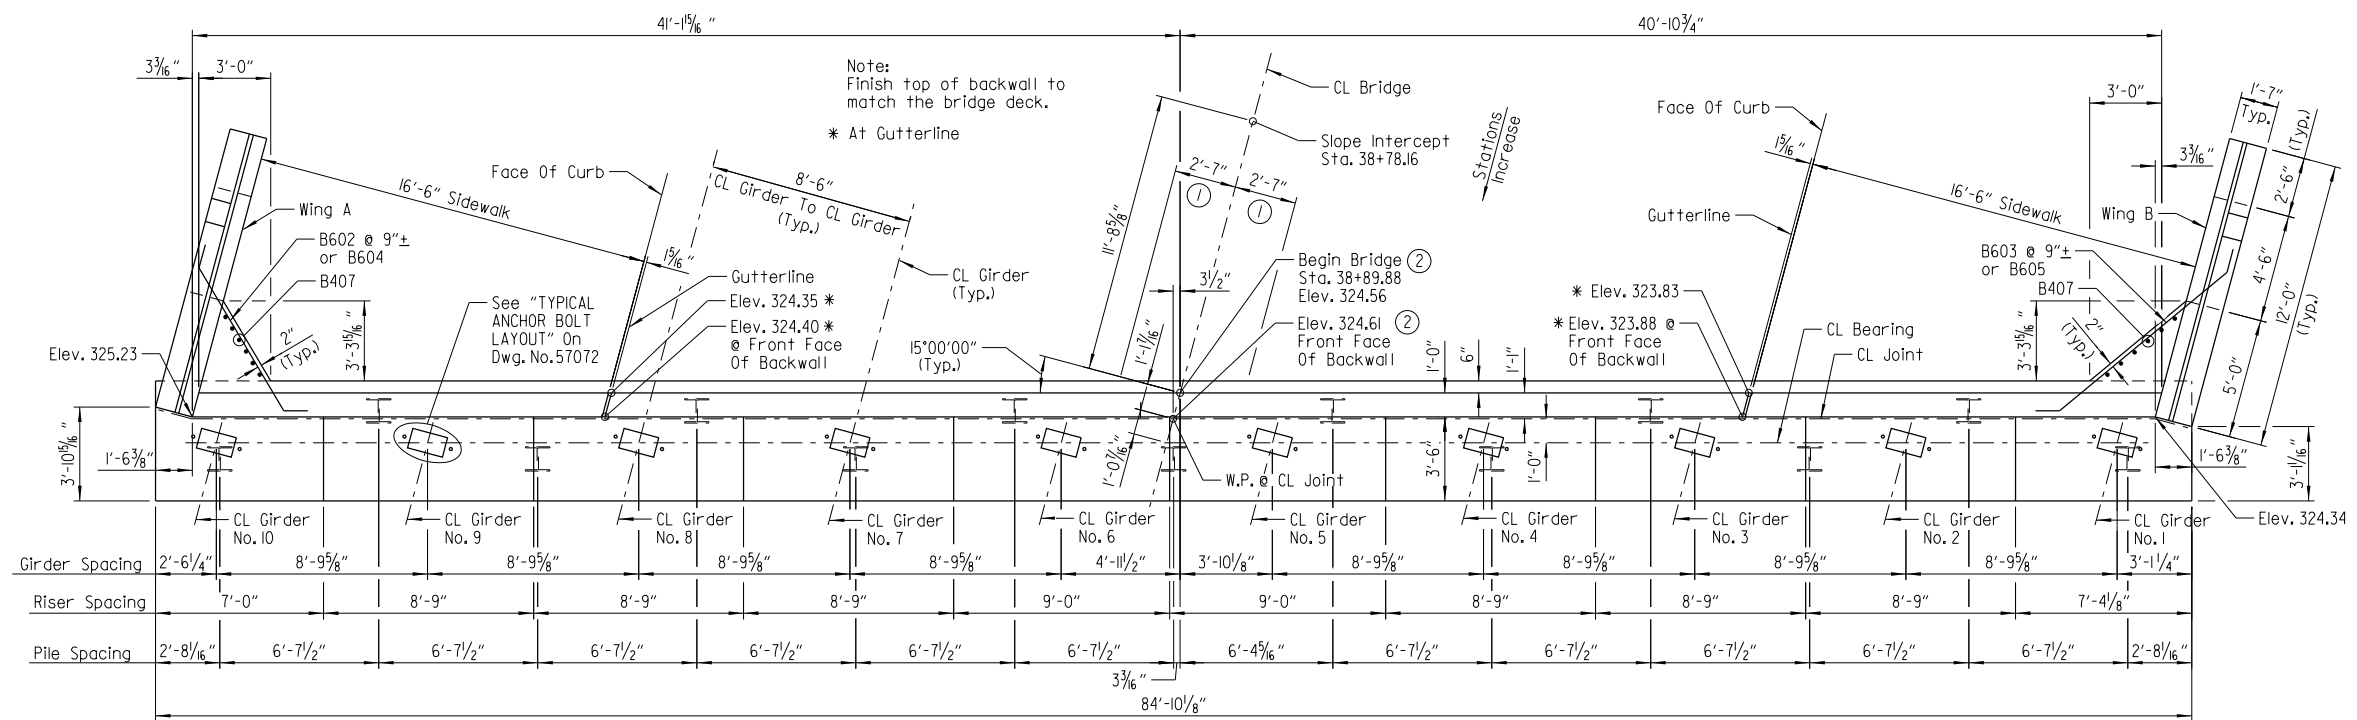

**PLAN - END BENT NO. 1**  
Scale: 1/4" = 1'-0"

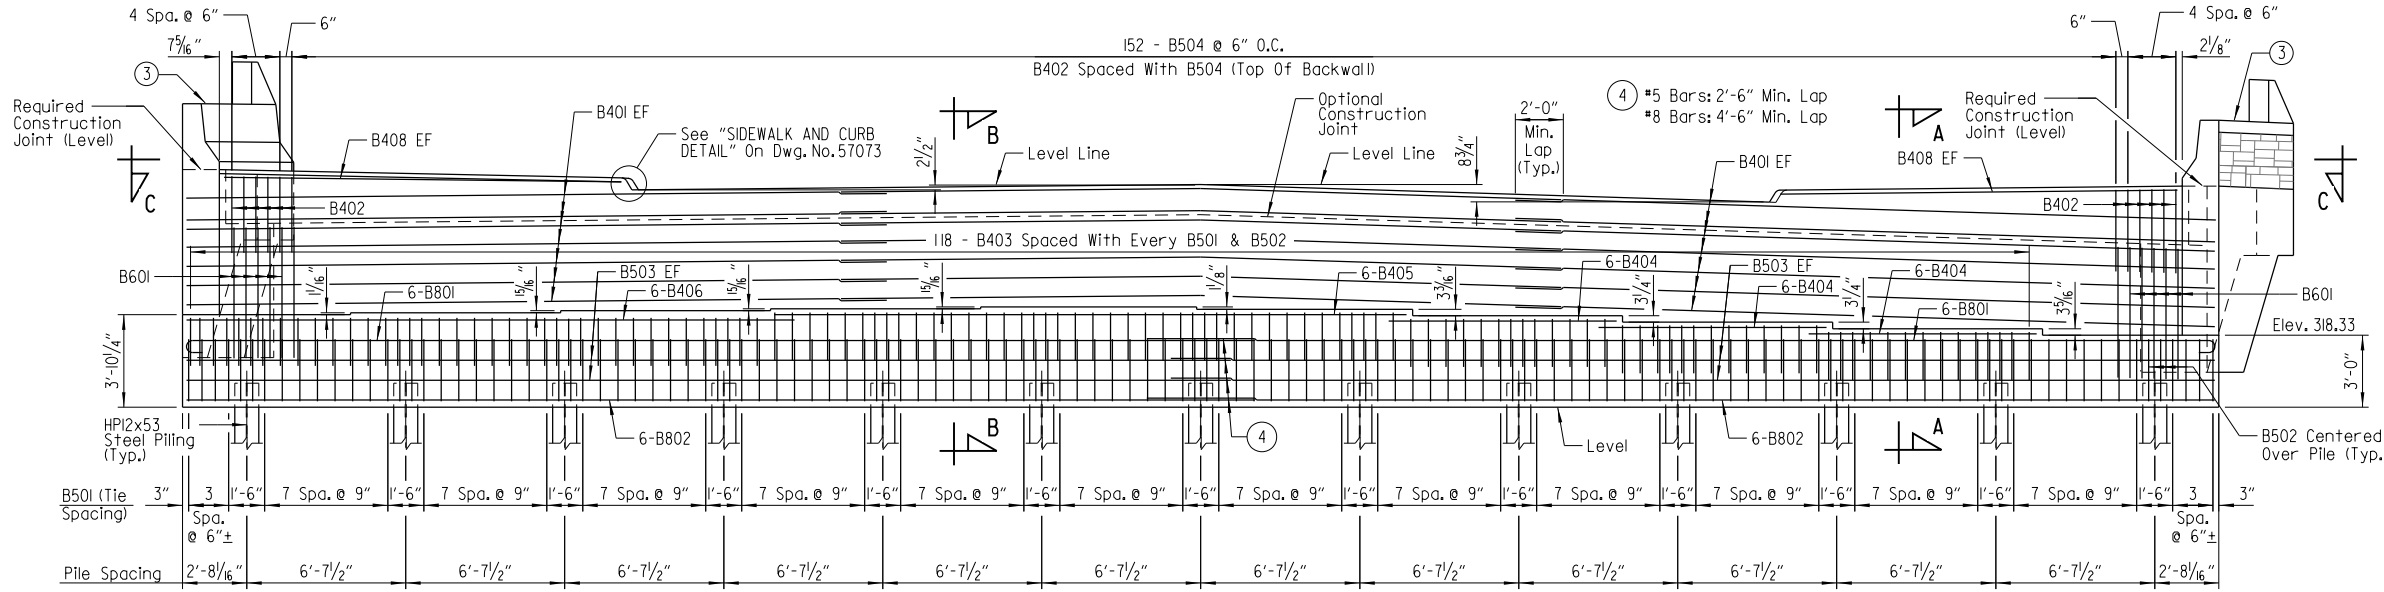

**ELEVATION - END BENT NO. 1**  
(Looking Back)  
Scale: 1/4" = 1'-0"

**GENERAL NOTES**

End bent piling shall not be driven until the waiting period has elapsed. See LAYOUT for more information.

All concrete shall be Class "S" and be poured in the dry. All exposed corners to be chamfered 3/4" unless otherwise noted.

All reinforcing steel shall conform to AASHTO M31 or M322 Type A, Gr. 60 (Yield Strength = 60,000 psi).

Structural steel in end bents shall be AASHTO M270, Gr. 50 and shall be paid for as "BRIDGE CONSTRUCTION." Structural Steel shall be cleaned and painted in accordance with Section 807. The color of the paint shall be Black and shall match Fed. Std. 595B, Color Chip No. 27038.

If anchor bolts are drilled into cap, top reinforcing bars shall be properly placed to avoid damage.

For additional information, see LAYOUT.

Class I Protective Surface Treatment shall be applied to the top of backwall. Class 3 Textured Coating shall be applied in accordance with SP "TEXTURED COATING FINISH".

**LEGEND**

EF = Each Face

**NOTES:**

For "BAR LIST" & "BAR BENDING DIAGRAMS", see Dwg. No. 57072  
For "SECTION A-A", "B-B", & "VIEW C-C", see Dwg. No. 57072  
For details of wing & rail, see Dwg. No. 57073  
For details of elastomeric bearing pads, see Dwg. No. 57089

**Note:**

The Backwall Above The Required Construction Joint Shall Not Be Poured Until The Girders Are In Place. Backwall May Be Placed Prior To Placing The Adjacent Concrete Deck Only If The Optional Backwall Construction Joint Is Used. See "DETAILS FOR BLOCKING EXPANSION JOINT DEVICE" On Dwg. No. 57087 For Additional Information.

Replaced "M53" with "M322 Type A", DRG 6-1-15. Checked by JHR

- ① See "ROUNDING DETAIL" on dwg. no. 57078
- ② Measured to Working Point - See "ROUNDING DETAIL" on dwg. no. 57078
- ③ Metal railing not shown for clarity. For details see dwg. no. 57086




Digitally Signed 06/01/2015  
BRIDGE ENGINEER

SHEET 1 OF 4  
DETAILS OF END BENT NO. 1  
ROUTE SEC.  
ARKANSAS STATE HIGHWAY COMMISSION  
LITTLE ROCK, ARK.

DRAWN BY: HEW DATE: MAR. 2015 FILENAME: B080517\_A1.dgn  
CHECKED BY: LIC DATE: APR. 2015 SCALE: As Shown  
DESIGNED BY: SRY DATE: JAN. 2015  
BRIDGE NO. 07345 DRAWING NO. 57070


DRGNO: 6/1/2015 12:53:39 PM  
 WORKSPACE: AHTD Bridge  
 L:\2012\201590 - Centrefield Access\Drawings\6TH\_ST\B080517\_A1.dgn  
 REVISED DATE:

DATE REVISED	DATE FILMED	DATE REVISED	DATE FILMED	FED. ROAD DIST. NO.	STATE	FED. AID PROJ. NO.	SHEET NO.	TOTAL SHEETS
				6	ARK.			
				JOB NO.		080517	72	182
				07345	END BENT DETAILS			57071

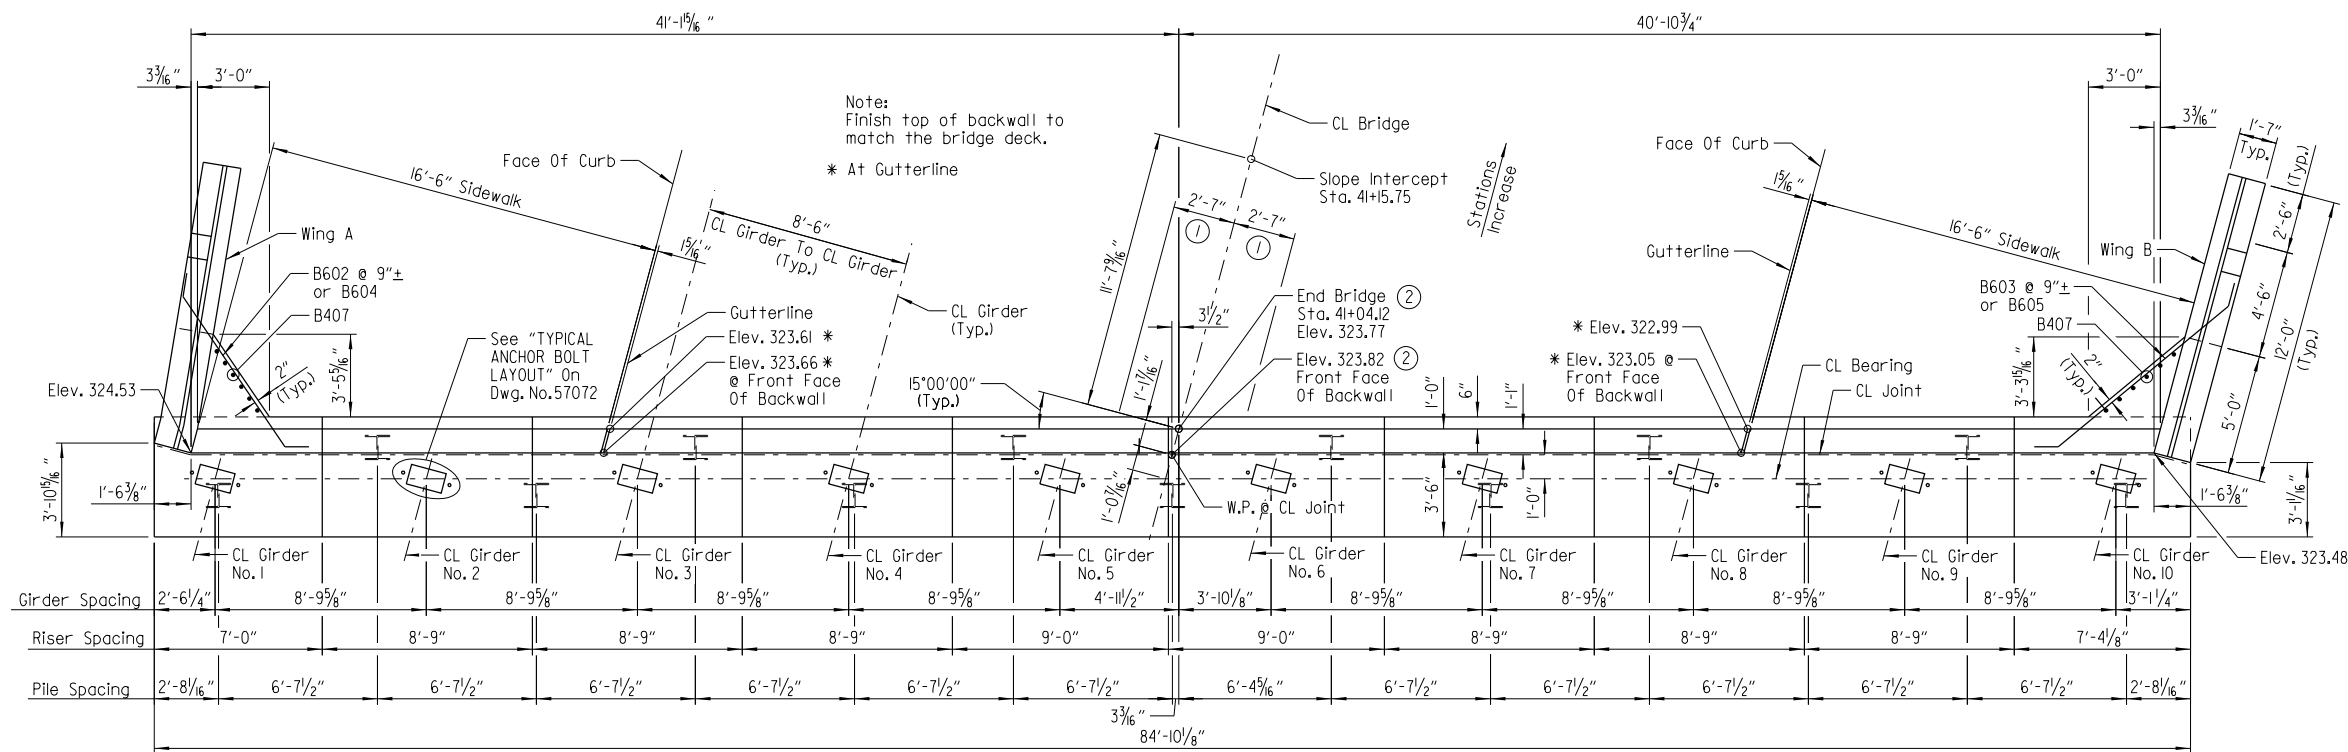

**PLAN - END BENT NO. 3**

Scale: 1/4" = 1'-0"

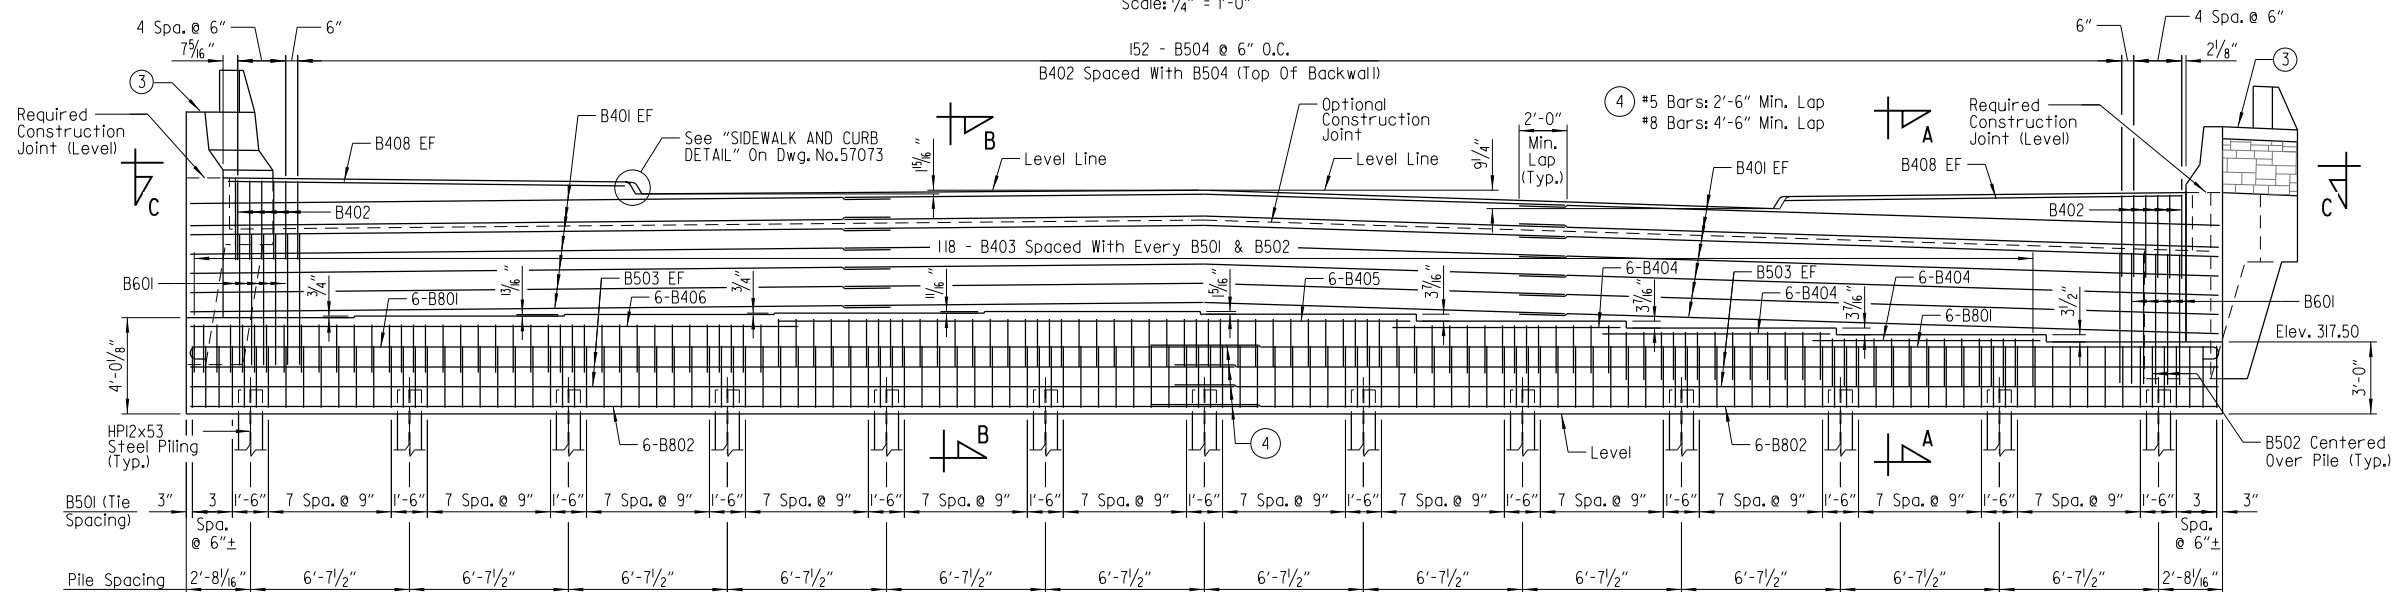

**ELEVATION - END BENT NO. 3**


(Looking Forward)  
Scale: 1/4" = 1'-0"

**LEGEND**

EF = Each Face

**NOTES:**  
For "BAR LIST" & "BAR BENDING DIAGRAMS", see Dwg. No. 57072  
For "SECTION A-A", "B-B", & "VIEW C-C", see Dwg. No. 57072  
For "GENERAL NOTES", see Dwg. No. 57070  
For details of wing & rail, see Dwg. No. 57073  
For details of elastomeric bearing pads, see Dwg. No. 57089

**Note:**  
The Backwall Above The Required Construction Joint Shall Not Be Poured Until The Girders Are In Place. Backwall May Be Placed Prior To Placing The Adjacent Concrete Deck Only If The Optional Backwall Construction Joint Is Used. See "DETAILS FOR BLOCKING EXPANSION JOINT DEVICE" On Dwg. No. 57087 For Additional Information.

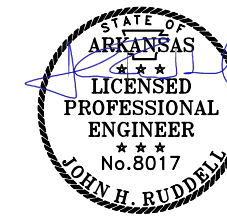

Digitally Signed 05/19/2015  
BRIDGE ENGINEER


SHEET 2 OF 4  
DETAILS OF END BENT NO. 3  
ROUTE SEC.  
ARKANSAS STATE HIGHWAY COMMISSION  
LITTLE ROCK, ARK.

DRAWN BY: HEW DATE: MAR. 2015 FILENAME: B080517\_A2.dgn  
CHECKED BY: LIC DATE: APR. 2015 SCALE: As Shown  
DESIGNED BY: SRY DATE: JAN. 2015  
BRIDGE NO. 07345 DRAWING NO. 57071


- ① See "ROUNDING DETAIL" on dwg. no. 57078
- ② Measured to Working Point - See "ROUNDING DETAIL" on dwg. no. 57078
- ③ Metal railing not shown for clarity. For details see dwg. no. 57086



DATE REVISED	DATE FILMED	DATE REVISED	DATE FILMED	FED. ROAD DIST. NO.	STATE	FED. AID PROJ. NO.	SHEET NO.	TOTAL SHEETS
				6	ARK.			
				JOB NO.	080517	73	182	
				07345	END BENT DETAILS	57072		

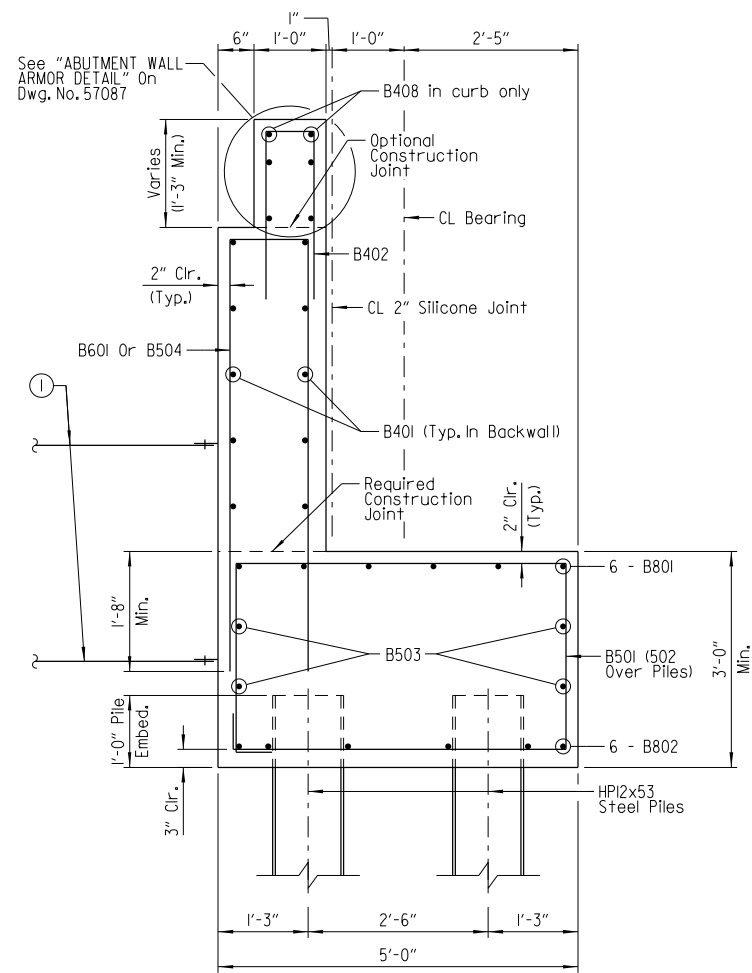


**SECTION A-A**  
Scale: 3/4" = 1'-0"

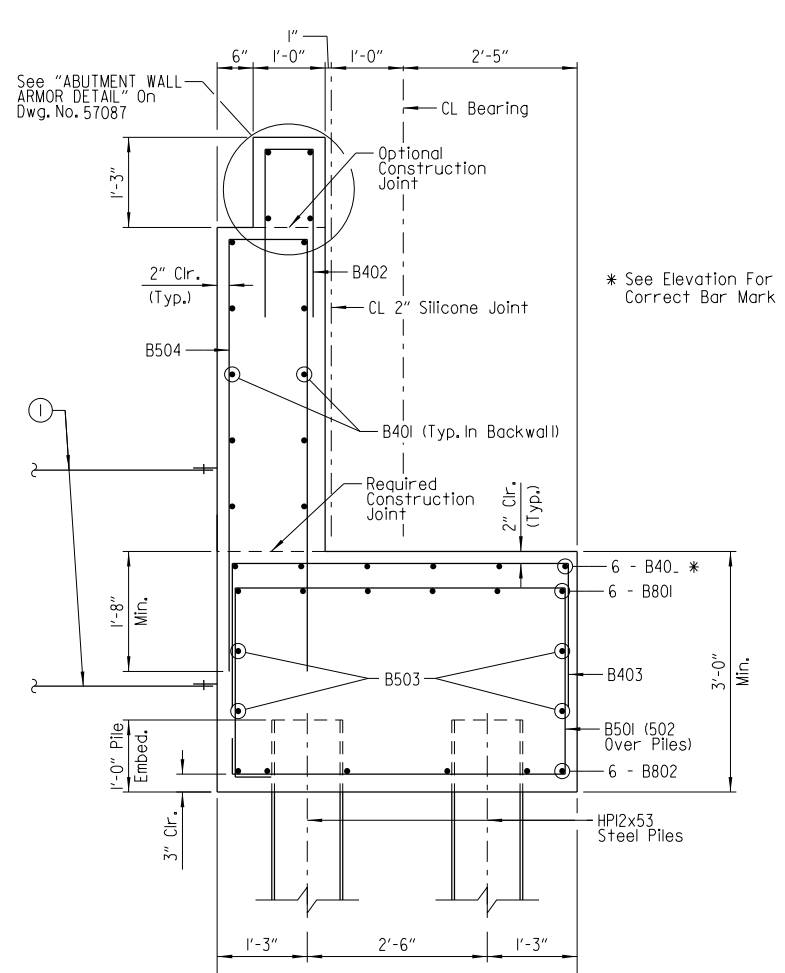


**SECTION B-B**  
Scale: 3/4" = 1'-0"

Note:  
The Backwall Above The Required Construction Joint Shall Not Be Poured Until The Girders Are In Place. Backwall May Be Placed Prior To Placing The Adjacent Concrete Deck Only If The Optional Construction Joint Is Used. See "DETAILS FOR BLOCKING EXPANSION JOINT DEVICE" On Dwg. No. 57087 For Additional Information.

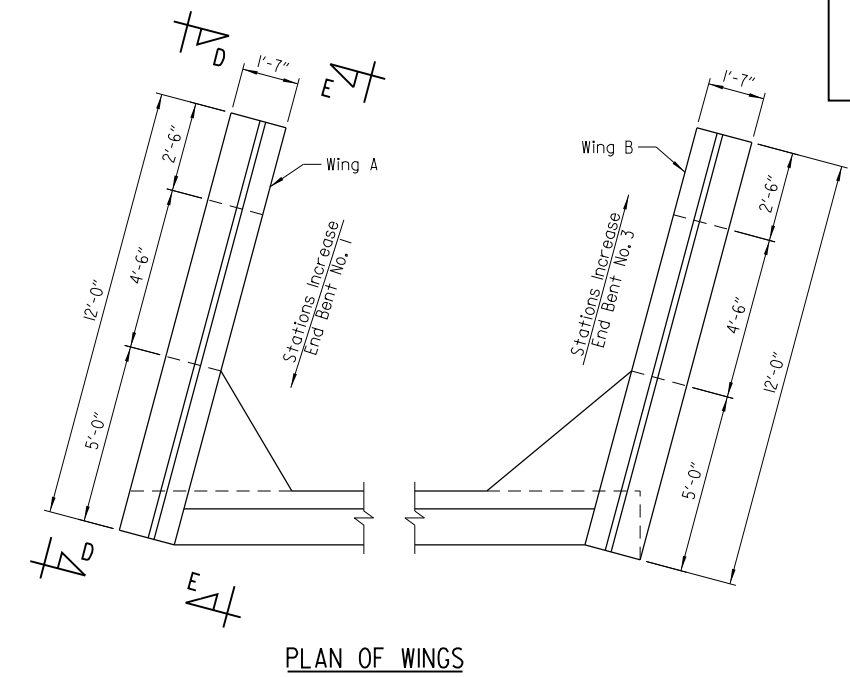

**PLAN OF WINGS**  
Scale: 3/8" = 1'-0"

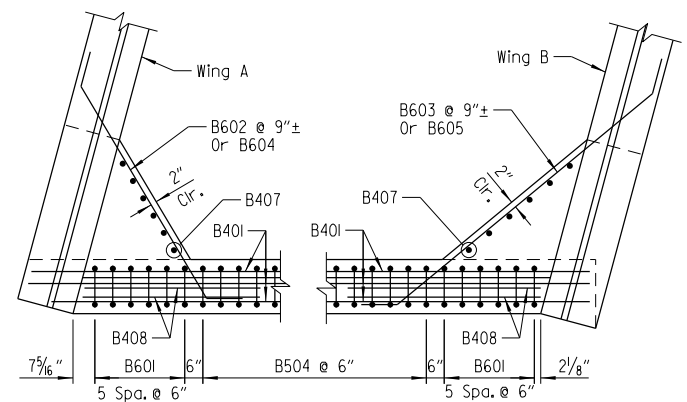


**VIEW C-C**  
Scale: 3/8" = 1'-0"


MARK	NO. REQ'D	LENGTH	"A"	"B"	P.D.
B401	42	30'-0"			STR.
B402	162	7'-2"	3'-4"	8"	2"
B403	118	8'-6"	2'-0"	4'-8"	2"
B404	18	9'-9"			STR.
B405	6	26'-5"			STR.
B406	6	25'-4"			STR.
B407	12	5'-3"			STR.
B408	4	16'-5"			STR.
B501	104	15'-0"			2 1/2"
B502	26	9'-7 1/2"	2'-7"	4'-8"	2 1/2"
B503	8	43'-6"			STR.
B504	152	11'-11 1/2"	5'-6"	1'-2"	2 1/2"
B601	10	11'-10"	5'-6"	1'-2"	4 1/2"
B602	5	8'-11"			4 1/2"
B603	5	11'-0"			4 1/2"
B604	1	7'-11"			4 1/2"
B605	1	10'-0"			4 1/2"
B801	12	45'-5"			6"
B802	12	44'-6"			STR.
R401	28	3'-9"			2"
R402	12	11'-8"			STR.
W401	14	9'-1"	7'-11"		3"
W402	14	10'-2"			STR.
W403 To W406	2 Each	8'-2" To 4'-9"	7'-0" To 3'-7"		3"
W407 To W410	2 Each	9'-2" To 5'-9"			STR.
W411	6	4'-0"	2'-10"		3"
W412	6	5'-2"			STR.
W413	3	14'-2"			3"
W414	3	15'-3"			3"
W415	2	4'-10"			3"
W416	6	5'-4"			3"
W701	8	11'-8"			STR.
W702 To W708	4 Each	8'-10" To 5'-6"			STR.
W709	4	13'-5"			5 1/4"

Note:  
Number of bars shown is for one end bent only.

① Reinforcing Straps and attachments to be designed and furnished by MSE wall supplier. See Dwg. No. 57065 for additional details.

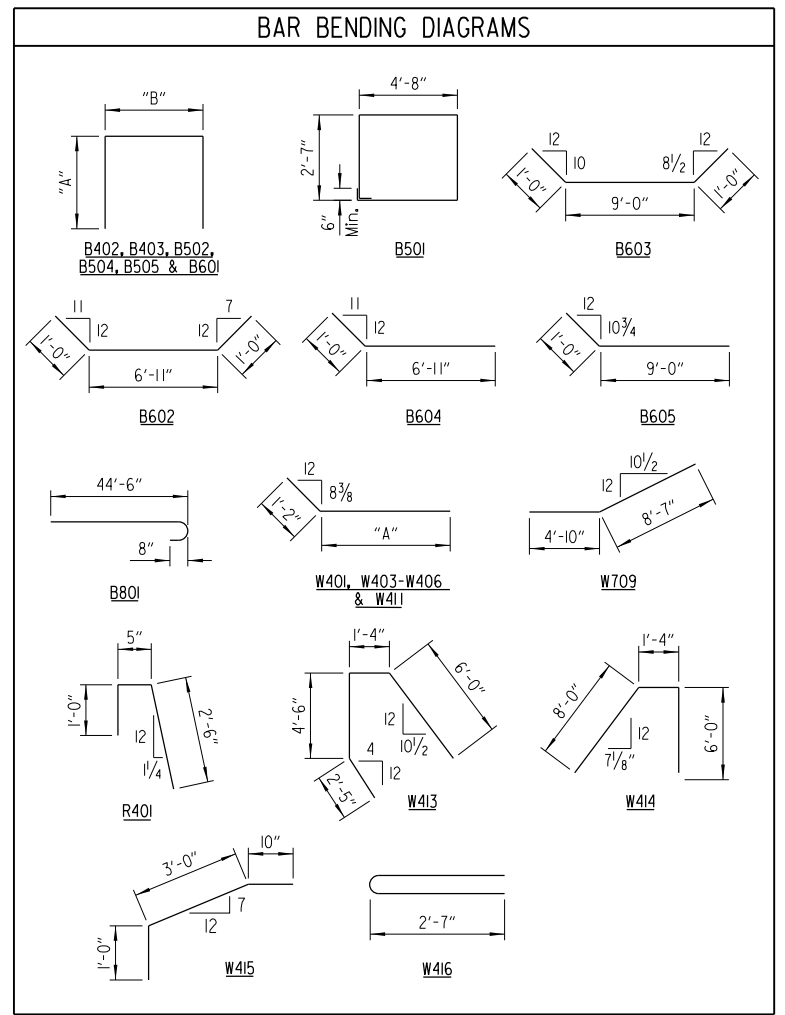

Note:  
Dimensions of bars in bending diagrams are out-to-out.

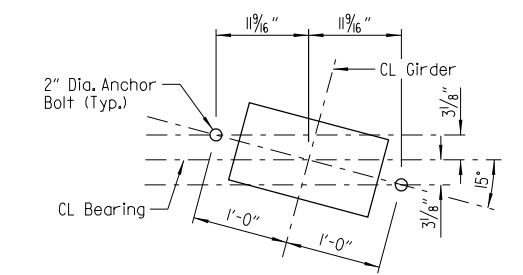

**TYPICAL ANCHOR BOLT LAYOUT**  
Scale: 1" = 1'-0"


DRC: 5/19/2015 1:27:36 PM  
 WORKSPACE: AHTD Bridge  
 L:\2012\201590 - Centrefield Access\Drawings\6TH\_ST\B080517\_A3.dgn  
 REVISED DATE:

Note:  
See Dwg. No. 57073 For View D-D And Section E-E.

**STATE OF ARKANSAS**  
 LICENSED PROFESSIONAL ENGINEER  
 No. 8017  
**JOHN H. RUELLE**  
 Bridge Engineer  
 Digitally Signed 05/19/2015


**SHEET 3 OF 4**  
**DETAILS OF END BENTS**  
 ROUTE SEC.  
**ARKANSAS STATE HIGHWAY COMMISSION**  
 LITTLE ROCK, ARK.  
 DRAWN BY: HEW DATE: MAR. 2015 FILENAME: B080517\_A3.dgn  
 CHECKED BY: LIC DATE: APR. 2015 SCALE: As Shown  
 DESIGNED BY: SRY DATE: JAN. 2015  
 BRIDGE NO. 07345 DRAWING NO. 57072

DATE REVISED	DATE FILMED	DATE REVISED	DATE FILMED	FED. ROAD DIST. NO.	STATE	FED. AID PROJ. NO.	SHEET NO.	TOTAL SHEETS
				6	ARK.			
				JOB NO.		080517	74	182
				07345	END BENT DETAILS		57073	

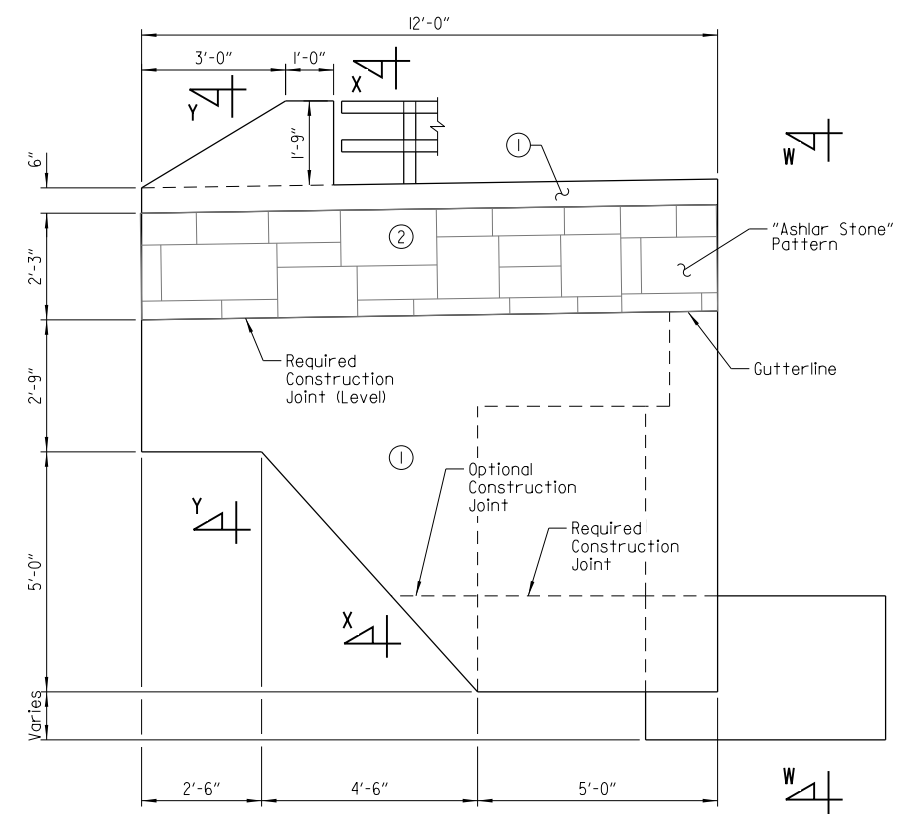


**VIEW D-D**  
Scale: 1/2" = 1'-0"

TABLE OF ELEVATIONS		
End Bent No.	Location	Elev. "A"
1	Wing "A"	323.75
	Wing "B"	322.75
3	Wing "A"	322.94
	Wing "B"	321.79

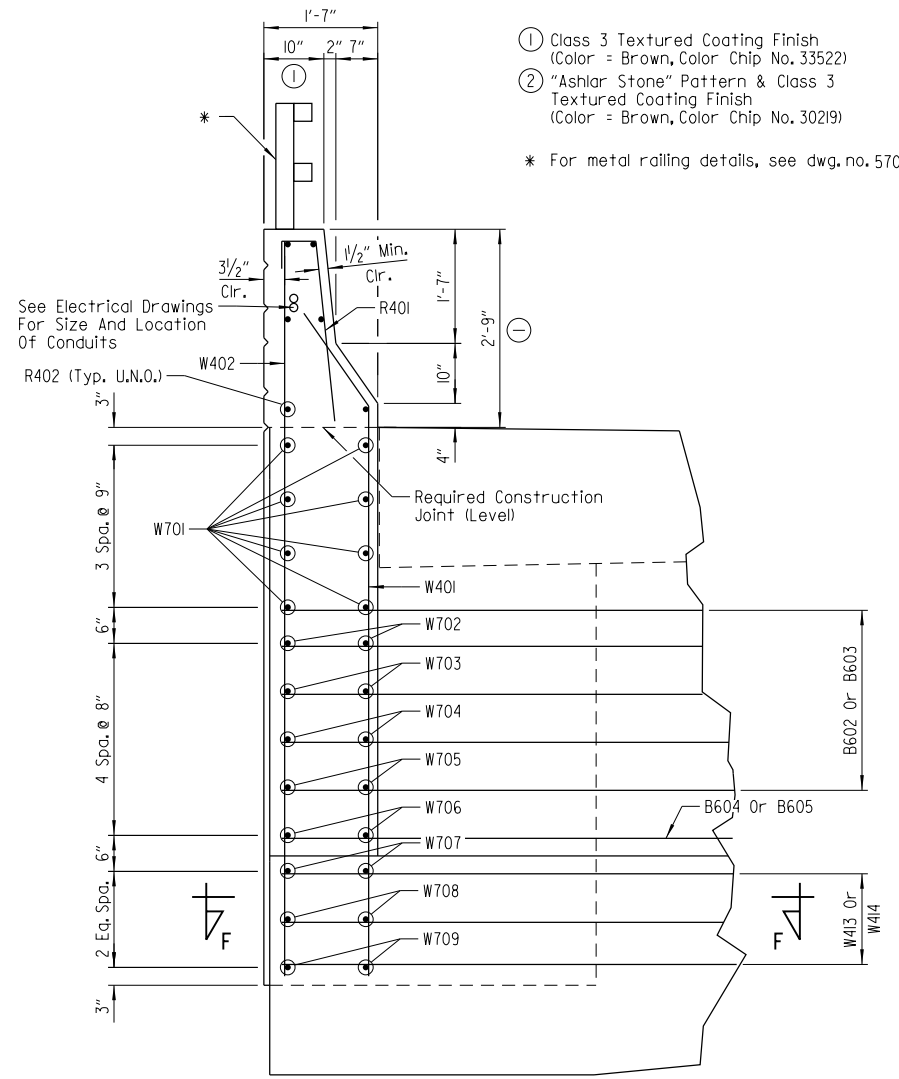


**SECTION W-W**  
Scale: 3/4" = 1'-0"

**LEGEND**  
EF = Each Face  
BF = Back Face  
FF = Front Face  
U.N.O. = Unless Noted Otherwise

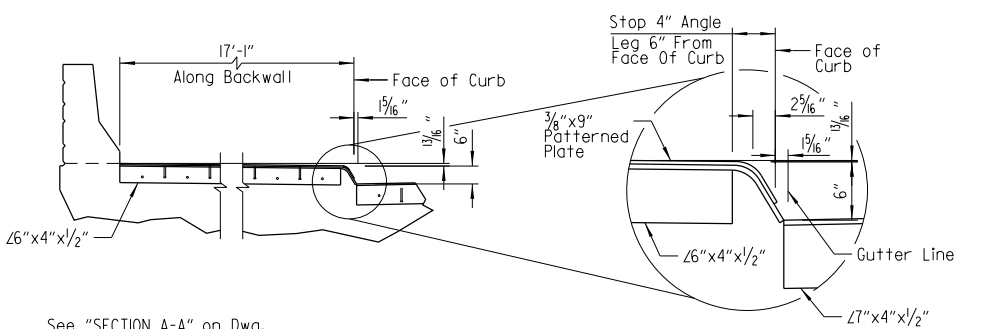


**SIDEWALK AND CURB DETAIL**  
Scale: NTS


See "SECTION A-A" on Dwg. No. 57087 for additional details.

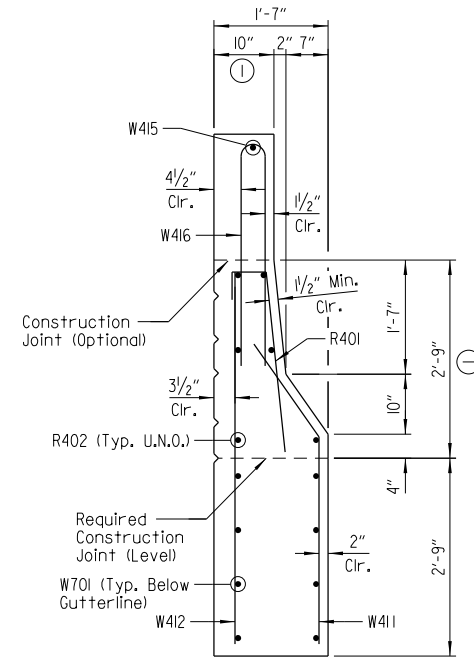


**SECTION Y-Y**  
Scale: 3/4" = 1'-0"

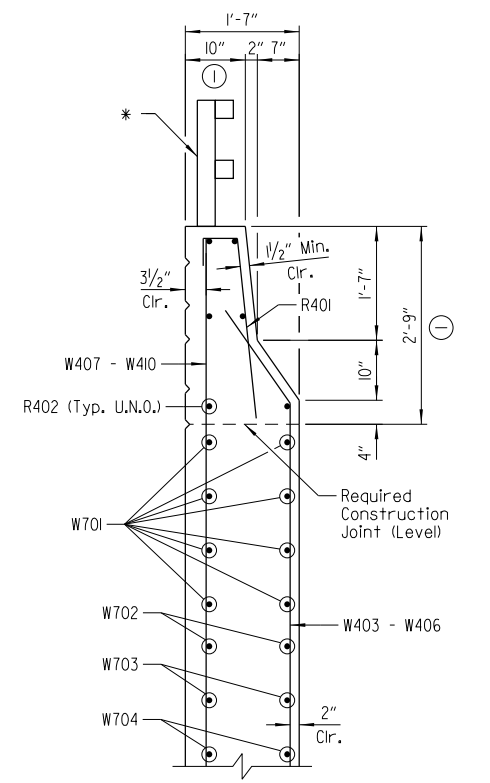


**SECTION X-X**  
Scale: 3/4" = 1'-0"

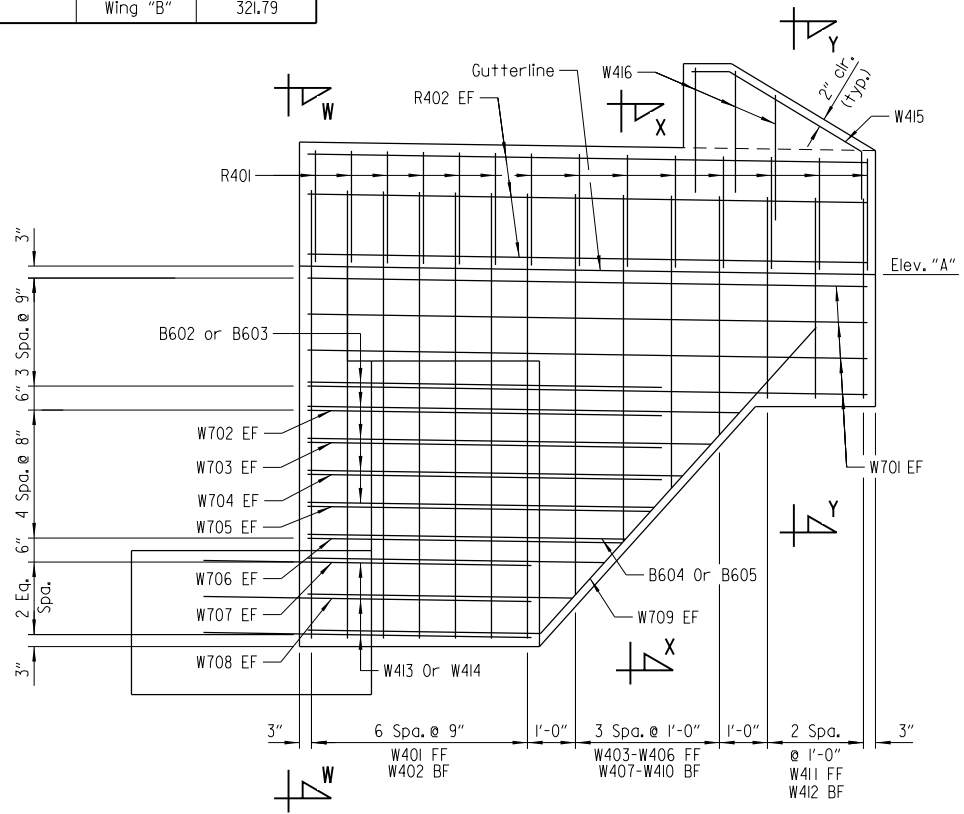


**SECTION E-E**  
Scale: 1/2" = 1'-0"

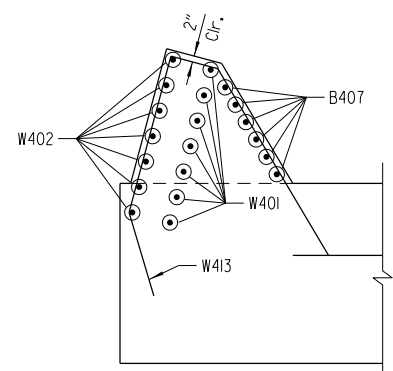

**SECTION F-F (WING A)**  
Scale: 3/8" = 1'-0"

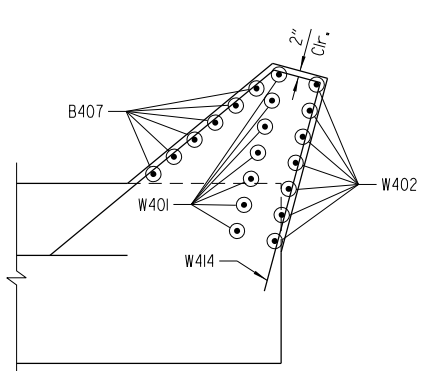

**SECTION F-F (WING B)**  
Scale: 3/8" = 1'-0"

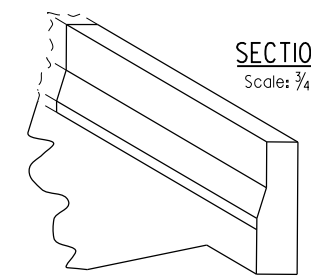

**THREE DIMENSIONAL VIEW OF RAIL**  
Scale: N.T.S.




Digitally Signed 05/19/2015  
BRIDGE ENGINEER

SHEET 4 OF 4  
DETAILS OF END BENTS  
ROUTE SEC.  
ARKANSAS STATE HIGHWAY COMMISSION  
LITTLE ROCK, ARK.

DRAWN BY: HEW DATE: MAR. 2015 FILENAME: B080517\_A4.dgn  
CHECKED BY: LIC DATE: APR. 2015 SCALE: As Shown  
DESIGNED BY: SRY DATE: JAN. 2015  
BRIDGE NO. 07345 DRAWING NO. 57073

DRGNO: 5/19/2015 1:27:36 PM  
 WORKSPACE: AHTD Bridge  
 L:\2012\201590 - Centrefield Access\Drawings\6TH\_ST\B080517\_A4.dgn  
 REVISED DATE:

DATE REVISED	DATE FILMED	DATE REVISED	DATE FILMED	FED. ROAD DIST. NO.	STATE	FED. AID PROJ. NO.	SHEET NO.	TOTAL SHEETS
				6	ARK.			
				JOB NO.		080517	75	182
				① 07345		TRANS. RAILING		57074

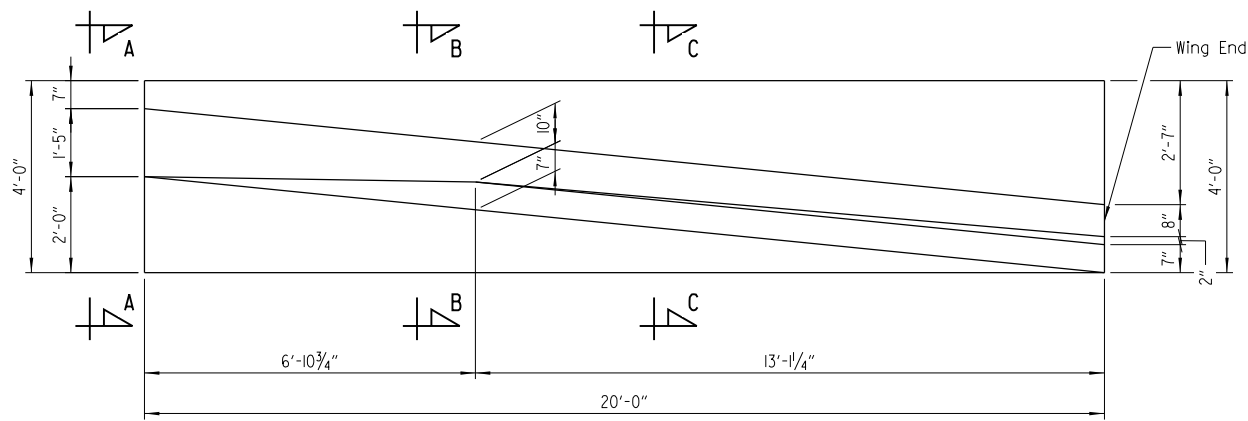

NOTE:  
Railings on each side of roadway are opposite hand to each other.

**PLAN**

Scale: 1/2" = 1'-0"

NOTES:  
Transitional Approach Railing shall be placed at ends of turnback wings at locations shown on the layout and at the end of the MSE Wall shown on the MSE Wall sheets.

All concrete shall be Class "S" and shall be poured in the dry. All exposed corners shall be chamfered 3/4" unless otherwise noted.

All reinforcing steel shall conform to AASHTO M31 or M322 Type A, Grade 60. Reinforcing steel designated as galvanized shall be galvanized in accordance with ASTM A767. Use coating Class I with galvanization after fabrication.

Class I Protective Surface Treatment shall be applied to the top and roadway face of rail.


Transitional Approach Railing shall conform to Section 806 and shall be paid for at the contract unit price bid per each for "TRANSITIONAL APPROACH RAILING".

For electrical conduit details, see Dwg. Nos. 57090- 57093 .

**SCHEDULE OF QUANTITIES**

CLASS "S" CONCRETE	REINFORCING STEEL (GRADE 60)
4.20 C.Y.	375.9 Lbs.

Quantities shown are for one rail unit.

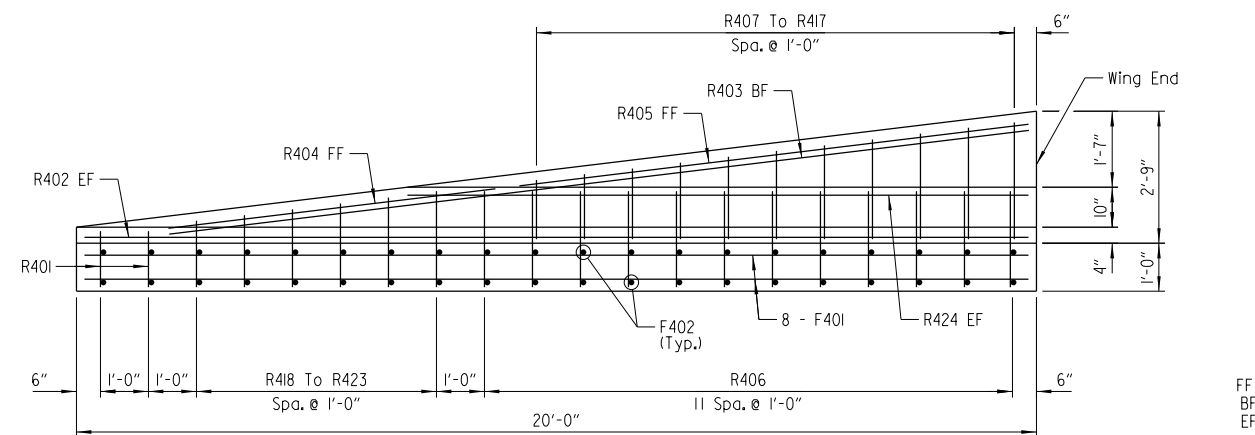


**ELEVATION**

Scale: 1/2" = 1'-0"

**LEGEND**


FF = Front Face  
BF = Back Face  
EF = Each Face

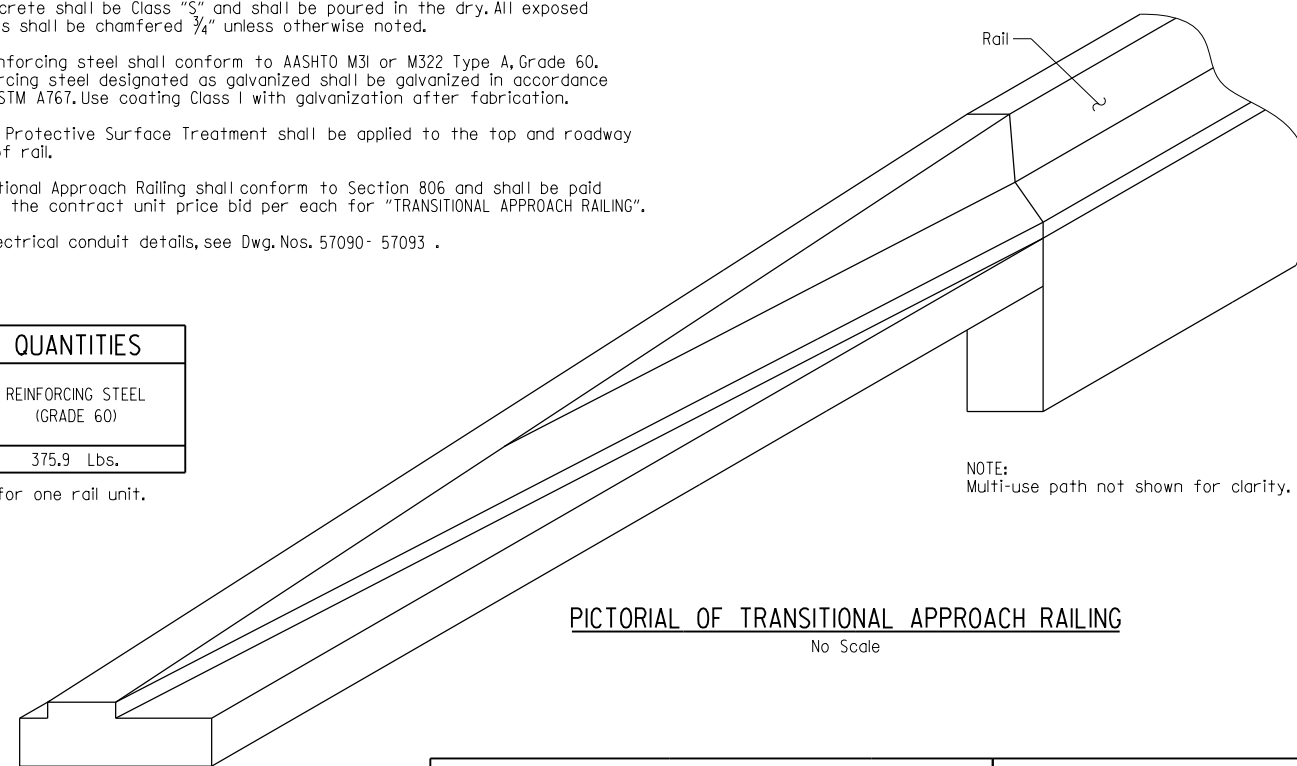

**PICTORIAL OF TRANSITIONAL APPROACH RAILING**

No Scale

NOTE:  
Multi-use path not shown for clarity.

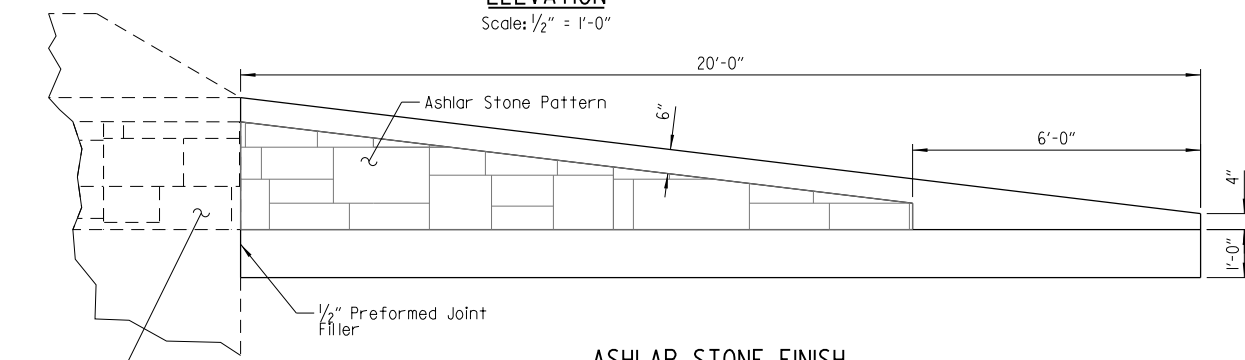


**ASHLAR STONE FINISH**

(Looking At Back Face)  
Scale: 1/2" = 1'-0"

**BAR LIST - PER TRANSITIONAL RAIL**


MARK	NO. REQ'D	LENGTH	"A"	"B"	P.D.
F401	8	19'-8"			Str.
F402	40	3'-8"			Str.
R401	2	4'-9"	1'-2"	1'-0 1/2"	2"
R402	2	19'-9"			Str.
R403	1	18'-3"			Str.
R404	1	5'-0"			Str.
R405	1	12'-10"			Str.
R406	12	6'-2"			2"
R407 To R417	1 Ea.	3'-1" To 5'-5"	1'-3" To 2'-5"	1'-3" To 2'-5"	2"
R418 To R423	1 Ea.	3'-8 1/2" To 5'-0"	1'-4" To 1'-1"	3" To 1 1/2"	2"
R424	2	12'-10"			Str.

**BAR BENDING DIAGRAMS**

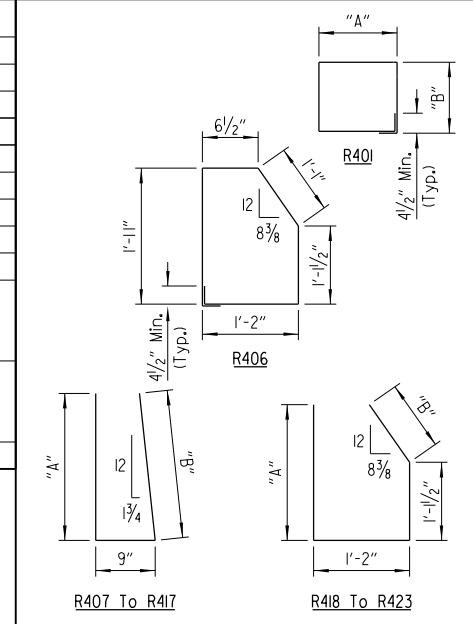


NOTE:  
Number of bars shown is for one transitional approach rail only.

NOTE:  
Dimensions of bars in bending diagrams are out-to-out.

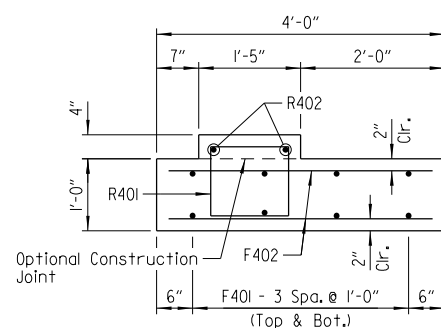


**VIEW A-A**

Scale: 3/4" = 1'-0"

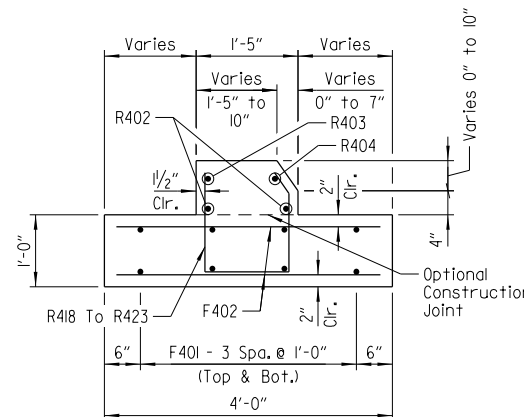


**SECTION B-B**

Scale: 3/4" = 1'-0"

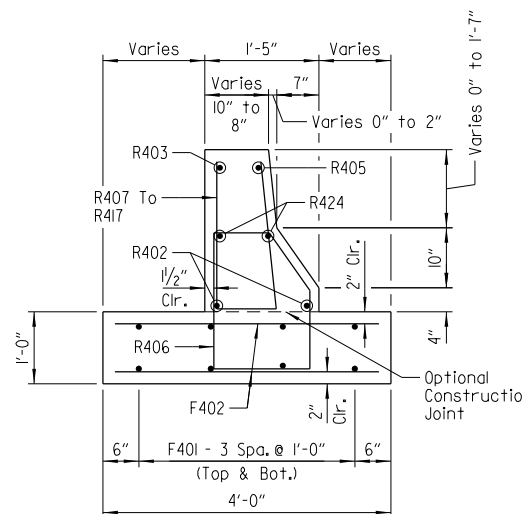

**SECTION C-C**

Scale: 3/4" = 1'-0"

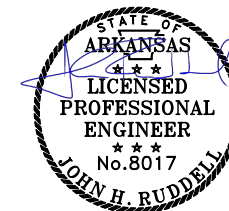


Digitally Signed 05/19/2015  
BRIDGE ENGINEER


**DETAILS OF TRANSITIONAL APPROACH RAILING**  
ROUTE SEC.  
**ARKANSAS STATE HIGHWAY COMMISSION**  
LITTLE ROCK, ARK.

DRAWN BY: DRG DATE: MAR. 2015 FILENAME: B080517\_TR.dgn  
CHECKED BY: JHR DATE: MAY 2015 SCALE: As Shown  
DESIGNED BY: DRG DATE: MAR. 2015  
BRIDGE NO. 07345 DRAWING NO. 57074


DATE REVISED	DATE FILMED	DATE REVISED	DATE FILMED	FED. ROAD DIST. NO.	STATE	FED. AID PROJ. NO.	SHEET NO.	TOTAL SHEETS
				6	ARK.			
						080517	76	182
				07345	INT. BENT DETAILS	57075		

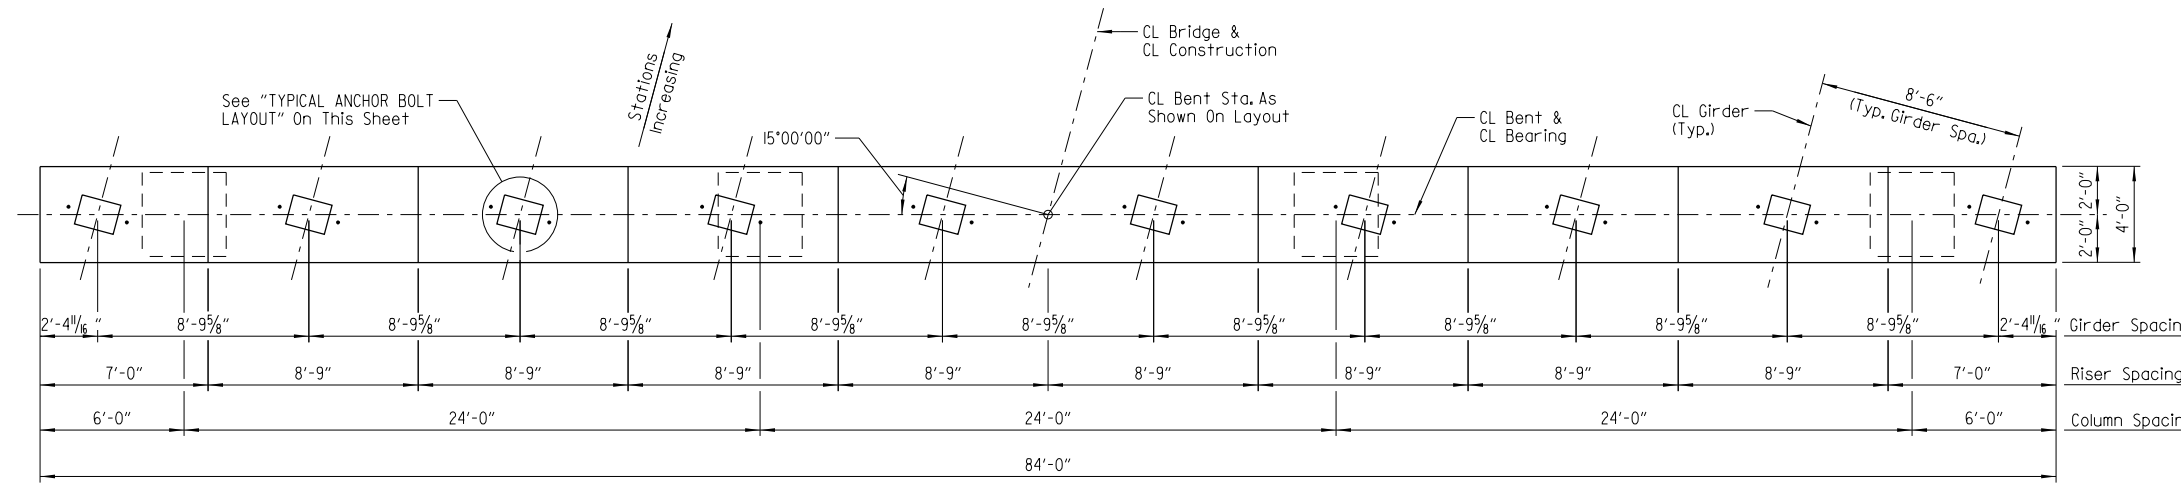


**PLAN**  
Scale: 1/4" = 1'-0"

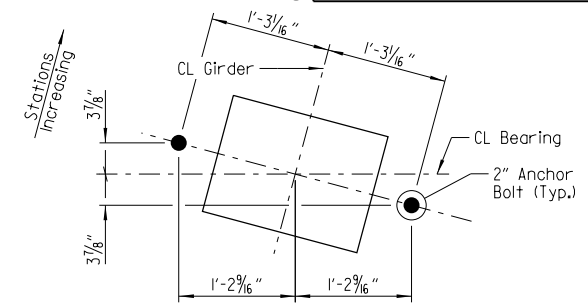

**TYPICAL ANCHOR BOLT LAYOUT**  
Scale: 1" = 1'-0"

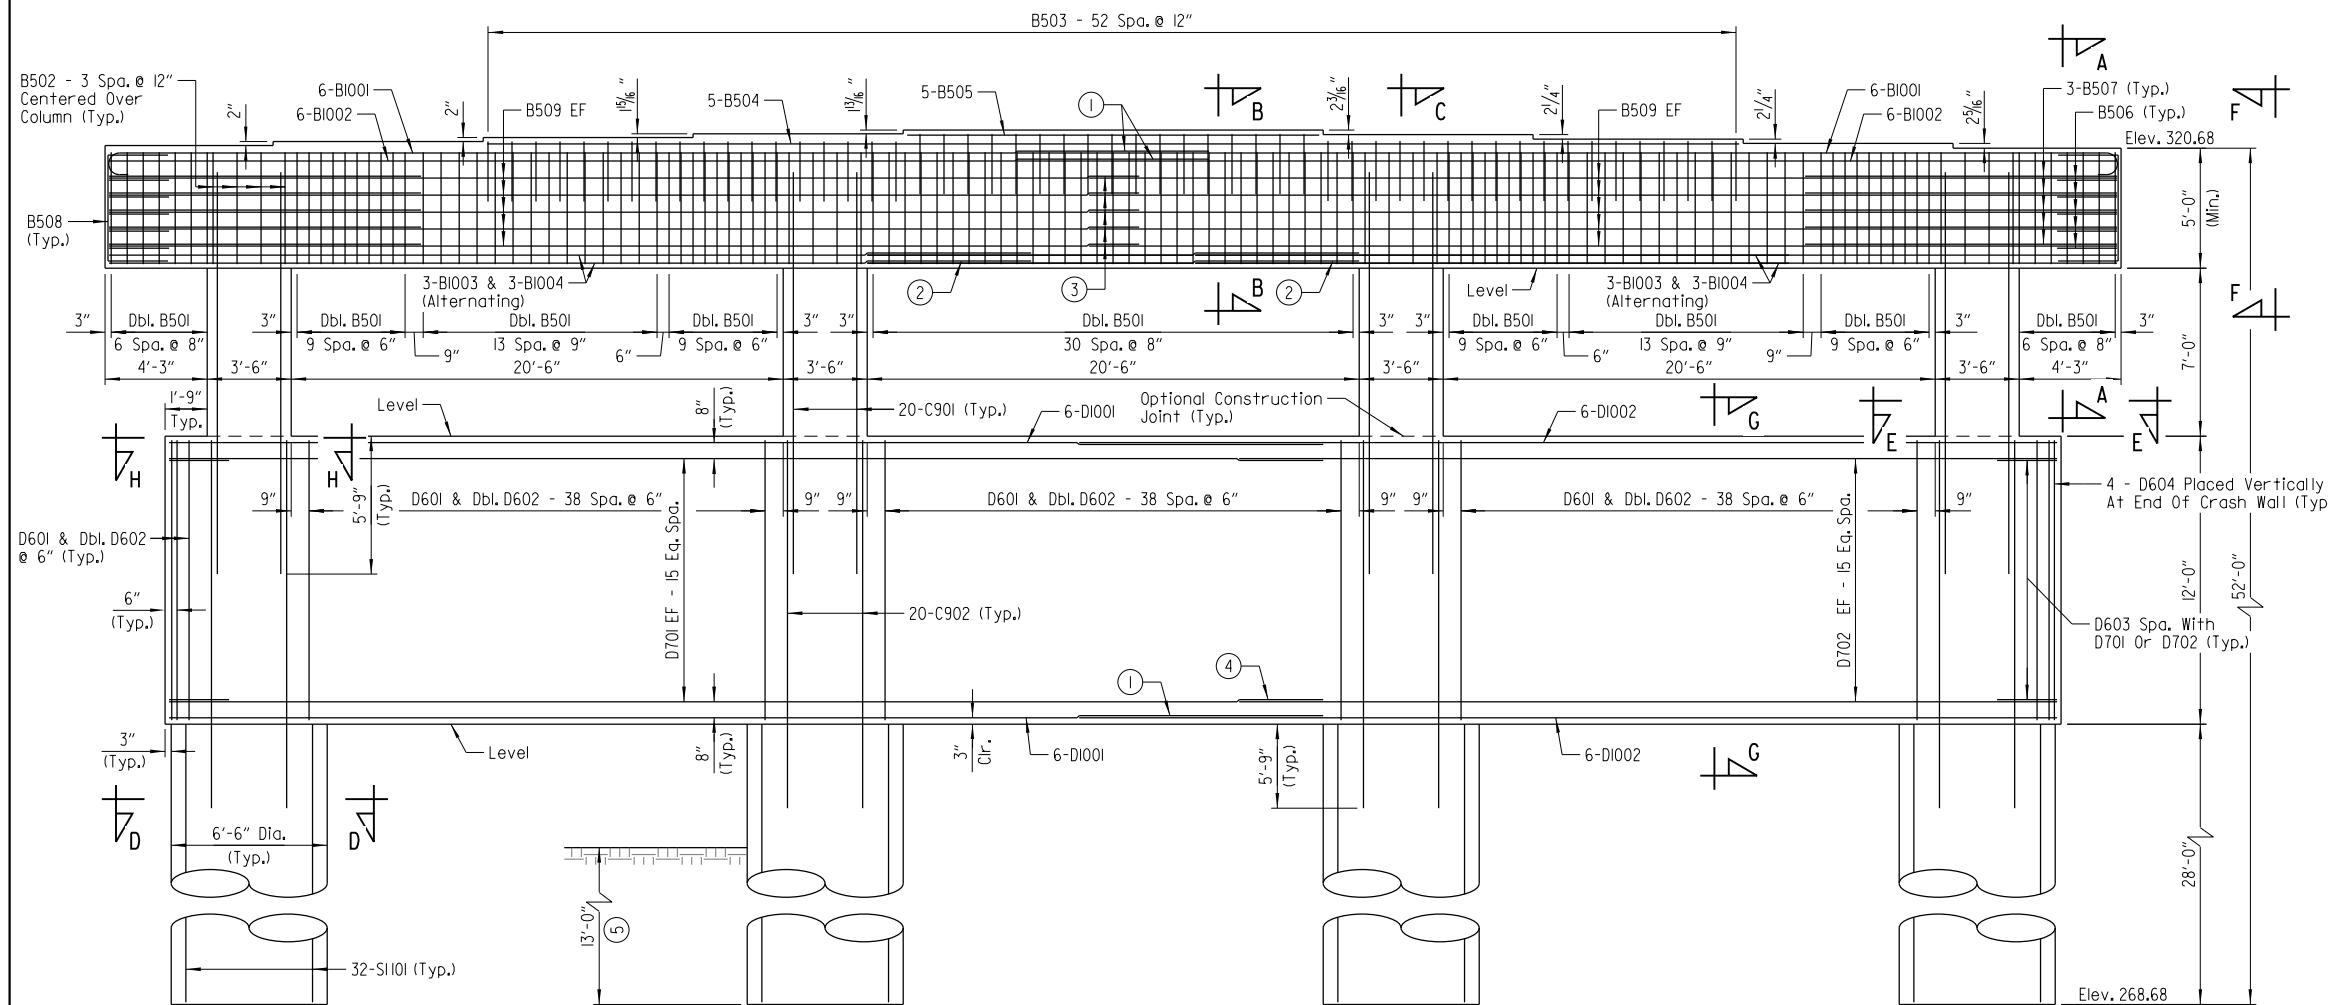

**ELEVATION**  
(Looking Forward)  
Scale: 1/4" = 1'-0"

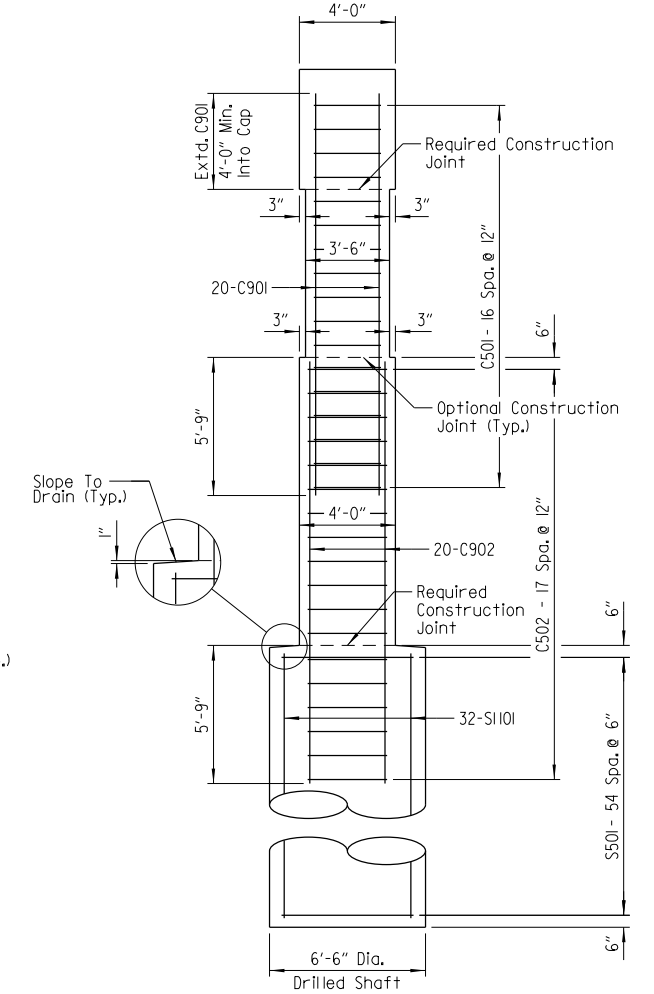

**SECTION C-C**  
Scale: 1/4" = 1'-0"

- ① 10'-2" Min. Lap Splice
- ② 6'-0" Min. Lap Splice
- ③ 2'-2" Min. Lap Splice
- ④ 3'-6" Min. Lap Splice
- ⑤ Minimum penetration into material designated as hard shale on boring legend.

**LEGEND**  
EF = Each Face




Digitally Signed 05/19/2015  
BRIDGE ENGINEER

SHEET 1 OF 3  
DETAILS OF INTERMEDIATE  
BENT NO. 2  
ROUTE SEC.  
ARKANSAS STATE HIGHWAY COMMISSION  
LITTLE ROCK, ARK.


DRAWN BY: HEW DATE: FEB. 2015 FILENAME: B080517\_BI.dgn  
CHECKED BY: JHR DATE: MAR. 2015 SCALE: As Shown  
DESIGNED BY: DRG DATE: JAN. 2015  
BRIDGE NO. 07345 DRAWING NO. 57075

DRGNO. 5/19/2015 1:27:37 PM  
 WORKSPACE: AHTD Bridge  
 L:\2012\201590 - Cantrell Field Access\Drawings\6TH\_ST\B080517\_BI.dgn  
 REVISED DATE:


DATE REVISED	DATE FILMED	DATE REVISED	DATE FILMED	FED. ROAD DIST. NO.	STATE	FED. AID PROJ. NO.	SHEET NO.	TOTAL SHEETS
6-1-15				6	ARK.	080517	77	182
						JOB NO.	07345	INT. BENT DETAILS
								57076

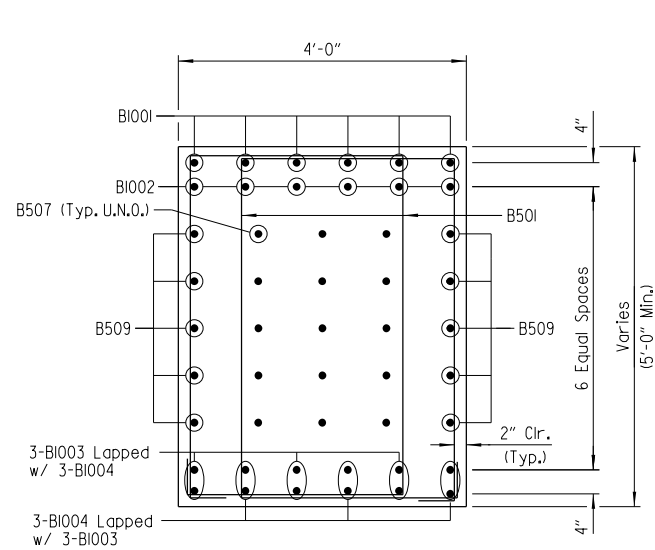

**SECTION A-A**  
Scale: 3/4" = 1'-0"

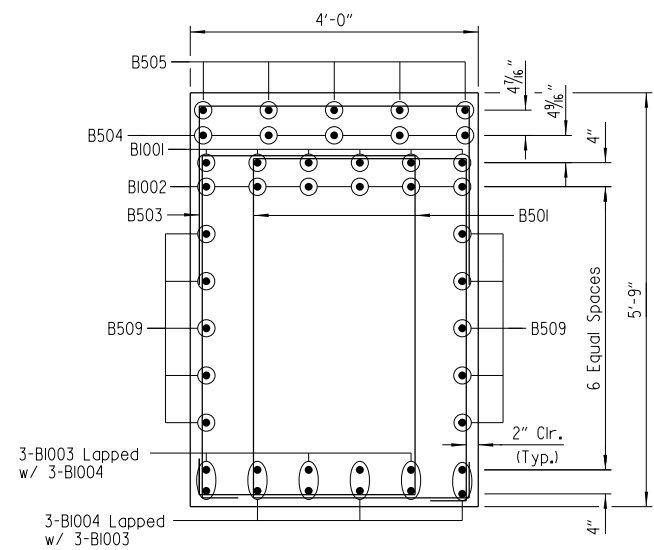


**SECTION B-B**  
Scale: 3/4" = 1'-0"

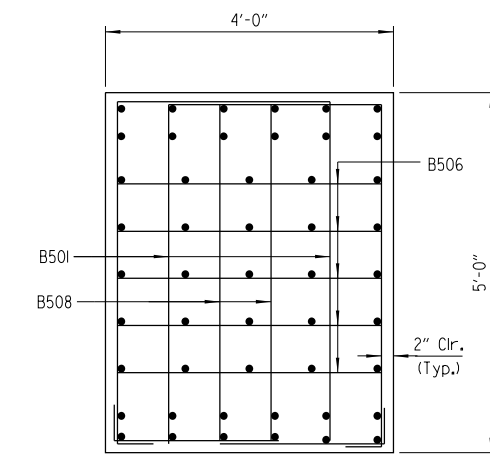

**VIEW F-F**  
Scale: 3/4" = 1'-0"


Revised B501 bar length, DRG 6-1-15.  
Checked by JHR

BAR LIST - PER BENT					
MARK	NO. REQ'D	LENGTH	"A"	"B"	P.D.
B501	226	15'-10"	3'-0"	4'-8"	2 1/2"
B502	16	12'-9"	3'-8"	4'-8"	2 1/2"
B503	53	8'-6"	3'-8"	2'-6"	2 1/2"
B504	5	52'-2"			Str.
B505	5	17'-2"			Str.
B506	10	8'-5"	3'-7"	2'-6"	2 1/2"
B507	30	13'-6"			Str.
B508	4	9'-5"	4'-7"	2'-6"	2 1/2"
B509	20	42'-11"			Str.
B1001	12	48'-4"			10"
B1002	12	46'-9"			Str.
B1003	12	52'-1"			Str.
B1004	12	37'-7"			Str.
C501	68	12'-0"	2'-10"	2'-10"	3 3/4"
C502	72	14'-8"	3'-6"	3'-6"	3 3/4"
C901	80	16'-9"			Str.
C902	80	17'-7"			Str.
D601	121	31'-0"	3'-4"	11'-7"	4 1/2"
D602	242	4'-8"			4 1/2"
D603	32	7'-10"	3'-2"	2'-6"	4 1/2"
D604	8	11'-7"			Str.
D701	32	48'-1"			Str.
D702	32	34'-1"			Str.
D1001	12	48'-1"			Str.
D1002	12	40'-9"			Str.
S501	220	18'-8"			3 3/4"
S1101	128	27'-8"			Str.

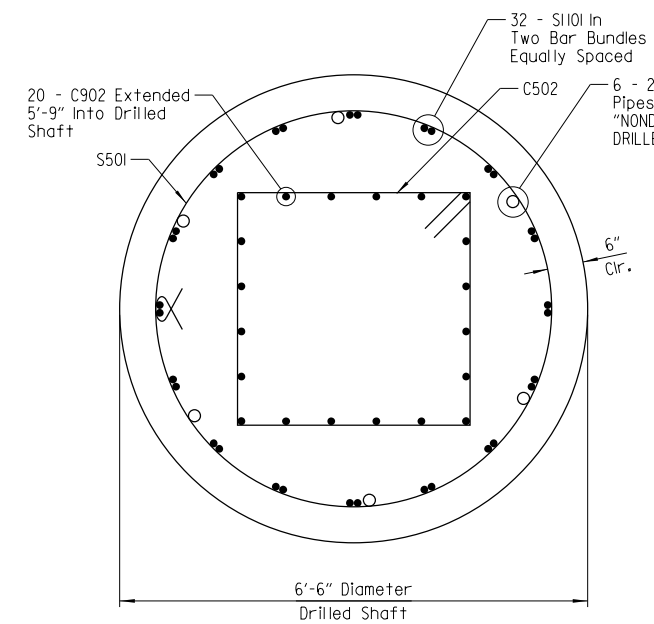


**SECTION D-D**  
Scale: 3/4" = 1'-0"

**LEGEND**  
U.N.O. = Unless Noted Otherwise

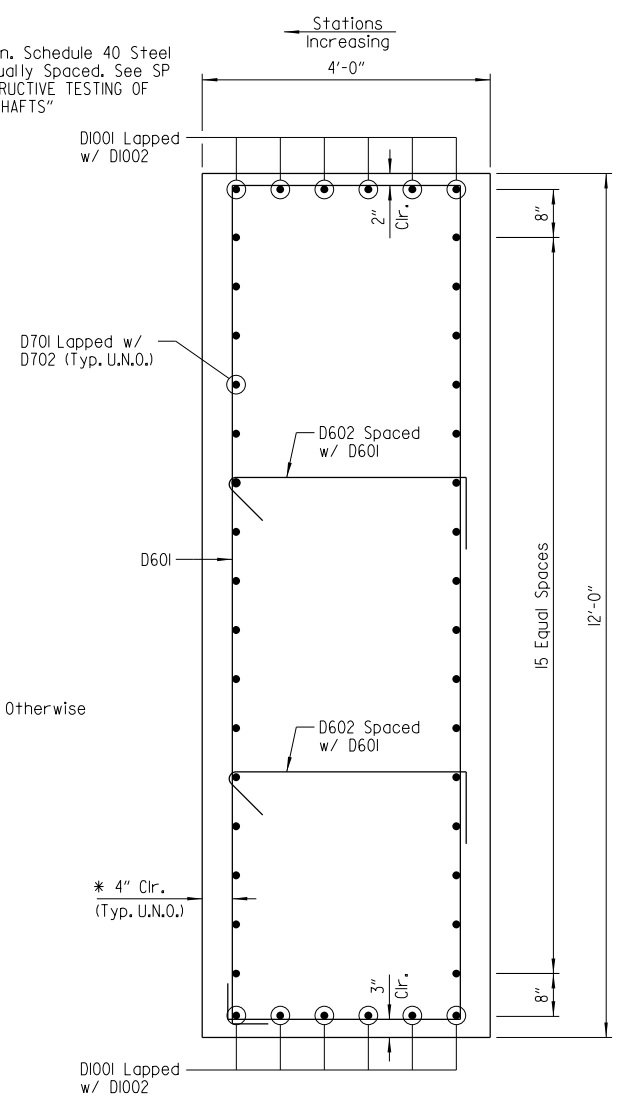

**SECTION G-G**  
Scale: 3/4" = 1'-0"

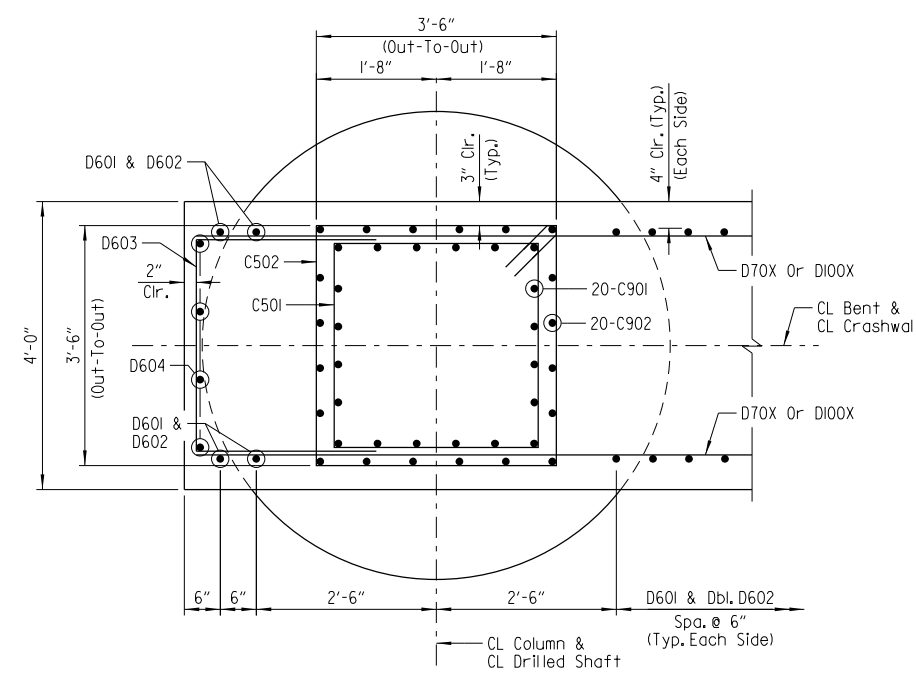

**SECTION H-H**  
Scale: 3/4" = 1'-0"

Non-Pay Item - Subsidiary to SP "DRILLED SHAFT FOUNDATIONS".

**GENERAL NOTES**

All concrete shall be Class "S" with a minimum 28-day compressive strength  $f'_c = 3500$  psi. Concrete shall be poured in the dry and all exposed corners shall be chamfered 3/4" unless otherwise noted.


All reinforcing steel shall conform to AASHTO M31 or M322 Type A, Grade 60 (Yield Strength = 60,000 psi) except as noted otherwise.

Reinforcing bars in top of cap shall be properly placed to avoid interference with anchor bolts or sheet metal sleeves.

Concrete and reinforcing steel in drilled shafts will not be paid for directly but will be included in the unit price of "DRILLED SHAFT (78" Dia.)".

For construction methods, materials, measurement and payment of drilled shafts, see SP "DRILLED SHAFT FOUNDATIONS".

For additional information, see Layout.

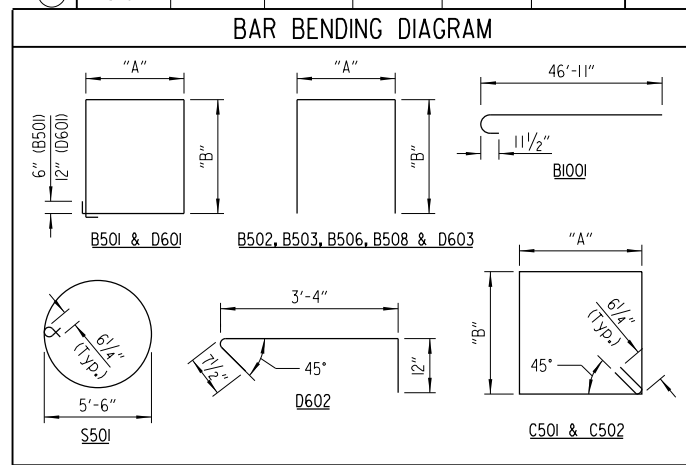

NOTE: Dimensions of bars are out-to-out.




SHEET 2 OF 3  
DETAILS OF INTERMEDIATE BENT NO. 2  
ROUTE SEC.  
ARKANSAS STATE HIGHWAY COMMISSION  
LITTLE ROCK, ARK.


DRAWN BY: HEW DATE: FEB. 2015 FILENAME: B080517\_B2.dgn  
CHECKED BY: JHR DATE: MAR. 2015 SCALE: As Shown  
DESIGNED BY: DRG DATE: JAN. 2015  
BRIDGE NO. 07345 DRAWING NO. 57076

DRGNO: 6/1/2015 12:39 PM  
 WORKSPACE: AHTD Bridge  
 L:\2012\201590 - CentrellField Access\Drawings\6TH\_ST\B080517\_B2.dgn  
 REVISED DATE:


DATE REVISED	DATE FILMED	DATE REVISED	DATE FILMED	FED. ROAD DIST. NO.	STATE	FED. AID PROJ. NO.	SHEET NO.	TOTAL SHEETS
				6	ARK.			
				JOB NO.		080517	78	182
				07345	INT. BENT DETAILS			57077

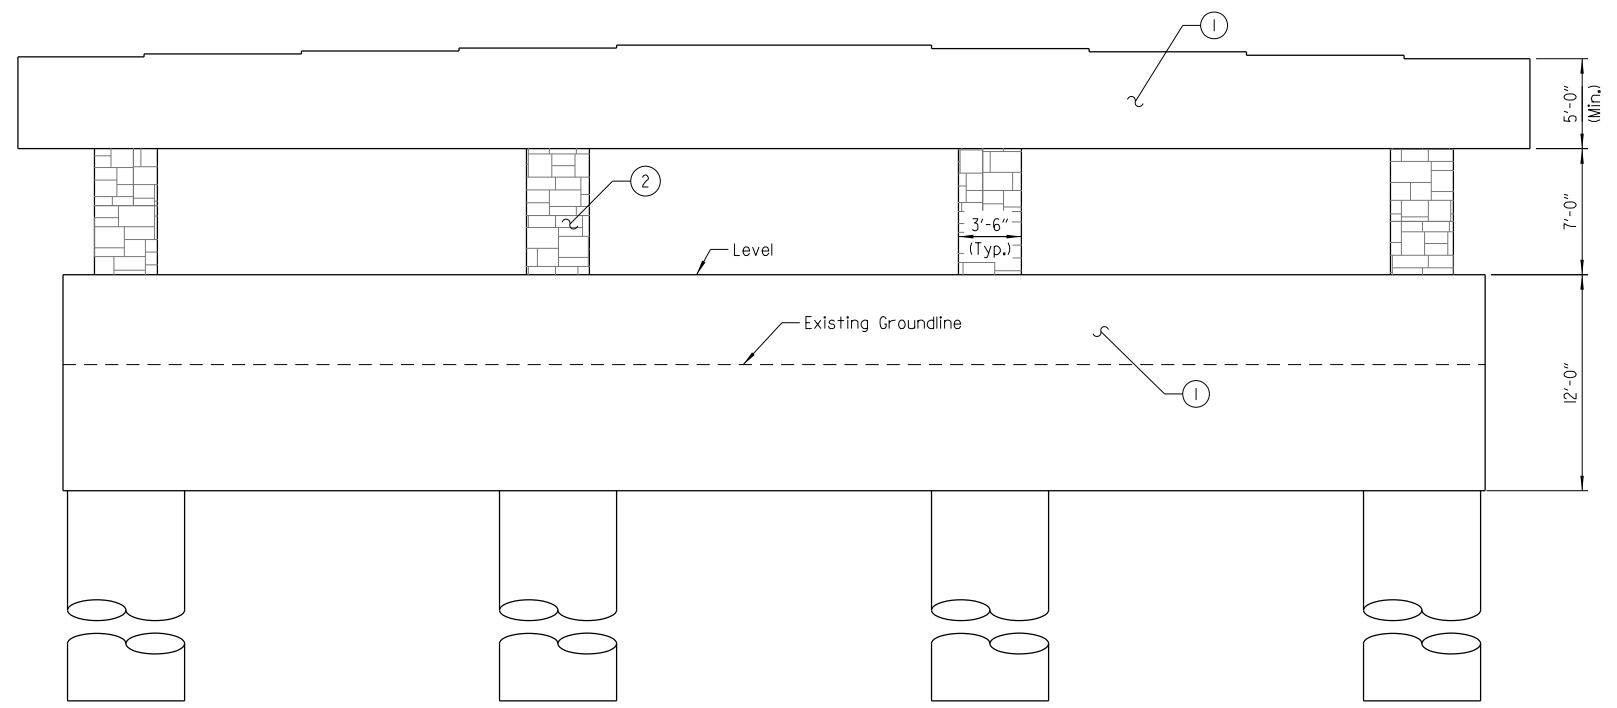

**ELEVATION**  
(Looking Forward)  
Scale: 3/16" = 1'-0"

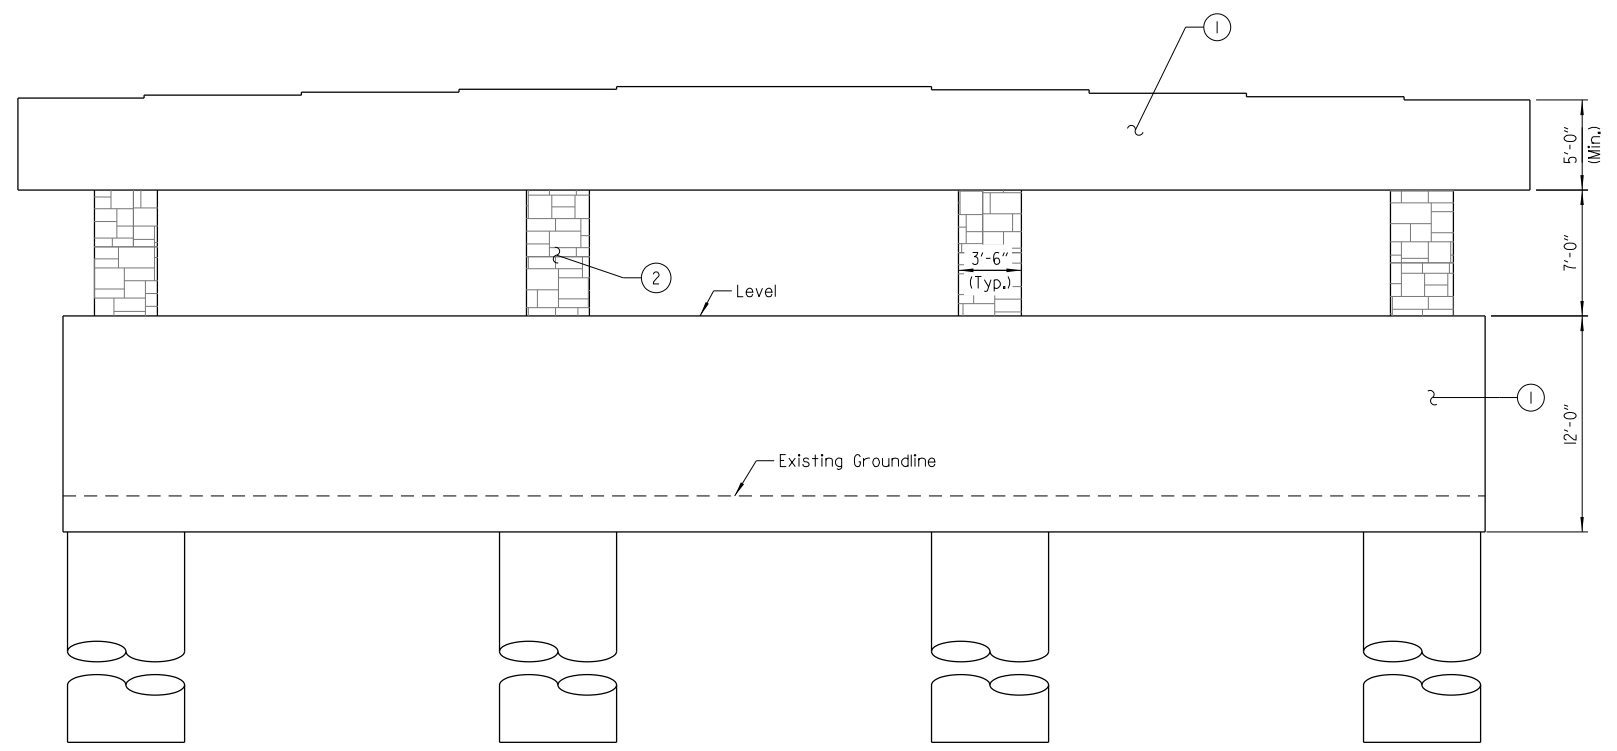


**ELEVATION**  
(Looking Back)  
Scale: 3/16" = 1'-0"

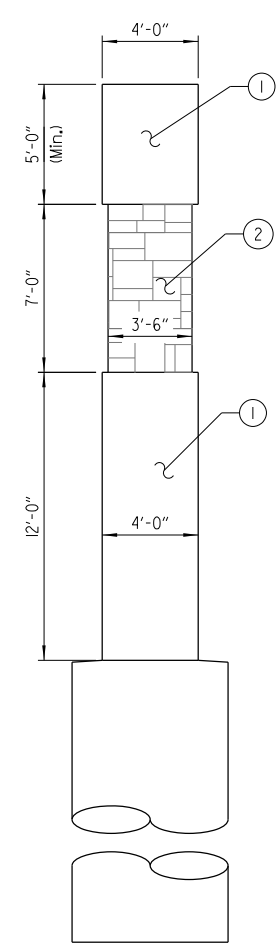

**ELEVATION**  
(Side View)  
Scale: 1/4" = 1'-0"

- ① Class 3 Textured Coating Finish  
(Color = Brown, Color Chip No. 33522)
- ② "Ashlar Stone" Pattern &  
Class 3 Textured Coating Finish  
(Color = Brown, Color Chip No. 30219)

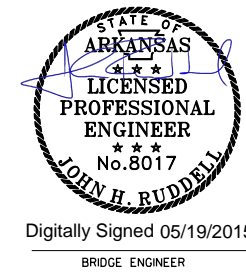

SHEET 3 OF 3  
DETAILS OF INTERMEDIATE  
BENT NO. 2  
ROUTE SEC.  
ARKANSAS STATE HIGHWAY COMMISSION  
LITTLE ROCK, ARK.  
DRAWN BY: DRG DATE: MAR. 2015 FILENAME: B080517\_B3.dgn  
CHECKED BY: JHR DATE: MAR. 2015 SCALE: As Shown  
DESIGNED BY: DRG DATE: JAN. 2015  
BRIDGE NO. 07345 DRAWING NO. 57077


DRG04D 5/19/2015 1:27:46 PM  
 WORKSPACE: AHTD Bridge  
 L:\2012\201590 - Centrefield Access\Drawings\6TH\_ST\B080517\_B3.dgn  
 REVISED DATE:

DATE REVISED	DATE FILMED	DATE REVISED	DATE FILMED	FED. ROAD DIST. NO.	STATE	FED. AID PROJ. NO.	SHEET NO.	TOTAL SHEETS
				6	ARK.			
				JOB NO.		080517	79	182
				07345		PL GIRDER UNIT		57078

- ① Measured to Working Point, see "ROUNDING DETAIL"
- ② See "ADJUSTMENT FOR SLAB THICKNESS TOLERANCE WHEN REMOVABLE DECK FORMING IS USED".
- ③ 16'-6" total width established to accommodate future planters and 10'-0" shared use path. See "PLANTER ACCOMMODATION" on this sheet.
- ④ Widened parapet to accommodate form liner and metal bridge railing. See Dwg. Nos. 57085 - 57086.


Note:  
Class 1 Protective Surface Treatment shall be applied to the roadway surface and sidewalk surface. Class 3 texture coating finish shall be applied to areas as specified in SP "TEXTURED COATING FINISH".

Note:  
The superstructure details shown are for use when removable deck forming is used and are the basis for measurement of concrete included in the item "BRIDGE CONSTRUCTION".

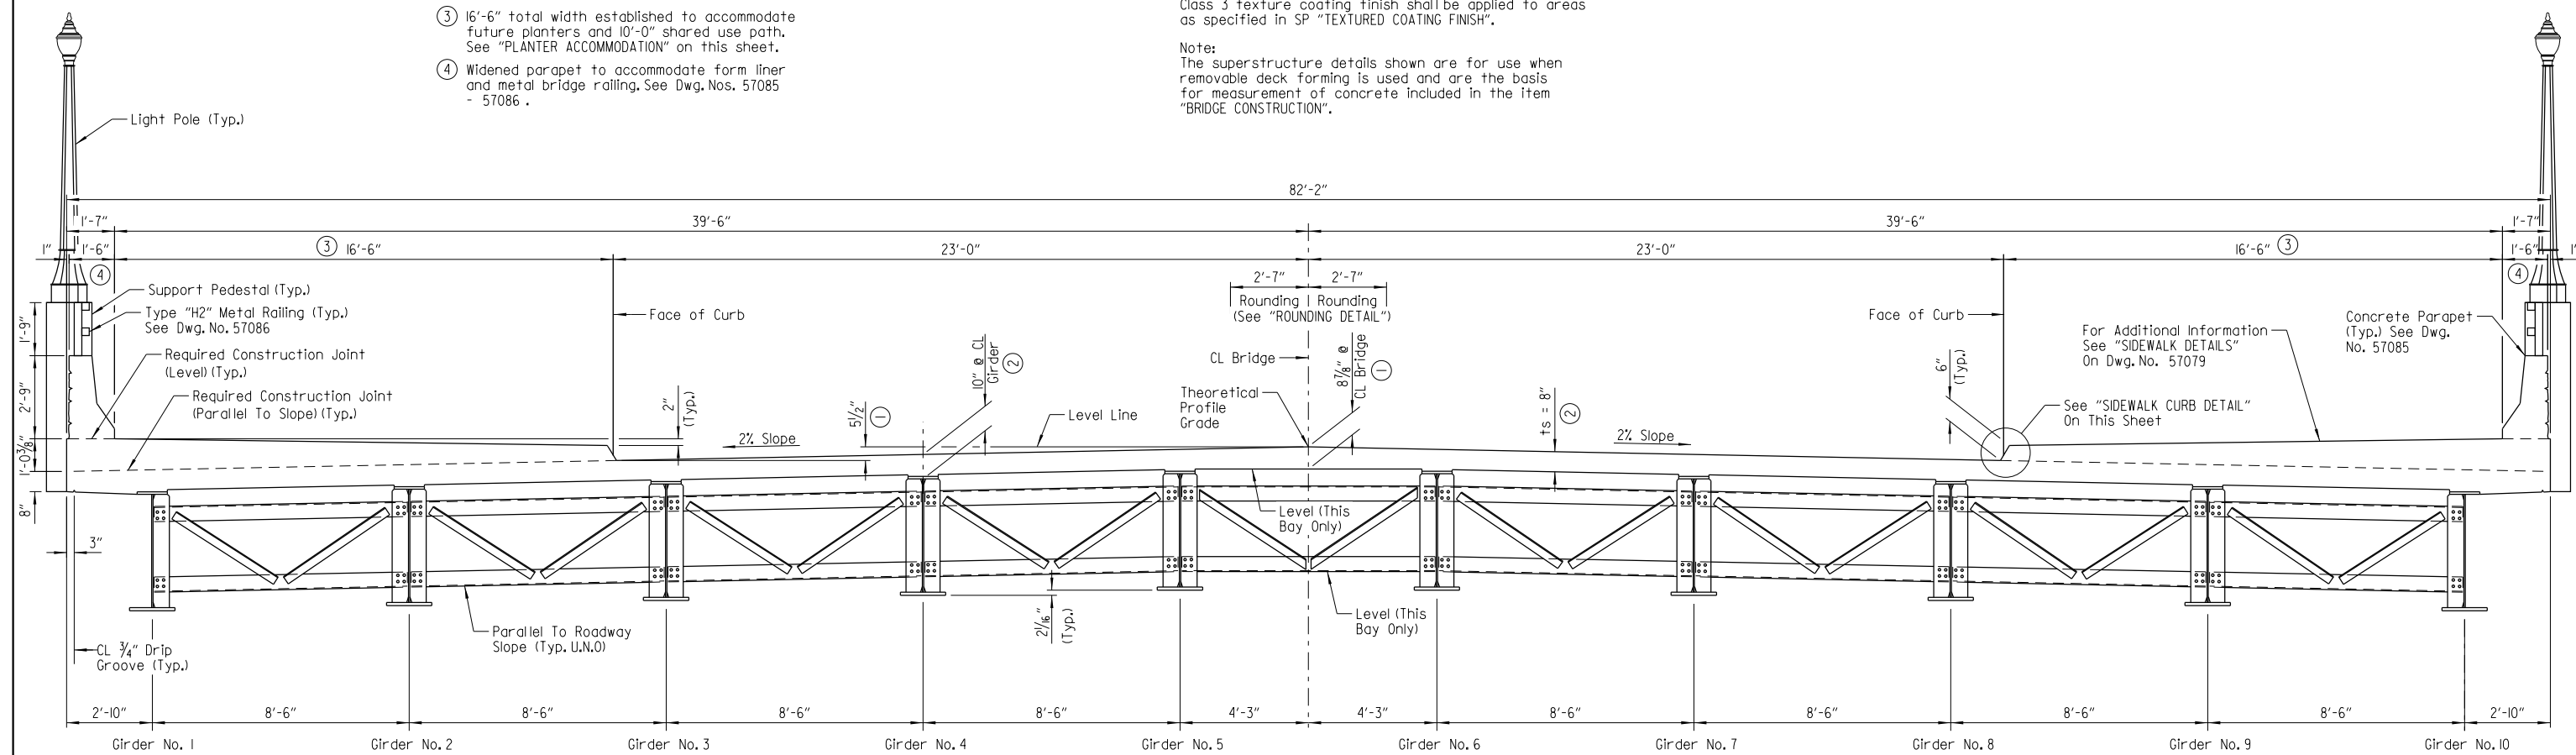

Note:  
For slab reinforcing details, see Dwg. No. 57079.

**TYPICAL SECTION**  
(Showing Overall Dimensions)  
Scale: 3/8" = 1'-0"

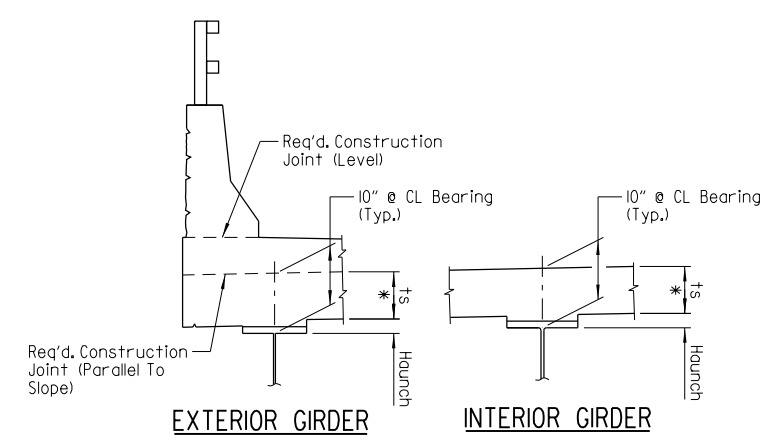


Note:  $t_s$  = Slab Thickness as shown on "TYPICAL SECTION".  
\* Tolerance when removable deck forming is used is  $+1/2"$ ,  $-1/4"$ . Haunch forming is required and shall be adjusted to maintain slab thickness tolerance.


**ADJUSTMENT FOR SLAB THICKNESS TOLERANCE WHEN REMOVABLE DECK FORMING IS USED**  
Scale: NTS

Haunch dimension may vary within the following limits to maintain the grade and slab thickness tolerance; minimum - occurs when the top flange contacts the bottom reinforcing steel; maximum - top flange thickness plus  $1/4"$ . No increase in concrete and structural steel quantities will be made to maintain tolerances.

Tolerances shown are applicable only when removable deck forming is used. See Std. Dwg. No. 55005 for tolerances when permanent steel deck forms are used. Payment for concrete shall be based on removable deck forming.

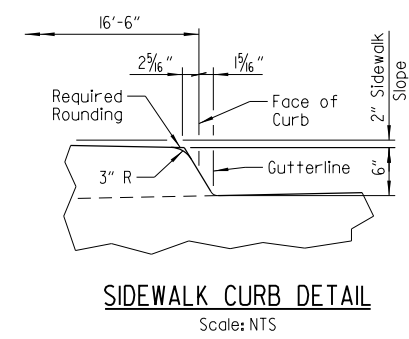


**SIDEWALK CURB DETAIL**  
Scale: NTS

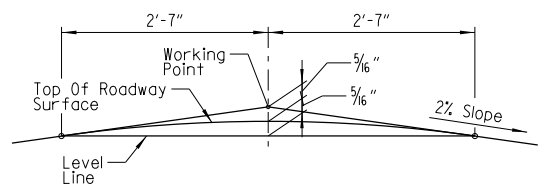

Note:  
Working Point matches Theoretical Profile Grade.

**ROUNDING DETAIL**  
Scale: NTS

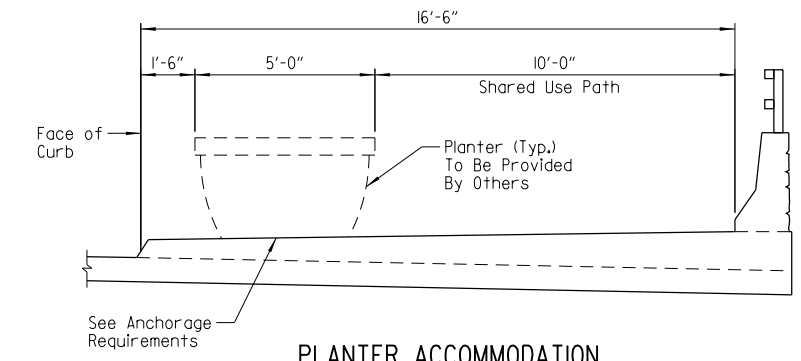

**PLANTER ACCOMMODATION**  
Scale: 3/8" = 1'-0"

The bridge has been designed to accommodate the loading associated with a 5' diameter 4' tall planter spaced at 25'-0" along the length of the bridge.

Anchorage Requirements:  
If the empty weight of the planter is less than 250 pounds, the planter shall be connected to the deck to the satisfaction of the Engineer.




Digitally Signed 05/19/2015  
BRIDGE ENGINEER

SHEET 1 OF 11  
DETAILS OF 212'-0" CONTINUOUS  
COMPOSITE PLATE GIRDER UNIT  
ROUTE SEC.  
ARKANSAS STATE HIGHWAY COMMISSION  
LITTLE ROCK, ARK.

DRAWN BY: HEW DATE: FEB. 2015 FILENAME: B080517\_Sl.dgn  
CHECKED BY: DRG DATE: MAR. 2015 SCALE: As Shown  
DESIGNED BY: JHR DATE: FEB. 2015  
BRIDGE NO. 07345 DRAWING NO. 57078

DRGNO: 5/19/2015 1:27:46 PM  
 WORKSPACE: AHTD Bridge  
 L:\2012\201590 - CentrellField Access\Drawings\6TH\_ST\B080517\_Sl.dgn  
 REVISED DATE:

DATE REVISED	DATE FILMED	DATE REVISED	DATE FILMED	FED. ROAD DIST. NO.	STATE	FED. AID PROJ. NO.	SHEET NO.	TOTAL SHEETS
				6	ARK.			
				JOB NO.		080517	80	182
				07345		PL GIRDER UNIT		57079

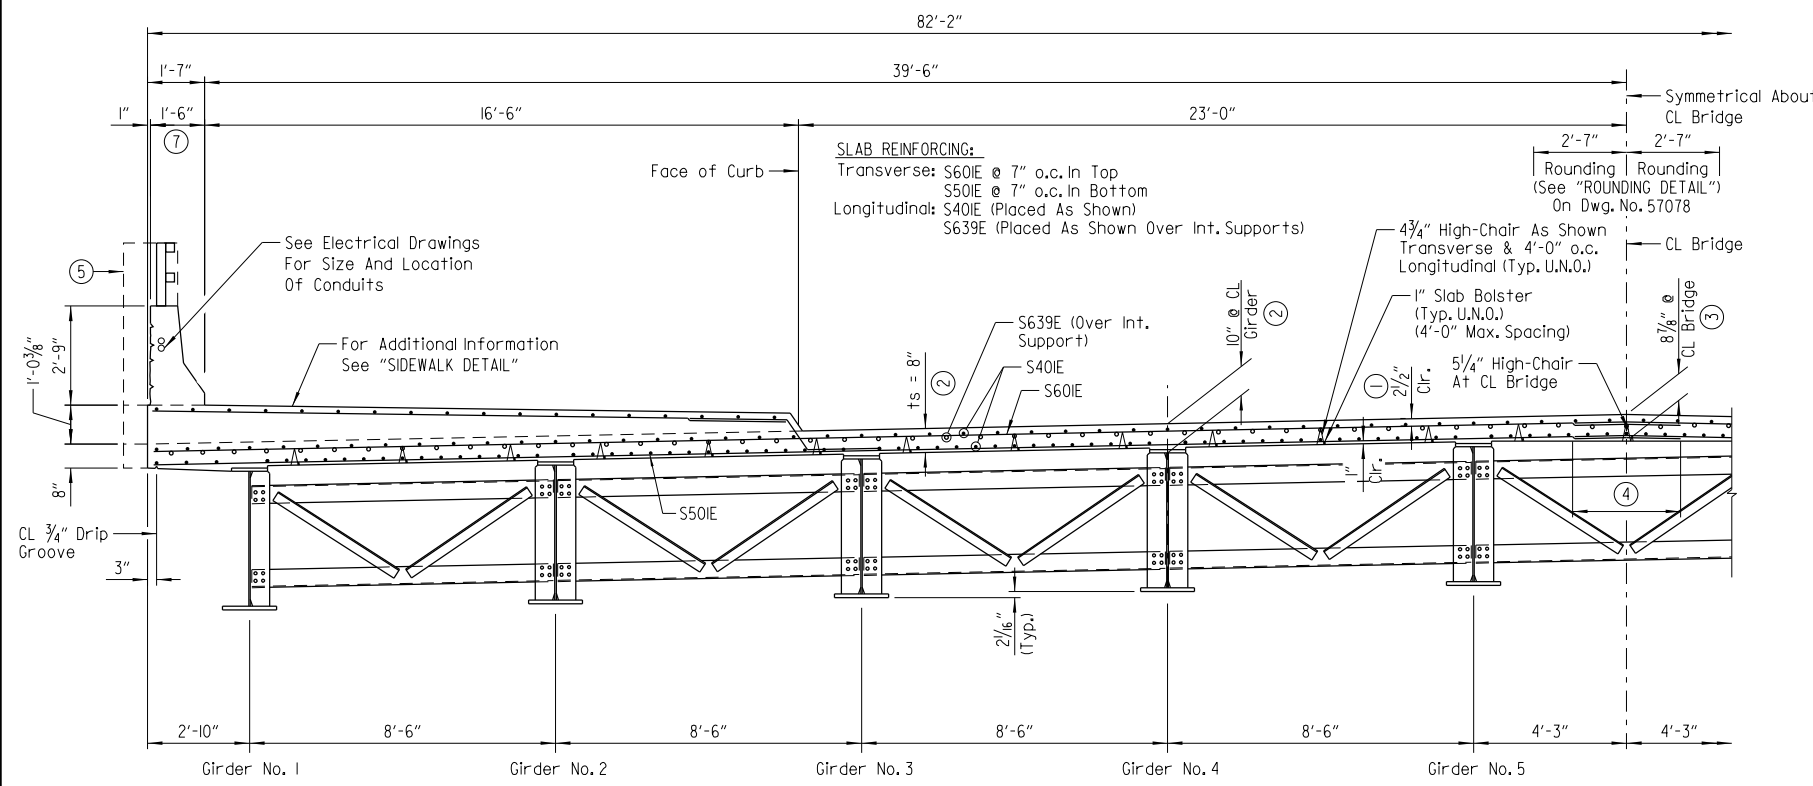

**HALF SECTION - SHOWING DECK REINFORCING**  
(Looking Ahead)  
Scale: 3/8" = 1'-0"


**LEGEND**

U.N.O. = Unless Noted Otherwise

① **TOLERANCE:**  
Minus = 1/4"  
Plus = Amount of slab thickening used to meet slab thickness tolerance - See "ADJUSTMENT FOR SLAB THICKNESS TOLERANCE WHEN REMOVABLE DECK FORMING IS USED" on Dwg. No. 57078


② See "ADJUSTMENT FOR SLAB THICKNESS TOLERANCE WHEN REMOVABLE DECK FORMING IS USED" on Dwg. No. 57078.  
③ Measured to Working Point, see "ROUNDING DETAIL" on Dwg. No. 57078.  
④ 3'-3" min. lap - #5  
3'-10" min. lap - #6

⑤ Support pedestal, see details on Dwg. No. 57085.  
⑥ Trim vertical leg of split channel as required.  
⑦ Widened parapet to accommodate form liner and metal bridge railing. See Dwg. Nos. 57085 - 57086.

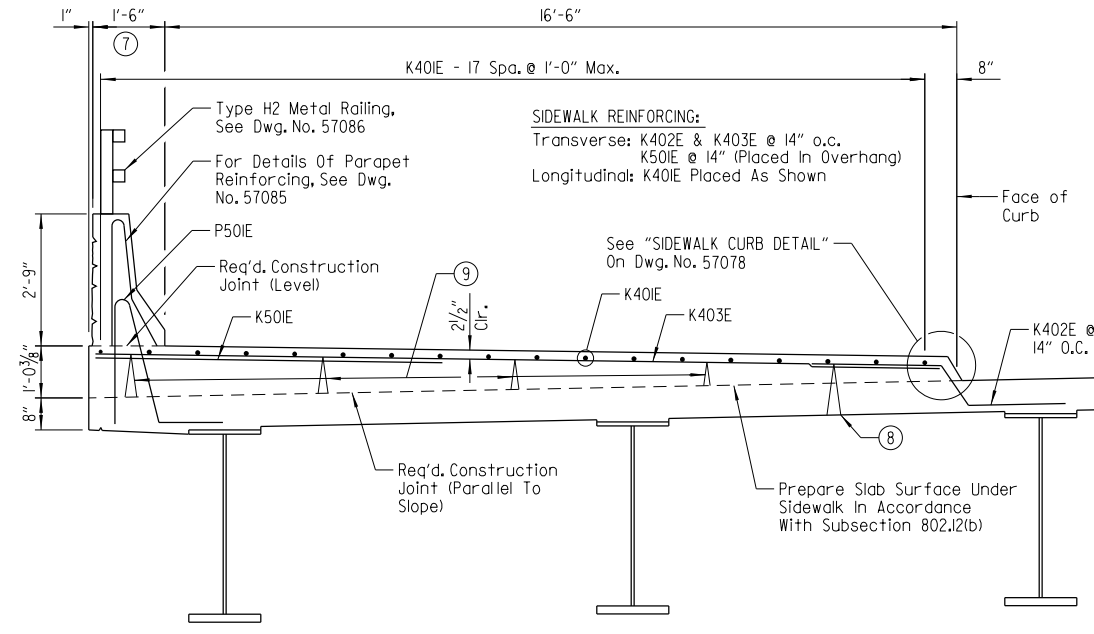

**SIDEWALK DETAIL**  
Scale: 1/2" = 1'-0"


⑧ 1 1/2" Highchair @ 4'-0" o.c. long.  
⑨ Unless noted otherwise height of hi-chairs in sidewalk areas shall be set as necessary to maintain 2 1/2" clear cover to top transverse bars. Space as shown transverse (4'-0" max.) and 4'-0" o.c. long.

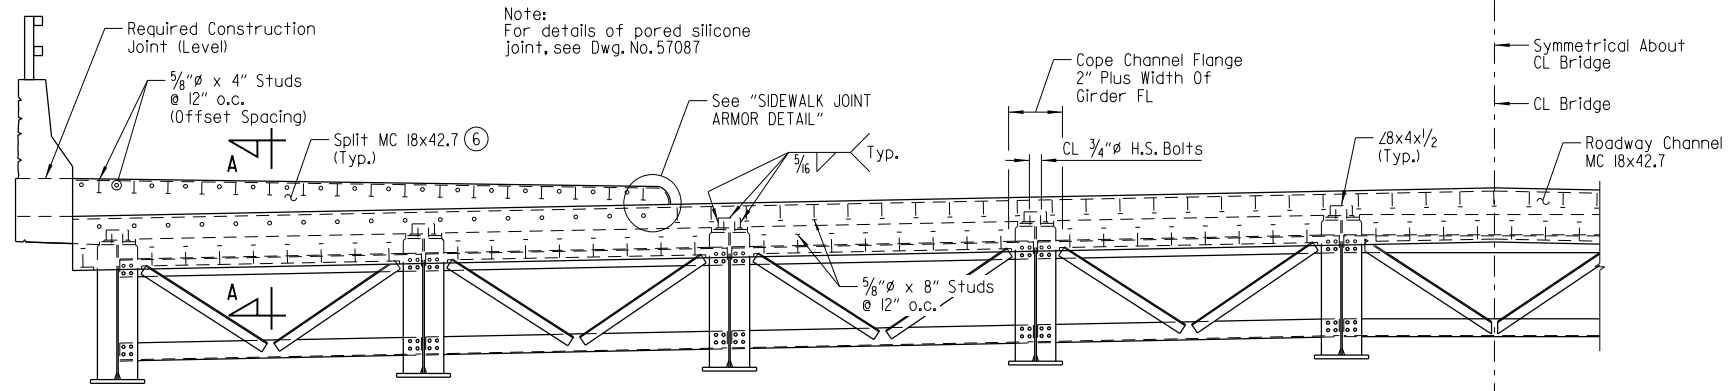

**TYPICAL SECTION THRU JOINT**  
(Looking Ahead)  
Scale: NTS


Note:  
For "SECTION A-A", See Dwg. No. 57087

**EXPANSION DEVICE:**  
Rdwy. Channel MC18x42.7  
Conn. Angles L8"x4"x1/2"  
Detail Device 1/8" High And Provide 1/4" Shims  
Using 2 - 1/16" And 1 - 1/8" Plates

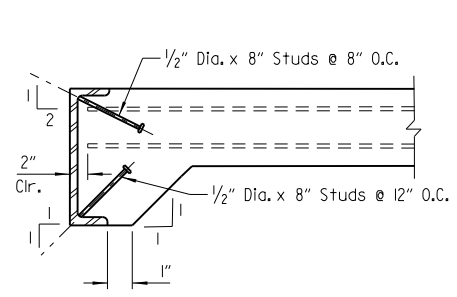


**DETAIL OF ALTERNATE ANCHORS**  
Scale: NTS

Note:  
As an alternate to 5/8" studs, 1/2" x 8" studs spaced as shown may be used. Use weight of 5/8" stud as basis of measurement of structural steel in anchors

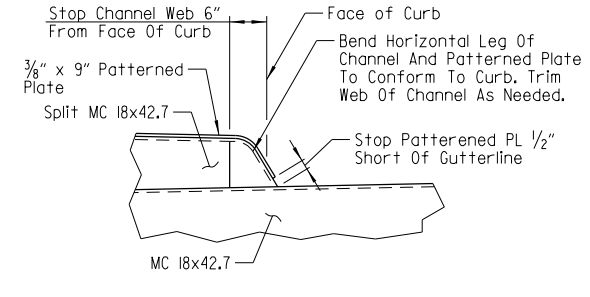

**SIDEWALK JOINT ARMOR DETAIL**  
Scale: NTS

D:\ROAD WORKSPACE\AHTD Bridge\1-2012\201590 - CentrellField Access\Drawings\6TH\_S1\B080517\_S2.dgn  
 5/19/2015 1:27:47 PM  
 REVISED DATE:

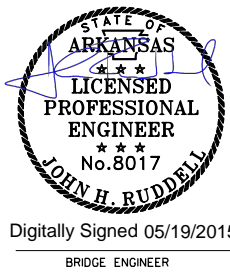


Digitally Signed 05/19/2015

SHEET 2 OF 11  
 DETAILS OF 212'-0" CONTINUOUS  
 COMPOSITE PLATE GIRDER UNIT  
 ROUTE SEC.  
 ARKANSAS STATE HIGHWAY COMMISSION  
 LITTLE ROCK, ARK.  
 DRAWN BY: HEW DATE: FEB. 2015 FILENAME: B080517\_S2.dgn  
 CHECKED BY: DRG DATE: MAR. 2015 SCALE: As Shown  
 DESIGNED BY: JHR DATE: FEB. 2015  
 BRIDGE NO. 07345 DRAWING NO. 57079




DATE REVISED	DATE FILMED	DATE REVISED	DATE FILMED	FED. ROAD DIST. NO.	STATE	FED. AID PROJ. NO.	SHEET NO.	TOTAL SHEETS
				6	ARK.			
				JOB NO.		080517	81	182

07345 PL GIRDER UNIT 57080

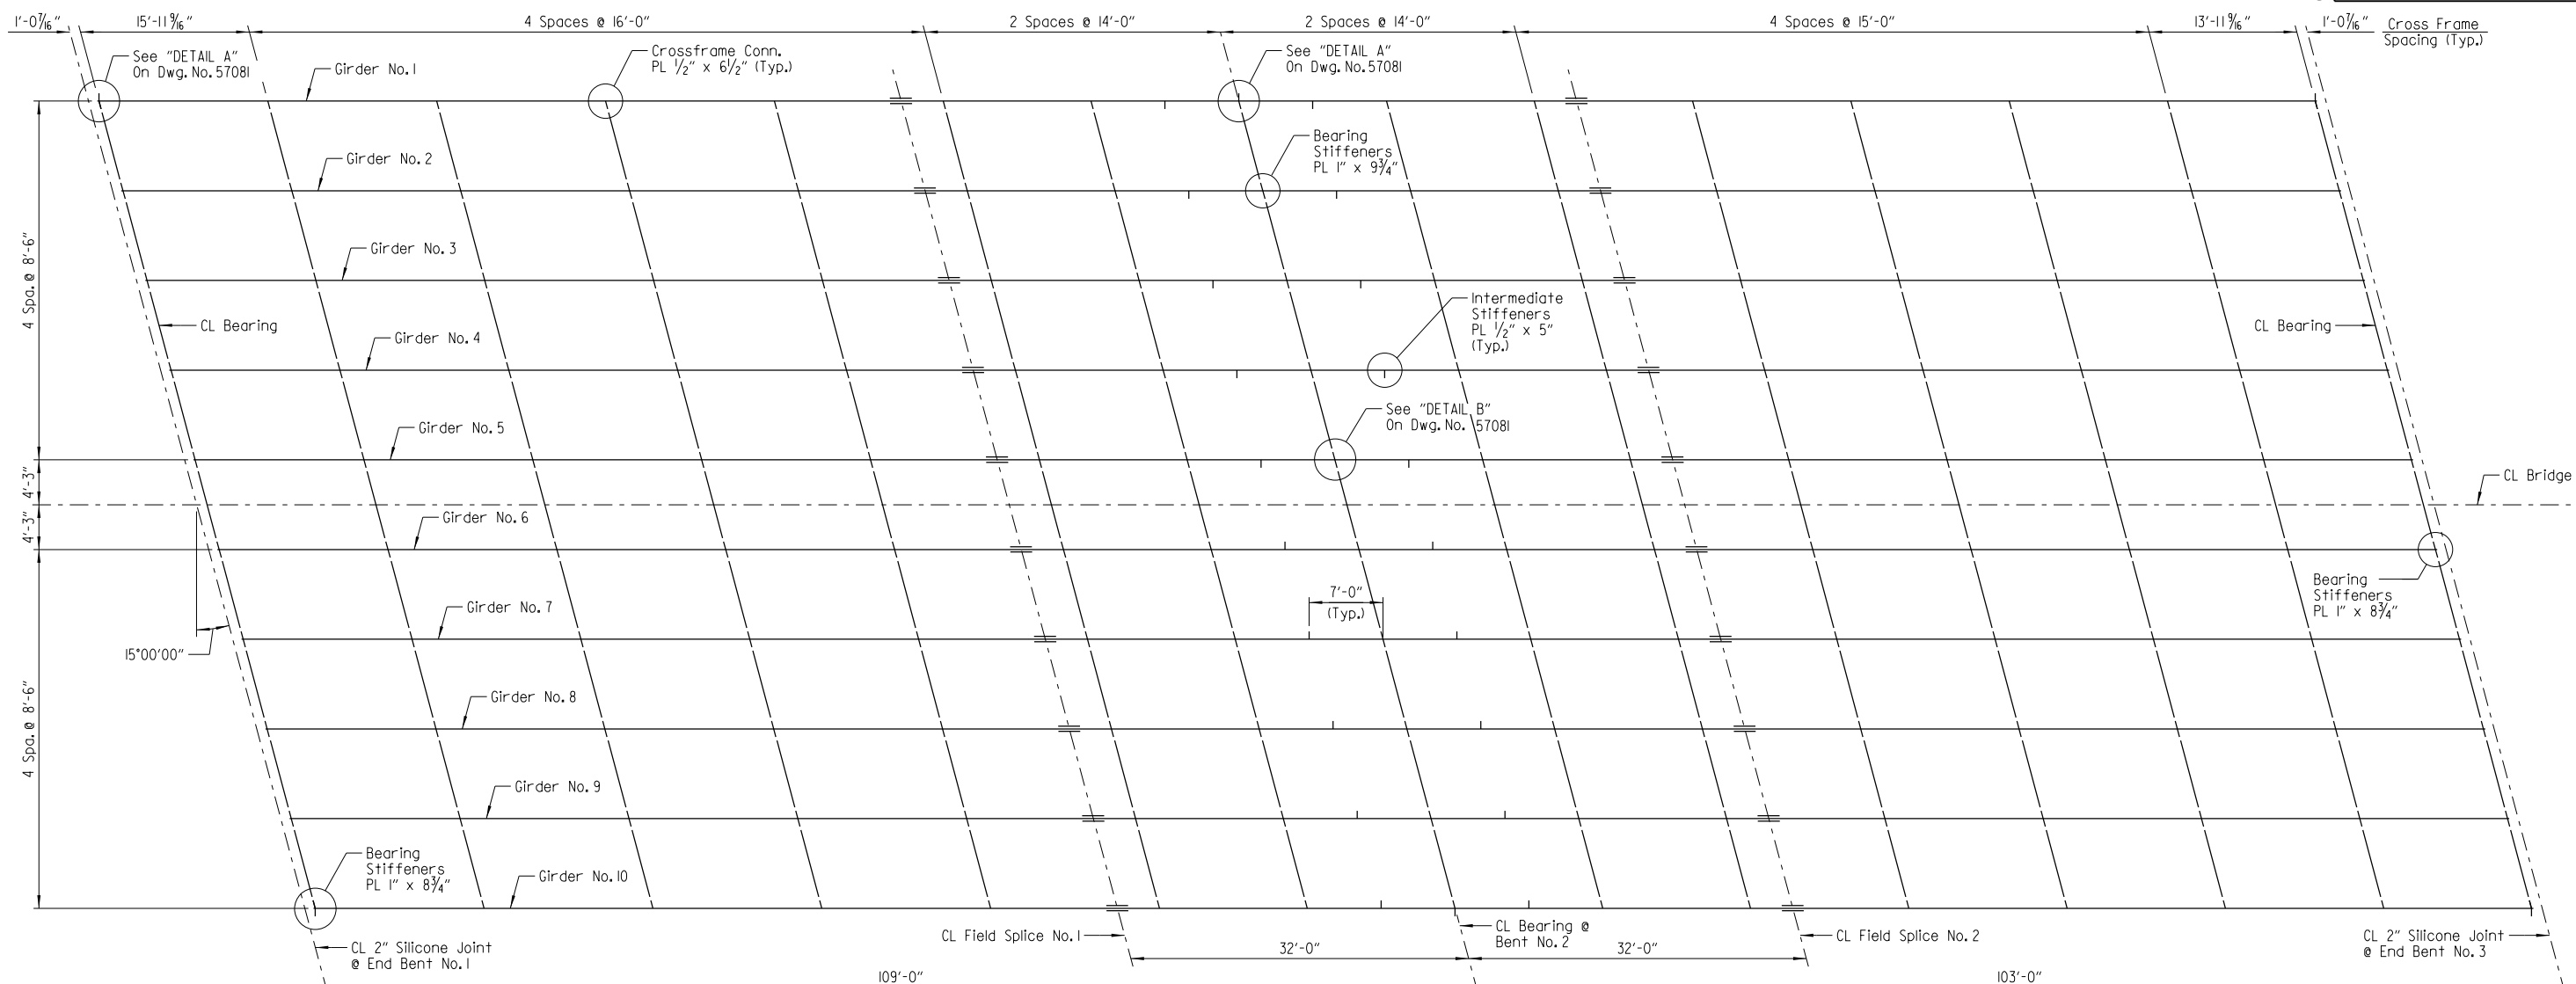

**FRAMING PLAN**  
Scale: 1/8" = 1'-0"

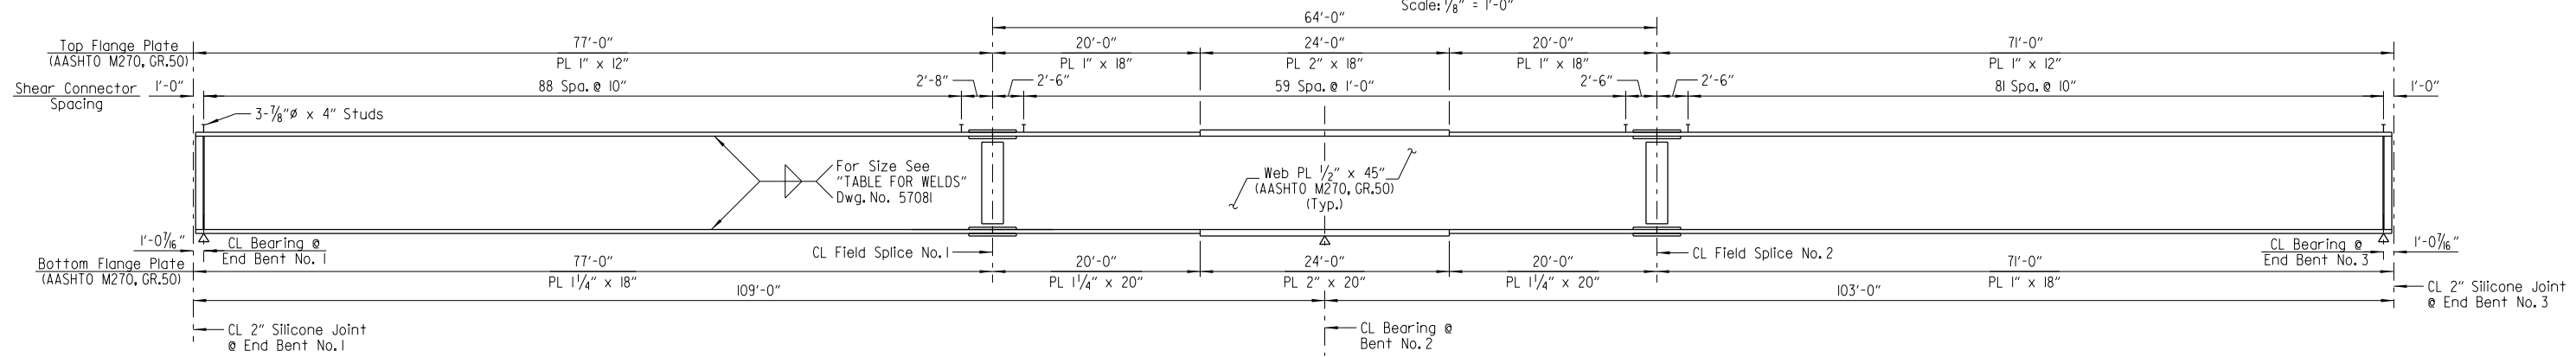

**TYPICAL GIRDER ELEVATION**  
Scale: NTS

Note:  
All crossframe connection plates and bearing stiffeners shall be placed along the skew except as shown for bearing stiffeners on outside face of exterior girder.




Digitally Signed 05/19/2015  
BRIDGE ENGINEER

SHEET 3 OF 11  
DETAILS OF 212'-0" CONTINUOUS COMPOSITE PLATE GIRDER UNIT  
ROUTE SEC.  
ARKANSAS STATE HIGHWAY COMMISSION  
LITTLE ROCK, ARK.


DRAWN BY: HEW DATE: FEB. 2015 FILENAME: B080517\_S3.dgn  
CHECKED BY: DRG DATE: MAR. 2015 SCALE: As Shown  
DESIGNED BY: JHR DATE: FEB. 2015  
BRIDGE NO. 07345 DRAWING NO. 57080

DRGNO: 5/19/2015 1:27:47 PM  
 WORKSPACE: AHTD Bridge  
 L:\2012\201590 - CentrelField Access\Drawings\6TH\_ST\B080517\_S3.dgn  
 REVISED DATE:

DATE REVISED	DATE FILMED	DATE REVISED	DATE FILMED	FED. ROAD DIST. NO.	STATE	FED. AID PROJ. NO.	SHEET NO.	TOTAL SHEETS
				6	ARK.			
						080517	82	182
				07345		PL GIRDER UNIT		57081

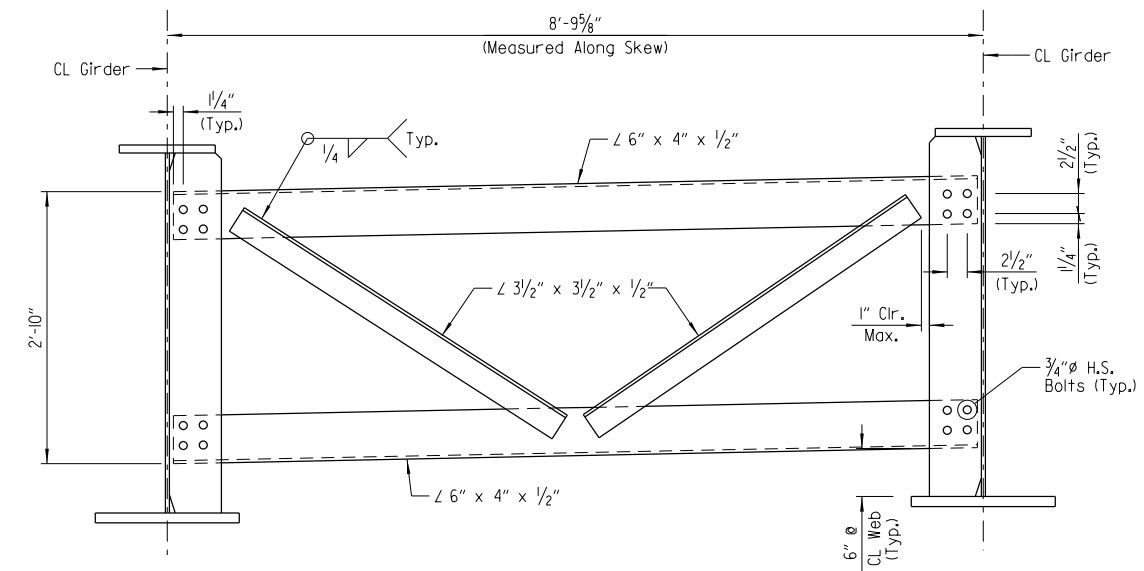

**TYPICAL CROSS-FRAME DETAIL**  
Scale: 1" = 1'-0"

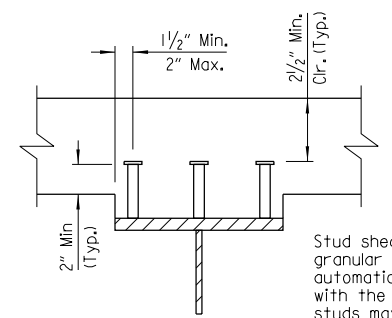


**SHEAR CONNECTOR DETAIL**  
Scale: NTS

Stud shear connectors shown shall be 7/8"  $\phi$  x 4" long, granular flux filled, solid fluxed or equal, and automatically end welded to the flange in accordance with the recommendations of the manufacturer. 3/4"  $\phi$  studs may be used in place of the 7/8"  $\phi$  studs shown, at the ratio of 1.361 - 3/4"  $\phi$  studs in place of one 7/8"  $\phi$  stud. 7/8"  $\phi$  studs will be used as basis for measurement of structural steel in shear connectors.


TABLE FOR WELDS		
Material Thickness Of Thicker Part Joined (Inches)	Minimum Size Of Fillet Weld (Inches)	Single Pass Weld
To 3/4" Inclusive	1/4"	Must Be Used
Over 3/4"	5/16"	

Notes: When a fillet weld size, as shown on the plans, is larger than the minimum, the first pass shall be that specified for minimum size of fillet weld.


- Notes:**
- For "GENERAL NOTES", see Drawing No. 57088
  - All structural steel including girders, cross-frames, bearing stiffeners, web stiffeners and connection plates, shall be AASHTO M270, Grade 50.
  - For elastomeric bearing details, see Drawing No. 57089
  - For details of field splices, see Drawing No. 57082
  - For typical haunch details, see Drawing No. 57078
  - For alternate anchor details, see Drawing No. 57079
  - For "TABLE OF DEAD LOAD DEFLECTIONS", see Drawing No. 57082

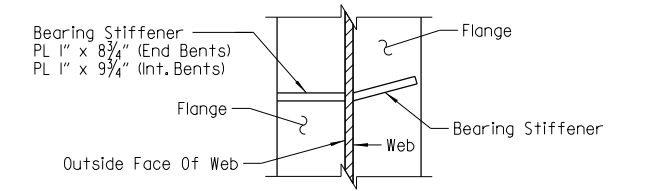


**DETAIL A**  
Girders 1 & 10  
Scale: NTS

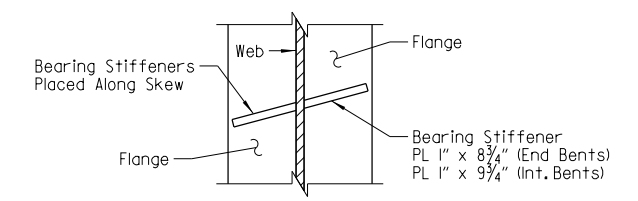


**DETAIL B**  
Girders 2-9  
Scale: NTS

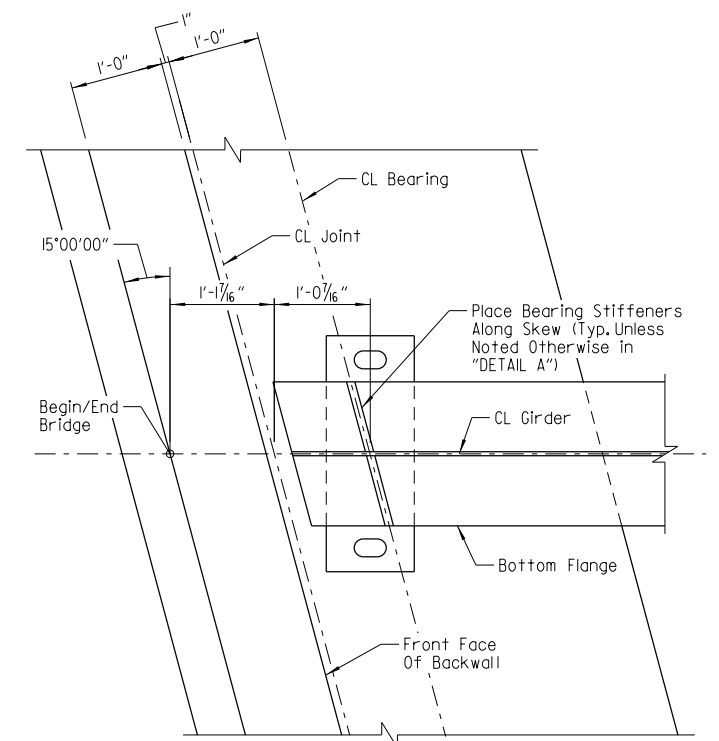


**BEARING PLAN @ END BENT**  
Scale: 1" = 1'-0"

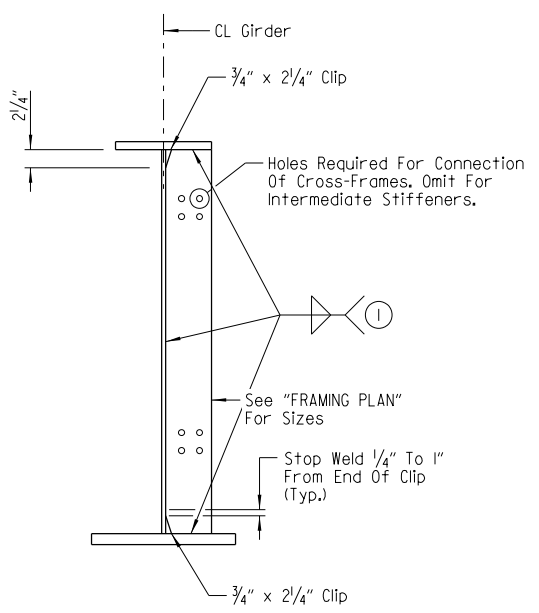

**CROSS-FRAME CONNECTION & INTERMEDIATE STIFFENER PLATE DETAIL**  
Scale: 1" = 1'-0"

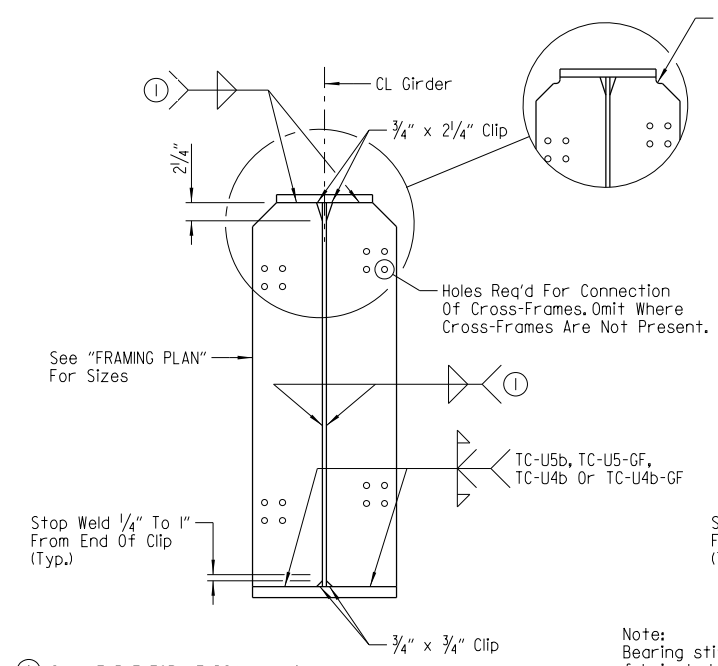

**BEARING STIFFENER @ END BENTS**  
Scale: 1" = 1'-0"

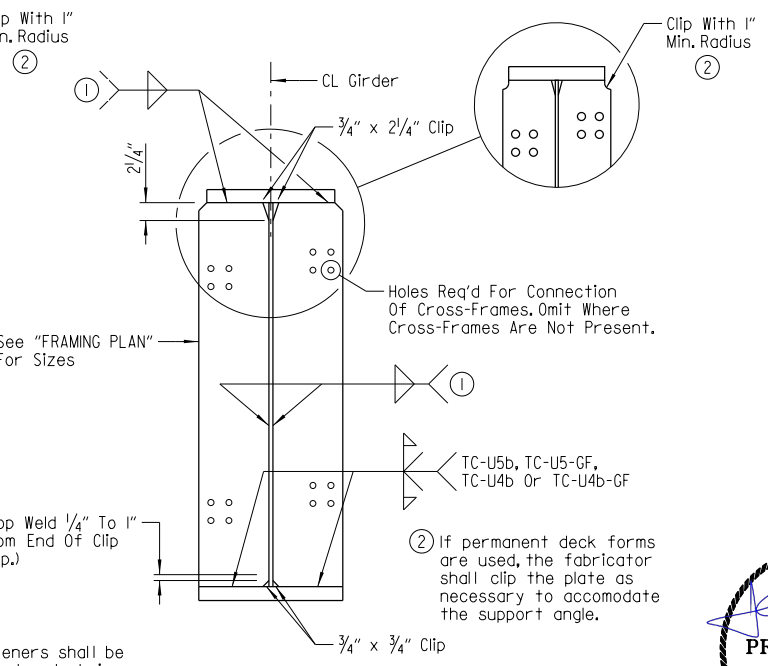

**BEARING STIFFENER @ INTERIOR BENT**  
Scale: 1" = 1'-0"

Note: Bearing stiffeners shall be fabricated to be plumb in their final positions.

② If permanent deck forms are used, the fabricator shall clip the plate as necessary to accommodate the support angle.


① See "TABLE FOR WELDS" on this sheet for min. weld size



Digitally Signed 05/19/2015  
BRIDGE ENGINEER


SHEET 4 OF 11  
DETAILS OF 212'-0" CONTINUOUS COMPOSITE GIRDER UNIT  
ROUTE SEC.  
ARKANSAS STATE HIGHWAY COMMISSION  
LITTLE ROCK, ARK.  
DRAWN BY: HEW DATE: FEB. 2015 FILENAME: B080517\_S4.dgn  
CHECKED BY: DRG DATE: MAR. 2015 SCALE: As Shown  
DESIGNED BY: JHR DATE: FEB. 2015  
BRIDGE NO. 07345 DRAWING NO. 57081

D:\ROAD 5/19/2015 1:27:48 PM  
 WORKSPACE: AHTD Bridge  
 L:\2012\201590 - Centrefield Access\Drawings\6TH\_ST\B080517\_S4.dgn  
 REVISED DATE:

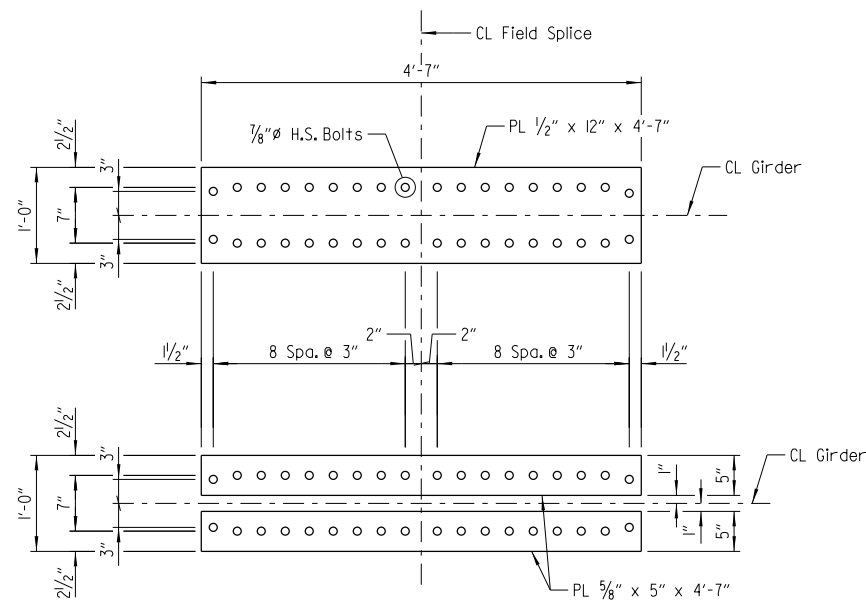


**TOP FLANGE SPLICE**

Scale: 1" = 1'-0"

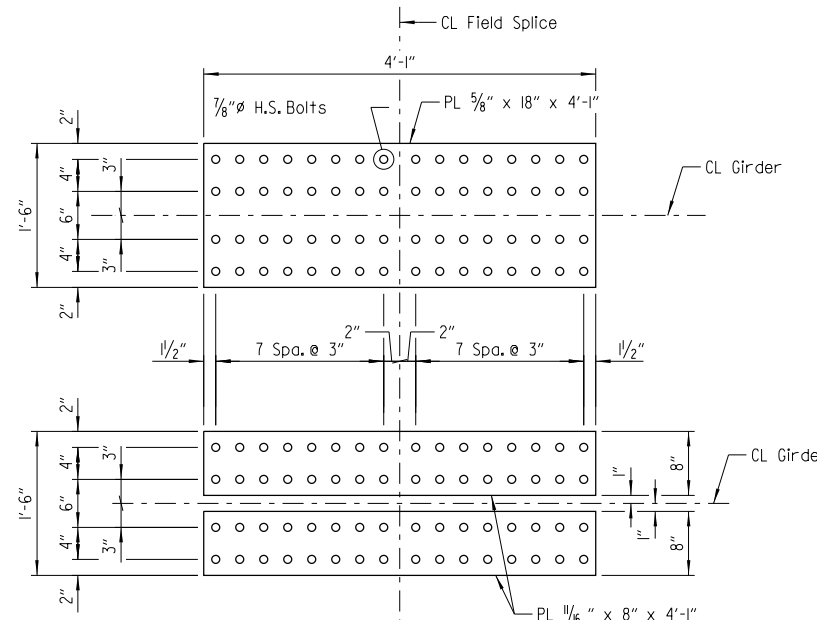

**BOTTOM FLANGE SPLICE**

Scale: 1" = 1'-0"

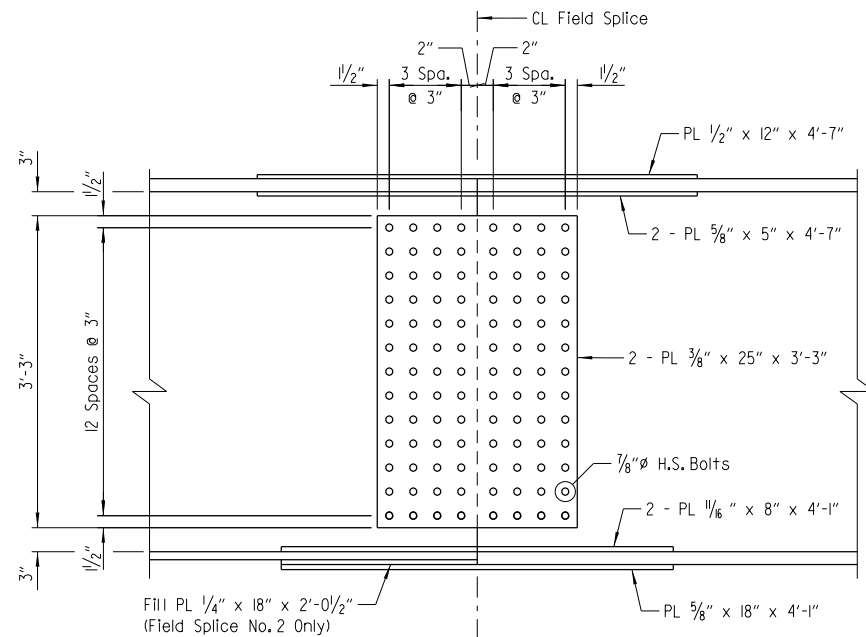

**ELEVATION OF FIELD SPLICE NO. 1 & NO. 2**

Scale: 1" = 1'-0"


**Notes:**

All field splice bolts shall be 7/8" H.S. bolts.

All holes for splice bolts shall be 15/16" Ø.


All field splice plates shall be AASHTO M270, GR. 50 steel.

Bolted field splices shown may be eliminated or shop welded splices may be substituted with approval of the Engineer. Payment will be made on the basis of the plan quantities.

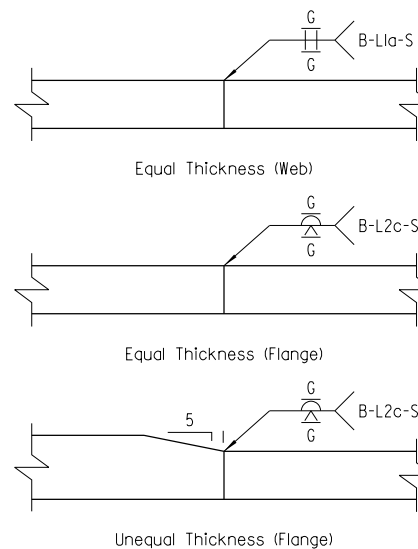

**DETAILS OF WELDED SPLICES**


Scale: NTS

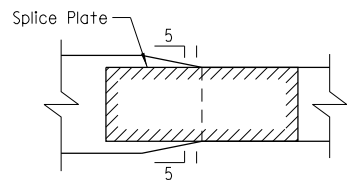

**FIELD SPLICE AT UNEQUAL BOTTOM FLANGE WIDTH**

Scale: NTS

Point Of Deflection	Girders 1-3 & 8-10			Girders 4-7		
	Wt. Of Girder And Cross-Frames	Wt. Of Girder, Cross-Frames And Slab	Wt. Of Girder, Cross-Frames, Slab, Sidewalk & Parapet	Wt. Of Girder And Cross-Frames	Wt. Of Girder, Cross-Frames And Slab	Wt. Of Girder, Cross-Frames, Slab, Sidewalk & Parapet
1.0	0.00	0.00	0.00	0.00	0.00	0.00
1.1	0.170	0.735	1.025	0.172	0.764	0.876
1.2	0.308	1.332	1.858	0.313	1.386	1.592
1.3	0.402	1.732	2.421	0.407	1.803	2.076
1.4	0.438	1.882	2.638	0.444	1.959	2.261
1.5	0.417	1.784	2.510	0.422	1.857	2.148
1.6	0.346	1.472	2.083	0.351	1.531	1.777
1.7	0.246	1.036	1.475	0.249	1.077	1.254
1.8	0.132	0.547	0.785	0.134	0.569	0.666
1.9	0.046	0.186	0.266	0.047	0.193	0.227
2.0	0.00	0.00	0.00	0.00	0.00	0.00
2.1	0.005	0.033	0.062	0.005	0.034	0.038
2.2	0.050	0.242	0.380	0.050	0.251	0.289
2.3	0.119	0.561	0.846	0.121	0.583	0.672
2.4	0.193	0.902	1.333	0.197	0.940	1.085
2.5	0.254	1.182	1.725	0.259	1.232	1.422
2.6	0.280	1.299	1.884	0.285	1.354	1.565
2.7	0.265	1.227	1.773	0.269	1.278	1.478
2.8	0.207	0.960	1.384	0.211	1.000	1.156
2.9	0.115	0.534	0.770	0.117	0.556	0.643
3.0	0.00	0.00	0.00	0.00	0.00	0.00

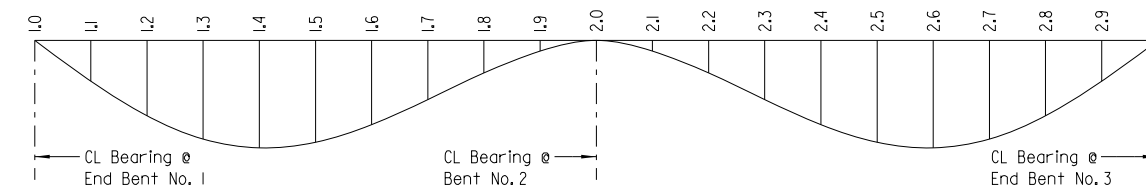


**DEAD LOAD DEFLECTION**

Scale: NTS

**NOTE:**

Camber for dead load deflection plus vertical curve +/- 1/4" tolerance. Deflections shown are from a chord from centerline bearing to centerline bearing. Vertical curve corrections are not included. Negative sign (-) indicates point above chord.

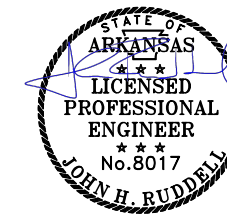

Digitally Signed 05/19/2015  
BRIDGE ENGINEER

SHEET 5 OF 11  
DETAILS OF 212'-0" CONTINUOUS  
COMPOSITE PLATE GIRDER UNIT  
ROUTE SEC.  
ARKANSAS STATE HIGHWAY COMMISSION  
LITTLE ROCK, ARK.


DRAWN BY: HEW DATE: FEB. 2015 FILENAME: B080517\_S5.dgn  
CHECKED BY: DRG DATE: MAR. 2015 SCALE: As Shown  
DESIGNED BY: JHR DATE: FEB. 2015  
BRIDGE NO. 07345 DRAWING NO. 57082

DATE REVISED	DATE FILMED	DATE REVISED	DATE FILMED	FED. ROAD DIST. NO.	STATE	FED. AID PROJ. NO.	SHEET NO.	TOTAL SHEETS
				6	ARK.			
				JOB NO.		080517	84	182
				07345		PL GIRDER UNIT		57083

③ Parapet joints designated with symbol (F) shall be stopped 4" from top of slab. All other parapet joints with symbol (P) shall be partial depth joints stopped 1'-2" from top of slab.

Note:  
Required slab joints and pouring sequence joints shall align with the parapet open joint at the gutterline.

\* Refer to "HALF SECTION - SHOWING DECK REINFORCING" Dwg. No. 57079 for placement.

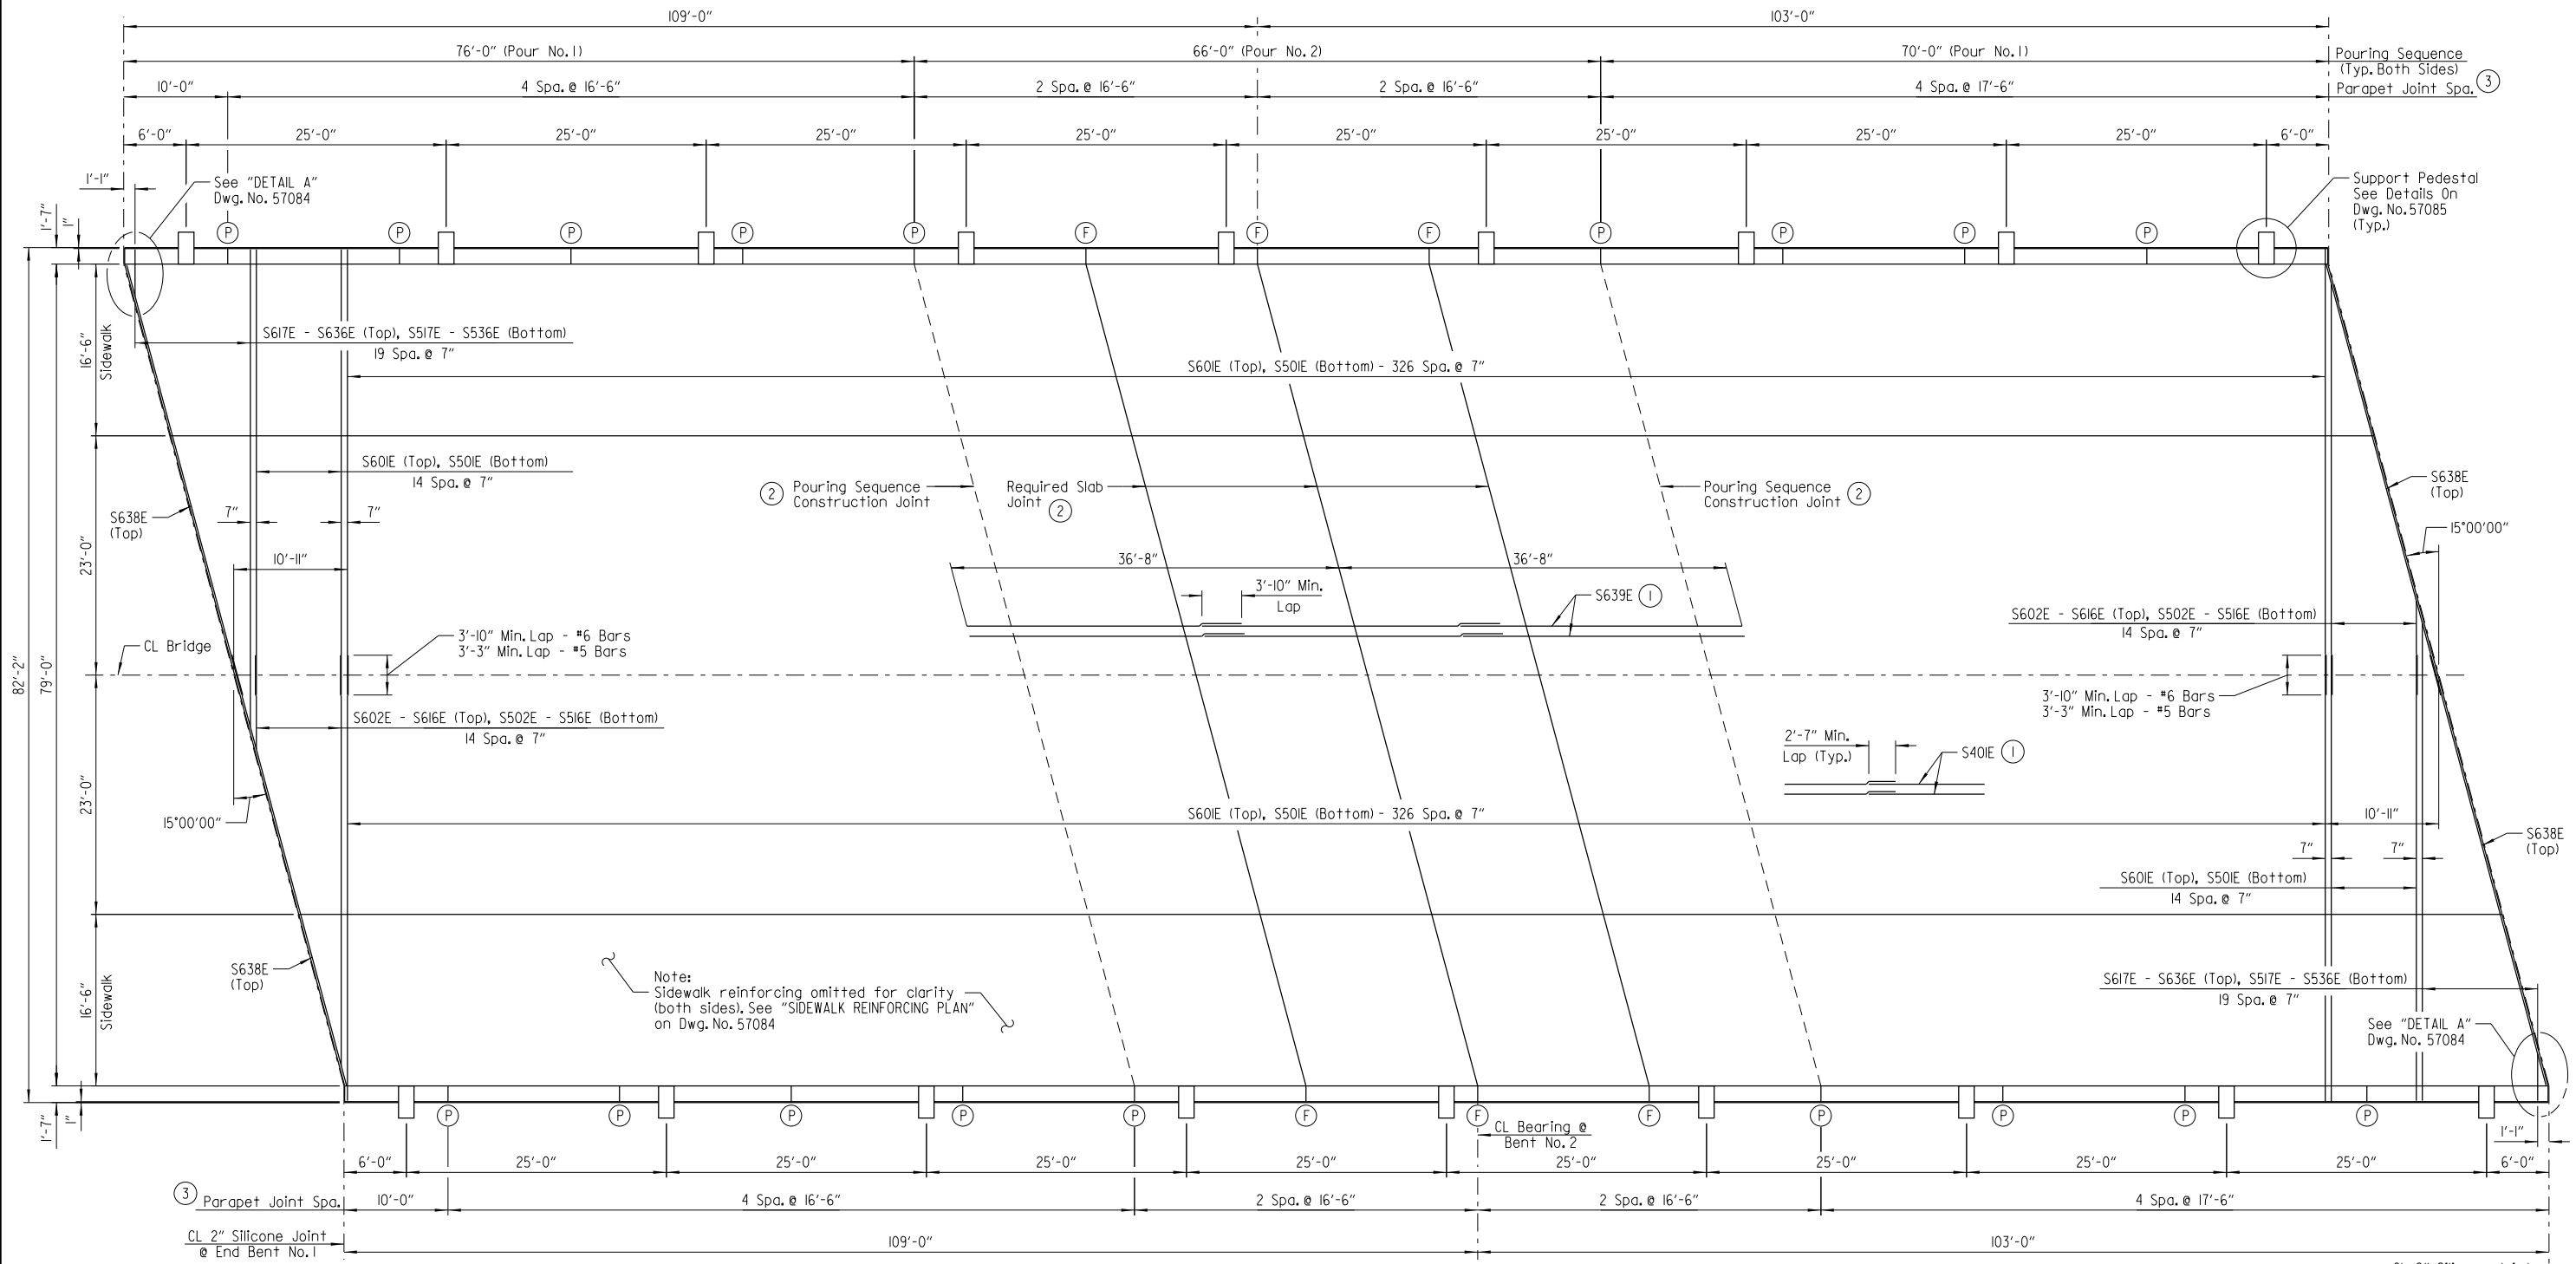


**REINFORCING PLAN & DECK POURING SEQUENCE**  
Scale: 1/8" = 1'-0"

Note:  
Pours with the same number may be placed simultaneously or separately. All Pours (1) must be placed before Pour (2) can be placed. 48 hours shall elapse before the end of a Pour and the start of the next Pour. 72 hours shall elapse between the end of a Pour and the start of an adjacent Pour. Any railing or sidewalk Pours made before the entire slab unit has been placed must be approved by the Engineer. A minimum of 72 hours shall elapse between the completion of the entire deck and the pouring of the sidewalk, and a minimum of 72 hours shall elapse between completion of the sidewalk and the Pouring of the parapet railing.

The Contractor must obtain approval from the Engineer for any deviations from the Pouring Sequence shown.

Concrete in bridge superstructure shall be consolidated for the entire Pour before any concrete has taken its initial set. This may require the use of a retarding agent.

- ① Place as shown in "HALF SECTION - SHOWING DECK REINFORCING" on Dwg. No. 57079
- ② See "SLAB JOINT DETAIL" on Dwg. No. 57084

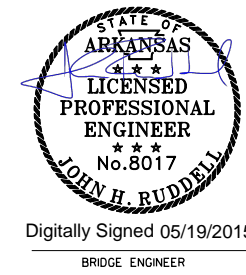


SHEET 6 OF 11  
DETAILS OF 212'-0" CONTINUOUS COMPOSITE PLATE GIRDER UNIT  
ROUTE SEC.  
ARKANSAS STATE HIGHWAY COMMISSION  
LITTLE ROCK, ARK.  
DRAWN BY: HEW DATE: FEB. 2015 FILENAME: B080517\_S6.dgn  
CHECKED BY: DRG DATE: MAR. 2015 SCALE: As Shown  
DESIGNED BY: JHR DATE: FEB. 2015  
BRIDGE NO. 07345 DRAWING NO. 57083

DRGNO: 5/19/2015 1:27:49 PM  
 WORKSPACE: AHTD Bridge  
 L:\2012\201590 - Centrefield Access\Drawings\6TH\_ST\B080517\_S6.dgn  
 REVISED DATE:


DATE REVISED	DATE FILMED	DATE REVISED	DATE FILMED	FED. ROAD DIST. NO.	STATE	FED. AID PROJ. NO.	SHEET NO.	TOTAL SHEETS
				6	ARK.			
				JOB NO.		080517	85	182
				07345		PL GIRDER UNIT		57084

- ① Spaced as shown in "SIDEWALK DETAIL" on Dwg. No. 57079
- ② See "SLAB JOINT DETAIL".

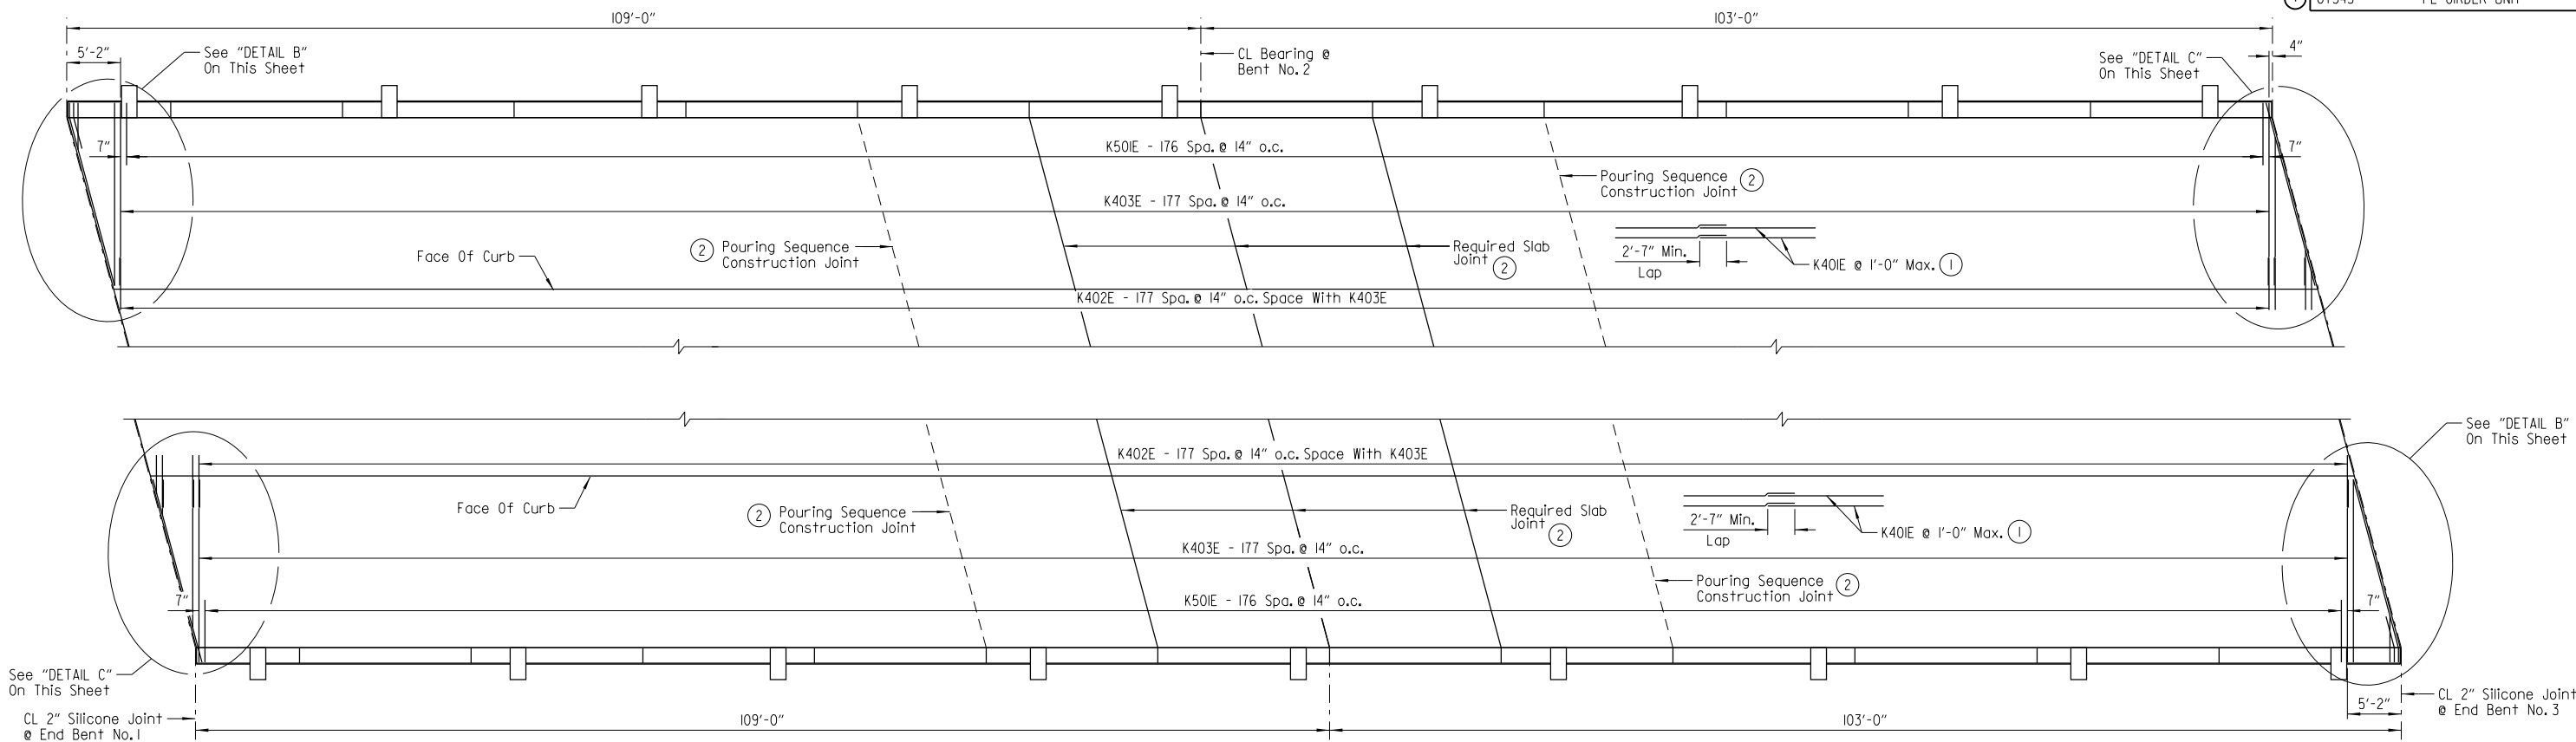


**SIDEWALK REINFORCING PLAN**

Scale: 1/8" = 1'-0"

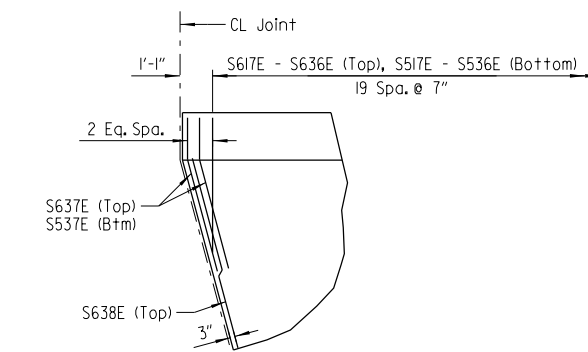


**DETAIL A**

Showing Slab Reinforcing Scale: NTS

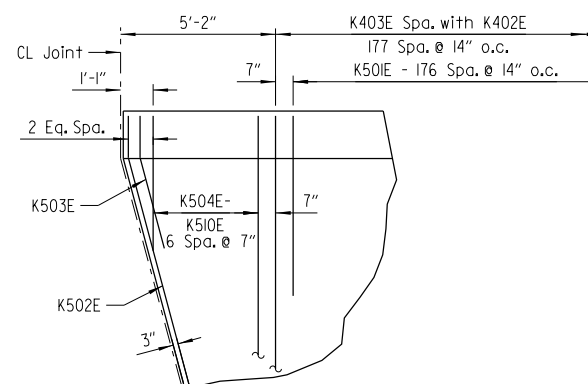


**DETAIL B**

Showing Sidewalk Reinforcing Scale: NTS

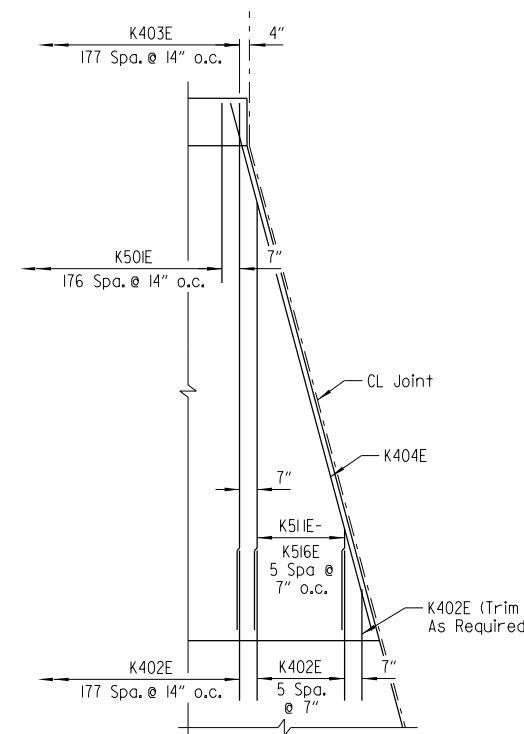

**DETAIL C**


Showing Sidewalk Reinforcing Scale: NTS

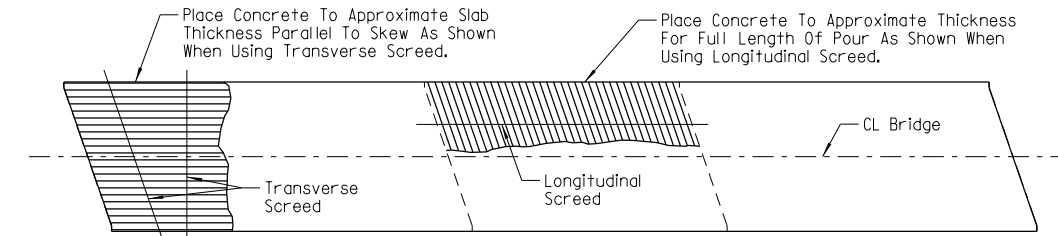

**CONCRETE PLACEMENT PROCEDURE**


Scale: NTS

NOTE:  
At the Contractor's option, the Transverse Screed may be placed parallel to the skew or perpendicular to CL Bridge.

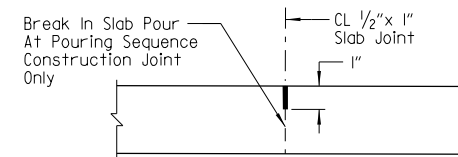

**SLAB JOINT DETAIL**

Scale: NTS

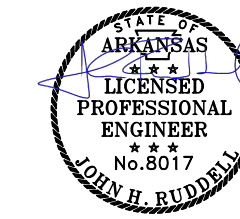


Digitally Signed 05/19/2015  
BRIDGE ENGINEER

SHEET 7 OF 11  
DETAILS OF 212'-0" CONTINUOUS  
COMPOSITE PLATE GIRDER UNIT  
ROUTE SEC.  
ARKANSAS STATE HIGHWAY COMMISSION  
LITTLE ROCK, ARK.


DRAWN BY: HEW DATE: FEB. 2015 FILENAME: B080517\_S7.dgn  
CHECKED BY: DRG DATE: MAR. 2015 SCALE: As Shown  
DESIGNED BY: JHR DATE: FEB. 2015  
BRIDGE NO. 07345 DRAWING NO. 57084

The 1/2" x 1" Poured Joint Sealer (Type 3 or 4) in slab shall conform to Subsection 501.02(h) and 501.05(i). Backer Rod filler will not be required. The Poured Joint Sealer shall be paid for separately but shall be included in the item "BRIDGE CONSTRUCTION". Slab joints shall extend to the outside edge of the deck slab. Slab joints in the sidewalk shall extend to the outside of the sidewalk and shall be installed before parapet railing is poured. If slab joints are to be sawed, they shall be sawed as soon as the concrete has sufficiently set to allow sawing of the joint without damage to the slab. Slab joints shall be placed at all pouring sequence construction joints and required slab joint locations. The joint sealer shall extend across the deck slab and across the top of the sidewalk. No joint sealer shall be placed on the deck slab under the sidewalk or parapet rail. Slab joints and pouring sequence joints shall align with parapet open joints.


DATE REVISED	DATE FILMED	DATE REVISED	DATE FILMED	FED. ROAD DIST. NO.	STATE	FED. AID PROJ. NO.	SHEET NO.	TOTAL SHEETS
				6	ARK.			
						080517	86	182
				07345		PL GIRDER UNIT		57085

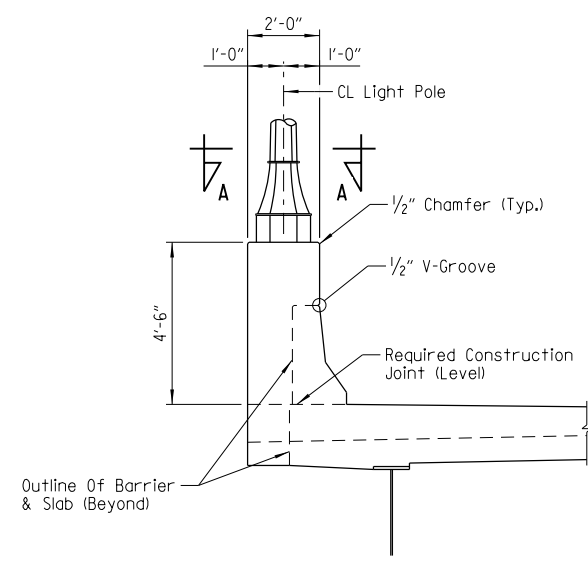

**SECTION SHOWING DIMENSIONS**

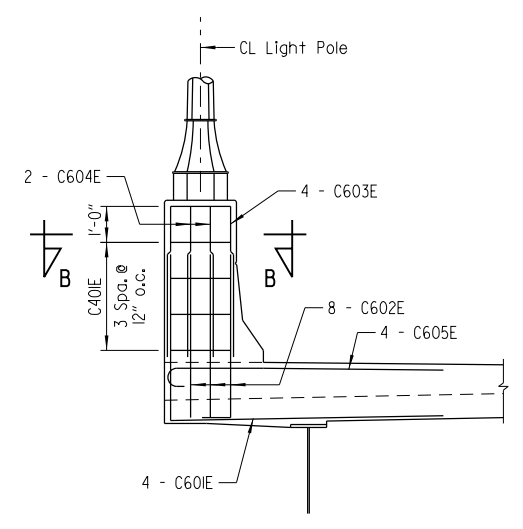


**SECTION SHOWING REINFORCING**

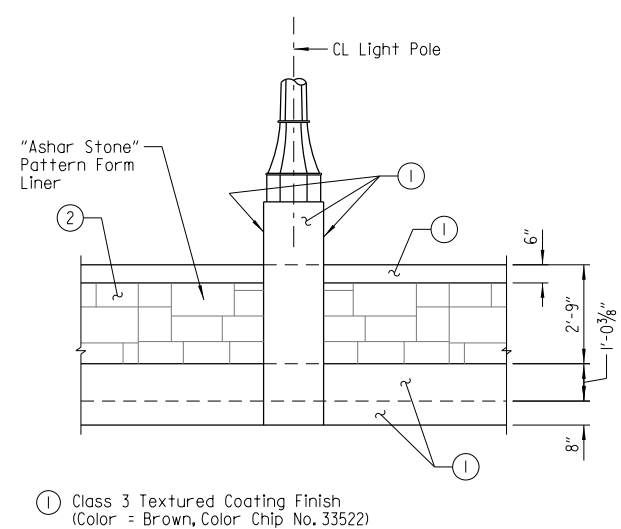


- ① Class 3 Textured Coating Finish (Color = Brown, Color Chip No. 33522)
- ② "Ashlar Stone" Pattern and Class 3 Textured Coating Finish (Color = Brown, Color Chip No. 30219)

**PANEL ELEVATION**  
(Showing Outside Face Of Parapet)  
Scale: 3/8" = 1'-0"

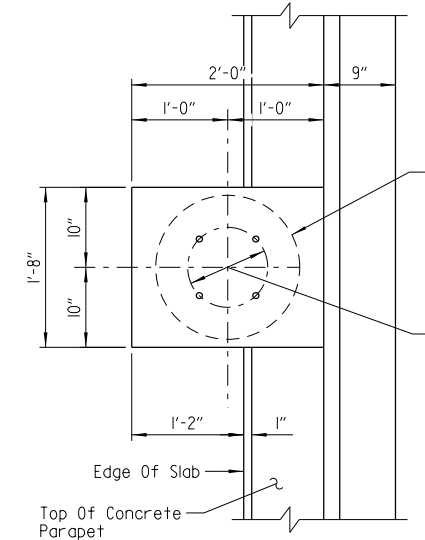



**VIEW A-A**  
Scale: 1" = 1'-0"

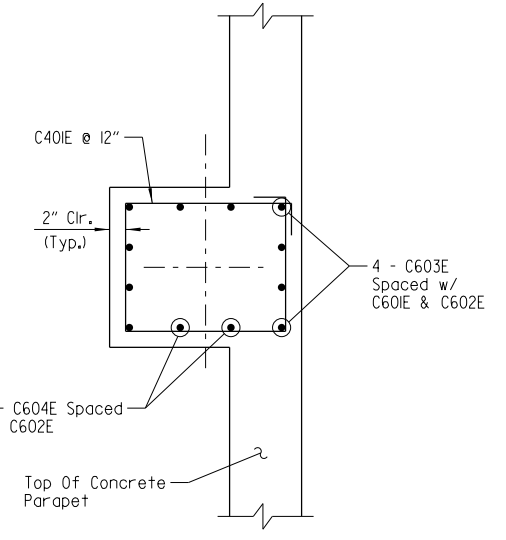


**SECTION B-B**  
Scale: 1" = 1'-0"

**PEDESTAL DETAIL**  
Scale: 3/8" = 1'-0"


- P CL partial-depth parapet joint (1/4" to 1" max.) as shown on slab plan. Stop 1'-2" from top of sidewalk.
- F CL full-depth parapet joint (1/4" to 1" max.) as shown on slab plan. Stop 4" from top of sidewalk.

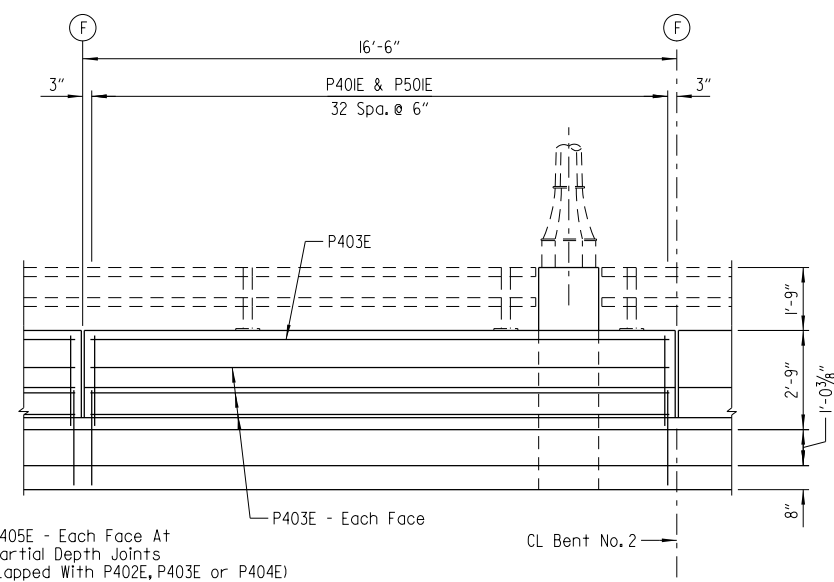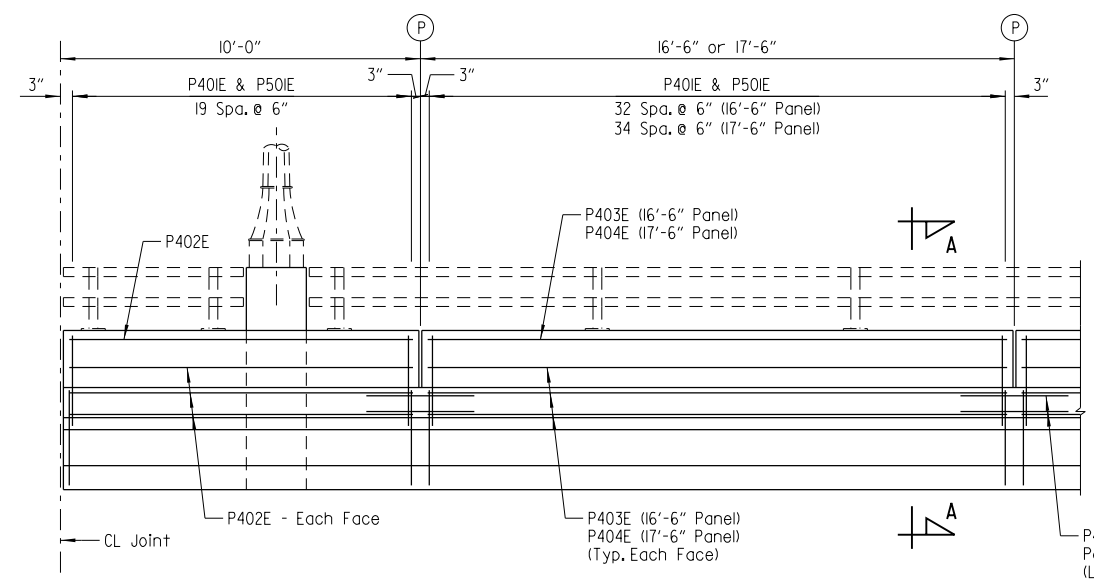

**PARAPET ELEVATION**  
Scale: 3/8" = 1'-0"

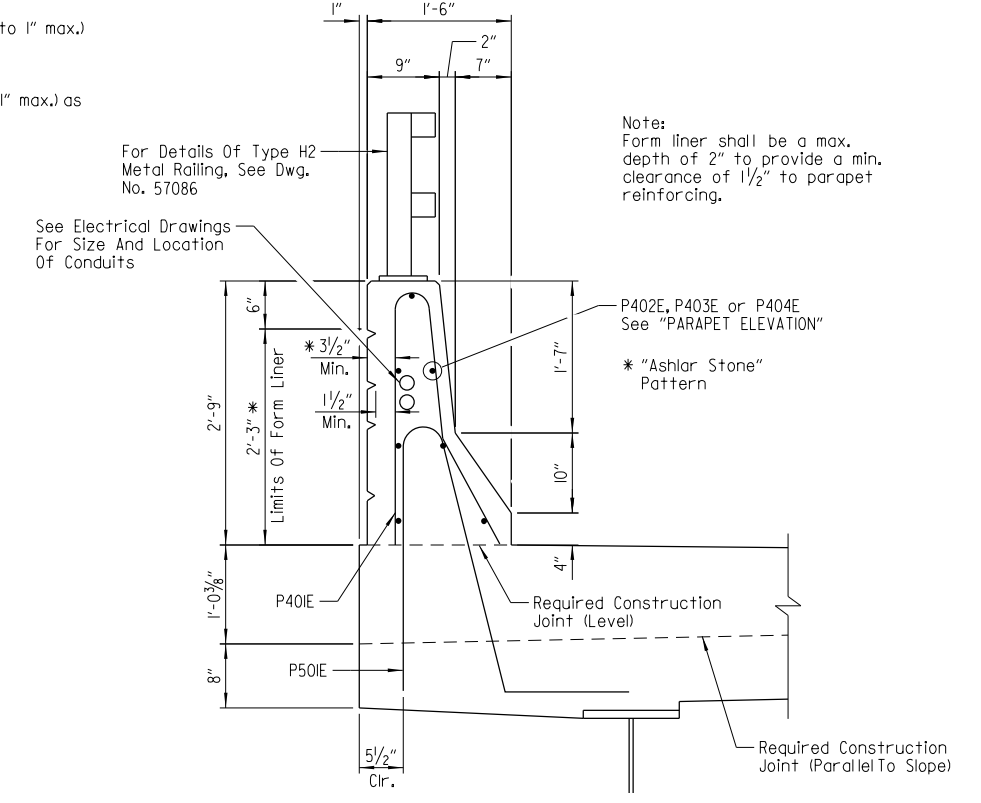

**SECTION A-A**  
Scale: 1" = 1'-0"

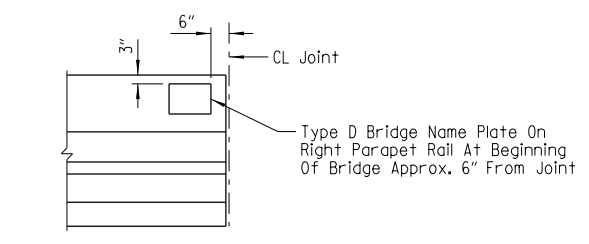


**VIEW SHOWING LOCATION OF NAME PLATE**  
(Showing Inside Face Of Parapet)  
Scale: NTS

Note:  
For "BAR LIST" & "BAR BENDING DIAGRAMS",  
see Dwg. No. 57088

**GENERAL NOTES**

CONCRETE: All concrete shall be Class (SAE) with a minimum 28 day compressive strength  $f'_c = 4000$  psi.  
REINFORCING STEEL: All reinforcing steel shall be Grade 60 conforming to AASHTO M31 or M322, Type A with mill test reports.

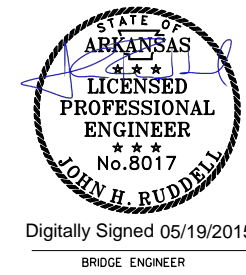


SHEET 8 OF 11  
DETAILS OF 212'-0" CONTINUOUS  
COMPOSITE PLATE GIRDER UNIT  
ROUTE SEC.  
ARKANSAS STATE HIGHWAY COMMISSION  
LITTLE ROCK, ARK.

DRAWN BY: HEW DATE: FEB. 2015 FILENAME: B080517\_S8.dgn  
CHECKED BY: DRG DATE: MAR. 2015 SCALE: As Shown  
DESIGNED BY: JHR DATE: FEB. 2015  
BRIDGE NO. 07345 DRAWING NO. 57085

5/19/2015 1:27:50 PM  
 WORKSPACE: AHTD Bridge  
 L:\2012\201590 - Centrefield Access\Drawings\6TH\_ST\B080517\_S8.dgn  
 REVISED DATE:


DATE REVISED	DATE FILMED	DATE REVISED	DATE FILMED	FED. ROAD DIST. NO.	STATE	FED. AID PROJ. NO.	SHEET NO.	TOTAL SHEETS
				6	ARK.			
				JOB NO.		080517	87	182
				07345		PL GIRDER UNIT		57086

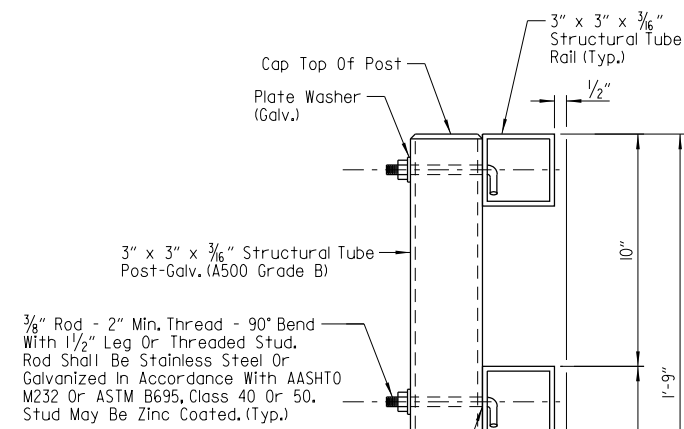

3/8" Rod - 2" Min. Thread - 90° Bend With 1/2" Leg Or Threaded Stud. Rod Shall Be Stainless Steel Or Galvanized In Accordance With AASHTO M232 Or ASTM B695, Class 40 Or 50. Stud May Be Zinc Coated. (Typ.)

**TYPE H2 RAIL**

Scale: 3" = 1'-0"

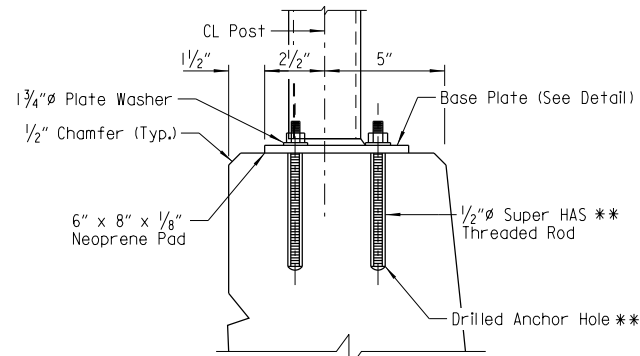


\*\* HILTI HIT RE 500 Epoxy Adhesive Anchor System with 4/2" embedment or an approved equal.


The HILTI Epoxy Adhesive Anchor System shall be installed in accordance with Manufacturer's recommendations.

**DETAILS OF ALTERNATE POST ANCHOR SYSTEM**

(Epoxy Adhesive Anchors)  
Scale: 3" = 1'-0"

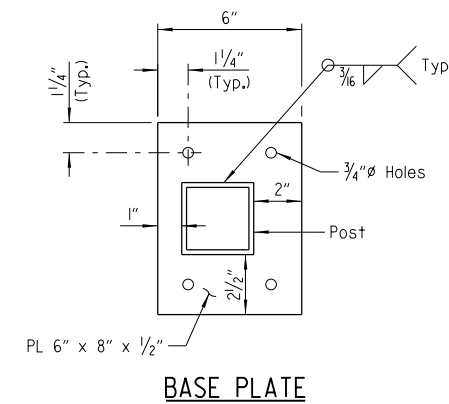


**BASE PLATE**

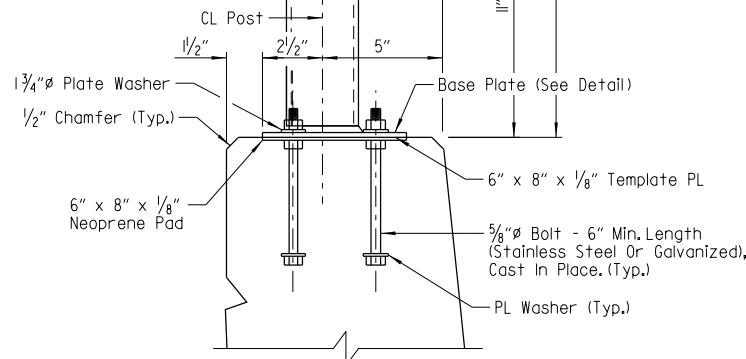

**TYPE H2 RAIL**


Scale: 3" = 1'-0"

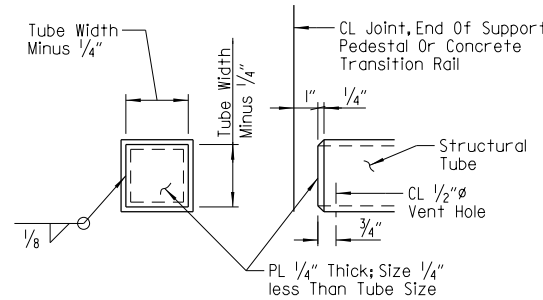

**END ELEV. SIDE ELEV.**


**DETAILS OF END CAPS**

Scale: 3" = 1'-0"

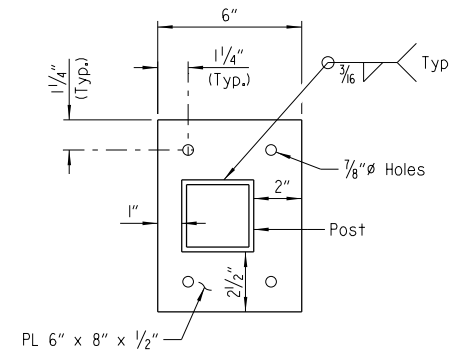

**BASE PLATE**

Scale: 3" = 1'-0"

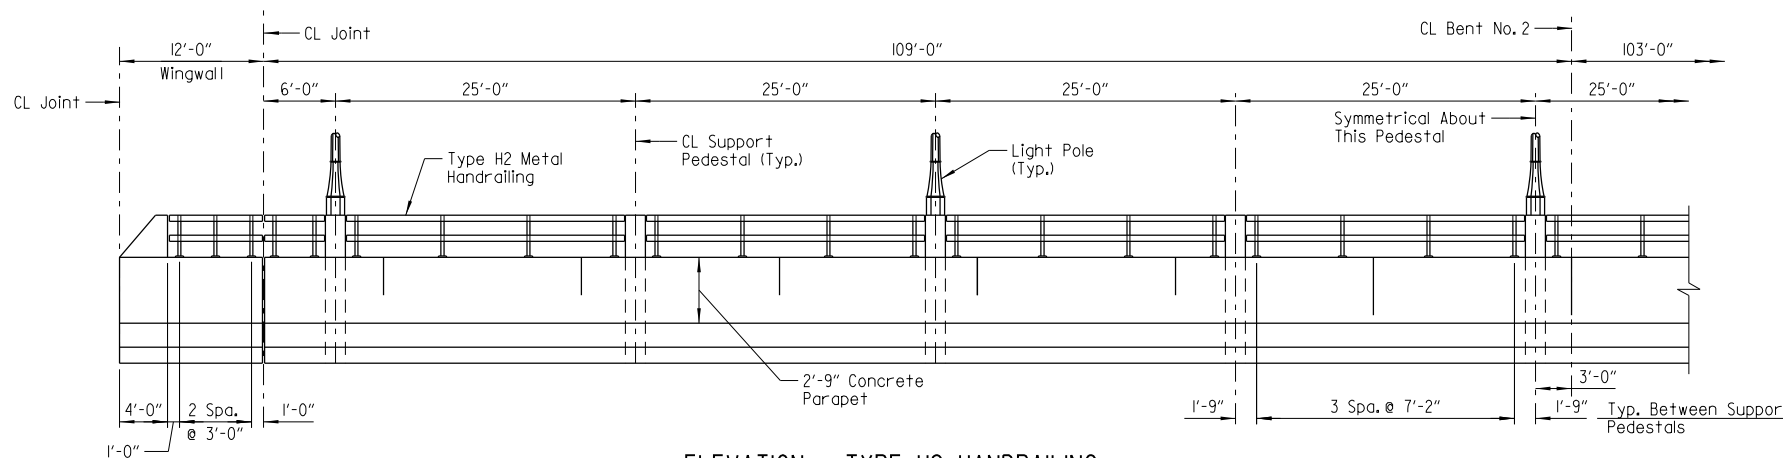

**ELEVATION - TYPE H2 HANDRAILING**

Scale: NTS

**NOTES FOR BRIDGE RAILING:**

Rail layout shall conform to vertical and horizontal alignment of Bridge. All posts shall be vertical.

Base plates shall not be placed upon areas that are improperly finished, deformed or irregular.

Shop drawings showing details of railing shall be submitted and approval secured before fabrication is begun.

**MATERIALS:**

Tubing, Posts, and Accessories: AASHTO M270, Gr. 36 or ASTM A500-Grade B.

Railing End Caps shall conform to AASHTO M270, Gr. 36 galvanized.

Steel rail members shall be galvanized in accordance with AASHTO M111 after fabrication and shall receive a powder coating process after galvanizing. Galvanizing shall not interfere with the powder coating process. Galvanized surfaces shall be prepared in accordance with Subsection 807.87 and the powder coating manufacturer's recommendations before application of the powder coating process. The powder coating process shall be a two coat system applied using electrostatic spray. The base coat shall be a thermosetting epoxy powder with a minimum thickness of 2-4 mils. The top coat shall be a tough polyester powder coat with a minimum thickness of 2-4 mils. Color shall be Black equal to or close to Federal Std. 595B, color chip 27038. Coated galvanized framework shall have a salt spray resistance of 3,000 hours using ASTM B117 without loss of adhesion. The powder coating process shall be in accordance with Manufacturer's recommendations.

The Contractor shall submit a point color sample prior to fabrication for Owner's approval.

Cast in place anchor bolts shall be of stainless steel or high strength steel. Stainless steel anchor bolts shall conform to ASTM A193 or A320-Grade B8 with a minimum yield strength of 80,000 psi. High strength steel anchor bolts shall conform to AASHTO M64 or A354-Grade BC galvanized in accordance with AASHTO M232 or ASTM B695, Class 40 or 50.

Splice Set Screws shall conform to the requirements of ASTM A193 or A320-Gr.B8 (Stainless steel) or AASHTO M270, Gr.36 (Galvanized).

Nuts shall conform to AASHTO M292, Gr.8A (Stainless steel) or galvanized in accordance with AASHTO M232 or ASTM B695 Class 40 or 50.

Threads on bolts, screws and nuts shall conform to American Standard Coarse Series, Class 2 FIT, ASA Specification B11.

Washers shall be stainless steel and conform to the requirements of ASTM A276 or A167-Type 302 with dimensions meeting ASTM F436, or high strength steel conforming to AASHTO M293 and galvanized in accordance with AASHTO M232 or ASTM B695, Class 40 or 50.

Plate Washers shall be stainless steel and conform to the requirements of ASTM A167-Type 302 or AASHTO M270, Gr.36, galvanized in accordance with AASHTO M232 or ASTM B695, Class 40 or 50. Plate washers shall have dimensions meeting the requirements of ANSI/ASME B18.22.1, Type A plain washer (Wide Series).

Mixing of stainless steel and galvanized fasteners will not be permitted.

Metal Bridge Railing, including posts, fasteners, base plates, template plates, anchor bolts, neoprene pad, galvanizing and powder coatings; fabrication and erection; and all incidentals necessary to complete the work shall included in the item "BRIDGE CONSTRUCTION".



Digitally Signed 05/19/2015  
BRIDGE ENGINEER

SHEET 9 OF 11  
DETAILS OF 212'-0" CONTINUOUS  
COMPOSITE PLATE GIRDER UNIT  
ROUTE SEC.  
ARKANSAS STATE HIGHWAY COMMISSION  
LITTLE ROCK, ARK.

DRAWN BY: HEW DATE: FEB. 2015 FILENAME: B080517\_S9.dgn  
CHECKED BY: DRG DATE: MAR. 2015 SCALE: As Shown  
DESIGNED BY: JHR DATE: FEB. 2015  
BRIDGE NO. 07345 DRAWING NO. 57086

DATE REVISED	DATE FILMED	DATE REVISED	DATE FILMED	FED. ROAD DIST. NO.	STATE	FED. AID PROJ. NO.	SHEET NO.	TOTAL SHEETS
				6	ARK.			
				JOB NO.		080517	88	182
				07345		PL GIRDER UNIT		57087

SILICONE JOINT DATA						
"A" Width Perpendicular To Joint At 24 Hour Average Temperature * 0f:			"B" Perpendicular To Joint At 60°F	"D"	Bumper Plate Size	
40°F	60°F	80°F				
2 3/8"	2"	1 1/8"	2 1/4" ±	4 1/2"	1" x 1"	

\* The temperature used to set the joint opening shall be the approximate average air temperature during the 24 hour period immediately before the bolts are tightened. The Engineer shall establish the temperature. Interpolation of the table may be necessary.

Notes: The temperature limitations recommended by the sealant manufacturer shall be observed.


The sealant may be installed in skewed joints only when the average 24 hour air temperature is between 40° and 80°F.

Backer Rod: Use an appropriately sized backer rod at the depth shown in the manufacturer's literature based on the joint width at the time of sealing. Except as noted, do not install more backer rod than can be sealed in the same day. The Contractor shall verify separation of the backer rod from the joint material after the joint material has set.

Note: Each expansion joint device shall be blocked in the shop by the fabricator to the dimension shown for 60°F and the blocking details shall be shown on the shop drawings. Blocking shall be placed within 2' of each end of the device and with a maximum spacing of 8'.

EXPANSION DEVICE INSTALLATION AT END BENTS: The Contractor may elect to install the expansion device using one of the following two alternatives.

- 1) The concrete span pour adjacent to joint shall be placed before the end bent backwall is placed. After the end bent backwall forms are in place and the beams erected, the blocked expansion device shall be installed and adjusted for grade. All connection bolts shall be fully tightened prior to placing the deck concrete adjacent to the bent. Immediately prior to pouring the backwall concrete, the blocking shall be removed, the opening adjusted for temperature, and the backwall constructed.
- 2) The backwall shall be poured to the optional construction joint after beams are erected. The blocked expansion device shall be installed and adjusted for grade. All connection bolts shall be fully tightened prior to placing the deck concrete adjacent to the bent. Immediately prior to pouring the remainder of the backwall concrete, the blocking shall be removed and the opening adjusted for temperature.

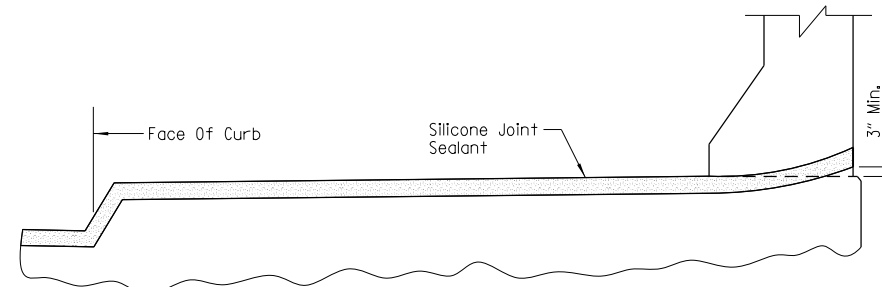


**JOINT SEAL PLACEMENT AT SIDEWALK AND PARAPET**  
Scale: NTS

Note: Concrete shall be hand packed under the roadway channel & joint armor in the backwall.

One of two different blocking systems is required depending on the type of span finishing machine that is used.

For Transverse Strike-off: Plate, Angle or Other Shapes Attached To Channel And Angle For Blocking.

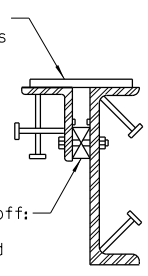

For Longitudinal Strike-off: Bolt And Spacer May Be Attached To Channel And Angle For Blocking.


**DETAILS FOR BLOCKING EXPANSION JOINT DEVICE**

Scale: NTS


- 1) Ctsk. 1/8" Ø Holes in 3/8" Patterned PL. Tap 4" leg of angles for ASTM A449 5/8" Ø screw @ 12" O.C. Install screws in the shop and ship as a unit. Screws on span side to be removed. Screws on backwall side to remain in place after erection. See "EXPANSION DEVICE INSTALLATION AT END BENTS" on this drawing.
- 2) Trim vertical leg of Split MC18x42.7 as needed.
- 3) Dimensions shown @ 60°F

Sidewalk plates shall be AASHTO M270, Gr. 36 and shall be paid for as "BRIDGE CONSTRUCTION". The surfaces of the plates which will not be in contact with the concrete shall be cleaned and painted in accordance with Section 638, or as directed by the Engineer. Only one coat is required and shall be applied in the fabricator's shop. Painting shall not be paid for directly, but will be considered subsidiary to "BRIDGE CONSTRUCTION".


NOTE: Concrete shall be hand packed under the joint armor in the sidewalk. For expansion joint detail, see "DETAIL A" on this drawing.

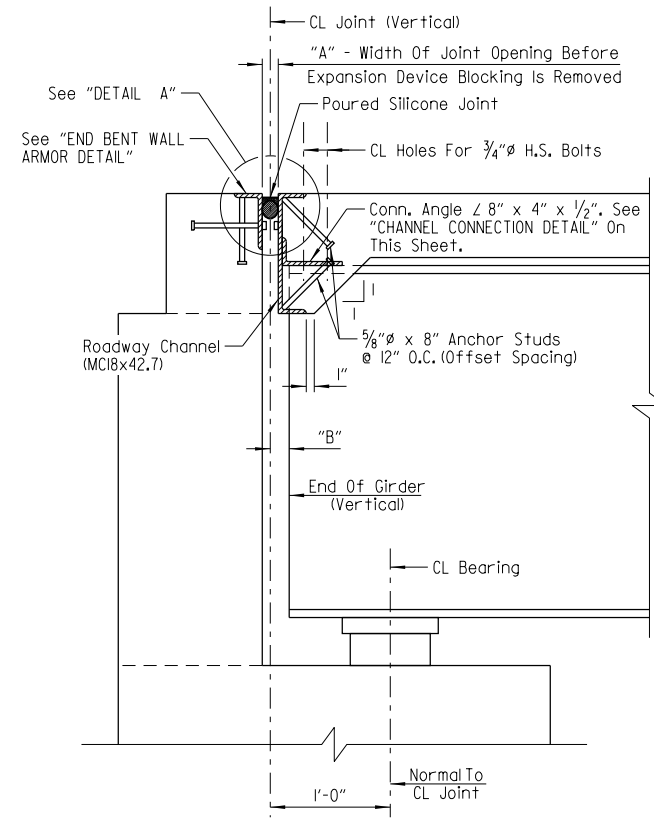


**SECTION THRU SILICONE JOINT**  
(Section Taken Normal To CL Joint)  
Scale: NTS

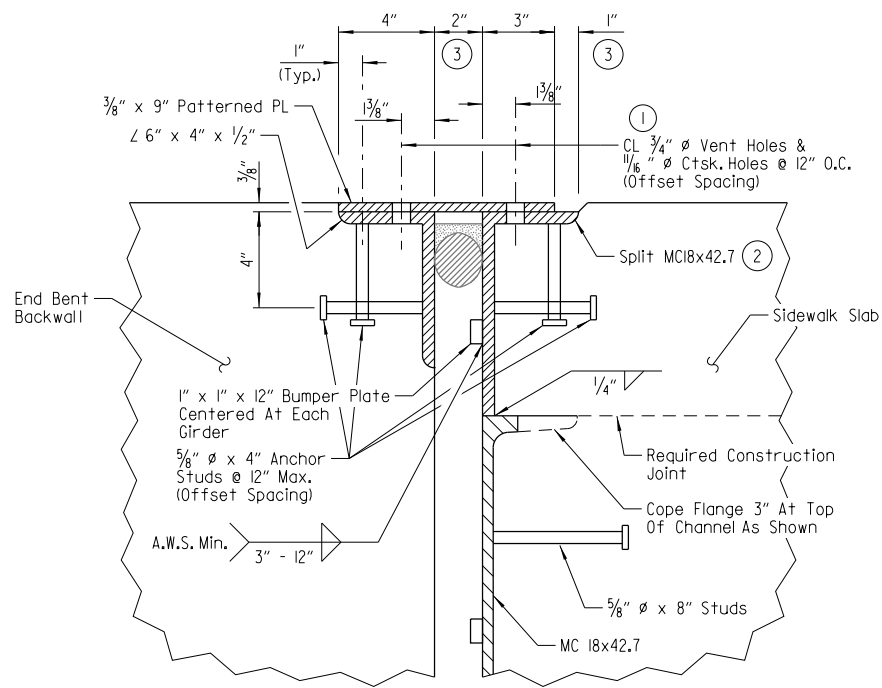


**SECTION A-A**  
Scale: 3" = 1'-0"

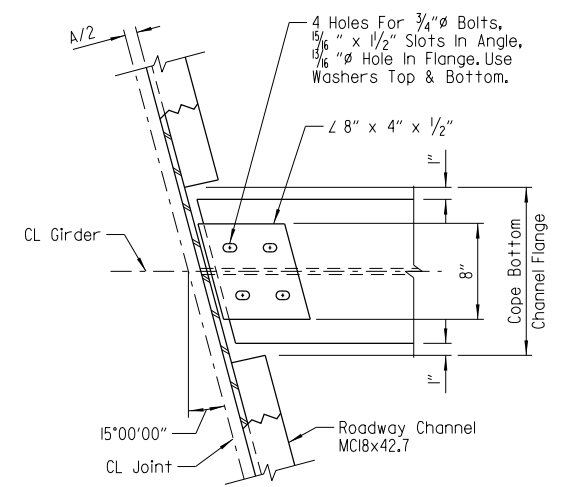

**CHANNEL CONNECTION DETAIL**  
Scale: NTS

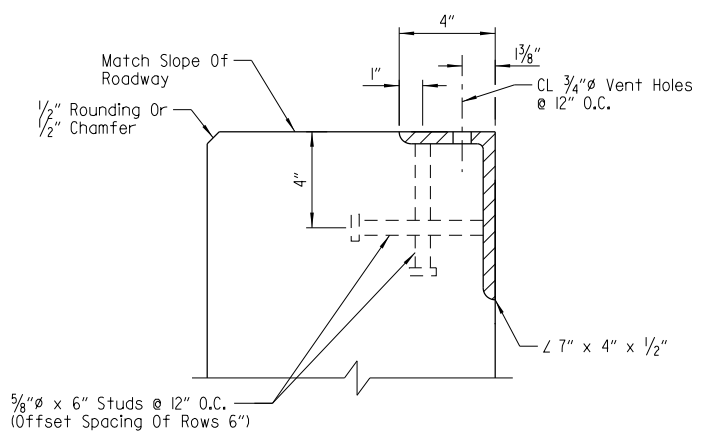

**END BENT WALL ARMOR DETAIL**  
Scale: NTS

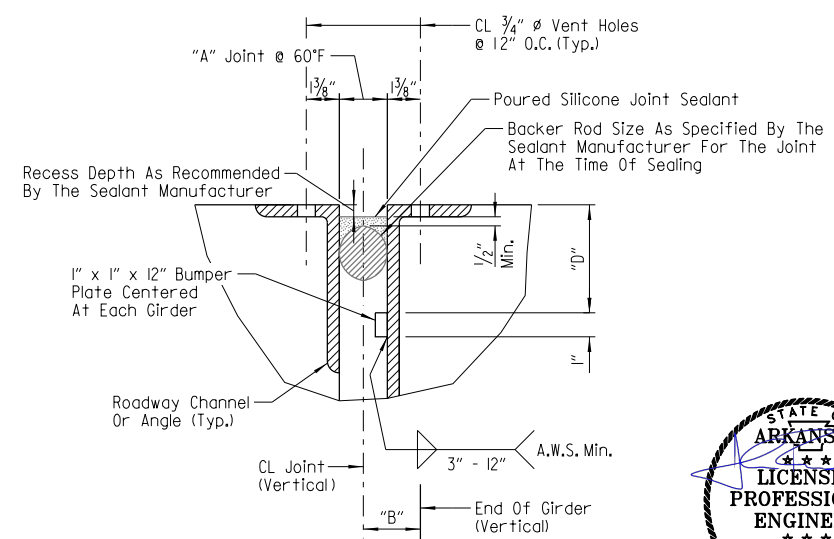

**DETAIL A**  
Scale: 3" = 1'-0"



Digitally Signed 05/19/2015  
BRIDGE ENGINEER

SHEET 10 OF 11  
DETAILS OF 212'-0" CONTINUOUS COMPOSITE PLATE GIRDER UNIT  
ROUTE SEC.  
ARKANSAS STATE HIGHWAY COMMISSION  
LITTLE ROCK, ARK.

DRAWN BY: HEW DATE: FEB. 2015 FILENAME: B080517\_S10.dgn  
CHECKED BY: DRG DATE: MAR. 2015 SCALE: As Shown  
DESIGNED BY: JHR DATE: FEB. 2015  
BRIDGE NO. 07345 DRAWING NO. 57087

DRGNO: 5/19/2015 1:27:51PM  
 WORKSPACE: AHTD Bridge  
 L:\2012\1201590 - CentrellField Access\Drawings\6TH\_ST\B080517\_S10.dgn  
 REVISED DATE:



DATE REVISED	DATE FILMED	DATE REVISED	DATE FILMED	FED. ROAD DIST. NO.	STATE	FED. AID PROJ. NO.	SHEET NO.	TOTAL SHEETS
				6	ARK.			
				JOB NO.		080517	89	182
				07345		PL GIRDER UNIT		57088

## GENERAL NOTES

### CONCRETE:

Concrete shall be poured in the dry and all exposed corners to be chamfered  $\frac{3}{4}$ " unless otherwise noted. All concrete shall be Class S(AE) with a minimum 28 day compressive strength  $f'_c = 4,000$  psi.

The superstructure details shown are for use when removable deck forming is used and are the basis for measurements of Class S(AE) Concrete. See Standard Drawing No. 55005 for allowable modifications and for tolerances when permanent steel deck forms are used.

Concrete in bridge superstructure shall be placed, consolidated and screeded off for the entire pour before any concrete has taken its initial set. This may require the use of a retarding agent.

The concrete deck shall be given a fine finish in accordance with Subsection 802.19 for Class 5 Tined Bridge Roadway Surface Finish. The 16'-6" sidewalk shall receive a broomed finish as specified in Subsection 802.19 for Class 6 Broomed Finish. Movement of the finishing machine across new concrete shall be on planks placed on the surface and shall be prohibited for 72 hours after finishing the pour. Sufficient concrete must be placed ahead of the strike-off to fully load the girder. A minimum of 72 hours shall elapse between completion of the bridge deck slab and the pouring of the sidewalk, and a minimum of 72 hours shall elapse between completion of the sidewalk and the pouring of the parapet railing. All railing pours made before the entire sidewalk has been placed and cured must be approved by the Engineer.

### REINFORCING STEEL:

All reinforcing steel shall be Grade 60 conforming to AASHTO M31 or M322 Type A with mill test reports. The reinforcing steel is to be accurately located in the forms and firmly held in place by steel wire supports, sufficient in number and size to prevent displacement during the course of construction. The wire supports will not be paid for directly, but will be considered subsidiary to the item "BRIDGE CONSTRUCTION".

### STRUCTURAL STEEL:

All structural steel shall be AASHTO M270, Gr. 50 unless noted otherwise and shall be included in the item "BRIDGE CONSTRUCTION". All Structural Steel shall be cleaned in accordance with Subsection 807.84 unless noted otherwise. Structural Steel completely embedded in concrete may be AASHTO M270, Gr. 36 unless otherwise noted. See Drawing No. 57089 for cleaning requirements of external load plates on elastomeric bearings.

Requests for substitution of structural steel shapes shown with shapes of greater size must be submitted by the Contractor to the Engineer for approval. Steels of equal or greater strengths will be accepted only when shown on approved shop drawings. Shapes and materials shown in the plans will be the basis of payment and no additional compensation will be made for any adjustments due to substitutions.

Drawings show general features of design only. Shop drawings shall be prepared in accordance with the specifications, submitted and approved before fabrication is begun.

Bolted field splices shown may be eliminated or shop welded splices may be substituted with approval of the Engineer. Payment will be made on the basis of plan quantities.

All girder webs & flanges of plate girders and field splice plates are considered main load carrying members and shall meet the Longitudinal Charpy V-Notch Test specified in Subsection 807.05. This work and material will not be paid for directly but are considered as subsidiary to the item "BRIDGE CONSTRUCTION".

Steel plates for main load carrying members (flange and web plates) and flange field splice plates shall be cut and fabricated so that the primary direction of rolling is parallel to the direction of the main tensile and/or compressive stresses.

Girder webs may be made by shop splicing with a minimum length of 25'-0" for sections. Flange plates longer than 50'-0" may be made by shop splicing with a minimum length of 25'-0" for sections. Material specifications and locations of shop-welded splice, if any, shall be shown on the shop drawings. No additional payment for these welded splices will be made.

All welding that is to be done during fabrication of structural steel, including temporary welds, shall be detailed on the shop drawings and submitted for approval. If additional welds are required, whether temporary or permanent, a formal request with detailed drawings shall be submitted to the Engineer for approval; however, additional welds used for attaching falsework support devices or screed rail supports to the structural steel that do not exceed the limitations of Subsection 802.13 will not require approval prior to construction. All welding shall conform to Subsection 807.26.

All girders shall be blocked in their true position with webs horizontal in the shop as specified in Subsection 807.54 (b)(2). The camber, length of sections, distance between bearings and opening of joints shall be measured with the girders in their true position and this information shall become a part of the permanent records of this job. The component parts shall be match marked in this assembly and these marks shall be shown on the erection diagram. All girder dimensions are based on a temperature of 60°F. A tolerance of  $\pm \frac{1}{4}$ " is allowed for camber.

Groove welds in flange and web plates shall be Quality Control (Q.C.) tested by nondestructive testing, as required by the Standard Specifications.

Fillet welds at flange to web plate connections shall be Quality Control (Q.C.) tested by the magnetic particle method.

All Quality Control (Q.C.) testing is at the Contractor's expense.

All connection plates & intermediate stiffeners shall be fabricated normal to the top flange and on the side of the girder web as indicated on the framing plans. No intermediate stiffeners are to be placed on the outside of the exterior girders except as noted. All bearing stiffeners shall be fabricated to be plumb in their final position.

Cross frames shall be installed as girders are erected. All bolts in diaphragms and field splices shall be installed and tightened in accordance with Subsection 807.71 prior to pouring of the concrete deck.

Field connections shall be bolted with high-strength bolts. Bolts shall be  $\frac{3}{4}$ "  $\phi$ , except as noted, and open holes shall be  $\frac{1}{16}$ " unless noted otherwise. Holes for  $\frac{3}{4}$ "  $\phi$  bolts may be  $\frac{5}{16}$ "  $\phi$  if a washer is supplied for use under both the nut and head of the bolt. Bolt spacing shall be  $2\frac{1}{2}$ " for  $\frac{3}{4}$ "  $\phi$  bolts unless otherwise noted. For field splice bolts shall be  $\frac{1}{8}$ "  $\phi$  bolts unless otherwise noted. Open holes shall be  $\frac{1}{16}$ "  $\phi$  unless noted otherwise. Bolt spacing shall be 3" for  $\frac{1}{8}$ "  $\phi$  bolts unless otherwise noted. Bolts shall be placed with heads on the outside face of the exterior girder web and on the bottom of the girder flanges.

All contact surfaces between plates at field splices shall be free of paint, oil, rust or scale before assembly.

All stud shear connectors shall be granular flux filled, solid fluxed or equal and shall be automatically end welded in accordance with recommendations of the manufacturer.

Bearings shall be firmly seated in accordance with Subsection 808.08. This work is to be considered subsidiary to the item "BRIDGE CONSTRUCTION" and will not be paid for directly.


Anchor bolts shall be AASHTO designation M314 Gr. 55, including supplemental requirement S1, and shall be galvanized to conform to AASHTO M 232, Class C or AASHTO M298 Class 50. Anchor bolts will be included in the item "BRIDGE CONSTRUCTION".

### SURFACE TREATMENT:

Class 1 Protective Surface Treatment shall be applied to the roadway surface and sidewalk surface. Class 3 Textured Coating Finish shall be applied as specified in SP "TEXTURED COATING FINISH".

### PAINTING:

All structural steel except galvanized members, machined surfaces and surfaces in contact with concrete shall be painted as specified in Section 807. Color of the paint shall be Black, Fed. Std. 595B, Color Chip 27038. See Subsection 807.75.

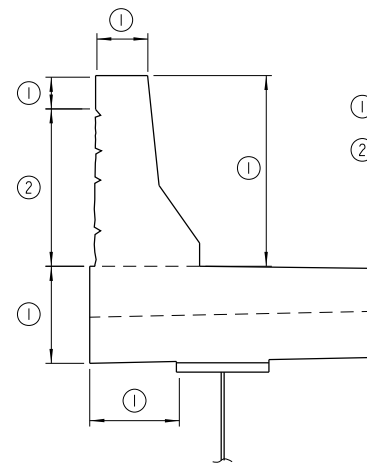


TEXTURED COATING FINISH

Scale: NTS

BAR LIST			
Mark	No. Req'd.	Length	Pin, Dia.
S40IE	1374	37'-6"	Str.
S50IE	684	42'-7"	Str.
S502E	8'-10"		Str.
To	2 Each	To	
S516E		39'-4"	
S517E	4'-6"		Str.
To	2 Each	To	
S536E		45'-10"	
S537E	4	5'-5"	3 $\frac{3}{4}$ "
S60IE	684	42'-10"	Str.
S602E	9'-1"		Str.
To	2 Each	To	
S616E		39'-7"	
S617E	4'-6"		Str.
To	2 Each	To	
S636E		45'-10"	
S637E	4	5'-5"	4 $\frac{1}{2}$ "
S638E	4	42'-10"	Str.
S639E	261	27'-0"	Str.
K40IE	216	37'-6"	Str.
K402E	370	5'-5"	2"
K403E	356	17'-7"	Str.
K404E	2	18'-4"	Str.
K50IE	354	7'-0"	Str.
K502E	2	18'-2"	3 $\frac{3}{4}$ "
K503E	2	4'-11"	3 $\frac{3}{4}$ "
K504E	4'-6"		Str.
To	2 Each	To	
K510E		17'-6"	
K511E	14'-3"		Str.
To	2 Each	To	
K516E		3'-4"	
P40IE	848	5'-6"	3"
P402E	14	9'-7"	Str.
P403E	112	16'-2"	Str.
P404E	56	17'-2"	Str.
P405E	72	5'-6"	Str.
P50IE	848	7'-1"	3 $\frac{3}{4}$ "
C40IE	72	6'-4"	2"
C60IE	72	11'-10"	4 $\frac{1}{2}$ "
C602E	144	6'-3"	4 $\frac{1}{2}$ "
C603E	72	9'-7"	4 $\frac{1}{2}$ "
C604E	36	9'-4"	4 $\frac{1}{2}$ "
C605E	72	7'-2"	4 $\frac{1}{2}$ "

### BAR BENDING DIAGRAM

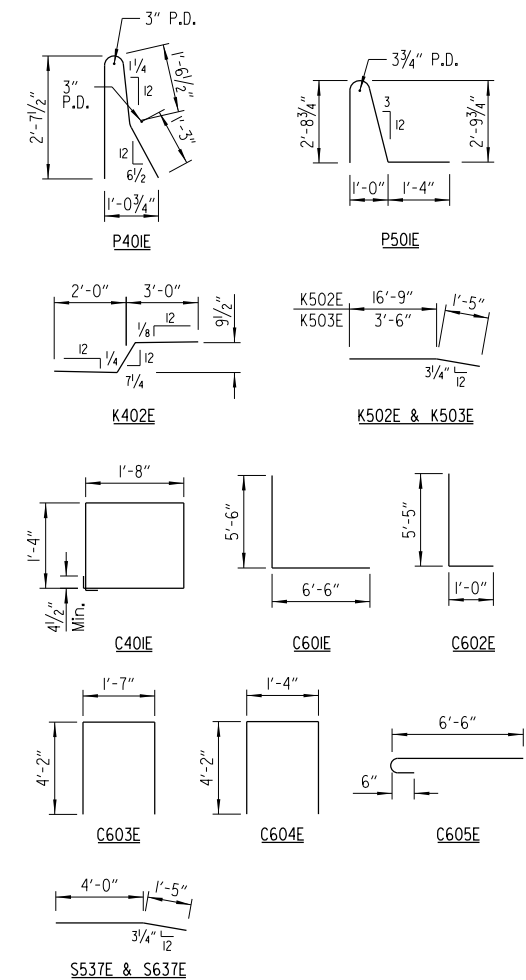

NOTE:  
Dimension of bars are out-to-out.  
Bar designations ending with "E" indicate epoxy coated bars.




Digitally Signed 05/19/2015  
BRIDGE ENGINEER


SHEET 11 OF 11  
DETAILS OF 212'-0" CONTINUOUS  
COMPOSITE PLATE GIRDER UNIT  
ROUTE SEC.  
ARKANSAS STATE HIGHWAY COMMISSION  
LITTLE ROCK, ARK.

DRAWN BY: HEW DATE: FEB. 2015 FILENAME: B080517\_S11.dgn  
CHECKED BY: DRG DATE: MAR. 2015 SCALE: As Shown  
DESIGNED BY: JHR DATE: FEB. 2015  
BRIDGE NO. 07345 DRAWING NO. 57088


DATE REVISED	DATE FILMED	DATE REVISED	DATE FILMED	FED. ROAD DIST. NO.	STATE	FED. AID PROJ. NO.	SHEET NO.	TOTAL SHEETS
				6	ARK.			
				JOB NO.	080517	90	182	
				07345	ELASTOMERIC BEARINGS		57089	

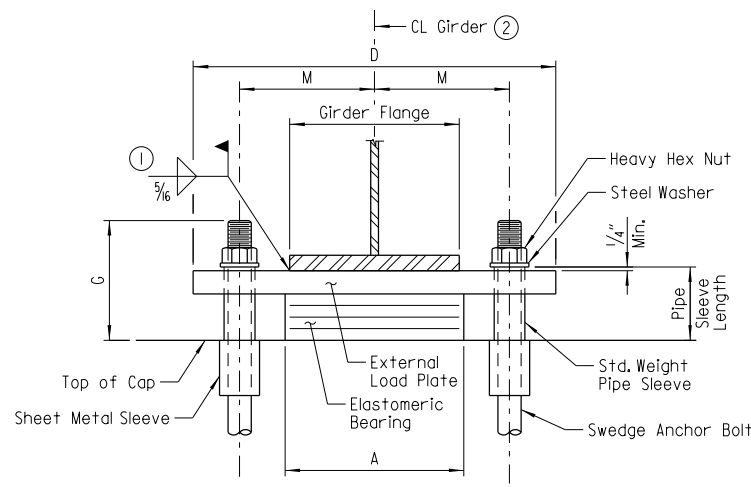

FRONT VIEW - AT BENT NOS. 1 & 3

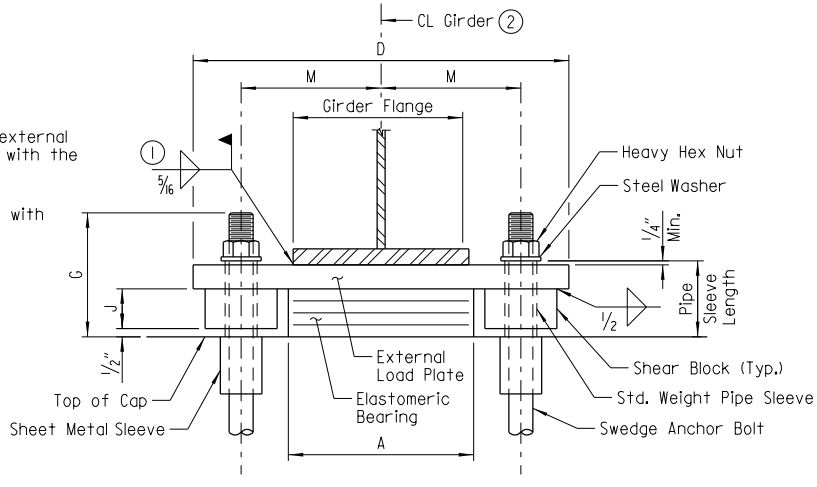


FRONT VIEW - AT BENT NO. 2

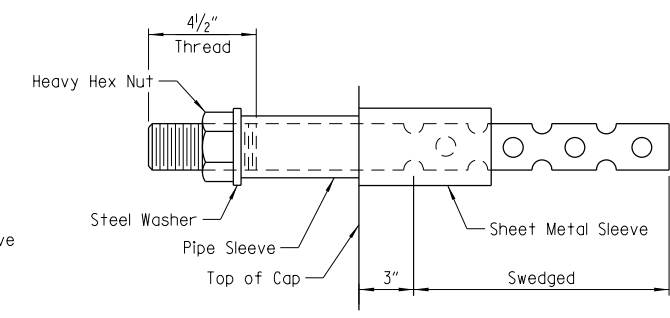


ANCHOR BOLT DETAIL

- ① Care shall be taken to ensure that the external load plate is in full and complete contact with the girder flange before welding begins.
- ② Centerline elastomeric pad shall be aligned with centerline girder.

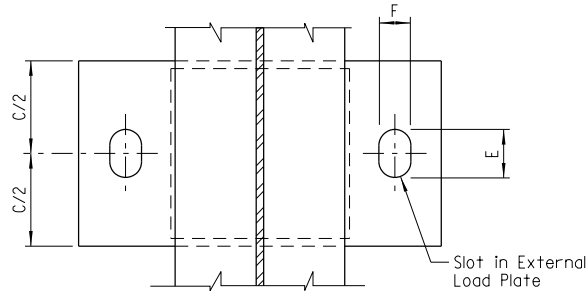


PLAN VIEW - AT BENT NOS. 1 & 3

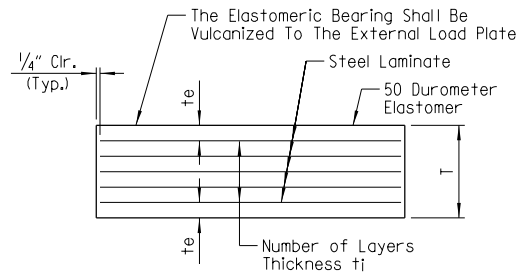

ELASTOMERIC BEARING

t<sub>e</sub> = Thickness Of Elastomer Cover On Top And Bottom Of Pad  
t<sub>i</sub> = Thickness Of Elastomer Between Steel Laminates  
N = Number Of Elastomer Layers Of Thickness t<sub>i</sub>

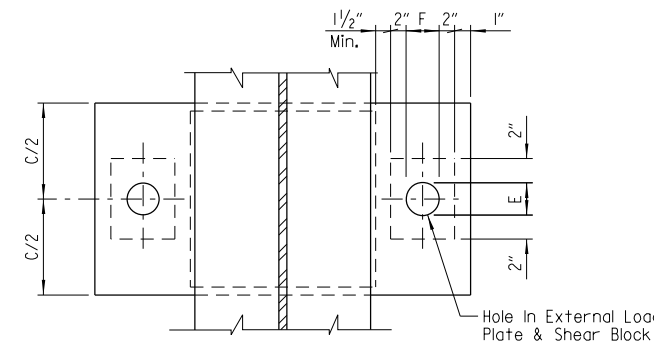

PLAN VIEW - AT BENT NO. 2

NOTE:  
Anchor bolts may be cast in place or drilled and grouted into place. If anchor bolts are to be cast in place, the galvanized sheet metal sleeves will not be required.

If anchor bolts are to be drilled and grouted in place, the galvanized sheet metal sleeves shall be cast in place as shown. Sleeves shall be dry packed with styrofoam, urethane foam or approved equal prior to pouring of concrete. After pouring of the cap and prior to erection of structural steel, the dry pack shall be removed and holes for the anchor bolts shall be accurately drilled into the masonry. Bolts placed in drilled holes shall be accurately set and fixed using a QPL approved epoxy or non-shrink grout that completely fills the holes. Galvanized sheet metal sleeves will not be paid for directly but will be included in the item "BRIDGE CONSTRUCTION".

GENERAL NOTES

Elastomeric bearings shall conform to Section 808 and shall be included in the item "BRIDGE CONSTRUCTION".


External load plates and shear blocks shall conform to AASHTO M270, Grade 50. Pipe sleeves shall be ASTM A53, Grade B, and shall be galvanized to conform to AASHTO M232, Class C or ASTM B695, Class 50.

External load plates and shear blocks shall be completely fabricated (including bevel and bolt holes) and shall be cleaned before vulcanizing to the elastomeric bearing. The surface in contact with the elastomeric bearing shall be cleaned in accordance with Subsection 807.84(b) for painted steel and painted in accordance with Subsection 807.75. Mask areas of field welding. Painting will not be paid for directly but shall be included in the item "BRIDGE CONSTRUCTION".

Anchor bolts, washers and nuts shall conform to Subsection 807.07. The anchor bolt grade of steel shall be as specified in the "TABLE OF FABRICATOR VARIABLES". Indentations shall be circular with bottoms and staggered as shown in the details.

External load plates, shear blocks, pipe sleeves, anchor bolts, washers and nuts shall be included in the item "BRIDGE CONSTRUCTION".


Bearings shall be seated in accordance with Subsection 808.08. This work and materials shall be included in the item "BRIDGE CONSTRUCTION".

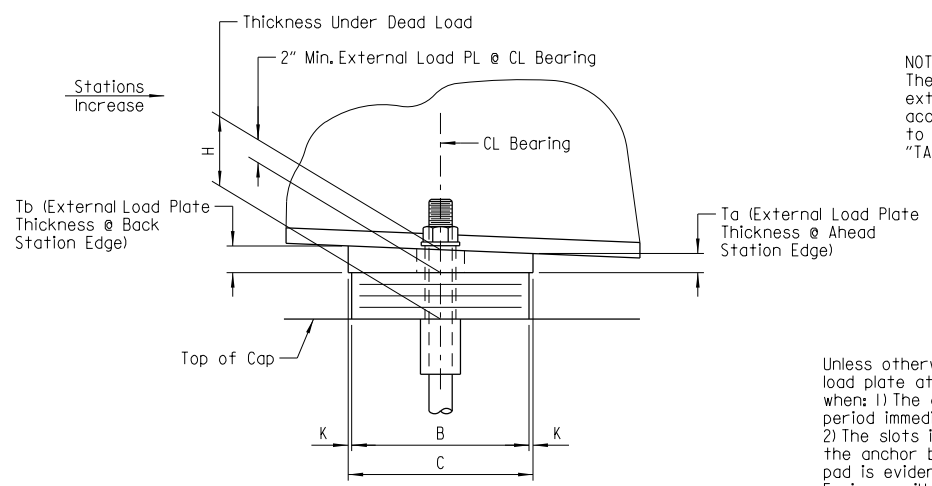

SIDE VIEW - AT BENT NOS. 1 & 3

NOTE:  
The direction of the bevel of the external load plate may not be accurately depicted with respect to T<sub>a</sub> and T<sub>b</sub> values shown in "TABLE OF FABRICATOR VARIABLES".

Unless otherwise approved by the Engineer, welding of the external load plate at expansion bearings to the girder will be allowed only when: 1) The approximate average air temperature during the 24 hour period immediately preceding welding is between 40°F and 80°F; and 2) The slots in the external load plate are positioned to center on the anchor bolts; and 3) No horizontal deformation of the elastomeric pad is evident. If welding at other temperatures is required, the Engineer will provide adjustment data.

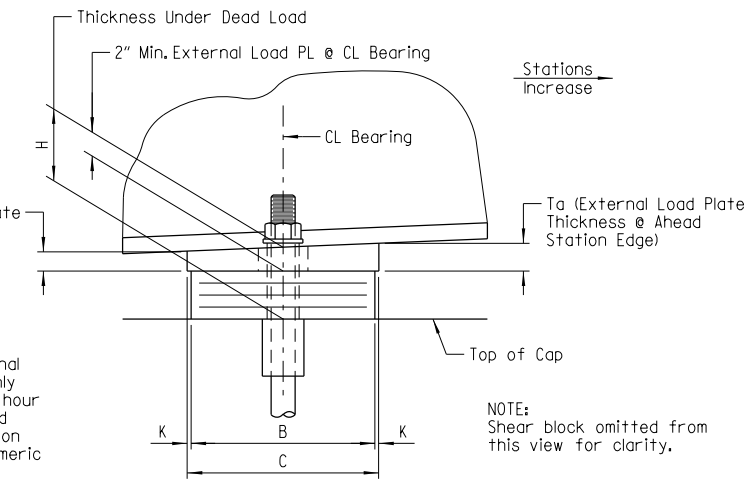


SIDE VIEW - AT BENT NO. 2

NOTE:  
Shear block omitted from this view for clarity.

TABLE OF FABRICATOR VARIABLES

Bridge No.	Location		Bearing Type	No. Of Bearings Each Bent	* Maximum Design Load (Kips)	Elastomeric Pad		External Load Plate												Anchor Bolt								
	Bent No(s).	Girder No.				G	H	A	B	N	t <sub>i</sub>	t <sub>e</sub>	No. & Thickness Of Steel Laminate	T	C	D	E	F	J	K	M	T <sub>a</sub>	T <sub>b</sub>	Anchor Bolt (Dia. x L)	Grade	Pipe Sleeve Size (Dia. x L)	Sheet Metal Sleeve Size (Dia. x L)	Steel Washer Size (O.D.)
07345	1	All	Exp.	10	178.6	8 3/8"	4 5/8"	18"	10"	4	1/2"	1/4"	5 @ 12 Ga.	3"	11"	30 1/2"	5"	3 3/8"	-	1/2"	12"	2.23"	1.77"	2" x 34"	55	2 1/2" x 5 3/8"	4" x 22 1/2"	3 3/4"
	2	All	Fix.	10	496.8	7 5/8"	4 3/8"	20"	15"	3	1/2"	1/4"	4 @ 12 Ga.	2 1/8"	16"	39 1/4"	3 3/8"	3 3/8"	1 5/8"	1/2"	15 1/8"	1.96"	2.04"	2" x 32"	55	2 1/2" x 4 5/8"	4" x 17"	3 3/4"
	3	All	Exp.	10	166.4	8 3/8"	4 5/8"	18"	10"	4	1/2"	1/4"	5 @ 12 Ga.	3"	11"	30 1/2"	5"	3 3/8"	-	1/2"	12"	1.73"	2.27"	2" x 34"	55	2 1/2" x 5 3/8"	4" x 22 1/2"	3 3/4"

\* Maximum Design Load = Service I Limit State

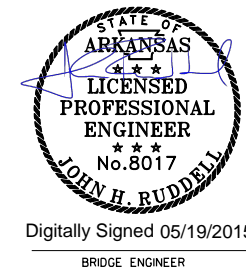

DETAILS OF ELASTOMERIC BEARINGS  
ROUTE SEC.  
ARKANSAS STATE HIGHWAY COMMISSION  
LITTLE ROCK, ARK.

Digitally Signed 05/19/2015  
BRIDGE ENGINEER

DRAWN BY: HEW DATE: MAR. 2015 FILENAME: B080517\_EI.dgn  
CHECKED BY: JHR DATE: MAR. 2015 SCALE: As Shown  
DESIGNED BY: DRG DATE: MAR. 2015  
BRIDGE NO. 07345 DRAWING NO. 57089

DRGNO: 5/19/2015 1:27:53 PM  
WORKSPACE: AHTD Bridge  
L:\2012\201590 - Centrefield Access\Drawings\6TH\_ST\B080517\_EI.dgn  
REVISED DATE:

DATE REVISED	DATE FILMED	DATE REVISED	DATE FILMED	FED. ROAD DIST. NO.	STATE	FED. AID PROJ. NO.	SHEET NO.	TOTAL SHEETS
				6	ARK.			
						080517	91	182
				07345		LIGHTING DETAILS		57090

ELECTRICAL SYMBOLS LEGEND

	NEW ACORN STYLE DECORATIVE LIGHT FIXTURE, SEE NOTES, PLANS AND SCHEDULES FOR MORE INFORMATION.
	PULLBOX
	CONDUIT & WIRE AS NOTED IN NOTES AND IN SCHEDULES.
	RELAY CONTACT, NORMALLY OPEN.
	CIRCUIT BREAKER, TRIP RATING SHOWN, 2-POLE UNLESS NOTED OTHERWISE.
	SURGE PROTECTIVE DEVICE WITH INDICATING LIGHTS.
	3/4" x 10' COPPER CLAD GROUND ROD.
	SERVICE POINT LOCATION
	20 AMP DUPLEX RECEPTACLE, WITH GROUND WIRE, "GFCI" INDICATES GROUND FAULT CIRCUIT INTERRUPTER.

ABBREVIATIONS

A	AMP	LO	LUGS ONLY
ABC	ABOVE COUNTER	LOR	LOCAL-OFF-REMOTE
ACS	ACCESS CONTROL SYSTEM	LSI	LONG, SHORT, INSTANTANEOUS
ACU	AIR CONDITIONING UNIT	LSIG	LONG, SHORT, INSTANTANEOUS, GROUND
AHU	AIR HANDLING UNIT	LV	LOW VOLTAGE
AIC	AMPS INTERRUPTING CAPACITY	MCB	MAIN CIRCUIT BREAKER
AM	AMP-METER	MCC	MOTOR CONTROL CENTER
ANN	ANNUNCIATOR	MCP	MOTOR CIRCUIT PROTECTOR
AP	AERIAL PRIMARY	MFR	MANUFACTURER
AS	AERIAL SECONDARY	MIN	MINIMUM
ATS	AUTOMATIC TRANSFER SWITCH	MLO	MAIN LUGS ONLY
AUX	AUXILIARY	MN	MASS NOTIFICATION
BFI	BLOWN FUSE INDICATOR	MON	MONACO
BI	BYPASS ISOLATION	MS	MOTOR STARTER
BKR	BREAKER	MTS	MANUAL TRANSFER SWITCH
C	CONDUIT	N	NEUTRAL
CB	CIRCUIT BREAKER	NFDS	NON-FUSED DISCONNECT SWITCH
CCTV	CLOSED CIRCUIT TELEVISION	NL	NIGHT LIGHT
CGRS	PVC COATED GALVANIZED RIGID STEEL	OH	OVERHEAD
CKT	CIRCUIT	OHP	OVERHEAD PRIMARY
COM	COMMON	OHS	OVERHEAD SECONDARY
CONT	CONTINUOUS	OL	OVERLOAD
CP	CONTROL PANEL	PB	PUSH BUTTON
CPT	CONTROL POWER TRANSFORMER	PEC	PHOTO ELECTRIC CELL
CR	CONTROL RELAY	PF	POWER FACTOR
CRI	COLOR RENDERING INDEX	PFCC	POWER FACTOR CORRECTION CAPACITOR
CS	CORD SET	PL	PILOT LIGHT
CU	COEFFICIENT OF UTILIZATION	PMR	PHASE MONITOR RELAY
DEB	DIRECT EARTH BURIED	PNL	PANEL
EC	EMPTY OR EMBEDDED CONDUIT	PTT	PUSH-TO-TEST
EF	EXHAUST FAN	PTZ	PAN-TILT-ZOOM
EG	EQUIPMENT GROUND	PVC	SCHEDULE 40 POLYVINYL CONDUIT
EL	ELEVATION	RECPT	RECEPTACLE
EMT	ELECTRICAL METALLIC TUBING	RVAT	REDUCED VOLTAGE AUTO-TRANSFORMER STARTER
ETM	ELASPED TIME METER	SA	SURGE ARRESTER
FC	FAN COIL	SDBC	SOFT DRAWN BARE COPPER
FDS	FUSED DISCONNECT SWITCH	SE	SERVICE ENTRANCE
FOC	FIBER OPTIC CABLE	SN	SOLID NEUTRAL
FVNR	FULL VOLTAGE NON-REVERSING STARTER	SPD	SURGE PROTECTIVE DEVICE
FVR	FULL VOLTAGE REVERSING STARTER	SS	STAINLESS STEEL
GFCI	GROUND FAULT CIRCUIT INTERRUPTER	STA	STATION
GND	GROUND	SW	SWITCH
GRS	GALVANIZED RIGID STEEL	TC	TIME CLOCK
HID	HIGH INTENSITY DISCHARGE	TD	TIME DELAY
HOA	HAND-OFF-AUTO	TDD	TIME DELAY ON DE-ENERGIZATION
HP	HORSEPOWER OR HEAT PUMP	TDE	TIME DELAY ON ENERGIZATION
IDS	INTRUSION DETECTION SYSTEM	TEL	TELEPHONE
HR	HOUR	THD	TOTAL HARMONIC DISTORTION
IC	ISOLATED GROUND	TMGB	TELECOMMUNICATIONS MAIN GROUND BAR
ISP	INDIVIDUALLY SHIELDED PAIR	TGB	TELECOMMUNICATIONS GROUND BAR
JB	JUNCTION BOX	TR	TAMPER RESISTANT
KVA	KILOVOLT-AMPERE	UG	UNDERGROUND
KVAR	KILOVOLT-AMPERE, REACTIVE	UGE	UNDERGROUND ELECTRIC
KW	KILOWATT	UGP	UNDERGROUND PRIMARY
LA	LIGHTNING ARRESTER	UGS	UNDERGROUND SECONDARY
LC	LIGHTING CONTACTOR	UH	UNIT HEATER
LLF	LIGHT LOSS FACTOR	UON	UNLESS OTHERWISE NOTED
		UTP	UNSHIELDED TWISTED PAIR
		V	VOLT
		VA	VOLT-AMP
		VFD	VARIABLE FREQUENCY DRIVE
		VM	VOLT-METER
		W	WATT OR WIRE
		WAP	WIRELESS ACCESS POINT
		WH	WEATHER HEAD
		WM	WATT METER
		WP	WEATHERPROOF
		XFMR	TRANSFORMER

GENERAL NOTES:

- SOME SYMBOLS OR ABBREVIATIONS MAY APPEAR ON THIS SHEET BUT NOT BE UTILIZED ON THE PROJECT.
- LIGHTING LEGEND SHOWS EXAMPLE IDENTIFIERS, REFER TO LIGHT FIXTURE SCHEDULE FOR SPECIFIC REQUIREMENTS.
- ALL PARTS OF THIS INSTALLATION SHALL BE IN ACCORDANCE WITH THE ARKANSAS HIGHWAY AND TRANSPORTATION DEPARTMENT STANDARDS AND DETAILS, AND WITH THE MANUAL ON UNIFORM TRAFFIC CONTROL DEVICES, CURRENT EDITIONS.
- CONDUIT INSTALLED UNDER ROADWAY SECTIONS SHALL BE INSTALLED BY PUSHING OR BORING METHODS. IF THE ENGINEER DETERMINES THIS IS NOT FEASIBLE, THEN A TRENCHING METHOD MAY BE USED.
- CONTRACTOR MAY USE HDPE OR PVC FOR BORING. SECTIONAL PVC SHALL BE UL LISTED AND MARKED FOR USE IN DIRECTIONAL BORING.


DRG004 5/19/2015 1:27:53 PM  
 WORKSPACE: AHTD Bridge  
 L:\2012\201590 - CentrelField Access\Drawings\6TH\_ST\B080517\_LPI.dgn  
 REVISED DATE:




**ELECTRICAL LEGEND**  
 ROUTE SEC.  
**ARKANSAS STATE HIGHWAY COMMISSION**  
 LITTLE ROCK, ARK.

DRAWN BY: NAH DATE: FEB. 2015 FILENAME: B080517\_LPI.dgn  
 CHECKED BY: ECF DATE: FEB. 2015 SCALE: No Scale  
 DESIGNED BY: NAH DATE: FEB. 2015  
 BRIDGE NO. 07345 DRAWING NO. 57090

DATE REVISED	DATE FILMED	DATE REVISED	DATE FILMED	FED. ROAD DIST. NO.	STATE	FED. AID PROJ. NO.	SHEET NO.	TOTAL SHEETS
				6	ARK.			
				JOB NO.		080517	92	182
				07345		LIGHTING DETAILS		57091

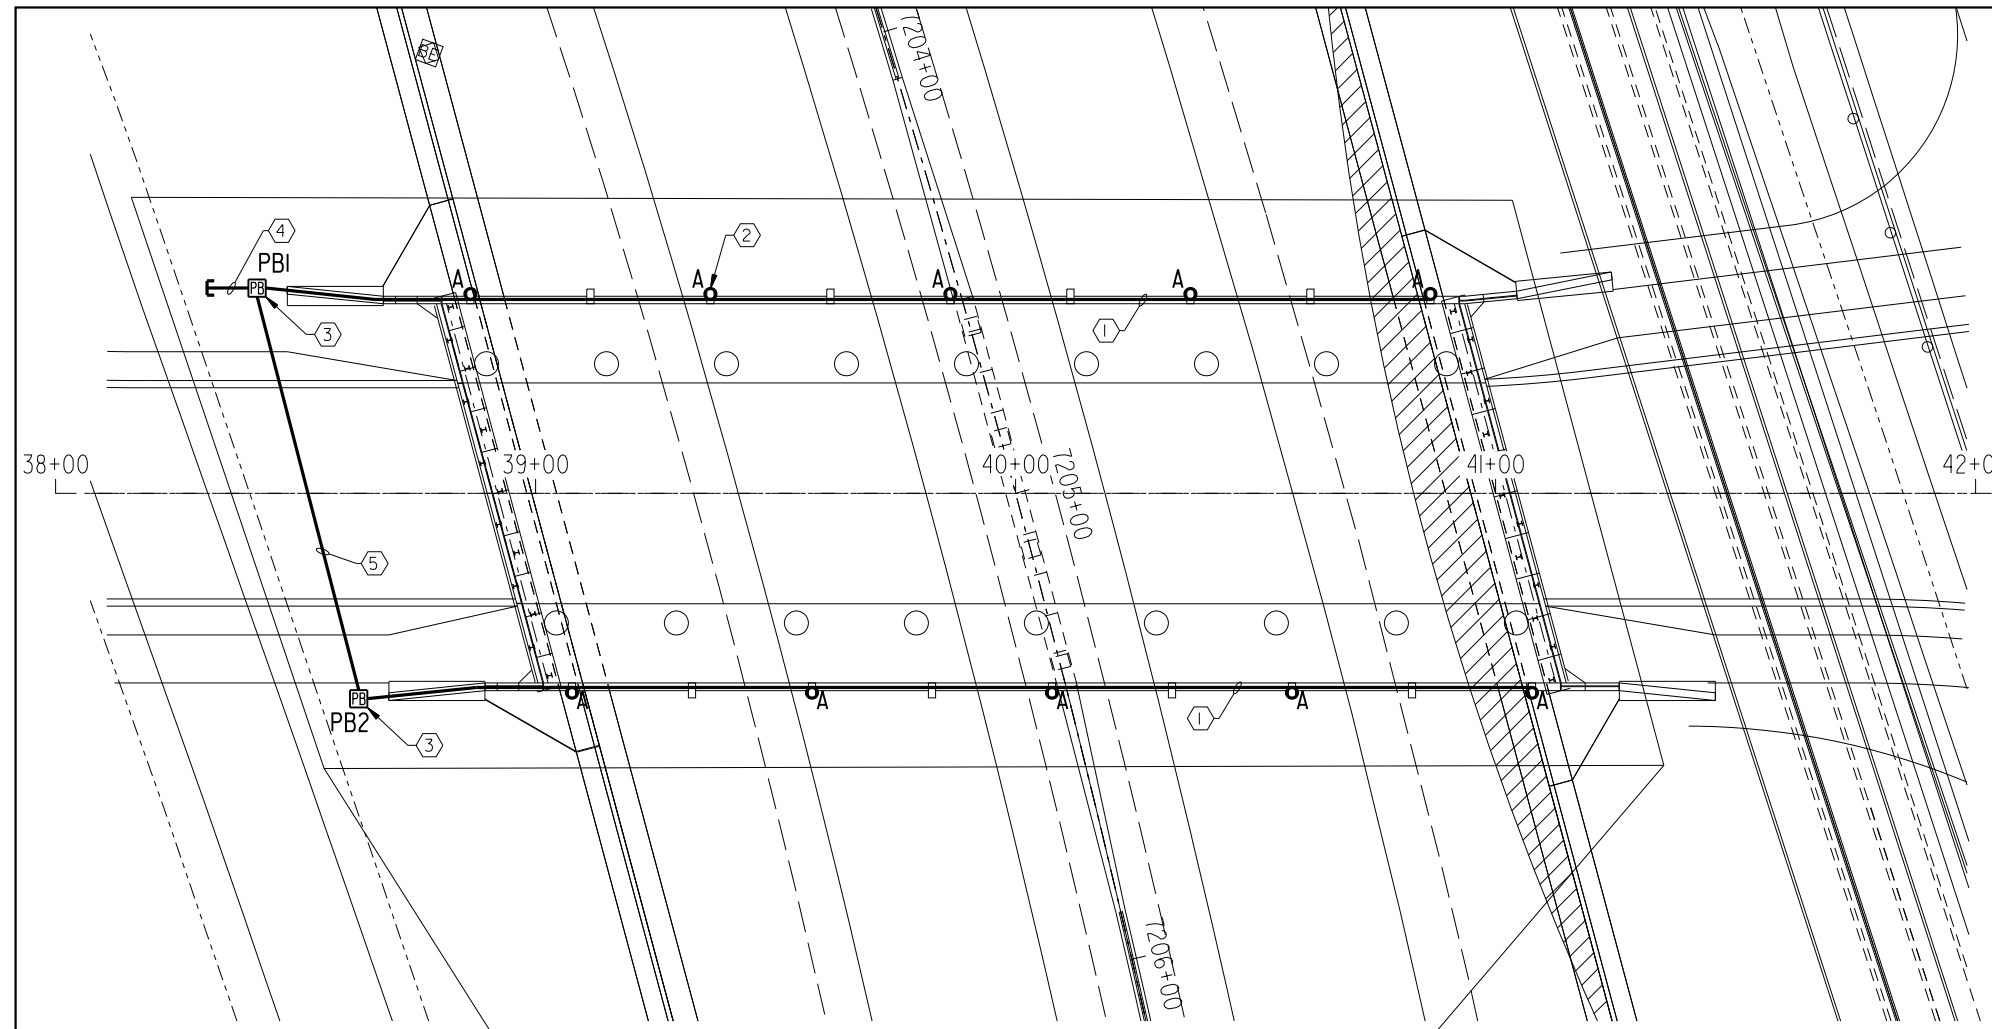

ENLARGED OVERPASS LIGHTING PLAN  
SCALE: 1"=20'

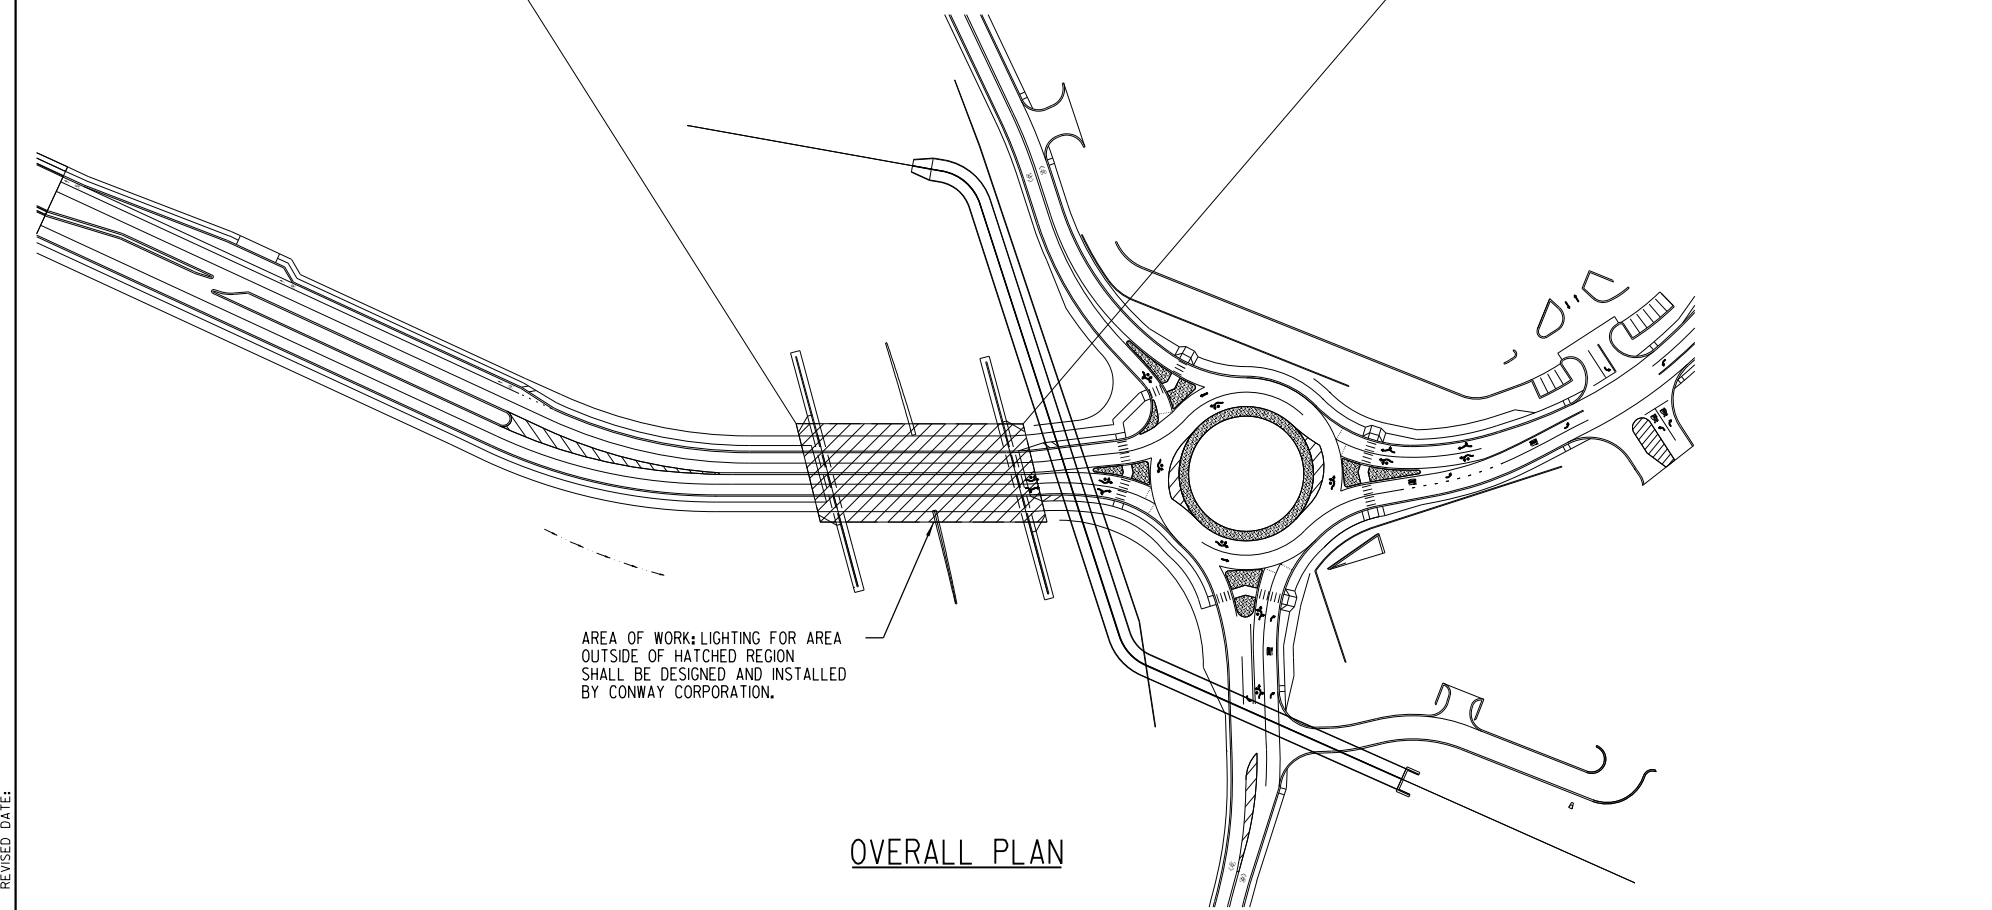

AREA OF WORK: LIGHTING FOR AREA OUTSIDE OF HATCHED REGION SHALL BE DESIGNED AND INSTALLED BY CONWAY CORPORATION.

OVERALL PLAN

LIGHT FIXTURE SCHEDULE						
TYPE	DESCRIPTION	MANUFACTURER CATALOG NUMBER	LAMPS		VOLTAGE	REMARKS
			WATTS	TYPE		
A	DECORATIVE ACORN FIXTURE	STERBERG A850ASRLD/C56T/6ARC45T3R/MDL03/CDR/BKT	96W	LED	240V	1
	TAPERED OCTAGONAL POLE	WHATLEY X065/DI6M/10/AB/BLK/30/-30				

STATISTICS (BASED ON 0.76 LLF)					
DESCRIPTION	AVG	MAX	MIN	MAX/MIN	AVG/MIN
ROADWAY SIDE	1.2 fc	2.6 fc	0.4 fc	6.5:1	3.0:1
PEDESTRIAN SIDE	2.7 fc	3.1 fc	1.5 fc	2.1:1	1.8:1

FIXTURE SCHEDULE NOTES:  
1. PROVIDE FIXTURES LISTED AND LABELED FOR WET LOCATION.

ILLUMINATION DESIGN CRITERIA TABLE			
DESCRIPTION	AVG	MIN	AVG/MIN
ROADWAY SIDE	1.2 fc	0.4 fc	3.0:1
PEDESTRIAN SIDE	1.5 fc	0.5 fc	3.0:1

LIGHTING CALCULATIONS NOTES:  
1. LIGHTING CALCULATIONS WERE PERFORMED USING LITHONIA LIGHTING VISUAL PROFESSIONAL EDITION VERSION 2.7 SOFTWARE.  
2. LIGHTING LEVELS ARE IN FOOTCANDLE UNITS (fc).  
3. DESIGN BASIS IS THE ILLUMINATING ENGINEERING SOCIETY OF NORTH AMERICA, IESNA LIGHTING HANDBOOK, 10TH EDITION AND RP-8-00.

GENERAL NOTES

- OVERPASS LIGHTING IS DESIGNED AROUND STERNBERG MODEL #A850ASRLD-6ARC45T3R. FIXTURE MODEL IS REQUIRED FOR MAINTENANCE AND AESTHETIC REASONS.
- FIXTURE SHALL BE MOUNTED ON 10' POLE WITH VIBRATION DAMPENOR INSTALLED INTEGRAL TO THE POLE.
- OVERPASS LIGHTING SHALL BE CONNECTED TO CONWAY CORPORATION ROADWAY LIGHTING PEDESTAL FOR POWER (INSTALLED BY OTHERS). CONTRACTOR SHALL COORDINATE WORK WITH CONWAY CORPORATION TO ENSURE PROPER OPERATION OF LIGHTING ON OVERPASS ONCE CONNECTED WITH CONWAY CORPORATION POWER SYSTEM.
- COORDINATE ALL ELECTRICAL WORK WITH THE BRIDGE LAYOUT. CONTRACTOR SHALL COORDINATE LOCATION AND ROUTING OF CONDUIT WITH BRIDGE ENGINEER SUCH THAT THERE ARE MINIMUM PENETRATIONS TO THE BRIDGE STRUCTURE.
- EXPOSED CONDUIT SHALL BE COATED GALVANIZED RIGID STEEL. CONDUIT EMBEDDED IN THE PARAPET WALL SHALL BE GALVANIZED RIGID STEEL. CONDUIT BURIED IN EARTH SHALL BE SCHEDULE 40 PVC. CONDUIT BURIED BELOW ROADWAY SHALL BE SCHEDULE 80 PVC.
- LABEL CABLES IN ALL HANDHOLES AND JUNCTION BOXES. (TYPICAL)
- CONTRACTOR SHALL INSTALL TWO (2) 1-1/2" GRSC IN PARAPET WALLS, ONE FOR POWER TO FIXTURES, ONE AS SPARE.
- LIGHT FIXTURE AND POLE COLORS SHALL BE COORDINATED AND SELECTED BY THE CITY OF CONWAY AND ENGINEER DURING SHOP DRAWING REVIEW. ALL FIXTURES SHALL BE WET LOCATION RATED.

KEYED NOTES:

- INSTALL NEW ALUMINUM CONDUCTORS (2\*10, 1\*10 EGC) 1-1/2" C. TYPICAL.
- INSTALL NEW DECORATIVE ACORN LED FIXTURE, SEE SCHEDULE AND DETAILS FOR MORE INFORMATION. TYPICAL.
- INSTALL NEW PULLBOX, SEE DETAILS FOR MORE INFORMATION.
- INSTALL WATERTIGHT CAPPED 1-1/2" STUBOUT AS INDICATED. COORDINATE CONNECTION TO LIGHTING SYSTEM AND SERVICE POINT WITH CONWAY CORPORATION.
- INSTALL 1-1/2" SCHEDULE 80 PVC MINIMUM OF 24" BELOW ROADWAY SURFACE. COORDINATE WITH BRIDGE AND ROADWAY INSTALLATION.





BRIDGE LIGHTING  
INSTALLATION PLAN  
ROUTE SEC.  
ARKANSAS STATE HIGHWAY COMMISSION  
LITTLE ROCK, ARK.

DRAWN BY: NAH DATE: FEB. 2015 FILENAME: B080517\_LP2.dgn  
CHECKED BY: ECF DATE: FEB. 2015 SCALE: 1" = 20'  
DESIGNED BY: NAH DATE: FEB. 2015  
BRIDGE NO. 07345 DRAWING NO. 57091

DRGNO: 5/19/2015 1:27:57 PM  
 WORKSPACE: AHTD Bridge  
 L:\2012\201590 - Centrel\field Access\Drawings\6TH\_ST\B080517\_LP2.dgn  
 REVISED DATE:

Digitally Signed 05/19/2015  
BRIDGE ENGINEER

DATE REVISED	DATE FILMED	DATE REVISED	DATE FILMED	FED. ROAD DIST. NO.	STATE	FED. AID PROJ. NO.	SHEET NO.	TOTAL SHEETS
				6	ARK.			
				JOB NO.		080517	93	182
				07345		LIGHTING DETAILS		57092

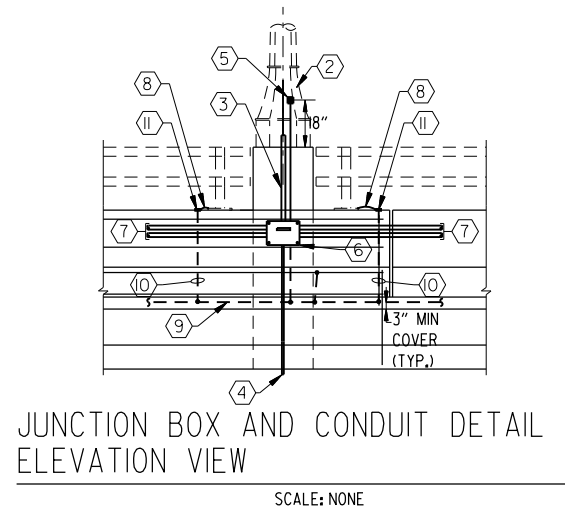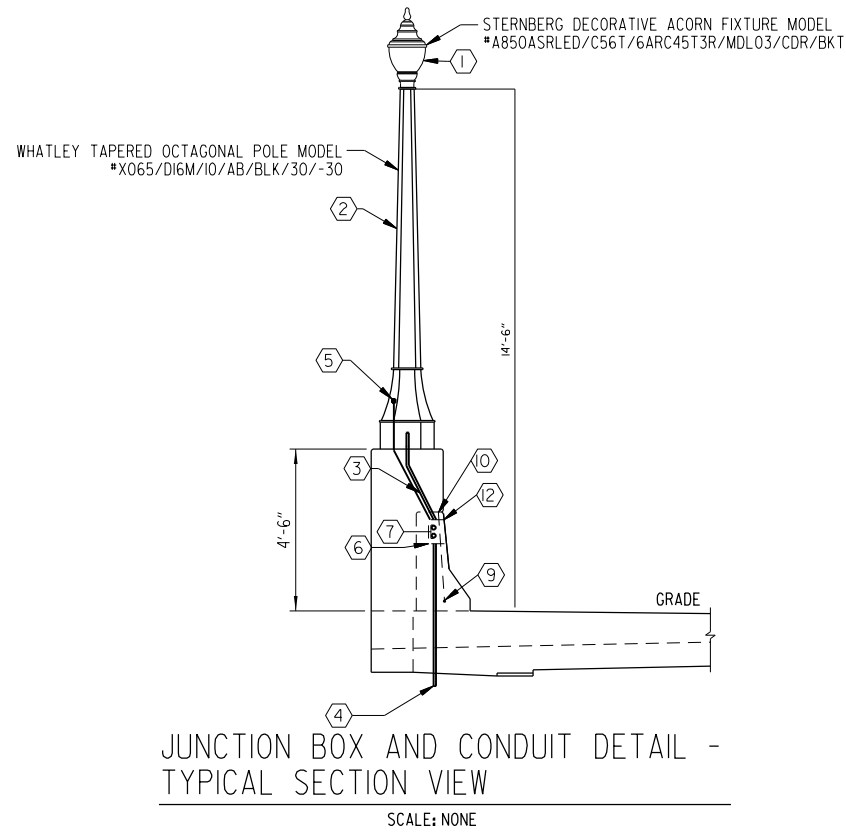

3" MIN WIDTH

CAUTION BURIED ELECTRIC LINE BELOW

**GENERAL NOTES:**

- POWER MARKING TAPES SHALL BE DETECTABLE TYPE CONSTRUCTION WITH RED BACKGROUND AND BLACK LETTERING.
- COMMUNICATION MARKING TAPES SHALL BE DETECTABLE TYPE CONSTRUCTION WITH ORANGE BACKGROUND AND BLACK LETTERING, "TELEPHONE LINE" OR "FIBER OPTIC LINE" RESPECTIVELY.
- TAPE SHALL BE DETECTABLE, DURABLE, HIGHLY VISIBLE, RESISTANT TO ELEMENTS, MEETING AND/OR EXCEEDING ALL INDUSTRY STANDARDS.

**UNDERGROUND DETECTABLE WARNING TAPE**

SCALE: N.T.S.

**KEYED NOTES:**

- INSTALL NEW LIGHT FIXTURE ON POLE. SEE FIXTURE SCHEDULE AND LAYOUT PLANS FOR MORE INFORMATION.
- INSTALL NEW POLE WITH HANDHOLE FACING WALKWAY. INSTALL NEW IN-LINE FUSE HOLDERS AND FUSES. EQUIPMENT SHALL BE FULLY ACCESSIBLE VIA HANDHOLE.
- INSTALL NEW 1" GRSC AND CONDUCTORS FROM POLE BASE TO ADJACENT JUNCTION BOX.
- INSTALL NEW 1/2" GRSC FROM JUNCTION BOX TO UNDERSIDE OF BRIDGE, EXTEND 3" BELOW BRIDGE AND INSTALL DRAIN/BREATHER AT END.
- INSTALL NEW GROUNDING BUSHING, BOND DEDICATED #6 AWG COPPER GROUND WIRE TO POLES, TO BUSHING AND TO JUNCTION BOXES.
- INSTALL NEW NEMA 4X STAINLESS STEEL JUNCTION BOX RECESSED IN THE PARAPET WALL WITH THE FOLLOWING ITEMS. SEE DETAIL C THIS SHEET:
  - 8" H x 8" W x 6" D MINIMUM SIZE. TOP OF BOX SHALL BE A MINIMUM OF 8" BELOW TOP OF BARRIER WALL.
  - CAPTIVE TYPE TAMPER RESISTANT, FLUSH HEAD SS SCREWS FOR GASKETED COVER.
  - MOUNTING BACK PANEL WITH JUNCTION BOX, FULL SIZED.
  - 2" x 4" x 1/4" COPPER GROUND BAR WITH MINIMUM OF 10 LUGS.
  - EXTERNAL GROUND LUG, BOND TO GROUND CONDUCTOR USING #6 AWG COPPER.
- BOND GROUND CONDUCTORS TO JUNCTION BOX, GROUND BAR AND ALL OTHER GROUND CONDUCTORS. LABEL USING CABLE MARKERS AND COLOR CODE TAPE ALL CONDUCTORS WITHIN EACH JUNCTION BOX. INSTALL NEW (2) 1-1/2" GRSC ELECTRICAL CONDUIT DUCT SYSTEM ALONG ENTIRE STRUCTURE:
  - LIGHTING CIRCUITS 240V IN 1-1/2" GRSC
  - SPARE 1-1/2" GRSC WITH PULLWIRE
 SECURE ELECTRICAL CONDUIT DUCT SYSTEM AND INSTALL GROUNDING AND BONDING TYPE BUSHINGS WITHIN ALL JUNCTION BOXES, BONDED TO GROUND. INSTALL NEW EXPANSION GRSC CONDUIT FITTINGS AT ALL EXPANSION JOINTS, SEE DETAIL D THIS SHEET.
- INSTALL NEW GROUNDING COMPRESSION TERMINAL AND CONNECT TO EMBEDDED 4 LUG GROUNDING PLATE VIA #6 AWG GROUND WIRE. TYPICAL FOR EACH SECTION OF HAND RAIL, UTILIZE INSTILLATION METHODS TO PREVENT VANDALISM.
- INSTALL NEW DEDICATED #4/0 AWG COPPER GROUND WIRE ALONG ENTIRE STRUCTURE. EMBEDDED IN BRIDGE WALL. BOND POLE TO GROUND WIRE AND BOND JUNCTION BOX TO GROUND WIRE USING #6 AWG COPPER AND EXOTHERMIC WELDS ONLY.
- INSTALL #2 AWG COPPER GROUND WIRE AND BOND EACH HAND RAIL SECTION TO GROUND WIRE SYSTEM. UTILIZE APPROVED INSTALLATION METHODS TO PREVENT VANDALISM.
- INSTALL NEW EMBEDDED 4 LUG GROUNDING PLATE. CONNECT #2 GROUND WIRE USING GROUNDING COMPRESSION TERMINAL (TYPICAL).
- ALL JUNCTION BOXES SHALL BE FLUSH WITH CONCRETE SURFACE.

**GENERAL NOTES:**


- INSTALL NEW TAPERED, OCTAGONAL, FIBERGLASS COMPOSITE CORE, ELASTOMERIC CLAD URETHANE POLE SHAFT, ACCESSIBLE GROUNDING PROVISION, BASE COVER, VIBRATION DAMPER, ALL REQUIRED MOUNTING ACCESSORIES. SEE DETAILS FOR SIZE AND GAUGE REQUIREMENTS. INSTALL HANDHOLE WITH CAPTIVE TYPE TAMPER RESISTANT SCREWS FACING THE PEDESTRIAN WALKWAY. HANDHOLE COVER SHALL HAVE SAFETY CHAIN SECURED TO POLE INTERIOR. POLE SHALL BE DESIGNED FOR THE TOTAL EFFECTIVE PROJECTED AREA OF ALL LIGHT FIXTURES AT A 90 MPH BASIC WIND SPEED WITH 3 SECOND GUST. ALL POLES SHALL BE DESIGNED TO MEET THE AASHTO STANDARD SPECIFICATIONS FOR STRUCTURAL SUPPORTS FOR HIGHWAY SIGNS, LUMINAIRES AND TRAFFIC SIGNALS, CURRENT EDITION.
- LIGHT FIXTURE AND POLE COLORS SHALL BE COORDINATED AND SELECTED BY THE OWNER AND ENGINEER DURING SHOP DRAWING REVIEW. POLE SHALL INCLUDE PRE-TREATMENT PROCESSES AND POWDER COAT FINISH TO PREVENT CORROSION. ALL FIXTURES TO BE WET LOCATION RATED.
- ACCEPTANCE CRITERIA SHALL CONSIST OF THE FOLLOWING:
  - SUBMIT COMPLETE SHOP DRAWING DATA FOR FIXTURE AND LAMP, INCLUDING IES FILE AND LLF CALCULATION.
  - SUBMIT COMPLETE POINT-BY-POINT PHOTOMETRIC LIGHTING ANALYSIS OF ALL GIVEN AREAS FOR BOTH INITIAL LUMEN AND LLF CALCULATIONS.
  - LLF DESIGN, LIGHTING ANALYSIS VALUES SHALL MEET OR EXCEED THE ILLUMINATION DESIGN CRITERIA TABLE REQUIREMENTS, NO EXCEPTION.
- FINAL ACCEPTANCE TESTING PROCEDURE SHALL CONSIST OF THE FOLLOWING:
  - SUBMIT TEST PROCEDURE FOR REVIEW AND APPROVAL.
  - CONDUCT MINIMUM 14-DAY FINAL ACCEPTANCE TEST FOR THE COMPLETE LIGHTING SYSTEM. CORRECT MALFUNCTIONING EQUIPMENT AND RETEST, OTHERWISE REMOVE AND REPLACE WITH NEW EQUIPMENT.
  - REPLACE BURNED OUT AND NOTICEABLY DIM LAMPS AND RETEST.
  - DURING FINAL ACCEPTANCE TEST PERIOD, TAKE FIELD LIGHT LEVEL MEASUREMENTS (ILLUMINANCE) ALONG THE ENTIRE STRUCTURE, IN A 10' GRID PATTERN COVERING ALL PAVED AREAS. FIELD LEVEL MEASUREMENTS AND CALCULATIONS SHALL MEET OR EXCEED INITIAL LUMEN DESIGN CALCULATIONS. COORDINATE FIELD WORK WITH OWNER AND ENGINEER.

DRG000 5/19/2015 1:27:57 PM  
 WORKSPACE: AHTD Bridge  
 L:\2012\201590 - CentrelField Access\Drawings\6TH\_ST\B080517\_LP3.dgn  
 REVISION DATE:

  
 Digitally Signed 05/19/2015  
 BRIDGE ENGINEER

SHEET 1 OF 2  
 ELECTRICAL DETAILS  
 ROUTE SEC.  
 ARKANSAS STATE HIGHWAY COMMISSION  
 LITTLE ROCK, ARK.  
 DRAWN BY: NAH DATE: FEB. 2015 FILENAME: B080517\_LP3.dgn  
 CHECKED BY: ECF DATE: FEB. 2015 SCALE: No Scale  
 DESIGNED BY: NAH DATE: FEB. 2015  
 BRIDGE NO. 07345 DRAWING NO. 57092


DATE REVISED	DATE FILMED	DATE REVISED	DATE FILMED	FED. ROAD DIST. NO.	STATE	FED. AID PROJ. NO.	SHEET NO.	TOTAL SHEETS
				6	ARK.			
				JOB NO.		080517	94	182
				07345	LIGHTING DETAILS			57093

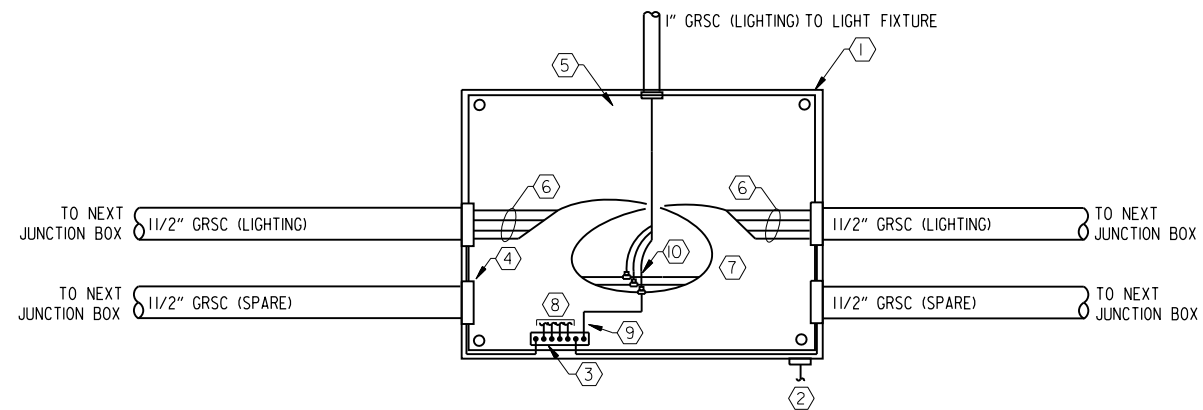

**KEYED NOTES:**

- ① INSTALL NEW NEMA 4X STAINLESS STEEL JUNCTION BOX RECESSED IN PARAPET WALL WITH TAMPER RESISTANT CAPTIVE HARDWARE. TOP OF BOX SHALL BE A MINIMUM OF 8" BELOW TOP OF BARRIER WALL.
- ② BOND EXTERNAL GROUND LUG USING #6 AWG COPPER TO #4/0 AWG GROUNDING CONDUCTOR SYSTEM.
- ③ INSTALL NEW COPPER GROUND BAR AND CONNECT ALL GROUND CONDUCTORS.
- ④ INSTALL NEW GROUNDING AND BONDING TYPE INSULATED BUSHINGS ON ALL CONDUITS AND BOND TO GROUND BAR (TYPICAL)
- ⑤ INSTALL NEW FULL-SIZE BACK PANEL FOR MOUNTING EQUIPMENT.
- ⑥ LOOP THE NEW LIGHTING CIRCUITS WITHIN EACH JUNCTION BOX, SLACK WIRE EQUAL TO ONE COMPLETE LOOP FOR FUTURE USE. NEATLY TRAIN AND LACE BRANCH CIRCUIT BUNDLES TOGETHER WITHIN THE BOX SECURED TO THE BACK PANEL WITH A SEPARATE BUNDLE FOR EACH BRANCH CIRCUIT.
- ⑦ ALL CABLES, SPLICES, TERMINATIONS, ETC. SHALL BE RATED 600 VOLTS, WATERPROOF METHOD.
- ⑧ BOND ALL BRANCH CIRCUIT GROUND WIRES TO GROUND BAR WITHIN EACH BOX (TYPICAL).
- ⑨ BOND LIGHT POLE GROUND TO GROUND BAR WITHIN EACH BOX (TYPICAL).
- ⑩ ALL CONDUCTORS SHALL BE CONTINUOUS FROM ORIGIN TO EQUIPMENT TERMINATION WITHOUT SPLICES. WHERE LIGHT FIXTURE TAPS ARE REQUIRED, TAPS SHALL BE MADE USING A SEALED, INSULATED PRESSURE CONNECTOR PROVIDING BOTH INSULATION AND JACKET EQUAL TO THE CABLE. CONNECTORS SHALL BE 600V RATED, 150 DEGREE C TEMPERATURE RATED, AND UL LISTED.


INTERIOR JUNCTION BOX VIEW  
SCALE: NONE

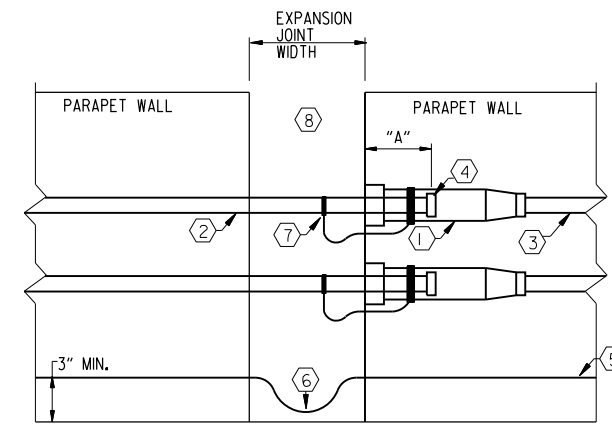

**KEYED NOTES:**


- ① INSTALL NEW EXPANSION JOINT FITTING COUPLING FOR 1 1/2" GRSC FLUSH WITH PARAPET WALL. PAINT COUPLING WITH PVC COATING FOR CORROSION PROTECTION PRIOR TO CONCRETE WORK, INSTALL AT ALL EXPANSION JOINTS.
- ② INSTALL NEW 1 1/2" GRSC RECESSED 3-1/2" IN EXPANSION COUPLING. EXPANSION COUPLING SHALL ALLOW FOR 4" OF CONDUIT MOVEMENT, PROVIDE O-Z/GEDNEY TYPE AX OR APPROVED EQUAL. PAINT ALL EXPOSED CONDUIT WITH PVC COATING AT EXPOSED AREAS AND 12" INTO PARAPET WALL FOR CORROSION PROTECTION PRIOR TO CONCRETE WORK.
- ③ INSTALL NEW 1 1/2" GRSC AND SECURE TO EXPANSION COUPLING, PAINT WITH PVC COATING 12" INTO PARAPET WALL FOR CORROSION PROTECTION PRIOR TO CONCRETE WORK.
- ④ INSTALL NEW BUSHING INSULATOR (TYPICAL).
- ⑤ INSTALL NEW DEDICATED #4/0 AWG COPPER GROUND WIRE, BOND TO ALL POLES AND JUNCTION BOXES.
- ⑥ INSTALL SLACK IN GROUND WIRE, COAT WITH PVC COATING AT EXPOSED AREA AND 12" INTO PARAPET WALL BOTH SIDES.
- ⑦ INSTALL NEW GROUNDING AND BONDING JUMPERS WITH SLACK ON EACH EXPANSION JOINT FITTING. PAINT WITH PVC COATING.
- ⑧ REFER TO BRIDGE DRAWINGS FOR EXPANSION JOINT LOCATIONS AND SIZES.

EXPANSION JOINT COUPLING DETAIL (TYPICAL)  
SCALE: NONE

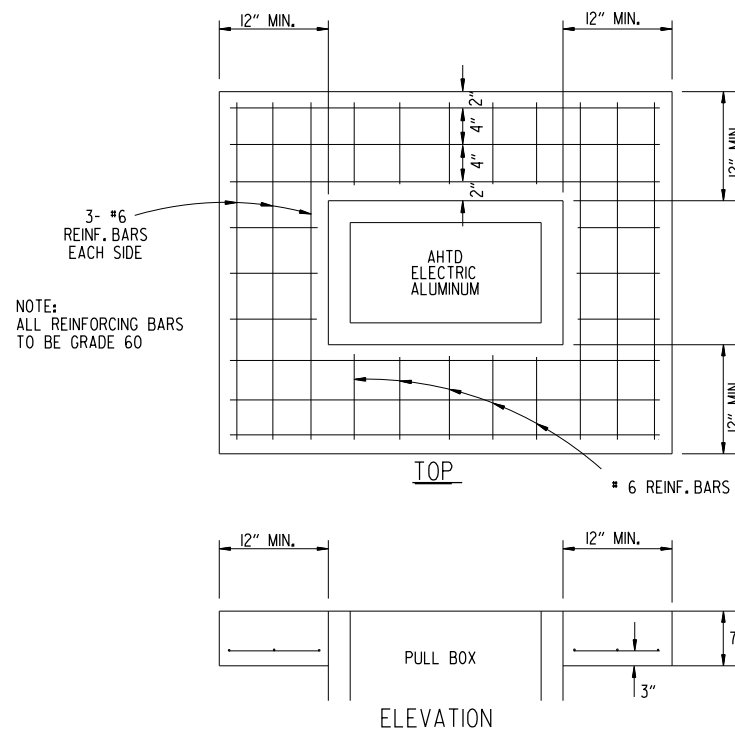

NOTE:  
ALL REINFORCING BARS  
TO BE GRADE 60

CONCRETE PULL BOX (TYPE SPECIAL HD) DETAIL  
SCALE: NONE

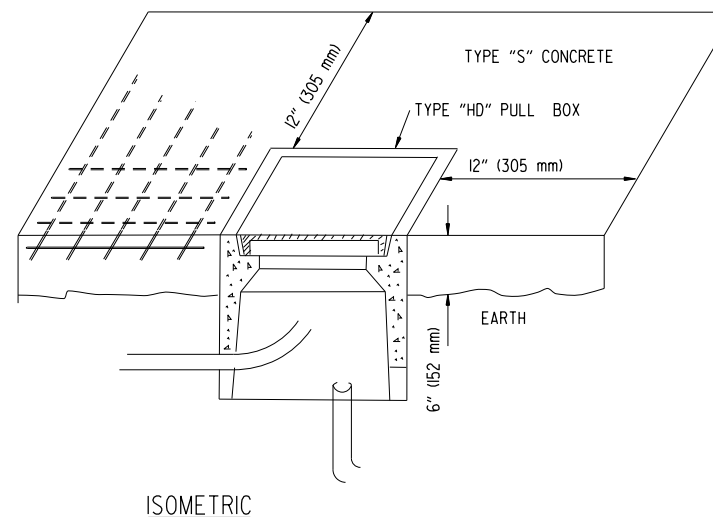

ISOMETRIC

**PULLBOX NOTES:**

- 1. ALL TYPE HD PULL BOXES ARE INSTALLED WITH AN APRON OF CONCRETE 12" (305 MM) WIDE AND 6" (152 MM) IN DEPTH. ALL PAYMENT SHALL BE INCLUDED IN THE PRICE OF THE TYPE HD PULL BOX. PULL BOX SHALL BE INSTALLED FLUSH TO SURROUNDING GRADE UNLESS OTHERWISE INSTRUCTED BY THE ENGINEER. THE CONCRETE SHALL BE CLASS "S." THREE #6 REINFORCING BARS IN THE APRON ON ALL SIDES OF THE PULL BOX ARE REQUIRED IN CONCRETE.
- 2. UL LISTED PULLBOX AND EXTRA HEAVY-DUTY COVER SHALL BE DESIGNED FOR A TEST LOAD OF 33,750 LBS AND A DESIGN LOAD OF 22,500 LBS.
- 3. PULLBOX INTERIOR DIMENSIONS SHALL BE 18"L x 24"W x 18"D (OPEN BOTTOM).
- 4. PROVIDE MINIMUM 3' SLACK CABLE LOOP FOR EACH CABLE.
- 5. COLOR CODE, TAG AND IDENTIFY ALL CABLES IN UL LISTED PULLBOX.
- 6. EXACT LOCATION OF EACH UL LISTED PULLBOX SHALL BE APPROVED BY CONWAY CORPORATION AND ENGINEER PRIOR TO INSTALLATION.




Digitally Signed 05/19/2015  
BRIDGE ENGINEER

SHEET 2 OF 2  
ELECTRICAL DETAILS  
ROUTE SEC.  
ARKANSAS STATE HIGHWAY COMMISSION  
LITTLE ROCK, ARK.  
DRAWN BY: NAH DATE: FEB. 2015 FILENAME: B080517-LP4.dgn  
CHECKED BY: ECF DATE: FEB. 2015 SCALE: No Scale  
DESIGNED BY: NAH DATE: FEB. 2015  
BRIDGE NO. 07345 DRAWING NO. 57093

D:\ROAD 5/19/2015 1:27:58 PM  
 WORKSPACE: AHTD Bridge  
 L:\2012\201590 - Conrail\field Access\Drawings\6TH\_ST\B080517-LP4.dgn  
 REVISED DATE:


DATE REVISED	DATE FILMED	DATE REVISED	DATE FILMED	FED. ROAD DIST. NO.	STATE	FED. AID PROJ. NO.	SHEET NO.	TOTAL SHEETS
				6	ARK.			
				JOB NO.		080517	95	182
				07345		RETAINING WALLS		57094

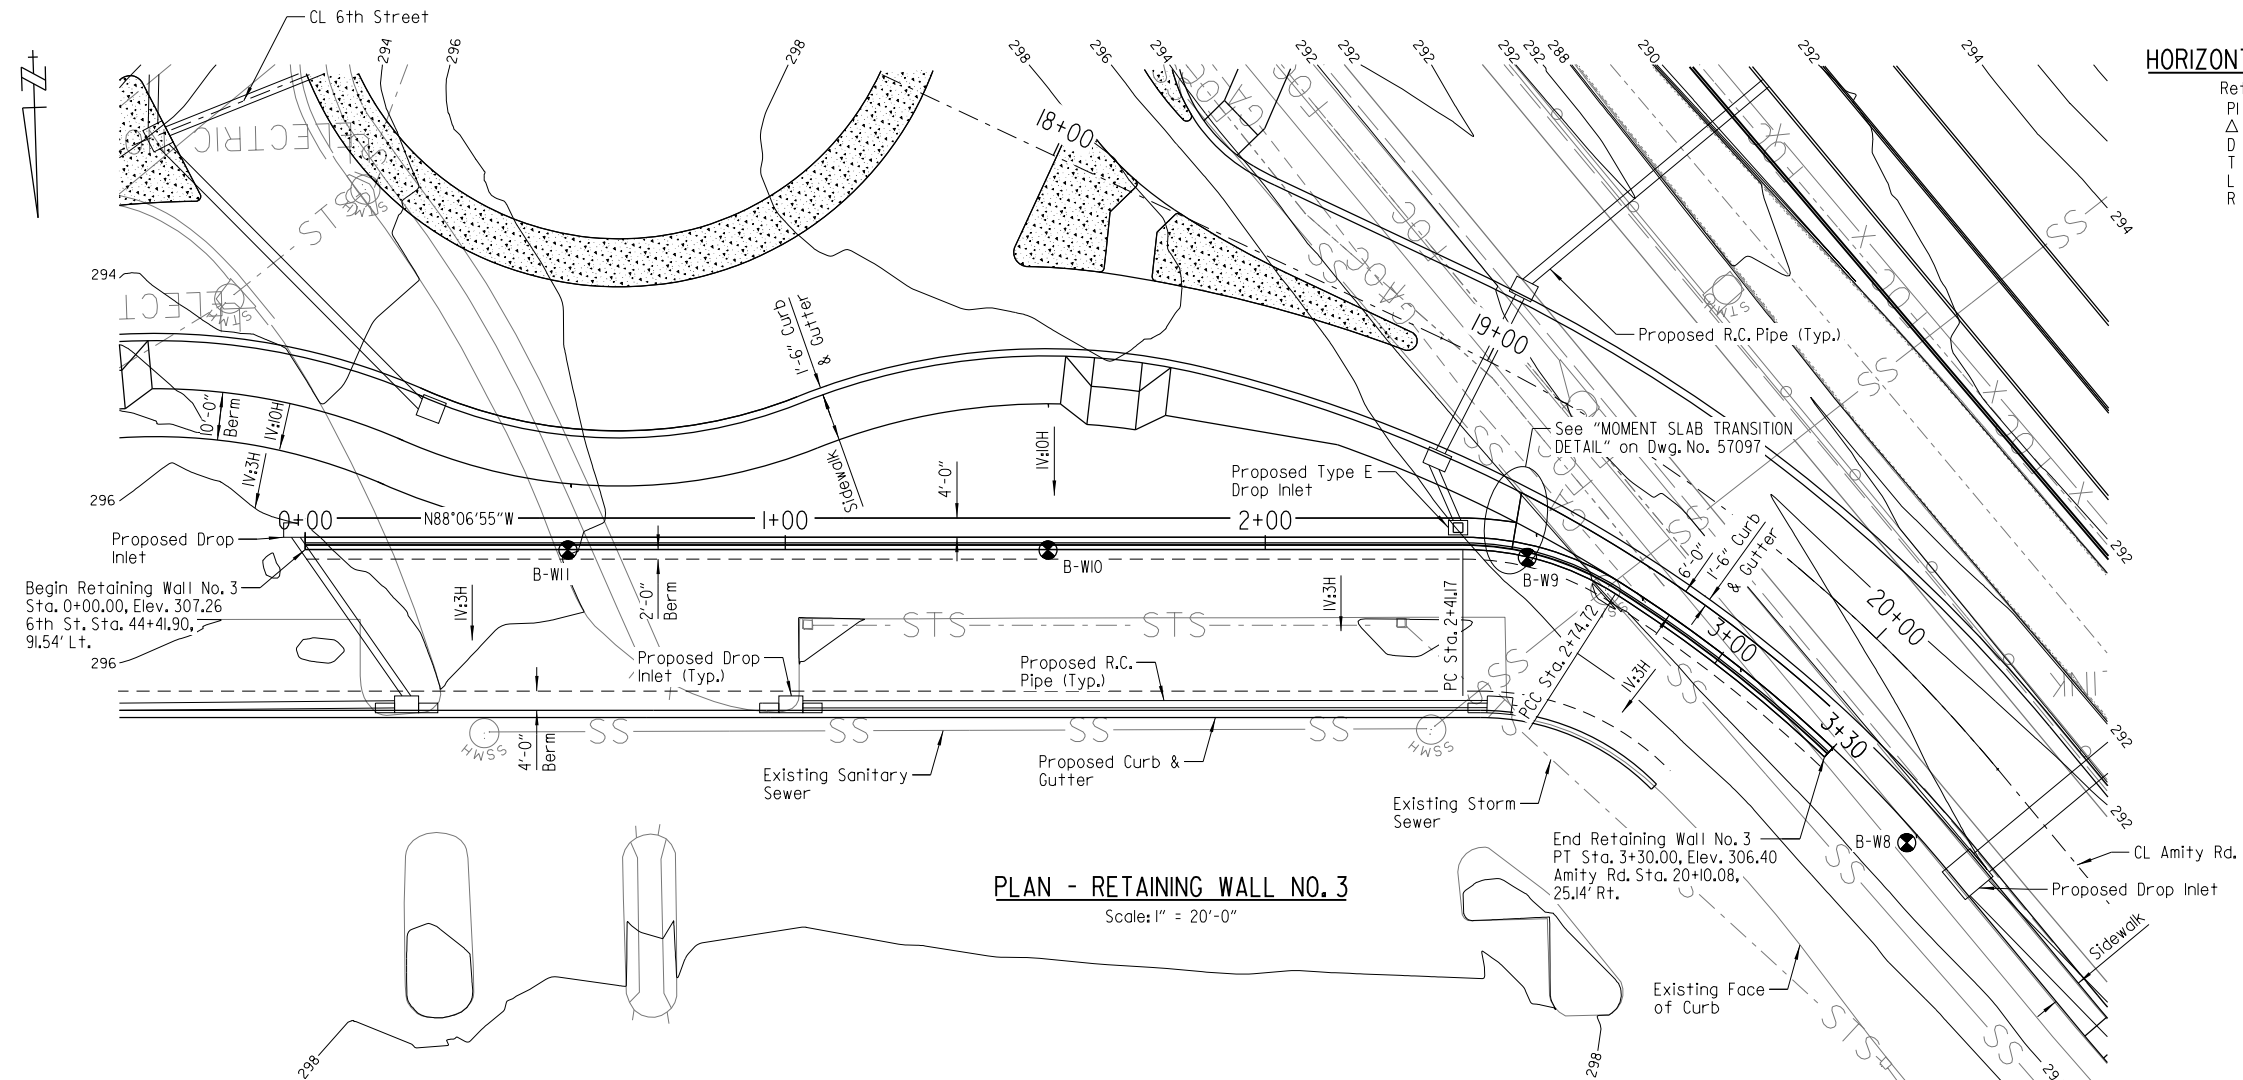


HORIZONTAL CURVE 1 DATA	HORIZONTAL CURVE 2 DATA
Retaining Wall No. 3 PI = 2+58.41 Δ = 32°30'40" Rt. D = 96°54'22" T = 17.24' L = 33.55' R = 59.13'	Retaining Wall No. 3 PI = 3+02.44 Δ = 10°55'28" Rt. D = 19°45'36" T = 27.73' L = 55.28' R = 289.96'

Station	Top Of Wall Elevation	Finished Grade Elevation
0+00.00	307.26	306.21
0+10.00	308.29	306.19
0+30.00	310.35	306.16
0+50.00	311.86	306.14
0+70.00	312.21	306.14
0+90.00	312.37	306.14
1+10.00	312.52	306.34
1+30.00	312.68	306.54
1+50.00	312.84	306.62
1+70.00	312.84	306.58
1+90.00	312.79	306.54
2+10.00	312.75	306.32
2+30.00	312.70	306.10
2+50.00	312.66	305.65
2+70.00	311.28	304.96
2+90.00	309.73	304.27
3+10.00	308.06	304.72
3+30.00	306.40	305.17

NOTE: Stations shown are along outside vertical face of Reinforced Concrete Retaining Wall.

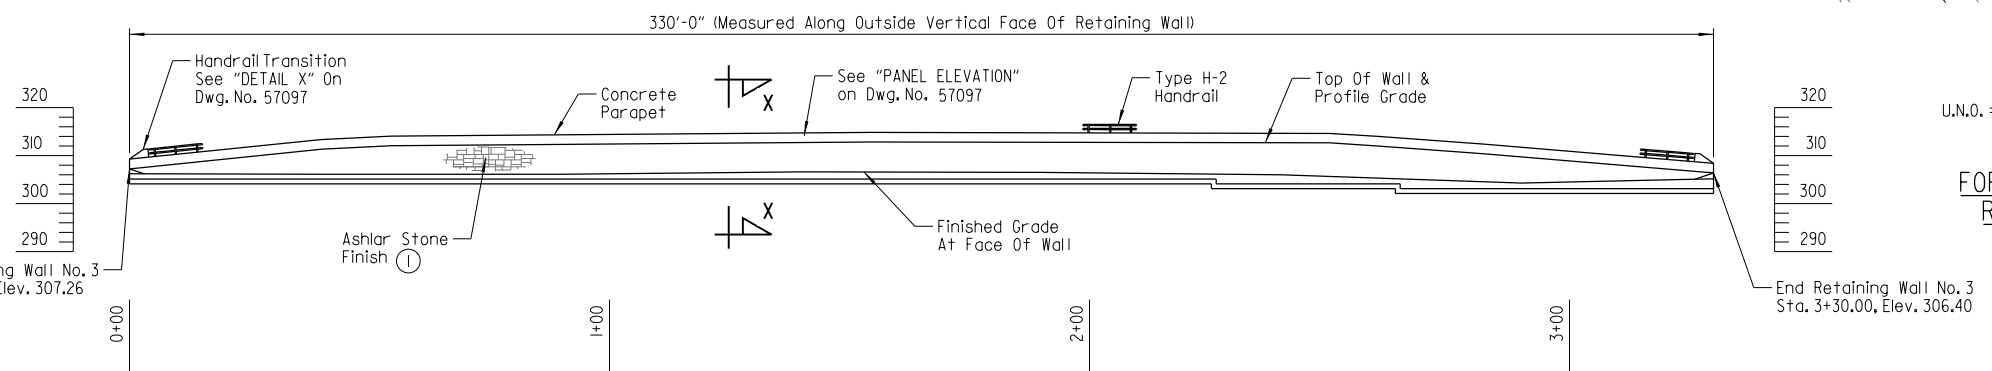


**LEGEND**  
U.N.O. = Unless Noted Otherwise  
  
FOR R/W DATA, SEE ROADWAY PLANS

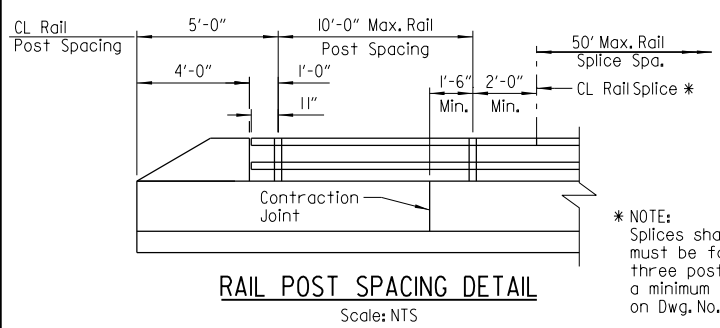

\* NOTE: Splices shall be at 50' max. spacing. Rail sections must be fabricated to attach to at least three posts. CL splices shall be located at a minimum of 2'-0" from CL Post. See "SPlice DETAIL" on Dwg. No. 57097.

① For details of architectural finish, see "SECTION X-X" on Dwg. No. 57098.

NOTES:  
For "SECTION X-X", see Dwg. No. 57098.  
  
Stationing shown is along outside vertical face of Reinforced Concrete Retaining Wall U.N.O.  
  
Offset dimensions are measured from CL Amity Rd. or CL 6th St. to outside vertical face of Retaining Wall.  
  
Elevations shown are at top of Reinforced Concrete Retaining Wall.  
  
Underdrain outlet shall penetrate front face of Retaining Wall.  
  
For details of Reinforced Concrete Retaining Wall, see Std. Dwg. SI-2.

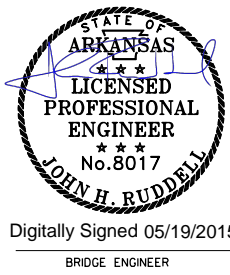


Digitally Signed 05/19/2015  
BRIDGE ENGINEER

SHEET 1 OF 5  
DETAILS OF RETAINING WALLS  
ROUTE SEC.  
ARKANSAS STATE HIGHWAY COMMISSION  
LITTLE ROCK, ARK.  
DRAWN BY: HEW DATE: NOV. 2014 FILENAME: B080517\_WI.dgn  
CHECKED BY: DRG DATE: MAR. 2015 SCALE: As Shown  
DESIGNED BY: SRY DATE: NOV. 2015  
BRIDGE NO. 07345 DRAWING NO. 57094

5/19/2015 8:00:39 PM  
 WORKSPACE: AHTD Bridge  
 L:\2012\201590 - Centrefield Access\Drawings\6TH\_ST\B080517\_WI.dgn  
 REVISED DATE:

DATE REVISED	DATE FILMED	DATE REVISED	DATE FILMED	FED. ROAD DIST. NO.	STATE	FED. AID PROJ. NO.	SHEET NO.	TOTAL SHEETS
				6	ARK.			
				JOB NO.		080517	96	182
				07345		RETAINING WALLS		57095

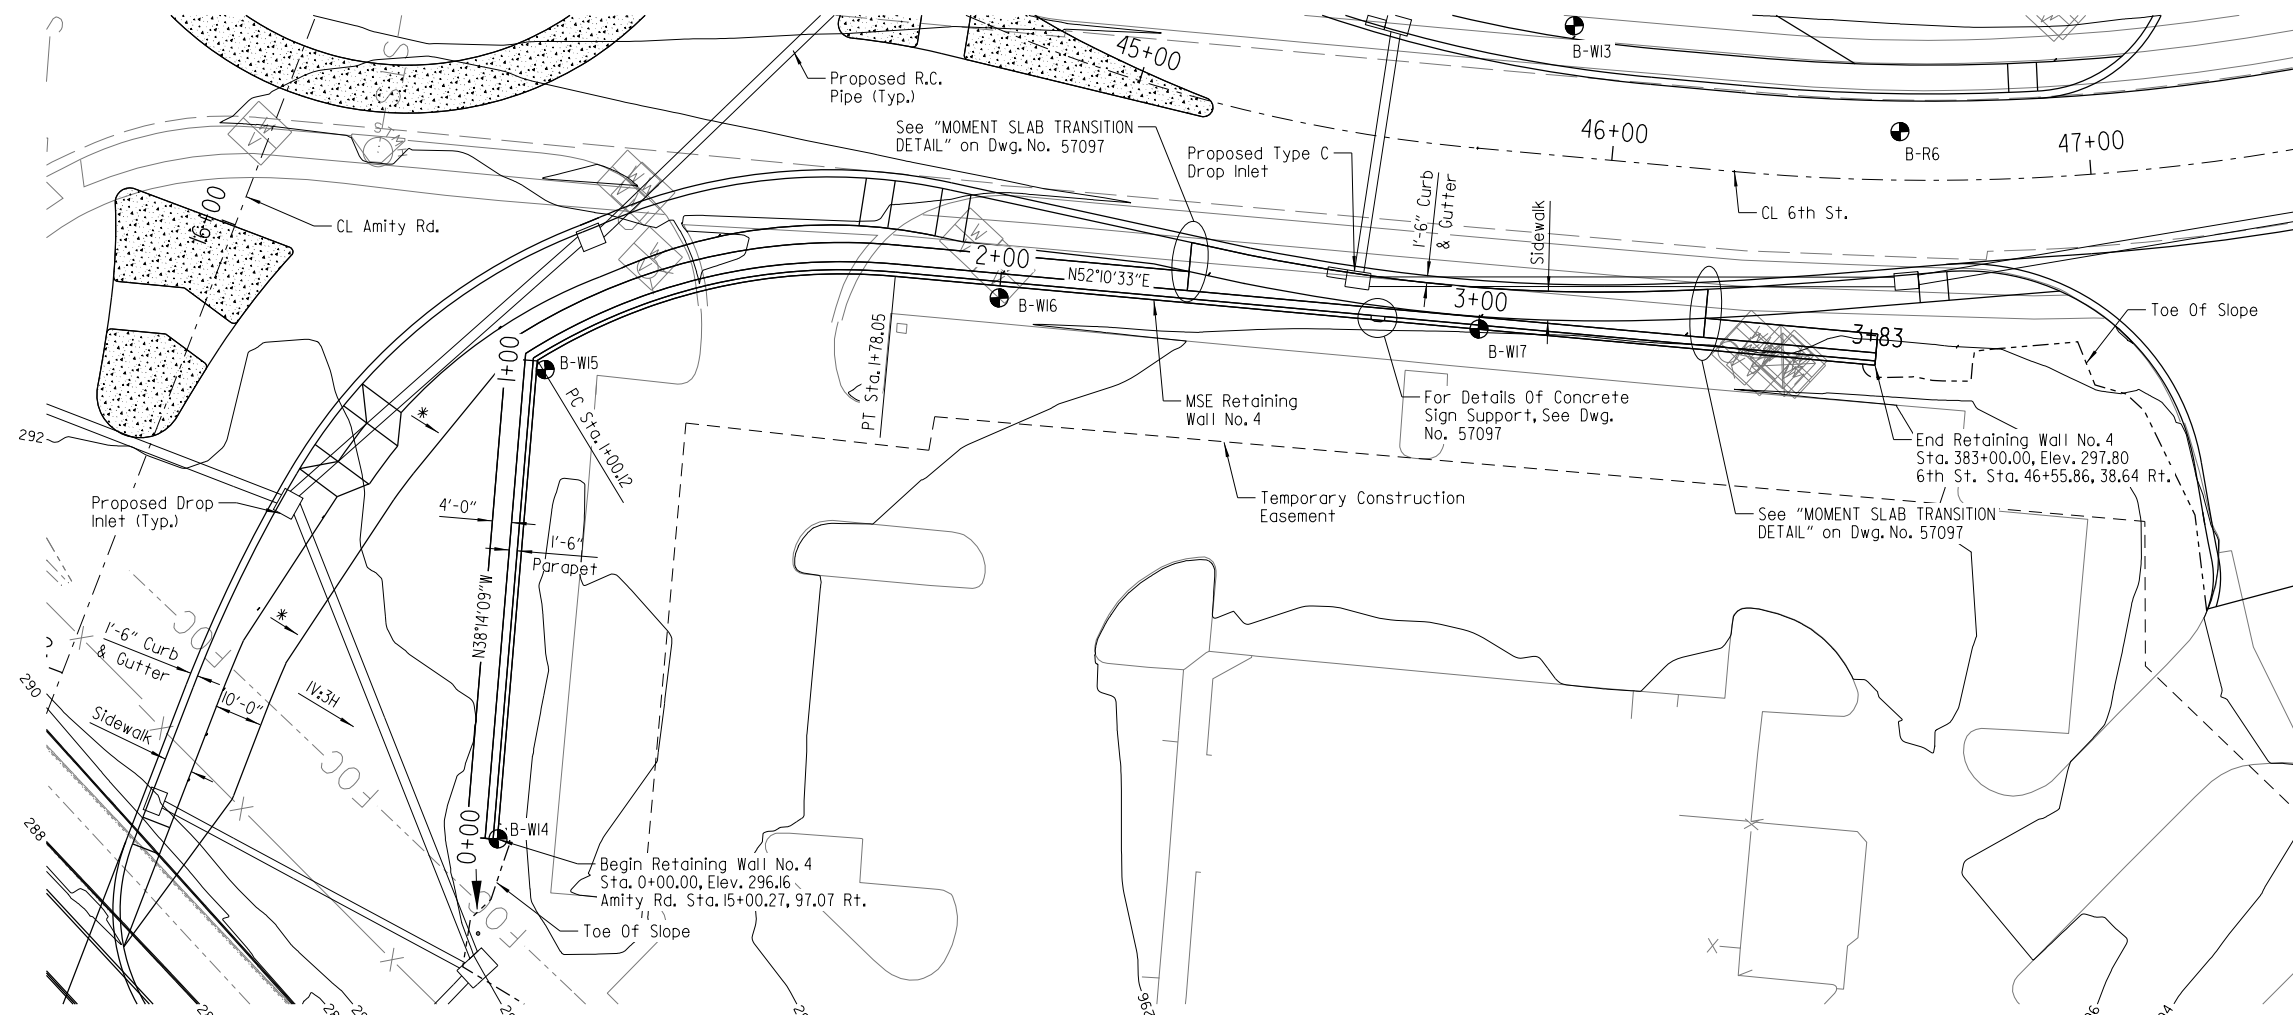

**HORIZONTAL CURVE DATA**

Retaining Wall No. 4  
 PI = 1+40.51  
 $\Delta$  = 27°10'19" Rt.  
 D = 47°41'48"  
 T = 40.39'  
 L = 77.93'  
 R = 120.13'


**LEGEND**

U.N.O. = Unless Noted Otherwise

**FOR R/W DATA, SEE ROADWAY PLANS**


**PLAN - MSE RETAINING WALL NO. 4**  
 Scale: 1" = 20'-0"

**NOTES:**  
 For "SECTION A-A" & "SECTION B-B", see Dwg. No. 57096.  
 Stationing shown is along outside vertical face of MSE Retaining Wall U.N.O.  
 Offset dimensions are measured from CL 6th St. or CL Amity Rd. to outside vertical face of MSE Retaining Wall.  
 Elevations shown are at top of MSE Wall coping.  
 Underdrain outlet shall penetrate front face of MSE Retaining Wall.  
 For "GENERAL NOTES", see Dwg. No. 57096.  
 For "TABLE OF MSE RETAINING WALL NO. 4 ELEVATIONS", see Dwg. No. 57096.  
 For "RAIL POST SPACING DETAIL", see Dwg. No. 57094.

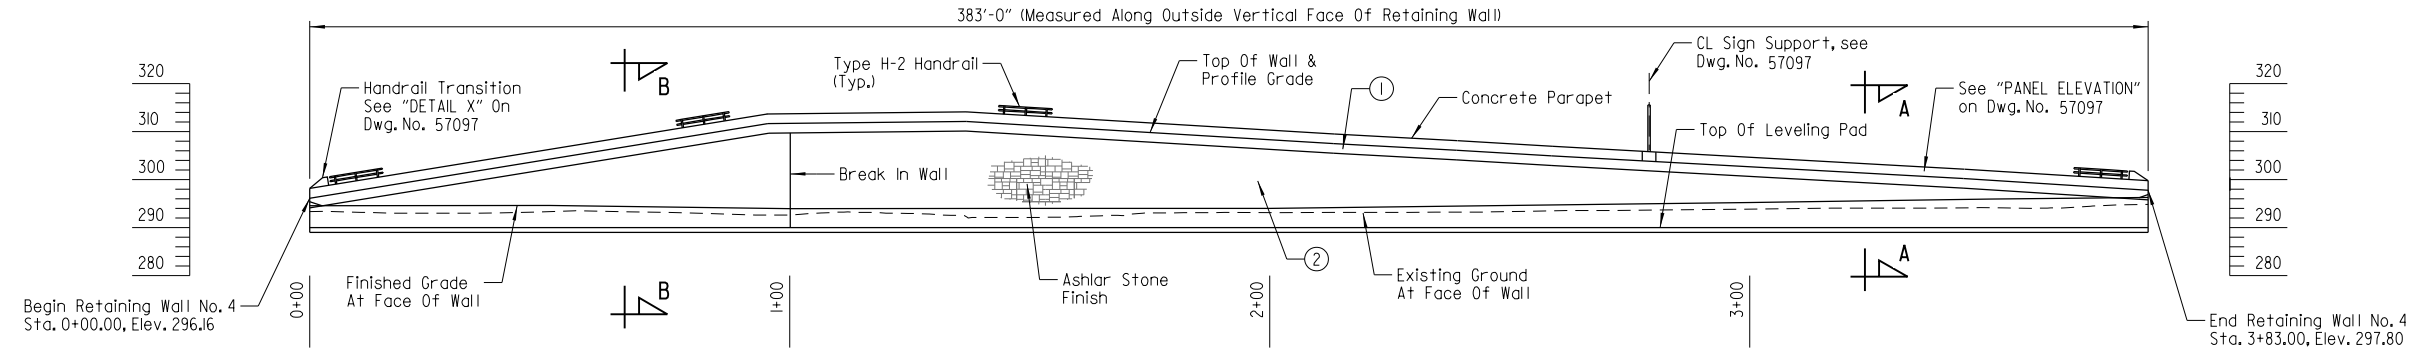

**ELEVATION - MSE RETAINING WALL NO. 4**  
 (Looking At Front Face Of Wall)  
 Scale: 1" = 20'-0"

- ① Class 3 Textured Coating Finish (Color = Brown, Color Chip No. 33522)
- ② Ashlar Stone Pattern & Class 3 Textured Coating Finish (Color = Brown, Color Chip No. 30219)

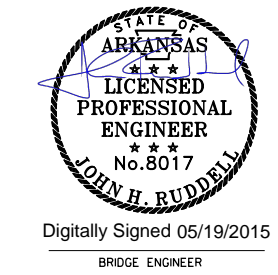


SHEET 2 OF 5  
 DETAILS OF RETAINING WALLS  
 ROUTE SEC.  
 ARKANSAS STATE HIGHWAY COMMISSION  
 LITTLE ROCK, ARK.

DRAWN BY: HEW DATE: NOV. 2014 FILENAME: B080517\_W2.dgn  
 CHECKED BY: DRG DATE: MAR. 2015 SCALE: As Shown  
 DESIGNED BY: SRY DATE: NOV. 2015  
 BRIDGE NO. 07345 DRAWING NO. 57095

DRG04D 5/19/2015 1:28:00 PM  
 WORKSPACE: AHTD Bridge  
 L:\2012\201590 - Centrefield Access\Drawings\6TH\_ST\B080517\_W2.dgn  
 REVISED DATE:



DATE REVISED	DATE FILMED	DATE REVISED	DATE FILMED	FED. ROAD DIST. NO.	STATE	FED. AID PROJ. NO.	SHEET NO.	TOTAL SHEETS
				6	ARK.			
				07345	RETAINING WALLS		97	182

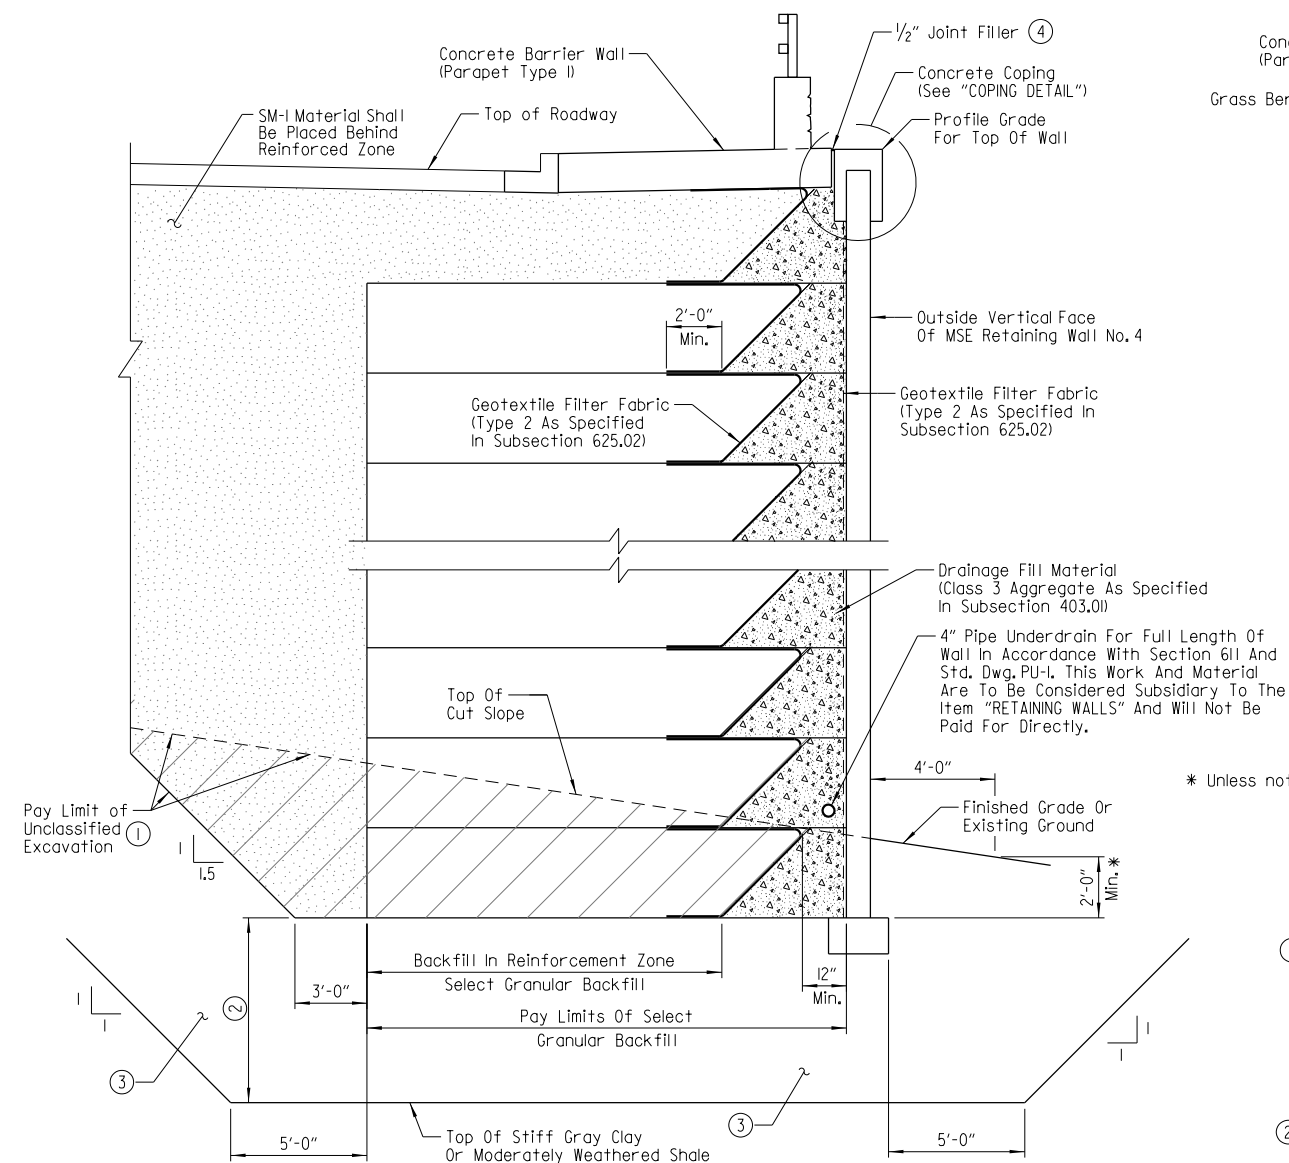


**SECTION A-A**  
(Backfill Method A)  
Scale: NTS

NOTE:  
For details of Backfill Method B,  
see "SECTION A-A" on Dwg. No. 57065

\* Unless noted otherwise on the MSE wall elevation view.

- ① Excavation required for reinforcing zone, leveling pad and placement of SM-I material will be paid for under the pay item "UNCLASSIFIED EXCAVATION". See SP "RETAINING WALLS".  
NOTE:  
All backfill and drainage fill material within the reinforcement zone shall be included in the price bid for "SELECT GRANULAR BACKFILL". Select material required behind reinforced zone shall be included in the price bid for "EMBANKMENT CONSTRUCTION". See SP "RETAINING WALLS".
- ② Depth of undercut varies from 0' to 3' as directed by the Engineer
- ③ For MSE Wall No. 4, SM-I material shall be placed as undercut backfill. Excavation and backfill material for the undercut area shall be paid for under the pay item "MSE WALL UNDERCUT AND BACKFILL". See SP "RETAINING WALLS" for details.
- ④ 1/2" Joint Filler (AASHTO M153, Type 1 Per Subsection 50L02(h)(1) With 1/2" x 1" Type 3 or 4 Joint Sealer Per Subsection 50L02(h)(2))

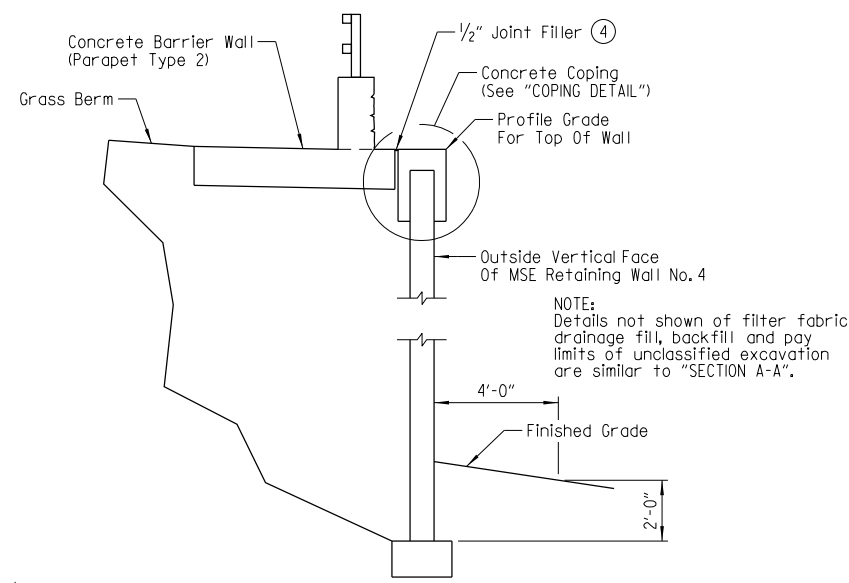

**SECTION B-B**  
Scale: NTS

NOTE:  
Details not shown of filter fabric,  
drainage fill, backfill and pay  
limits of unclassified excavation  
are similar to "SECTION A-A".

**TABLE OF MSE RETAINING WALL NO. 4 ELEVATIONS**

Station	Top Of Wall Elevation	Existing Ground Elevation
0+00.00	296.16	293.36
0+20.00	299.42	293.00
0+40.00	302.67	293.09
0+60.00	305.93	293.45
0+80.00	309.19	293.04
0+95.46	311.71	292.65
1+00.00	311.75	292.65
1+20.00	311.95	293.03
1+36.75	312.12	292.53
1+40.00	311.92	292.14
1+60.00	310.72	292.33
1+80.00	309.51	293.10
2+00.00	308.30	293.13
2+20.00	307.15	293.19
2+40.00	306.08	293.26
2+60.00	304.89	293.52
2+80.00	303.79	293.67
3+00.00	302.68	293.87
3+20.00	301.58	294.10
3+40.00	300.47	294.11
3+60.00	299.24	294.08
3+80.00	297.98	294.82
3+83.00	297.79	294.88

NOTE:  
Stations shown are along outside vertical face  
of MSE Wall.

**GENERAL NOTES:**

DESIGN SPECIFICATIONS: AASHTO LRFD Bridge Design Specifications 6th Edition (2012) with Current Interim Revisions

SEISMIC PERFORMANCE ZONE: I SDI = 0.093 SITE CLASS: B

4" pipe underdrain shall maintain a minimum slope of 1/8" per foot toward nearest outlet.


Elevations are approximate. Wall dimensions may vary depending on wall design selected.

See SP "RETAINING WALLS" for additional information.

Boring logs, including laboratory results, may be obtained from Programs and Contracts Division.

Joint filler, joint sealer, polystyrene foam board and rodent screen will not be paid for directly but will be considered subsidiary to SP "RETAINING WALLS".


A Class 3 Textured Coating Finish shall be applied to surfaces as specified in SP "TEXTURED COATING FINISH" and in accordance with Subsection 802.19.

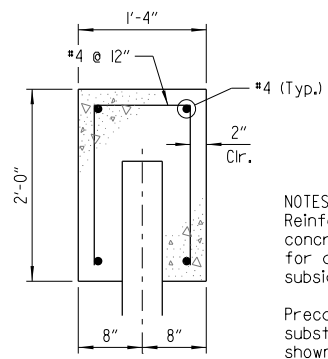

**COPING DETAIL**  
Scale: NTS

NOTES:  
Reinforcing steel and concrete for concrete coping shall not be paid for directly but will be considered subsidiary to the item "RETAINING WALLS".

Precast concrete coping may be substituted for cast-in-place coping shown.

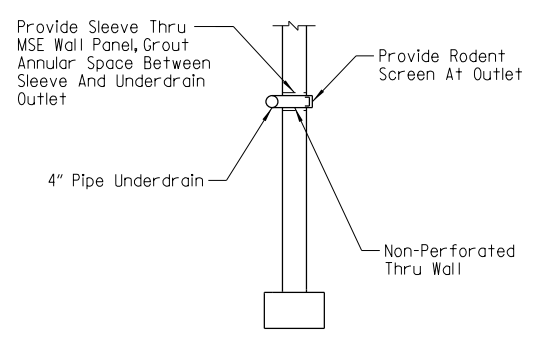

**OUTLET DETAIL**  
Scale: NTS




SHEET 3 OF 5  
DETAILS OF RETAINING WALLS  
ROUTE SEC.  
ARKANSAS STATE HIGHWAY COMMISSION  
LITTLE ROCK, ARK.

DRAWN BY: DRG DATE: MAR. 2015 FILENAME: B080517.W3.dgn  
CHECKED BY: SRY DATE: MAR. 2015 SCALE: As Shown  
DESIGNED BY: DRG DATE: MAR. 2015  
BRIDGE NO. 07345 DRAWING NO. 57096

Digitally Signed 05/19/2015  
BRIDGE ENGINEER


5/19/2015 7:28:00 PM  
 DRG004  
 WORKSPACE: AHTD Bridge  
 L:\2012\201590 - Centrefield Access\Drawings\6TH\_ST\B080517.W3.dgn  
 REVISED DATE:

DATE REVISED	DATE FILMED	DATE REVISED	DATE FILMED	FED. ROAD DIST. NO.	STATE	FED. AID PROJ. NO.	SHEET NO.	TOTAL SHEETS
				6	ARK.			
				JOB NO.		080517	98	182
				07345		RETAINING WALLS		57097

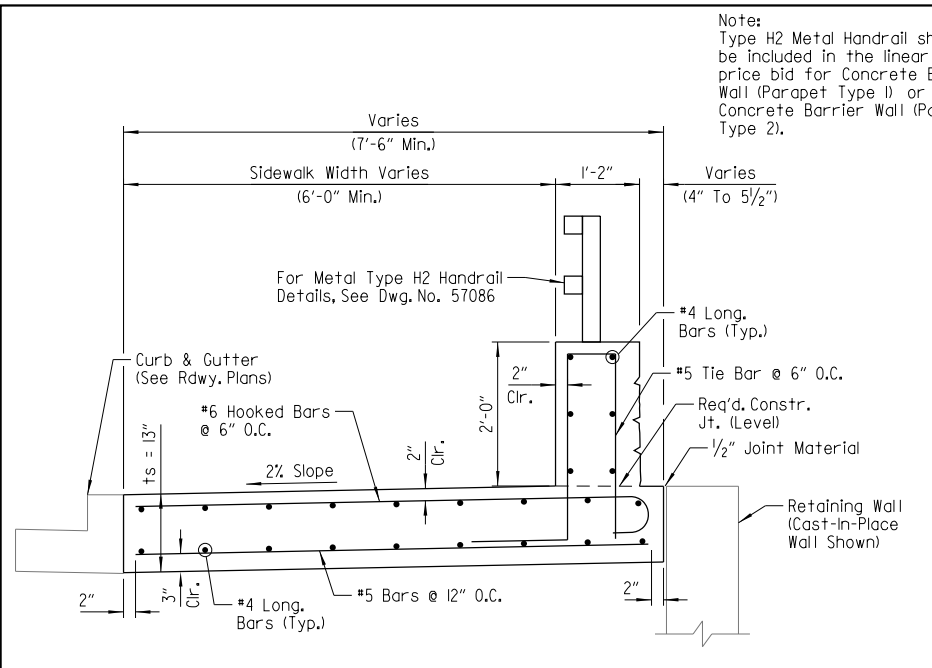


**CONCRETE BARRIER WALL (PARAPET TYPE 1)**

Scale: 3/4" = 1'-0"

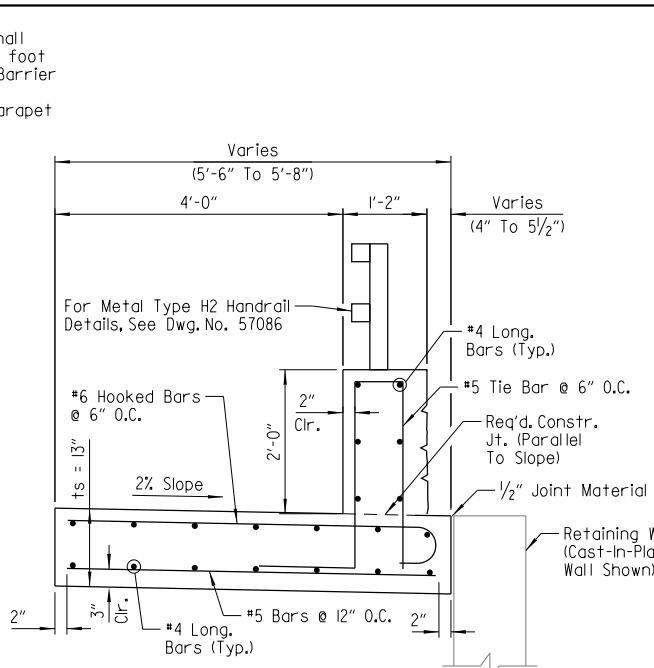


**CONCRETE BARRIER WALL (PARAPET TYPE 2)**

Scale: 3/4" = 1'-0"

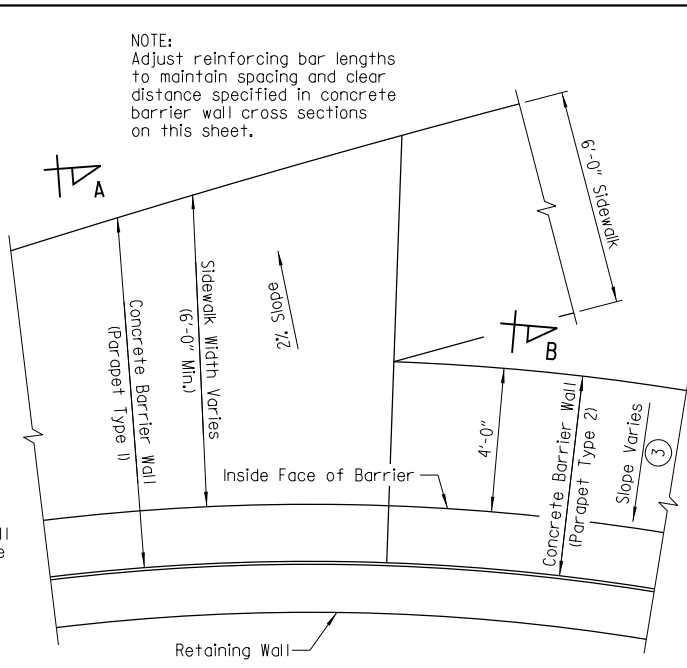


**MOMENT SLAB TRANSITION DETAIL**

Scale: NTS

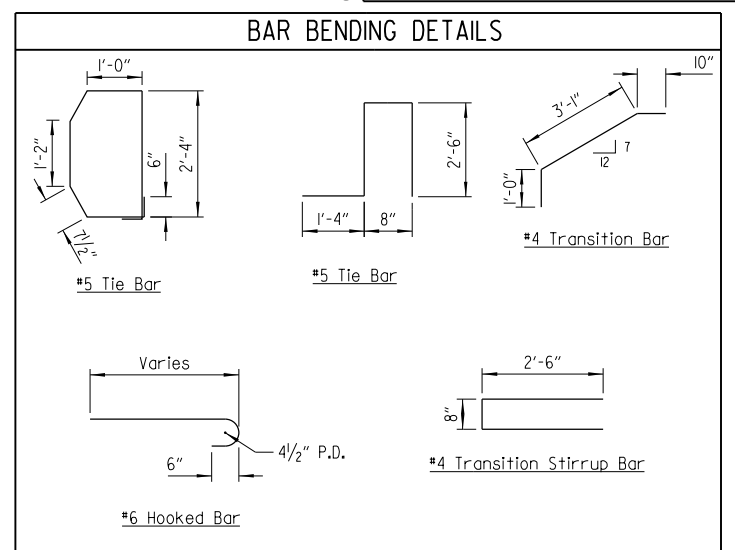


Note: Dimensions of bars are out-to-out.

③ Transition cross slope of Concrete Barrier Wall (Parapet Type 2) footing to match slope of adjacent Concrete Barrier Wall (Parapet Type 1).

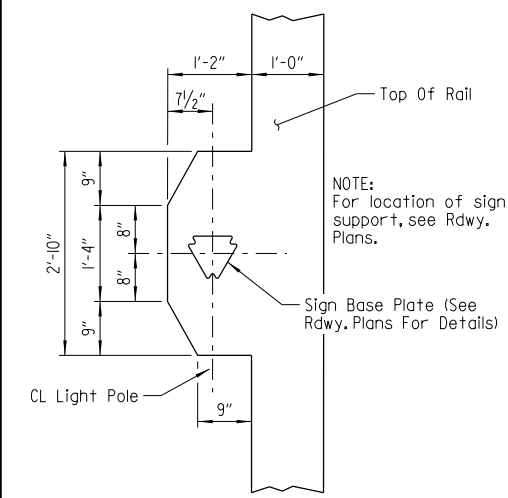


**PLAN - CONCRETE SIGN SUPPORT**

Scale: 3/4" = 1'-0"

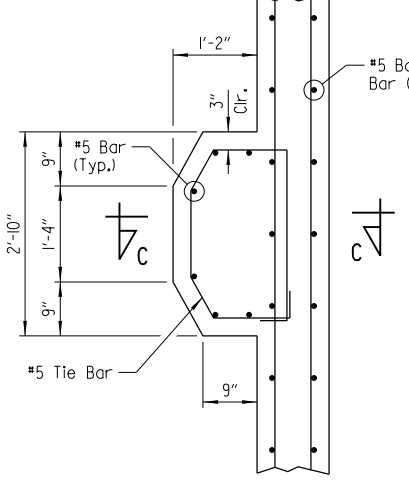


**PLAN - CONCRETE SIGN SUPPORT (Reinforcing Details)**

Scale: 3/4" = 1'-0"

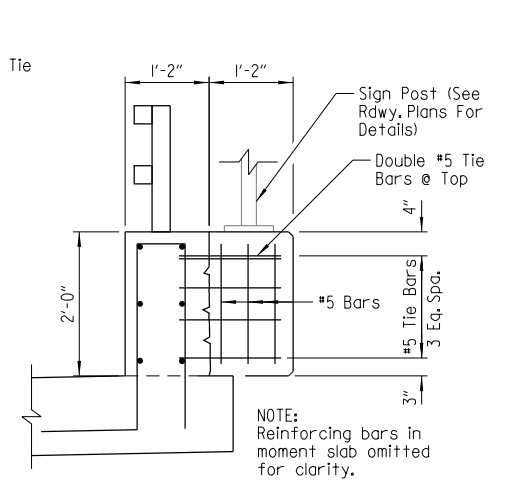

**SECTION C-C**

Scale: 3/4" = 1'-0"

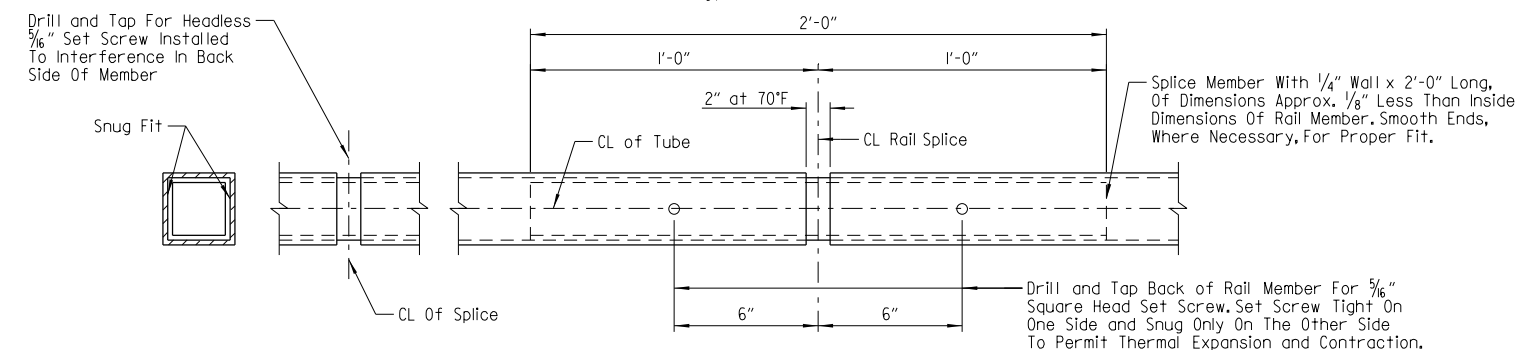


**ALTERNATE INSTALLATION**

**SPLICE DETAIL**


Scale: 3" = 1'-0"

Note: For additional structural and material details of Type H2 Metal Handrail, see Dwg. No. 57086.

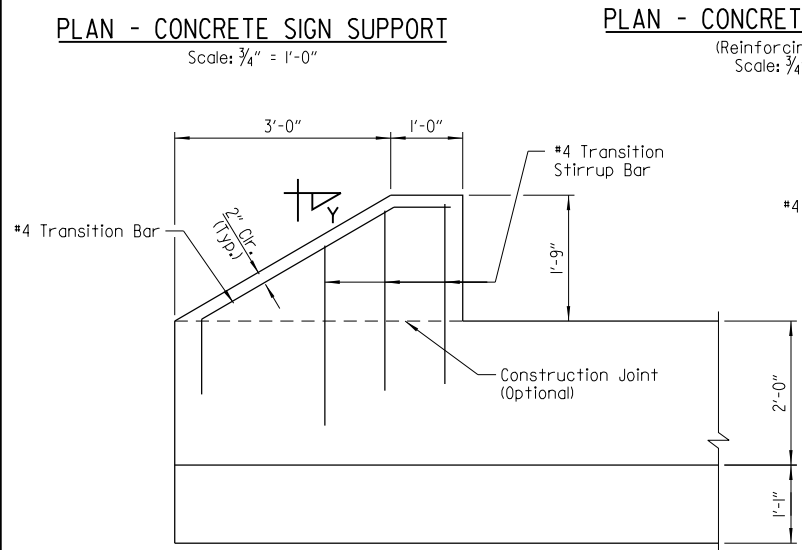


**DETAIL X**

Scale: 3/4" = 1'-0"

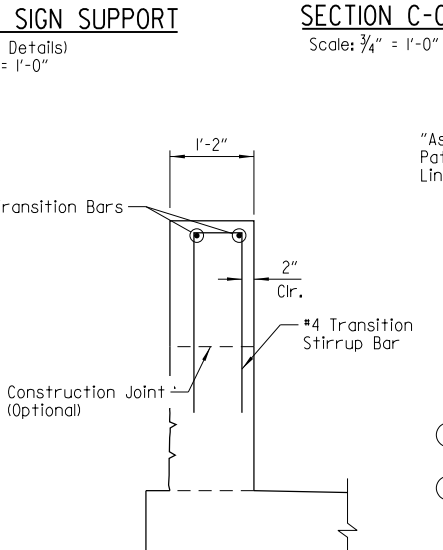


**SECTION Y-Y**

Scale: 3/4" = 1'-0"

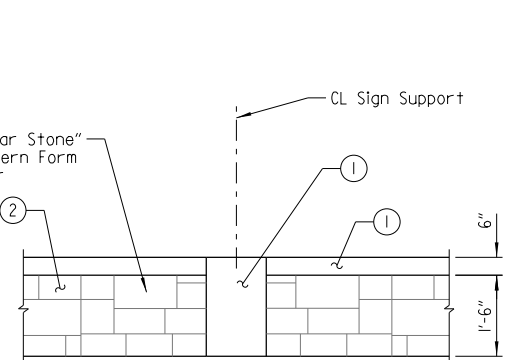

**PANEL ELEVATION**

(Showing Outside Face Of Barrier) Scale: NTS

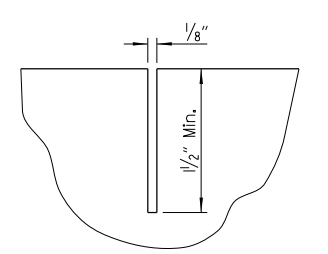

**CONTRACTION JOINT DETAIL**


Scale: NTS

- Notes for barrier & moment slab.
- All exposed edges shall have 3/4" chamfers.
  - Contraction joints shall be constructed at 15'-0" max. spacing in top and sides and shall be formed in fresh concrete.
  - All reinforcing steel Grade 60
  - All concrete Class S(AE)

- Class 3 Textured Coating Finish (Color = Brown, Color Chip No. 33522)
- Ashlar Stone Pattern & Class 3 Textured Coating Finish (Color = Brown, Color Chip No. 30219)



Digitally Signed 05/19/2015  
BRIDGE ENGINEER

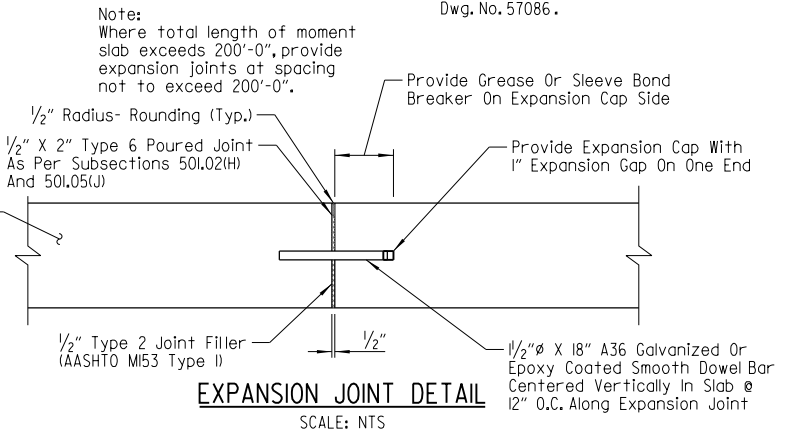

**EXPANSION JOINT DETAIL**


SCALE: NTS

SHEET 4 OF 5  
DETAILS OF RETAINING WALLS  
ROUTE SEC.  
ARKANSAS STATE HIGHWAY COMMISSION  
LITTLE ROCK, ARK.


DRAWN BY: DRG DATE: MAR. 2015 FILENAME: B080517\_W4.dgn  
CHECKED BY: SRY DATE: MAR. 2015 SCALE: As Shown  
DESIGNED BY: DRG DATE: MAR. 2015  
BRIDGE NO. 07345 DRAWING NO. 57097

DRGNO: 5/19/2015 1:28:01PM  
 WORKSPACE: AHTD Bridge  
 L:\2012\201590 - Centrell\Field Access\Drawings\6TH\_ST\B080517\_W4.dgn  
 REVISED DATE:


DATE REVISED	DATE FILMED	DATE REVISED	DATE FILMED	FED. ROAD DIST. NO.	STATE	FED. AID PROJ. NO.	SHEET NO.	TOTAL SHEETS
				6	ARK.			
				JOB NO.		080517	99	182
				07345		RETAINING WALLS		57098

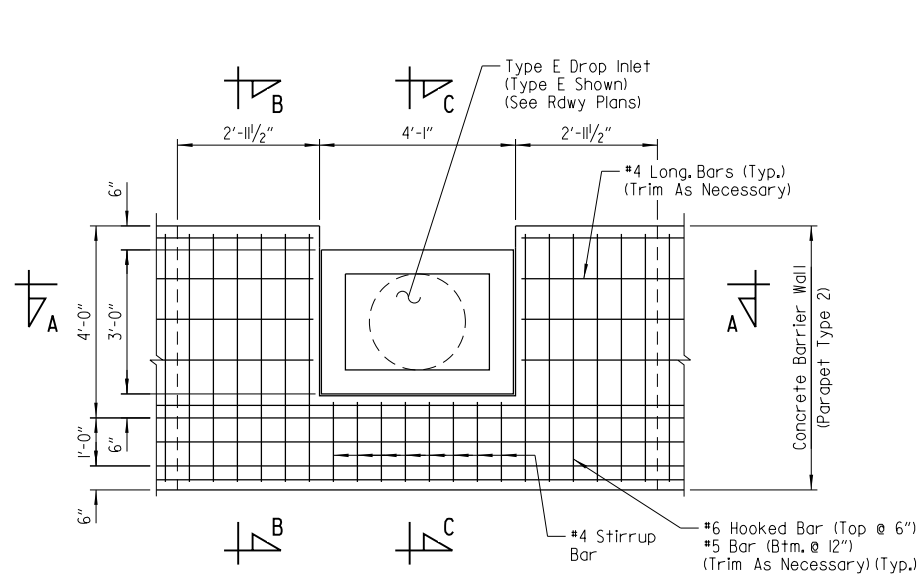

**PLAN - MOMENT SLAB AT TYPE E DROP INLET**  
Scale: 1/2" = 1'-0"

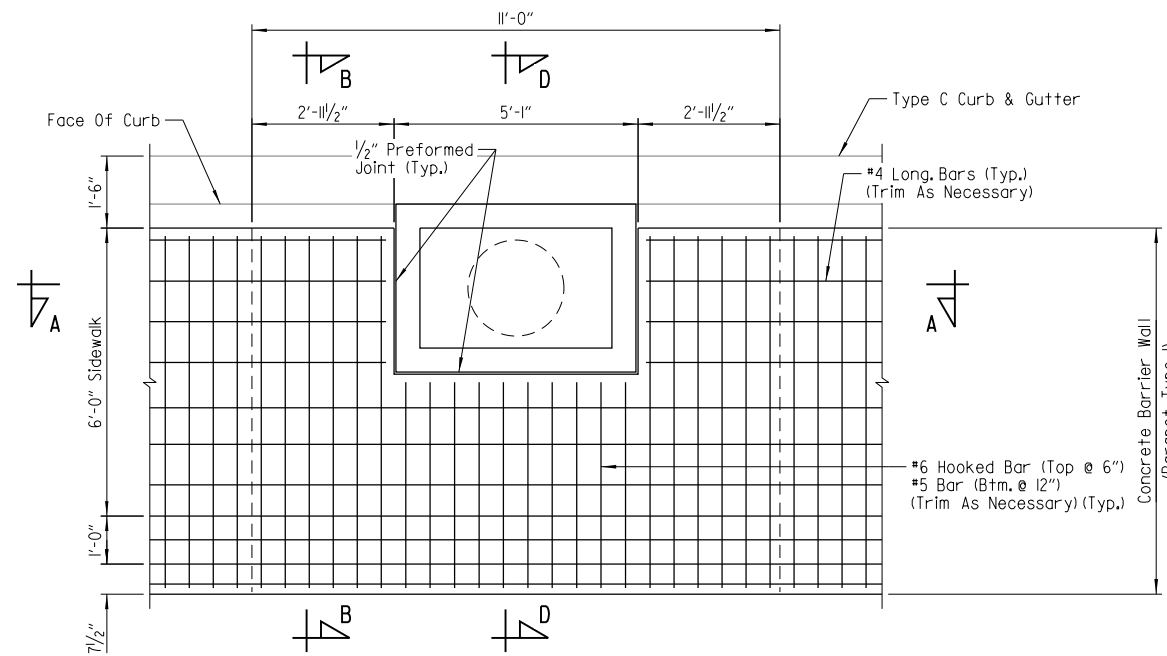


**PLAN - MOMENT SLAB AT TYPE C DROP INLET**  
Scale: 1/2" = 1'-0"

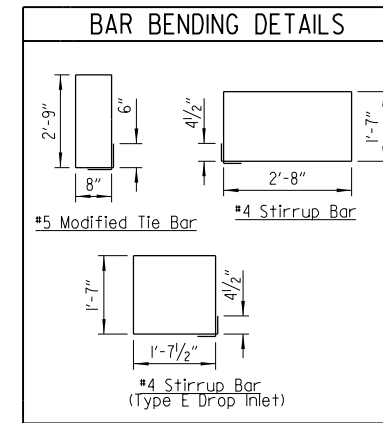


NOTE:  
Dimensions of bars are out-to-out.


- ① Class 3 Textured Coating Finish (Color = Brown, Color Chip No. 33522)
- ② Ashlar Stone Pattern & Class 3 Textured Coating Finish (Color = Brown, Color Chip No. 30219)
- ③ 1'-0" as shown in Std. Dwg. SI-2 plus 2" for architectural finish

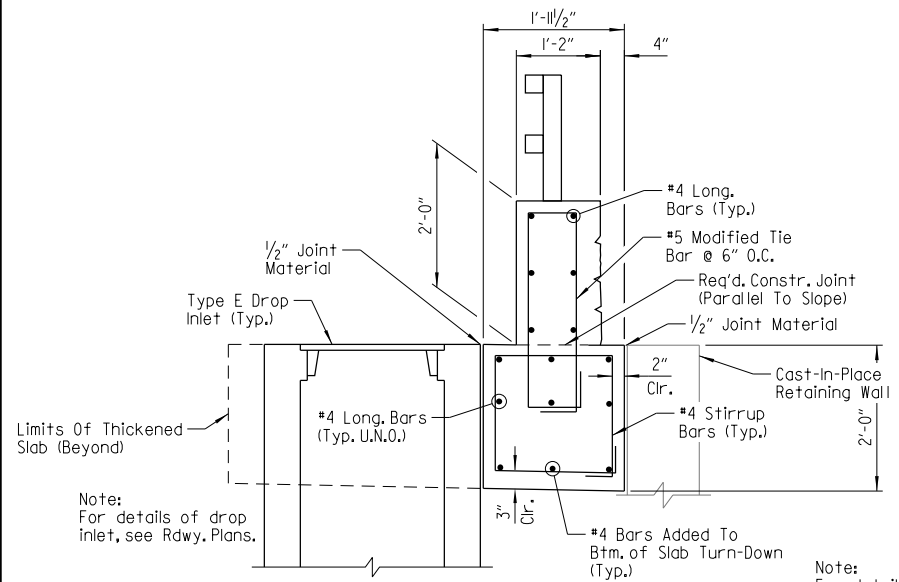


**SECTION C-C**  
Scale: NTS

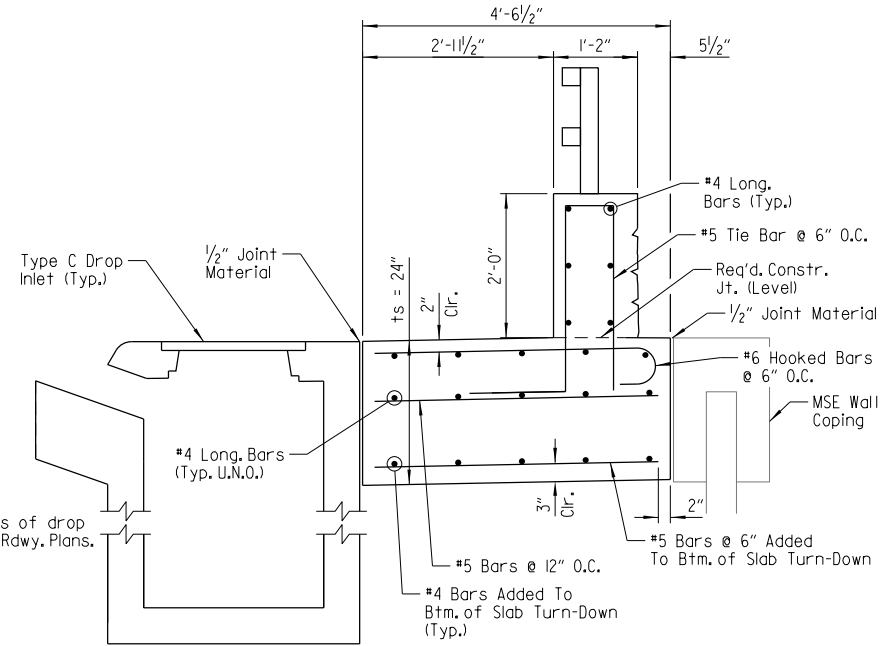


**SECTION D-D**  
Scale: NTS

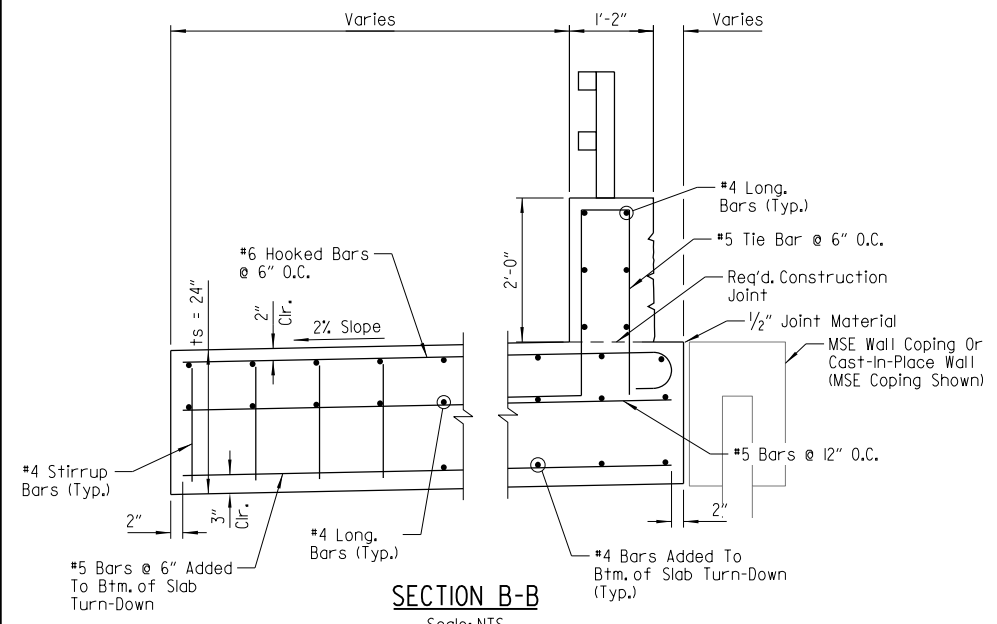

**SECTION B-B**  
Scale: NTS

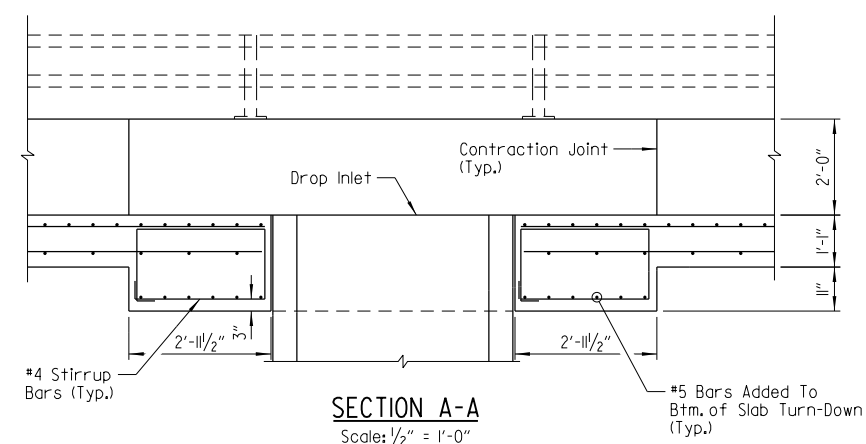

**SECTION A-A**  
Scale: 1/2" = 1'-0"

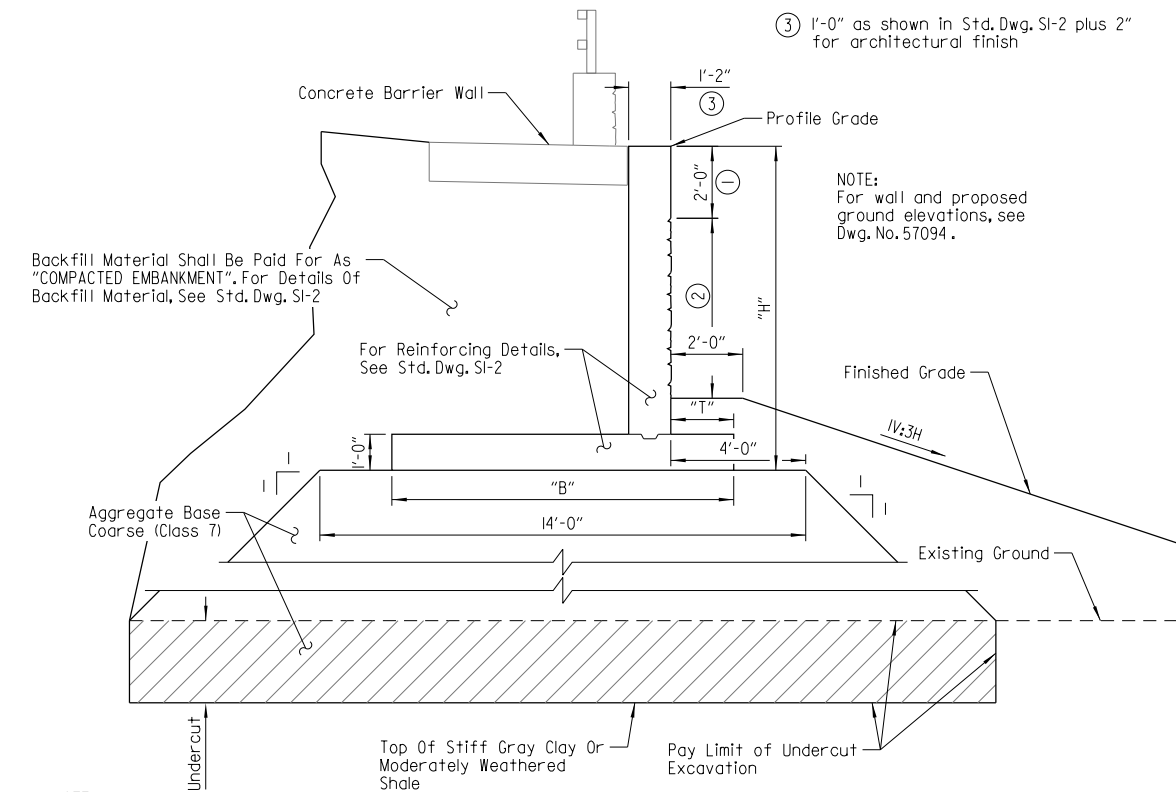

**SECTION X-X**  
Scale: NTS






SHEET 5 OF 5  
DETAILS OF RETAINING WALLS  
ROUTE SEC.  
ARKANSAS STATE HIGHWAY COMMISSION  
LITTLE ROCK, ARK.

DRAWN BY: DRG DATE: MAR. 2015 FILENAME: B080517\_W5.dgn  
CHECKED BY: SRY DATE: MAR. 2015 SCALE: As Shown  
DESIGNED BY: DRG DATE: MAR. 2015  
BRIDGE NO. 07345 DRAWING NO. 57098


DRG04D 5/19/2015 1:28:02 PM  
 WORKSPACE: AHTD Bridge  
 L:\2012\1201590 - Centrefield Access\Drawings\6TH\_ST\B080517\_W5.dgn  
 REVISED DATE:

Digitally Signed 05/19/2015  
BRIDGE ENGINEER

DATE REVISED	DATE FILMED	DATE REVISED	DATE FILMED	FED. ROAD DIST. NO.	STATE	FED. AID PROJ. NO.	SHEET NO.	TOTAL SHEETS
				6	ARK.			
				JOB NO.		080517	100	182
				07345		BORING LOGS		57099

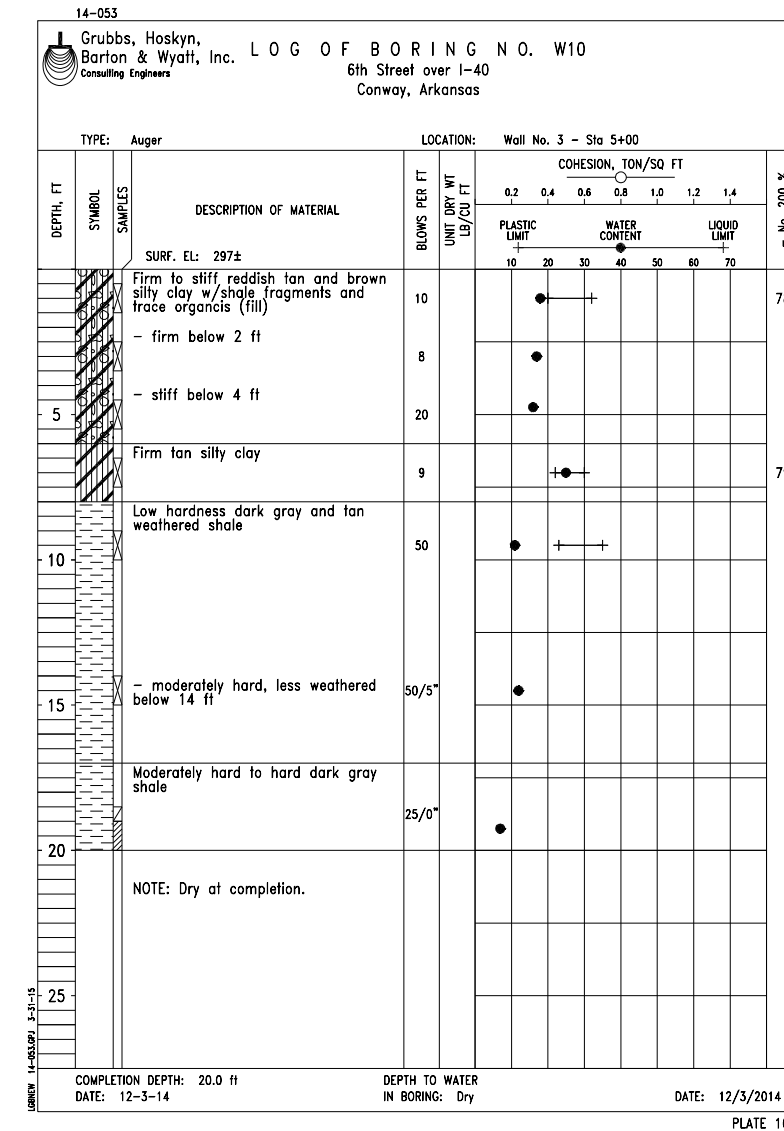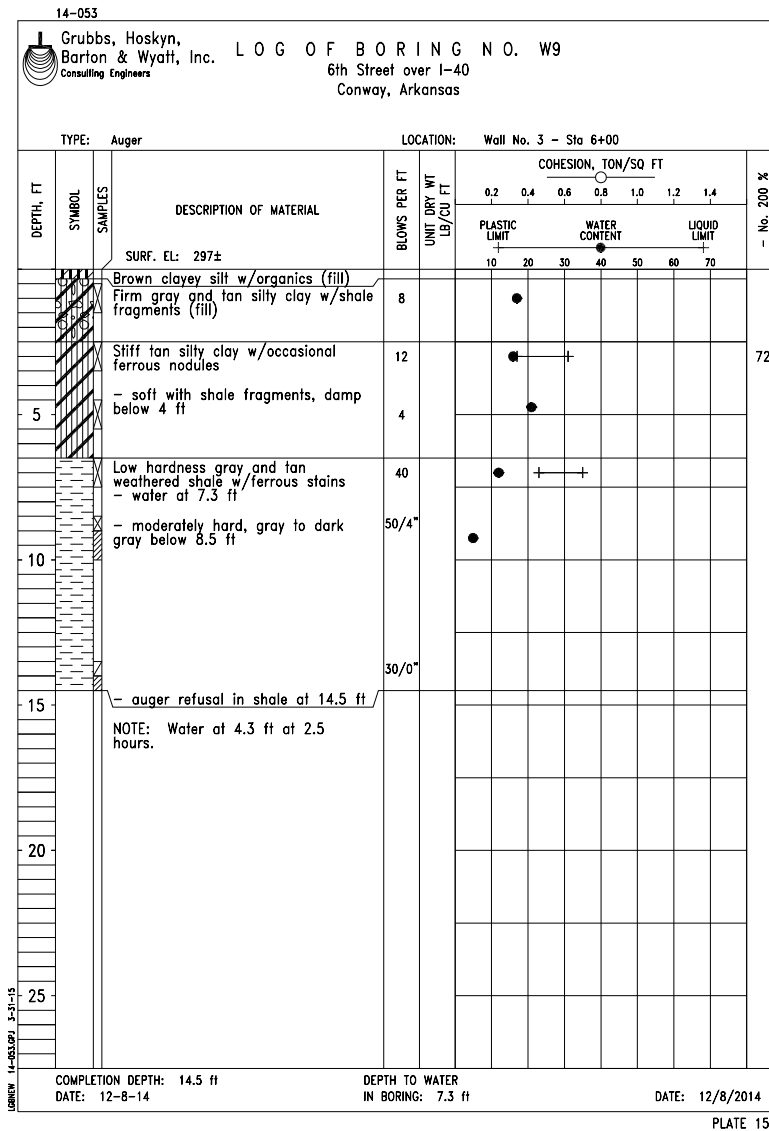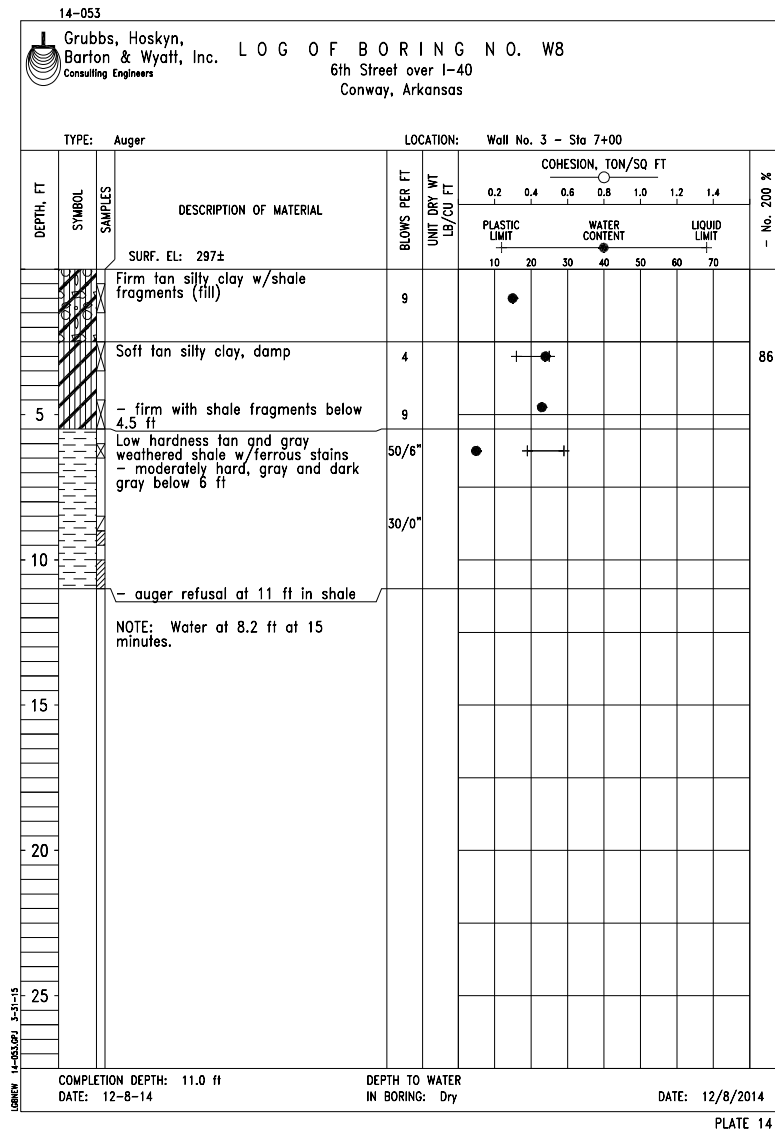

DRGNO: 14-053-01  
 5/19/2015 7:50:58 PM  
 WORKSPACE: AHTD Bridge  
 L:\2012\201590 - Centrefield Access\Drawings\6TH\_ST\B080517\_BL4.dgn  
 REVISED DATE:

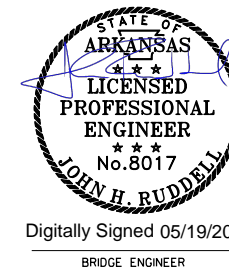




SHEET 1 OF 4  
 BORING LOG DETAILS  
 RETAINING WALL NOS. 3 & 4  
 ROUTE SEC.  
 ARKANSAS STATE HIGHWAY COMMISSION  
 LITTLE ROCK, ARK.

DRAWN BY: HEW DATE: MAR. 2015 FILENAME: B080517\_BL4.dgn  
 CHECKED BY: DRG DATE: MAR. 2015 SCALE: As Shown  
 DESIGNED BY: DATE:


BRIDGE NO. 07345 DRAWING NO. 57099

Digitally Signed 05/19/2015  
BRIDGE ENGINEER

DATE REVISED	DATE FILMED	DATE REVISED	DATE FILMED	FED. ROAD DIST. NO.	STATE	FED. AID PROJ. NO.	SHEET NO.	TOTAL SHEETS
				6	ARK.			
				JOB NO.		080517	101	182
				07345		BORING LOGS		57100

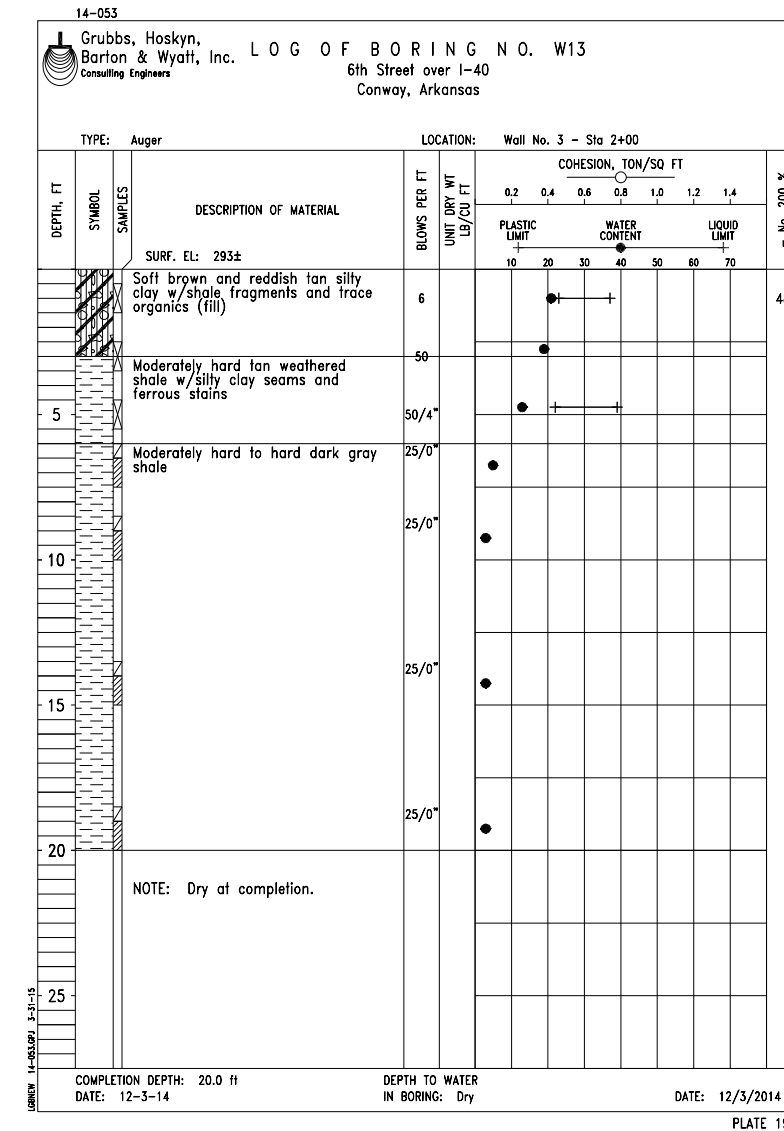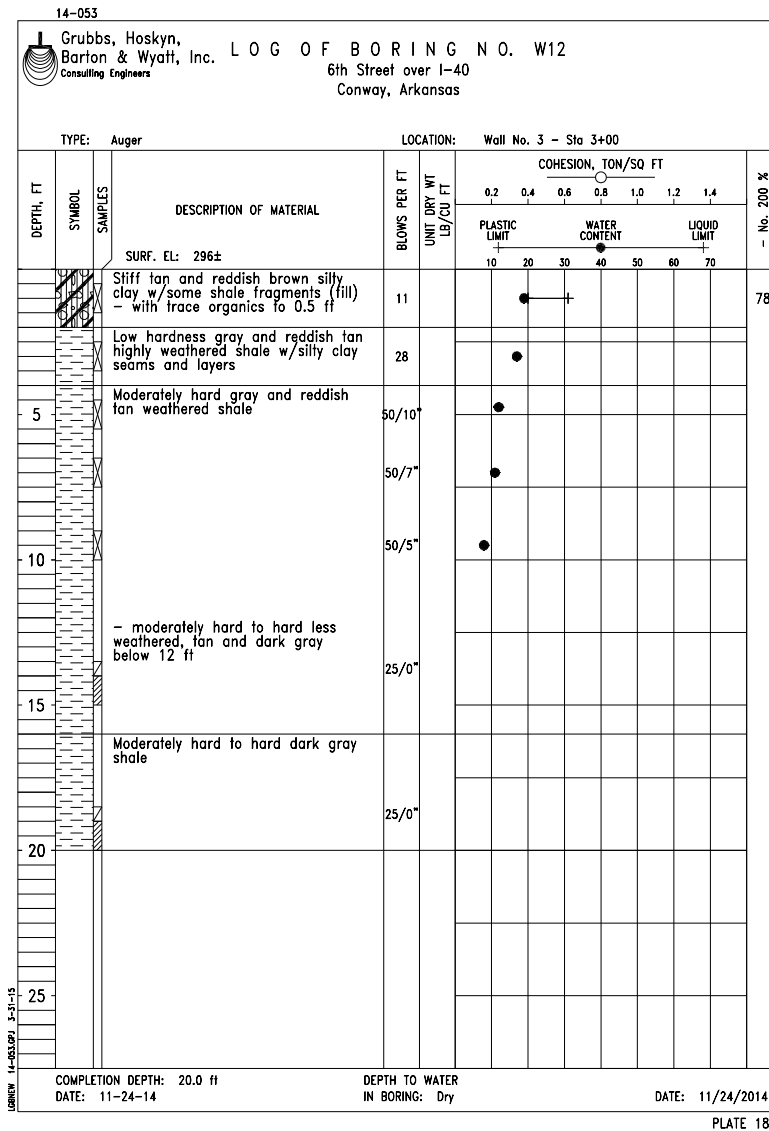
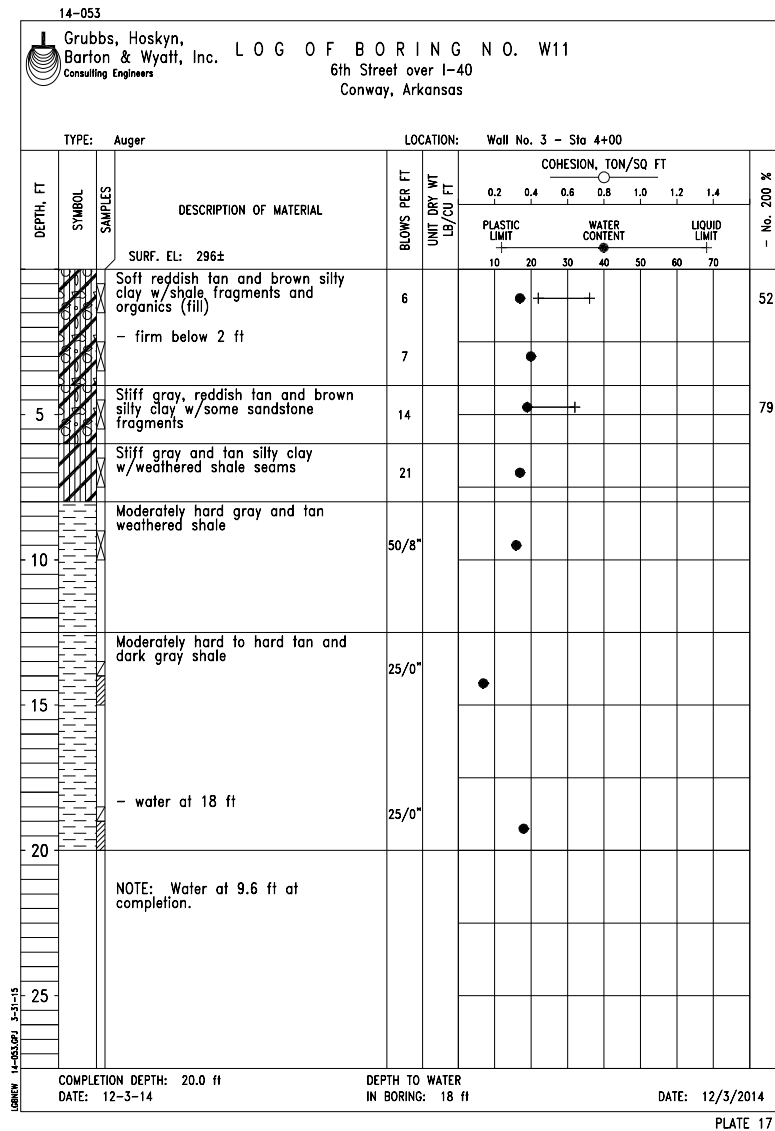


DRGNO: 14-053L01 5-31-15  
 5/19/2015 7:50:59 PM  
 WORKSPACE: AHTD Bridge  
 L:\2012\201590 - Centrefield Access\Drawings\6TH\_ST\B080517\_BL5.dgn  
 REVISED DATE:

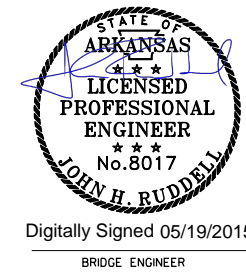


SHEET 2 OF 4  
 BORING LOG DETAILS  
 RETAINING WALL NOS. 3 & 4  
 ROUTE SEC.  
 ARKANSAS STATE HIGHWAY COMMISSION  
 LITTLE ROCK, ARK.  
 DRAWN BY: HEW DATE: MAR. 2015 FILENAME: B080517\_BL5.dgn  
 CHECKED BY: DRG DATE: MAR. 2015 SCALE: As Shown  
 DESIGNED BY: DATE: -  
 BRIDGE NO. 07345 DRAWING NO. 57100

DATE REVISED	DATE FILMED	DATE REVISED	DATE FILMED	FED. ROAD DIST. NO.	STATE	FED. AID PROJ. NO.	SHEET NO.	TOTAL SHEETS
				6	ARK.			
				JOB NO.		080517	102	182
				07345		BORING LOGS		57101

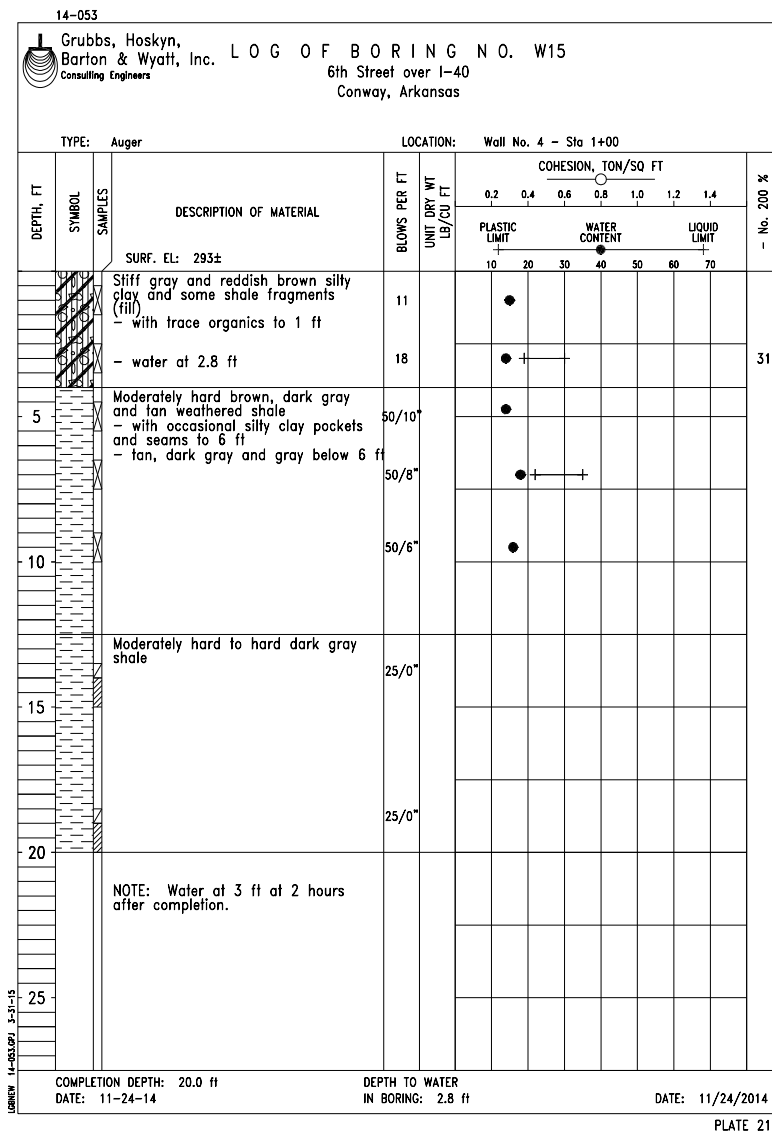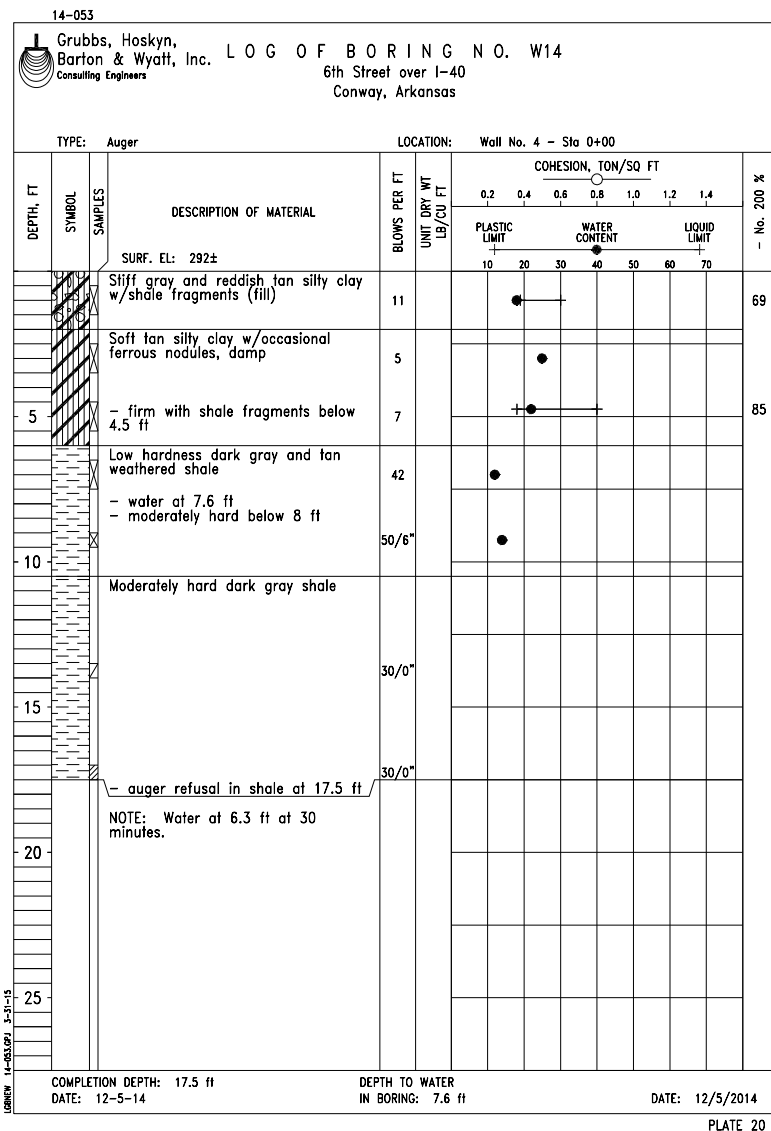

DRG04D 5/19/2015 7:54:04 PM  
 WORKSPACE: AHTD Bridge  
 L:\2012\201590 - CentrellField Access\Drawings\6TH\_ST\B080517\_BL6.dgn  
 REVISED DATE:

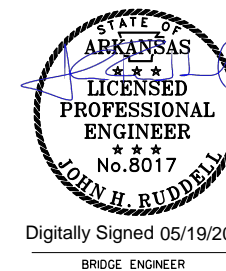



Digitally Signed 05/19/2015  
BRIDGE ENGINEER

SHEET 3 OF 4  
 BORING LOG DETAILS  
 RETAINING WALL NOS. 3 & 4  
 ROUTE SEC.  
 ARKANSAS STATE HIGHWAY COMMISSION  
 LITTLE ROCK, ARK.


DRAWN BY: HEW DATE: MAR. 2015 FILENAME: B080517\_BL6.dgn  
 CHECKED BY: DRG DATE: MAR. 2015 SCALE: As Shown  
 DESIGNED BY: DATE:

BRIDGE NO. 07345 DRAWING NO. 57101

DATE REVISED	DATE FILMED	DATE REVISED	DATE FILMED	FED. ROAD DIST. NO.	STATE	FED. AID PROJ. NO.	SHEET NO.	TOTAL SHEETS
				6	ARK.			
				JOB NO.		080517	103	182
				07345		BORING LOGS		57102

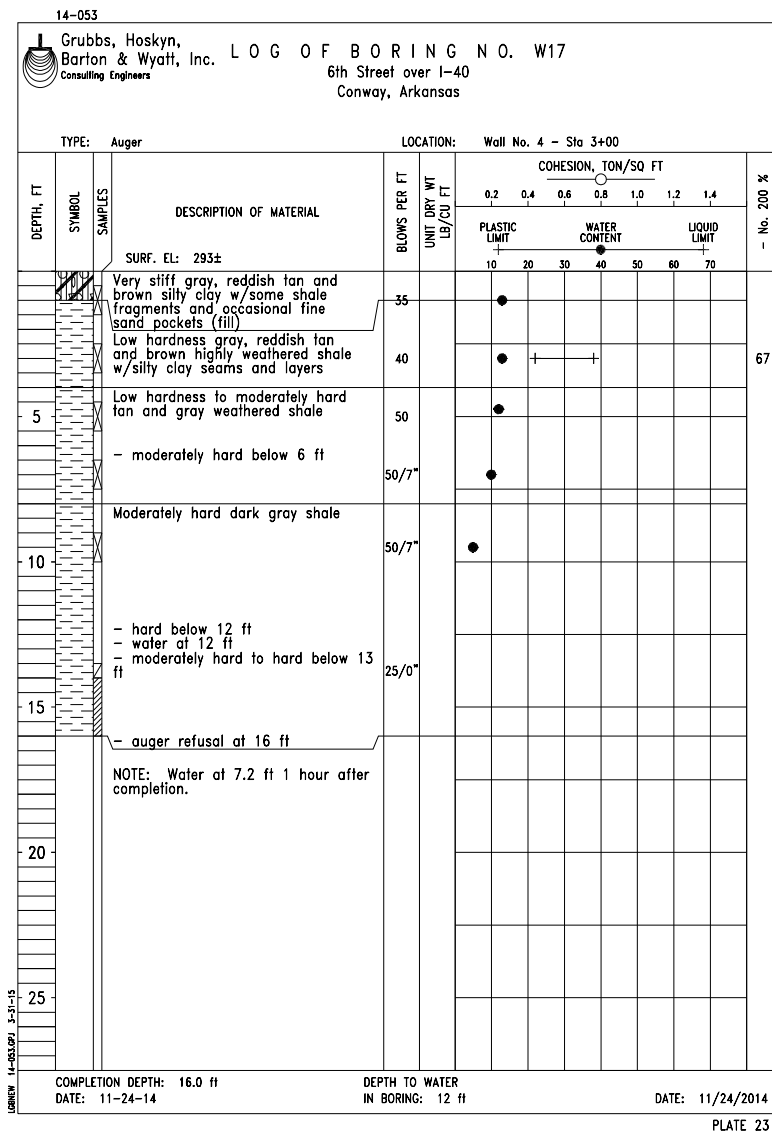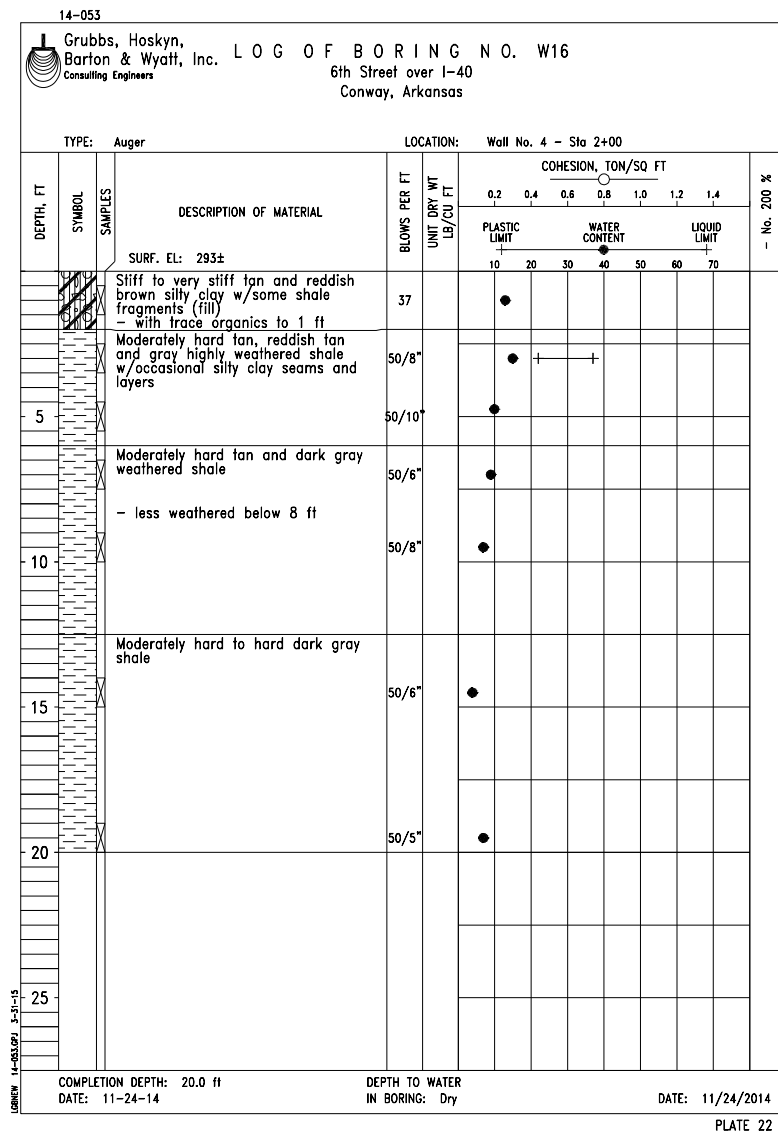

DRGNO: 14-053-01  
 5/19/2015 7:54:04 PM  
 WORKSPACE: AHTD Bridge  
 L:\2012\201590 - Centrefield Access\Drawings\6TH\_ST\B080517\_BLT.dgn  
 REVISED DATE:

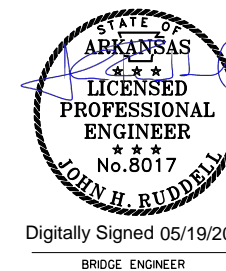


Digitally Signed 05/19/2015  
BRIDGE ENGINEER


SHEET 4 OF 4  
BORING LOG DETAILS  
RETAINING WALL NOS. 3 & 4  
ROUTE SEC.  
ARKANSAS STATE HIGHWAY COMMISSION  
LITTLE ROCK, ARK.

DRAWN BY: HEW DATE: MAR. 2015 FILENAME: B080517\_BLT.dgn  
 CHECKED BY: DRG DATE: MAR. 2015 SCALE: As Shown  
 DESIGNED BY: DATE: -  
 BRIDGE NO. 07345 DRAWING NO. 57102


DATE REVISED	DATE FILMED	DATE REVISED	DATE FILMED	FED. ROAD DIST. NO.	STATE	FED. AID PROJ. NO.	SHEET NO.	TOTAL SHEETS
				6	ARK.			
							JOB NO.	104
							① EMBANKMENT & BACKFILL	55000

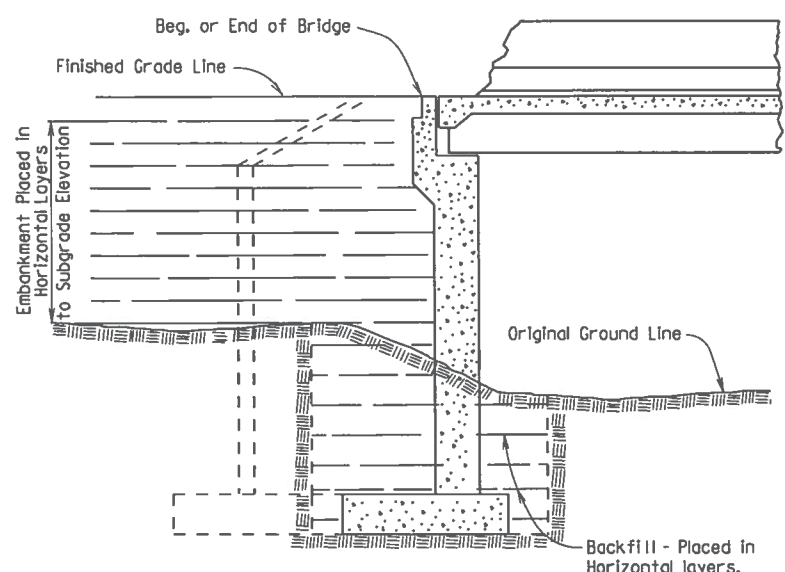


**EMBANKMENT CONSTRUCTION AND FOOTING BACKFILL AT VERTICAL WALL ABUTMENTS**

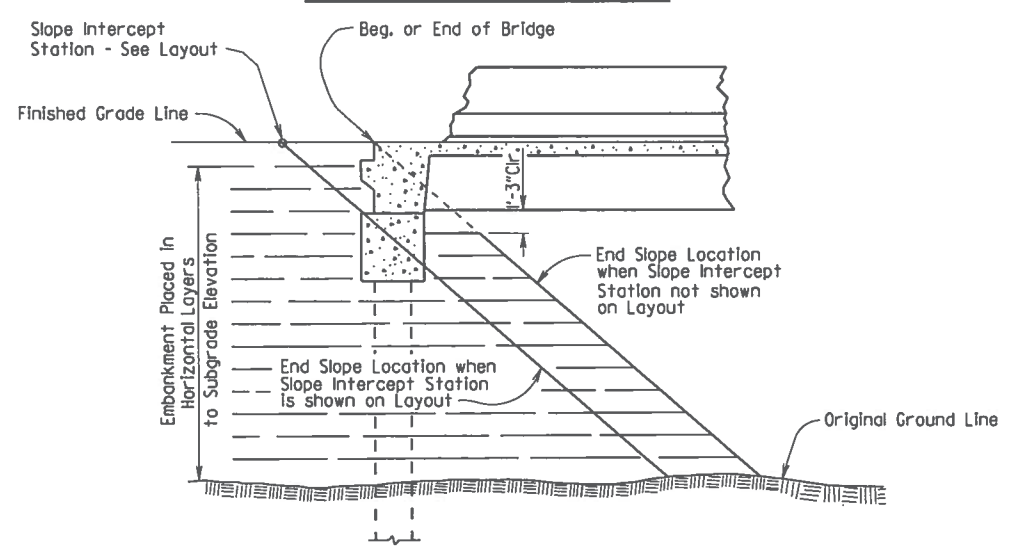


**EMBANKMENT CONSTRUCTION AT SPILL-THROUGH PILE END BENTS**

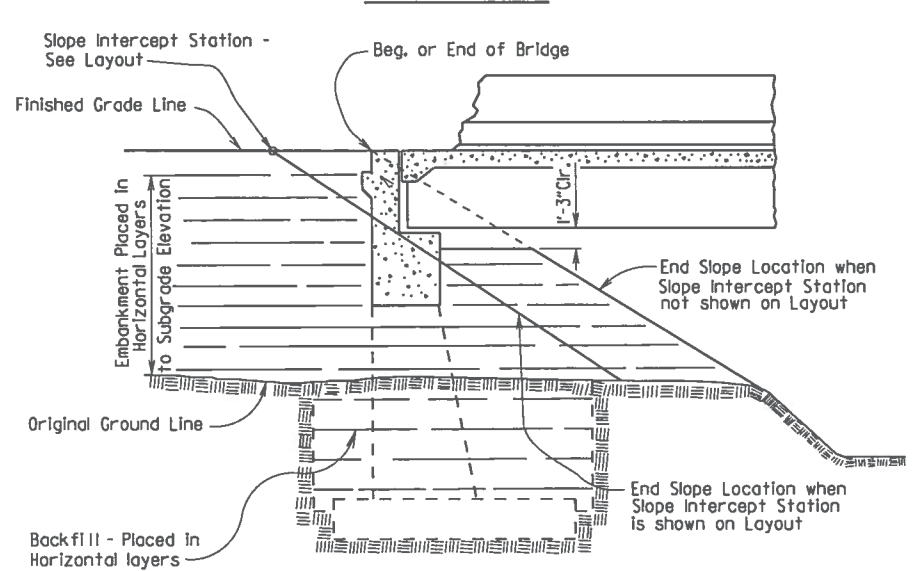


**EMBANKMENT CONSTRUCTION AND FOOTING BACKFILL AT SPILL-THROUGH END BENTS**

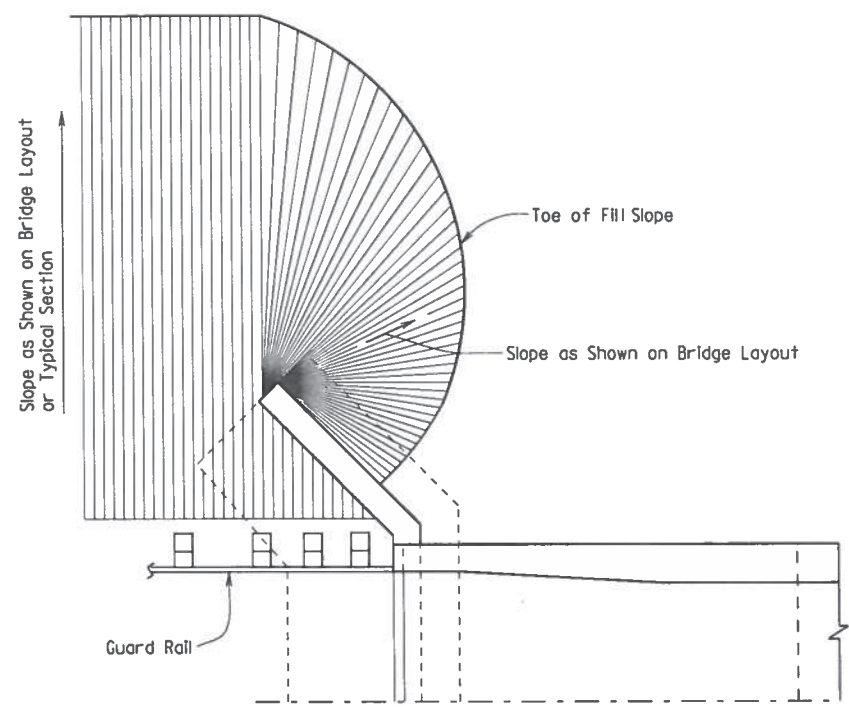


**VERTICAL WALL ABUTMENTS**

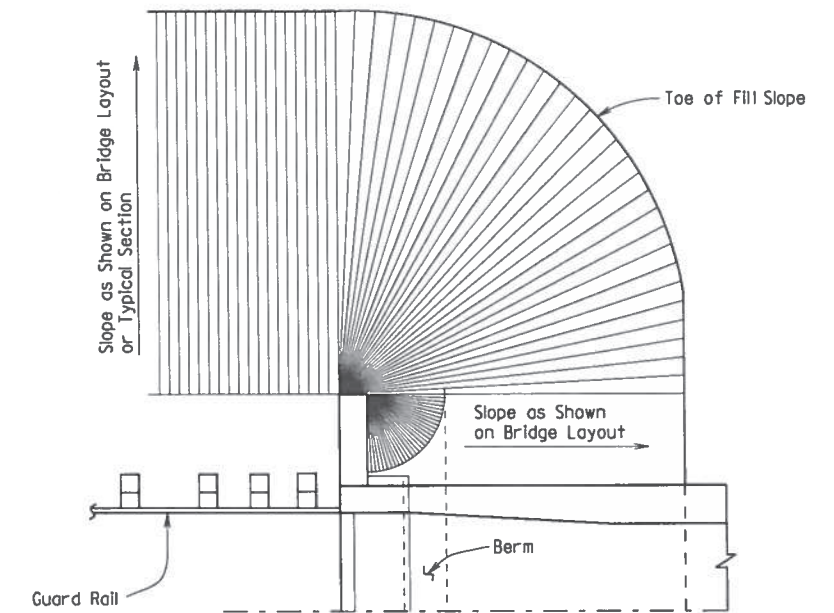

**SPILL-THROUGH END BENTS WITH STUB WING**

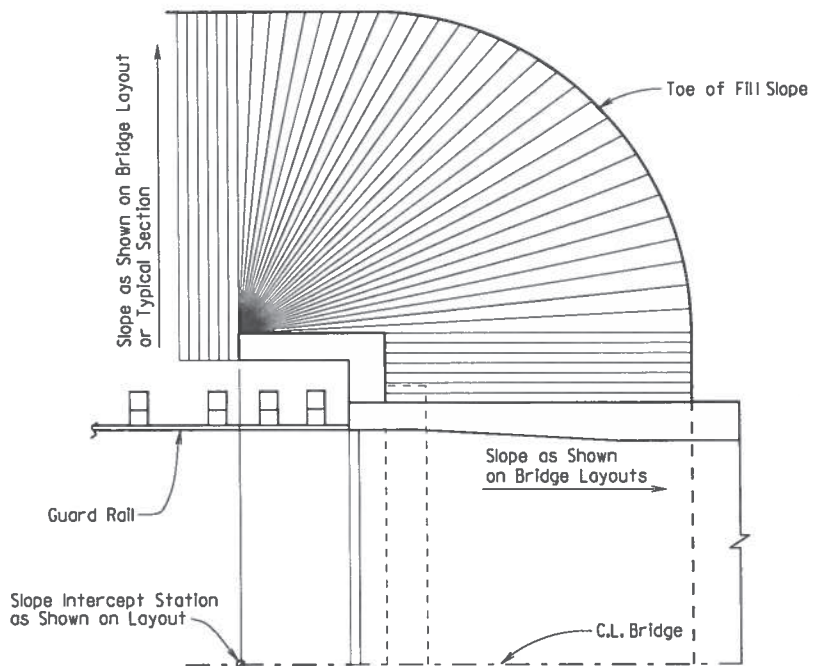

**SPILL-THROUGH END BENTS WITH TURNBACK WING**

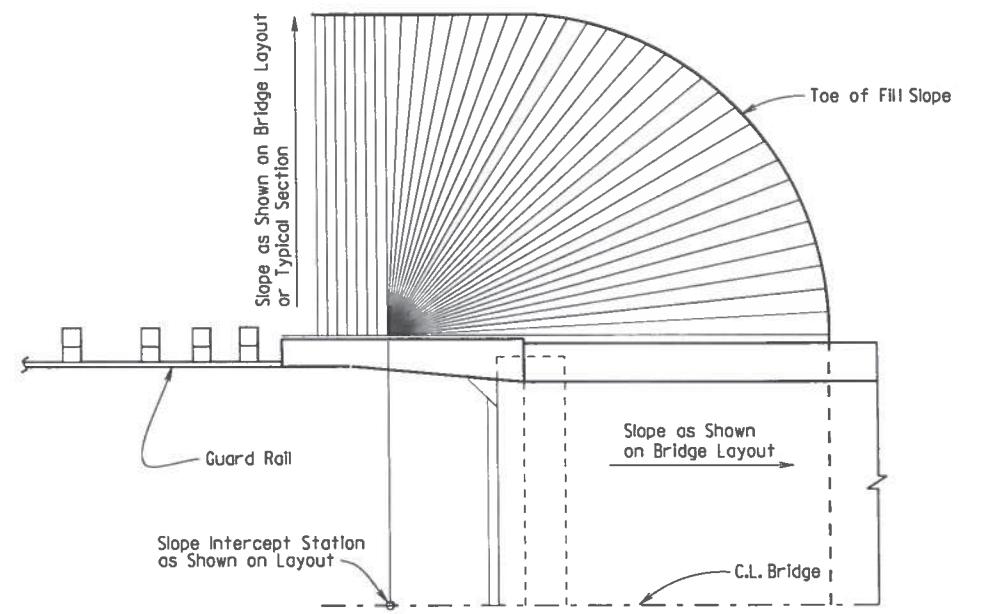

**SPILL-THROUGH END BENTS WITH TRANSITION WING**

**METHOD OF DETERMINING FILL SLOPE LOCATION AT BRIDGE ENDS**

**GENERAL NOTES**

The Bridge End Embankment shall be defined as a section of embankment, not less than 20 feet long adjacent to the bridge end, together with the side slopes and slopes under the bridge end including around the end of wingwalls. Embankment adjacent to structures shall be constructed in 6 inch horizontal layers (loose measure) and compacted by the use of mechanical equipment to the satisfaction of the Engineer. Refer to Subsections 210.09, 210.10 and 801.08 for construction requirements.

**STANDARD DETAILS FOR EMBANKMENT CONSTRUCTION AND BACKFILL AT BRIDGE ENDS**

**ARKANSAS STATE HIGHWAY COMMISSION**


LITTLE ROCK, ARK.

DRAWN BY: KDH DATE: 2-27-2014 FILENAME: b55000.dgn  
 CHECKED BY: BEF DATE: 2-27-2014 SCALE: NO SCALE  
 DESIGNED BY: STD. DATE: -


DRAWING NO. 55000



Note:  
Sloped surfaces of concrete riprap to be marked off into blocks (construction joints optional) with an approved grooving tool, spacing the grooved lines about 5' apart.

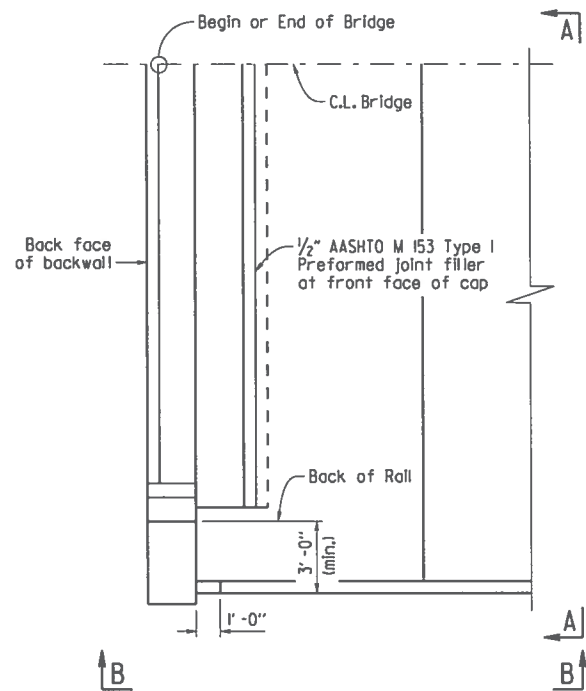


**PLAN OF CONCRETE RIPRAP PERPENDICULAR TO WING**  
1/4" = 1'-0"

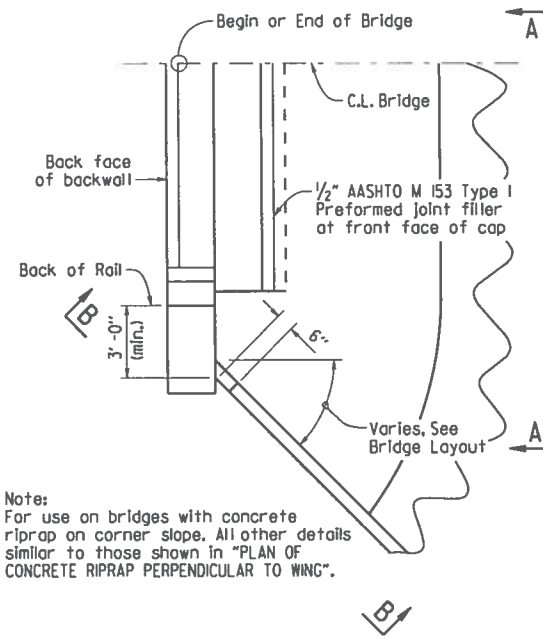


Note:  
For use on bridges with concrete riprap on corner slope. All other details similar to those shown in "PLAN OF CONCRETE RIPRAP PERPENDICULAR TO WING".

**PLAN OF CONCRETE RIPRAP AT ANGLE TO WING**  
1/4" = 1'-0"

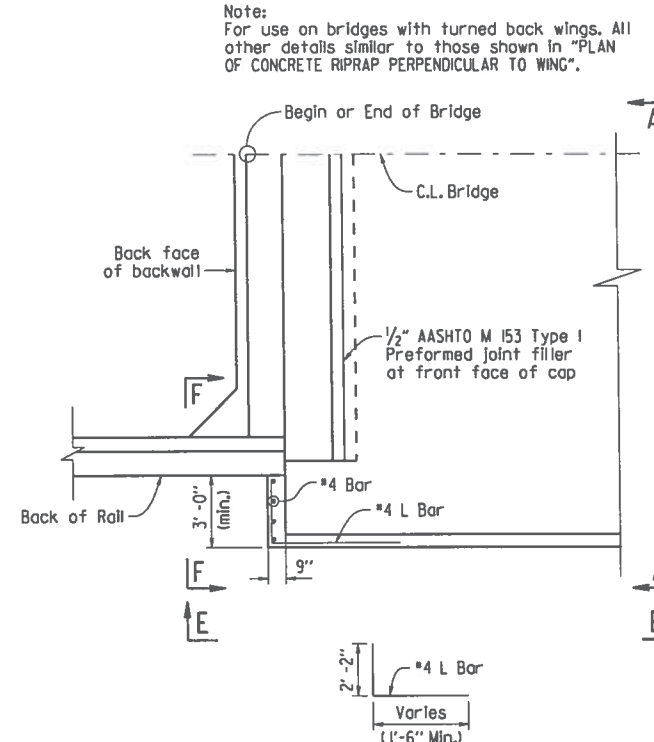

**PLAN OF CONCRETE RIPRAP PERPENDICULAR TO TURNED BACK WING**  
1/4" = 1'-0"

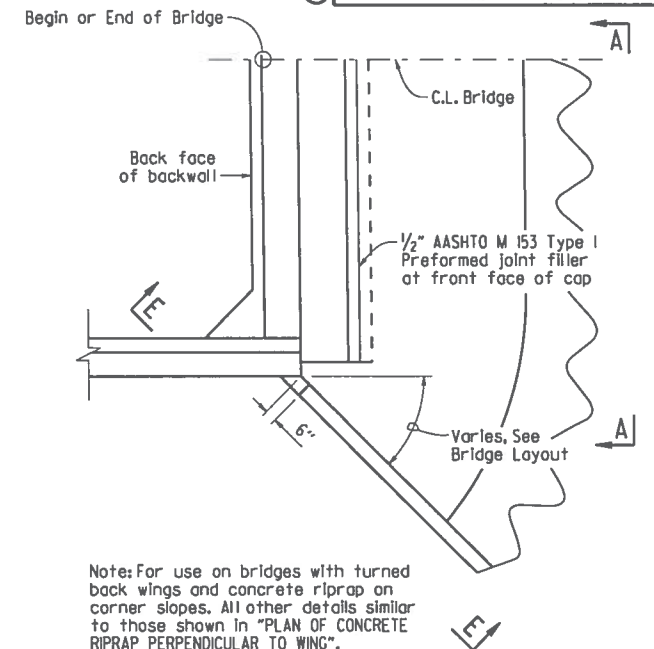


Note: For use on bridges with turned back wings and concrete riprap on corner slopes. All other details similar to those shown in "PLAN OF CONCRETE RIPRAP PERPENDICULAR TO WING".


**PLAN OF CONCRETE RIPRAP AT ANGLE FROM TURNED BACK WING**  
1/4" = 1'-0"

DATE REVISED	DATE FILMED	DATE REVISED	DATE FILMED	FED. ROAD DIST. NO.	STATE	FED. AID PROJ. NO.	SHEET NO.	TOTAL SHEETS
				6	ARK.			
JOB NO.							105	


CONCRETE RIPRAP 55002

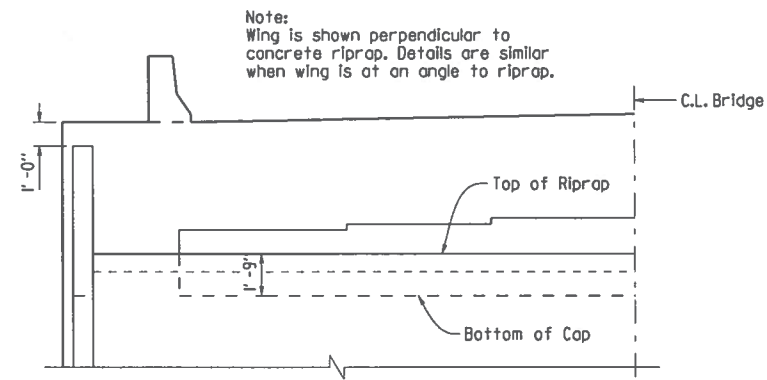


**VIEW A-A**  
1/4" = 1'-0"

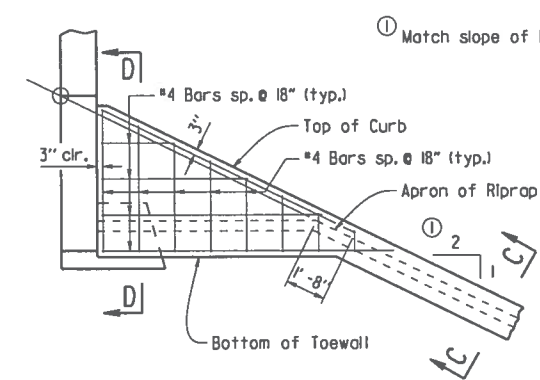


**VIEW B-B**  
1/4" = 1'-0"

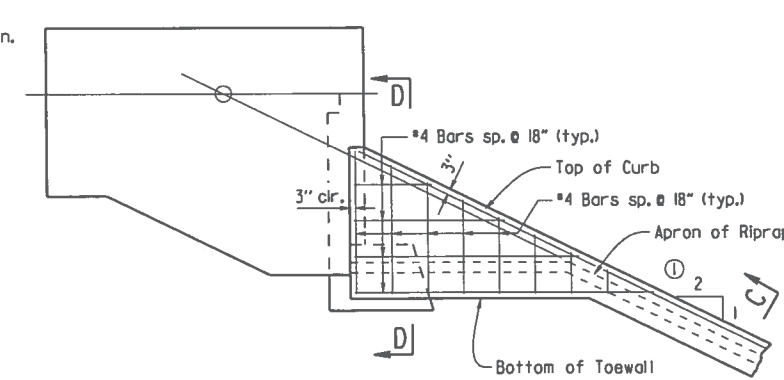


**VIEW E-E**  
1/4" = 1'-0"

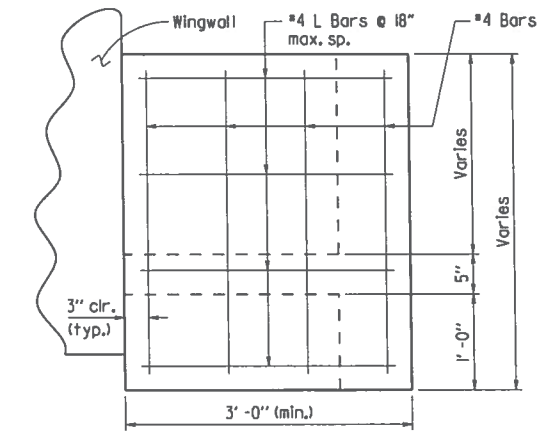


**VIEW F-F**  
1" = 1'-0"

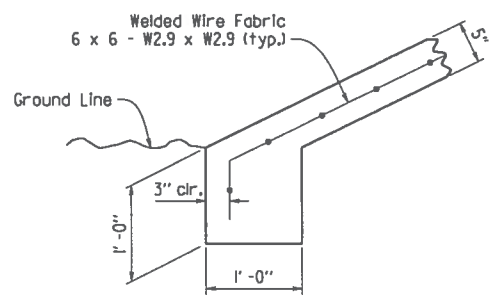

**TOE OF CONCRETE RIPRAP**  
1" = 1'-0"

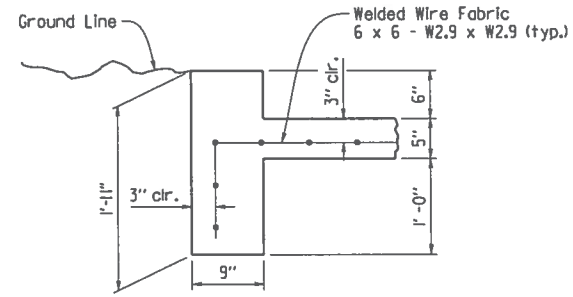

**SECTION C-C**  
1" = 1'-0"








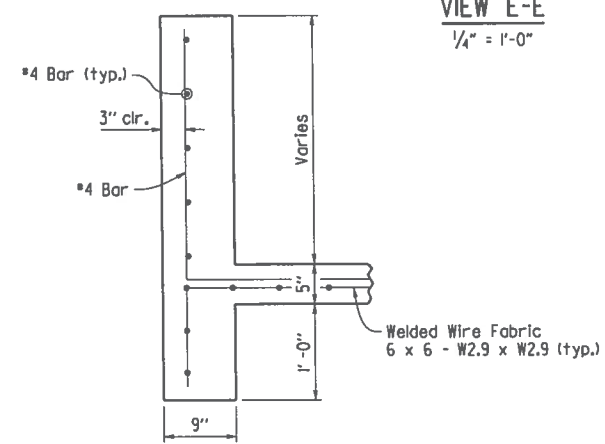


**SECTION D-D**  
1" = 1'-0"

**GENERAL NOTES**  
All concrete shall be Class A with a minimum compressive strength, f'c = 2,400 psi.  
Welded wire fabric shall conform to AASHTO M55 or M221.

**STANDARD DETAILS FOR CONCRETE RIPRAP**  
**ARKANSAS STATE HIGHWAY COMMISSION**  
LITTLE ROCK, ARK.  
DRAWN BY: ACP DATE: 2/27/2014 FILENAME: b55002.dgn  
CHECKED BY: BEF DATE: 2/27/2014 SCALE: AS SHOWN  
DESIGNED BY: Std. DATE: ---  
DRAWING NO. 55002

DATE REVISED	DATE FILMED	DATE REVISED	DATE FILMED	FED. ROAD DIST. NO.	STATE	FED. AID PROJ. NO.	SHEET NO.	TOTAL SHEETS
				6	ARK.			
JOB NO.							106	
BRIDGE DECK FORMS							55005	

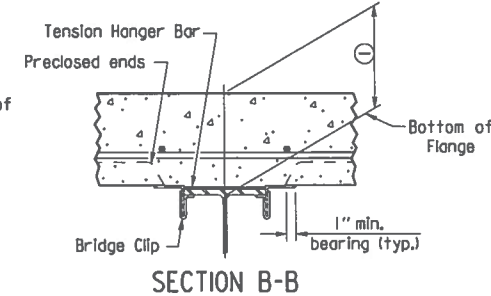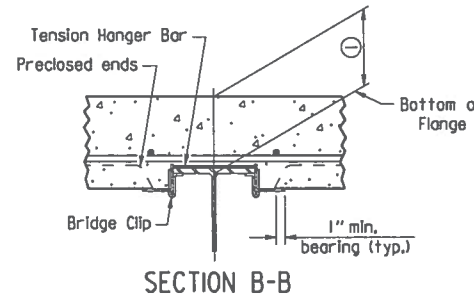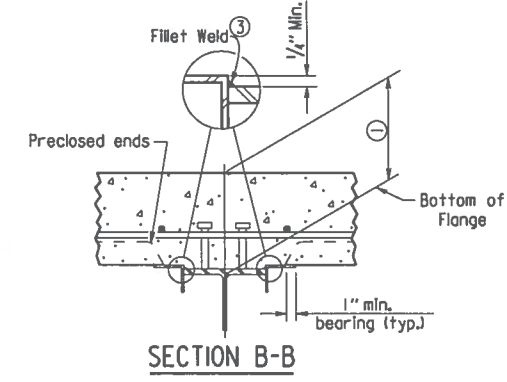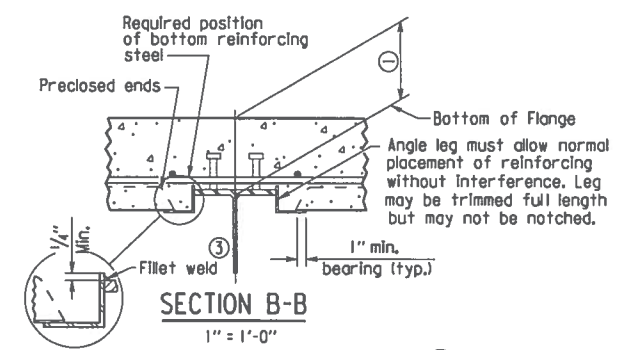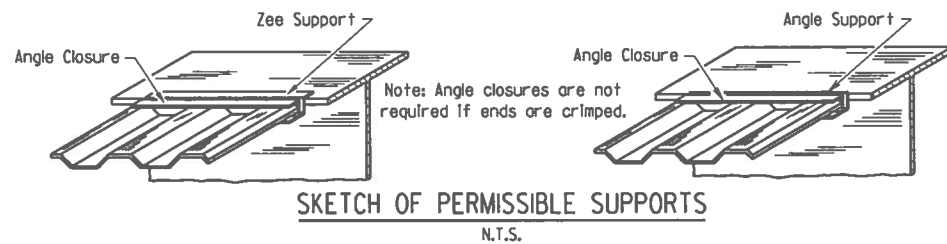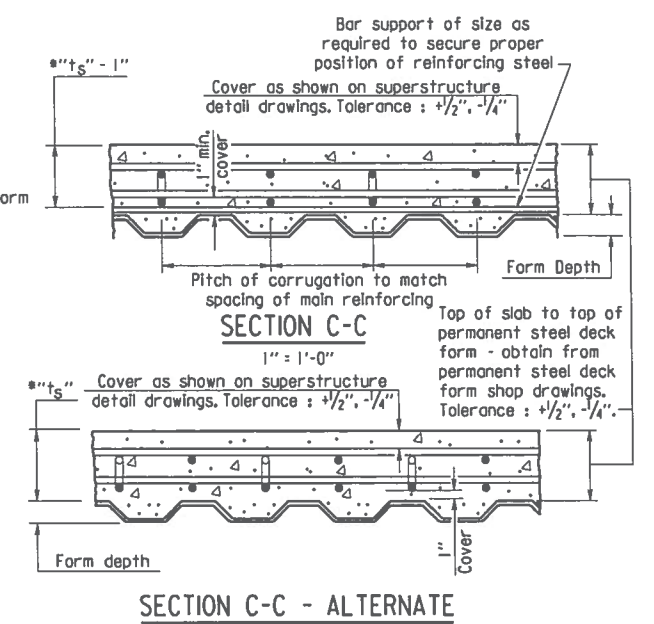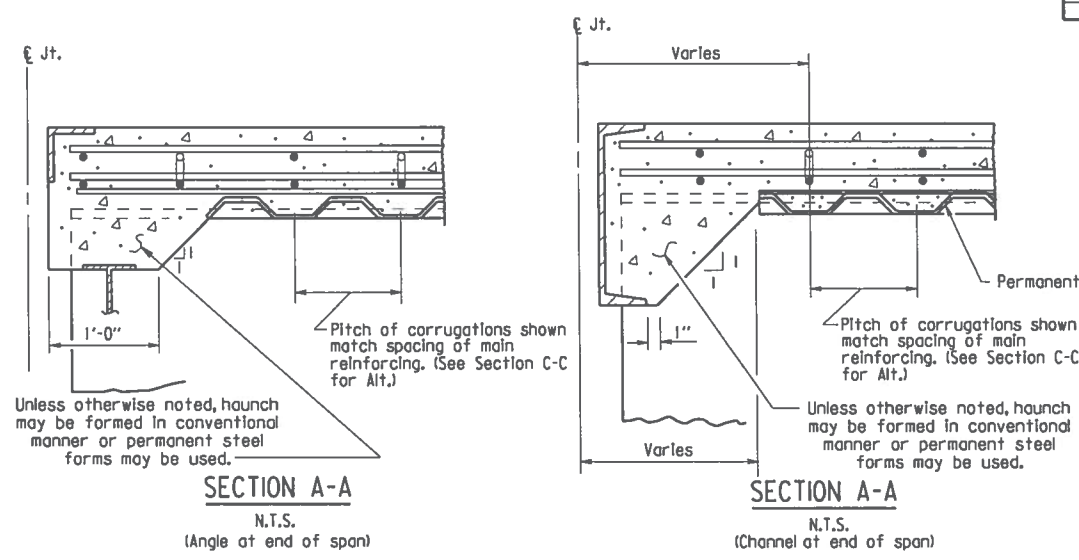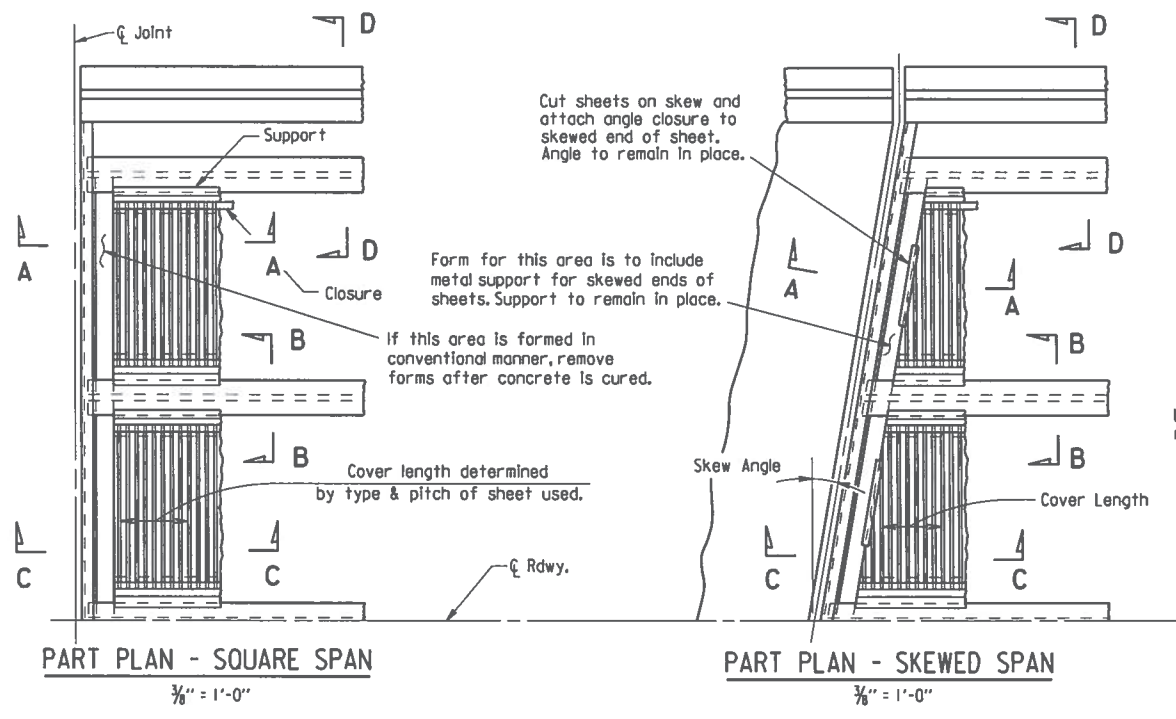





(Showing permissible support for tension flange where shear connectors are used, and for all compression flanges)

③ Minimum weld: 1/8" x 1' @ 18". More weld may be required; maximum length per weld = 1/2" (typ.)

(Showing permissible support for tension flange where shear connectors are used and for all compression flanges)

(Showing permissible support for tension flange where shear connectors are not used)

(Showing permissible support for tension flange where shear connectors are not used)

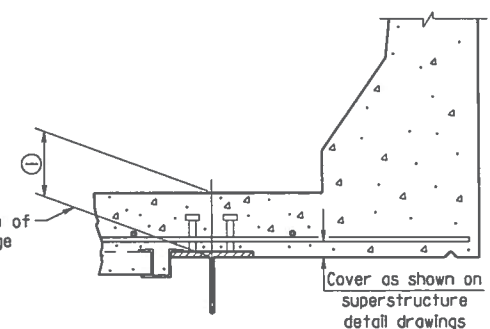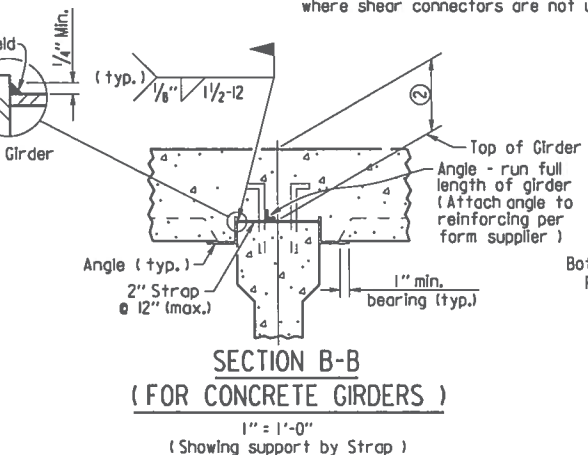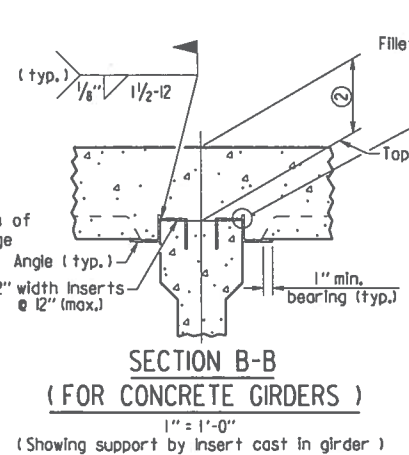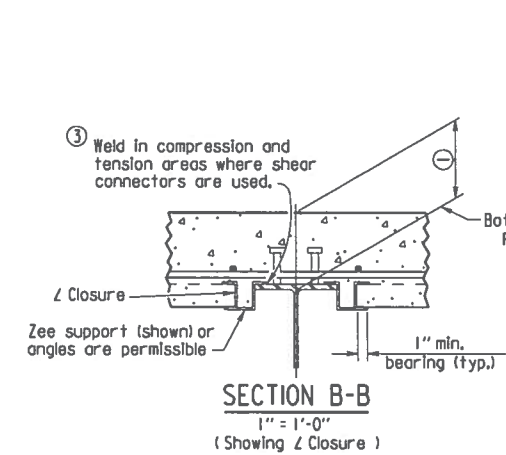

① Distance from top of slab to bottom of top flange as measured at centerline girder and as shown on superstructure detail drawings. This dimension may vary within the following limits to maintain the grade and slab thickness tolerances: Minimum - occurs when either the top flange or the support angle leg contacts the bottom reinforcing steel; Maximum =  $t_s + 1 1/4"$  + flange thickness. See Section C-C for slab thickness tolerance between adjacent girder flanges.

② Distance from top of slab to top of girder as measured at centerline girder and as shown on superstructure detail drawings. This dimension may vary within the following limits to maintain the grade and slab thickness tolerances: Minimum - occurs when either the top of girder or the support angle leg contacts the bottom reinforcing steel; Maximum - value shown on the superstructure detail drawings when removable forms are used. See Section C-C for slab thickness tolerance between adjacent girder flanges.

**GENERAL NOTES**

Permanent steel deck forms may be used at the Contractor's option and shall be at no additional cost to the Department. Such use may result in changes to the dead load deflection of the girder. Any cost for adjustments due to a change in the dead load deflection will be borne by the Contractor. Payment for deck concrete and structural steel will not be increased due to use of permanent steel deck forms.

Permanent steel deck forms shall conform to Subsection 802.14(b). Detailed plans, including detailed calculations and manufacturer's technical brochure, shall be submitted to and approved by the Engineer before work of forming the bridge deck is started.

Welding of form supports to the tension flange of steel girders will be permitted only in areas where shear connectors are used. When welding is not allowed, the method of fastening Z or L supports to the flange must be approved by the Engineer.

Form sheets shall be fastened to supporting members and to each other with galvanized metal screws sufficient in size and number to provide a secure attachment. Alternate methods of attachment must be approved by the Engineer.

When the pitch of form corrugations match the reinforcing spacing, transversely align form sheets across the bridge to maintain the correct orientation of continuous reinforcing bars in the corrugations.

Bar support rods, when used, shall be sized and spaced to adequately support the bottom reinforcing mat at the required position.

High chairs shall be sized to support the top mat of reinforcing at the proper position. High chairs shall be placed at locations shown on the detail drawings.

Specifications: Arkansas State Highway and Transportation Department Standard Specifications for Highway Construction (2014 Edition), with applicable Supplemental Specifications and Special Provisions.

## STANDARD DETAILS FOR PERMANENT STEEL BRIDGE DECK FORMS FOR STEEL & CONCRETE GIRDER SPANS

ARKANSAS STATE HIGHWAY COMMISSION  
LITTLE ROCK, ARK.

DRAWN BY: KDH DATE: 2-27-2014 FILENAME: b55005.dgn  
CHECKED BY: BEF DATE: 2-27-2014 SCALE: NONE  
DESIGNED BY: STD. DATE: —

DRAWING NO. 55005



DATE REVISED	DATE FILMED	DATE REVISED	DATE FILMED	FED. ROAD DIST. NO.	STATE	FED. AID PROJ. NO.	SHEET NO.	TOTAL SHEETS
12-1-14				6	ARK.			
1-14-15							107	

① TYPE D NAME PLATE 55010

The name of the bridge as shown on the plans shall be placed on Lines 1-3 using 1/8" raised letters and numerals 3/8" high.

	Example 1	Example 2	Example 3	Example 4
Line 1	Red River	Southern	Saline	Highway 5
Line 2	Relief	Railroad	River	
Line 3		Overpass	Relief	

**GENERAL NOTES**  
 Specifications: Arkansas State Highway and Transportation Department Standard Specifications for Highway Construction, (2014 Edition) with applicable Supplemental Specifications and Special Provisions.  
 Name plates shall be cast bronze and shall meet the material requirements as specified in Section 812.  
 Body of plate shall be 1/4" thick and shall include four tapering cone lugs 3/8" to 3/16" x 2" long. The border and all lettering shall be raised 1/8" above the face of plate and shall be polished.  
 All lettering shall be plain gothic, square cut and not tapered.  
 The number of plates required and the location and name on the plate for each bridge shall be as designated on the plans.

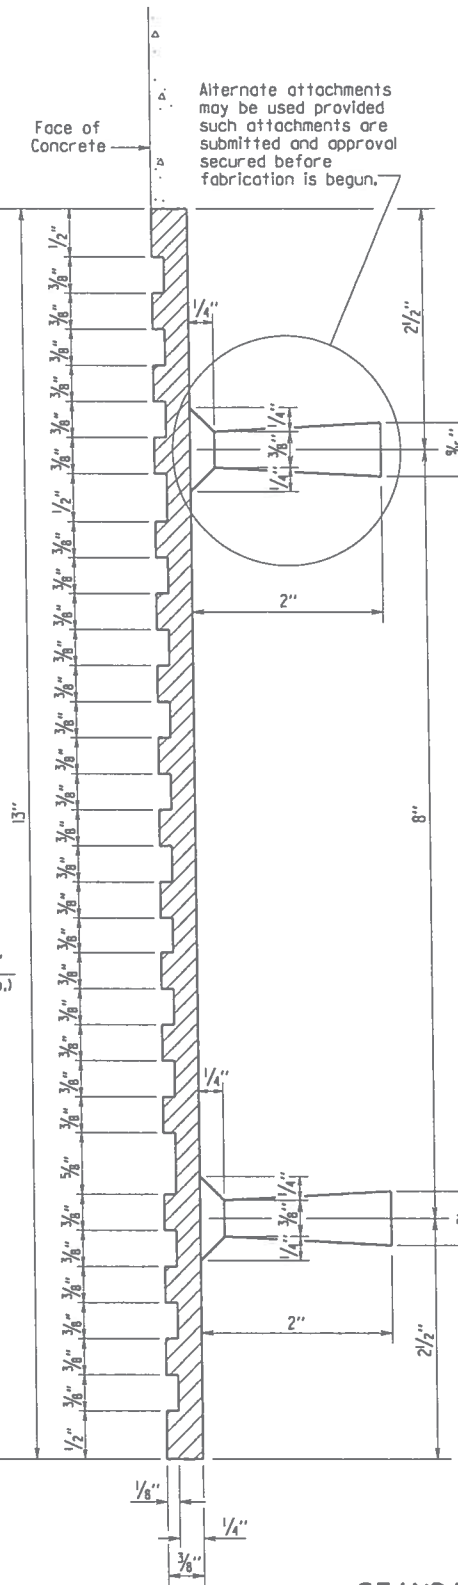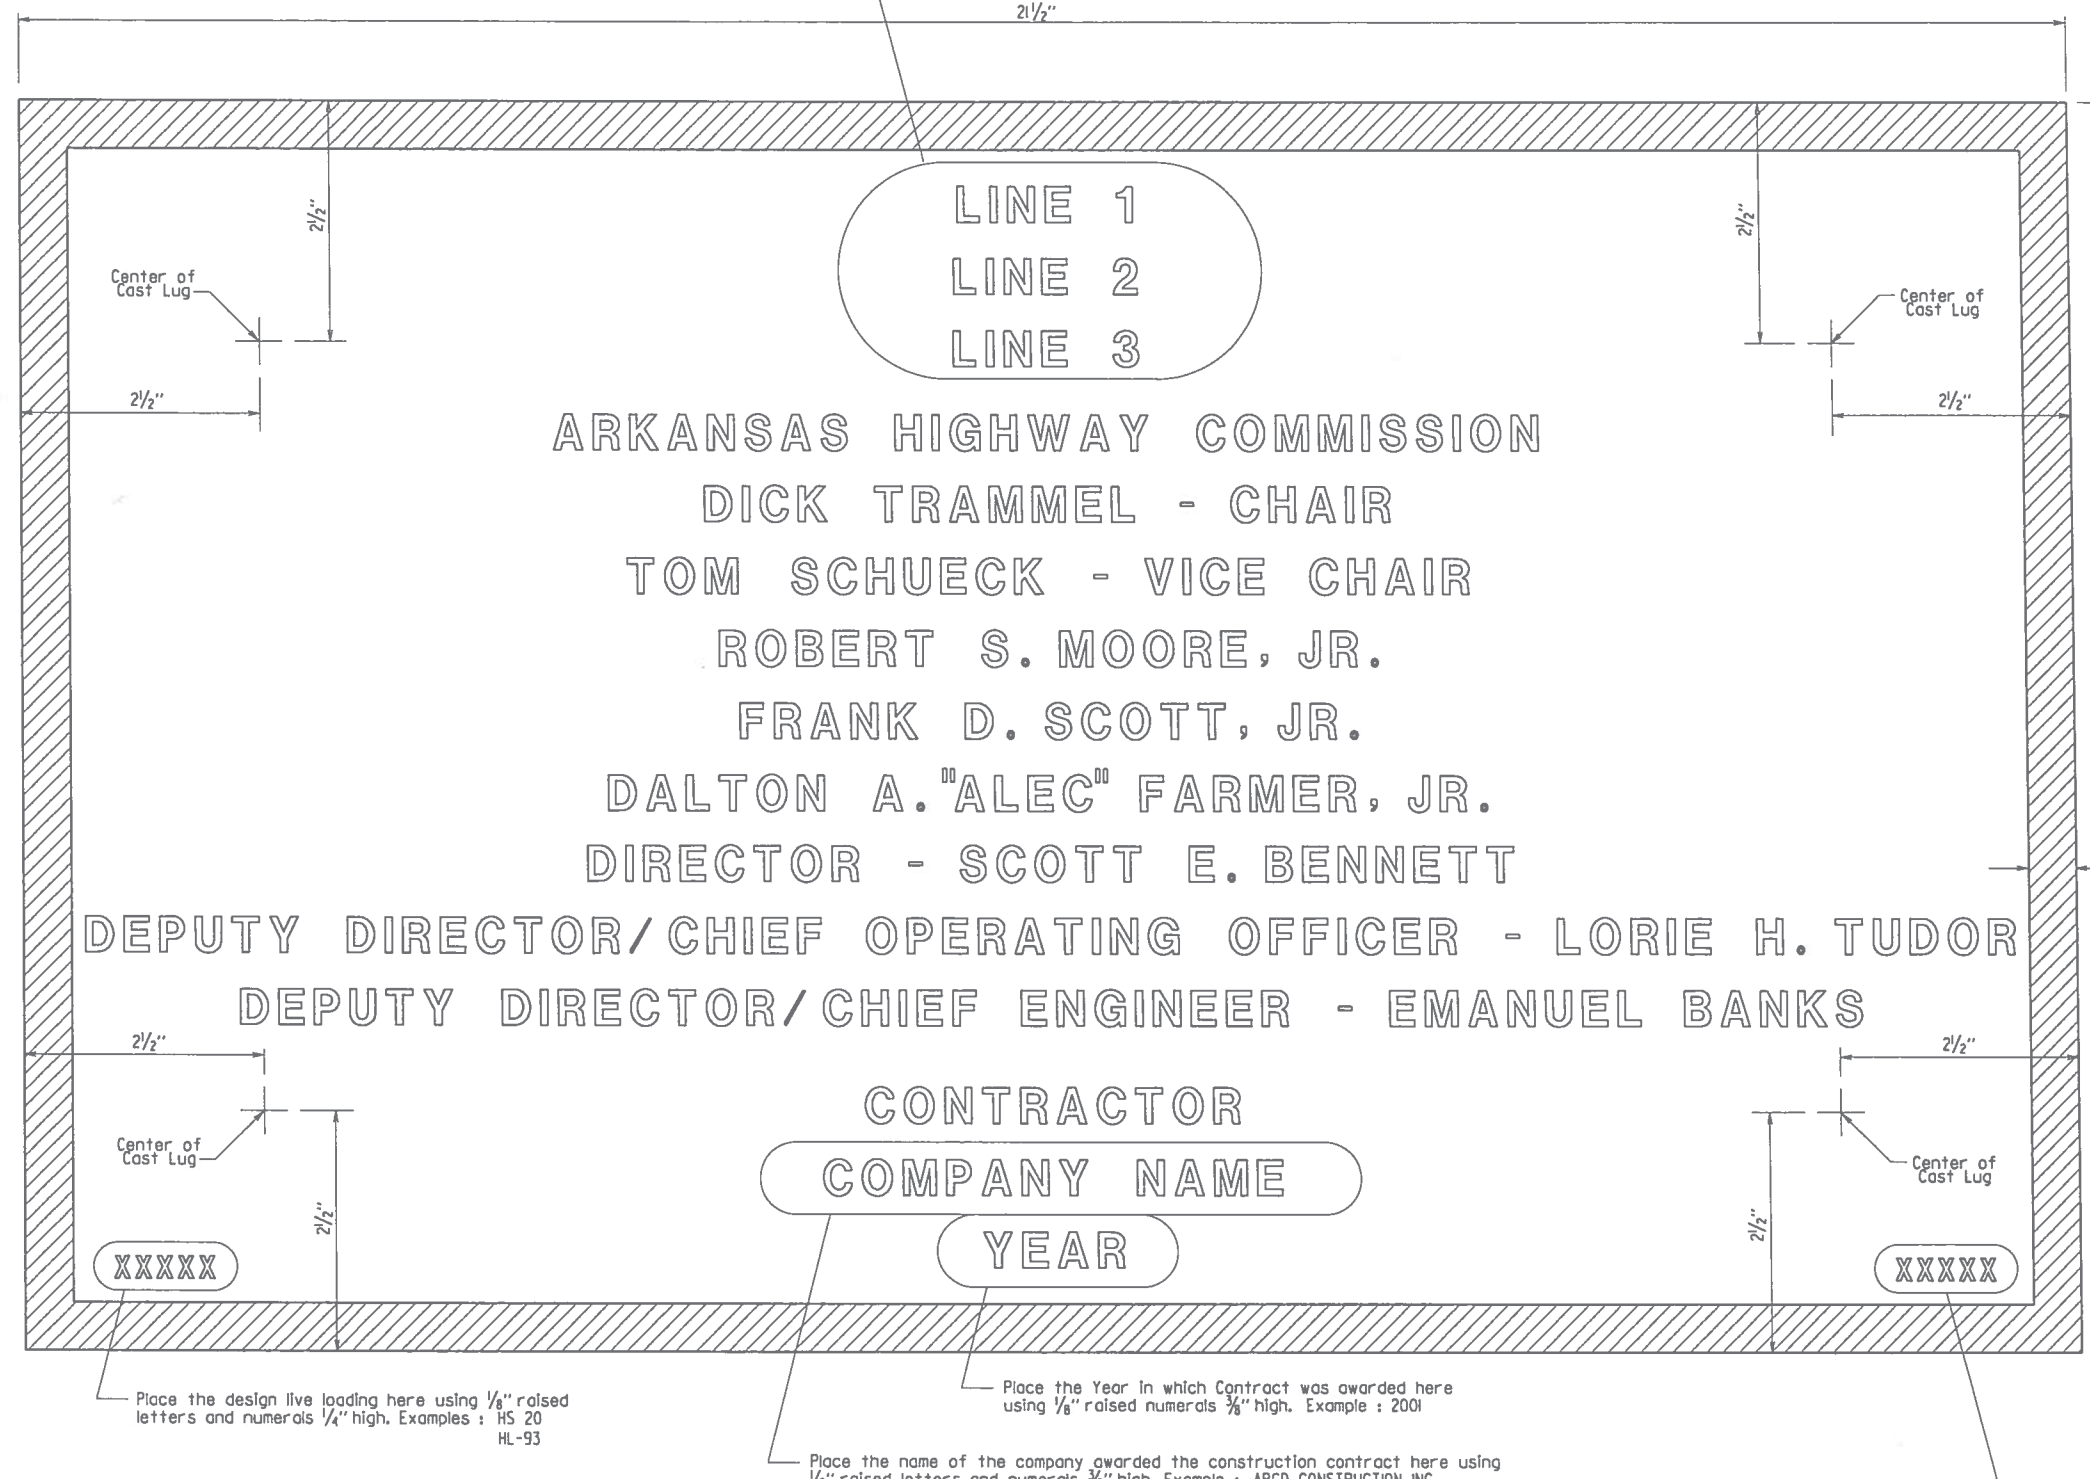

Place the design live loading here using 1/8" raised letters and numerals 1/4" high, Examples: HS 20 HL-93

Place the Year in which Contract was awarded here using 1/8" raised numerals 3/8" high, Example: 2001

Place the name of the company awarded the construction contract here using 1/8" raised letters and numerals 3/8" high, Example: ABCD CONSTRUCTION, INC.

Place the Bridge number here using 1/8" raised letters and numerals 1/4" high, Examples: A1234 05432

- ② Revised Chair and Vice Chair Added New Commissioner  
1-14-15 KDH Checked By: CRE
- ① Revised Deputy Director/Chief Engineer Added Deputy Director/Chief Operating Officer  
12-1-14 KDH Checked By: CRE

TYPICAL BRIDGE NAME PLATE

STANDARD DETAILS FOR TYPE D BRIDGE NAME PLATE

ARKANSAS STATE HIGHWAY COMMISSION  
 LITTLE ROCK, ARK.  
 DRAWN BY: KDH DATE: 2-27-2014 FILENAME: b55010.dgn  
 CHECKED BY: BEF DATE: 2-27-2014 SCALE: NO SCALE  
 DESIGNED BY: STD. DATE: \_\_\_\_\_  
 DRAWING NO. 55010

DATE REVISED	DATE FILMED	DATE REVISED	DATE FILMED	FED. ROAD DIST. NO.	STATE	FED. AID PROJ. NO.	SHEET NO.	TOTAL SHEETS
				6	ARK.			
				JOB NO.			108	
① STEEL H-PILES								55020


**GENERAL NOTES FOR STEEL H-PILES:**

Steel H-Piles shall conform to AASHTO M 270, Grade 36 or greater.


See Bridge Layout and Bent Details for pile size, estimated length, spacing, pile anchorage (if required) and for driving information.

Steel H-Piles that extend above the ground and are not protected by pile encasement shall be painted in accordance with Subsection 805.02.

Brackets, lugs, cap plates, pile tips, driving points, pile painting, splicing and welding shall not be paid for directly, but shall be considered subsidiary to the item "Steel Piling".

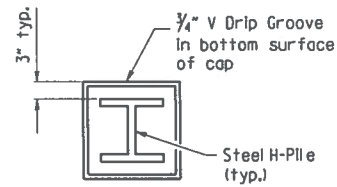

VIEW X-X

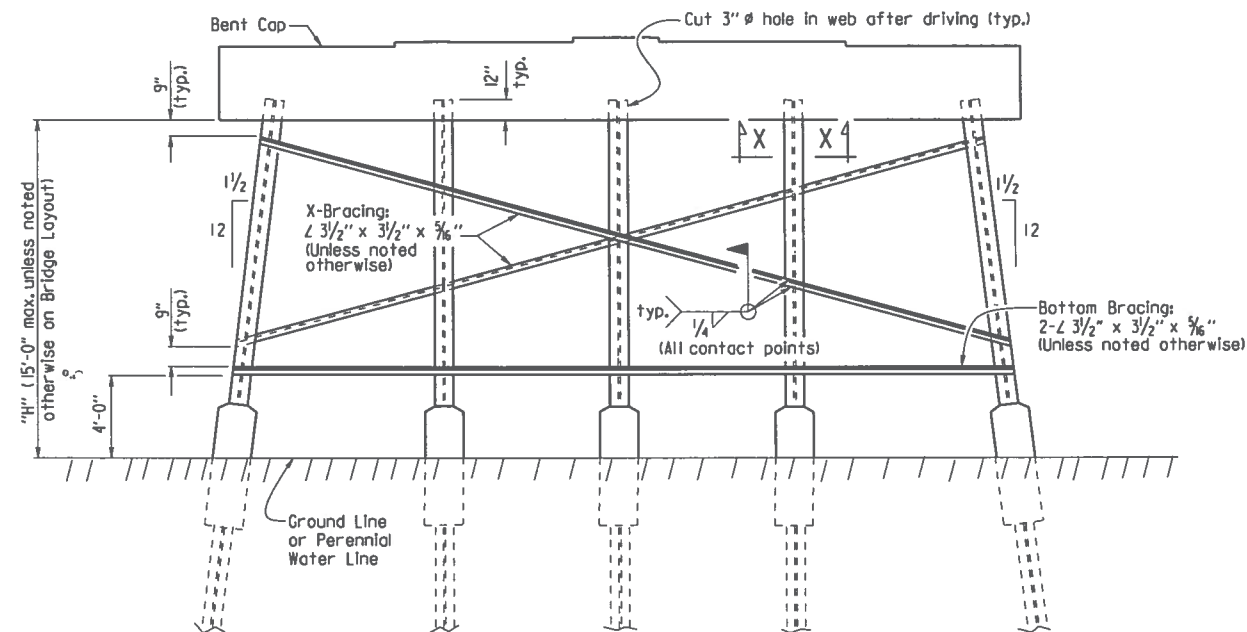

**Notes:**

All bracing shall be cut and welded in the field. Each brace shall be furnished in one piece. Payment shall be made under item 807.

Unless noted otherwise, omit X-Bracing when "H" is less than 8 feet.


Omit X-Bracing and Bottom Bracing when "H" is 5 feet or less.

When required on the Bridge Layout sheet, pile encasements shall be constructed. See Notes and Details for H-Pile Encasements.

Omit all bracing (and V-groove in cap) when pile encasement is extended to bottom of bent cap.

**TYPICAL DETAILS OF H-PILE TRESTLE INTERMEDIATE BENT**


(Shown with Partial Height Encasement)

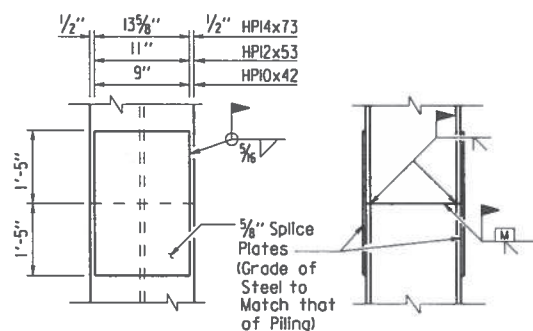

**Notes:**

The Contractor may for his own convenience and at his own expense provide as many as three splices per pile. Minimum spacing between splices shall be 5 feet.

**TYPICAL SPLICE DETAILS**

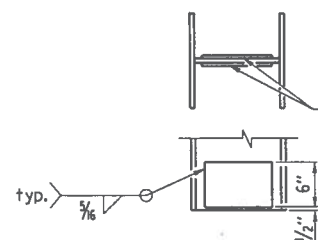

**REINFORCING DETAIL FOR STEEL H-PILE TIP**

**Notes:**

Steel pile tip reinforcing not required when approved H-Pile driving points are used.

Steel pile tip reinforcing shall not be paid for directly, but shall be considered subsidiary to the item "Steel Piling".

- HPI4x73 - PL 1/2" x 6" x 11"
- HPI2x53 - PL 1/2" x 6" x 9"
- HPI0x42 - PL 1/2" x 6" x 7"

**GENERAL NOTES FOR H-PILE ENCASEMENTS:**


See Bridge Layout for additional notes and required location of pile encasements.

All concrete shall be Class S with a minimum 28-day compressive strength, f'c = 3,500 psi. If concrete cannot be placed in the dry, Seal Concrete may be used from top to bottom of encasement.

Reinforcing steel shall be Grade 60 conforming to AASHTO M 31 or M 322, Type A.


Welded Wire Fabric shall conform to AASHTO M 55 or M 221. Galvanized Corrugated Steel Pipe shall conform to AASHTO M 36 and M 218.

Concrete, welded wire fabric or reinforcing steel and galvanized pipe shall not be paid for directly, but shall be considered subsidiary to the item "Pile Encasement".

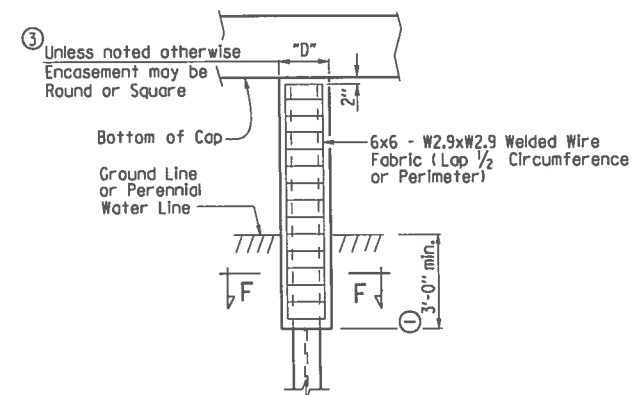

**PILE ENCASEMENT DETAIL FOR STEEL H-PILES**

④ (Shown with Encasement to Bottom of Cap)

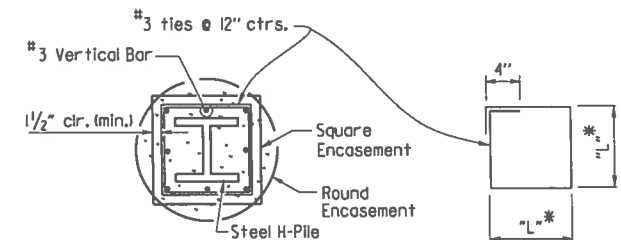


SECTION F-F

\* Measured out-to-out of bar.

**TABLE OF VARIABLES FOR PILE ENCASEMENT**

Pile Size	"D"		"L"*
	Square Encsmt.	Round Encsmt.	
HPI0x42	1'-7"	2'-0"	1'-4"
HPI2x53	1'-8"	2'-2"	1'-5"
HPI4x73	1'-11"	2'-6"	1'-8"

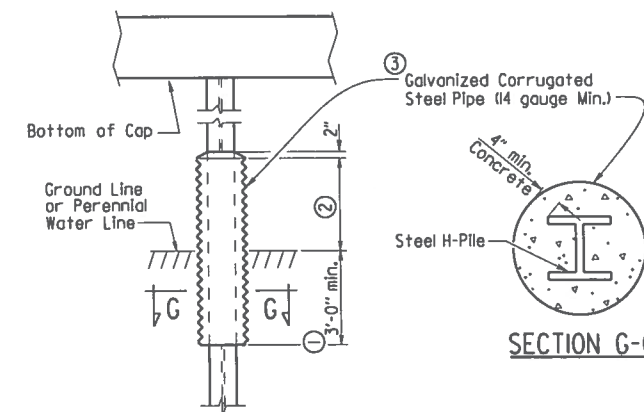

SECTION G-G

**ALTERNATE PILE ENCASEMENT DETAIL FOR STEEL H-PILES**

(Shown with Partial Height Encasement)

① Unless otherwise noted on Bridge Layout.

② 3'-0" minimum or as shown on Bridge Layout.

③ Encasement dimensions shall be sized to maintain a minimum concrete cover of 4" from the H-Pile. Reinforcement shall be sized to provide a minimum concrete cover of 1/2" and a minimum clearance of 1/4" from the pile.

④ Alternate pile encasement, when not extended to bottom of cap, shall have 2" concrete taper for water runoff as shown in the Partial Height Encasement detail.

⑤ Alternate pile encasement may not be allowed. See Bridge Layout.

**STANDARD DETAILS FOR STEEL H-PILES AND PILE ENCASEMENTS**


ARKANSAS STATE HIGHWAY COMMISSION  
LITTLE ROCK, ARK.

DRAWN BY: A.M.S. DATE: 2/27/2014 FILENAME: b55020.dgn  
CHECKED BY: B.E.F. DATE: 2/27/2014 SCALE: NO SCALE  
DESIGNED BY: STD. DATE: —




BRIDGE ENGINEER

This document was originally issued and sealed by Carl J. Fuseller, PE No. 7510, on February 27, 2014. This copy is not a signed and sealed document.

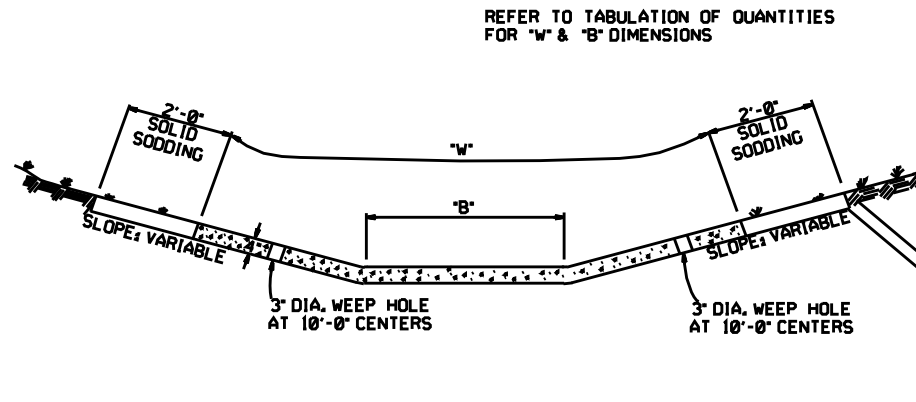


TYPE A

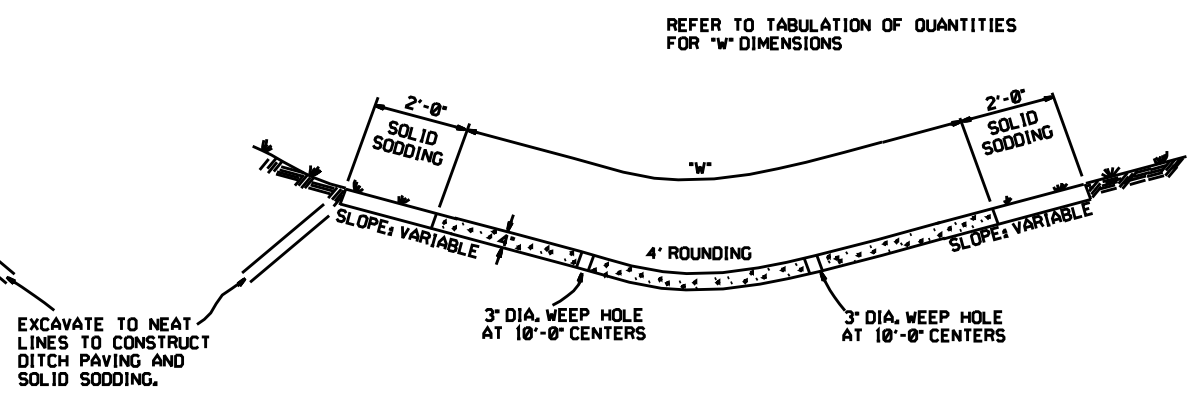


TYPE B

EXCAVATE TO NEAT LINES TO CONSTRUCT DITCH PAVING AND SOLID SODDING.


THE STEEL AND ADDITIONAL CONCRETE FOR THE WALLS SHALL NOT BE PAID FOR DIRECTLY, BUT SHALL BE CONSIDERED TO BE INCLUDED IN THE PRICE BID FOR "CONCRETE DITCH PAVING."

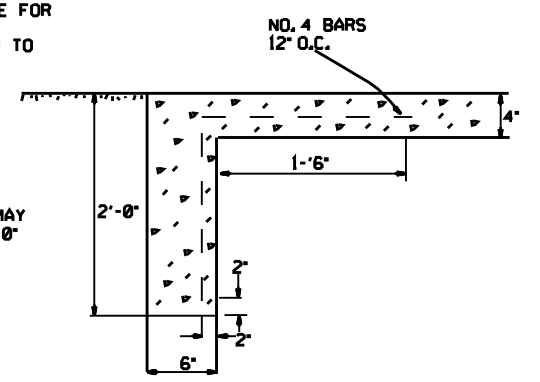

TOE WALL DETAIL FOR CONCRETE DITCH PAVING

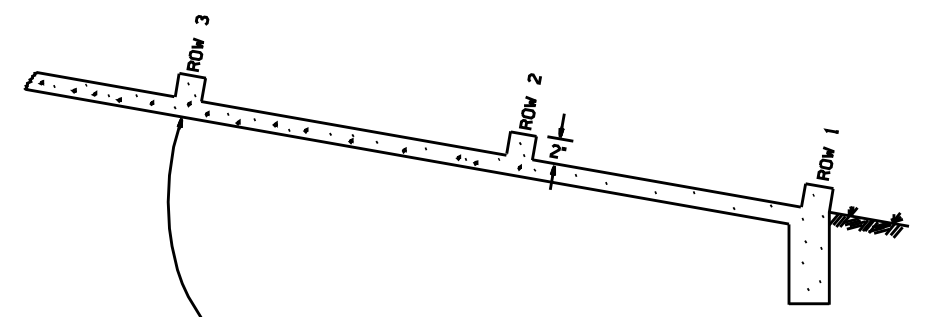

ENERGY DISSIPATORS TO BE USED FOR THE ENTIRE LENGTH OF DITCH WHEN SLOPE OF DITCH PAVING EXCEEDS 7%. THE DISSIPATORS WILL NOT BE PAID FOR DIRECTLY, BUT SHALL BE CONSIDERED TO BE INCLUDED IN THE PRICE BID FOR CONCRETE DITCH PAVING.

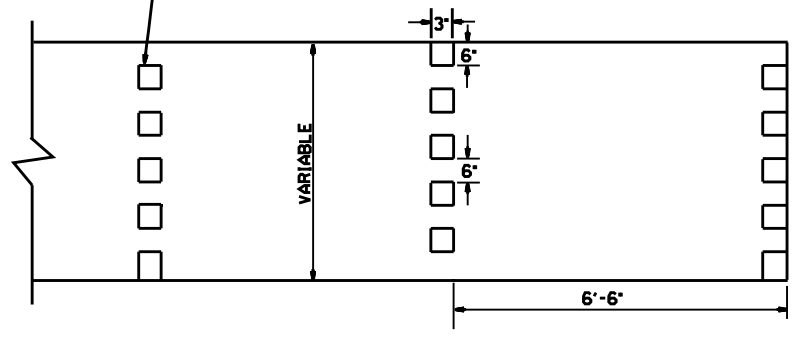

ENERGY DISSIPATORS  
(NO SCALE)

GENERAL NOTES:


- THE FULL WIDTH OF EACH SECTION SHALL BE POURED MONOLITHICALLY.
- TOE WALLS TO BE CONSTRUCTED FULL WIDTH AT EACH END OF DITCH PAVING, AND POURED MONOLITHICALLY.
- SOLID SOD ALONG DITCH PAVING TO BE PLACED WITHIN 14 DAYS OF DITCH PAVING CONSTRUCTION.
- 1' WIDE TRANSVERSE EXPANSION JOINTS SHALL BE PLACED IN CONCRETE DITCH PAVING AT 45' INTERVALS. THE SPACE SHALL BE FILLED WITH APPROVED JOINT FILLER COMPLYING WITH AASHTO M213.

DATE	REVISION	DATE FILM'D
11-17-10	ADDED GENERAL NOTE	
6-2-94	ADDED GENERAL NOTE ABOUT SOLID SODDING	
11-30-8	ELIMINATED MIN. ROWS OF ELEMENTS	11-30-89
7-15-88	REVISED DISSIPATOR NOTE	653-7-15-88
4-3-87	REVISED ENERGY DISSIPATOR	671-4-3-87
1-9-87	MODIFIED NOTE ON ENERGY DISS.	632-1-9-87
11-3-86	ADDED NOTE TO ENERGY DISS.	599-2-1-86
11-1-84	ENERGY DISSIPATOR DETAILS ADDED	508-11-1-84
11-1-84	EXCAVATION DETAILS ADDED	
	TYPED A & B	
10-2-72	REVISED AND REDRAWN	508-10-2-72


ARKANSAS STATE HIGHWAY COMMISSION

CONCRETE DITCH PAVING


STANDARD DRAWING CDP-1

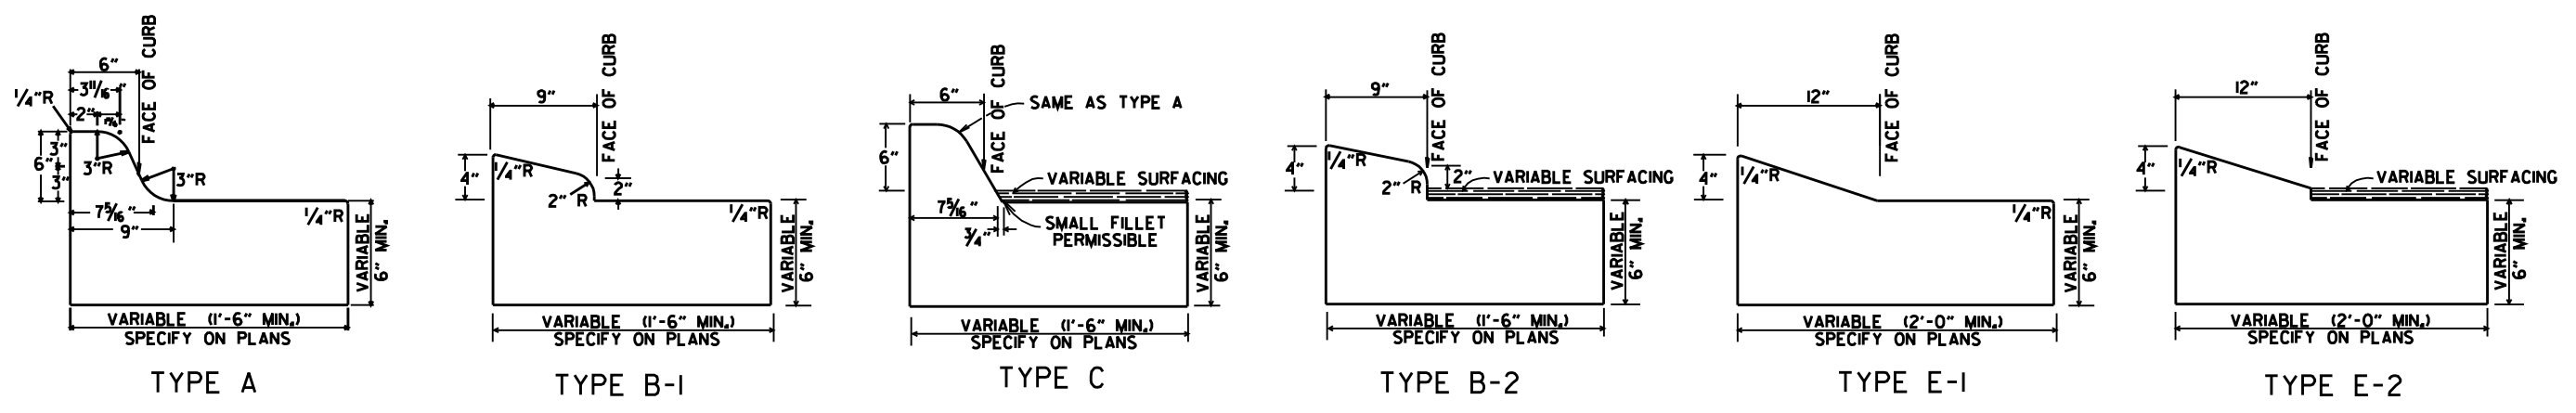


CONCRETE COMBINATION CURB AND GUTTER

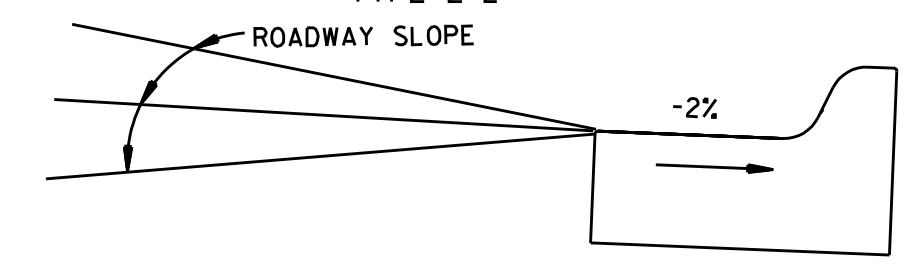

DETAIL OF GUTTER SLOPE  
GUTTER SHALL BE CONSTRUCTED ON 2% SLOPE AWAY FROM ROADWAY, REGARDLESS OF ROADWAY SLOPE.

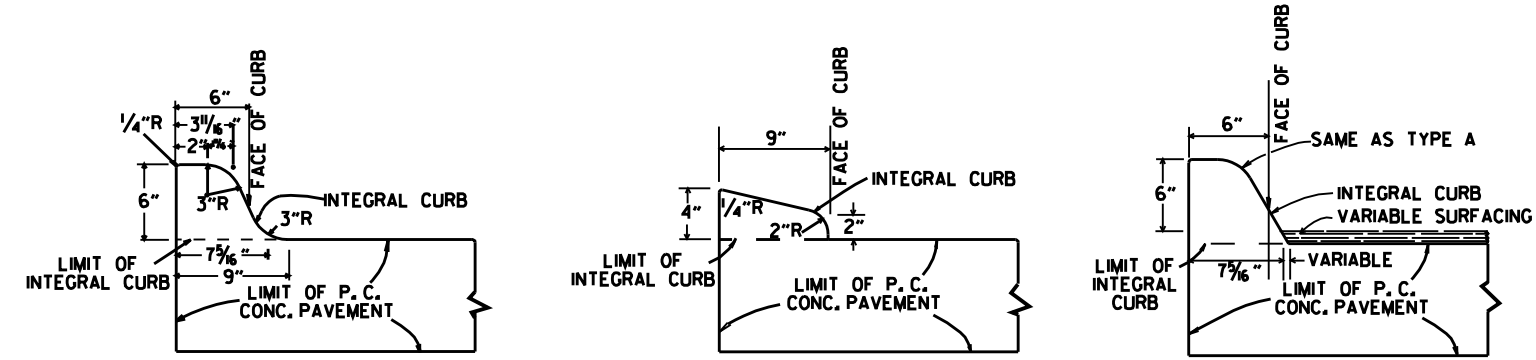


INTEGRAL CURB

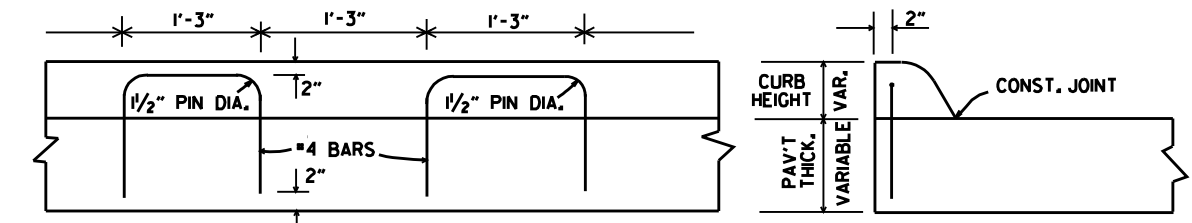


LONGITUDINAL SECTION ELEVATION

ALTERNATE CONSTRUCTION METHOD FOR INTEGRAL CURB

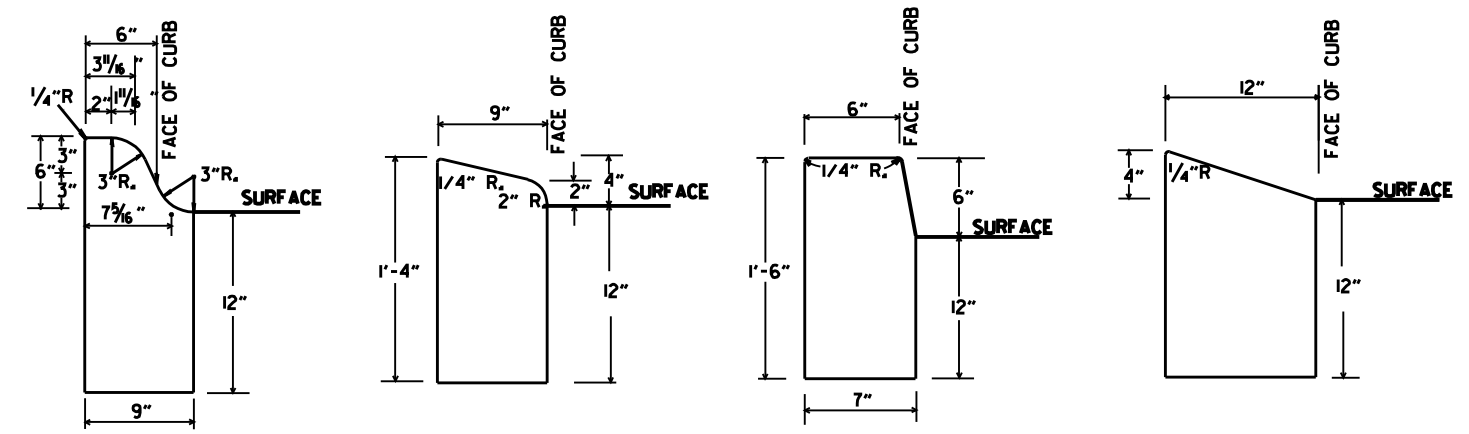

CONCRETE CURB

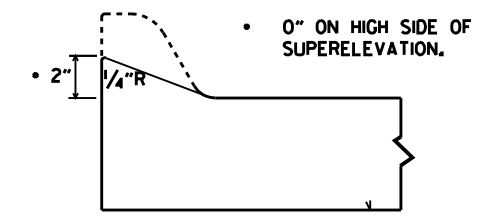

DETAILS OF MODIFIED CURB


NOTE: USE MODIFIED CURB AS SPECIFIED ON STD. DR-1. COMPENSATION FOR MODIFIED CURB WILL BE CONSIDERED INCLUDED IN THE PRICE BID FOR THE TYPE OF CURB OR CURB AND GUTTER SPECIFIED.

DATE	REVISION	DATE FILMED
11-29-07	REVISED GUTTER SLOPE & MODIFIED CURB DETAILS	
11-10-05	ADDED DETAILS OF TYPE E CURBS	
11-16-01	REVISED CONCRETE CURB TYPE B	
11-18-98	REVISED MODIFIED CURB	
6-2-94	ADDED NOTE TO SPECIAL MODIFIED CURB	
8-5-93	CORRECTED GUTTER SLOPE	8-5-93
10-1-92	ADDED DETAILS OF GUTTER SLOPE	10-1-92
5-24-90	ADDED DETAILS OF MODIFIED CURB	5-24-90
11-30-89	VARIABLE DEPTH TYPE A & B I	11-30-89
7-15-88	REVISED MODIFIED CURB	630-7-15-88
11-1-73	REVISED MODIFIED CURB	500-11-1-73
10-2-72	REVISED AND REDRAWN	512-10-2-72


ARKANSAS STATE HIGHWAY COMMISSION

CURBING DETAILS


STANDARD DRAWING CG-1

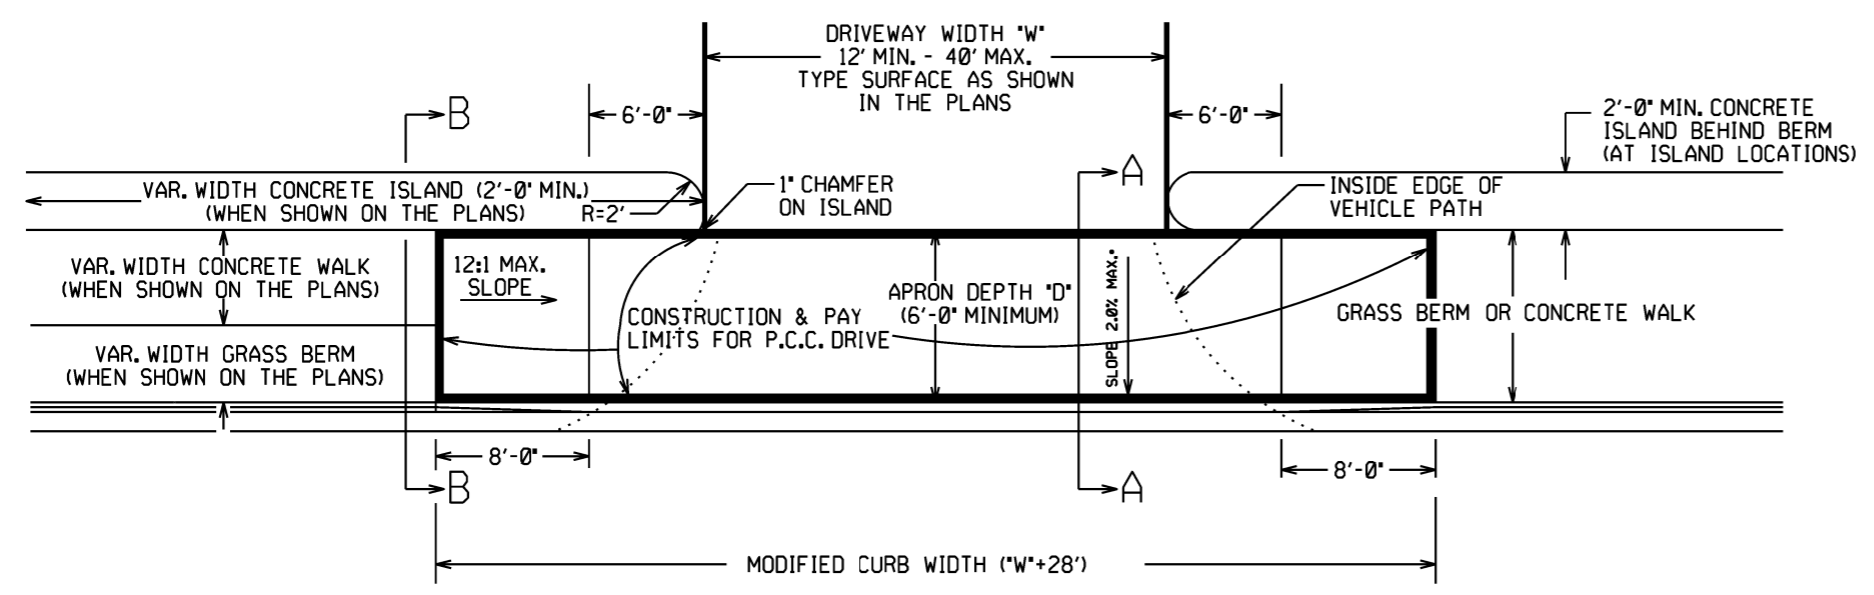

PLAN VIEW

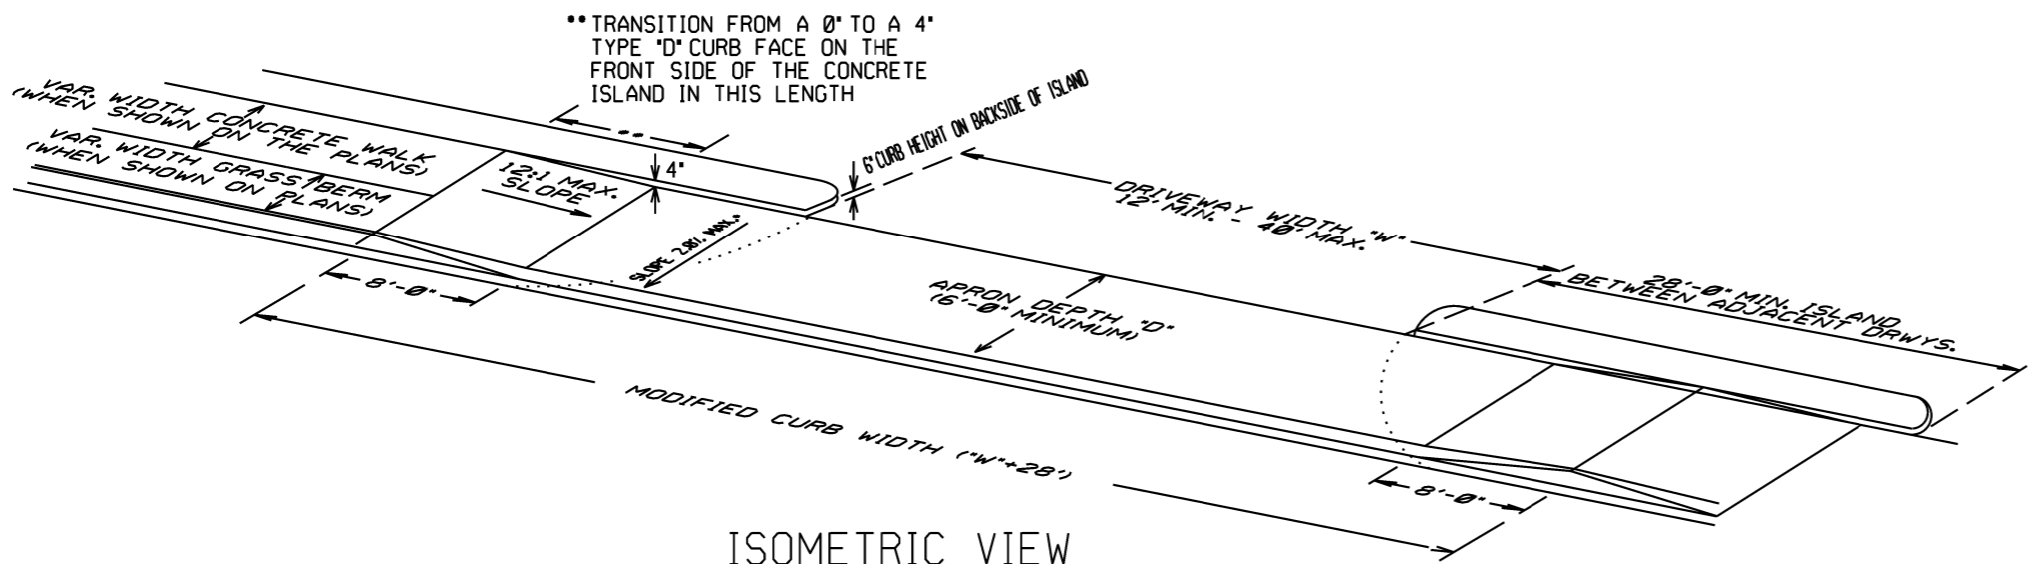


ISOMETRIC VIEW

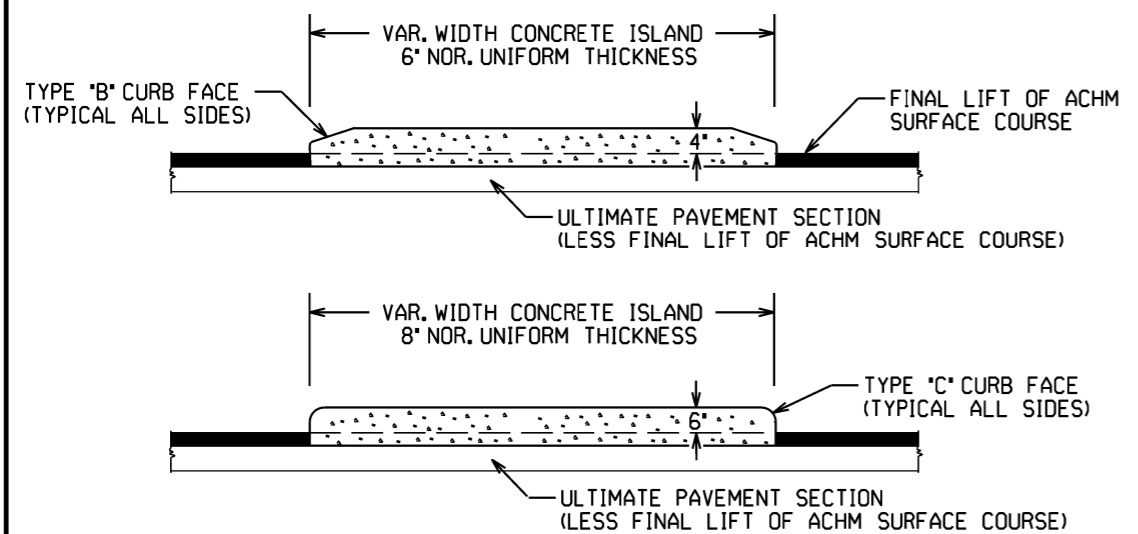

CURBED ISLANDS FOR CHANNELIZATION

REFER TO PLANS FOR TYPE OF CURB FACE TO BE USED.  
NO DIRECT PAYMENT WILL BE MADE FOR THE CURB FACES  
SHOWN ON THE ISLAND DETAILS. PAYMENT FOR THE CURB  
FACE WILL BE INCLUDED IN THE UNIT PRICE BID FOR THE  
ITEM "CONCRETE ISLAND".

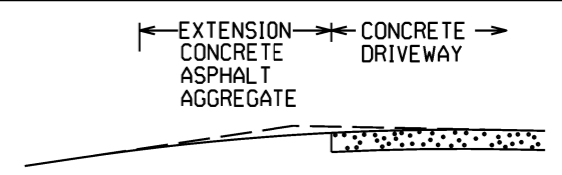


EXTENSION TYPICAL SECTIONS

- 1: CONCRETE - 6" P.C. CONCRETE DRIVEWAY
- 2: ASPHALT - 2" ACHM SURFACE COURSE (1/2")  
4" ACHM BINDER COURSE (1") OR  
4" ACHM BASE COURSE (1-1/2")
- 3: ASPHALT - 2" ACHM SURFACE COURSE (1/2")  
7" AGGREGATE BASE COURSE
- 4: AGGREGATE - 6" AGGREGATE BASE COURSE


THE TYPE OF EXTENSION SHALL BE AS SHOWN IN THE PLANS.  
THE CONTRACTOR MAY, WITH THE APPROVAL OF THE ENGINEER,  
SUBSTITUTE A LOWER NUMBERED TYPE OF EXTENSION IN LIEU  
OF THE TYPE SPECIFIED IN THE PLANS, BUT AT NO ADDITIONAL  
COST TO THE DEPARTMENT.

DRIVEWAY EXTENSION DETAILS

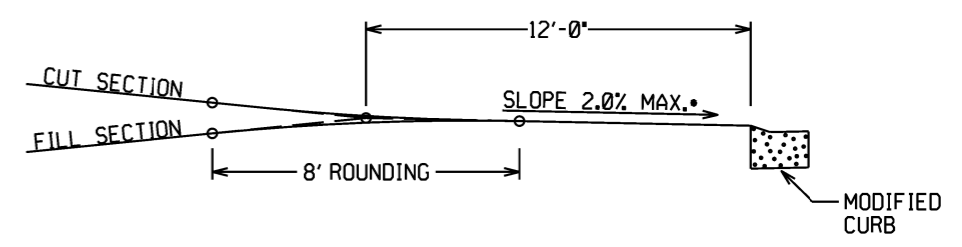


DRIVEWAY VERTICAL ALIGNMENT DETAILS

NOTE: DRIVEWAYS MAY NOT BE SLOPED AWAY  
FROM THE ROADWAY UNLESS APPROVED  
BY THE ENGINEER.

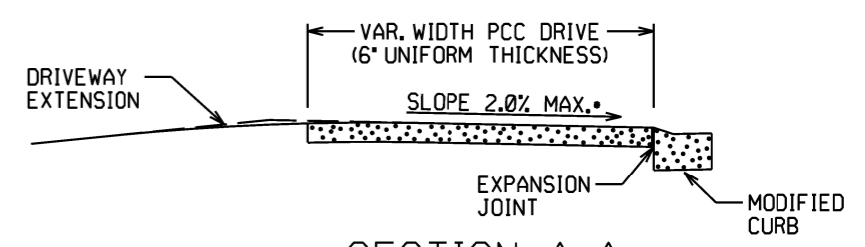


SECTION A-A

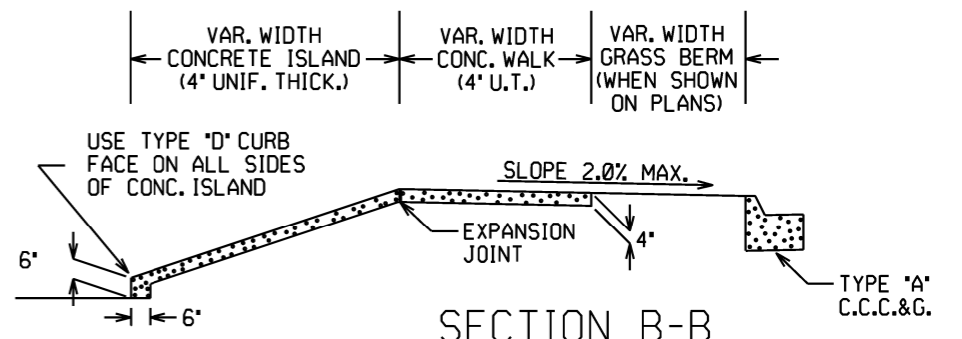


SECTION B-B  
CURBED ISLAND BEHIND WALK

DATE	REV	DESCRIPTION
2-27-14		REVISED PLAN & ISOMETRIC VIEW
11-29-07		ADDED CHANNELIZATION ISLAND WITH TYPE C CURB FACE & REVISED DRIVEWAY SLOPE NOTE & VERTICAL ALIGNMENT DETAIL
11-10-05		REV. APRON SLOPE & DEPTH OF AGG. BASE.
8-22-02		ADDED ISLAND DETAILS & NOTES
3-30-00		REV. MOD. CURB WIDTH & TRANS. NOTE
11-19-98		REVISED NOTES
11-18-98		REDRAWN AND REISSUED
		DATE REV DATE FILMED DESCRIPTION


ARKANSAS STATE HIGHWAY COMMISSION  
DETAILS OF DRIVEWAYS & ISLANDS  
STANDARD DRAWING DR-1

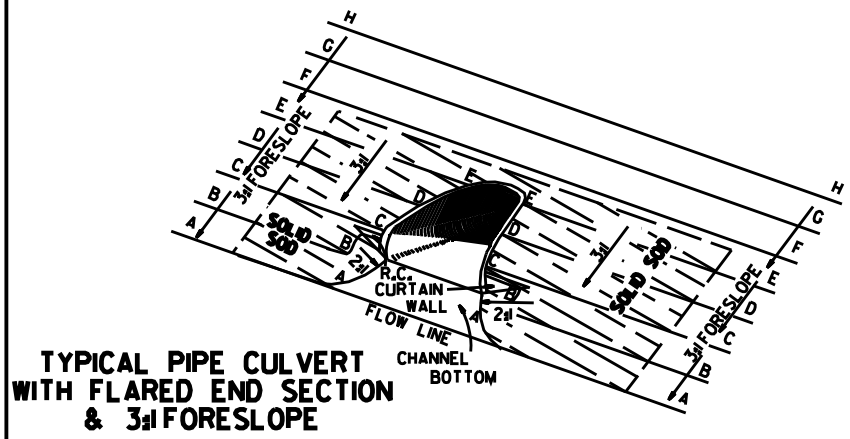


TYPICAL PIPE CULVERT WITH FLARED END SECTION & 3/4:1 FORESLOPE

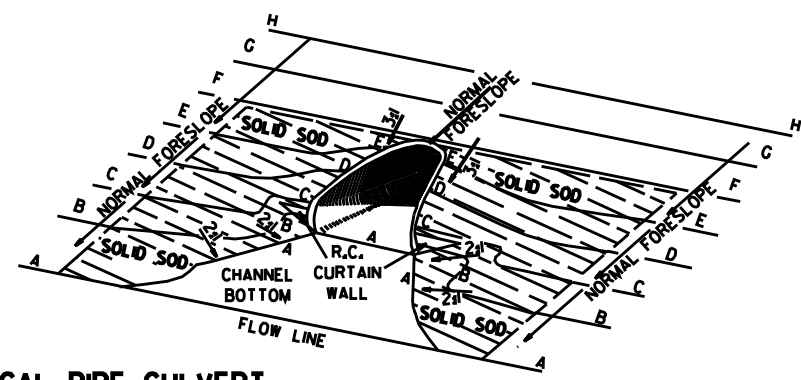

TYPICAL PIPE CULVERT WITH FLARED END SECTION & FLATTENED ADJACENT SLOPES

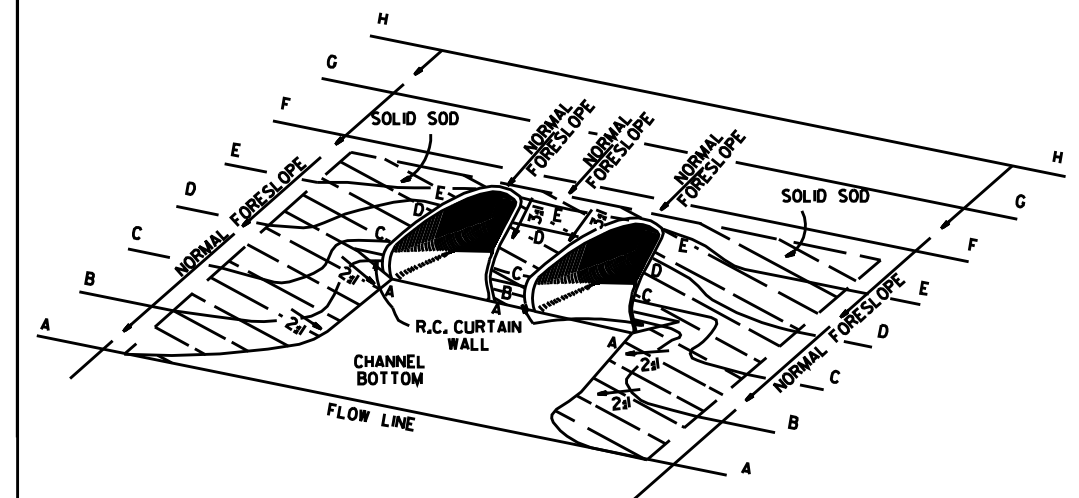

TYPICAL MULTIPLE PIPE CULVERT WITH FLARED END SECTIONS & FLATTENED ADJACENT SLOPES

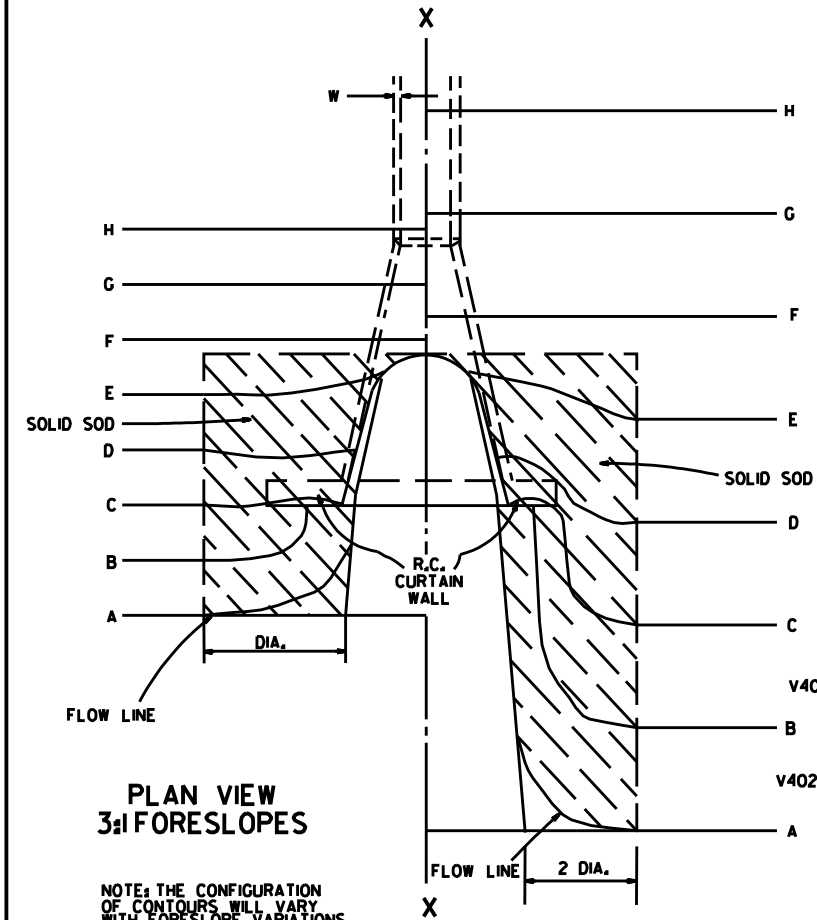


PLAN VIEW 3/4:1 FORESLOPES

PLAN VIEW FLATTENED FORESLOPES

R.C. CURTAIN WALL DIMENSIONS & QUANTITIES


PIPE DIA.	H <sub>1</sub>	L <sub>1</sub>	L	L (DBL.) / 2	SINGLE R.C.P.C.		DOUBLE R.C.P.C.	
					CONC.	REINF. STEEL	CONC.	REINF. STEEL
					CU. YDS.	LBS.	CU. YDS.	LBS.
18"	11 1/2"	3'-5"	8'-0"	6'-3"	0.31	27.7	0.45	39.5
24"	1'-0 1/2"	4'-6"	9'-6"	7'-6"	0.37	33.4	0.53	48.0
30"	1'-3 1/2"	5'-7"	11'-0"	9'-0"	0.45	39.0	0.67	59.0
36"	1'-7"	6'-8"	13'-0"	10'-6"	0.58	52.6	0.83	73.9
42"	2'-1 1/2"	7'-3"	15'-6"	12'-0"	0.82	77.1	1.10	100.7
48"	2'-5"	7'-10"	17'-0"	13'-0"	0.98	94.9	1.27	120.4
54"	2'-9 1/2"	8'-5"	18'-6"	14'-0"	1.16	115.8	1.47	143.7
60"	3'-4"	9'-0"	20'-6"	15'-6"	1.47	149.7	1.84	180.3
72"	4'-5"	10'-2"	25'-6"	18'-6"	2.31	232.6	2.73	271.0

NOTE: QUANTITIES SHOWN ARE FOR ONE (1) CURTAIN WALL.

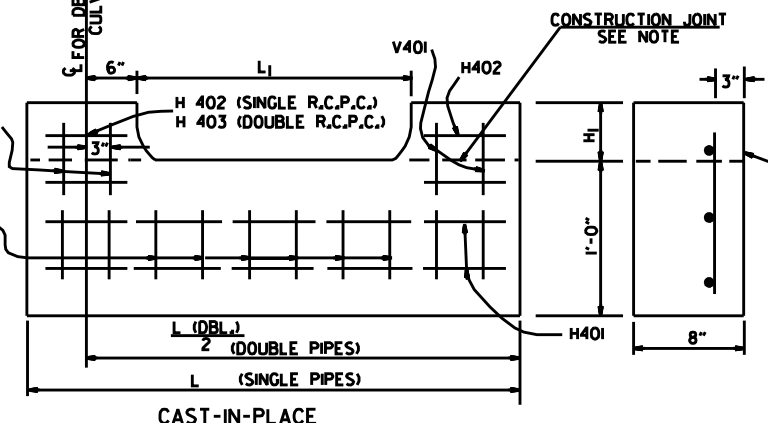

NOTE: THE PORTION OF THE R.C. CURTAIN WALL BENEATH THE FLARED END SECTION (LOWER 1'-0") SHALL BE PLACED MONOLITHICALLY. THE FLARED END SECTION SHALL THEN BE SET IN PLACE & THE REMAINING PORTIONS OF THE R.C. CURTAIN WALL PLACED.

R.C. CURTAIN WALL DETAILS

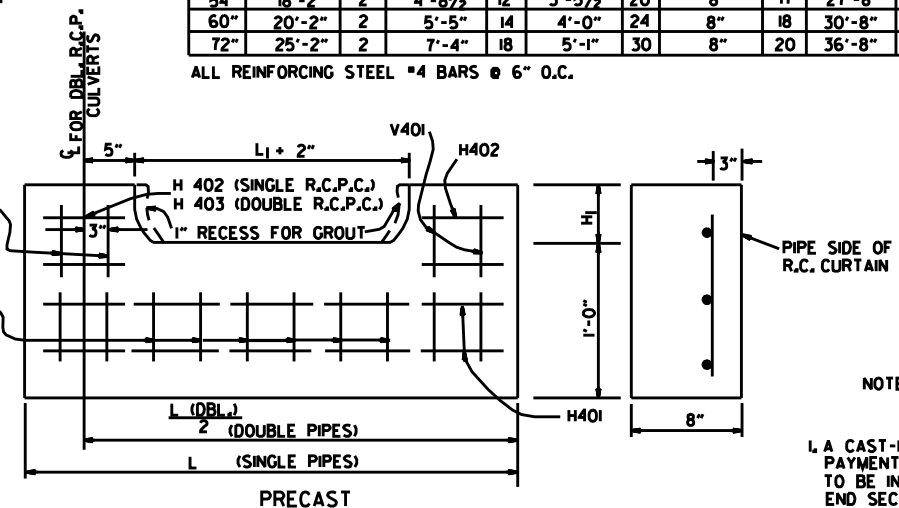

NOTE: THE PRECAST CURTAIN WALL WILL BE SET AND BACKFILLED WITH COMPACTED MATERIAL. THE FLARED END SECTION SHALL THEN BE SET IN PLACE AND THE 1" RECESS FILLED WITH GROUT. WHERE "L" EXCEEDS 11' THE CURTAIN WALL MAY BE CAST IN TWO (2) OR MORE SECTIONS. THE METHOD OF JOINING THE SECTIONS FOR INSTALLATION SHALL BE APPROVED BY THE ENGINEER.

REINFORCING STEEL SCHEDULE

PIPE DIA.	SINGLE R.C. PIPE CULVERT								DOUBLE R.C. PIPE CULVERT									
	H401		H402		V401		V402		H401		H402		H403		V401		V402	
	L	NO.	L	NO.	L	NO.	L	NO.	L	NO.	L	NO.	L	NO.	L	NO.	L	NO.
18"	7'-8"	2	1'-11 1/2"	4	1'-7 1/2"	8	8"	8	12'-2"	2	1'-11 1/2"	4	8"	2	1'-7 1/2"	10	8"	14
24"	9'-2"	2	2'-2"	4	1'-8 1/2"	10	8"	9	14'-8"	2	2'-2"	4	8"	2	1'-8 1/2"	12	8"	18
30"	10'-8"	2	2'-4 1/2"	4	1'-11 1/2"	10	8"	12	17'-8"	2	2'-4 1/2"	4	8"	2	1'-11 1/2"	14	8"	22
36"	12'-8"	2	2'-10"	6	2'-3"	12	8"	14	20'-8"	2	2'-10"	6	8"	3	2'-3"	14	8"	28
42"	15'-2"	2	3'-9 1/2"	8	2'-9 1/2"	16	8"	15	23'-8"	2	3'-9 1/2"	8	8"	4	2'-9 1/2"	18	8"	30
48"	16'-8"	2	4'-3"	10	3'-1"	18	8"	16	25'-8"	2	4'-3"	10	8"	5	3'-1"	20	8"	32
54"	18'-2"	2	4'-8 1/2"	12	3'-5 1/2"	20	8"	17	27'-8"	2	4'-9"	12	8"	6	3'-5 1/2"	22	8"	34
60"	20'-2"	2	5'-5"	14	4'-0"	24	8"	18	30'-8"	2	5'-5"	14	8"	7	4'-0"	26	8"	36
72"	25'-2"	2	7'-4"	18	5'-1"	30	8"	20	36'-8"	2	7'-4"	18	8"	9	5'-1"	33	8"	40

ALL REINFORCING STEEL #4 BARS @ 6" O.C.


SOLID SODDING

PIPE DIA.	SINGLE R.C.P.C.						DOUBLE R.C.P.C.					
	3:1		4:1		6:1		3:1		4:1		6:1	
	SO. YDS.						SO. YDS.					
18"	5	7	12	6	8	13	5	7	12	6	8	13
24"	8	12	19	9	13	20	8	12	19	9	13	20
30"	13	18	29	14	19	30	13	18	29	14	19	30
36"	17	26	41	18	28	43	17	26	41	18	28	43
42"	23	35	55	25	37	57	23	35	55	25	37	57
48"	29	46	68	31	48	70	29	46	68	31	48	70
54"	35	57	85	37	59	87	35	57	85	37	59	87
60"	45	62	104	48	65	107	45	62	104	48	65	107
72"	64	92	156	67	95	159	64	92	156	67	95	159

NOTE: QUANTITIES SHOWN ABOVE ARE FOR ONE (1) END OF F.E.S.

GENERAL NOTES

- A CAST-IN-PLACE OR PRECAST CURTAIN WALL MAY BE USED. PAYMENT FOR THE CURTAIN WALL SHALL BE CONSIDERED TO BE INCLUDED IN THE UNIT PRICE BID EACH FOR FLARED END SECTIONS OF THE SEVERAL SIZES, WHICH PRICE SHALL BE FULL COMPENSATION FOR FURNISHING ALL MATERIALS INCLUDING REINFORCING STEEL AND CONCRETE; FOR FORMS, MIXING AND PLACING; FOR EXCAVATION AND BACKFILL, AND FOR ALL LABOR, TOOLS, EQUIPMENT AND INCIDENTALS NECESSARY TO COMPLETE THE WORK.
- ALL EXPOSED EDGES SHALL BE CHAMFERED 3/4".
- CONCRETE FOR CURTAIN WALL SHALL MEET THE REQUIREMENTS FOR CLASS A OR S CONCRETE AS PROVIDED IN SECTION 802 OF THE STANDARD SPECIFICATIONS OR FOR PAVING CONCRETE AS PROVIDED IN SECTION 501 OF THE STANDARD SPECIFICATIONS.
- WELDED WIRE MESH 3 x 3 W/10 x W/10 MAY BE USED IN LIEU OF REINFORCING BARS.

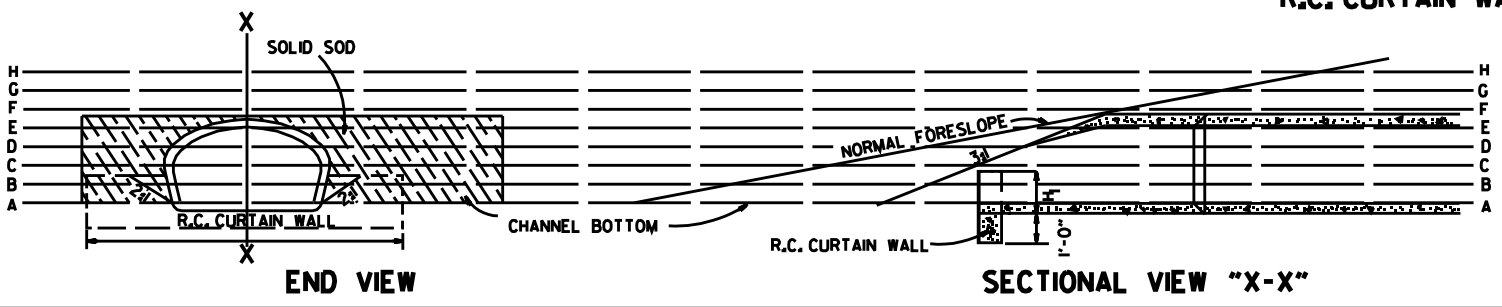


END VIEW

SECTIONAL VIEW "X-X"

10-18-98	ADDED NOTE TO SOLID SODDING		ARKANSAS STATE HIGHWAY COMMISSION
10-12-95	CORRECTED SPELLING		
11-3-94	ADDED GENERAL NOTE NO. 4		
8-15-91	REV. CURTAIN WALL QUANT., STEEL SCH. & SOLID SOD QUANT.		
3-2-81	ALLOW PRECAST IN 2 OR MORE PIECES CHAMFER EDGES		
5-15-80	ADDED PRECAST WALL & GENERAL NOTES		
10-2-72	REVISED AND REDRAWN		
DATE	REVISION	FILMED	STANDARD DRAWING FES-1




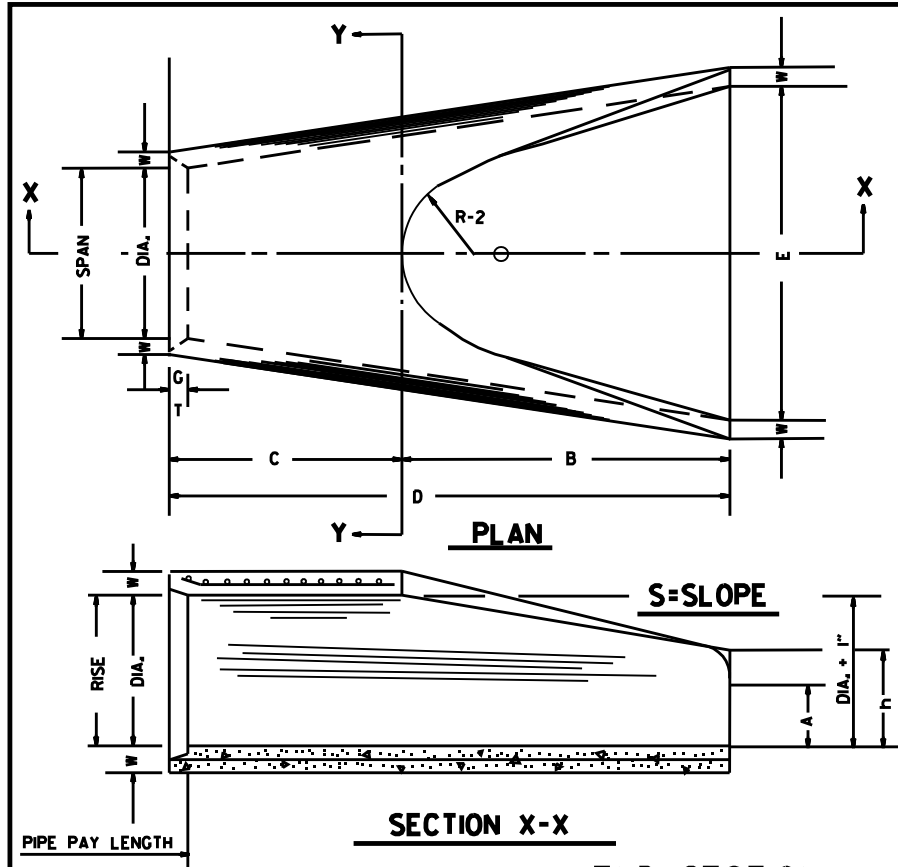

**END SECTION FOR REINFORCED CONCRETE PIPE CULVERTS**

**TABLE OF DIMENSIONS**

DIA.	WALL	A	B	C	D	E	S	DIA. + 1"	P	R-1	R-2	G-T	WT.	h
18"	2 1/2"	9"	2'-3"	3'-10"	6'-1"	3'-0"	3#	19"	29"	15 1/2"	12"	2"	1000	1'-0 1/2"
24"	3"	9 1/2"	3'-7 1/2"	2'-6"	6'-1 1/2"	4'-0"	3#	25"	33 3/8"	16 3/8"	14"	2 1/2"	1600	1'-1 1/2"
30"	3 1/2"	1'-0"	4'-6"	1'-7 1/2"	6'-1 3/4"	5'-0"	3#	31"	37"	18 1/2"	15"	3 1/4"	1940	1'-4 5/8"
36"	4"	1'-3"	5'-3"	2'-10 1/4"	8'-1 1/2"	6'-0"	3#	37"	47 1/8"	24 1/8"	20"	3 1/2"	4100	1'-8"
42"	4 1/2"	1'-9"	5'-3"	2'-11"	8'-2"	6'-6"	3#	43"	53 1/2"	27 1/2"	22"	3 1/2"	5380	2'-2 1/2"
48"	5"	2'-0"	6'-0"	2'-2"	8'-2"	7'-0"	3#	49"	56 1/2"	28 1/2"	22"	3 1/2"	6550	2'-6"
54"	5 1/2"	2'-4"	6'-6"	1'-10"	8'-4"	7'-6"	3#	55"	65 1/2"	33 1/8"	24"	4"	8750	2'-10 1/2"
60"	6"	2'-10"	6'-6"	1'-10"	8'-4"	8'-0"	3#	61"	72 1/2"	36 3/8"	24"	4"	9270	3'-5"
72"	7"	3'-10"	6'-6"	1'-10"	8'-4"	9'-0"	3#	73"	77 1/8"	38 3/8"	24"	5"	13250	4'-6"

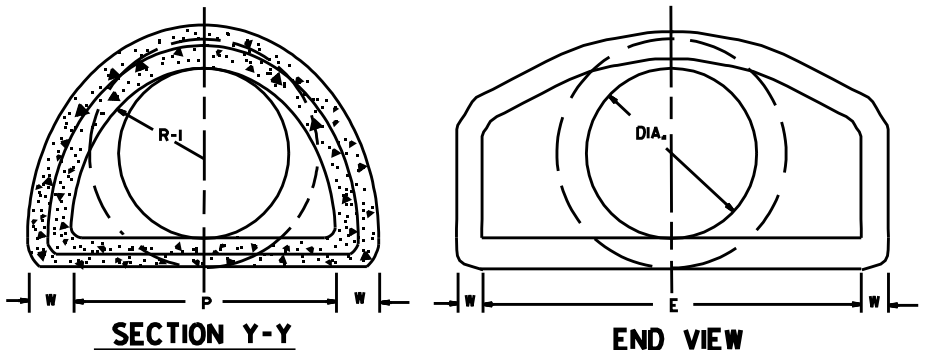


NOTE: TONGUE END ON UPSTREAM SECTION  
GROOVE END ON DOWNSTREAM SECTION


**ARCH PIPE**

EQUIV. DIA.	SPAN		RISE		W	A	B	C	D	E	P	R2	G-T	S
	AASHTO M 206	AHD NOMINAL	AASHTO M 206	AHD NOMINAL										
15	18	18	11	11	2"	4"	2'-0"	4'-0"	6'-0"	3'-0"	29"	12"	1 1/2"	2 1/2#
18	22	22	13 1/2	14	2 1/2"	5"	2'-0"	4'-1"	6'-1"	3'-6"	32 1/8"	13"	2 1/2"	2 1/2#
21	26	26	15 1/2	16	2 3/4"	7"	2'-3"	3'-10"	6'-1"	4'-0"	34 1/8"	14"	2 1/2"	2 1/2#
24	28 1/2	29	18	18	3"	9"	2'-3"	3'-10"	6'-1"	5'-0"	36 3/8"	15"	2 1/2"	2 1/2#
30	36 1/4	36	22 1/2	23	3 1/2"	10"	3'-1"	3'-0 1/2"	6'-1 1/2"	6'-0"	47 1/8"	20"	3"	2 1/2#
36	43 1/4	44	26 1/2	27	4"	10 1/2"	4'-0"	2'-1 1/2"	6'-1 1/2"	6'-6"	54 1/8"	22"	3 1/2"	2 1/2#
42	51 1/8	51	31 1/2	31	4 1/2"	11 1/2"	4'-7"	1'-10 1/4"	6'-5 1/4"	7'-2"	59 1/2"	23"	3 3/4"	2 1/2#
48	58 1/2	59	36	36	5"	1'-3"	5'-3"	2'-10 1/4"	8'-1 1/4"	7'-10"	70 1/8"	24"	4 1/4"	2 1/2#
54	65	65	40	40	5 1/2"	1'-7"	5'-3"	2'-11"	8'-2"	8'-6"	72 1/8"	24"	4 3/4"	2 1/2#
60	73	73	45	45	6"	1'-10"	5'-6"	2'-8"	8'-2"	9'-0"	77 1/8"	24"	5"	2 1/2#

\* THE MEASURED SPAN AND RISE SHALL NOT VARY MORE THAN ± 2 PER CENT FROM THE VALUES SPECIFIED BY AASHTO M 206.

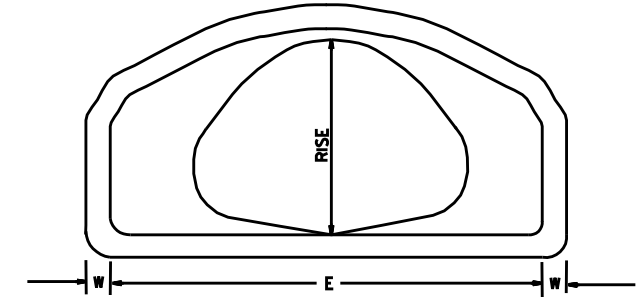

**END VIEW CONCRETE ARCH PIPE**

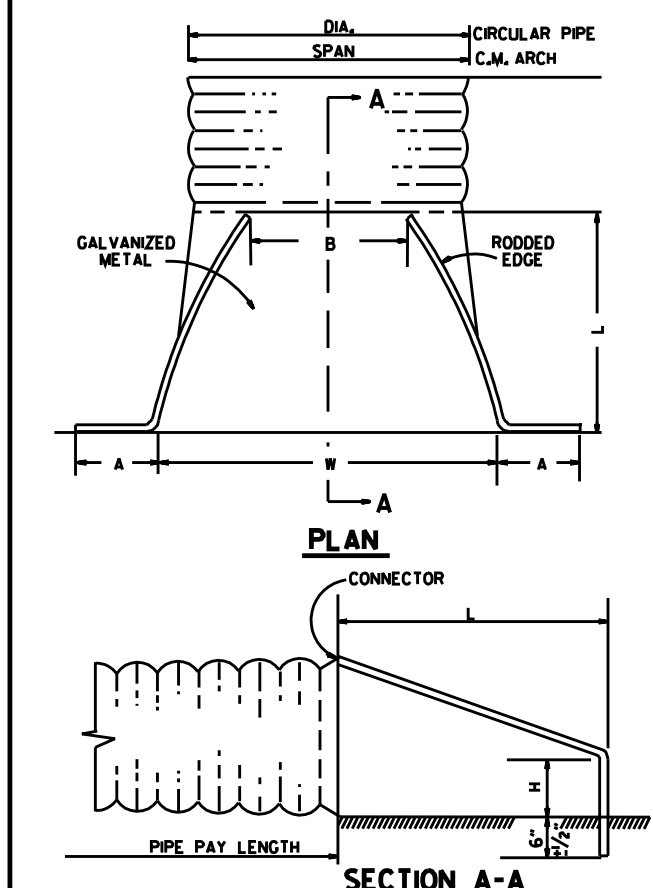


**END SECTIONS FOR CORRUGATED METAL PIPE CULVERTS**

NOTE: ALTERNATE CONNECTIONS TO THE PIPE CULVERTS, IN ACCORDANCE WITH MANUFACTURER'S STANDARD PRACTICES, MAY BE MADE SUBJECT TO THE APPROVAL OF THE ENGINEER.

**CIRCULAR PIPE**


D. DIA.	GAUGE	A	B. MAX.	H	L	W	S
12	16	6	6	6	21	24	2 1/2#
15	16	7	8	6	26	30	2 1/2#
18	16	8	10	6	31	36	2 1/2#
21	16	9	12	6	36	42	2 1/2#
24	16	10	13	6	41	48	2 1/2#
30	14	12	16	8	51	60	2 1/2#
36	14	14	19	9	60	72	2 1/2#
42	12	16	22	11	69	84	2 1/2#
48	12	18	27	12	78	90	2 1/2#
54	12	18	30	12	84	102	2#
60	12	18	33	12	87	114	1 3/4#
66	12	18	36	12	87	120	1 1/2#
72	12	18	39	12	87	126	1 1/3#

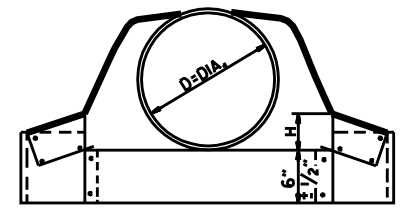


**CIRCULAR PIPE**

**C.M. ARCH PIPE**


EQUIV. DIA.	SPAN	RISE	A	B	H	L	W	S	GAUGE
15"	17	13	7	9	6	19	30	2 1/2#	16
18"	21	15	7	10	6	23	36	2 1/2#	16
21"	24	18	8	12	6	28	42	2 1/2#	16
24"	28	20	9	14	6	32	48	2 1/2#	16
30"	35	24	10	16	6	39	60	2 1/2#	14
36"	42	29	12	18	8	46	75	2 1/2#	14
42"	49	33	13	21	9	53	85	2 1/2#	12
48"	57	38	18	26	12	63	90	2 1/2#	12
54"	64	43	18	30	12	70	102	2 1/2#	12
60"	71	47	18	33	12	77	114	2 1/2#	12

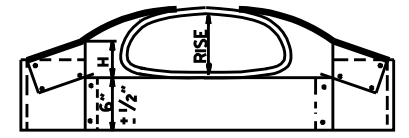

**C.M. ARCH PIPE**


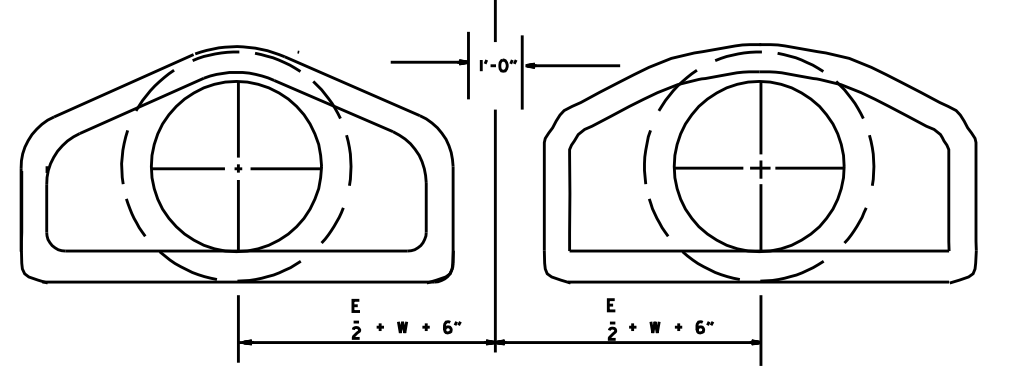


**MULTIPLE R.C. PIPE CULVERTS**

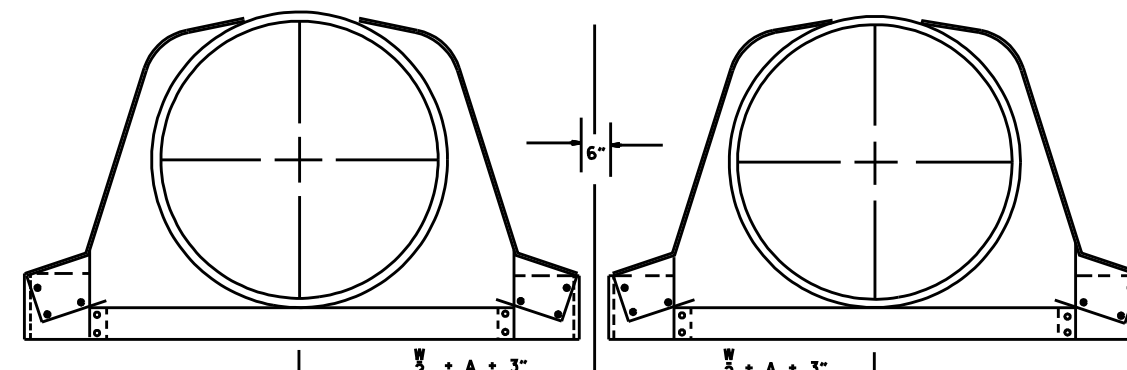


**MULTIPLE C.M. PIPE CULVERTS**

10-18-96	REVISED ASTM REF. TO AASHTO		ARKANSAS STATE HIGHWAY COMMISSION
5-15-80	REVISED DISTANCE BETWEEN MULTIPLE R.C.P. F.E.S.	664-5-15-80	
7-14-78	C.M. ARCH SIZES TO CONFORM WITH AASHTO SIZES	752-7-14-78	
8-22-75	ADDED MULTIPLE PIPE CULVERTS	517-8-22-75	FLARED END SECTION
12-5-74	REMOVED NOTE RE REINF. FOR R.C. F.E.S.	500-12-5-74	
5-24-73	CMP END SECTION, SHOW PIPE PAY LENGTH	627-5-24-73	
10-2-72	REVISED AND REDRAWN	760-10-2-72	STANDARD DRAWING FES-2
DATE	REVISION	FIG. NO.	

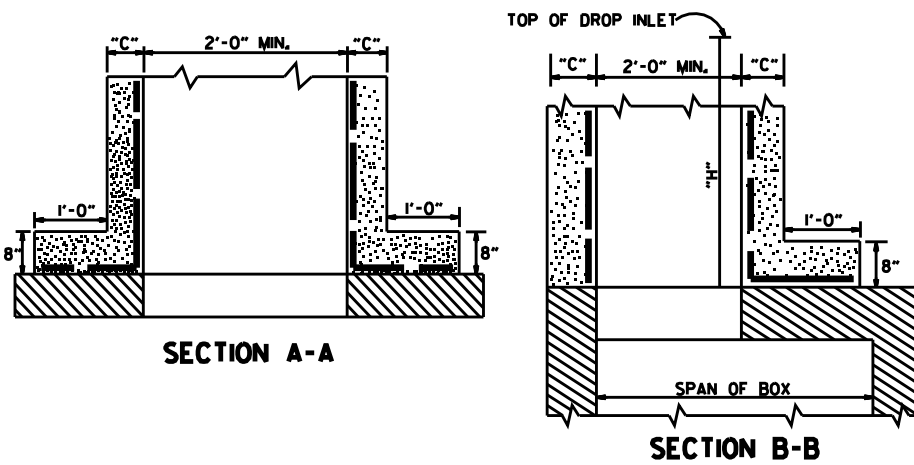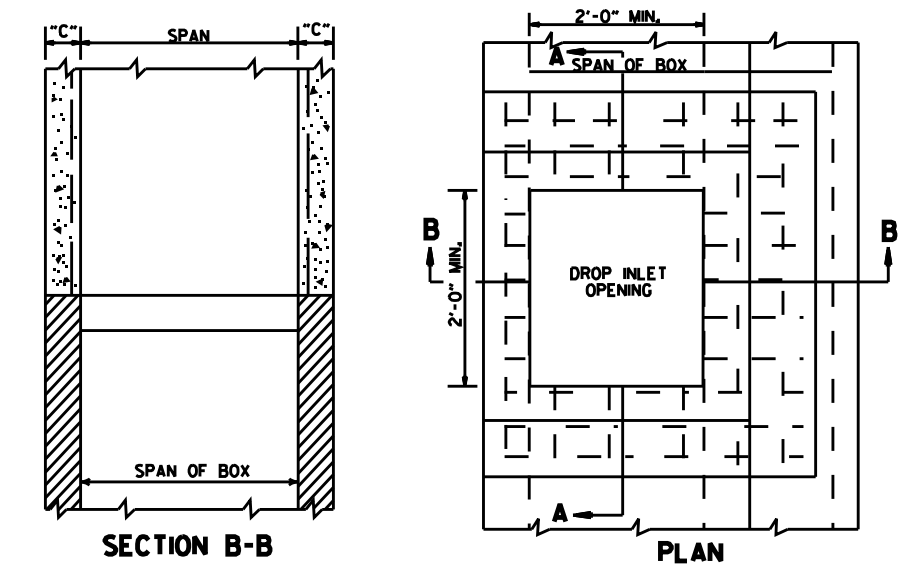


**METHOD OF CONSTRUCTING DROP INLET ON EXISTING R.C. BOX CULVERT**

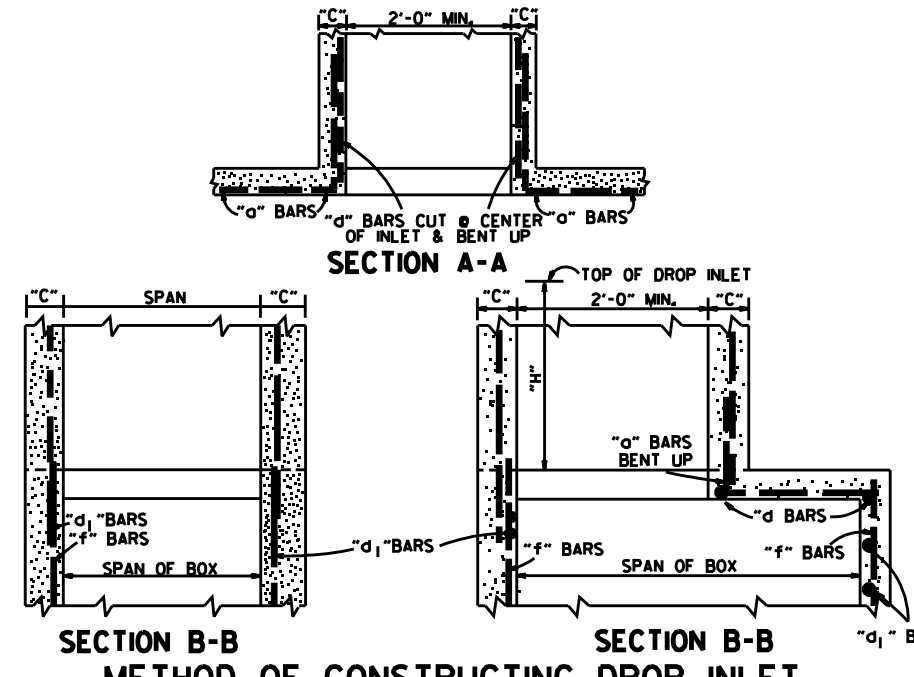


**METHOD OF CONSTRUCTING DROP INLET ON NEW R.C. BOX CULVERT**

NOTE: "C" DIMENSIONS AND REINFORCING BAR SIZES, SHALL CONFORM TO THOSE SHOWN ON STANDARD DRAWING FOR DROP INLET.

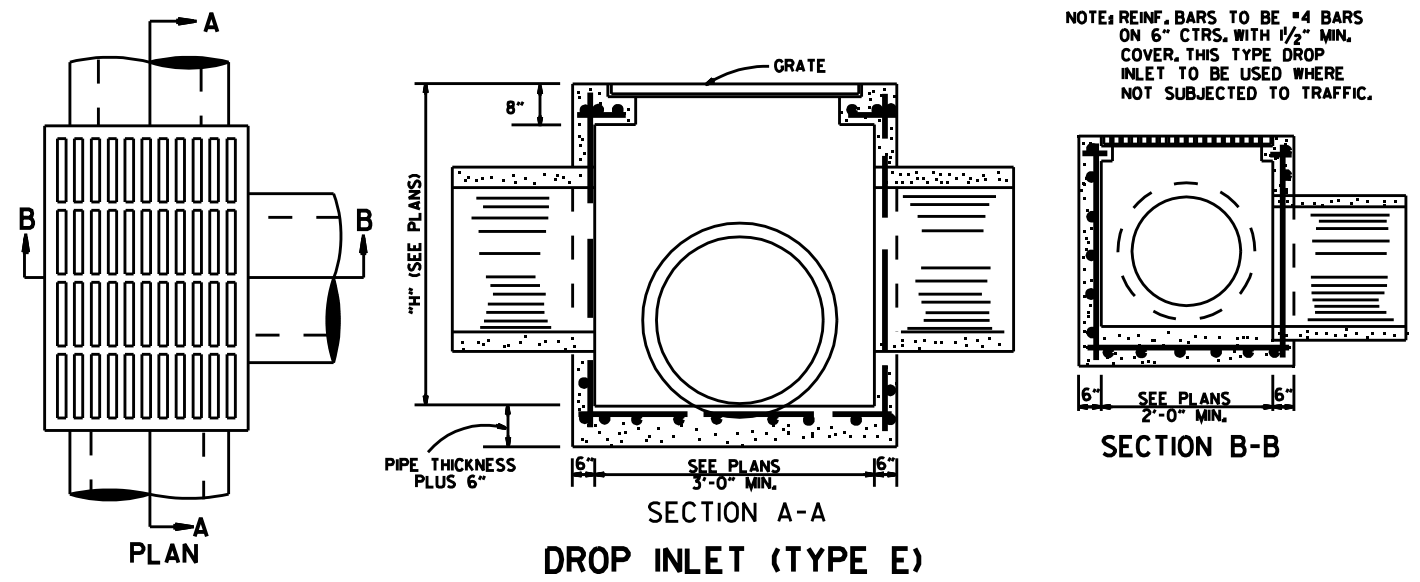


**DROP INLET (TYPE E)**

NOTE: REINF. BARS TO BE #4 BARS ON 6" CTRS. WITH 1/2" MIN. COVER. THIS TYPE DROP INLET TO BE USED WHERE NOT SUBJECTED TO TRAFFIC.

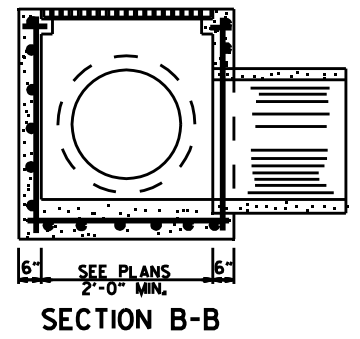


**SECTION B-B**

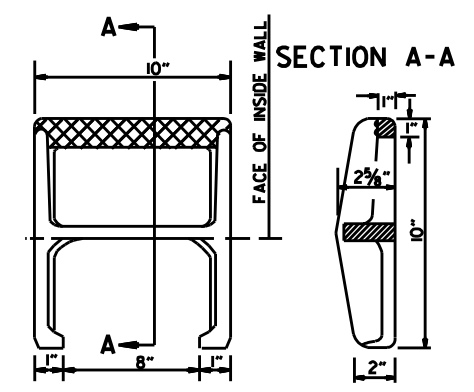


APPROX. WEIGHT = 11 LBS. (CAST IRON)  
**PLAN**  
 NOTE: THIS DETAIL IS TYPICAL. OTHERS MAY BE USED WITH PRIOR APPROVAL OF THE ENGINEER.

**DETAIL OF STEP FOR DROP INLET**

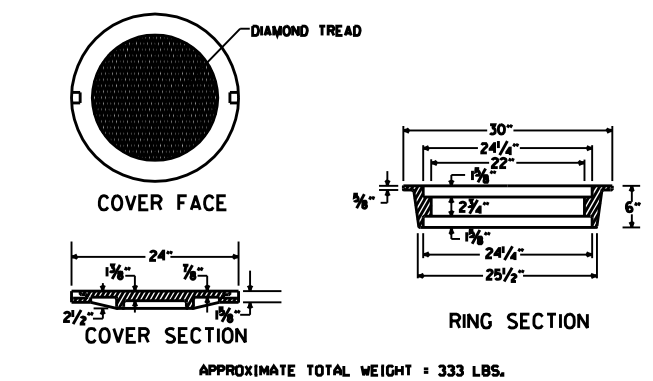


**HEAVY DUTY RING & COVER**

APPROXIMATE TOTAL WEIGHT = 333 LBS.

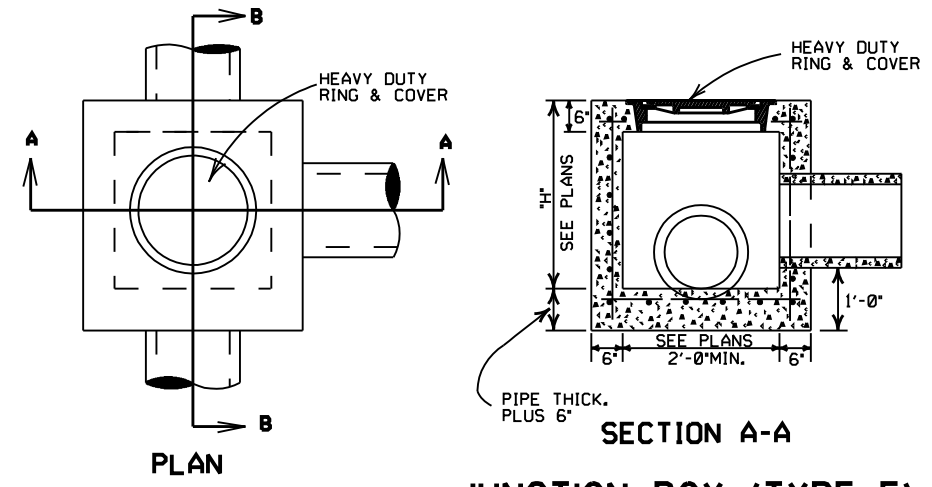


**JUNCTION BOX (TYPE E)**

NOTE: REINF. BARS TO BE #4 BARS ON 6" CTRS. WITH 1/2" MIN. COVER. THIS TYPE JUNCTION BOX TO BE USED WHERE NOT SUBJECTED TO TRAFFIC.

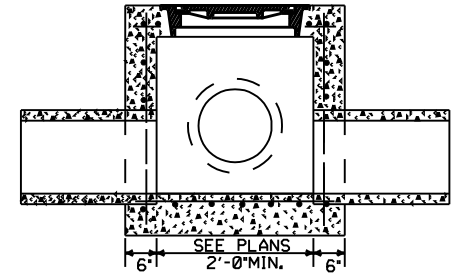


**SECTION B-B**

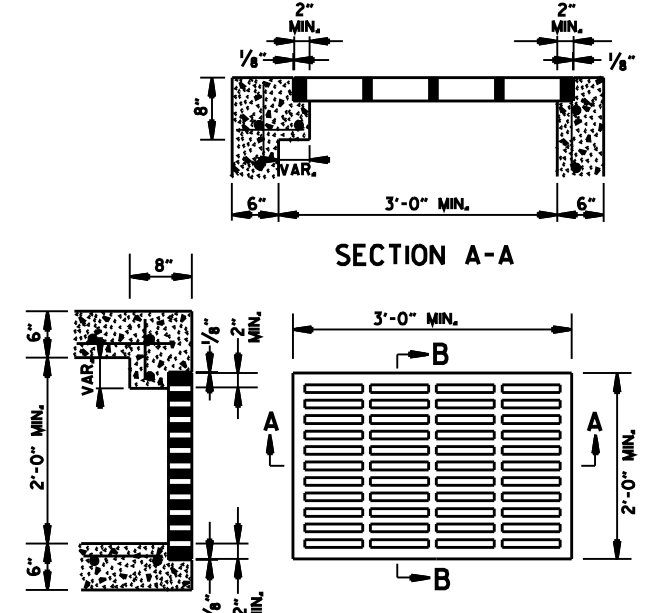

**GRATE FOR TYPE E DROP INLET**

APPROXIMATE MINIMUM WATERWAY OPENING = 260 SQ. IN.


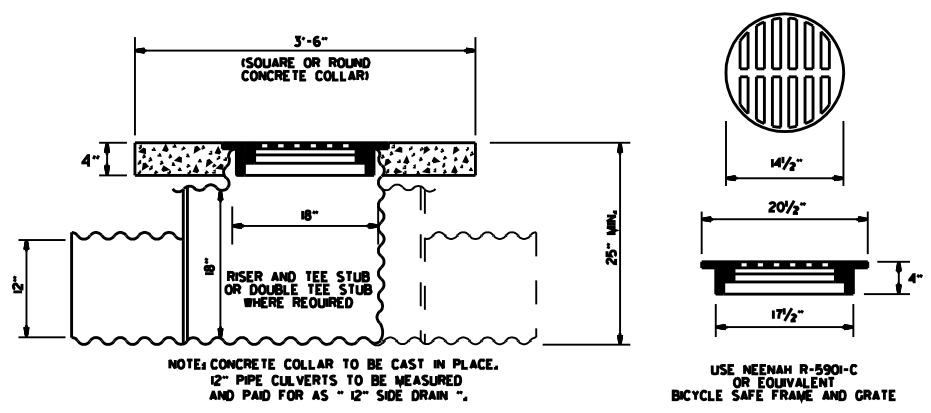


**DETAIL OF YARD DRAIN**

DATE	REV.	REVISION	DATE FILMED
11-16-01		ADDED NOTE 10	
1-12-00		REVISED HEAVY DUTY RING & COVER	
7-02-98		CHANGED GRATE DETAIL, DELETED D (TYPE D), REPLACED RING & COVER W/HEAVY DUTY RING & COVER, ADDED JUNCTION BOX (TYPE E)	
6-26-97		ADDED DIMENSION TO TYPE IV-A	
10-18-96		ADDED DETAIL OF YARD DRAIN	
8-15-91		DELETE TYPE IV GRATE	
7-15-88		REVISED STEP DETAIL	
5-20-83		REVISED DETAILS OF GRATES (TYPE IV & IV-A)	
2-4-83		ADDED GENERAL NOTE NO. 4	
3-2-81		ADDED TYPE IV-A GRATE	
5-22-74		DELETED INLET (TYPE F) & GRATE (TYPE III)	
10-2-72		REVISED AND REDRAWN	

- GENERAL NOTES:**
1. ALL EXPOSED CORNERS SHALL BE 3/4" CHAMFERED.
  2. STEPS SHALL BE INSTALLED ON 16" CENTERS ON ALL INLETS 4'-0" HIGH OR OVER, OR AS APPROVED BY THE ENGINEER.
  3. EXPANSION JOINT MATERIAL SHALL BE 3/4" PREFORMED FIBER.
  4. GRATE OR GRATE AND FRAME SHALL BE CONSTRUCTED OF CAST IRON AND SHALL CONFORM TO THE REQUIREMENTS OF THE STANDARD SPECIFICATIONS FOR GRAY IRON CASTINGS AASHTO M 105 CLASS 35B. GRATE MAY BE USED WITHOUT FRAME.
  5. GRATE AND FRAME SHALL NOT BE PAINTED.
  6. GRATE SHALL BE BICYCLE SAFE.
  7. HEAVY DUTY RING SHALL ALWAYS BE INSTALLED WITH FLANGE ON TOP.
  8. HEAVY DUTY RING AND COVER SHALL BE CONSTRUCTED OF CAST IRON AND SHALL CONFORM TO THE REQUIREMENTS OF THE STANDARD SPECIFICATIONS FOR GRAY IRON CASTINGS AASHTO M105 CLASS 35B & AASHTO M306.
  9. HEAVY DUTY RING AND COVER SHALL NOT BE PAINTED.
  10. DIMENSIONS SHOWN FOR RING AND COVER ARE TYPICAL. THE CONTRACTOR MAY SUBSTITUTE SIMILAR CASTINGS WITH THE APPROVAL OF THE ENGINEER, REQUESTING APPROVAL FOR CASTING DESIGNS MAY BE MADE BY REFERRING TO PREVIOUSLY APPROVED DRAWINGS.

**ARKANSAS STATE HIGHWAY COMMISSION**  
**DETAILS OF DROP INLETS & JUNCTION BOXES**  
**STANDARD DRAWING FPC-9**



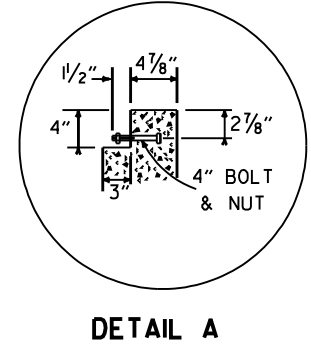
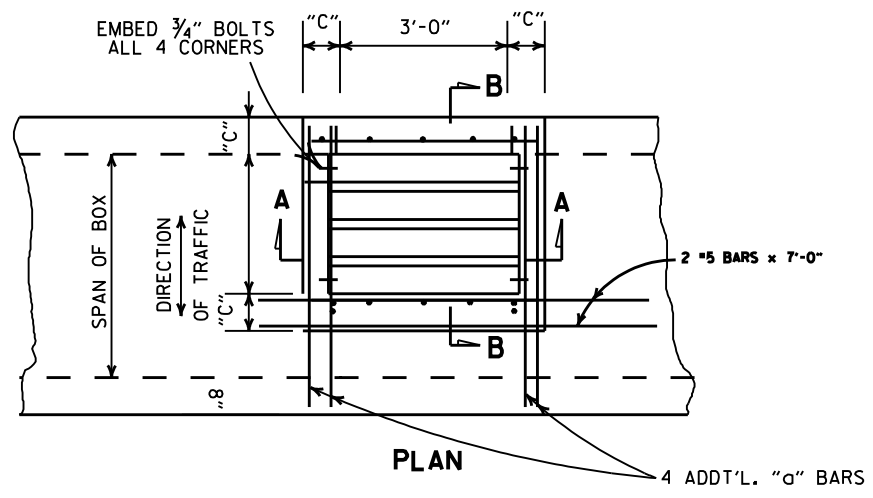


- GENERAL NOTES:**
1. STEEL PIPE FOR GRATES AND BOLTS SHALL CONFORM TO THE REQUIREMENTS OF SECTION 807. BOLTS SHALL CONFORM TO ONE OF THE FOLLOWING: ASTM A193, GRADE B8 CLASS 10R 2, ASTM A307 OR AASHTO M 164.
  2. STEEL PIPE FOR GRATES SHALL BE "STANDARD WEIGHT" PIPE CONFORMING TO ASTM A53 NATIONAL STANDARD PIPE.
  3. BOLTS, NUTS, WASHERS SHALL BE GALVANIZED IN ACCORDANCE WITH AASHTO M 232 OR AASHTO M 298, CLASS 40 OR 50.
  4. ALL EXPOSED CORNERS TO HAVE 3/4" CHAMFER.
  5. ALL #4 AND #5 REINFORCING BARS TO HAVE 1/2" COVER, LARGER SIZES TO HAVE 2" COVER.
  6. THE COMPLETE PIPE GRATE SHALL BE PAINTED IN ACCORDANCE WITH THE STANDARD SPECIFICATIONS.

**TABLE OF "W" DIMENSIONS**




I.D. PIPE	SKEW OF CROSS DRAIN		
	STRAIGHT	30°	45°
24"	4'-0"	4'-0"	4'-0"
30"	4'-0"	4'-0"	4'-5"
36"	4'-0"	4'-3"	5'-3"
42"	4'-3"	4'-11"	6'-1"
48"	4'-10"	5'-7"	6'-11"

NOTE: DIMENSIONS SHOWN ABOVE ARE FOR PIPES INTERSECTING DROP INLET ON ONE SIDE ONLY. FOR SKEWED PIPES INTERSECTING BOTH SIDES OF DROP INLET, "W" WILL NEED TO BE INCREASED OR AXIS OF INTERSECTING PIPES WILL NEED TO BE SHIFTED.

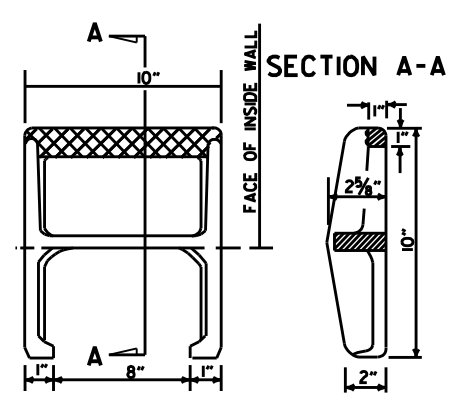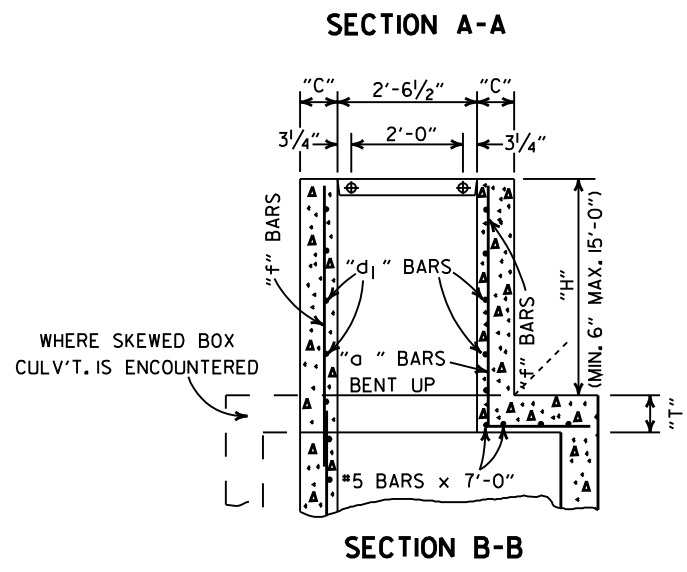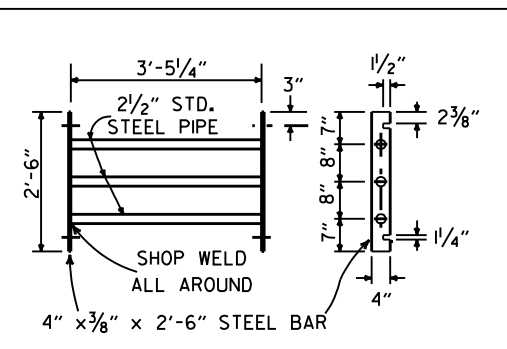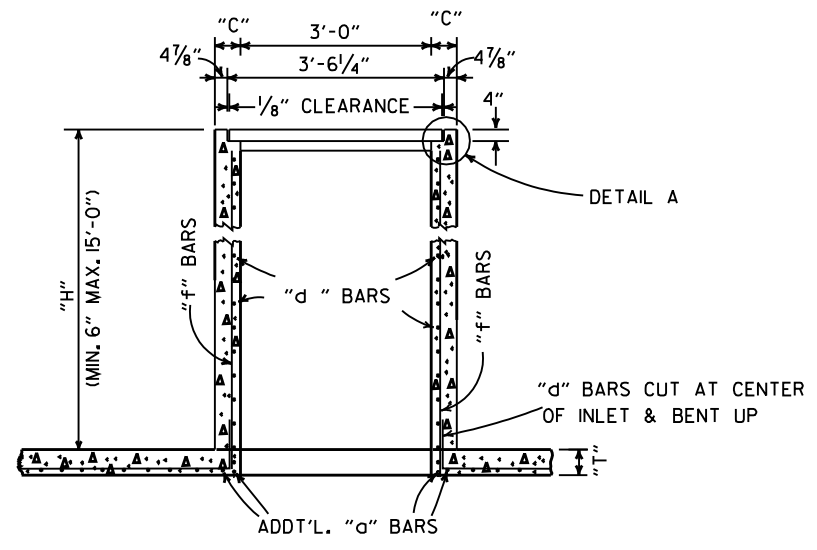

APPROX. WEIGHT = 11 LBS. (CAST IRON)  
 PLAN  
 NOTE: THIS DETAIL IS TYPICAL. OTHERS MAY BE USED WITH PRIOR APPROVAL OF THE ENGINEER.

**DETAIL OF STEP FOR DROP INLET**

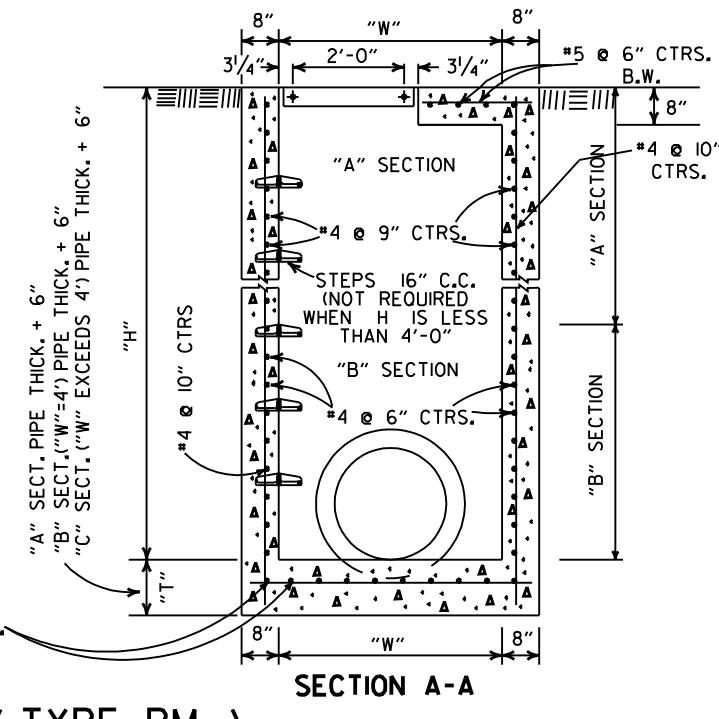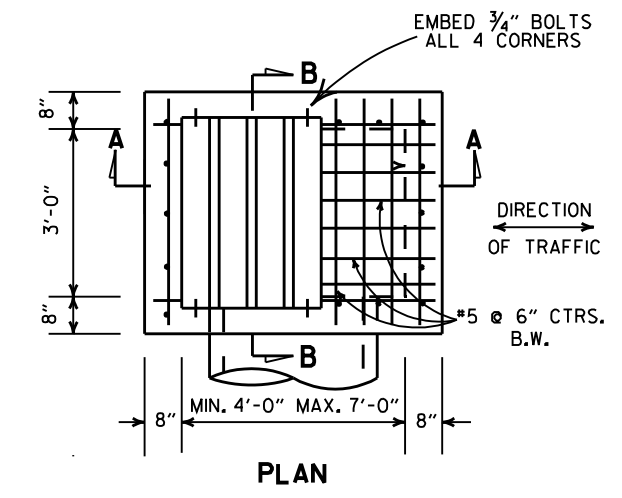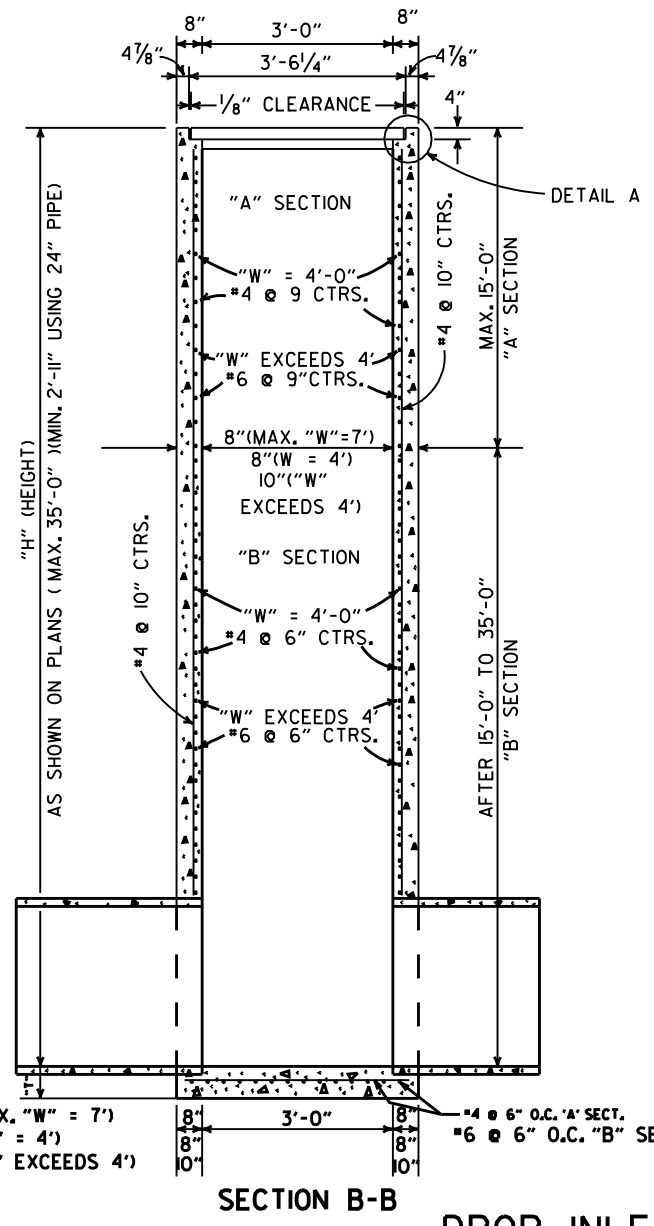

"A" SECT. (MAX. "W" = 7')  
 "B" SECT. ("W" = 4')  
 "C" SECT. ("W" EXCEEDS 4')

**DROP INLET (TYPE RM)**

8-22-02	ADDED & REVISED DIMENSION TO SECTION A-A	
1-12-00	CORRECTED DIMENSION ON SECTION B-B	
11-06-97	ADDED DIMENSION TO SECTION A-A	
10-18-96	REVISED ASTM REF. TO AASHTO AND ADDED NOTE TO TABLE OF "W" DIMENSIONS	
10-1-92	ADDED DIRECTION OF TRAFFIC	10-1-92
8-15-91	ADDED NOTE ABOUT PAINTING OF GRATE	8-15-91
11-30-89	ALTERED DETAIL A	11-30-89
7-15-88	REVISED STEP DETAIL, TM & RM D.I. & GRATE DETAIL	719-7-15-88
10-2-72	REVISED AND REDRAWN	542-10-2-72
REVISED		DATE FILMED

ARKANSAS STATE HIGHWAY COMMISSION

**DETAILS OF DROP INLETS**

STANDARD DRAWING FPC-9D

NOTE: ADD'L. REINF. STEEL TO BE INCLUDED IN UNIT PRICE BID PER TYPE "TM" D.I.




DIMENSIONS & REINF. BARS FOR D.I. TO BE THE SAME AS THOSE SHOWN ON APPLICABLE STD. BARREL DRAWING FOR R.C. BOX CULVERTS.

**DROP INLET TYPE "TM" FOR REINFORCED CONC. BOX CULVERTS**

4'-0" LENGTH DROP INLET DROP INLET EXTENSION




PIPE SIZE	MIN. WIDTH	HEIGHT 5'-0"		PLUS OR MINUS PER LIN. FT. OF HEIGHT		4'-0"		8'-0"	
		CLASS A CONC. CU. YDS.	REINF. STEEL POUNDS	CLASS A CONC. CU. YDS.	REINF. STEEL POUNDS	CLASS A CONC. CU. YDS.	REINF. STEEL POUNDS	CLASS A CONC. CU. YDS.	REINF. STEEL POUNDS
18"	2'-6"	1.77	156	0.28	22				
24"	2'-6"	1.79	156	0.28	22				
30"	3'-2"	2.39	205	0.30	26				
36"	3'-8"	2.63	236	0.32	28				
42"	4'-4"	2.95	250	0.34	30				
48"	4'-10"	3.21	265	0.36	32				
						DEDUCT FROM QUANTITY COMPUTED FOR EACH EXTENSION ADDED.			
						0.04	3		

NOTE: QUANTITIES ARE APPROXIMATE AND ARE SHOWN FOR BIDDER INFORMATION ONLY.

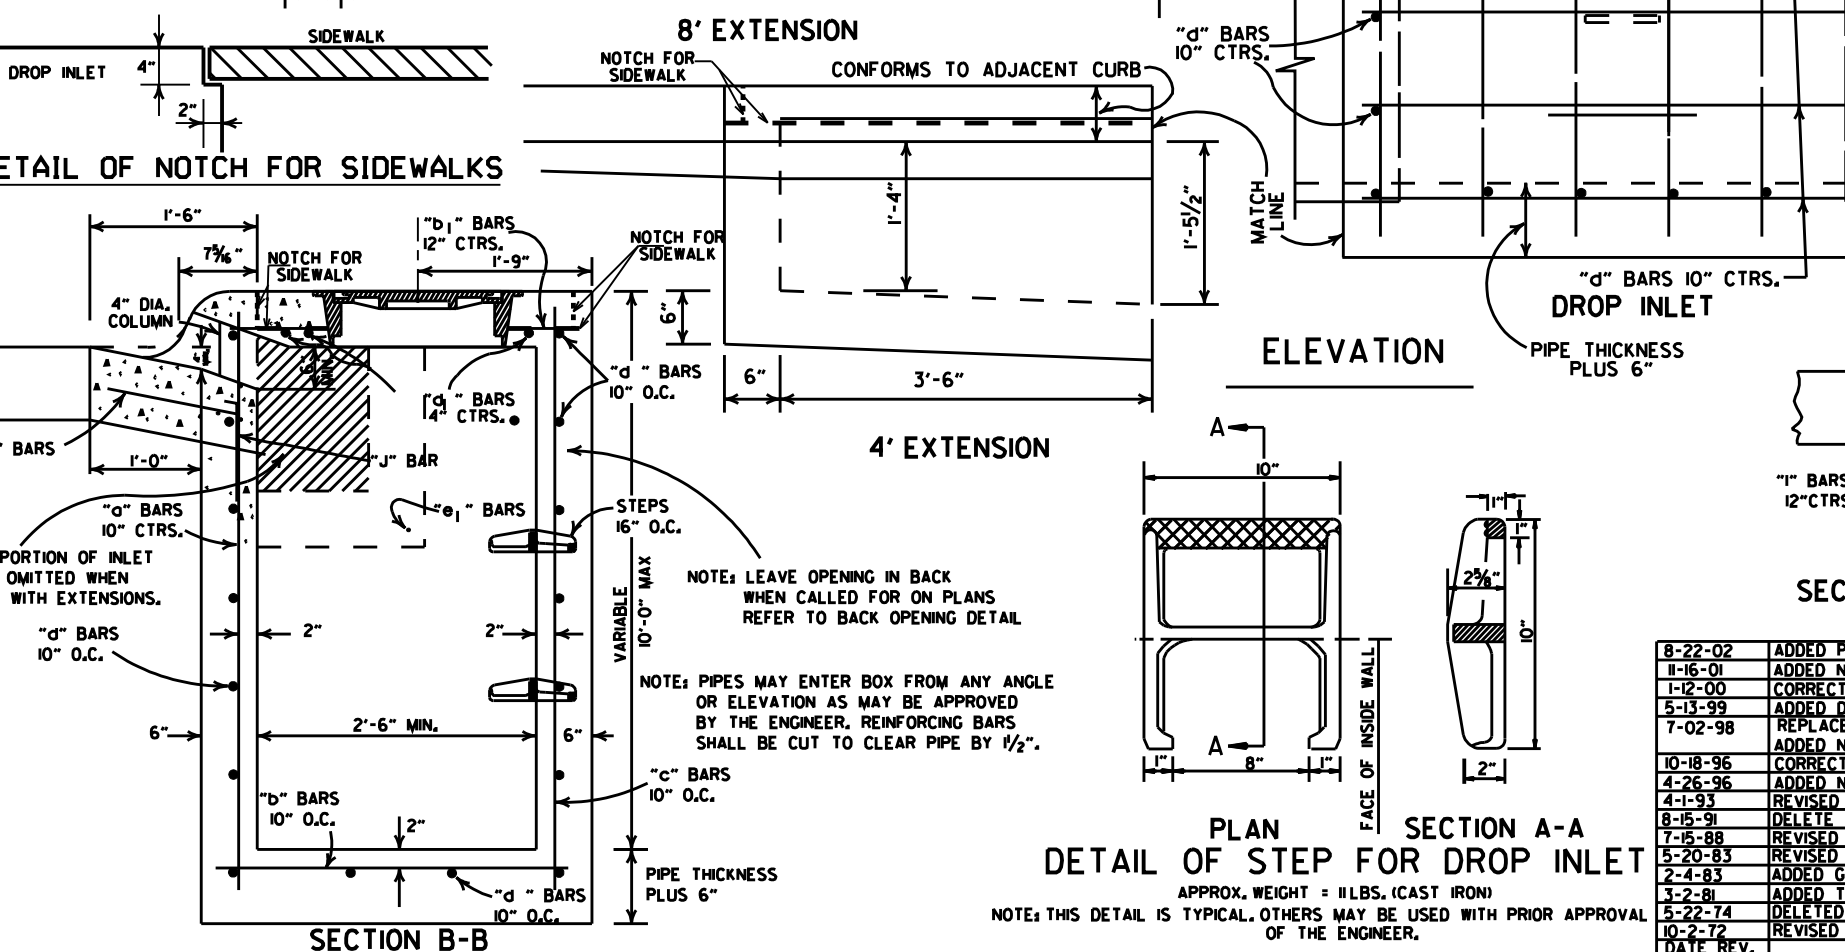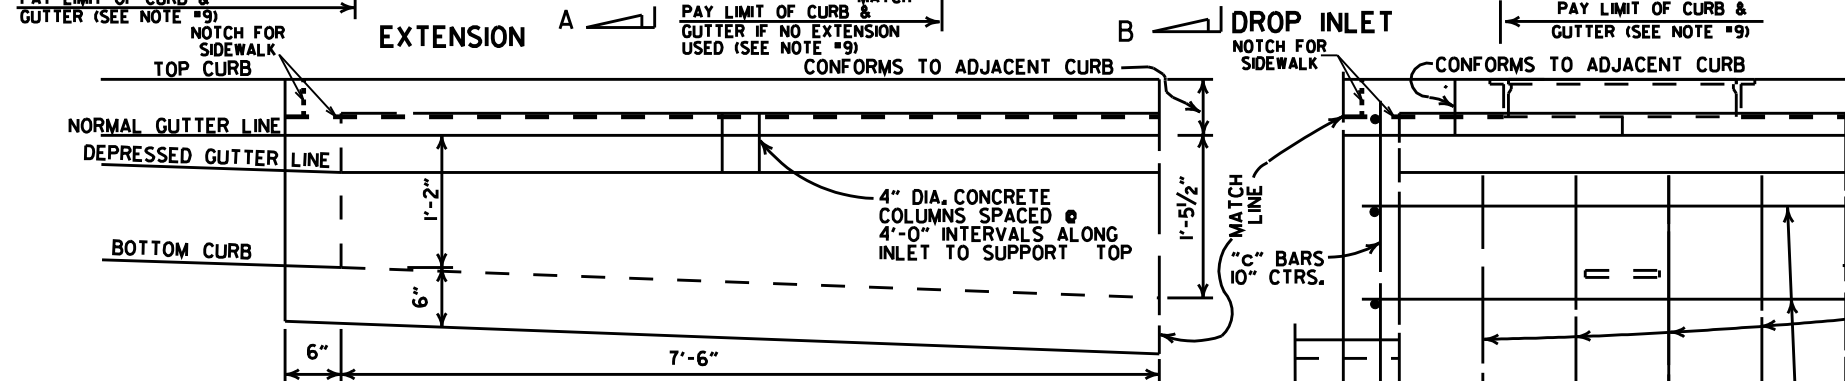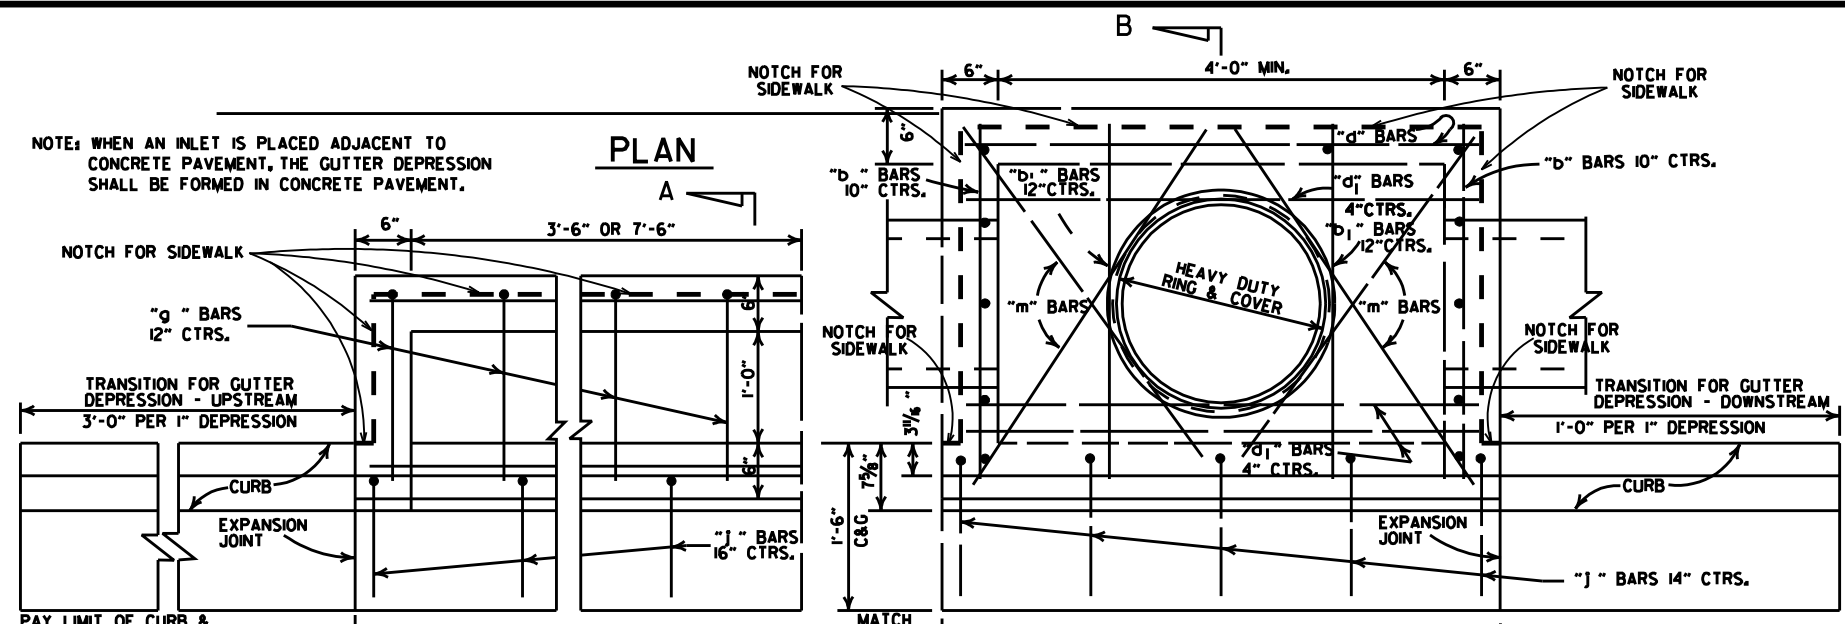

DEDUCT FROM QUANTITY COMPUTED FOR EACH PIPE ENTERING INLET

INSIDE DIA. PIPE INCHES	CLASS CONC. CU. YDS.	REINF. STEEL POUNDS
18	0.05	2
24	0.09	3
30	0.13	4
42	0.24	8

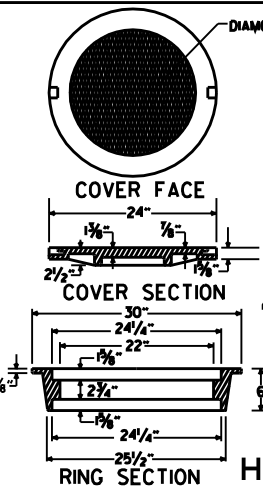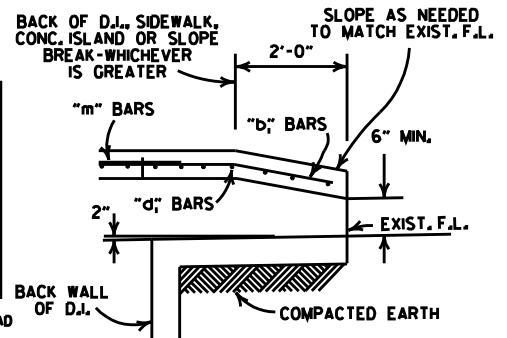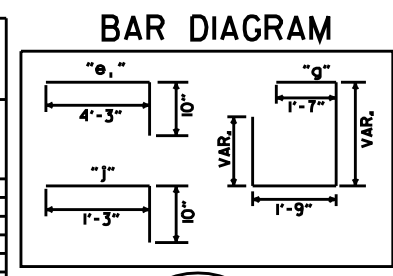

BACK OPENING  
WHEN OPENING IN BACK IS CALLED FOR ON PLANS EXTEND OPENING AS SHOWN IN DETAIL. PAYMENT TO BE INCLUDED IN PRICE BID FOR DROP INLET (TYPE C).

- GENERAL NOTES:
- ALL EXPOSED CORNERS TO HAVE 3/4" CHAMFER.
  - STEPS SHALL BE INSTALLED IN ALL INLETS 4'-0" HIGH AND OVER OF AS APPROVED BY THE ENGINEER.
  - ALL REINF. BARS SHALL BE #4 AND HAVE 1/2" COVER.
  - DROP INLETS AND EXTENSION ON CURVED SECTIONS SHALL CONFORM TO THE CURVATURE OF THE CURB.
  - THIS DROP INLET MAY BE CONSTRUCTED ON NEW OR EXISTING R.C. BOX CULVERT AS SHOWN ON F.P.C.-9.
  - WHEN PLANS CALL FOR DROP INLET OVER 10'-0" HIGH, FLOOR AND WALLS SHALL BE CONSTRUCTED AS SHOWN FOR TYPE "RM" DROP INLET (F.P.C.-9D).
  - HEAVY DUTY RING SHALL ALWAYS BE INSTALLED WITH FLANGE ON TOP.
  - DURING CONSTRUCTION OF THE ROADWAY THE CONTRACTOR SHALL MAINTAIN DRAINAGE INTO OR AROUND THE DROP INLET AS APPROVED BY THE ENGINEER.
  - PAYMENT FOR CURB AND/OR CURB AND GUTTER WITHIN THE LIMITS OF DROP INLETS AND DROP INLET EXTENSIONS SHALL BE CONSIDERED INCLUDED IN PAYMENT MADE FOR DROP INLETS AND/OR DROP INLET EXTENSIONS.
  - HEAVY DUTY RING AND COVER SHALL BE CONSTRUCTED OF CAST IRON AND SHALL CONFORM TO THE REQUIREMENTS OF THE STANDARD SPECIFICATIONS FOR GRAY IRON CASTINGS AASHTO M105 CLASS 35B & AASHTO M306.
  - HEAVY DUTY RING AND COVER SHALL NOT BE PAINTED.
  - 4"x2" NOTCH SHALL BE FORMED IN ALL DROP INLETS TO SUPPORT SIDEWALK CONSTRUCTION. REFER TO DETAIL OF NOTCH FOR SIDEWALKS.
  - DIMENSIONS SHOWN FOR RING AND COVER ARE TYPICAL. THE CONTRACTOR MAY SUBSTITUTE SIMILAR CASTINGS WITH THE APPROVAL OF THE ENGINEER. REQUESTING APPROVAL FOR CASTING DESIGNS MAY BE MADE BY REFERRING TO PREVIOUSLY APPROVED DRAWINGS.







DATE	REV.	REVISION	DATE FILMED
8-22-02		ADDED PAY LIMIT CURB NOTES TO SECTIONS A-A & B-B	
11-16-01		ADDED NOTE 13; REVISED SECTION B-B	
1-12-00		CORRECTED DIMENSION ON SECTION B-B & REVISED RING & COVER	
5-13-99		ADDED DETAIL OF NOTCH FOR SIDEWALKS	
7-02-98		REPLACED RING & COVER W/HEAVY DUTY RING & COVER	
		ADDED NOTES 9, 10, & 11	
10-18-96		CORRECTED SPELLING	
4-26-96		ADDED NOTE 8 & REVISED (4'x8') EXTENSION TITLES	10-18-96
4-1-93		REVISED BACK OPENING & NOTE	
8-15-91		DELETE TYPE IV GRATE	
7-15-88		REVISED STEP DETAIL	
5-20-83		REVISED DETAILS OF GRATES (TYPE IV & IV-A)	
2-4-83		ADDED GENERAL NOTE NO. 4	
3-2-81		ADDED TYPE IV-A GRATE	
5-22-74		DELETED INLET (TYPE F) & GRATE (TYPE III)	
10-2-72		REVISED AND REDRAWN	

ARKANSAS STATE HIGHWAY COMMISSION

DETAILS OF DROP INLETS  
(TYPE C)


STANDARD DRAWING FPC-9E

PLAN SECTION A-A  
DETAIL OF STEP FOR DROP INLET  
APPROX. WEIGHT = 11 LBS. (CAST IRON)  
NOTE: THIS DETAIL IS TYPICAL. OTHERS MAY BE USED WITH PRIOR APPROVAL OF THE ENGINEER.

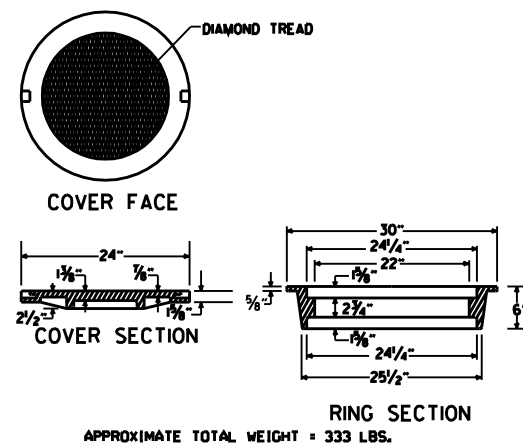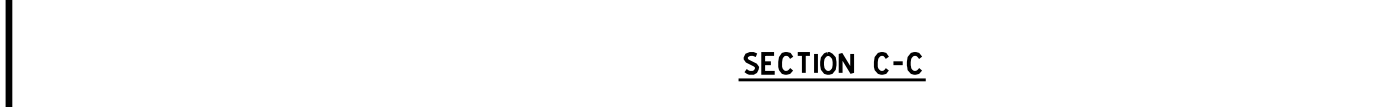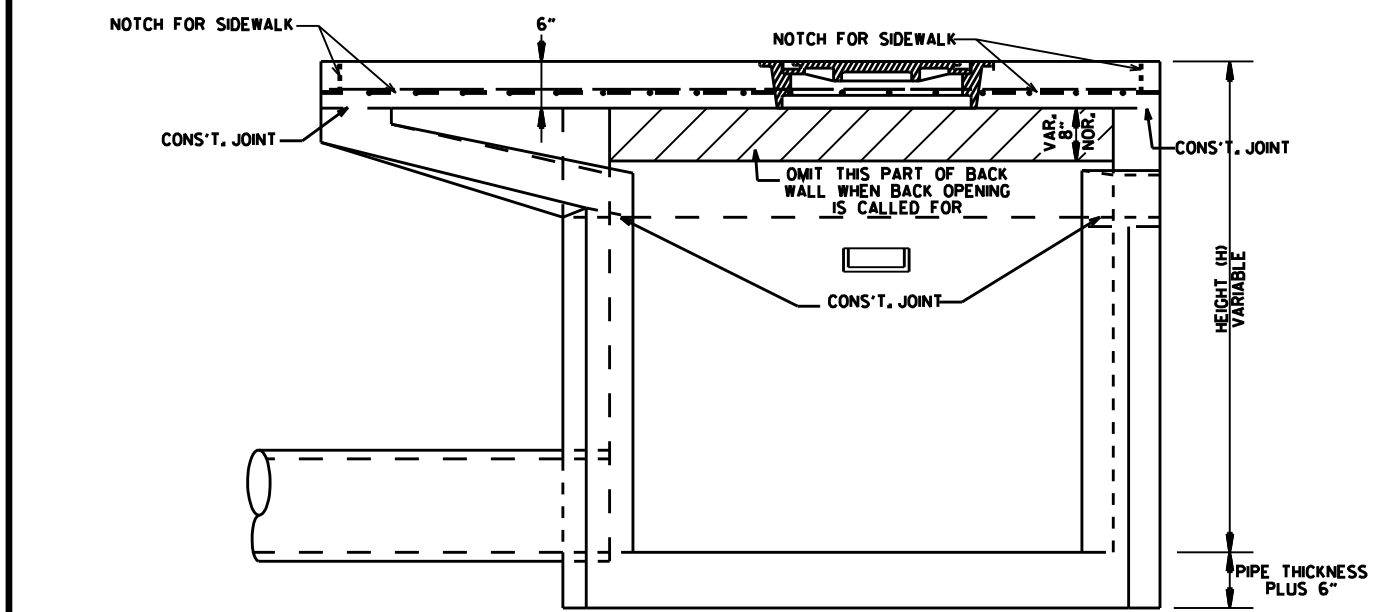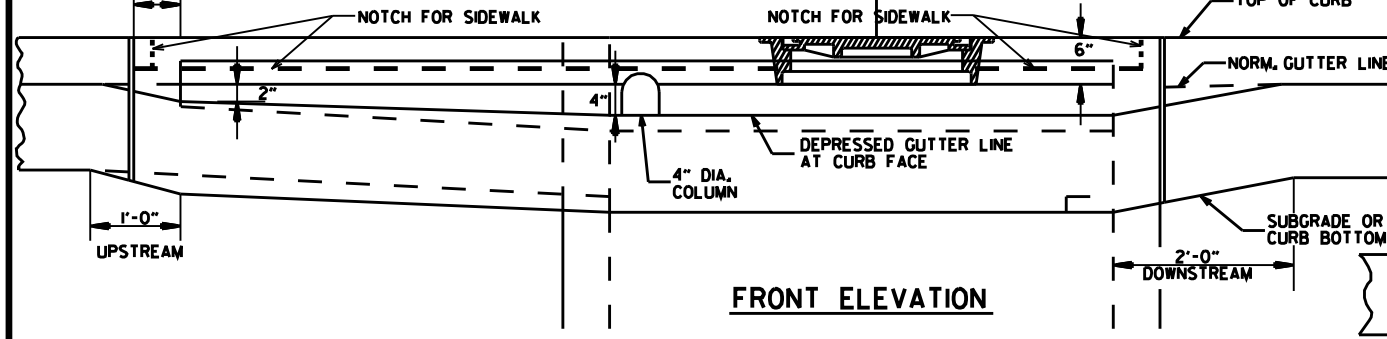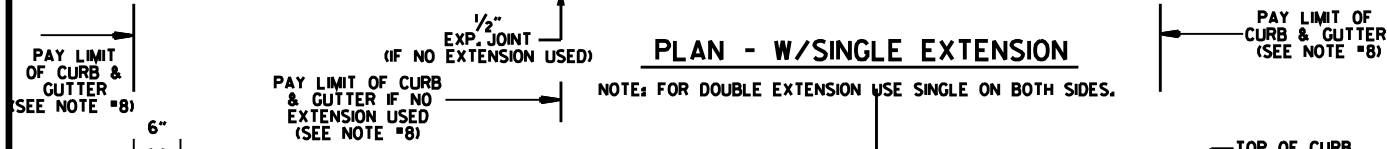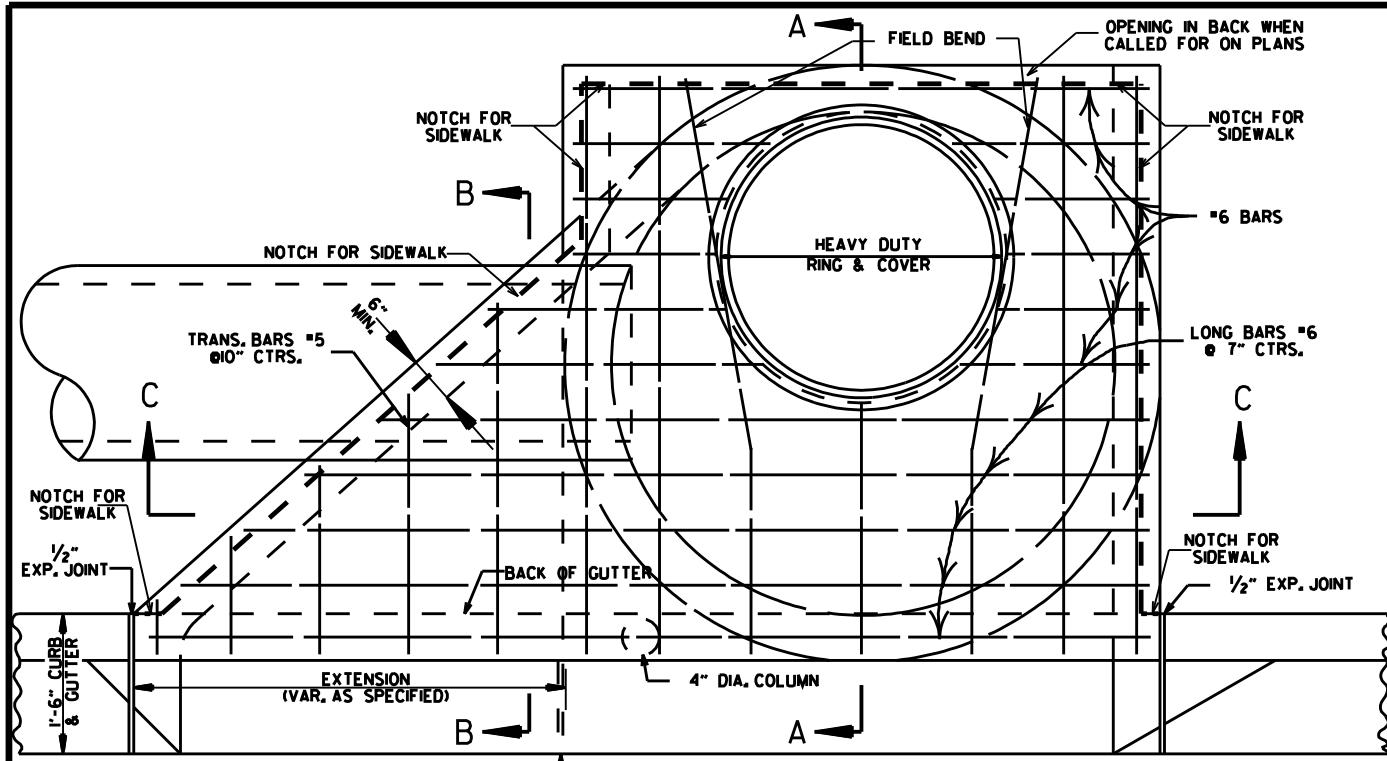


**HEAVY DUTY RING & COVER**


1. HEAVY DUTY RING AND COVER SHALL BE CONSTRUCTED OF CAST IRON AND SHALL CONFORM TO THE REQUIREMENTS OF THE STANDARD SPECIFICATIONS FOR GRAY IRON CASTINGS AASHTO M105 CLASS 35B & AASHTO M306.
2. HEAVY DUTY RING AND COVER SHALL NOT BE PAINTED.
3. HEAVY DUTY RING SHALL ALWAYS BE INSTALLED WITH FLANGE ON TOP.

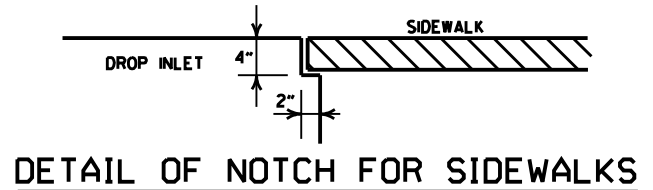


**DETAIL OF NOTCH FOR SIDEWALKS**

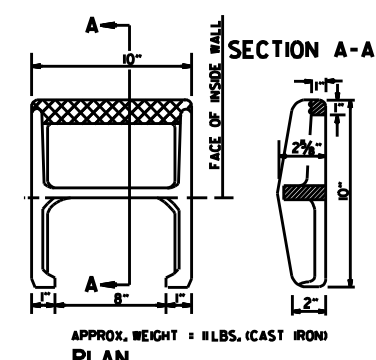


**DETAIL OF STEP FOR DROP INLET**

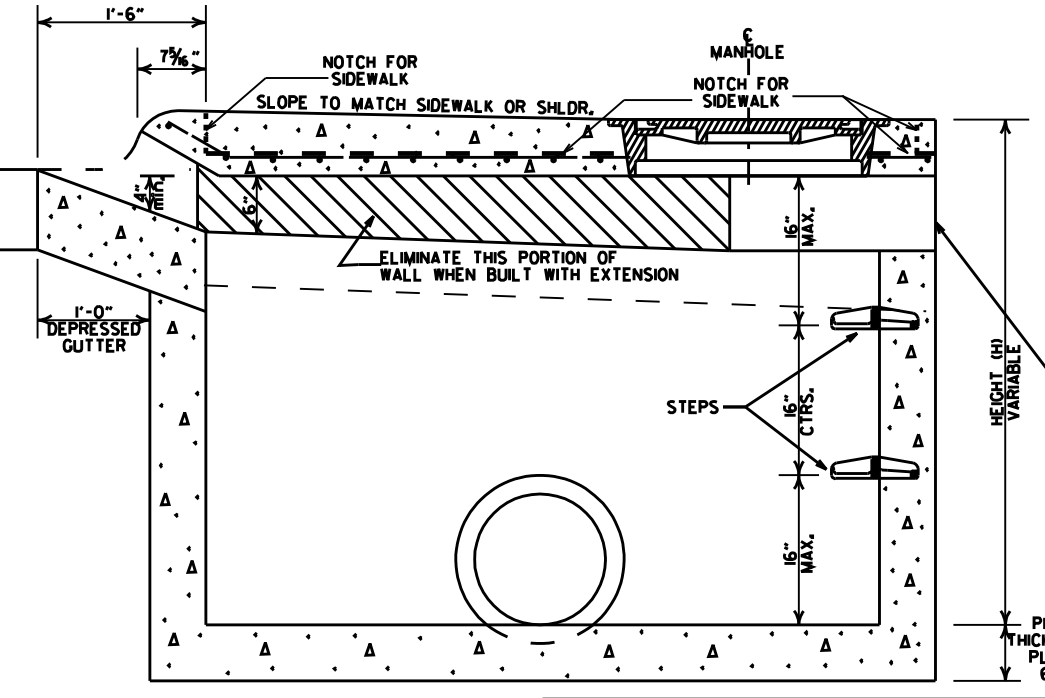

**SECTION A-A**

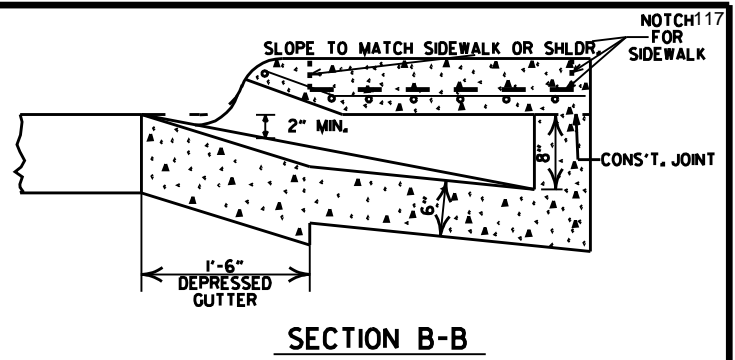

**SECTION B-B**

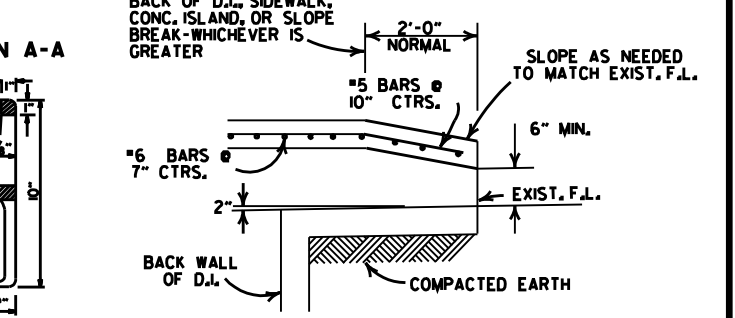

**BACK OPENING**

WHEN OPENING IN BACK IS CALLED FOR ON PLANS EXTEND OPENING AS SHOWN IN DETAIL. PAYMENT TO BE INCLUDED IN PRICE BID FOR DROP INLET (TYPE MO).

- GENERAL NOTES:
1. ALL EXPOSED CORNERS TO HAVE 3/4" CHAMFER.
  2. STEPS SHALL BE INSTALLED IN ALL INLETS 4'-0" HIGH AND OVER OR AS DIRECTED BY THE ENGINEER.
  3. ALL REINFORCING BARS SHALL BE GRADE 60 AND HAVE MIN. 1/2" COVER.
  4. DROP INLETS AND EXTENSION ON CURVED SECTIONS SHALL CONFORM TO THE CURVATURE OF THE CURB.
  5. 4" DIA. COLUMNS SPACED AT MAX. 4'-0" INTERVALS SHALL BE INSTALLED ALONG INLET AND EXTENSION TO SUPPORT TOP.
  6. BASE AND INLET WALLS SHALL BE CAST MONOLITHICALLY.
  7. THE THROAT SHALL BE CAST INTEGRALLY WITH THE GUTTER.
  8. PAYMENT FOR CURB AND/OR CURB AND GUTTER WITHIN THE LIMITS OF DROP INLETS AND DROP INLET EXTENSIONS SHALL BE CONSIDERED INCLUDED IN PAYMENT MADE FOR DROP INLETS AND/OR DROP INLET EXTENSIONS.
  9. PIPES MAY ENTER DROP INLET FROM ANY ANGLE OR ELEVATION AS MAY BE APPROVED BY THE ENGINEER.
  10. APPROPRIATE SIZE TYPE C DROP INLETS MAY BE SUBSTITUTED FOR TYPE MO DROP INLETS AS APPROVED BY THE ENGINEER. PAYMENT TO BE AS DROP INLET (TYPE MO).
  11. DURING CONSTRUCTION OF THE ROADWAY THE CONTRACTOR SHALL MAINTAIN DRAINAGE INTO OR AROUND THE DROP INLET AS APPROVED BY THE ENGINEER.
  12. 4"x2" NOTCH SHALL BE FORMED IN ALL DROP INLETS TO SUPPORT SIDEWALK CONSTRUCTION. REFER TO DETAIL OF NOTCH FOR SIDEWALKS.
  13. DIMENSIONS SHOWN FOR RING AND COVER ARE TYPICAL. THE CONTRACTOR MAY SUBSTITUTE SIMILAR CASTINGS WITH THE APPROVAL OF THE ENGINEER. REQUESTING APPROVAL FOR CASTING DESIGNS MAY BE MADE BY REFERRING TO PREVIOUSLY APPROVED DRAWINGS.

LEAVE OPENING IN BACK WHEN CALLED FOR ON PLANS REFER TO BACK OPENING DETAIL


MINIMUM WALL THICKNESS			
DIA. OF D.I.	DIA. OF OUTLET PIPE	CAST IN PLACE	PRECAST
4" LD.	12" THRU 27"	6"	5"
5" LD.	30" THRU 42"	8"	6"
6" LD.	48" THRU 54"	8"	7"

DATE	REVISIONS	DATE FILED
11-22-02	ADDED PAY LIMIT CURB NOTES TO SECTIONS A-A & B-B	
11-16-01	ADDED NOTE 13	
11-12-00	REVISED HEAVY DUTY RING & COVER	
5-13-99	ADDED NOTCH DETAIL FOR SIDEWALKS	
7-02-98	REP. NOTE B, RING PLAN DET., REV. PICTURE FOR COVER AND DETAIL OF STEP FOR DROP INLET	
10-12-96	ADDED NOTE 11 TO OPENING DETAIL	
10-12-96	CORRECTED #5 BAR SPACING	
11-20-95	CORRECTED DIAMETER OF D.I. IN BOX	
12-2-95	TYPE C TO MO (OPEN BACK DETAIL)	
11-15-94	REVISED GENERAL NOTES	11-15-94
11-15-94	REVISED DETAIL A NOTE	11-15-94
11-15-94	REVISED NOTES 11/2 A ADDED BACK OPEN DETAIL	11-15-94
11-15-94	ADDED NOTE NO. 12	11-15-94
11-15-94	ADDED NOTE A MINIMUM WALL THICKNESS	11-15-94
11-15-94	ADDED EXTENT NOTE TO SECTION A-A	11-15-94
11-15-94	MODIFIED WALL THICKNESS	11-15-94
11-15-94	ISSUED	11-15-94

ARKANSAS STATE HIGHWAY COMMISSION

**DETAILS OF DROP INLET (TYPE MO)**


STANDARD DRAWING FPC-9M

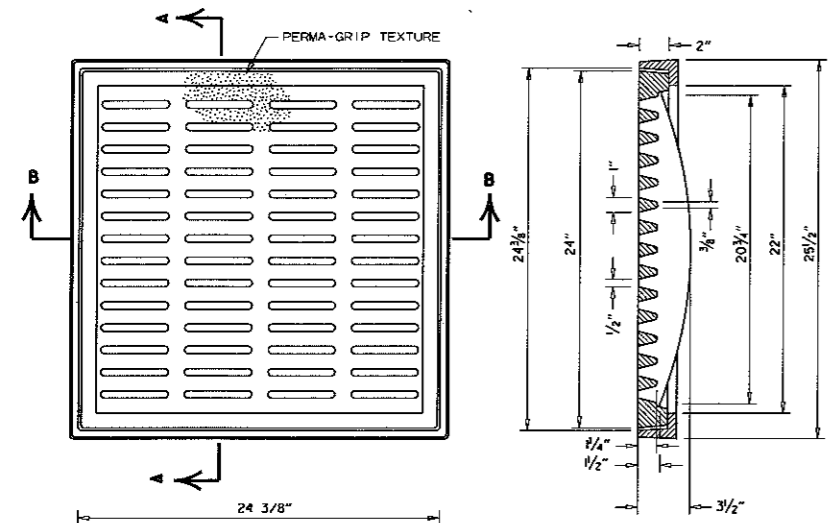


**SECTION A-A**

**GENERAL NOTES (PEDESTRIAN GRATE & FRAME)**


1. THE PEDESTRIAN GRATE SHALL BE ORIENTED IN THE TOP OF THE DROP INLET SO THAT THE 1/2" OPENINGS ARE PERPENDICULAR TO THE PATH OF PEDESTRIAN TRAVEL.
2. THE PEDESTRIAN GRATE AND FRAME SHALL BE CONSTRUCTED OF CAST IRON AND SHALL CONFORM TO THE REQUIREMENTS OF THE STANDARD SPECIFICATIONS FOR GRAY IRON CASTINGS AASHTO M 105, CLASS 35B, & AASHTO M 306.
3. THE GRATE AND FRAME SHALL NOT BE PAINTED.
4. THE GRATE AND FRAME SHALL BE INSTALLED IN THE DROP INLET IN THE ASSEMBLED POSITION.
5. THE APPROXIMATE WEIGHT OF THE GRATE AND FRAME SHALL BE 21 LBS.
6. THE MINIMUM WATERWAY OPENING SHALL BE 122 SQ. IN.

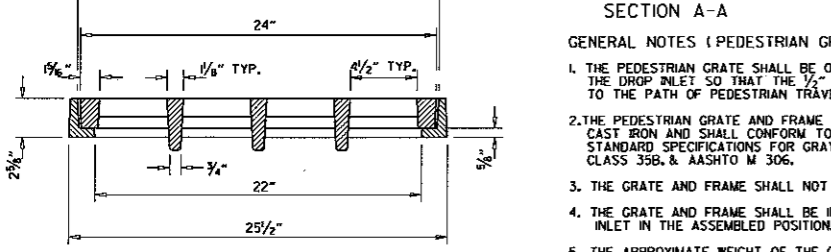

**SECTION B-B**  
**DETAILS OF PEDESTRIAN GRATE AND FRAME**

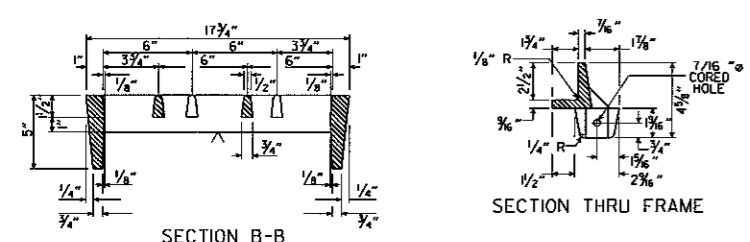


**SECTION THRU FRAME**

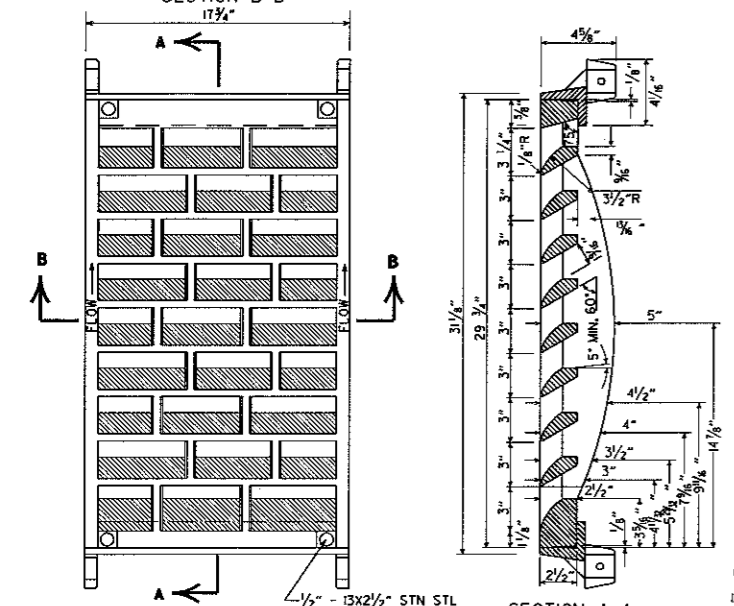


**SECTION A-A**  
**DETAILS OF RIBBED VANE GRATE AND FRAME**

**GENERAL NOTES (RIBBED VANE GRATE & FRAME)**

1. RIBBED VANE GRATE AND FRAME SHALL BE CONSTRUCTED OF CAST IRON AND SHALL CONFORM TO THE REQUIREMENTS OF THE STANDARD SPECIFICATIONS FOR GRAY IRON CASTINGS AASHTO M 105, CLASS 35B, & AASHTO M 306.
2. GRATE AND FRAME SHALL NOT BE PAINTED.
3. GRATE AND FRAME SHALL BE INSTALLED IN DROP INLET IN ASSEMBLED POSITION.
4. APPROXIMATE WEIGHT OF GRATE SHALL BE 170 LBS.

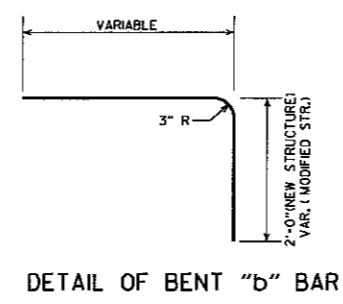


**DETAIL OF BENT "b" BAR**

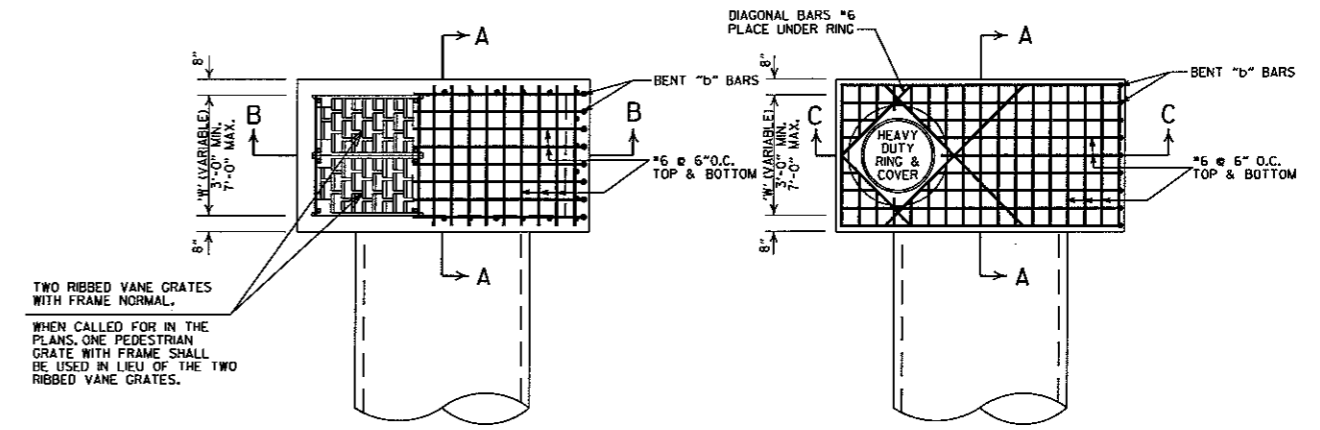


**TWO RIBBED VANE GRATES WITH FRAME NORMAL.**


WHEN CALLED FOR IN THE PLANS, ONE PEDESTRIAN GRATE WITH FRAME SHALL BE USED IN LIEU OF THE TWO RIBBED VANE GRATES.

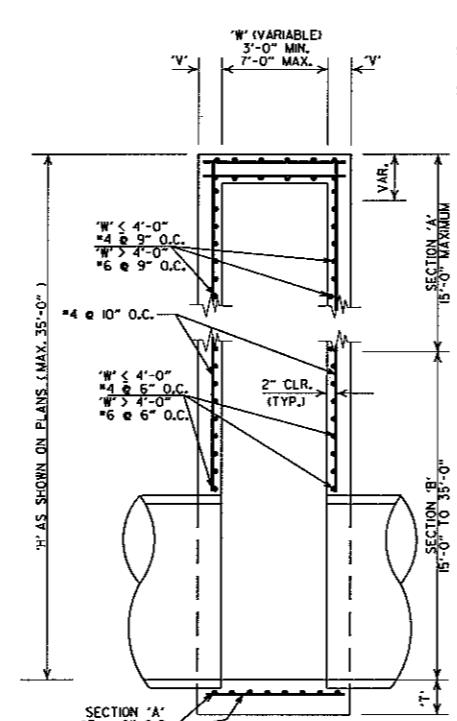


**SECTION A-A**  
**SECTION B-B**  
**DETAILS OF DROP INLET (TYPE ST)**

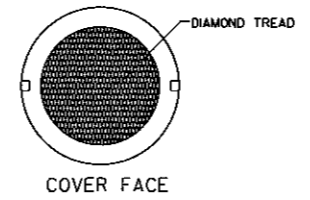


**COVER FACE**

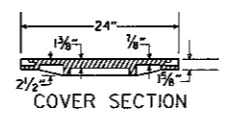

**COVER SECTION**

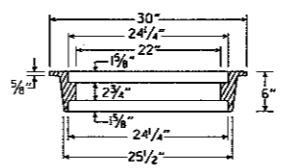

**RING SECTION**  
**HEAVY DUTY RING & COVER**  
APPROXIMATE TOTAL WEIGHT = 333 LBS.

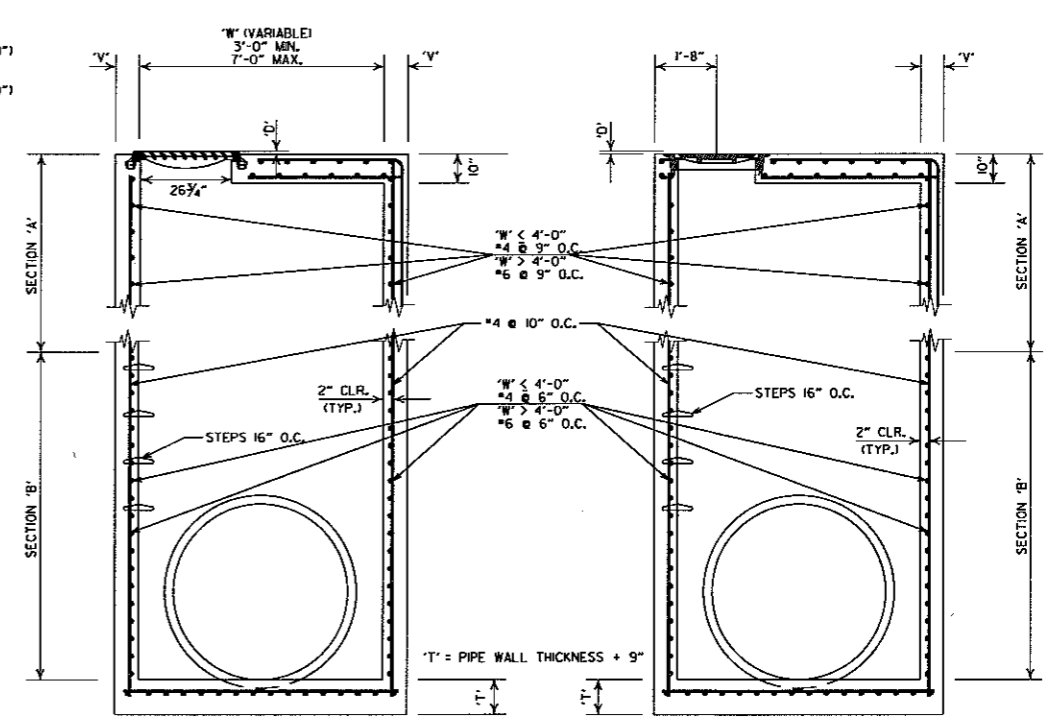

**SECTION A-A**  
**SECTION B-B**  
**SECTION C-C**  
**DETAILS OF JUNCTION BOX (TYPE ST)**

**GENERAL NOTES (TYPE ST DROP INLET & JUNCTION BOX)**

1. THE 'D' DIMENSION SHALL MATCH THE FINAL LIFT OF ACQU SURFACE COURSE SHOWN IN THE PLANS WHEN ASPHALT PAVING SURROUNDS THE GRATE OR RING COVER, AND SHALL BE 0" AT OTHER INSTALLATIONS.
2. THE STEPS SHALL BE OMITTED WHERE 'H' IS LESS THAN 4'-0".
3. ALL EXPOSED CORNERS ARE TO HAVE A 3/4" CHAMFER.

**GENERAL NOTES (HEAVY DUTY RING & COVER):**

1. HEAVY DUTY RING AND COVER SHALL BE CONSTRUCTED OF CAST IRON AND SHALL CONFORM TO THE REQUIREMENTS OF THE STANDARD SPECIFICATIONS FOR GRAY IRON CASTINGS AASHTO M 105, CLASS 35B, & AASHTO M 306.
2. HEAVY DUTY RING AND COVER SHALL NOT BE PAINTED.
3. HEAVY DUTY RING SHALL ALWAYS BE INSTALLED WITH FLANGE ON TOP.
4. DIMENSIONS SHOWN FOR RING AND COVER ARE TYPICAL. THE CONTRACTOR MAY SUBSTITUTE SIMILAR CASTINGS WITH THE APPROVAL OF THE ENGINEER, REQUESTING APPROVAL FOR CASTING DESIGNS MAY BE MADE BY REFERRING TO PREVIOUSLY APPROVED DRAWINGS.

DATE REVISED	DATE FILMED	DESCRIPTION
7-26-12		REMOVED NOTE 4, REVISED 'T', REVISED BOTTOM SLAB REBAR FOR SECTION 'A', SHOWED REBAR CLEARANCE IN SECTIONS
11-16-01		ADDED NOTE 4
1-12-00		REVISED HEAVY DUTY RING & COVER
5-13-99		ADDED PEDESTRIAN FRAME & GRATE
7-02-98		REMOVED NOTE 5, REV. DIMENSIONS, ADDED HEAVY DUTY RING & COVER, ADDED AASHTO REF, REVISED GRATE
10-18-96		REVISED ASTM REF. TO AASHTO
10-1-92		REVISED & REISSUED
8-15-91	8-15-91	REVISED & REISSUED

ARKANSAS STATE HIGHWAY COMMISSION  
**DETAILS OF DROP INLET & JUNCTION BOX (TYPE ST)**  
STANDARD DRAWING FPC-95

**REINFORCED CONCRETE ARCH PIPE DIMENSIONS**

EQUIV. DIA.	SPAN		RISE	
	AASHTO M 206	AHTD NOMINAL	AASHTO M 206	AHTD NOMINAL
INCHES	INCHES			
15	18	18	11	11
18	22	22	13 1/2	14
21	26	26	15 1/2	16
24	28 1/2	29	18	18
30	36 1/4	36	22 1/2	23
36	43 3/8	44	26 3/8	27
42	51 1/8	51	31 5/8	31
48	58 1/2	59	36	36
54	65	65	40	40
60	73	73	45	45
72	88	88	54	54
84	102	102	62	62
90	115	115	72	72
96	122	122	77 1/2	77
108	138	138	87 1/8	87
120	154	154	96 3/8	97
132	168 3/4	169	106 1/2	107

THE MEASURED SPAN AND RISE SHALL NOT VARY MORE THAN ± 2 PERCENT FROM THE VALUES SPECIFIED BY AASHTO M206.

**REINFORCED CONCRETE HORIZONTAL ELLIPTICAL PIPE DIMENSIONS**

EQUIV. DIA.	AASHTO M 207	
	SPAN	RISE
INCHES	INCHES	
18	23	14
24	30	19
27	34	22
30	38	24
33	42	27
36	45	29
39	49	32
42	53	34
48	60	38
54	68	43
60	76	48
66	83	53
72	91	58
78	98	63
84	106	68

THE MEASURED SPAN AND RISE SHALL NOT VARY MORE THAN ± 2 PERCENT FROM THE VALUES SPECIFIED BY AASHTO M207.

**CONSTRUCTION SEQUENCE**

1. PLACE STRUCTURAL BEDDING MATERIAL TO GRADE. DO NOT COMPACT.
2. INSTALL PIPE TO GRADE.
3. COMPACT STRUCTURAL BEDDING OUTSIDE THE MIDDLE THIRD OF THE PIPE.
4. PLACE AND COMPACT THE HAUNCH AREA UP TO THE MIDDLE OF THE PIPE.
5. COMPLETE BACKFILL ACCORDING TO SUBSECTION 606.03.(f)(1).


**NOTE:** HAUNCH AND STRUCTURAL BEDDING MATERIAL WILL NOT BE PAID FOR SEPARATELY, BUT COMPENSATION WILL BE CONSIDERED TO BE INCLUDED IN THE PRICE BID PER LINEAR FOOT OF CONCRETE PIPE.

**- LEGEND -**

- D<sub>1</sub> = NORMAL INSIDE DIAMETER OF PIPE
- D<sub>0</sub> = OUTSIDE DIAMETER OF PIPE
- H = FILL COVER HEIGHT OVER PIPE (FEET)
- MIN. = MINIMUM
- (Hatched) = UNDISTURBED SOIL

INSTALLATION TYPE	MATERIAL REQUIREMENTS FOR HAUNCH AND STRUCTURAL BEDDING
TYPE 1	AGGREGATE BASE COURSE (CLASS 5 OR CLASS 7)
TYPE 2	SELECTED MATERIALS (CLASS SM-1, SM-2, OR SM-4) OR TYPE 1 INSTALLATION MATERIAL*
TYPE 3**	AASHTO CLASSIFICATION A-1 THRU A-6 SOIL OR TYPE 1 OR 2 INSTALLATION MATERIAL

\* SM-3 WILL NOT BE ALLOWED.  
\*\* MATERIALS SHALL NOT INCLUDE ORGANIC MATERIALS OR STONES LARGER THAN 3 INCHES.

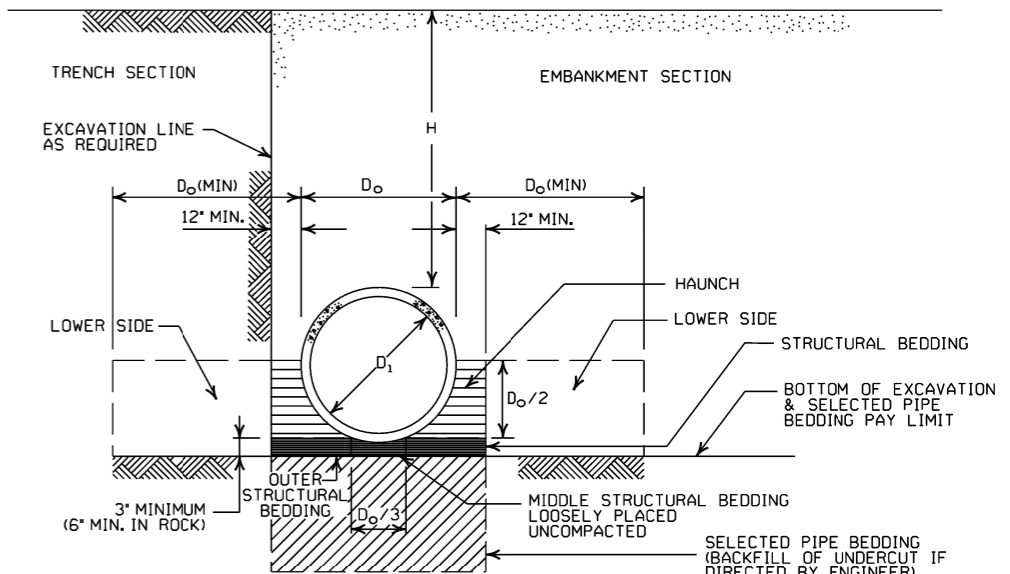

**EMBANKMENT AND TRENCH INSTALLATIONS**

1. MATERIAL IN THE HAUNCH AND OUTER STRUCTURAL BEDDING SHALL BE COMPACTED TO 95% OF THE MAXIMUM DENSITY ACCORDING TO THE TYPE OR CLASS OF MATERIAL USED.
2. FOR TRENCHES WITH WALLS OF NATURAL SOIL, THE DENSITY OF THE SOIL IN THE LOWER SIDE ZONE SHALL BE AS FIRM AS THE 95% DENSITY REQUIRED FOR THE HAUNCH. IF THE EXISTING SOIL DOES NOT MEET THIS CRITERIA, IT SHALL BE REMOVED AND RECOMPACTED TO 95% OF THE MAXIMUM DENSITY ACCORDING TO THE TYPE OF MATERIAL USED.
3. FOR EMBANKMENTS, THE MATERIAL IN THE LOWER SIDE ZONE SHALL BE COMPACTED TO 95% OF THE MAXIMUM DENSITY ACCORDING TO THE TYPE OR CLASS OF MATERIAL USED.

**GENERAL NOTES**

1. CONCRETE PIPE CULVERT CONSTRUCTION SHALL CONFORM TO ARKANSAS STATE HIGHWAY AND TRANSPORTATION DEPARTMENT STANDARD SPECIFICATIONS FOR HIGHWAY CONSTRUCTION (CURRENT EDITION), WITH APPLICABLE SUPPLEMENTAL SPECIFICATIONS AND SPECIAL PROVISIONS. UNLESS OTHERWISE NOTED IN THE PLANS, SECTION AND SUBSECTION REFER TO THE STANDARD CONSTRUCTION SPECIFICATIONS.
2. CONCRETE PIPE CULVERT DESIGN SHALL CONFORM TO AASHTO LRFD BRIDGE DESIGN SPECIFICATIONS, FIFTH EDITION (2010) WITH 2010 INTERIMS.
3. ALL PIPE SHALL CONFORM TO SECTION 606. CIRCULAR R.C. PIPE CULVERTS SHALL CONFORM TO AASHTO M170, R.C. ARCH PIPE CULVERTS SHALL CONFORM TO AASHTO M206 AND HORIZONTAL ELLIPTICAL PIPE CULVERTS SHALL CONFORM TO AASHTO M207.
4. ALL PIPE SHALL BE PROTECTED DURING CONSTRUCTION BY A COVER SUFFICIENT TO PREVENT DAMAGE FROM PASSAGE OF EQUIPMENT.
5. THE MINIMUM TRENCH WIDTH SHALL BE THE OUTSIDE DIAMETER OF THE PIPE PLUS 24 INCHES. THE MAXIMUM ALLOWABLE TRENCH WIDTH SHALL BE THE MINIMUM WIDTH PRACTICABLE FOR WORKING CONDITIONS.
6. MULTIPLE PIPE CULVERTS SHALL BE INSTALLED WITH A MINIMUM CLEARANCE OF 24 INCHES BETWEEN STRINGS OF PIPE. REFER TO STD. DWG. FES-2 FOR MINIMUM CLEARANCE WHERE FLARED END SECTIONS ARE USED.
7. IMPERVIOUS MATERIAL SHOULD BE PLACED AS DIRECTED BY THE ENGINEER AT THE ENDS OF THE CULVERT TO PREVENT LOSS OF STRUCTURAL BEDDING WHEN PERVIOUS MATERIAL IS USED FOR STRUCTURAL BEDDING AND/OR BACKFILL.
8. NOT MORE THAN ONE LIFTING HOLE MAY BE PROVIDED IN CONCRETE PIPE TO FACILITATE HANDLING. HOLE MAY BE CAST IN PLACE, CUT INTO THE FRESH CONCRETE AFTER FORMS ARE REMOVED, OR DRILLED. THE HOLE SHALL NOT BE MORE THAN TWO INCHES IN DIAMETER OR TWO INCHES SQUARE. CUTTING OR DISPLACEMENT OF REINFORCEMENT WILL NOT BE PERMITTED. SPALLED AREAS AROUND THE HOLE SHALL BE REPAIRED IN A WORKMANLIKE MANNER. LIFTING HOLE SHALL BE FILLED WITH MORTAR, CONCRETE, OR OTHER METHOD AS APPROVED BY THE ENGINEER.
9. WHEN DIRECTED BY THE ENGINEER, UNSUITABLE MATERIAL THAT IS ENCOUNTERED AT THE BOTTOM OF THE EXCAVATED TRENCH (BELOW THE AREA IDENTIFIED AS "STRUCTURAL BEDDING" ABOVE) WILL BE EXCAVATED AND REPLACED WITH SELECTED PIPE BEDDING. THE QUANTITY OF MATERIAL REQUIRED TO BACKFILL THE UNDERCUT AREA UP TO THE SELECTED PIPE BEDDING PAY LIMIT DESIGNATED ABOVE WILL BE MEASURED AND PAID FOR AS "SELECTED PIPE BEDDING."
10. WHEN THE EXISTING MATERIAL EXCAVATED FOR THE PIPE TRENCH IS DETERMINED BY THE ENGINEER TO BE UNSUITABLE FOR BACKFILLING THE PIPE (ABOVE THE AREA IDENTIFIED ABOVE AS THE HAUNCH), BORROW MATERIAL OR MATERIAL FROM THE ROADWAY EXCAVATION WILL BE USED TO BACKFILL THE PIPE. IF SUITABLE MATERIAL IS NOT AVAILABLE, THE ENGINEER MAY AUTHORIZE THE USE OF "SELECTED PIPE BACKFILL."

**MINIMUM HEIGHT OF FILL "H" OVER CIRCULAR R.C. PIPE CULVERTS**

INSTALLATION TYPE	CLASS OF PIPE			
	TYPE 1 OR 2	TYPE 3	ALL	ALL
PIPE ID (IN.)	FEET			
12-15	2	2.5	2	1
18-24	2.5	3	2	1
27-33	3	4	2	1
36-42	3.5	5	2	1
48	4.5	5.5	2	1
54-60	5	7	2	1
66-78	6	8	2	1
84-108	7.5	8	2	1

NOTE: FOR MINIMUM COVER VALUES, "H" SHALL INCLUDE A MINIMUM OF 12" OF PAVEMENT AND/OR BASE.

**MAXIMUM HEIGHT OF FILL "H" OVER CIRCULAR R.C. PIPE CULVERTS**

INSTALLATION TYPE	CLASS OF PIPE		
	CLASS III	CLASS IV	CLASS V
	FEET		
TYPE 1	21	32	50
TYPE 2	16	25	39
TYPE 3	12	20	30

NOTE: IF FILL HEIGHT EXCEEDS 50 FEET, A SPECIAL DESIGN CONCRETE PIPE WILL BE REQUIRED USING TYPE 1 INSTALLATION.

**MINIMUM HEIGHT OF FILL "H" OVER R.C. ARCH & HORIZONTAL ELLIPTICAL PIPE CULVERTS**

INSTALLATION TYPE	CLASS OF PIPE	
	CLASS III	CLASS IV
	FEET	
TYPE 2 OR TYPE 3	2.5	1.5

NOTE: TYPE 1 INSTALLATION WILL NOT BE ALLOWED FOR ARCH & HORIZONTAL ELLIPTICAL PIPE CULVERTS.

NOTE: FOR MINIMUM COVER VALUES, "H" SHALL INCLUDE A MINIMUM OF 12" OF PAVEMENT AND/OR BASE.

**MAXIMUM HEIGHT OF FILL "H" OVER R.C. ARCH & HORIZONTAL ELLIPTICAL PIPE CULVERTS**

INSTALLATION TYPE	CLASS OF PIPE	
	CLASS III	CLASS IV
	FEET	
TYPE 2	13	21
TYPE 3	10	16

NOTE: TYPE 1 INSTALLATION WILL NOT BE ALLOWED FOR ARCH & HORIZONTAL ELLIPTICAL PIPE CULVERTS.

DATE	REVISION	DATE FILMED
2-27-14	REVISED GENERAL NOTE 1.	
12-15-11	REVISED FOR LRFD DESIGN SPECIFICATIONS	
5-18-00	REVISED TYPE 3 BEDDING & ADDED NOTE	
3-30-00	REVISED INSTALLATIONS	
11-06-97	ISSUED	

<b>ARKANSAS STATE HIGHWAY COMMISSION</b>		
<b>CONCRETE PIPE CULVERT FILL HEIGHTS &amp; BEDDING</b>		
<b>STANDARD DRAWING PCC-1</b>		

**CORRUGATED STEEL PIPE (ROUND)**

PIPE DIAMETER (INCHES)	① MINIMUM COVER TOP OF PIPE TO TOP OF GROUND "H" (FEET)	MAX. FILL HEIGHT "H" ABOVE TOP OF PIPE (FEET)				
		METAL THICKNESS (INCHES)				
		0.064	0.079	0.109	0.138	0.168
2 3/8 INCH BY 1/2 INCH CORRUGATION RIVETED, WELDED, OR HELICAL LOCK-SEAM						
12	1	84	91			
15	1	67	73			
18	1	56	61			
24	1	42	46	59		
30	2	34	36	47		
36	2		30	39	41	
42	2		43	67	70	73
48	2		37	58	61	64
② 3 INCH BY 1 INCH OR 5 INCH BY 1 INCH CORRUGATION RIVETED, WELDED, BOLTED, OR HELICAL LOCK-SEAM						
36	1	48	60	88	111	118
42	1	41	51	72	90	102
48	1	36	45	64	77	85
54	2	32	40	59	71	79
60	2	29	36	53	64	71
66	2	26	33	47	58	64
72	2	24	30	44	53	59
78	2		28	41	49	54
84	2		26	38	45	51
90	2		24	35	43	45
96	2		22	33	40	44
102	2			31	38	42
108	2			30	35	39
114	2			28	34	37
120	2			27	32	35



**CONSTRUCTION SEQUENCE**

1. PLACE STRUCTURAL BEDDING MATERIAL TO GRADE. DO NOT COMPACT.
2. INSTALL PIPE TO GRADE.
3. COMPACT STRUCTURAL BEDDING OUTSIDE THE MIDDLE THIRD OF THE PIPE.
4. COMPLETE STRUCTURAL BACKFILL OPERATION BY WORKING FROM SIDE TO SIDE OF THE PIPE. THE SIDE TO SIDE STRUCTURAL BACKFILL DIFFERENTIAL SHALL NOT EXCEED 24 INCHES OR 1/3 THE SIZE OF THE PIPE, WHICHEVER IS LESS.

**NOTE: STRUCTURAL BACKFILL AND STRUCTURAL BEDDING MATERIAL WILL NOT BE PAID FOR SEPARATELY, BUT COMPENSATION WILL BE CONSIDERED TO BE INCLUDED IN THE PRICE BID PER LINEAR FOOT OF METAL PIPE.**

INSTALLATION TYPE	MATERIAL REQUIREMENTS FOR STRUCTURAL BACKFILL AND STRUCTURAL BEDDING
TYPE 1	AGGREGATE BASE COURSE (CLASS 4, 5, 6, OR 7)
TYPE 2	SELECTED MATERIALS (CLASS SM-1, SM-2, OR SM-4) OR TYPE 1 INSTALLATION MATERIAL ③

③ SM-3 WILL NOT BE ALLOWED.

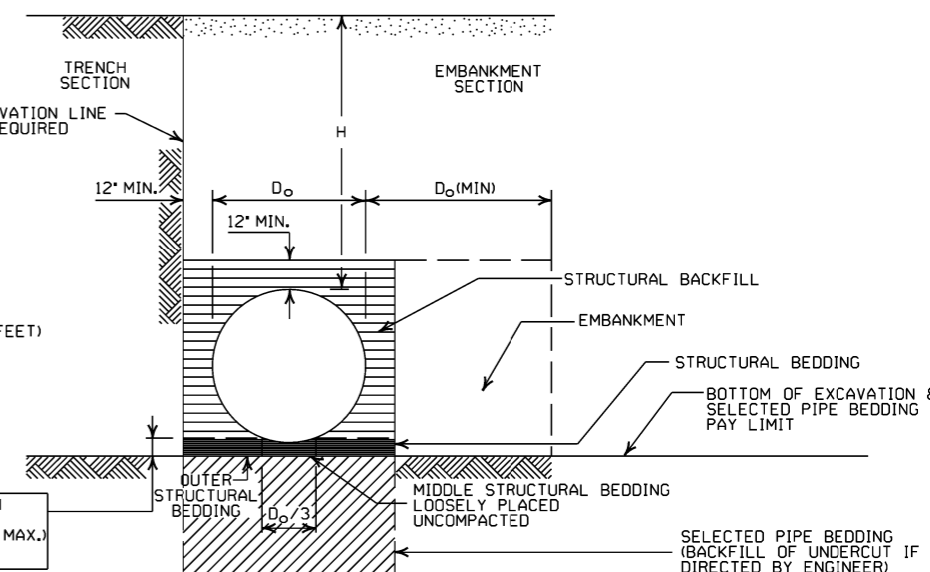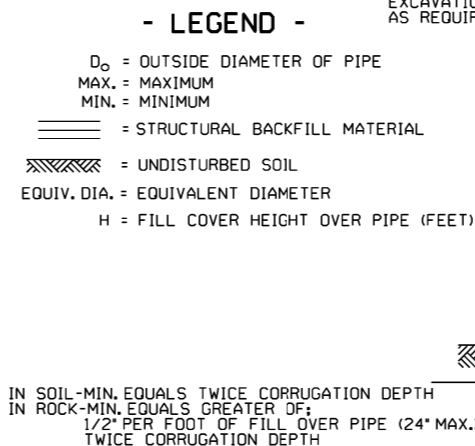

**EMBANKMENT AND TRENCH INSTALLATIONS**

1. STRUCTURAL BACKFILL, EMBANKMENT, AND OUTER STRUCTURAL BEDDING MATERIAL SHALL BE COMPACTED TO 95% OF THE MAXIMUM DENSITY ACCORDING TO THE TYPE OR CLASS OF MATERIAL USED.
2. INSTALLATION TYPE 1 OR 2 MAY BE USED FOR CORRUGATED STEEL OR ALUMINUM PIPE (ROUND).
3. INSTALLATION TYPE 1 SHALL BE USED FOR CORRUGATED STEEL OR ALUMINUM PIPE ARCHES WITH 2 3/8" X 1/2" CORRUGATION.
4. INSTALLATION TYPE 1 OR 2 MAY BE USED FOR CORRUGATED STEEL OR ALUMINUM PIPE ARCHES WITH 3" X 1" OR 5" X 1" CORRUGATION.

**CORRUGATED ALUMINUM PIPE (ROUND)**

PIPE DIAMETER (INCHES)	① MINIMUM COVER TOP OF PIPE TO TOP OF GROUND "H" (FEET)	MAX. FILL HEIGHT "H" ABOVE TOP OF PIPE (FEET)				
		METAL THICKNESS IN INCHES				
		0.060	0.075	0.105	0.135	0.164
2 3/8 INCH BY 1/2 INCH CORRUGATION RIVETED OR HELICAL LOCK-SEAM						
12	1	45	45	52		
18	2	30	30	39	41	34
24	2	22	22	31	32	28
30	2		18	26	27	28
36	2.5		15	26	27	28
42	2			43	43	44
48	2			40	41	43
54	2			35	37	38
60	2				33	34
66	2					31
72	2					29

**EQUIVALENT METAL THICKNESSES AND GAUGES**

METAL THICKNESS IN INCHES			GAUGE NUMBER
STEEL			
ZINC COATED	UNCOATED	ALUMINUM	
0.064	0.0598	0.060	16
0.079	0.0747	0.075	14
0.109	0.1046	0.105	12
0.138	0.1345	0.135	10
0.168	0.1644	0.164	8

**GENERAL NOTES**

1. METAL PIPE CULVERT CONSTRUCTION SHALL CONFORM TO ARKANSAS STATE HIGHWAY AND TRANSPORTATION DEPARTMENT STANDARD SPECIFICATIONS FOR HIGHWAY CONSTRUCTION (CURRENT EDITION), WITH APPLICABLE SUPPLEMENTAL SPECIFICATIONS AND SPECIAL PROVISIONS. UNLESS OTHERWISE NOTED IN THE PLANS, SECTION AND SUBSECTION REFER TO THE STANDARD CONSTRUCTION SPECIFICATIONS.
2. METAL PIPE CULVERT DESIGN SHALL CONFORM TO AASHTO LRFD BRIDGE DESIGN SPECIFICATIONS, FIFTH EDITION (2010) WITH 2010 INTERIMS.
3. METAL PIPE CULVERT MATERIALS AND INSTALLATIONS SHALL CONFORM TO SECTION 606 AND JOB SPECIAL PROVISION "METAL PIPE".
4. ALL PIPE SHALL BE PROTECTED DURING CONSTRUCTION BY A COVER SUFFICIENT TO PREVENT DAMAGE FROM PASSAGE OF EQUIPMENT.
5. THE MINIMUM TRENCH WIDTH SHALL BE THE OUTSIDE DIAMETER OF THE PIPE PLUS 24 INCHES. THE MAXIMUM ALLOWABLE TRENCH WIDTH SHALL BE THE MINIMUM WIDTH PRACTICABLE FOR WORKING CONDITIONS.
6. MULTIPLE PIPE CULVERTS SHALL BE INSTALLED WITH A MINIMUM CLEARANCE OF 24 INCHES BETWEEN STRINGS OF PIPE. REFER TO STD. DWG. FES-2 FOR MINIMUM CLEARANCE WHERE FLARED END SECTIONS ARE USED.
7. IMPERVIOUS MATERIAL SHOULD BE PLACED AS DIRECTED BY THE ENGINEER AT THE ENDS OF THE CULVERT TO PREVENT LOSS OF STRUCTURAL BEDDING WHEN PERVIOUS MATERIAL IS USED FOR STRUCTURAL BEDDING AND/OR BACKFILL.
8. WHEN DIRECTED BY THE ENGINEER, UNSUITABLE MATERIAL THAT IS ENCOUNTERED AT THE BOTTOM OF THE EXCAVATED TRENCH (BELOW THE AREA IDENTIFIED AS "STRUCTURAL BEDDING" ABOVE) WILL BE EXCAVATED AND REPLACED WITH SELECTED PIPE BEDDING. THE QUANTITY OF MATERIAL REQUIRED TO BACKFILL THE UNDERCUT AREA UP TO THE SELECTED PIPE BEDDING PAY LIMIT DESIGNATED ABOVE WILL BE MEASURED AND PAID FOR AS "SELECTED PIPE BEDDING."
9. WHEN THE EXISTING MATERIAL EXCAVATED FOR THE PIPE TRENCH IS DETERMINED BY THE ENGINEER TO BE UNSUITABLE FOR BACKFILLING THE PIPE (ABOVE THE AREA IDENTIFIED AS STRUCTURAL BACKFILL), BORROW MATERIAL OR MATERIAL FROM THE ROADWAY EXCAVATION WILL BE USED TO BACKFILL THE PIPE. IF SUITABLE MATERIAL IS NOT AVAILABLE, THE ENGINEER MAY AUTHORIZE THE USE OF "SELECTED PIPE BACKFILL."

**CORRUGATED METAL PIPE ARCHES**

EQUIV. DIA. (INCHES)	PIPE DIMENSION SPAN X RISE (INCHES)	MINIMUM CORNER RADIUS (INCHES)	STEEL				ALUMINUM			
			MIN. THICKNESS REQUIRED INCHES	① MIN. HEIGHT OF FILL, "H" (FT.)		MIN. THICKNESS REQUIRED INCHES	① MIN. HEIGHT OF FILL, "H" (FT.)			
				INSTALLATION			INSTALLATION			
				TYPE 1	TYPE 1		TYPE 1	TYPE 1		
2 3/8 INCH BY 1/2 INCH CORRUGATION RIVETED, WELDED, OR HELICAL LOCK-SEAM										
15	17x13	3	0.064	2	15	0.060	2	15		
18	21x15	3	0.064	2	15	0.060	2	15		
21	24x18	3	0.064	2,25	15	0.060	2,25	15		
24	28x20	3	0.064	2,5	15	0.075	2,5	15		
30	35x24	3	0.079	3	12	0.075	3	12		
36	42x29	3 1/2	0.079	3	12	0.105	3	12		
42	49x33	4	0.079	3	12	0.105	3	12		
48	57x38	5	0.109	3	13	0.135	3	13		
54	64x43	6	0.109	3	14	0.135	3	14		
60	71x47	7	0.138	3	15	0.164	3	15		
66	77x52	8	0.168	3	15					
72	83x57	9	0.168	3	15					
② 3 INCH BY 1 INCH OR 5 INCH BY 1 INCH CORRUGATION RIVETED, WELDED, OR HELICAL LOCK-SEAM										
			INSTALLATION				INSTALLATION			
			TYPE 2		TYPE 1		TYPE 2		TYPE 1	
36	40x31	5	0.079	3	2	12	15			
42	46x36	6	0.079	3	2	13	15			
48	53x41	7	0.079	3	2	13	15			
54	60x46	8	0.079	3	2	13	15			
60	66x51	9	0.079	3	2	13	15			
66	73x55	12	0.079	3	2	15	15			
72	81x59	14	0.079	3	2	15	15			
78	87x63	14	0.079	3	2	15	15			
84	95x67	16	0.109	3	2	15	15			
90	103x71	16	0.109	3	2	15	15			
96	112x75	18	0.109	3	2	15	15			
102	117x79	18	0.109	3	2	15	15			
108	128x83	18	0.138	3	2	15	15			

① FOR MINIMUM COVER VALUES, "H" SHALL INCLUDE A MINIMUM 12" OF PAVEMENT AND/OR BASE.

② WHERE THE STANDARD 2 2/3" X 1/2" CORRUGATION AND GAUGE IS SPECIFIED FOR A GIVEN DIAMETER, A PIPE OF THE SAME DIAMETER WITH A 3" X 1" OR 5" X 1" CORRUGATION MAY BE SUBSTITUTED, PROVIDING IT IS GAUGED FOR A FILL HEIGHT CONDITION EQUAL TO OR GREATER THAN THE MAXIMUM FILL HEIGHT CONDITION FOR THE SPECIFIED GAUGE AND CORRUGATION.

DATE	REVISION	DATE FILMED
2-27-14	REVISED GENERAL NOTE 1.	
12-15-11	REVISED FOR LRFD DESIGN SPECS	
3-30-00	REVISED INSTALLATIONS	
11-06-97	ISSUED	

**ARKANSAS STATE HIGHWAY COMMISSION**

**METAL PIPE CULVERT  
FILL HEIGHTS & BEDDING**

**STANDARD DRAWING PCM-1**



INSTALLATION TYPE	•• MATERIAL REQUIREMENTS FOR STRUCTURAL BACKFILL AND STRUCTURAL BEDDING
TYPE 2	•SELECTED MATERIALS (CLASS SM-1, SM-2, OR SM-4)

- AGGREGATE BASE COURSE (CLASS 4, 5, 6, OR 7) MAY BE USED IN LIEU OF SELECTED MATERIAL. SM3 WILL NOT BE ALLOWED.
- STRUCTURAL BEDDING MATERIAL SHALL HAVE A MAXIMUM PARTICLE SIZE OF 1/2 INCH. STRUCTURAL BACKFILL MATERIAL SHALL BE FREE OF ORGANIC MATERIAL, STONES LARGER THAN 1.50 INCH IN GREATEST DIMENSION, OR FROZEN LUMPS.

STRUCTURAL BACKFILL AND STRUCTURAL BEDDING MATERIAL WILL NOT BE PAID FOR SEPARATELY, BUT COMPENSATION WILL BE CONSIDERED TO BE INCLUDED IN THE PRICE BID PER LINEAR FOOT OF PVC PIPE.

**MINIMUM TRENCH WIDTH BASED ON FILL HEIGHT "H"**

PIPE DIAMETER	TRENCH WIDTH (FEET)	
	"H" < 10'-0"	"H" > OR = 10'-0"
18"	4'-6"	4'-6"
24"	5'-0"	6'-0"
30"	5'-6"	7'-6"
36"	6'-0"	9'-0"


**MULTIPLE INSTALLATION OF PVC PIPES**

PIPE DIAMETER	CLEAR DISTANCE BETWEEN PIPES
18"	1'-6"
24"	2'-0"
30"	2'-6"
36"	3'-0"

**MAXIMUM FILL HEIGHT BASED ON STRUCTURAL BACKFILL**

PIPE DIAMETER	"H"
18"	45'-0"
24"	45'-0"
30"	40'-0"
36"	40'-0"

- NOTE:  
 12" MIN. (18" - 36" DIAMETERS)  
 MINIMUM COVER VALUE, "H" SHALL INCLUDE A MINIMUM 12" OF PAVEMENT AND/OR BASE.

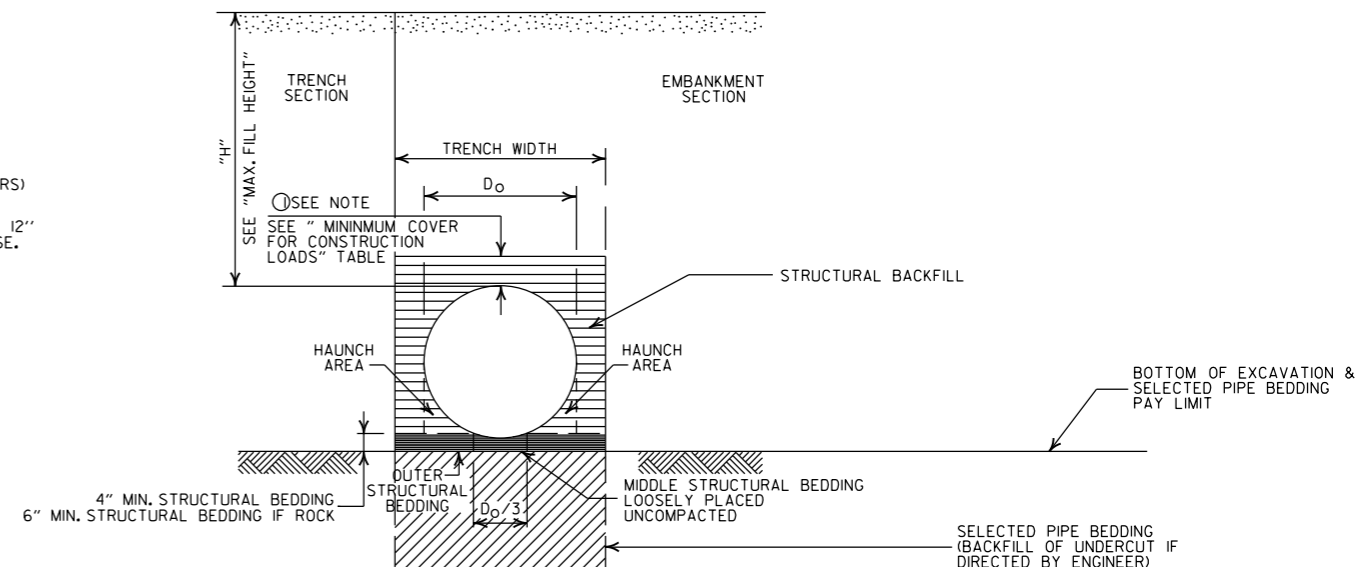

**TYPE 2 EMBANKMENT AND TRENCH INSTALLATIONS**

1. STRUCTURAL BACKFILL, EMBANKMENT, AND OUTER STRUCTURAL BEDDING MATERIAL SHALL BE COMPACTED TO 95% OF THE MAXIMUM DENSITY ACCORDING TO THE TYPE OR CLASS OF MATERIAL USED.

**MINIMUM COVER FOR CONSTRUCTION LOADS**

PIPE DIAMETER	MIN. COVER (FEET) FOR INDICATED CONSTRUCTION LOADS			
	18.0-50.0 (KIPS)	50.0-75.0 (KIPS)	75.0-110.0 (KIPS)	110.0-175.0 (KIPS)
18" THRU 36"	2'-0"	2'-6"	3'-0"	3'-0"

- MINIMUM COVER SHALL BE MEASURED FROM TOP OF PIPE TO TOP OF THE MAINTAINED CONSTRUCTION ROADWAY SURFACE. THE SURFACE SHALL BE MAINTAINED.

**CONSTRUCTION SEQUENCE**

- PLACE STRUCTURAL BEDDING MATERIAL TO GRADE. DO NOT COMPACT.
- INSTALL PIPE TO GRADE.
- COMPACT STRUCTURAL BEDDING OUTSIDE THE MIDDLE THIRD OF THE PIPE.
- THE STRUCTURAL BACKFILL SHALL BE PLACED AND COMPACTED IN LAYERS NOT EXCEEDING 8". THE LAYERS SHALL BE BROUGHT UP EVENLY AND SIMULTANEOUSLY TO THE ELEVATION OF THE MINIMUM COVER.
- PIPE INSTALLATION MAY REQUIRE THE USE OF RESTRAINTS, WEIGHTING OR OTHER APPROVED METHODS IN ORDER TO HELP MAINTAIN GRADE AND ALIGNMENT.

**- LEGEND -**

H = FILL HEIGHT (FT.)  
 D<sub>o</sub> = OUTSIDE DIAMETER OF PIPE  
 MAX. = MAXIMUM  
 MIN. = MINIMUM

==== = STRUCTURAL BACKFILL MATERIAL  
 ===== = UNDISTURBED SOIL

**GENERAL NOTES**

- PIPE SHALL CONFORM TO ASTM F949, CELL CLASS I2454. INSTALLATION SHALL CONFORM TO JOB SPECIAL PROVISION "PLASTIC PIPE" AND SECTION 606 OF THE STANDARD SPECIFICATIONS FOR HIGHWAY CONSTRUCTION (CURRENT EDITION).
- PLASTIC PIPE CULVERT DESIGN SHALL CONFORM TO AASHTO LRFD BRIDGE DESIGN SPECIFICATIONS, FIFTH EDITION (2010) WITH 2010 INTERIMS.
- THE MAXIMUM ALLOWABLE TRENCH WIDTH SHALL BE THE MINIMUM WIDTH PLUS A SUFFICIENT WIDTH TO ENSURE WORKING ROOM TO PROPERLY AND SAFELY PLACE AND COMPACT HAUNCHING AND OTHER BACKFILL MATERIAL.
- IMPERVIOUS MATERIAL SHOULD BE PLACED AS DIRECTED BY THE ENGINEER AT THE ENDS OF THE CULVERT TO PREVENT LOSS OF STRUCTURAL BEDDING WHEN PERVIOUS MATERIAL IS USED FOR STRUCTURAL BEDDING AND/OR BACKFILL.
- WHEN DIRECTED BY THE ENGINEER, UNSUITABLE MATERIAL THAT IS ENCOUNTERED AT THE BOTTOM OF THE EXCAVATED TRENCH (BELOW THE AREA IDENTIFIED AS "STRUCTURAL BEDDING" ABOVE) WILL BE EXCAVATED AND REPLACED WITH SELECTED PIPE BEDDING. THE QUANTITY OF MATERIAL REQUIRED TO BACKFILL THE UNDERCUT AREA UP TO THE SELECTED PIPE BEDDING PAY LIMIT DESIGNATED ABOVE WILL BE MEASURED AND PAID FOR AS "SELECTED PIPE BEDDING."
- WHEN THE EXISTING MATERIAL EXCAVATED FOR THE PIPE TRENCH IS DETERMINED BY THE ENGINEER TO BE UNSUITABLE FOR BACKFILLING THE PIPE (ABOVE THE AREA IDENTIFIED ABOVE AS STRUCTURAL BACKFILL), BORROW MATERIAL OR MATERIAL FROM THE ROADWAY EXCAVATION WILL BE USED TO BACKFILL THE PIPE. IF SUITABLE MATERIAL IS NOT AVAILABLE, THE ENGINEER MAY AUTHORIZE THE USE OF "SELECTED PIPE BACKFILL."
- FOR PIPE TYPES THAT ARE NOT SMOOTH ON THE OUTSIDE (CORRUGATED OR PROFILE WALLS), BACKFILL GRADATIONS SHOULD BE SELECTED THAT WILL PERMIT THE FILLING OF THE CORRUGATION OR PROFILE VALLEY.
- PVC PIPES OF DIAMETERS OTHER THAN SHOWN WILL NOT BE ALLOWED.
- JOINTS FOR PVC PIPE SHALL MEET THE REQUIREMENTS FOR SOIL TIGHTNESS AS SPECIFIED IN AASHTO SECTION 26.4.2.4 AND 30.4.2 "AASHTO LRFD BRIDGE CONSTRUCTION SPECIFICATIONS." JOINTS SHALL BE INSTALLED PER MANUFACTURER'S RECOMMENDATIONS.



DATE	REVISION	DATE FILMED
2-27-14	REVISED GENERAL NOTE 1.	
12-15-11	REV GENERAL NOTES & MINIMUM COVER NOTE; DELETED SM3 MATERIAL	
11-17-10	ISSUED	

ARKANSAS STATE HIGHWAY COMMISSION

PLASTIC PIPE CULVERT  
(PVC F949)

STANDARD DRAWING PCP-2




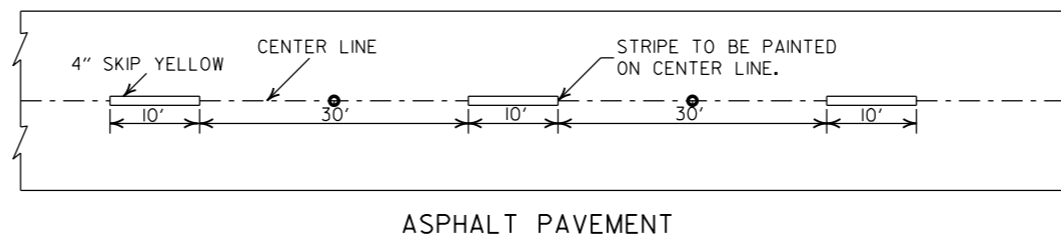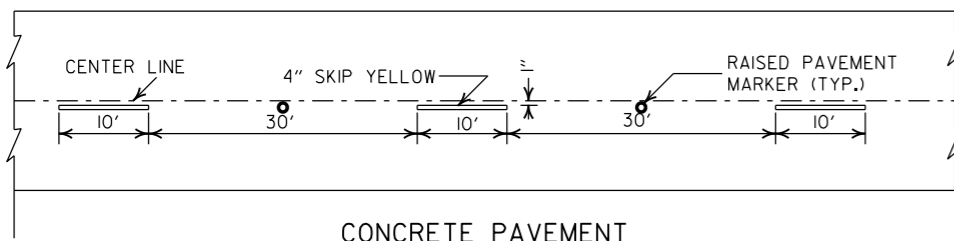


CONCRETE PAVEMENT

ASPHALT PAVEMENT


**BROKEN LINE STRIPING**

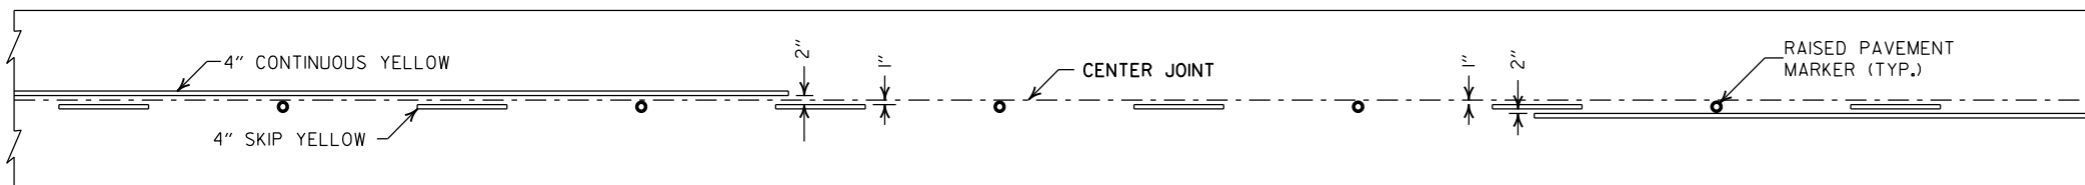


**SOLID LINE STRIPING ON CONCRETE PAVEMENT**

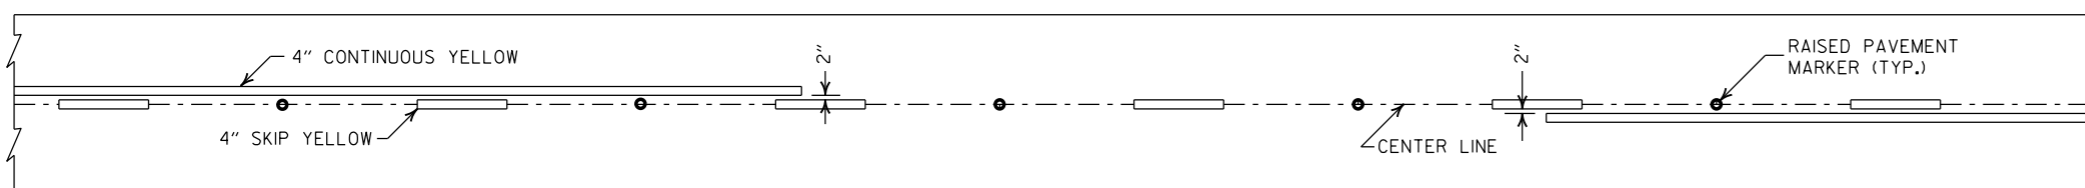

**SOLID LINE STRIPING ON ASPHALT PAVEMENT**

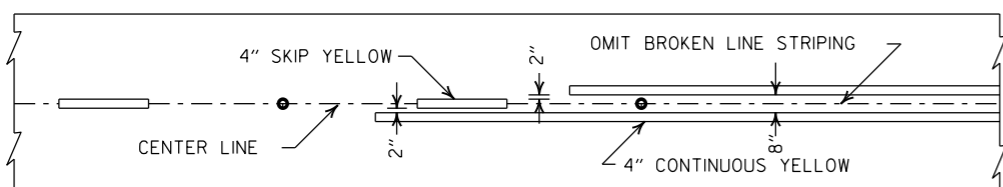


ASPHALT PAVEMENT

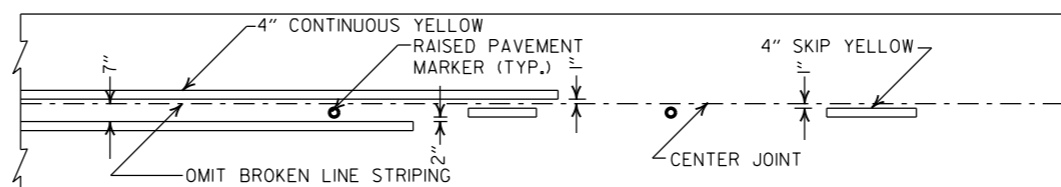

CONCRETE PAVEMENT

**STRIPING AT ADJACENT NO PASSING LANES**

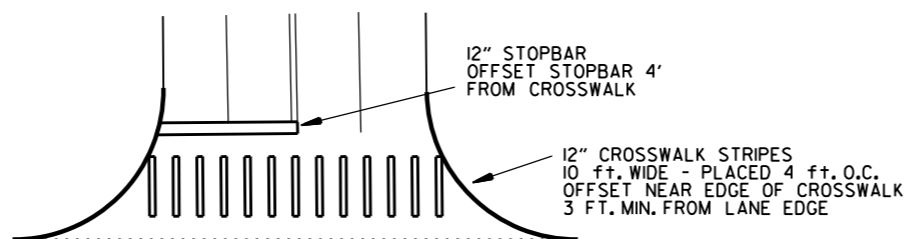


**CROSSWALK AND STOPBAR DETAILS**


NOTES:

1. ALL LINES SHALL HAVE A WIDTH OF 4 INCHES.
2. THE THICKNESS AND RATE OF PAINT APPLICATION SHALL BE AS SPECIFIED IN SECTION 718 OF THE STANDARD SPECIFICATIONS.
3. THIS DRAWING SHALL BE USED IN CONJUNCTION WITH THE LATEST REVISED ADDITION OF THE "MANUAL ON UNIFORM TRAFFIC CONTROL DEVICES."
4. RAISED PAVEMENT MARKERS SHALL BE CENTERED BETWEEN SKIP LINES ON 40 FEET SPACING UNLESS OTHERWISE SHOWN ON THE PLANS.


2" FOR ASPHALT OR CONCRETE PAVEMENT  
6" FOR BITUMINOUS SURFACE TREATMENT

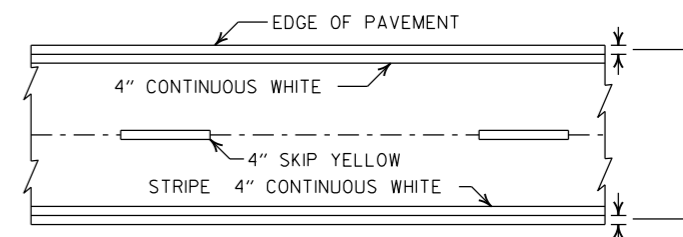

**PAVEMENT EDGE LINE MARKING**

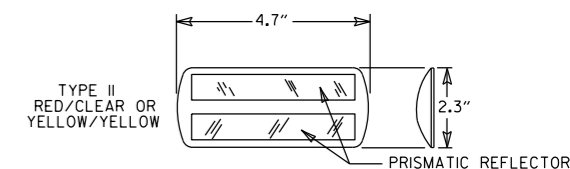

NOTE:  
THE RED LENS OF THE TYPE II R.P.M. SHALL FACE THE INCORRECT TRAFFIC MOVEMENT.

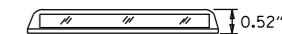

**DETAIL OF STANDARD RAISED PAVEMENT MARKERS**

GENERAL NOTES:  
THIS DRAWING SHOULD BE CONSIDERED AS TYPICAL ONLY AND THE FINAL LOCATION OF THE STRIPING AND RAISED PAVEMENT MARKERS SHALL BE DETERMINED BY THE ENGINEER.

THIS DRAWING SHOULD BE USED IN CONJUNCTION WITH THE "MANUAL ON UNIFORM TRAFFIC CONTROL DEVICES", LATEST REVISION.







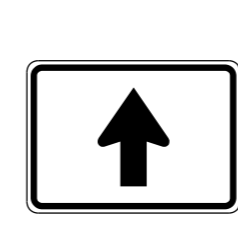






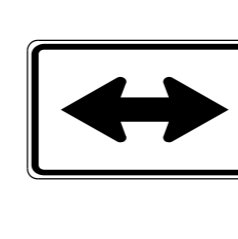


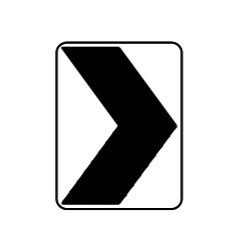



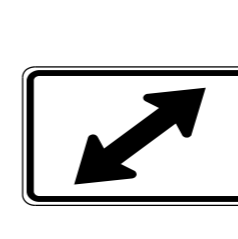
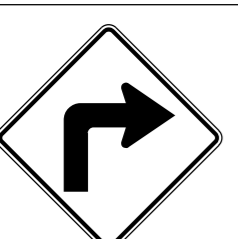
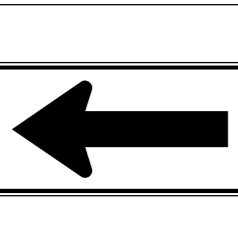
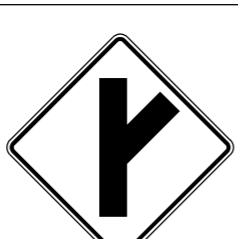

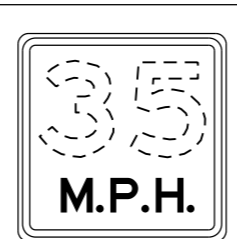
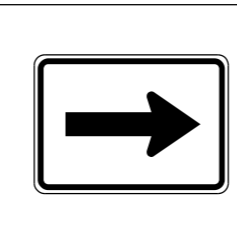
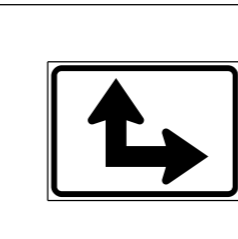
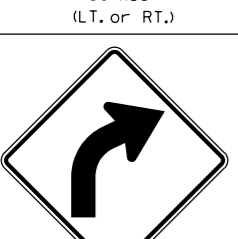
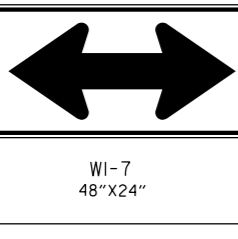
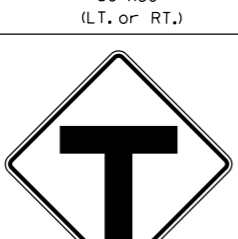

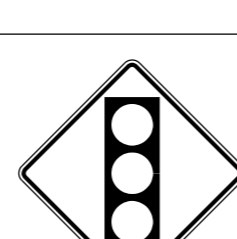
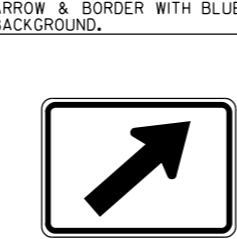
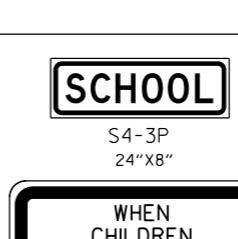
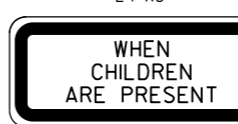
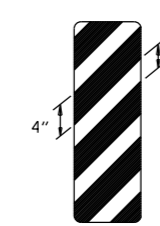
NOTE:  
DIMENSIONS SHOWN FOR RAISED PAVEMENT MARKERS ARE TYPICAL. THE CONTRACTOR MAY SUBSTITUTE SIMILAR MARKERS WITH THE APPROVAL OF THE ENGINEER. REQUESTING APPROVAL FOR SIMILAR MARKERS MAY BE MADE BY REFERRING TO THE AHTD QUALIFIED PRODUCTS LIST.



DATE	REVISION	FILMED
9-12-13	REVISED DETAIL OF STANDARD RAISED PAVEMENT MARKERS	
11-17-10	REVISED GENERAL NOTES & REMOVED PLOWABLE PVMT MRKRS	
11-18-04	REVISED NOTE 2 & GENERAL NOTES	
8-22-02	ADDED CROSSWALK & STOPBAR DTLS.	
7-02-98	ADDED DETAILS OF STD. RAISED PAV'T. MARKERS	
4-26-96	REV. NOTES 3&4; ADDED R.P.M.	
9-30-80	DRAWN	1-9-30-80

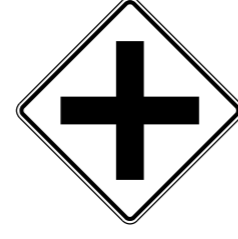ARKANSAS STATE HIGHWAY COMMISSION



**PAVEMENT MARKING DETAILS**

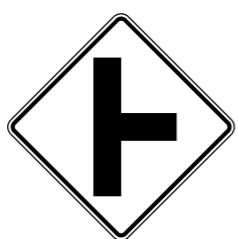STANDARD DRAWING PM-1

 RI-1 30"x30"	 W1-3 30"x30" (LT. OR RT.)	 W1-8 18"x24"	 W2-5 30"x30"	 W3-1 36"x36"	 W5-1 36"x36"	 M6-3 21"x15"
 RI-2 36"x36"x36"	 W1-4 30"x30" (LT. OR RT.)	 W2-1 30"x30"	 SI-1 36"x36"	 W3-2 36"x36"	 LASSEN 16 COUNTY County Route Marker MI-6 24"x24"	 M6-4 21"x15"
 R2-1 24"x30"	 W1-5 30"x30" (LT. OR RT.)	 W2-2 30"x30"	 NARROW BRIDGE W5-2 36"x36"	 PAVEMENT ENDS W8-3 36"x36"	 NOTE: REFLECTORIZED YELLOW LEGEND (COUNTY NAME, ROUTE LETTER & NUMBER) & BORDER ON A BLUE BACKGROUND. ALL WAY RI-3P 18"x6"	 M6-5 21"x15"
 W1-1 30"x30" (LT. OR RT.)	 W1-6 48"x24"	 W2-3 30"x30" (LT. OR RT.)	 ONE LANE BRIDGE W5-3 36"x36"	 35 M.P.H. W13-IP 18"x18"	 M6-1 21"x15"	 M6-6 21"x15"
 W1-2 30"x30" (LT. OR RT.)	 W1-7 48"x24"	 W2-4 30"x30"	 R X R W10-1 36" DIAMETER	 W3-3 36"x36"	 M6-2 21"x15"	 SCHOOL S4-3P 24"x8"
						 WHEN CHILDREN ARE PRESENT S4-2P 24"x10"
						 OM-3 12"x36" (LT. OR RT.)

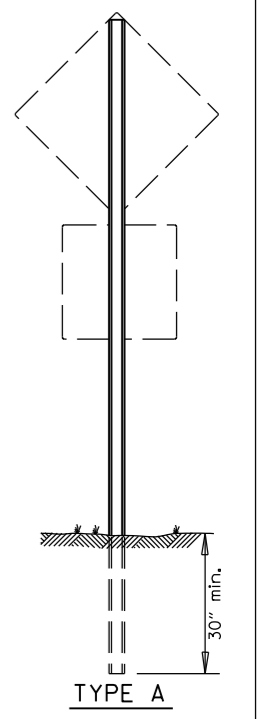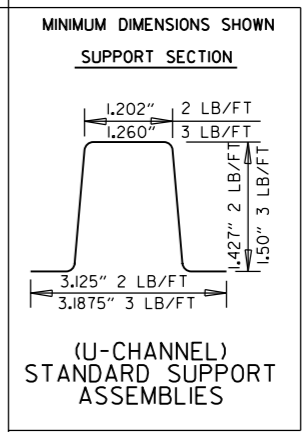

NOTE: LENGTH OF SIGN POSTS SHALL BE DETERMINED SO AS TO PROVIDE FOR MINIMUM VERTICAL CLEARANCES AS CALLED FOR IN THE SPECIFICATIONS PLUS A MINIMUM VERTICAL PENETRATION OF 30" IN THE SOIL.








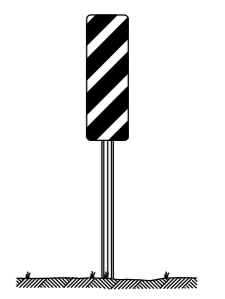
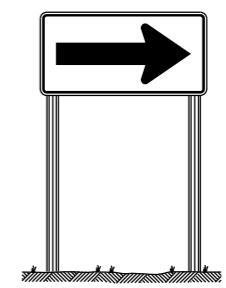


MINIMUM WEIGHT  
TYPE A & B = 3 LBS./FT.  
TYPE C = 2 LBS./FT.

STANDARD HIGHWAY SIGNS

9-12-13	DELETED JOB NO. BLOCK; REVISED RI-3 TO RI-3P	
4-17-08	REVISED SIGN DESIGNATION - W3-1 & W3-2	
4-10-03	REVISED W5-2, W8-3, OM-3; ADDED W1-8	
1-5-81	REDRAWN	960-1-15-81
9-15-78	ADDED W14-3	877-9-15-78
9-2-76	POST WT.	623-9-3-76
5-3-76	STEEL POST WT. FROM 2"-3"; ADDED S4-2 & S4-3	504-5-3-76
8-12-74	REV. HT. TYPE "C" ASSEMBLY	500-8-21-74
12-21-72	ADDED M6-2,3,4,5,6	500-12-21-72
12-1-72	ISSUED	562-12-1-72
DATE	REVISION	DATE FILMED

SUPPORT ASSEMBLIES

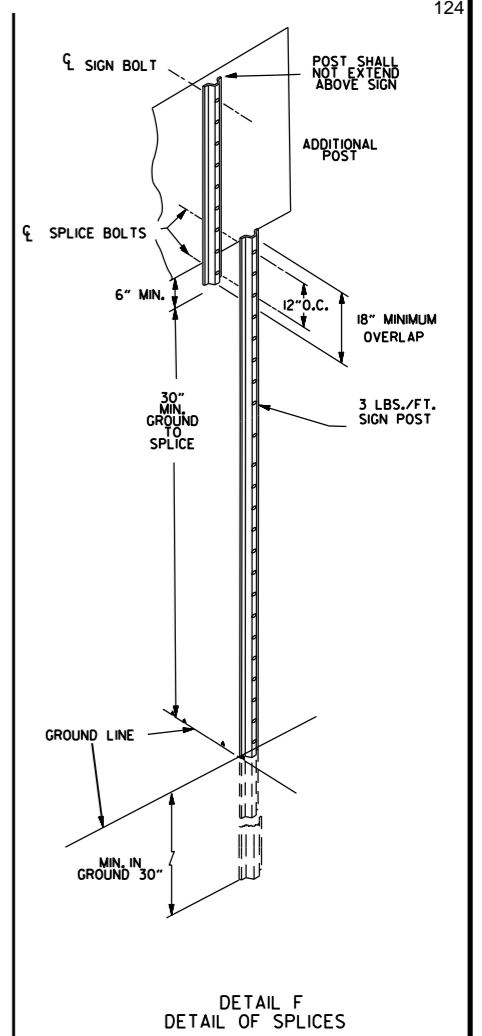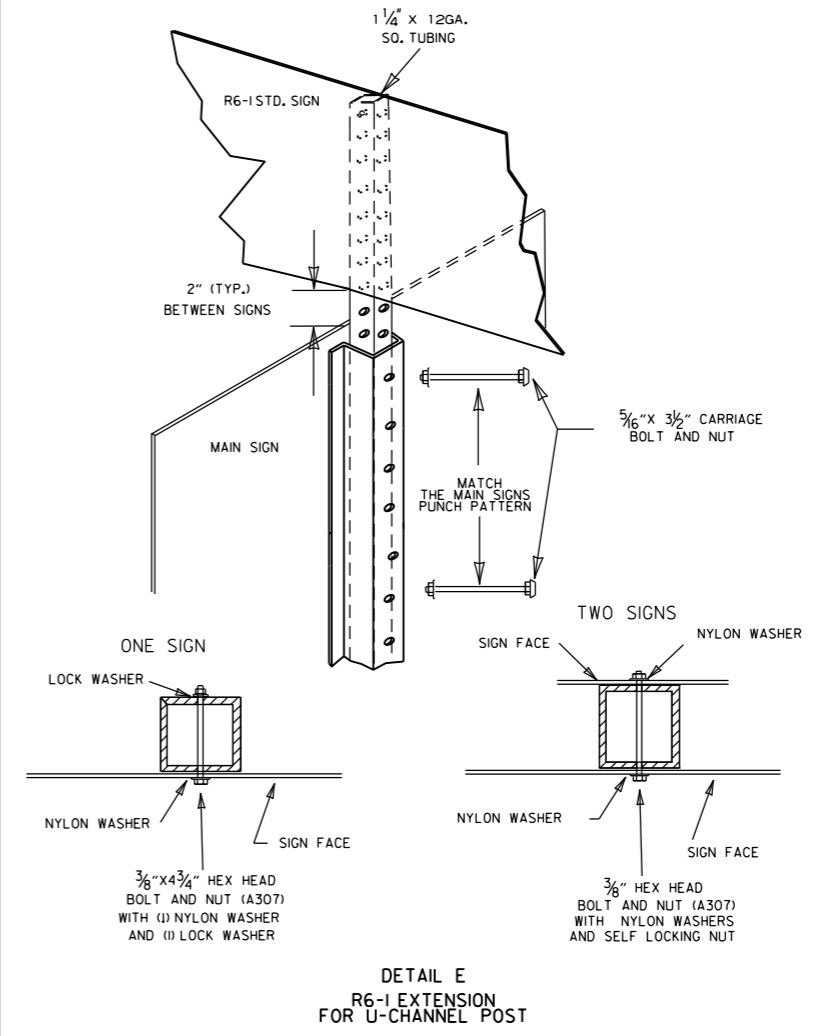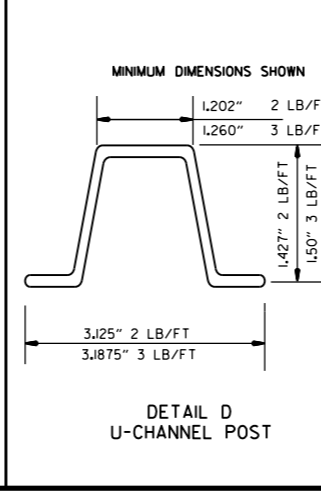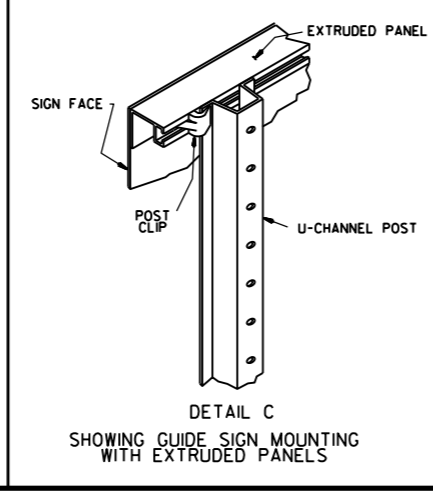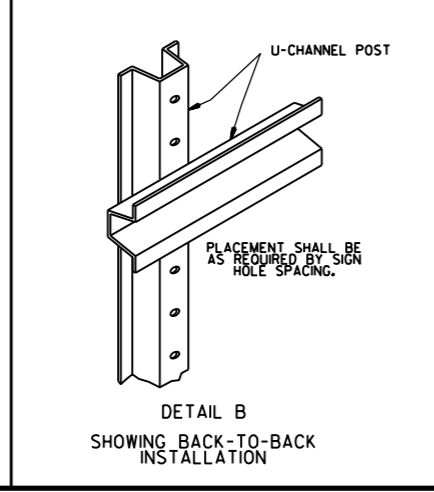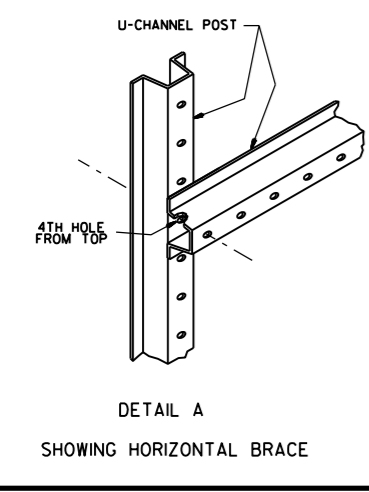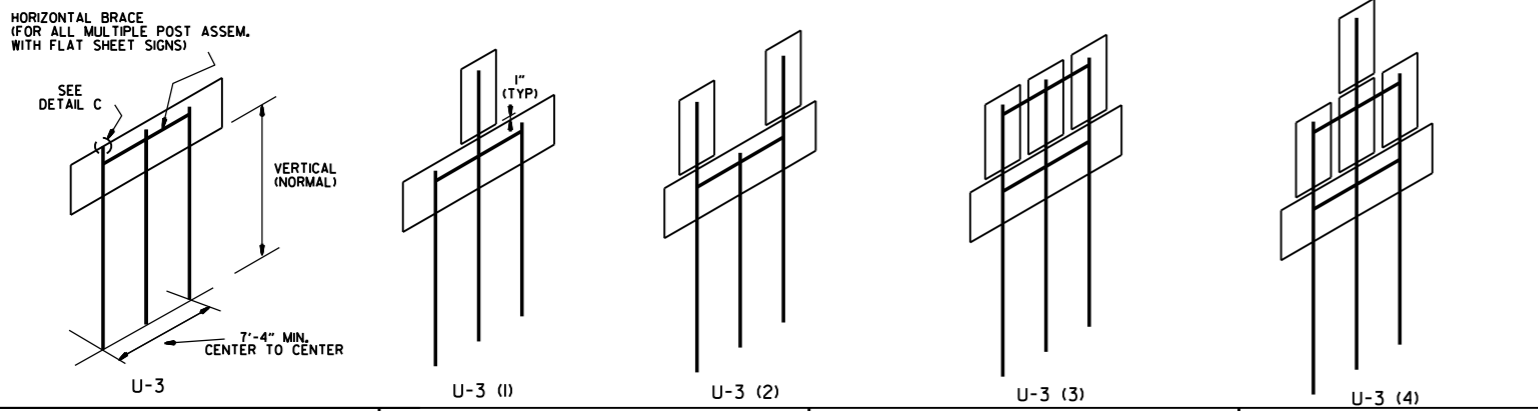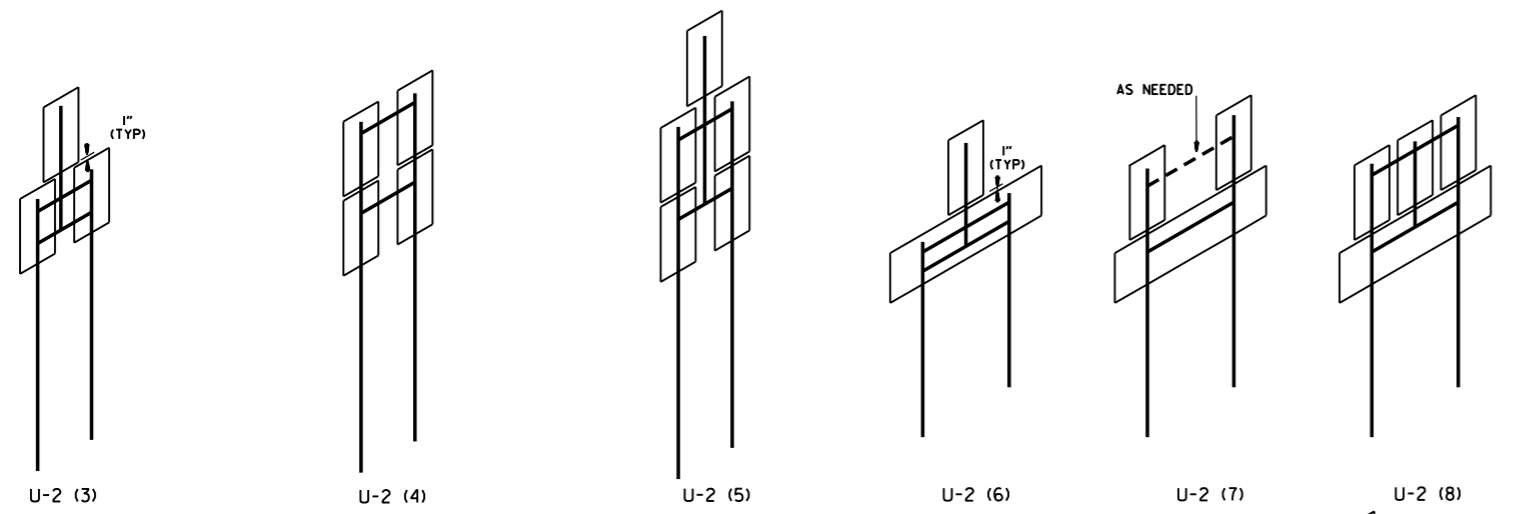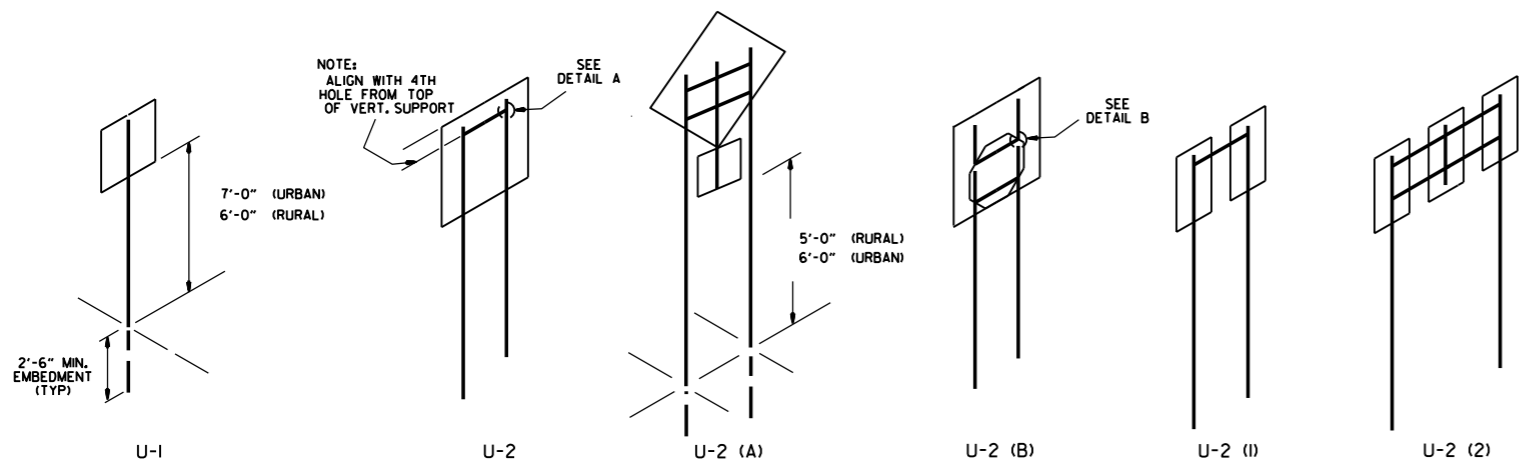

NOTES:


SIGNS AT LEAST 8' IN LENGTH MAY BE INSTALLED ON THREE 3 LB. POST. IN NO CASE SHALL THERE BE MORE THAN TWO 3 LB. POSTS WITHIN A 7' PATH.

SPLICES NECESSARY TO ATTAIN PROPER MOUNTING HEIGHT SHALL BE AS SHOWN IN DETAIL (F).

NORMAL INSTALLATIONS WILL REQUIRE 5/16" DIA. CARRIAGE BOLTS TO MOUNT SIGNS TO POST AND TO ASSEMBLE THE VARIOUS POST SUPPORTS.

ALL SIGN POSTS SHALL BE PLUMB.

THE POST FOR "TYPE U" SUPPORTS SHALL BE HOT DIP GALVANIZED.

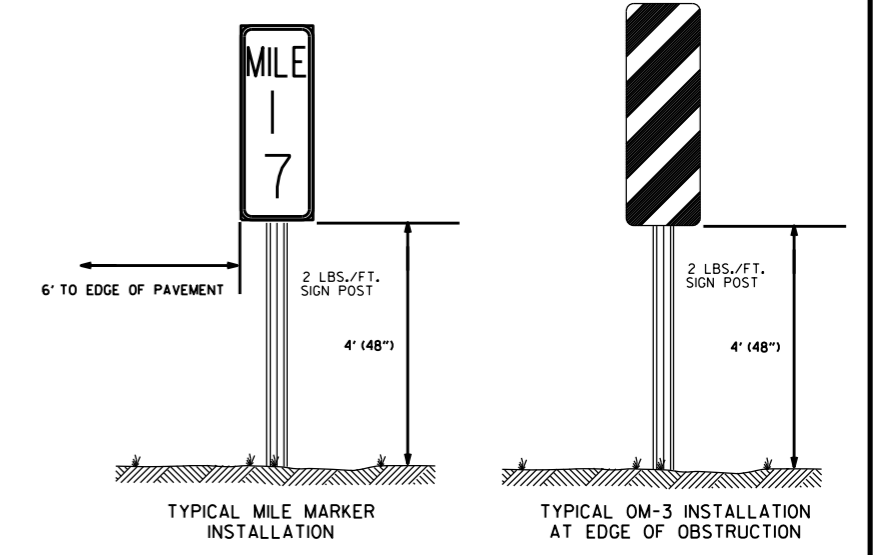


DATE	REVISION	FILED
2-27-14	REVISED NOTES.	
9-12-13	REVISED U-2(3), U-2(6), U-3(I), DETAIL D; ADDED DETAILS E & F; ADDED TYPICAL MARKERS	
10-9-03	REMOVED ROUND POST & REVISED SPACING	
10-12-95	MOVED UPPER SPLICE	
6-8-95	REVISED SPLICE DETAIL	6-8-95
2-2-95	REDRAWN	2-2-95

ARKANSAS STATE HIGHWAY COMMISSION


U-CHANNEL POST ASSEMBLIES

STANDARD DRAWING SHS-2

POST SIZE	BASE CONNECTION DATA											FUSE PLATE DATA											WT. OF EACH FUSE PLATE LBS.
	BOLT SIZE	BOLT TORQUE (INCH/LBS)	A	B	C	D	E	t <sub>1</sub>	t <sub>2</sub>	W	R	F	G	J	K	M	d <sub>1</sub>	d <sub>2</sub>	t <sub>3</sub>	BOLT SIZE			
W 6X9												4 1/4"	2"	4"	2 1/4"	1"	3/16"	3/4"	1/4"	1/2" x 1/2"	1.01		
W 6X12	3/8" x 2 3/4"	450-680	5"	2"	1 1/4"	2 3/4"	1 1/8"	3/4"	1/2"	1/4"	1/32"	5"	2 1/2"	6"	3 1/2"	1 1/2"	1/16"	1/4"	3/8"	3/8" x 2 1/4"	2.51		
W 6X15												5"	2 1/2"	5 1/4"	2 3/4"	1 1/4"	1/16"	1/4"	3/8"	3/8" x 2 1/4"	2.26		
W 8X18												5 1/2"	2 1/2"	5 1/4"	2 3/4"	1 1/4"	1/16"	1/4"	3/8"	3/8" x 2 1/4"	3.35		
W 8X21												6"	3"	5 3/4"	2 3/4"	1 3/8"	1/16"	1/8"	1/2"	3/4" x 2 1/4"	4.03		
W 10X22	3/4" x 3 1/2"	750-1050	6"	2 1/4"	1 3/8"	3 1/2"	1 1/4"	r	3/4"	3/16"	1/32"	6"	3"	6 1/2"	3 1/2"	1 5/8"	1/16"	1/2"	3/4" x 2 1/4"	4.47			
W 10X26												6"	3"	6 1/2"	3 1/2"	1 5/8"	1/16"	1/2"	3/4" x 2 1/4"	4.47			

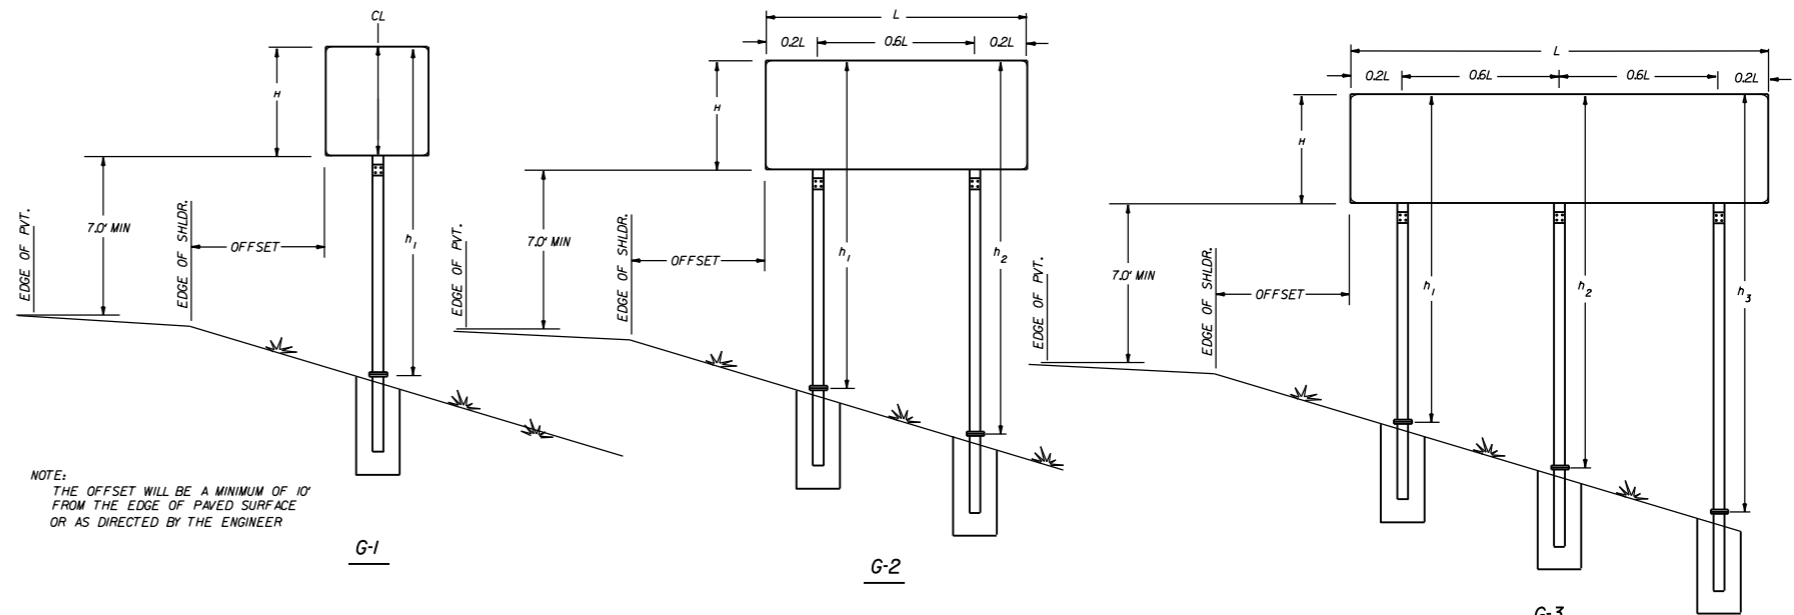


NOTE: THE OFFSET WILL BE A MINIMUM OF 10' FROM THE EDGE OF PAVED SURFACE OR AS DIRECTED BY THE ENGINEER

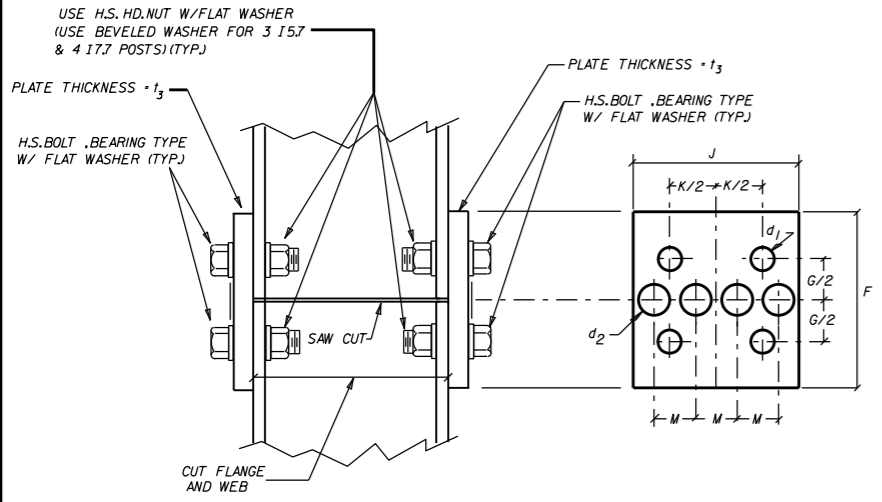



NOTE: SECTIONS SHOWN ARE FOR INSTALLATION ON THE RIGHT SHOULDER AND IN THE GORE. BOLT HOLES IN BASE PLATE ARE SLOTTED AND BEVELED AS SHOWN. USE H.S. BOLTS WITH HEX HD., HEX NUT AND THREE FLAT WASHERS FOR EACH BOLT. SEE TABLE FOR BOLT DIA. AND TORQUE.  
 NOTE: ASSEMBLE SIGN POST TO STUB POST USING THE BOLTS SPEC. IN THE TABLE AND AS SHOWN IN THE ELEVATION DETAILS. THERE SHALL BE THREE FLAT WASHERS ON EACH BOLT LOCATED AS SHOWN IN THE ELEVATIONS. USE A SHIM TO PLUMB THE SIGN POST, THEN TIGHTEN THE BOLTS USING A 12 TO 15" WRENCH UNTIL THE WASHERS AND SHIMS ARE SEATED AND THE BOLT THREADS ARE CLEAR. THEN LOOSEN EACH BOLT IN TURN AND RETIGHTEN IN A SYSTEMATIC ORDER TO THE PRESCRIBED TORQUE (SEE TABLE). THE BURR THREADS ADJACENT TO THE BACK SIDE OF THE NUT TO PREVENT LOOSENING.

NOTE: USE H.S. HEX HEAD BOLTS, HEX HEAD NUTS AND BEVEL OR FLAT WASHERS (WHERE REQ'D) UNDER NUTS. ALL HOLES SHALL BE DRILLED. ALL PLATE CUTS SHALL PREFERABLY BE SAW CUTS. HOWEVER FLAME CUTTING WILL BE PERMITTED PROVIDED ALL EDGES ARE GRIND. METAL PROJECTING BEYOND THE PLANE OF THE PLATE FACE WILL NOT BE PERMITTED. STEEL FUSE PLATES SHALL CONFORM TO THE REQUIREMENTS OF ASTM-A36, ASTM-A441, ASTM-572 GRADE 50, OR ASTM-A588 MAY BE SUBSTITUTED FOR A36 AT THE OPTION OF THE FABRICATOR. STEEL USED SHALL HAVE AN ULTIMATE TENSILE STRENGTH NOT TO EXCEED 80 KSI.


NOTE: BOLT HOLES, USED IN THE MOUNTING OF STANDARD SIGNS SHALL BE LOCATED IN THE FLANGE ADJACENT TO THE NEAR EDGE OF PAVEMENT FOR SINGLE POST ASSEMBLIES AND IN THE OUTSIDE FLANGES FOR MULTIPLE POST ASSEMBLIES.

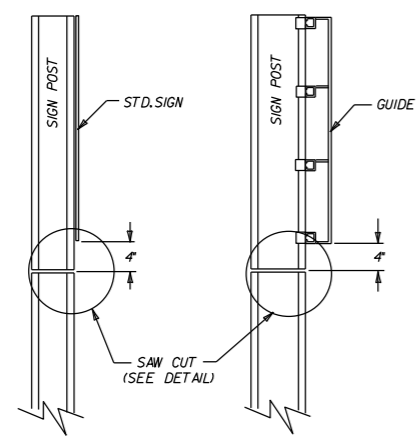

STANDARD SIGNS  
 FUSE PLATE DETAILS  
 GUIDE SIGNS

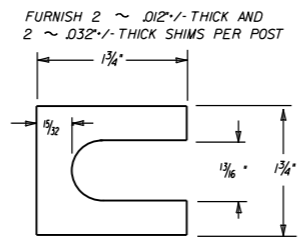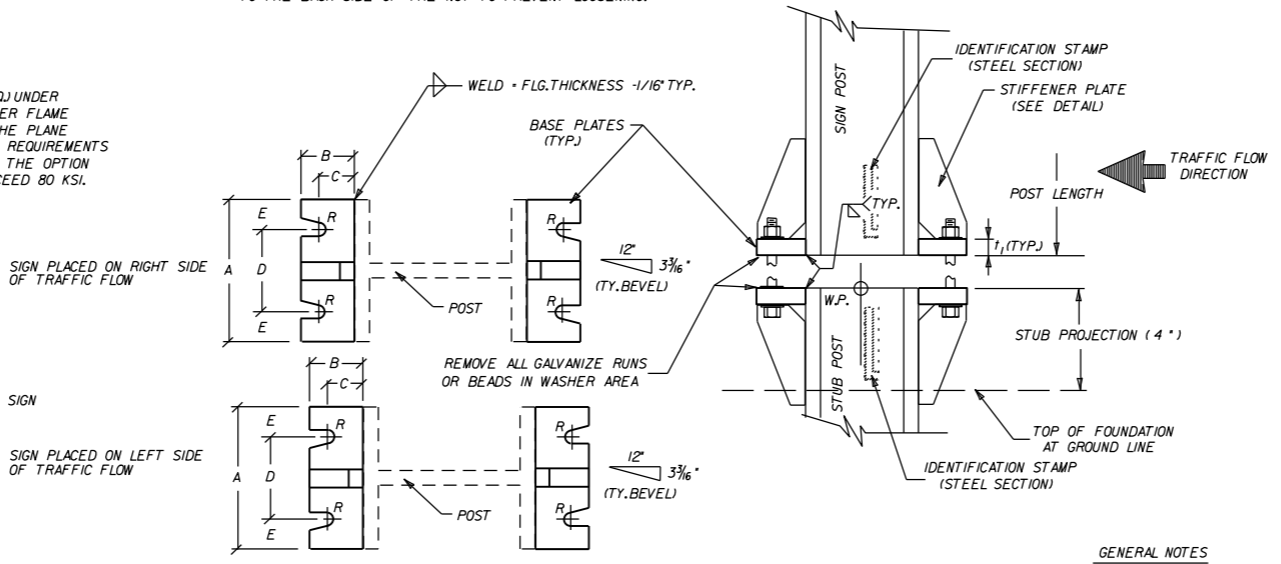

SHIM DETAIL

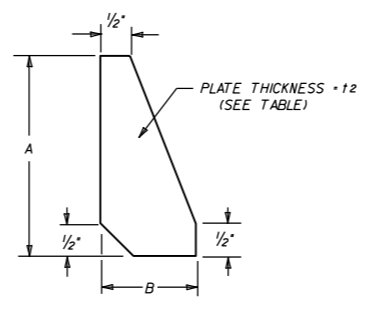


STIFFENER PLATE DETAIL

STEEL SCHEDULE

FOOTING DIAMETER INCHES	#3 TIE BARS		POUNDS
	DIAMETER INCHES	LENGTH FEET	
18	12	4.39	1.65
24	18	5.96	2.24
30	24	7.53	2.83
36	30	9.1	3.42

FOOTING DEPTH FEET	#6 STRAIGHT BARS			POUNDS
	BAR LENGTH FEET	NUMBER	REQ'D.	
2.50	2.00	8	24.03	
3.00	2.50	8	30.04	
3.50	3.00	8	36.05	
4.00	3.50	8	42.06	
4.50	4.00	8	48.06	
5.00	4.50	8	54.07	
5.50	5.00	8	60.08	
6.00	5.50	8	66.09	
6.50	6.00	8	72.10	
7.00	6.50	8	78.10	
7.50	7.00	8	84.11	
8.00	7.50	8	90.12	

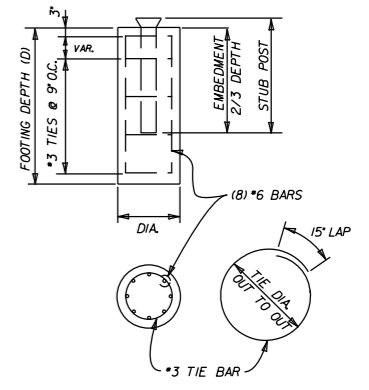


FOOTING QUANTITIES

FOOTING DEPTH FEET	NUMBER TIE BARS REQ'D	18" DIAMETER		24" DIAMETER		30" DIAMETER		36" DIAMETER	
		CLASS S CONCRETE CU. YD.	REINF STEEL (GRADE 60) CU. YD.	CLASS S CONCRETE CU. YD.	REINF STEEL (GRADE 60) CU. YD.	CLASS S CONCRETE CU. YD.	REINF STEEL (GRADE 60) CU. YD.	CLASS S CONCRETE CU. YD.	REINF STEEL (GRADE 60) CU. YD.
		2.50	4	0.16	31				
3.00	4	0.20	37						
3.50	5	0.23	44						
4.00	6	0.26	52	0.47	56				
4.50	6	0.29	58	0.52	62				
5.00	7	0.33	66	0.58	70	0.91	74		
5.50	8			0.64	78	1.00	83		
6.00	8			0.70	84	1.09	89	1.57	93
6.50	9					1.18	98	1.70	103
7.00	10					1.27	106	1.83	112
7.50	10							1.96	118
8.00	11							2.09	128


GENERAL NOTES  
 TIGHTEN THE HIGH STRENGTH BOLTS IN THE BASE CONNECTION ONLY TO THE TORQUE SHOWN. DO NOT OVERTIGHTEN.  
 BASE PLATES AND STIFFENER PLATES SHALL BE OF THE SAME MATERIAL AS THE PRIMARY SUPPORT POSTS WHICH THEY ARE WELDED.  
 REFER TO THE PLANS FOR FOOTING DIMENSIONS.  
 EACH STUB POST AND SIGN POST SHALL HAVE A PERMANENT IDENTIFYING STAMP WHICH SPECIFIES THE STEEL SECTION USED. IF THE CONTRACTOR ELECTS TO SHIP THE STUB POST SEPARATE FROM THE SIGN POST A MATCH MARK SYSTEM WILL BE REQUIRED.

SIGN POST AND STUB POST


ARKANSAS STATE HIGHWAY COMMISSION			
DETAIL OF BREAKAWAY SIGN SUPPORTS FOR GUIDE SIGNS			
STANDARD DRAWING SHS-3			
9-12-13	ISSUED		
DATE	REVISION		FILMED

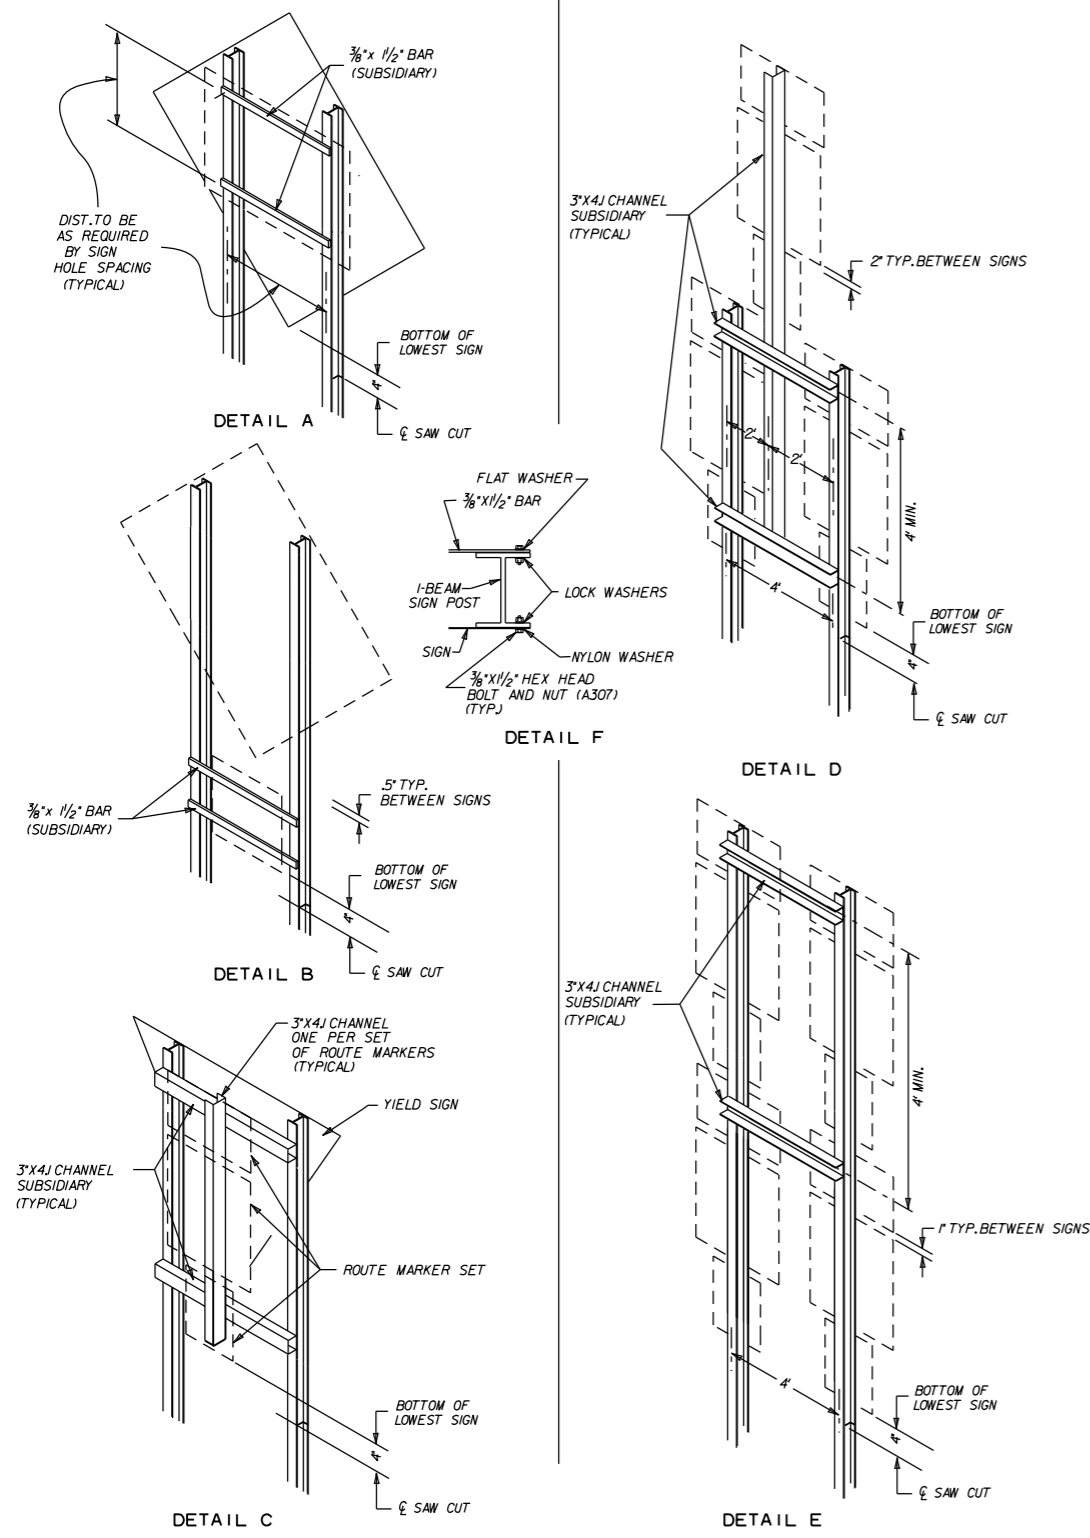


**NOTE**  
 ALL ADDITIONAL MOUNTING HARDWARE, BOLTS, NUTS, CHANNELS AND BAR STRAPS REQUIRED TO MOUNT SECONDARY SIGNS WILL BE CONSIDERED TO BE SUPPLEMENTAL TO THE MAIN SIGN SUPPORT SPECIFIED. PAYMENT WILL BE CONSIDERED SUBSIDIARY TO THE MAIN SUPPORT.  
 THE GALVANIZED STEEL CHANNEL AND BAR SUPPORTS MAY BE ASTM A-36.  
 REFER TO THE P.C. RUTLEDGE FORMULA ON PAGE 58 OF THE AASHTO PUBLICATION "STANDARD SPECIFICATIONS FOR STRUCTURAL SUPPORTS FOR HIGHWAY SIGNS, LUMINAIRES, AND TRAFFIC SIGNALS."  
 ALL BOLT HOLES SHALL BE 1/8" DIA. UNLESS OTHERWISE SHOWN.

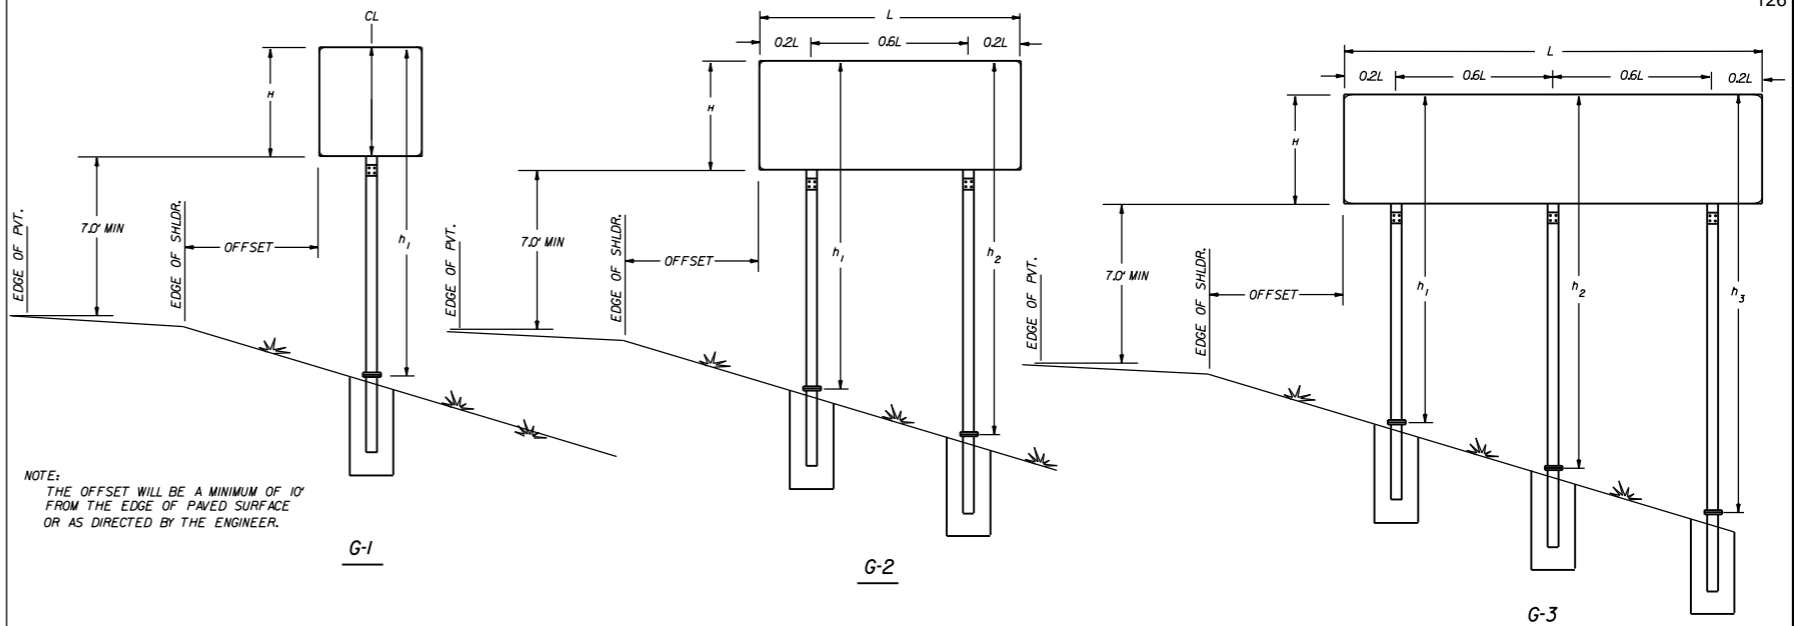


**NOTE:**  
 THE OFFSET WILL BE A MINIMUM OF 10' FROM THE EDGE OF PAVED SURFACE OR AS DIRECTED BY THE ENGINEER.

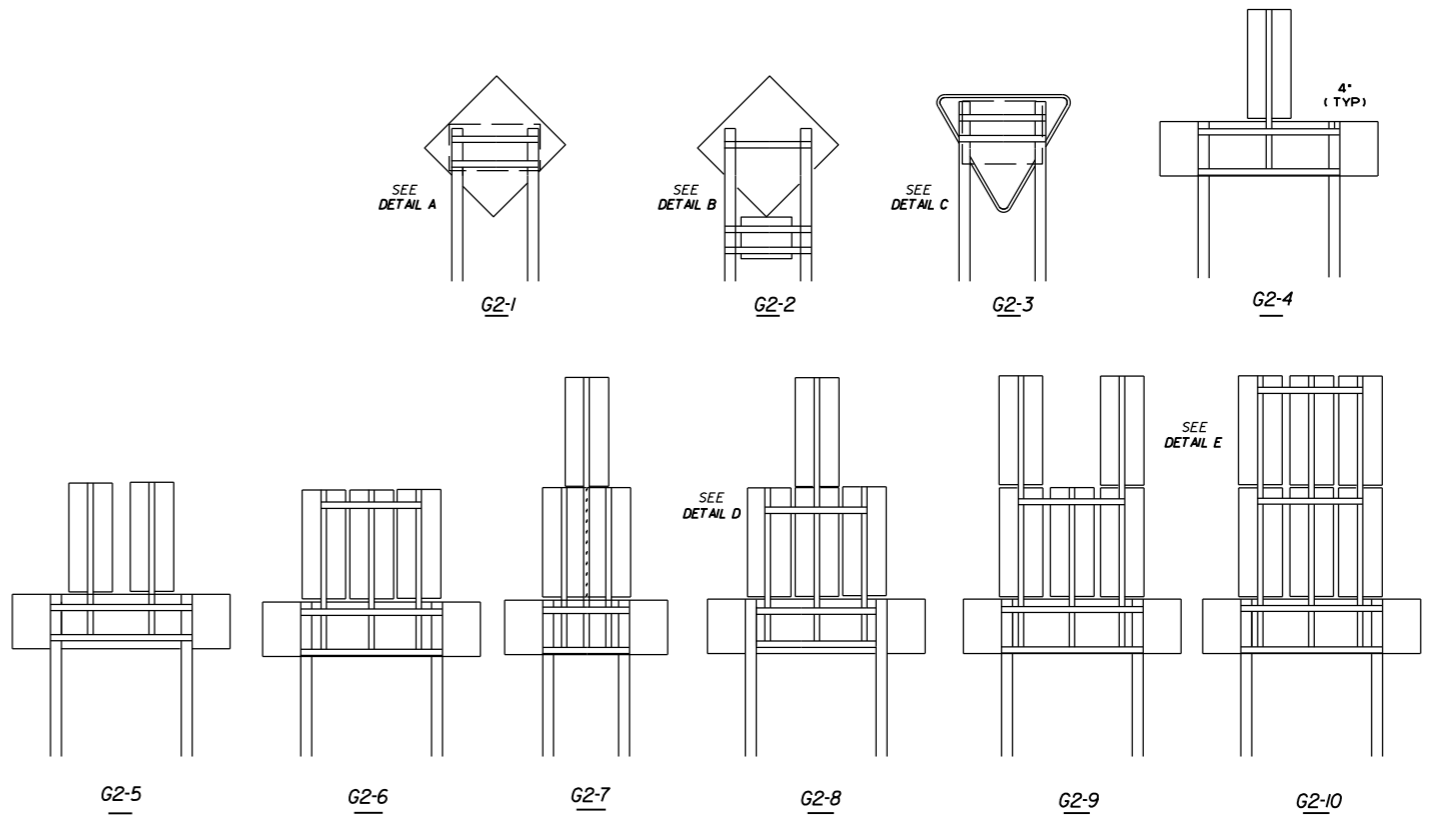


ARKANSAS STATE HIGHWAY COMMISSION			
DETAIL OF BREAKAWAY SIGN SUPPORTS FOR STANDARD SIGNS			
STANDARD DRAWING SHS-4			
9-12-13	ISSUED		
DATE	REVISION		FILMED

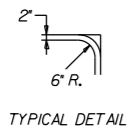


TYPE A

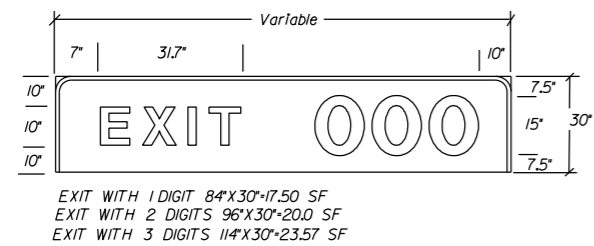

SLOTTED HOLES (7/16" x 7/8")  
DRILLED OR PUNCHED @ 12" O.C.  
BEGINNING 6" FROM ONE END

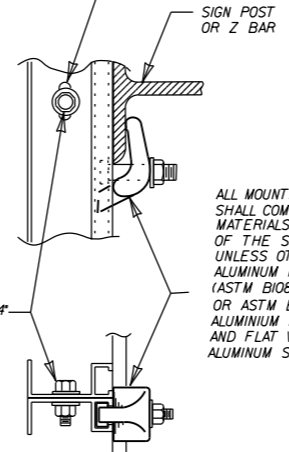


ALL MOUNTING HARDWARE SHALL COMPLY WITH THE MATERIALS SECTION OF 724 OF THE STANDARD SPECIFICATIONS UNLESS OTHERWISE SPECIFIED.  
ALUMINUM POST CLIP (ASTM B108 ALLOY 356-T61 OR ASTM B26 ALLOY 356-T6)  
ALUMINUM POST CLIP BOLT AND FLAT WASHER (3/8"-16x1 3/4")  
ALUMINUM STOP NUT

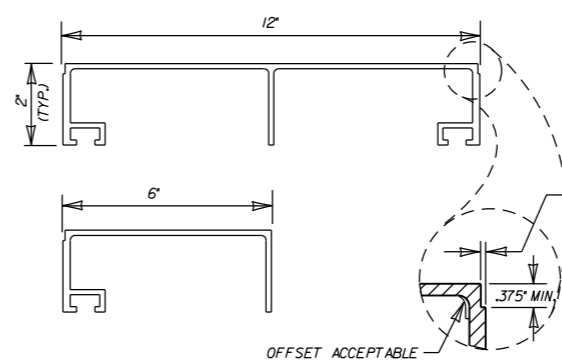



ONE PIECE EXTRUDED SIGN PANELS

USE DOUBLE POST CLIPS AT TOP AND BOTTOM OF SIGN

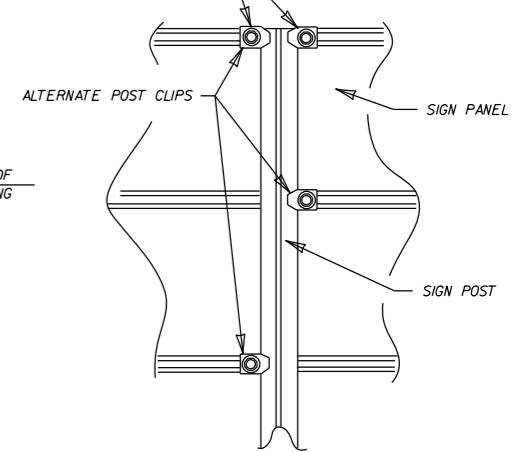


POST CLIP PLACEMENT

TYPE B

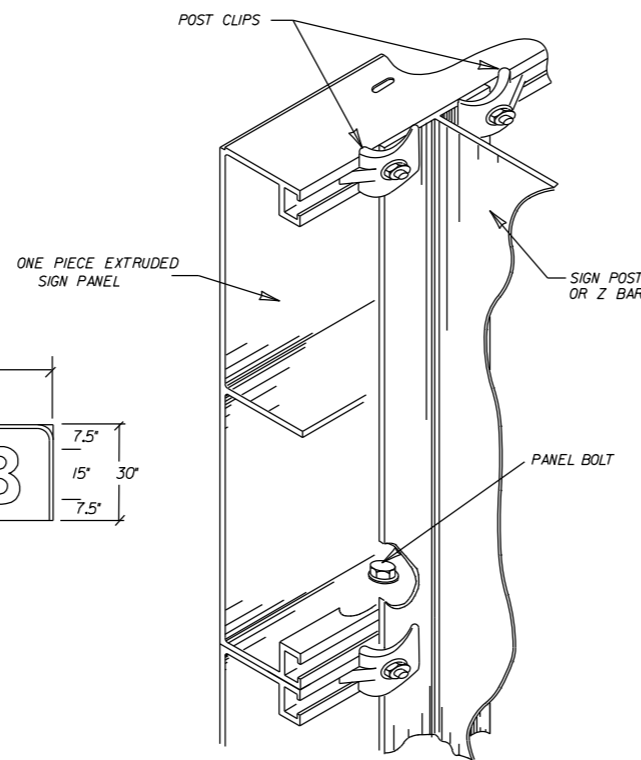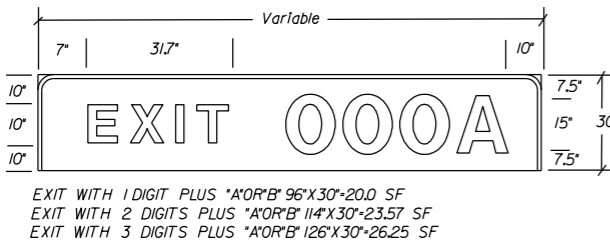


MOUNTING HARDWARE


TYPE C

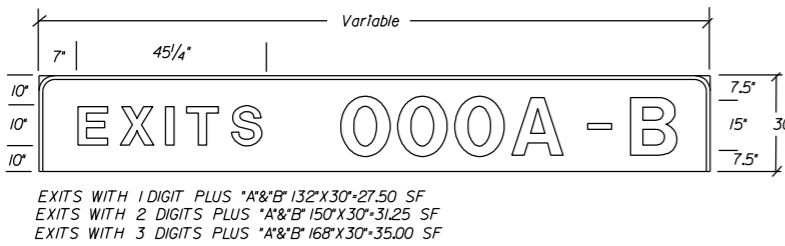

TYPE D


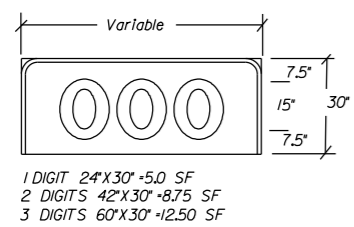


TYPE E

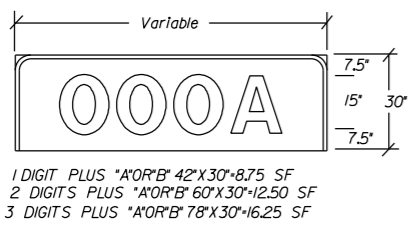

EXIT PANEL DETAILS

NOTE: EXIT NUMBER PANELS SHALL HAVE WHITE LEGENDS AND BORDERS. THE BACK GROUND COLOR WILL BE AS USE SPECIFIES. SHEETING TYPE WILL BE THE SAME AS THE GUIDE SIGN WHICH THE EXIT PANEL IS ATTACHED OR AS SPECIFIED IN THE PLANS. PAYMENT FOR ALL POST CLIPS, BOLTS, AND ANGLES SHALL BE SUBSIDIARY TO THE ITEM "EXIT NUMBER PANEL".


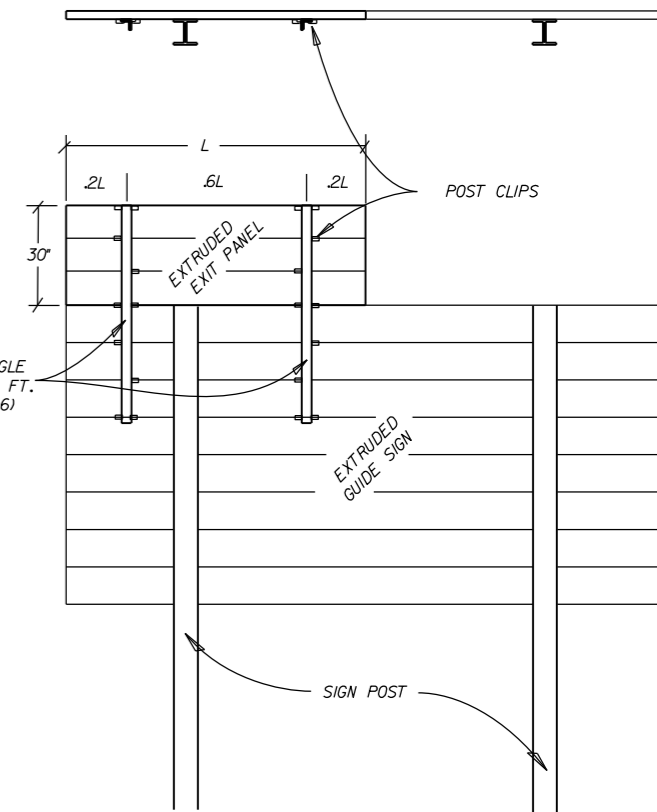
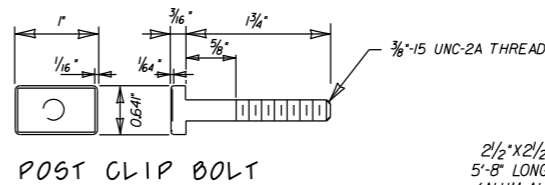


SECONDARY SIGN INSTALLATION ON BACKSIDE OF GUIDE SIGN

		ARKANSAS STATE HIGHWAY COMMISSION	
		DETAILS OF GUIDE SIGN PANELS	
		STANDARD DRAWING SHS-5	
9-12-13	ISSUED		
DATE	REVISION		FILMED

THE CONTRACTOR SHALL DRILL AND POP-RIVET LEGEND, SHIELDS, ARROWS, OR OTHER COPY AS SHOWN.

MOUNTING DETAILS FOR DEMOUNTABLE  
LEGEND ON GUIDE SIGNS

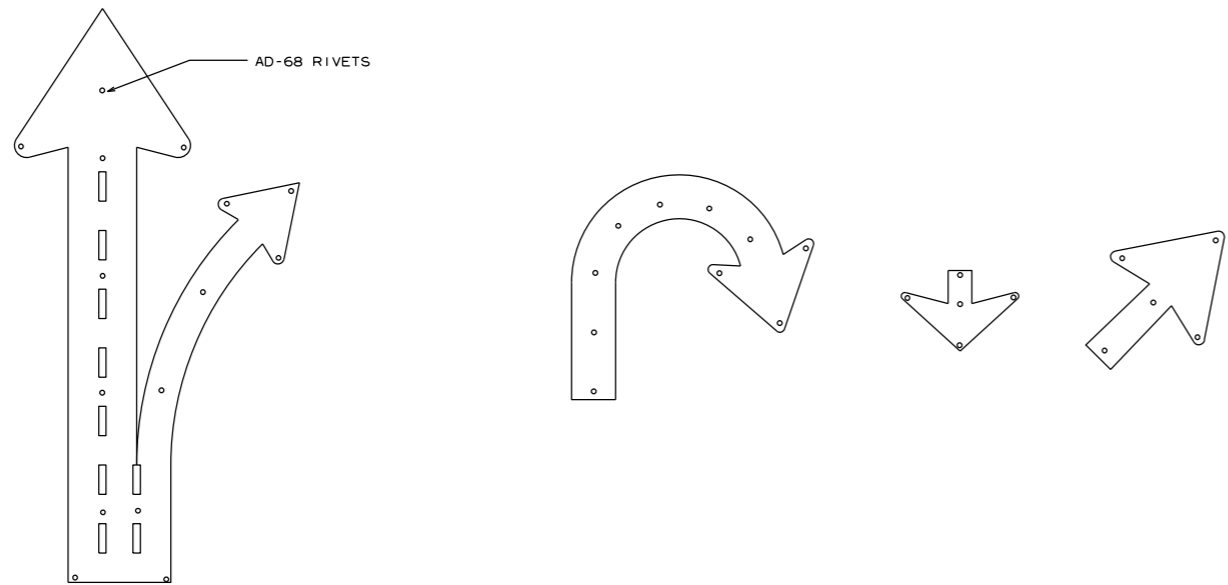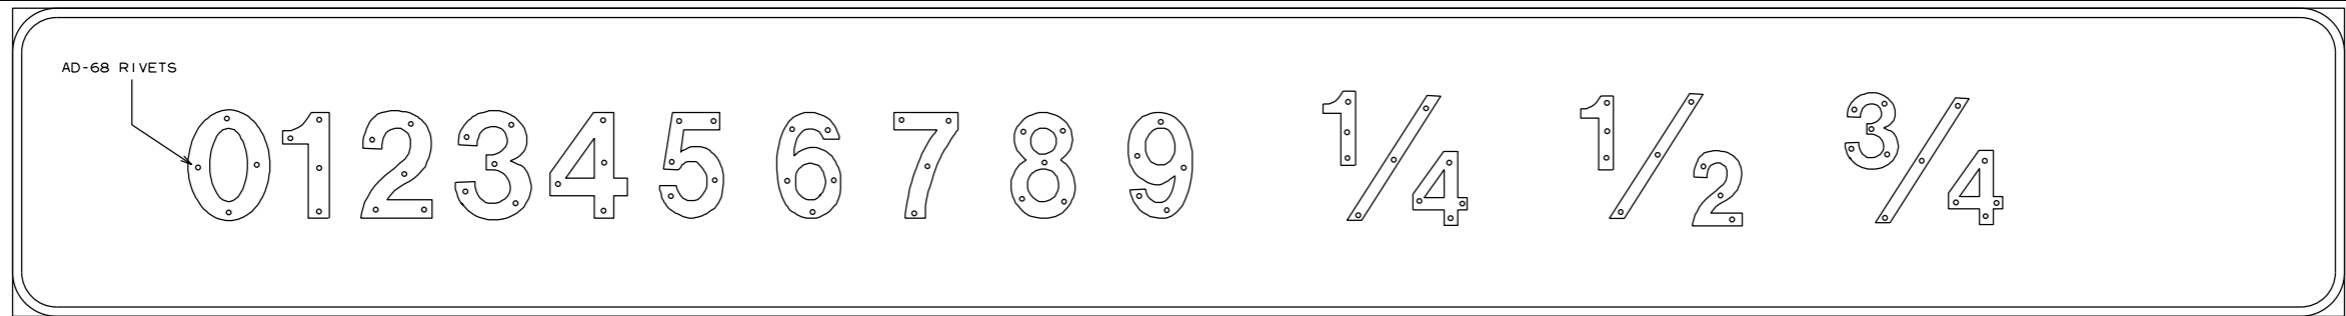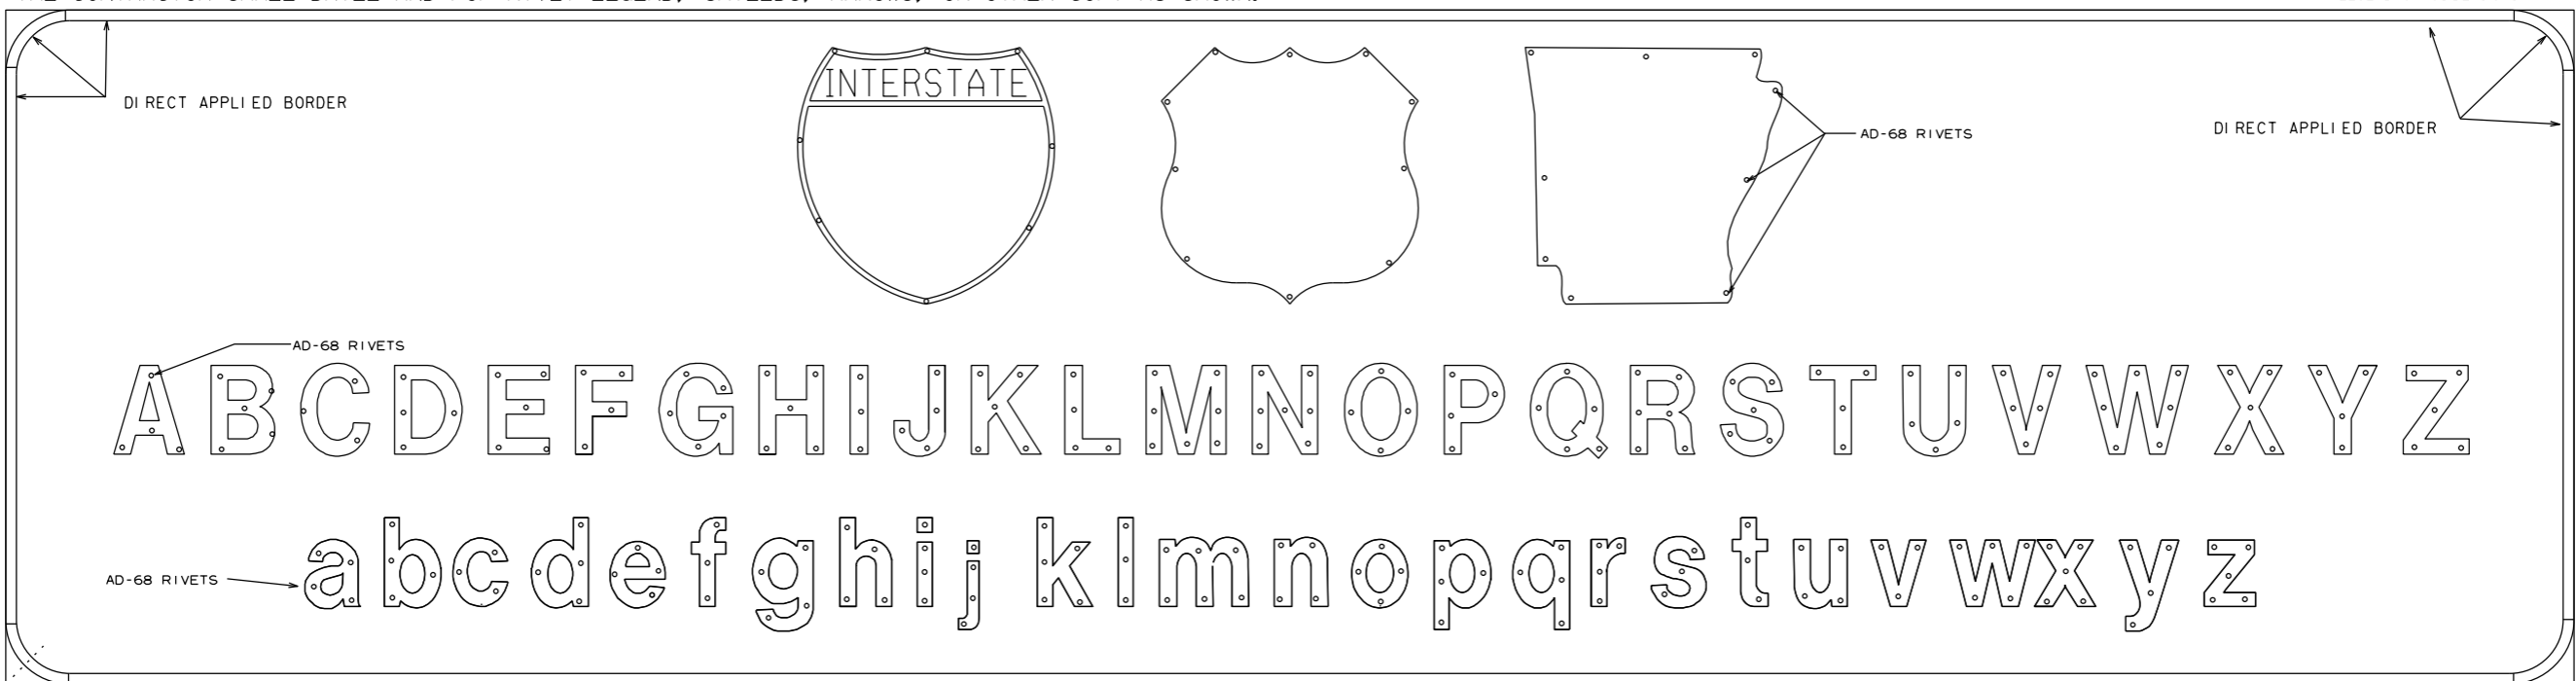

NOTES:

LEGEND ON GUIDE SIGNS ON THE MAIN LANES SHALL BE DEMOUNTABLE LEGEND. LEGEND ON GUIDE SIGNS ON CROSS ROADS AND RAMP SHALL BE DIRECT APPLIED. THE DEMOUNTABLE AND DIRECT APPLIED LEGENDS SHALL BE TYPE IX SHEETING.

THE BACKGROUND ON ALL GUIDE SIGNS AND STANDARD SIGNS SHALL BE CONSTRUCTED USING TYPE III SHEETING.

TYPE IX SHEETING FOR BORDER, LEGEND, SHIELDS, ARROWS, OR OTHER COPY SHALL BE ORIENTED VERTICALLY AS PER MANUFACTURERS' DATUM MARKS, ORIENTATION MARKS, OR OTHER RECOMMENDATIONS.


SIGN LEGEND, SHIELDS, ARROWS OR OTHER COPY SHALL BE APPLIED WITH RIVETS ONLY.

NO OTHER METHOD OF APPLYING CHARACTERS IS ALLOWED.

		ARKANSAS STATE HIGHWAY COMMISSION	
		MOUNTING DETAILS FOR DEMOUNTABLE LEGEND ON GUIDE SIGNS	
9-12-13	ISSUED	REVISION	FILMED
DATE			

STANDARD DRAWING SHS-6




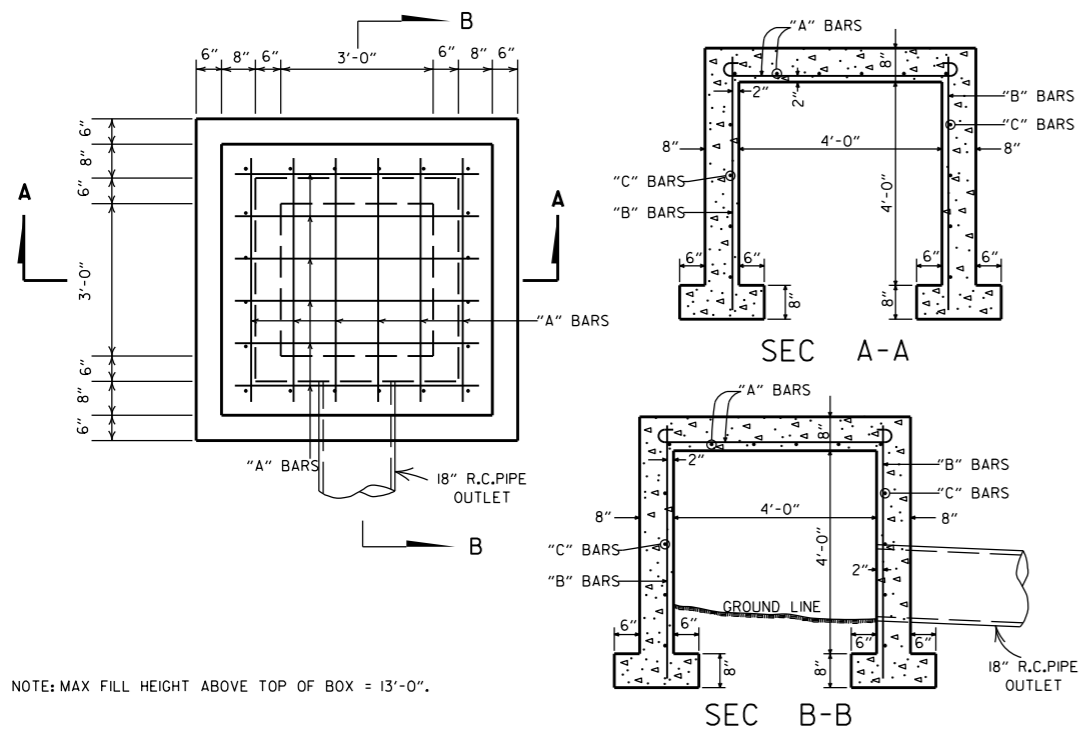

NOTE: MAX FILL HEIGHT ABOVE TOP OF BOX = 13'-0".

STEEL SCHEDULE

BARS	NUMBER	LENGTH	SPACING
"A"	12	6'-0"	10"
"B"	20	5'-0"	10 1/2"
"C"	16	5'-0"	12"

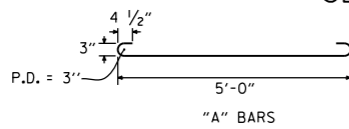


QUANTITIES  
 "A" BARS  
 CONCRETE 3.31 CU. YDS.  
 REINFORCING STEEL 168 LB.


GENERAL NOTE:  
 THE PAY ITEMS FOR REINFORCED CONCRETE SPRING BOXES SHALL BE FOR THE QUANTITIES OF CONCRETE OF THE CLASS SPECIFIED, REINFORCING STEEL, EXCAVATION FOR STRUCTURES AND 18" R.C. PIPE CULVERT.

**REINFORCED CONCRETE SPRING BOX**


ALL STEEL TO BE #4 BARS

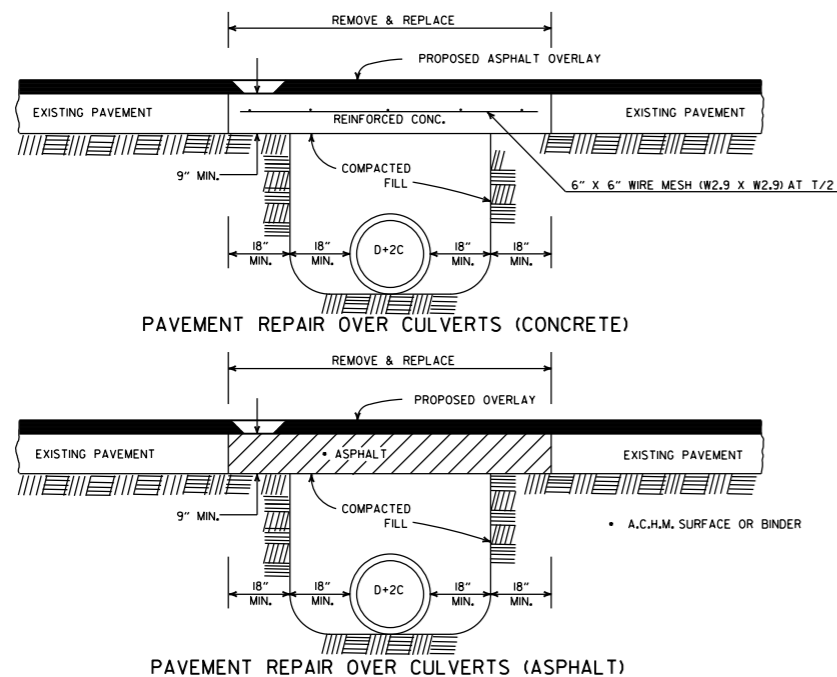


**DETAIL SHOWING REPAIR OF EXISTING PAVEMENT AT CULVERT INSTALLATIONS**

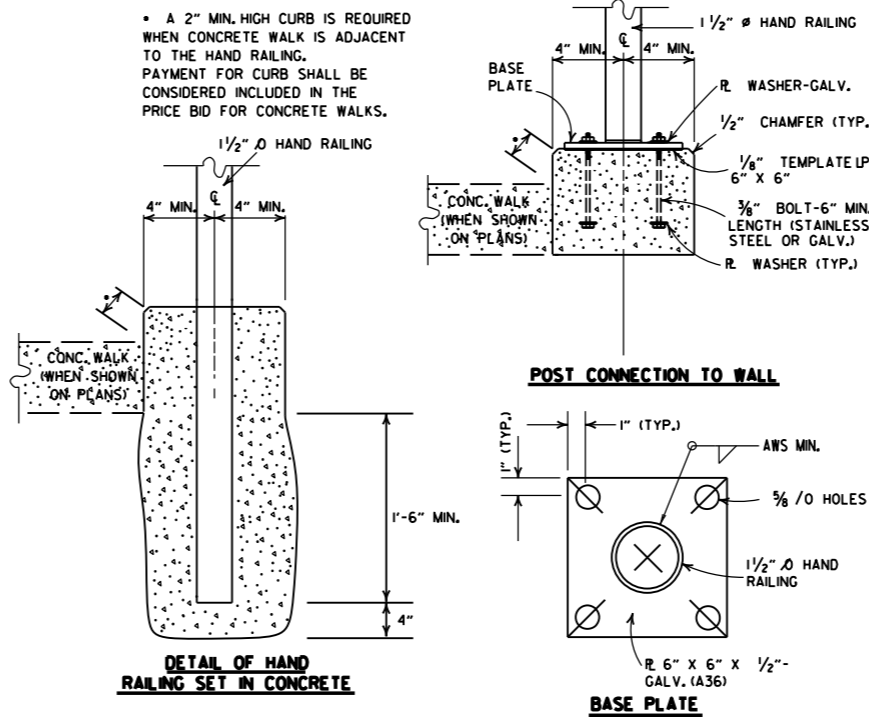

**POST CONNECTION DETAILS**

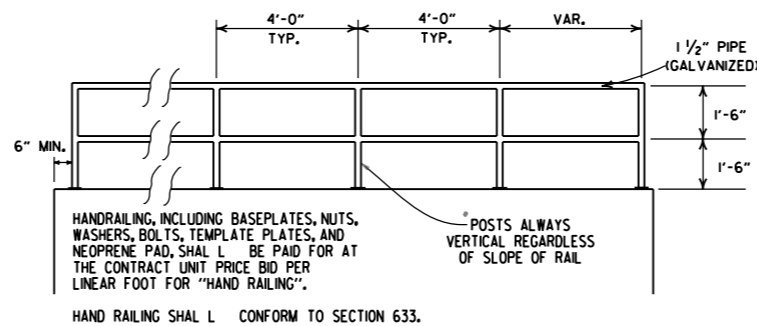


HAND RAILING SHALL CONFORM TO SECTION 633.

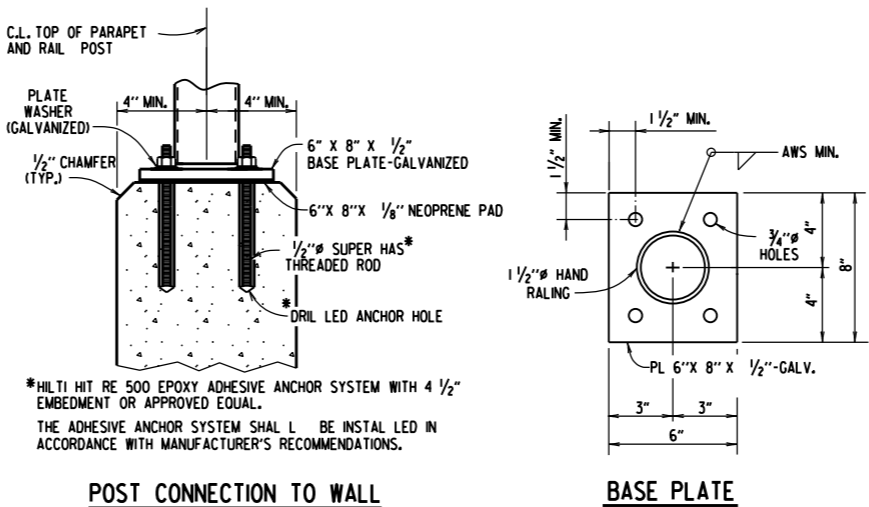

**DETAILS OF ALTERNATE POST ANCHOR SYSTEM (EPOXY ADHESIVE ANCHORS)**

**HAND RAILING DETAILS**

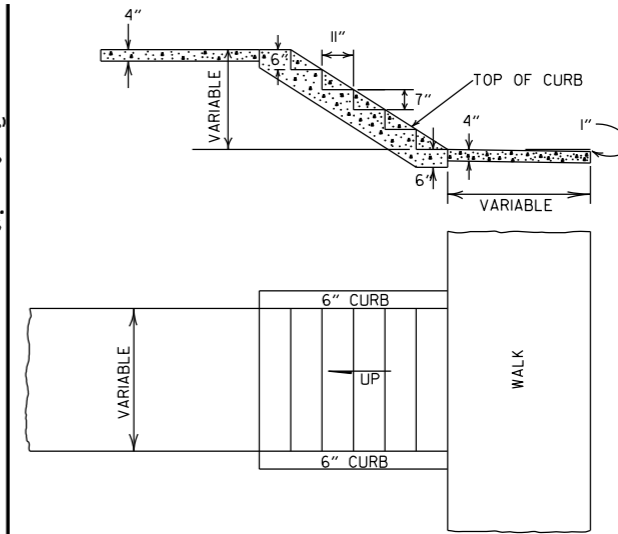

**DETAILS OF CONCRETE STEPS & WALKS**


GENERAL NOTES  
 1. RISE AND TREAD DIMENSIONS OF STEPS MAY BE VARIED AS DIRECTED BY THE ENGINEER, HOWEVER, TREAD WIDTHS SHALL BE 11" MIN. ALL STEPS IN A FLIGHT SHALL HAVE CONSISTENT TREAD & RISER DIMENSIONS.  
 2. 1" TRANSVERSE EXPANSION JOINTS SHALL BE PLACED IN CONCRETE WALKS AT 45' INTERVALS.

DATE	REVISION	DATE FILMED
9-12-13	REVISED REINFORCED CONCRETE SPRING BOX	
7-26-12	REMOVED RETAINING WALL DETAILS & REVISED HAND RAILING DETAILS	
4-17-08	REV. JOINT & FOOTING STEP DETAILS	
11-29-07	REVISED RETAINING WALL DRAINAGE	
5-25-06	REVISED PVMT REPAIR OVER CULVERTS (CONC); REVISED REINFORCED CONG SPRING BOX	
10-9-03	REVISED PIPE RAILING DETAILS TO HAND RAILING DETAILS	
4-10-03	REVISED RETAINING WALL DRAWING	
8-22-02	ADDED HAND RAILING DETAIL	
11-16-01	REVISED PVMT REPAIR OVER CULVERTS (CONC); CORRECTED SPELLING IN GENERAL NOTES	
11-18-98	ADDED GENERAL NOTES TO CONCRETE STEPS & WALKS	
7-02-98	ENLARGED PIPE	
4-03-97	ADDED NOTE TO STEEL BAR SCHED.	
10-18-96	CORRECTED SPELLING	
4-26-96	ADD WEEP HOLE; REV. JOINT SPACING IN RET. WALL	
6-2-94	CHANGED CONST. TO CONTRACTION JOINT	
10-1-92	CHANGED MESH FABRIC TO WIRE MESH	10-1-92
8-15-91	DELETED HDWL MODIFICATION DETAIL	8-15-91
11-8-90	DELETED COLD MIX FROM CULV'T. REPAIR	11-8-90
11-30-89	REV. RETAINING WALL STEEL SCHEDULE	11-30-89
11-17-88	V. BARS BEHIND ARROW	665-11-17-88
7-15-88	REV. PAVEMENT REPAIR	649-7-15-88
11-1-84	ADDED HDWL. MODS, DEL. PIPE UNDERDRAINS	
1-4-83	REV. TRENCH FOR PIPE UNDERDRAIN	510-11-1-84
	ELIMINATED CONG. CLASS & ADDED CHAMFER NOTE	682-1-4-83
3-2-81	SPELLING OF "UNDERDRAIN"	721-3-2-81
4-20-79	REV. UNDERDRAIN DET & PAVEMENT REPAIR	674-4-20-79
2-2-76	12" MIN. GRAN. MAT'L. OVER PIPE	919-2-2-76
4-10-75	REM. SPECS. FOR GRAN. MAT'L.	568-4-10-75-853
5-22-74	GRANULAR MAT'L. TO BE SB-3	567-5-22-74-740
10-2-72	REVISED AND REDRAWN	564-10-16-72


ARKANSAS STATE HIGHWAY COMMISSION

**DETAILS OF SPECIAL ITEMS**


STANDARD DRAWING SI - 1

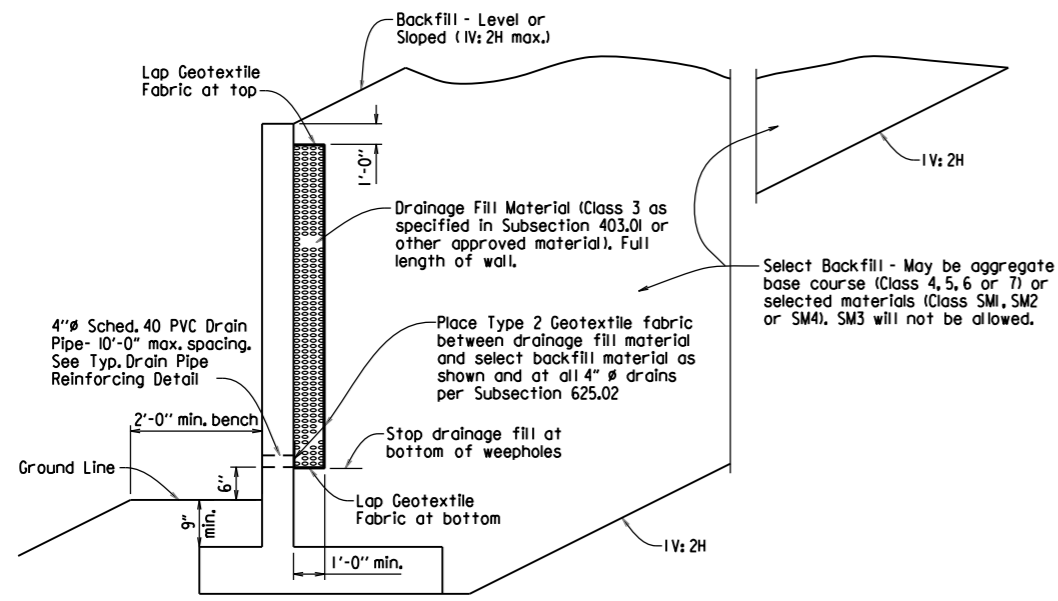

**TYPICAL DRAINAGE & BACKFILL DETAILS**  
N.T.S.

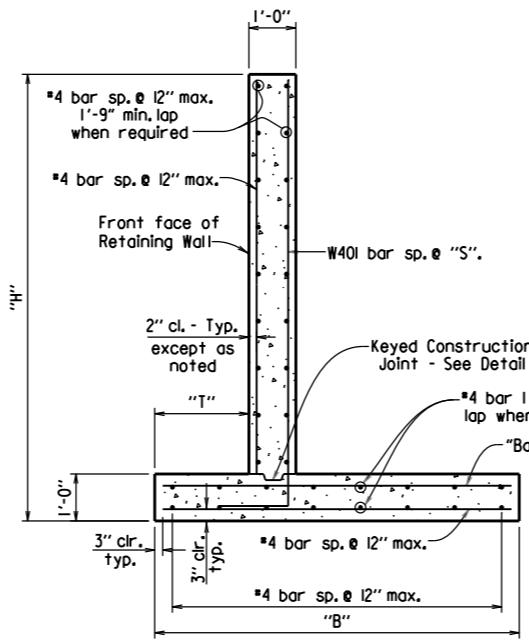


**TYPICAL SECTION**  
N.T.S.

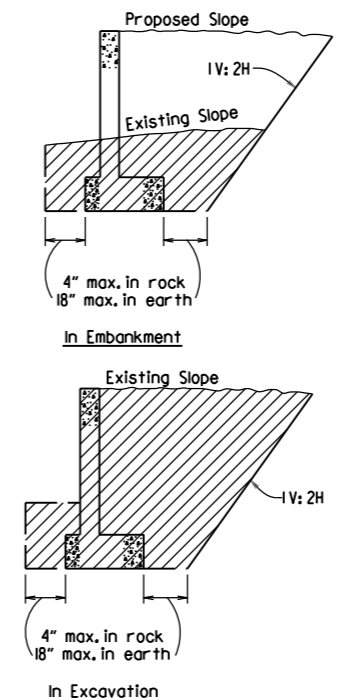


NOTE: Hatched area denotes maximum limits of pay excavation.

**DETAILS OF EXCAVATION**  
N.T.S.

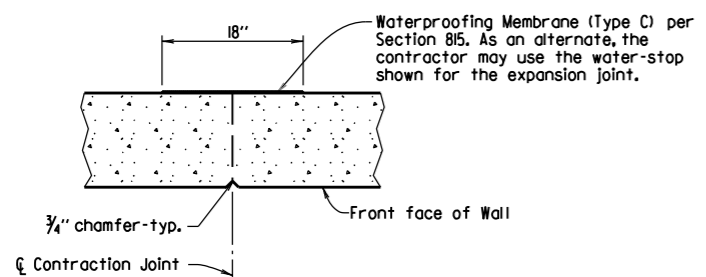


**TYPICAL CONTRACTION JOINT DETAIL**  
N.T.S.

Note: 20'-0" Max. Spacing between Contraction Joints. Horizontal reinforcement shall be continuous through Contraction joints.

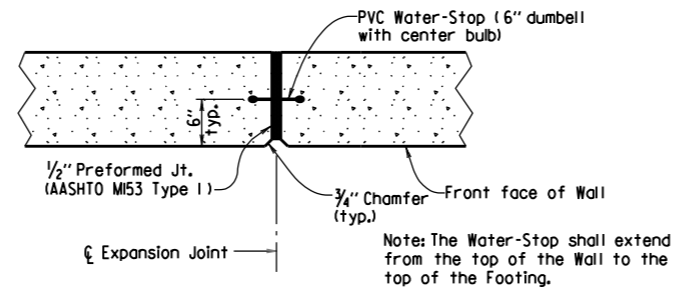


**TYPICAL EXPANSION JOINT DETAIL**  
N.T.S.

Note: 60'-0" Max. Spacing between Expansion Joints. Horizontal reinforcement shall stop 2" from Expansion Joint.

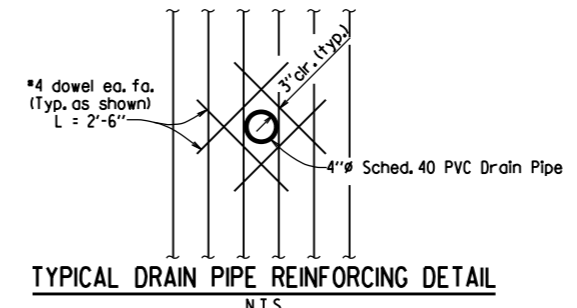

**TYPICAL DRAIN PIPE REINFORCING DETAIL**  
N.T.S.

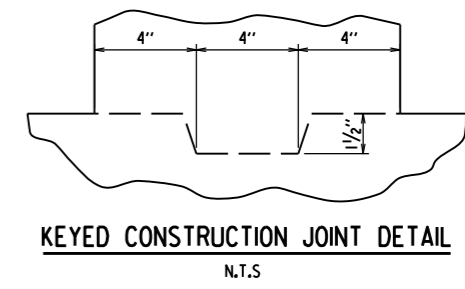

**KEYED CONSTRUCTION JOINT DETAIL**  
N.T.S.

**SEISMIC ZONE:** These walls have been designed for the following site adjusted peak ground accelerations ( $A_S$ ):  
Level Backfill -  $A_S \leq .40g$   
Sloped Backfill (1V:2H max.) -  $A_S \leq .30g$


**TABLE OF RETAINING WALL VARIABLES (LEVEL BACKFILL)**

"H"	"T"	"B"	"S"	"Bar A" Size & Spacing
3'-0"	9"	2'-6"	12"	#4 @ 12"
4'-0"	9"	3'-6"	12"	#4 @ 12"
5'-0"	9"	4'-0"	12"	#4 @ 12"
6'-0"	9"	4'-6"	12"	#4 @ 12"
7'-0"	9"	5'-6"	12"	#4 @ 10"
8'-0"	9"	6'-0"	12"	#5 @ 10"
9'-0"	1'-0"	7'-0"	12"	#5 @ 6 1/2"


**TABLE OF RETAINING WALL VARIABLES (SLOPED BACKFILL) (1V:2H MAX.)**

"H"	"T"	"B"	"S"	"Bar A" Size & Spacing
3'-0"	9"	2'-6"	12"	#4 @ 12"
4'-0"	9"	3'-6"	12"	#4 @ 12"
5'-0"	9"	4'-6"	12"	#4 @ 12"
6'-0"	9"	5'-6"	12"	#4 @ 6"
7'-0"	9"	6'-6"	12"	#5 @ 6 1/2"
8'-0"	1'-6"	8'-0"	7 1/2"	#6 @ 6"
9'-0"	1'-11"	9'-6"	5"	#8 @ 6"

**BENDING DIAGRAMS**

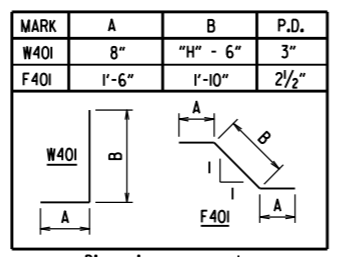

Dimensions are out to out of bars.

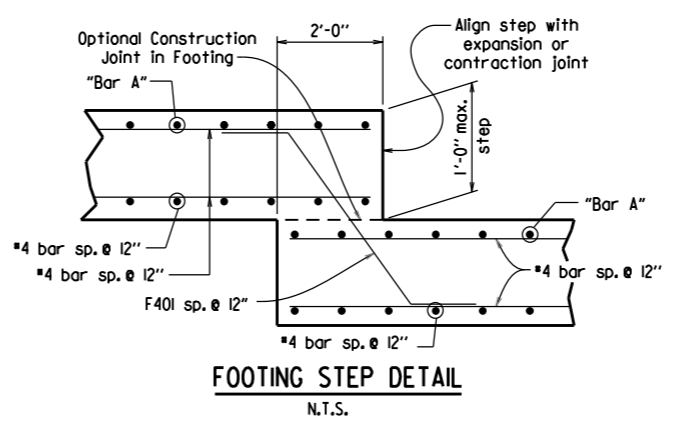

**FOOTING STEP DETAIL**  
N.T.S.


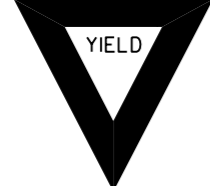

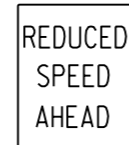

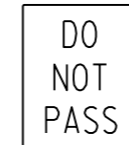



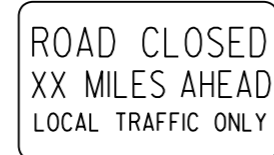
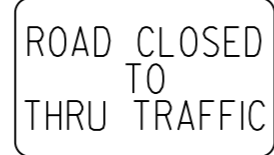

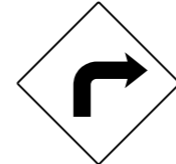



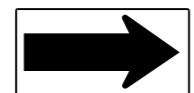

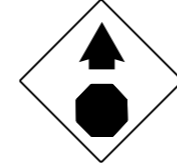

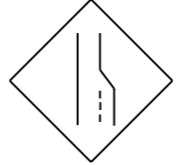



















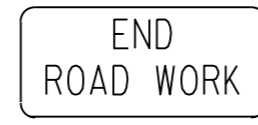
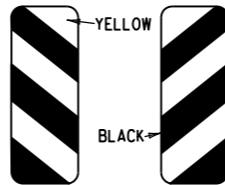



DATE	REVISION	DATE FILMED
2-27-14	REVISED GENERAL NOTES.	
7-26-12	DRAWING ISSUED	

ARKANSAS STATE HIGHWAY COMMISSION

**REINFORCED CONCRETE RETAINING WALL (WITHOUT LIVE LOAD SURCHARGE)**

STANDARD DRAWING SI - 2

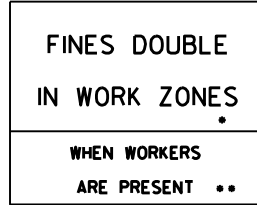

<p>RI-1</p>  <p>STANDARD 30"x30" EXPRESSWAY 36"x36" SPECIAL 48"x48"</p>	<p>RI-2</p>  <p>STD. 36"x36"x36" EXPWY. 48"x48"x48" FWY. 60"x60"x60"</p>	<p>R2-1</p>  <p>STD. 24"x30" EXPWY. 36"x48" FWY. 48"x60"</p>	<p>R2-5A</p>  <p>STD. 24"x30" EXPWY. 36"x48" FWY. 48"x60"</p>	<p>R2-5C</p>  <p>STD. 24"x30" EXPWY. 36"x48" FWY. 48"x60"</p>	<p>R4-1</p>  <p>STD. 24"x30" EXPWY. 36"x48" FWY. 48"x60"</p>	<p>R4-2</p>  <p>STD. 24"x30" EXPWY. 36"x48" FWY. 48"x60"</p>	
<p>R5-1</p>  <p>STD. 30"x30" EXPWY. 36"x36" SPECIAL 48"x48"</p>	<p>R11-2</p>  <p>48"x30"</p>	<p>R11-3A</p>  <p>60"x30"</p>	<p>R11-4</p>  <p>60"x30"</p>	<p>RSP-1</p>  <p>48"x30"</p>	<p>WI-1</p>  <p>STD. 36"x36" FWY. 48"x48"</p>	<p>WI-2</p>  <p>STD. 36"x36" FWY. 48"x48"</p>	
<p>WI-3</p>  <p>STD. 48"x48"</p>	<p>WI-4</p>  <p>STD. 48"x48"</p>	<p>WI-6</p>  <p>STD. 48"x24" SPECIAL 60"x30"</p>	<p>WI-8</p>  <p>STD. 18"x24" SPECIAL 24"x30" EXPWY. 30"x36" FWY. 36"x48"</p>	<p>W3-1</p>  <p>STD. 36"x36" SPECIAL 48"x48"</p>	<p>W3-2</p>  <p>STD. 36"x36" SPECIAL 48"x48"</p>	<p>W4-2</p>  <p>STD. 36"x36" FWY. 48"x48"</p>	
<p>W5-1</p>  <p>STD. 36"x36" SPECIAL 48"x48"</p>	<p>W6-3</p>  <p>EXPWY. 36"x36" SPECIAL 48"x48"</p>	<p>W8-7</p>  <p>EXPWY. 36"x36" FWY. 48"x48"</p>	<p>W9-2</p>  <p>STD. 36"x36" FWY. 48"x48"</p>	<p>W13-1</p>  <p>STD. 24"x24"</p>	<p>W20-1</p>  <p>STD. 48"x48"</p>	<p>W20-2</p>  <p>STD. 48"x48"</p>	<p>W20-3</p>  <p>STD. 48"x48"</p>
<p>W20-4</p>  <p>STD. 48"x48"</p>	<p>W20-5</p>  <p>STD. 48"x48"</p>	<p>W20-7a</p>  <p>18" 500 FEET 24" W16-2</p> <p>STD. 36"x36" FWY. 48"x48"</p>	<p>W21-2</p>  <p>STD. 30"x30" SPECIAL 36"x36"</p>	<p>W21-5</p>  <p>STD. 30"x30" SPECIAL 36"x36"</p>	<p>W24-1</p>  <p>STD. 36"x36"</p>	<p>WI-4b</p>  <p>STD. 48"x48"</p>	<p>R56-1</p>  <p>STD. 18"x18"</p>
<p>W8-11</p>  <p>STD. 36"x36" FWY. 48"x48"</p>	<p>W8-9</p>  <p>STD. 36"x36" FWY. 48"x48"</p>	<p>G20-1</p>  <p>60"x24"</p>	<p>G20-2</p>  <p>48"x24"</p>	<p>OM-3L OM-3R</p>  <p>12"x36"</p>	<p>M4-9</p>  <p>STD. 30"x24" SPECIAL 48"x36" SPECIAL 60"x48"</p>	<p>M4-10</p>  <p>48"x18"</p>	<p>R55-1</p>  <p>36"x60"</p> <p>• USE 6" C LETTERS •• USE 4" D LETTERS</p>

ADVANCE DISTANCES (XXXX)

500 FT	1/2 MILE
1000 FT	3/4 MILE
1500 FT	1 MILE AHEAD


GENERAL NOTES:

- ALL TRAFFIC CONTROL DEVICES USED ON ROAD CONSTRUCTION SHALL CONFORM TO THE MANUAL ON UNIFORM TRAFFIC CONTROL DEVICES, LATEST EDITION, AND TO THE STANDARD HIGHWAY SIGNS, LATEST EDITION, OR AS APPROVED BY THE FEDERAL HIGHWAY ADMINISTRATION.
- TRAFFIC CONTROL DEVICES SHALL BE SET UP JUST BEFORE THE START OF CONSTRUCTION OPERATIONS AND SHALL BE PROPERLY MAINTAINED DURING THE TIME SUCH CONDITIONS EXIST. THEY SHALL REMAIN IN PLACE ONLY AS LONG AS NEEDED AND REMOVED THEREAFTER.
- EXISTING SIGNS AND CONSTRUCTION SIGNS SHALL BE KEPT IN PROPER POSITION, AND BE CLEAN AND LEGIBLE AT ALL TIMES. SIGNS THAT DO NOT APPLY TO EXISTING CONDITIONS SHALL BE REMOVED. SIGNS THAT ARE DAMAGED, DEFACED, OR THAT ACCUMULATE DIRT DURING CONSTRUCTION SHALL BE CLEANED, REPAIRED, OR REPLACED.
- SIGNS ARE USUALLY MOUNTED ON A SINGLE POST, ALTHOUGH THOSE WIDER THAN 36" OR LARGER THAN 10 SO.FT. SHALL BE MOUNTED ON TWO POSTS OR ABOVE A TYPE III BARRICADE.
- SIGN POSTS DIRECT BURIED IN SOIL SHALL BE 2 LB. MINIMUM CHANNEL POST OR 4"x4" WOOD POSTS. CHANNEL POSTS SHALL BE PAINTED GREEN. WOOD POSTS SHALL BE PAINTED WHITE. ALL POSTS SHALL BE NEATLY CONSTRUCTED, AND SHALL BE REPLUMBED, CLEANED, OR REPAIRED AS NEEDED FOR THE DURATION OF THE JOB. THERE SHALL NOT BE MORE THAN 2 POSTS IN A 7' PATH FOR WOOD OR CHANNEL POSTS. ANY CHANNEL POST SPLICE SHALL BE IN ACCORDANCE WITH STANDARD DRAWING TC-3.
- POST MOUNTED SIGNS IN RURAL AREAS SHALL BE CONSTRUCTED WITH THE NEAR EDGE OF THE SIGN FROM 6 TO 12 FEET FROM THE PAVEMENT EDGE. SIGNS IN URBAN AREAS AND BARRICADE MOUNTED SIGNS SHALL BE MOUNTED A MINIMUM OF 2 FEET FROM THE PAVEMENT EDGE.
- ALL POST AND BARRICADE MOUNTED SIGNS MOUNTED IN URBAN AREAS SHALL BE MOUNTED A MINIMUM DISTANCE OF 7' FROM THE BOTTOM OF THE SIGN TO THE ROADWAY SURFACE. ALL POST AND BARRICADE MOUNTED SIGNS MOUNTED IN RURAL AREAS SHALL BE MOUNTED A MINIMUM DISTANCE OF 7' FROM THE BOTTOM OF THE SIGN TO THE ROADWAY SURFACE. EXCEPT A MINIMUM OF 6' SHALL BE USED WHEN MOUNTING AN ADVISORY SIGN BELOW A WARNING SIGN. TEMPORARY SIGNS MAY BE MOUNTED ON PORTABLE SUPPORTS FOR INTERMEDIATE TERM STATIONARY WORK CONDITIONS. THE SIGNS MINIMUM MOUNTING HEIGHT SHALL BE 5'. RETROREFLECTIVE DEVICES SHALL BE USED. TEMPORARY SIGNS MAY BE MOUNTED ON PORTABLE SUPPORTS FOR SHORT-TERM, SHORT DURATION, AND MOBILE CONDITIONS. THEY SHALL BE NO LESS THAN ONE (1) FOOT ABOVE THE TRAVELED WAY. LONG-TERM STATIONARY SIGNS SHALL BE DIRECT BURIED IN SOIL, UNLESS CONDITIONS NECESSITATE THE USE OF PORTABLE SIGNS, OR AS APPROVED BY THE ENGINEER. CONCRETE PADS, CONCRETE OR ROCK BALLAST, OR OTHER SOLID MATERIALS SHALL NOT BE UTILIZED WITH PORTABLE SIGN SUPPORTS.
- FLAGGERS SHALL USE REFLECTORIZED STOP-SLOW PADDLES. FLAGS MAY BE USED ONLY FOR EMERGENCY SITUATIONS.
- MOST OF THE SIGNS SHOWN ARE ORIENTED TO THE RIGHT. HOWEVER, THIS DOES NOT PRECLUDE THE USE OF MIRROR IMAGES OF THESE SIGNS WHERE THE REVERSE ORIENTATION MIGHT BETTER CONVEY TO MOTORISTS THE PROPER DIRECTION OF MOVEMENT.
- R55-1 SIGNS SHALL BE PLACED AT LEAST 150' BUT NOT MORE THAN 1 MILE IN ADVANCE OF THE WORK ZONE. IF A SPEED LIMIT REDUCTION IS IN EFFECT, THE SIGN SHALL BE PLACED A MINIMUM OF 500' IN ADVANCE OF THE "REDUCED SPEED AHEAD" SIGN.


• NOTE: SUPPORTS FOR SIGNS, BARRICADES, AND VERTICAL PANELS THAT ARE DIFFERENT FROM THE REQUIREMENTS SHOWN IN NOTES 4 & 5, BUT MEET THE REQUIREMENTS OF NCHRP-350 OR MANUAL FOR ASSESSING SAFETY HARDWARE (MASH), WILL BE ACCEPTED. COMPLIANCE WITH THE REQUIREMENTS OF NCHRP-350 OR MANUAL FOR ASSESSING SAFETY HARDWARE (MASH) IS REQUIRED FOR ALL PROJECTS.

12-15-11	REVISED W24-1	
11-17-10	DELETED W8-9a & ADDED W8-9	
10-15-09	ADDED REFERENCE TO MASH & ADDED SIGN W24-1	
4-17-08	REVISED SIGN DESIGNATIONS	
11-18-04	REVISED NOTES	
10-9-03	REVISED NOTE 1	
11-16-01	REVISED NOTE 7	
9-28-00	REVISED NOTE	
11-18-98	ADDED NOTE	
6-26-97	REVISED NOTE 5	
4-03-97	REVISED NOTE 5	
10-18-96	ADDED CONTROLLED ACCESS HWY. SIGN & TO NOTE 7	
10-12-95	ADDED R55-1	
6-8-95	REVISED TO CORRECT SIGN ILLUSTRATIONS	6-8-95
2-2-95	REVISED PER PART VI, MUTCD SEPT. 3, 1993	
8-15-91	DRAWN AND PLACED IN USE	
DATE	REVISION	FILMED


ARKANSAS STATE HIGHWAY COMMISSION  
STANDARD TRAFFIC CONTROLS  
FOR HIGHWAY CONSTRUCTION  
STANDARD DRAWING TC-1

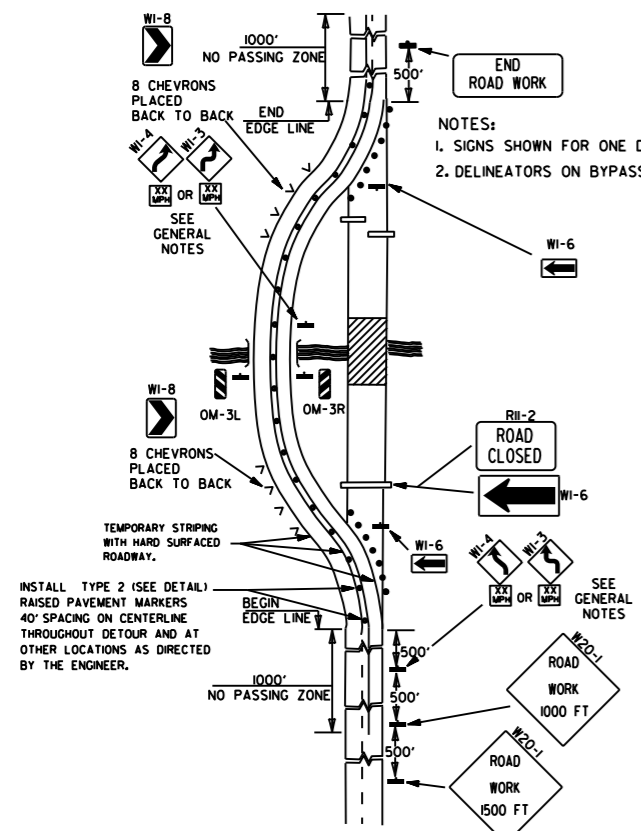


(A) TYPICAL APPLICATION OF TRAFFIC CONTROL DEVICES ON A 2-LANE HIGHWAY WHERE THE ENTIRE ROADWAY IS CLOSED AND A BYPASS DETOUR IS PROVIDED.

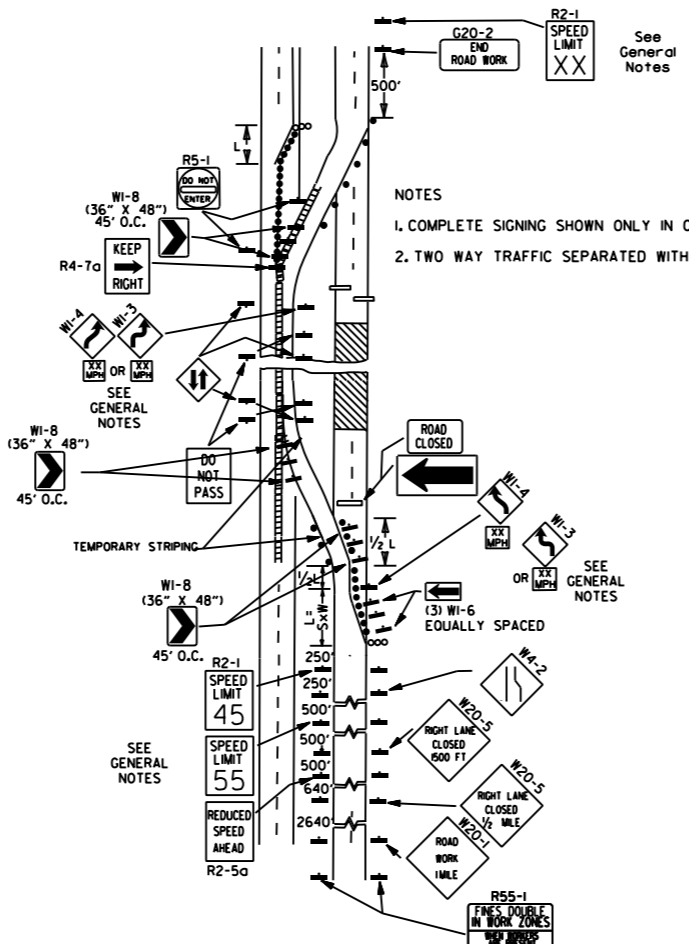


(B) TYPICAL APPLICATION - 4-LANE DIVIDED ROADWAY WHERE ONE ROADWAY IS CLOSED.

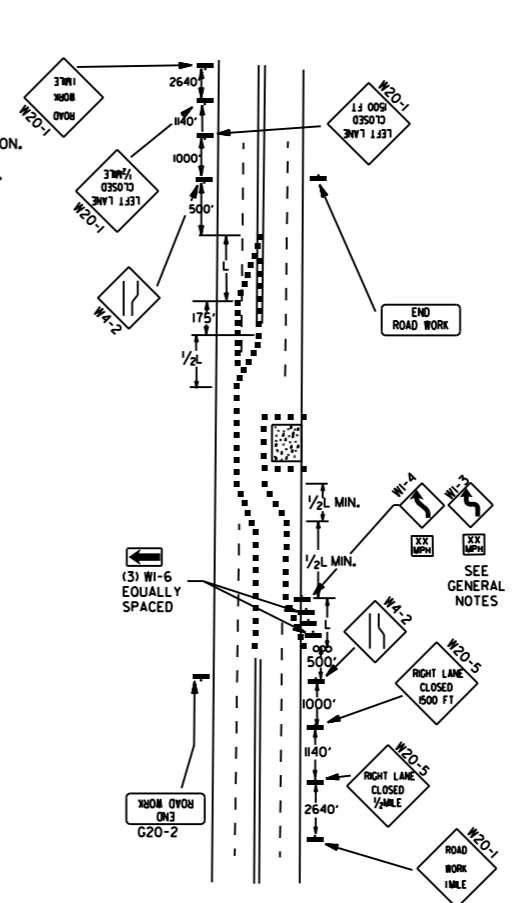


(C) TYPICAL APPLICATION - 4-LANE UNDIVIDED ROADWAY WHERE HALF OF THE ROADWAY IS CLOSED.

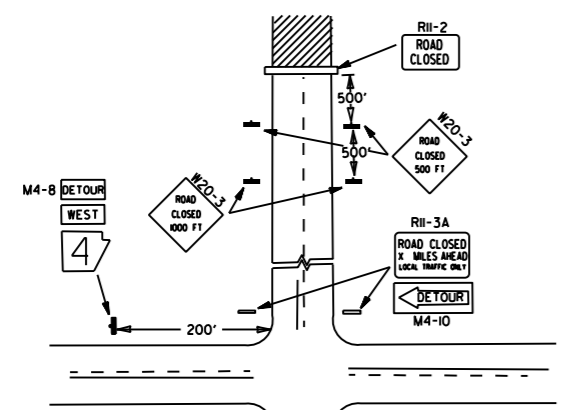


(D) TYPICAL APPLICATION - ROADWAY CLOSED BEYOND DETOUR POINT.

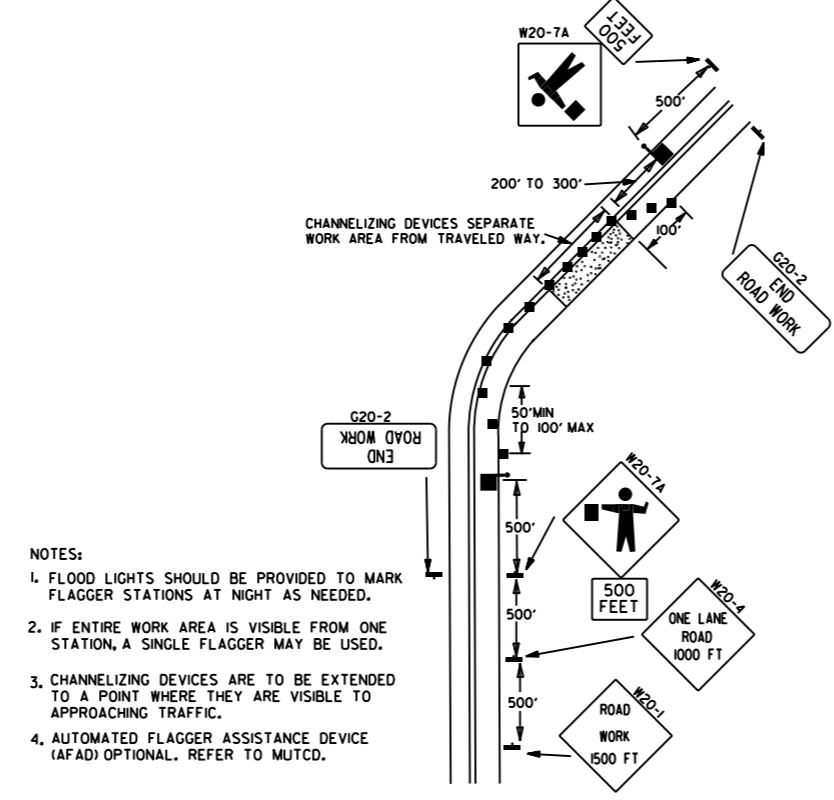

(E) TYPICAL APPLICATION OF TRAFFIC CONTROL DEVICES ON 2-LANE HIGHWAY WHERE ONE LANE IS CLOSED AND FLAGGING IS PROVIDED.

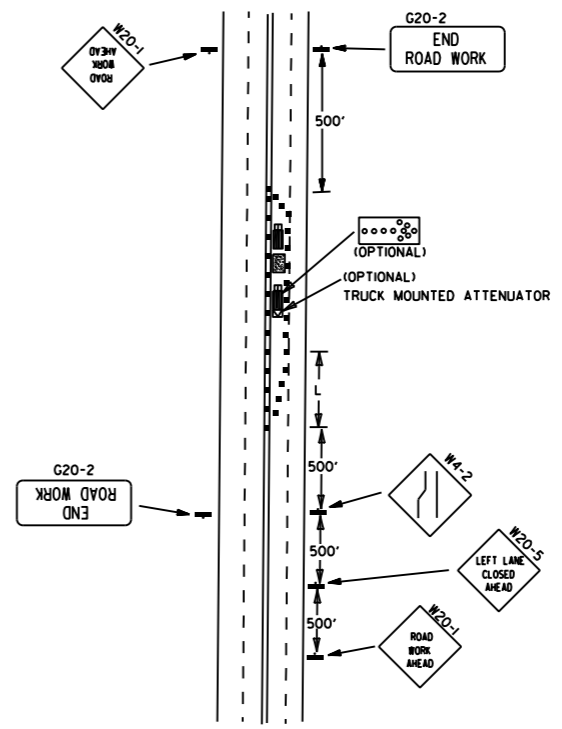

(F) TYPICAL APPLICATION - 4-LANE UNDIVIDED ROADWAY WITH INSIDE LANE CLOSED.

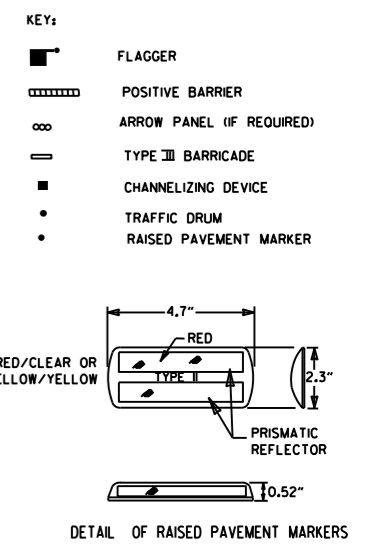


TYPICAL ADVANCE WARNING SIGN PLACEMENT

TAPER FORMULAE:  
 L=SW FOR SPEEDS OF 45MPH OR MORE.  
 $L = \frac{WS^2}{60}$  FOR SPEEDS OF 40MPH OR LESS.  
 WHERE:  
 L= MINIMUM LENGTH OF TAPER.  
 S= NUMERICAL VALUE OF POSTED SPEED LIMIT PRIOR TO WORK OR 85TH PERCENTILE SPEED.  
 W= WIDTH OF OFFSET.


- GENERAL NOTES:  
 1. ADVISORY SPEED POSTED ON W1-3 OR W1-4 CURVE WARNING SIGNS TO BE DETERMINED AT SITE. USE W1-4 WHEN SPEED IS GREATER THAN 30MPH AND W1-3 WHEN 30MPH OR LESS.  
 2. WHEN THE EXISTING SPEED LIMIT IS 45MPH AND THE PLANS REQUIRE A SPEED LIMIT OF 45MPH, THE R2-(K55) SHALL BE OMITTED AND THE R2-5A SHALL BE INSTALLED AT THAT LOCATION. ADDITIONAL R2-145MPH SPEED LIMIT SIGNS SHALL BE INSTALLED AT A MAXIMUM OF 1MILE INTERVALS. AT THE END OF THE WORK AREA A R2-(KXX) SHALL BE INSTALLED TO MATCH ORIGINAL SPEED LIMIT.  
 3. WHEN THE EXISTING SPEED LIMIT IS 65MPH AND THE PLANS REQUIRE A SPEED LIMIT OF 55MPH, THE R2-(K45) SHALL BE OMITTED. ADDITIONAL R2-155MPH SPEED LIMIT SIGNS SHALL BE INSTALLED AT A MAXIMUM OF 1MILE INTERVALS. AT THE END OF THE WORK AREA A R2-(KXX) SHALL BE INSTALLED TO MATCH ORIGINAL SPEED LIMIT.  
 4. THE MAXIMUM SPACING BETWEEN CHANNELIZING DEVICES IN A TAPER SHOULD BE APPROXIMATELY EQUAL IN FEET TO THE SPEED LIMIT. BEYOND THE TAPER, MAXIMUM SPACING SHALL BE TWO TIMES THE SPEED LIMIT, OR AS DIRECTED BY THE ENGINEER.  
 5. WARNING LIGHTS AND/OR FLAGS MAY BE MOUNTED TO SIGNS OR CHANNELIZING DEVICES AT NIGHT AS NEEDED.  
 6. PAVEMENT MARKINGS NO LONGER APPLICABLE WHICH MIGHT CREATE CONFUSION IN THE MINDS OF VEHICLE OPERATORS SHALL BE REMOVED OR OBLITERATED AS SOON AS PRACTICABLE.  
 7. TRAILER MOUNTED DEVICES SUCH AS ARROW PANELS AND PORTABLE CHANGEABLE MESSAGE SIGNS SHALL BE DELINEATED BY AFFIXING CONSPICUITY MATERIAL IN A CONTINUOUS LINE ON THE FACE OF THE TRAILER. WHEN PLACED ON OR ADJACENT TO THE SHOULDER AND NOT BEHIND A POSITIVE BARRIER, THESE DEVICES SHALL BE DELINEATED BY PLACING FIVE (5) TRAFFIC DRUMS, EQUALLY SPACED ALONG THE TRAFFIC SIDE OF THE DEVICE.

DATE	REVISION	FILMED
9-12-13	REVISED DETAIL OF RAISED PAVEMENT MARKERS	
3-11-10	ADDED (AFAD)	
11-20-08	REVISED SIGN DESIGNATIONS	
11-18-04	ADDED GENERAL NOTE	
10-18-96	ADDED R55-1	
4-26-96	CORRECTED (a) BEHIND G20-2	
6-8-95	CORRECTED SIGN IDENT. ON W1-4A	6-8-95
2-2-95	REVISED PER PART VI MUTCD, SEPT. 3, 1993	
8-15-91	DRAWN AND PLACED IN USE	







Channelizing devices

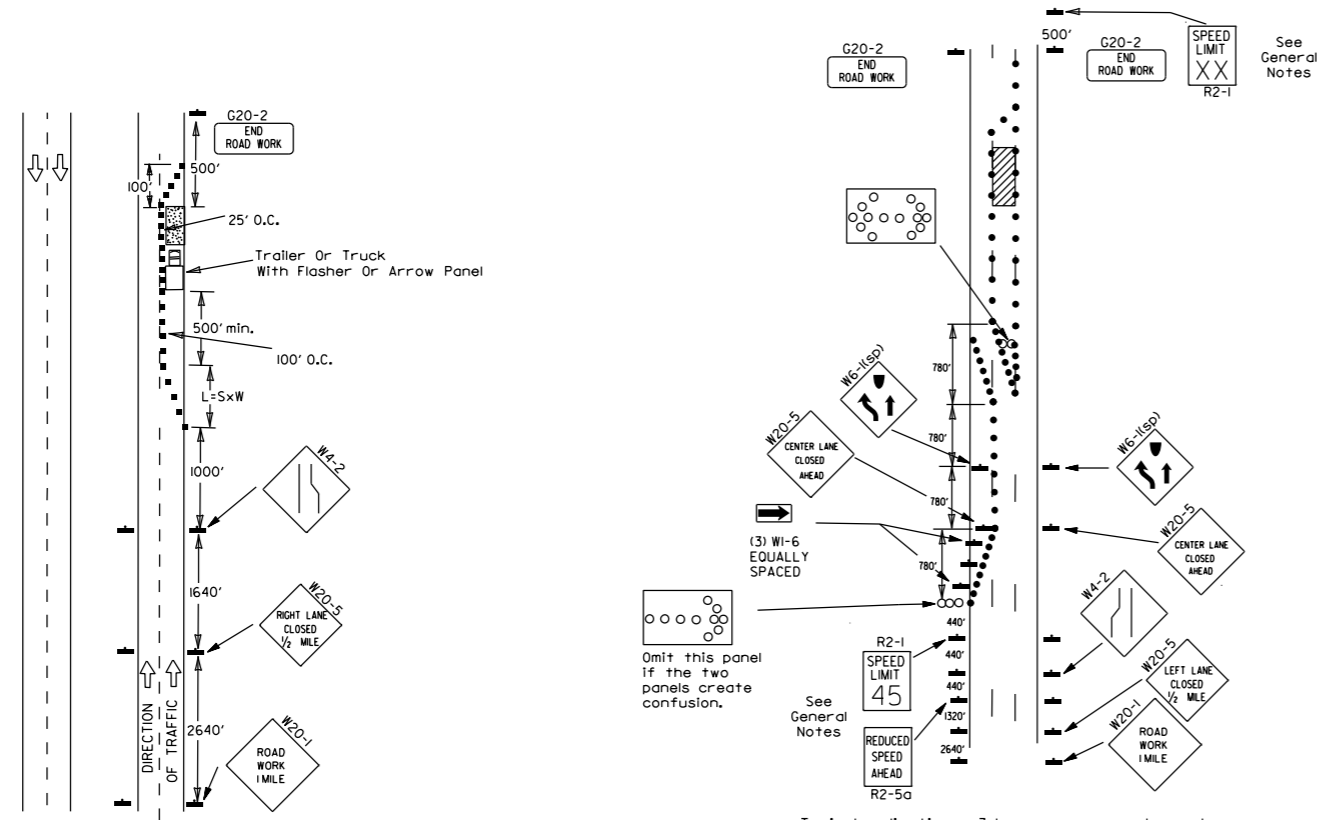


(A) Typical application - daytime maintenance operations of short duration on a 4-lane divided roadway where half of the roadway is closed.

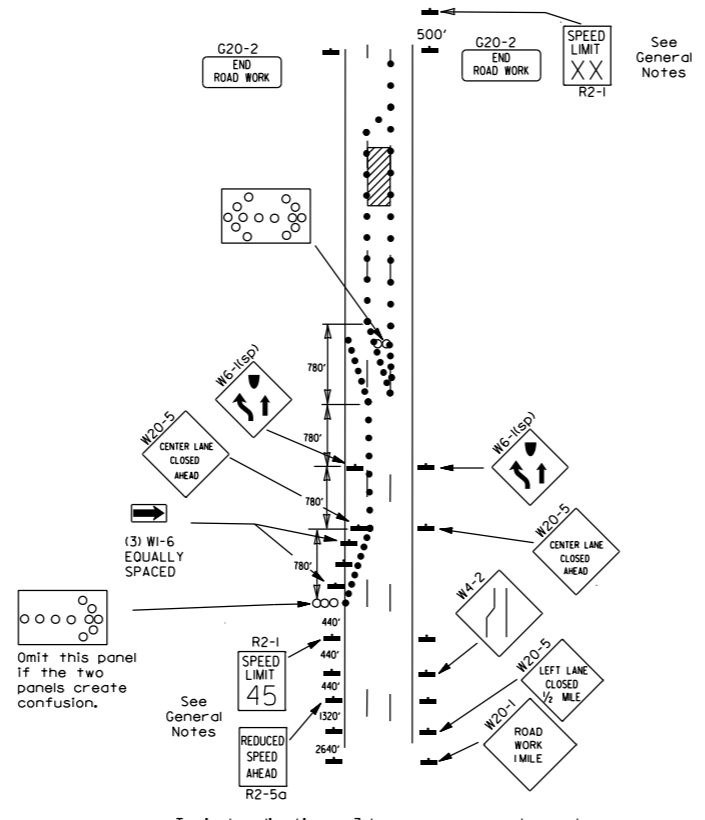

(B) Typical application - 3-lane oneway roadway where center lane is closed.

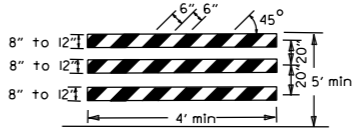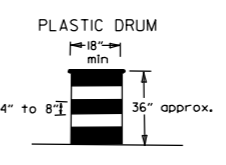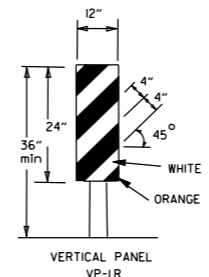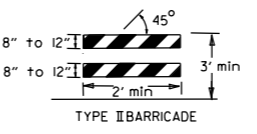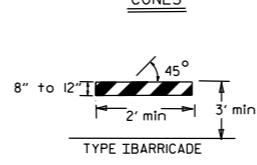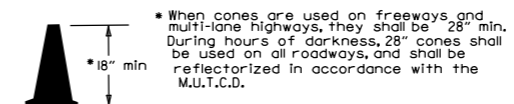




NOTE:  
For all road closures, the Type III barricades shall be of sufficient length to extend across entire roadway.

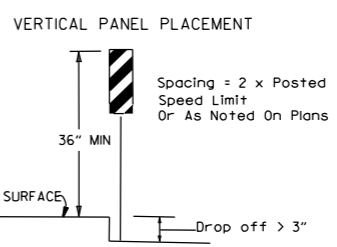



TRAFFIC CONTROL DEVICES FOR VERTICAL PAVEMENT DIFFERENTIALS

VERTICAL DIFFERENTIAL	LOCATIONS	TRAFFIC CONTROL
1" to 3"	Centerline, lane lines	W8-11
1" to 3"	Edge of shoulder	W8-9
Greater than 3"	Lane lines	Standard lane closure required
Greater than 3"	Edge of traveled lane	*RSP-1 and vertical panels, drums or concrete barrier
Greater than 3"	Edge of shoulder	*Vertical panels, drums or concrete barrier

\* When shown on the plans concrete barrier will be used.  
When the shoulder area is used as part of the traveled lane and there is insufficient width to place drums on the remaining shoulder width, then vertical panels shall be used.

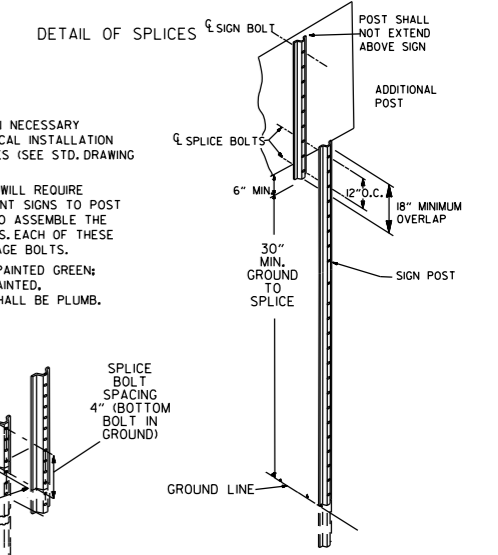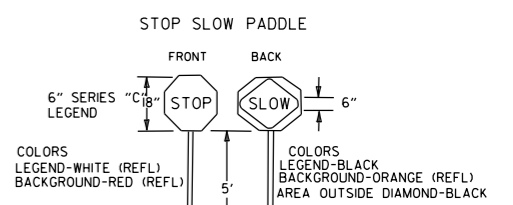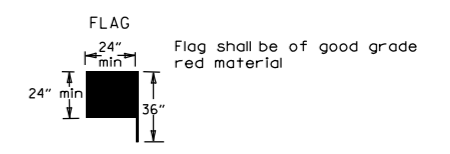

NOTES:  
USE SPLICES ONLY WHEN NECESSARY FOR INSTALLATION. TYPICAL INSTALLATION SHOULD HAVE NO SPLICES (SEE STD. DRAWING NO. SHS-2)  
NORMAL INSTALLATIONS WILL REQUIRE 1/4" DIA. BOLTS TO MOUNT SIGNS TO POST AND 5/16" DIA. BOLTS TO ASSEMBLE THE VARIOUS POST SUPPORTS. EACH OF THESE BOLTS SHALL BE CARRIAGE BOLTS.  
SIGN POSTS SHALL BE PAINTED GREEN; SIGNS SHALL NOT BE PAINTED, AND ALL SIGN POSTS SHALL BE PLUMB.

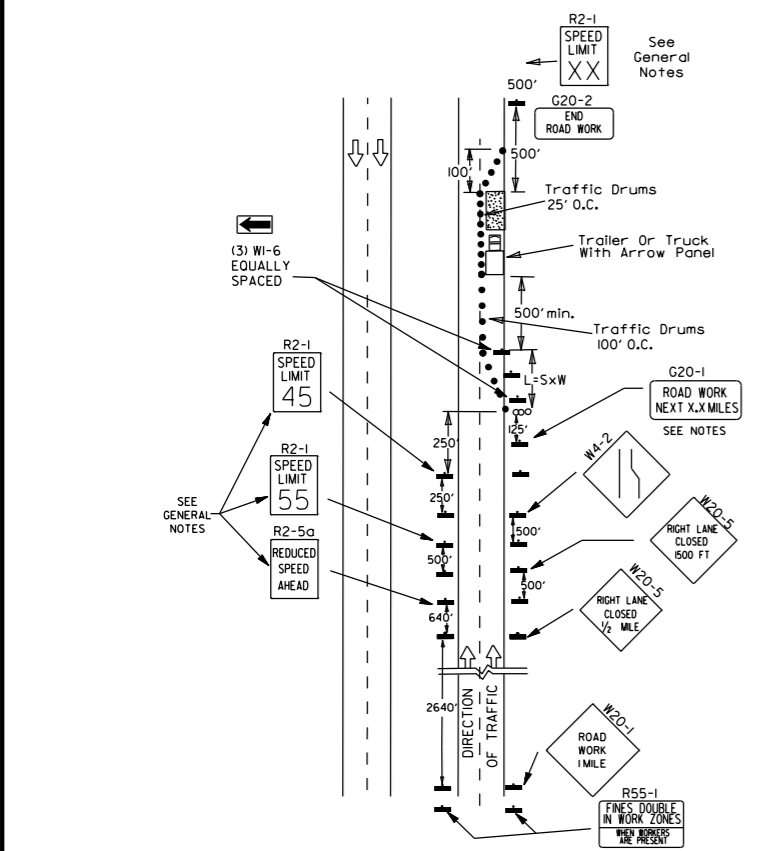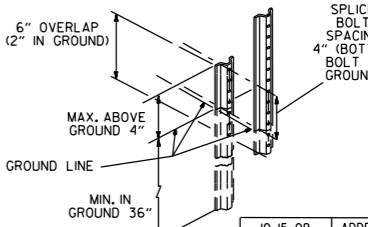


(C) Typical application - construction operations of intermediate to long term duration on a 4-lane divided roadway where half of the roadway is closed.

- KEY:
- Arrow Panel (if Required)
  - Channelizing Device
  - Traffic drum

GENERAL NOTES:











- A speed limit reduction may be implemented ONLY when designated in the plan or when recommended by the Roadway Design Division.
- When the existing speed limit is 55mph and the plans require a speed limit of 45mph, the R2-1(55) shall be omitted and the R2-5A shall be installed at that location. Additional R2-1(45mph) speed limit signs shall be installed at a maximum of 1 mile intervals. At the end of the work area a R2-1(XX) shall be installed to match original speed limit.
- When the existing speed limit is 65mph and the plans require a speed limit of 55mph, the R2-1(65) shall be omitted. Additional R2-1(55mph) speed limit signs shall be installed at a maximum of 1 mile intervals. At the end of the work area a R2-1(XX) shall be installed to match original speed limit.
- The maximum spacing between channelizing devices in a taper should be approximately equal in feet to the speed limit. Beyond the taper, maximum spacing shall be two times the speed limit or as directed by the Engineer.
- Warning lights and/or flags may be mounted to signs or channelizing devices at night as needed.
- Pavement markings no longer applicable which might create confusion in the minds of vehicle operators shall be removed or obliterated as soon as practicable.
- The G20-1 sign will be required on jobs of over two miles in length. When the lane closure is not at the beginning of the project, the G20-1 sign shall be erected 125' in advance of the job limit. Additional W20-1(1 MILE) signs are not required in advance of lane closures that begin inside the project limits.
- Flaggers shall use STOP/SLOW paddles for controlling traffic through work zones. Flags may be used only for emergency situations.
- All plastic drums and cones shall meet the requirements of NCHRP-350 or Manual For Assessing Safety Hardware (MASH).
- Trailer mounted devices such as arrow panels and portable changeable message signs shall be delineated by affixing conspicuity material in a continuous line on the face of the trailer. When placed on or adjacent to the shoulder and not behind a positive barrier, these devices shall be delineated by placing five (5) traffic drums, equally spaced along the traffic side of the device.

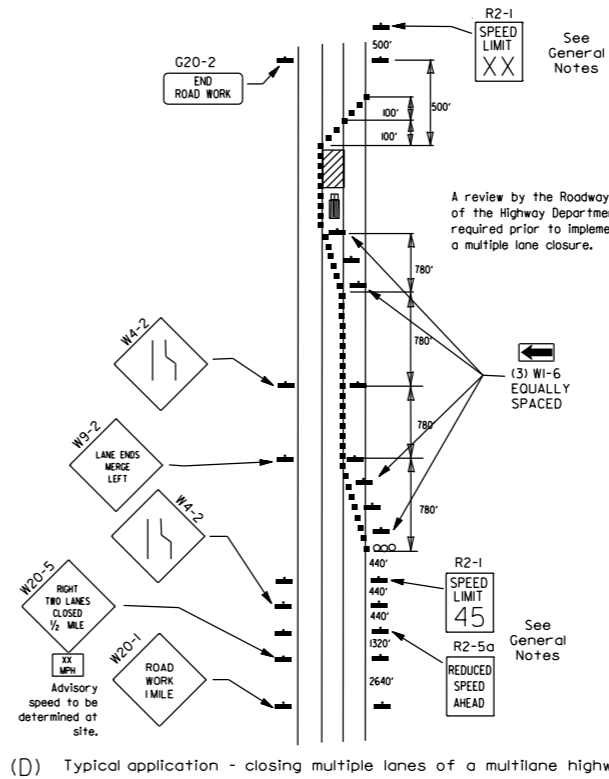


(D) Typical application - closing multiple lanes of a multilane highway.

DATE	REVISION	FILMED
10-15-09	ADDED REFERENCE TO MASH	
11-20-08	REVISED SIGN DESIGNATIONS	
11-18-04	ADDED NOTE	
10-1-98	ADDED NOTE	
4-03-97	ADDED (SP) TO W6-1 & REVISED TRAFFIC CONTROL DEVICES NOTE	
10-18-96	ADDED R55-1	
10-12-95	MOVED UPPER SPLICE	
6-8-95	REVISED SPLICE DETAIL, TEXT	6-8-95
2-2-95	REVISED PER PART VI, MUTCD, SEPT. 3, 1993	
8-15-91	DRAWN AND PLACED IN USE	

REINFORCING BAR TABLE PER BARRIER UNIT			
MARK	LOCATION	BAR SIZE (NO. BARS)	SKETCH
H-1	HORIZONTAL IN BARRIER TIED INSIDE V-1 BARS	#5 (6)	19'-3"
H-2	CENTERED ABOVE DRAIN SLOTS LONG. & TRANSVERSELY	#5 (6)	6'-6"
H-3	TIED ABOVE H-1 BARS TO SUPPORT H-2, TIED TO V-1	#4 (2)	1'-6"
S-1	OVER LIFT HOLES	#4 (2)	2'-5" 3/8" R 90°
S-2	HORIZ. AROUND SLOTS BETWEEN V-1'S & DRAIN SLOTS	#4 (2)	1 1/2" R SLOTS 1" MIN. CLEAR TO BAR TO BAR 5'-1" BAR W/ (4) 1 1/2" R BENDS & MIN. 1'-0" OVERLAP
V-1	VERTICAL IN BARRIER (3) EACH END & (2) AT EACH DRAIN SLOTS	#5 (16)	TOTAL LENGTH 4'-9" 2 3/16" R 12° 4 3/8" 2'-1 3/8" 3/8"

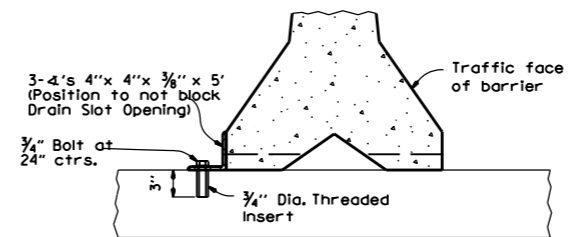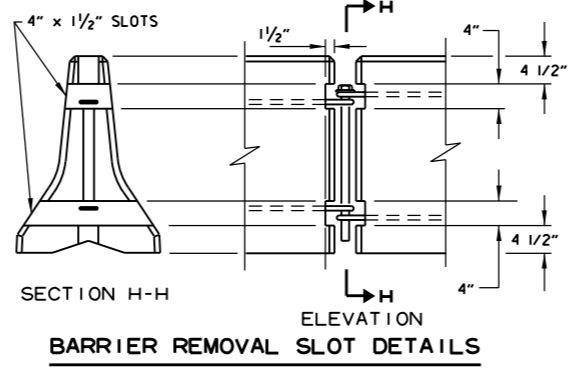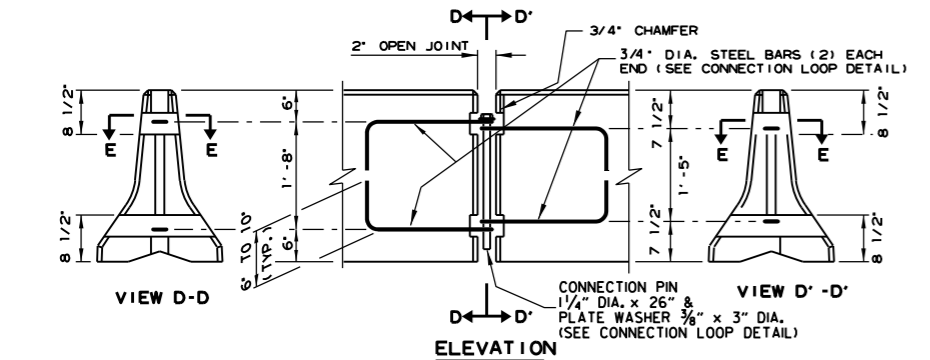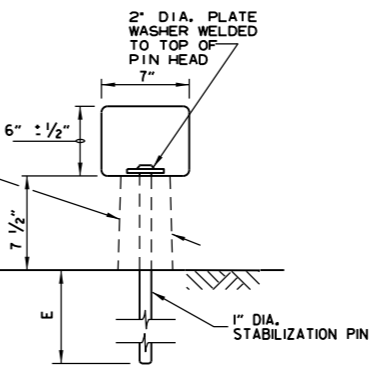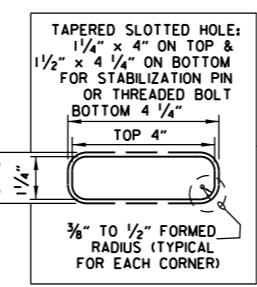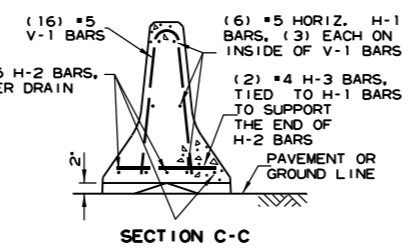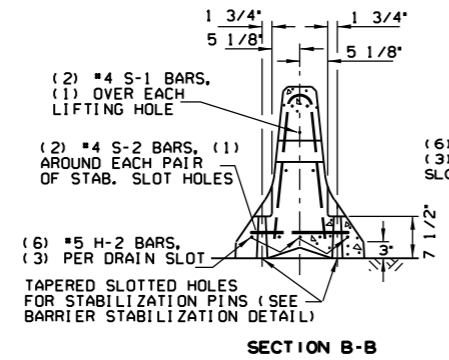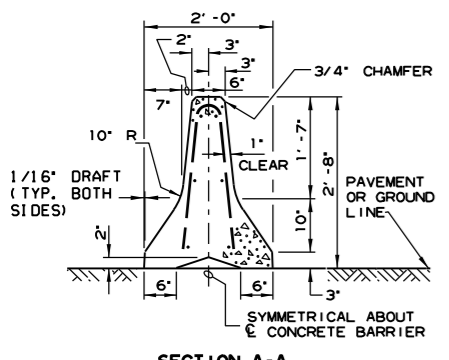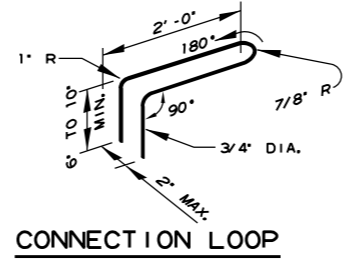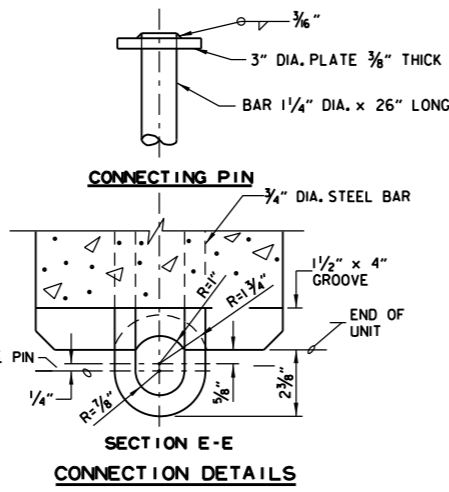

NOTE: 3/4" Threaded inserts shall be cast in place for all new bridge decks and drilled and grouted for existing bridge decks. Inserts shall have a minimum ultimate load capacity of 8000 lbs. In tension. After removal of barrier, bolts, and angles, the inserts shall be filled with approved non-shrink epoxy.

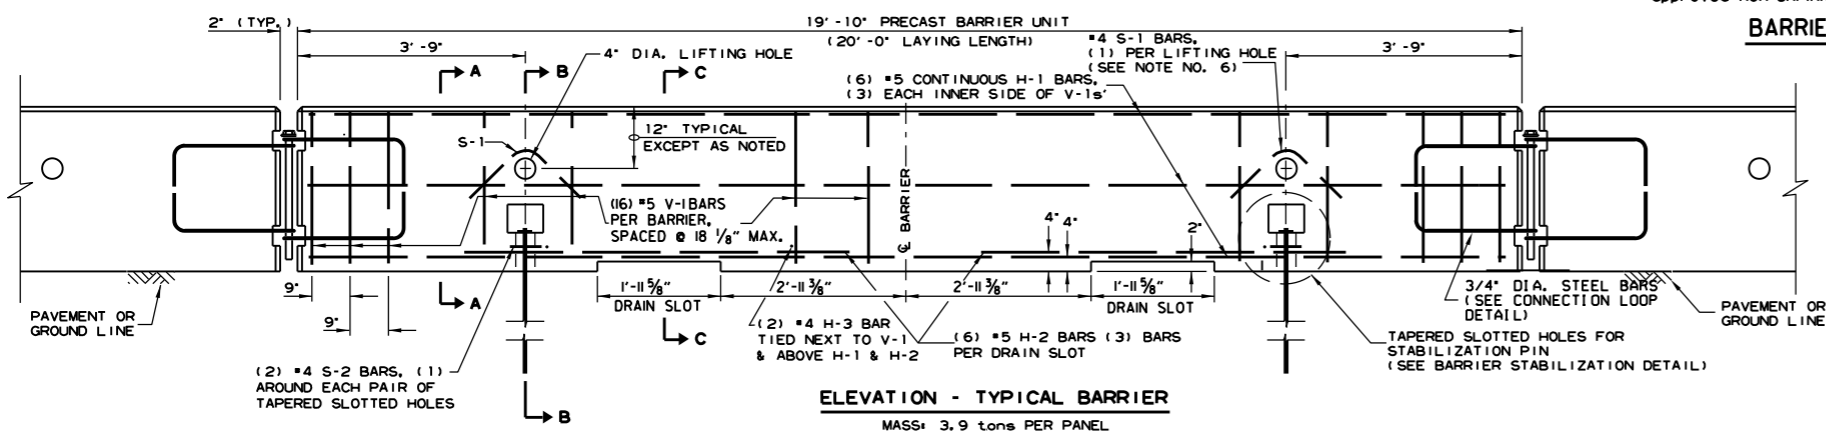


DATE	REVISION	FILMED
2-27-14	REVISED BARRIER STABILIZATION DETAIL	
10-15-09	ADDED REFERENCE TO MASH	
8-5-09	REV. NOTE 3 CONCERNING DRAIN SLOTS	
11-29-07	REVISED NOTE 3	
5-25-06	DELETED GENERAL NOTE 7	
11-18-04	REVISED BARRIER STABILIZATION DETAIL BRIDGE DECKS	
4-10-03	REVISED GENERAL NOTE 2	
8-22-02	ISSUED NEW DRAWING	

- General Notes**
- The contractor shall furnish the Precast Concrete Barrier Units and shall be responsible for the manufacture, shipment, storage, placement and removal. At the completion of the project, the precast units will remain the property of the contractor.
  - Materials shall meet the following minimum requirements:  
Concrete: 2500 psi compressive strength at 28 days.  
Reinforcing Steels: AASHTO M 31 or M 53, Grade 60  
Structural Steel: AASHTO-M270 Grade 36 shall be used for the Connection Pin, Connection Loops, and Stabilization Pins. A One Piece Pin with a 3" rounded top may be used in place of the detailed Connection Pin.  
Delineators: Delineators shall be mounted at 10' spacing on top of precast barrier.  
  
In applications where barrier walls within 6 feet of a traffic lane, additional delineators shall be placed on the barrier at 10' spacing approximately one (1) foot from the top of the barrier. Delineators shall be on the AHTD Qualified Products List for Construction Concrete Barrier Markers. Delineator color shall be in accordance with the Manual Uniform Traffic Control Devices. Payment for delineators shall be considered included in the price bid per Lin. Ft. for "Furnishing and Installing Precast Concrete Barrier". The contractor shall certify to the Engineer that the material and the design used in the precast barrier units meets the requirements as shown on this standard drawing.
  - Other Precast Concrete Barriers that have been crash tested and approved by the Federal Highway Administration to meet the requirements of NCHRP-350 test level 3 or Manual For Assessing Safety Hardware (MASH) will be accepted in lieu of the barrier shown. Drain slots shall be provided as needed or as directed by the Engineer. The Contractor shall furnish a certification of NCHRP Report 350 or Manual For Assessing Safety Hardware (MASH) compliance for any other types of precast barrier to be used. The certification shall state that the precast concrete barrier meets the requirements of NCHRP Report 350 or Manual For Assessing Safety Hardware (MASH) and include a copy of the Federal Highway Administration's (FHWA) approval letter with all attachments. Precast concrete barrier units shall be fabricated and installed in accordance with crash testing and documentation provided in the FHWA approval letter. Mixing of shapes will not be allowed in a continuous line of units.
  - Dowel holes in pavement or bridge slabs that are to remain in place shall be filled. Holes in concrete pavement and bridge slabs shall be filled with an approved non-shrink epoxy grout. Holes in asphalt pavement shall be filled with an approved asphalt joint filler. Payment for drilling and filling holes to be included in the price for various barrier items.
  - Attach Units To Roadway Surface with Stabilization Pins and to Deck Slabs using bolts when required.
  - A 4" White PVC Sleeve may be used to form the Lifting Hole and if used the Sleeve is to be left in place.

ARKANSAS STATE HIGHWAY COMMISSION  
STANDARD TRAFFIC CONTROLS  
FOR HIGHWAY CONSTRUCTION -  
TEMPORARY PRECAST BARRIER  
STANDARD DRAWING TC-4


(A) 4 feet or greater preferred. If less than 4 feet, Precast Units shall be connected to slab (SEE BARRIER STABILIZATION DETAIL-BRIDGE DECKS STD. DRWG. TC-4)

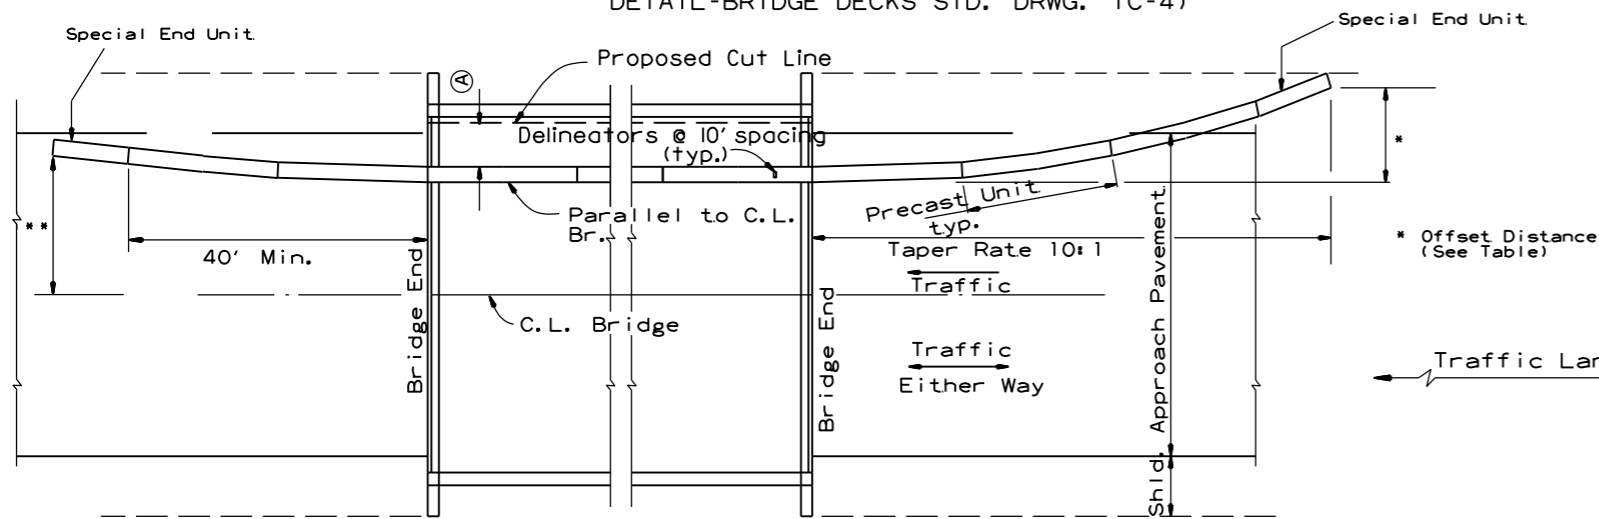

**BARRIER PLACEMENT ALONG BRIDGE WITH OFFSET**


No Scale

\*\* Offset Distance for Two Way Traffic Only

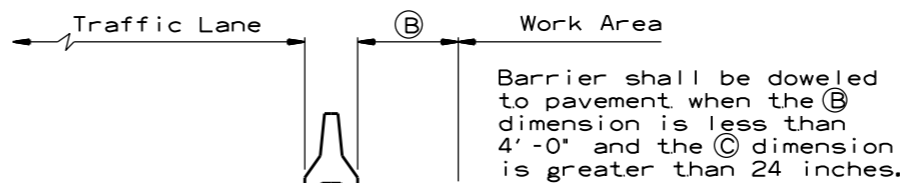

**SECTION J-J**

No Scale

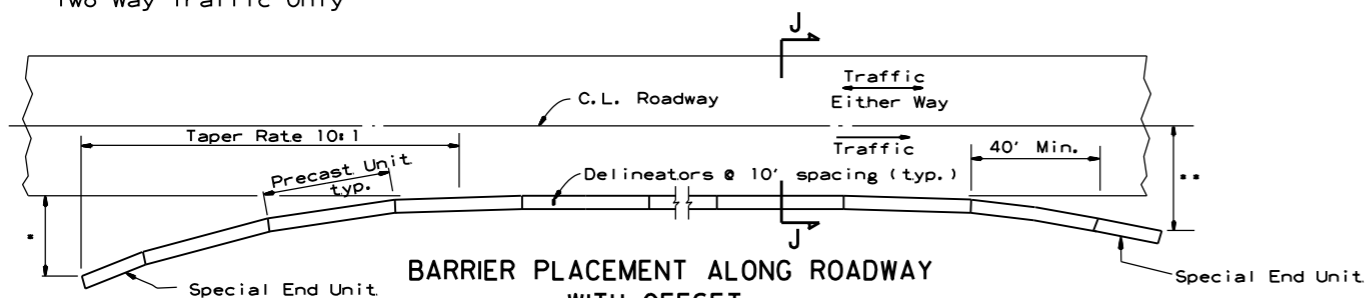

**BARRIER PLACEMENT ALONG ROADWAY WITH OFFSET**

No Scale


\* Offset Distance (See Table)

\*\* Offset Distance For Two Way Traffic Only

Offset Distance Table

Speed (MPH)	Offset Distance (FT.)
≤ 45	12
> 45	18

If offset distance is not attainable, then see 'Barrier Placement With Attenuator' Detail shown below.

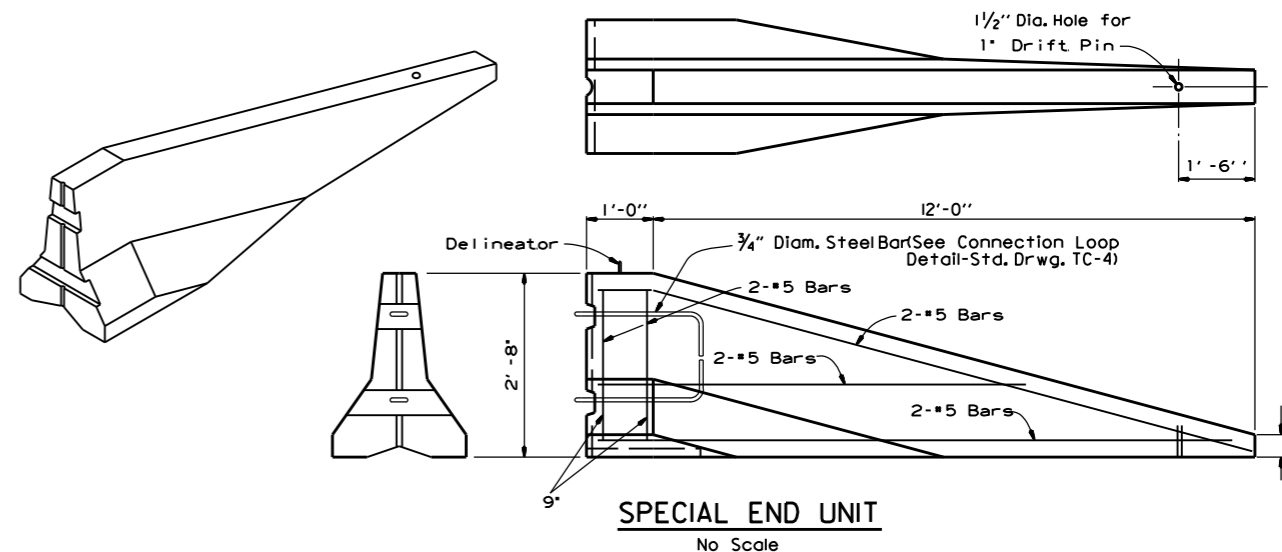


**SPECIAL END UNIT**

No Scale

General Notes

When shown on the Plans, the ends of the Temporary Precast Concrete Barrier shall be protected with an NCHRP-350 or Manual For Assessing Safety Hardware (MASH) approved Crash Cushion. Payment for Crash Cushions shall be made under the item of "Temporary Impact Attenuation Barrier."

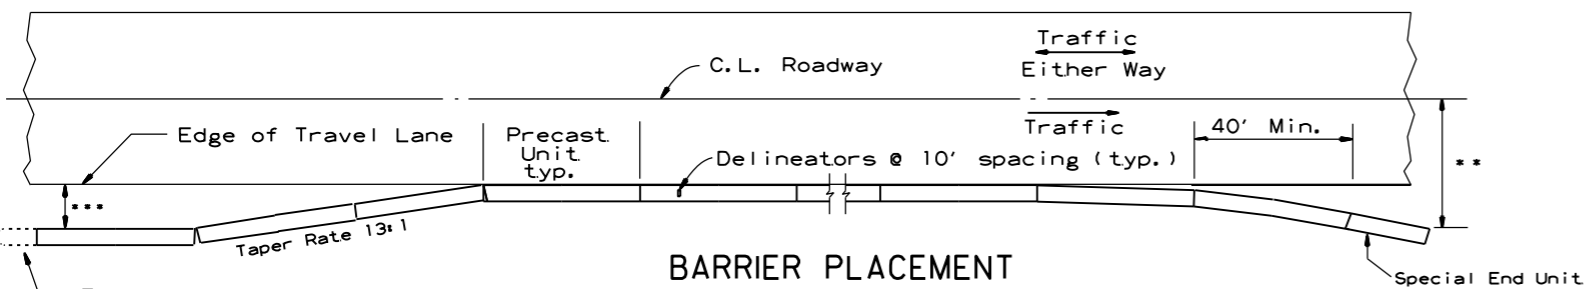

**BARRIER PLACEMENT WITH ATTENUATOR**

No Scale

\*\* Offset Distance For Two Way Traffic Only

\*\*\* Min. 3'-0" From Edge of Travel Lane to Nearest Edge of Attenuator

DATE	REVISION	FILMED
10-15-09	ADDED REFERENCE TO MASH	
5-25-06	REVISED BARRIER PLACEMENT	
8-22-02	ISSUED NEW DRAWING	


**ARKANSAS STATE HIGHWAY COMMISSION**

**STANDARD TRAFFIC CONTROLS  
FOR HIGHWAY CONSTRUCTION -  
TEMPORARY PRECAST BARRIER**



**STANDARD DRAWING TC-5**

GENERAL NOTES


INSTALL A MINIMUM OF 2 UPSLOPE STAKES AND 4 DOWNSLOPE STAKES AT AN ANGLE TO WEDGE WATTLE TO BOTTOM OF DITCH.

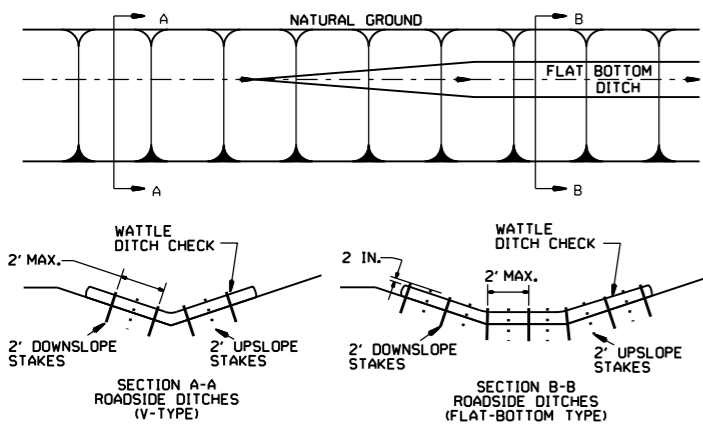

WATTLE DITCH CHECK (E-1)

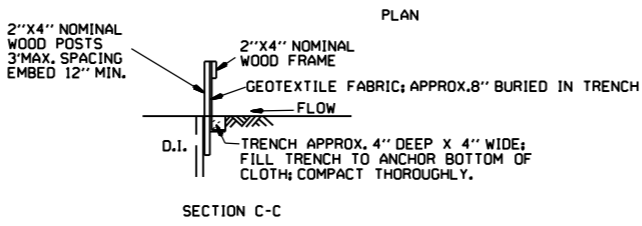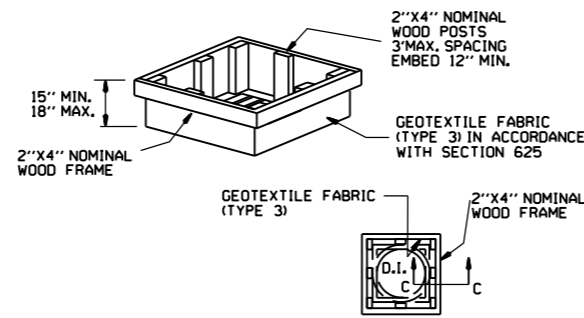


DROP INLET SILT FENCE (E-7)

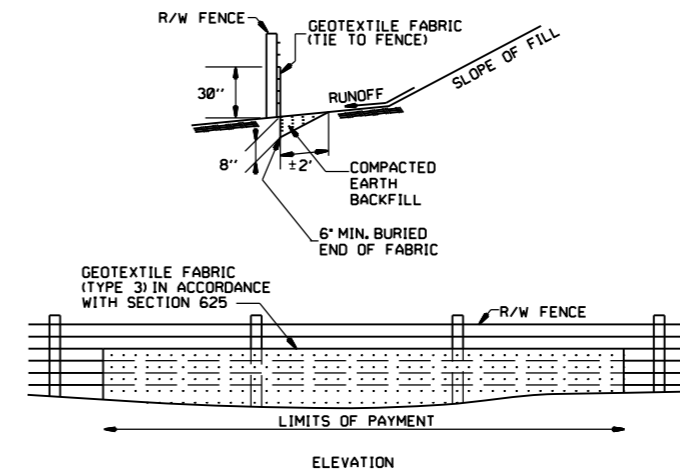

SILT FENCE ON R/W FENCE (E-4)


GENERAL NOTES  
 GEOTEXTILE FABRIC SHALL BE SPLICED TOGETHER WITH A SEWN SEAM ONLY AT A SUPPORT POST, OR TWO SECTIONS OF FENCE MAY BE OVERLAPPED INSTEAD. PAYMENT OF ADDITIONAL MATERIAL FOR OVERLAP WILL NOT BE MADE.

- GENERAL NOTES
1. STRAW BALES SHALL BE INSTALLED SO THAT THE BINDINGS ARE ORIENTED AROUND THE SIDES RATHER THAN ALONG THE TOPS AND BOTTOMS OF THE BALES. THE BALES SHALL BE A MINIMUM OF 30 INCHES IN LENGTH.
  2. NO GAPS SHALL BE LEFT BETWEEN BALES.
  3. BALED STRAW FILTER BARRIERS COMPLETED AND ACCEPTED WILL BE MEASURED BY THE BALE IN PLACE AS AUTHORIZED BY THE ENGINEER AND WILL BE PAID FOR AT THE CONTRACT UNIT PRICE BID PER BALE FOR BALED STRAW DITCH CHECKS.

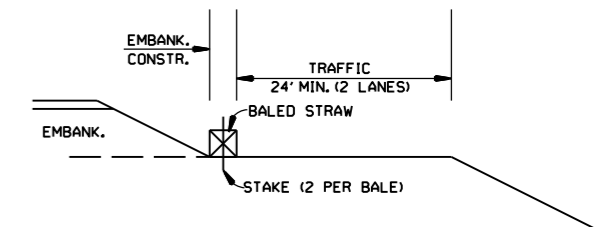


BALED STRAW FILTER BARRIER (E-2)

NUMBER OF SAND BAGS AND ARRANGEMENT VARIABLE WITH ON-SITE CONDITIONS. PLACE SAND BAGS AT BASE OF DITCH CHECK IN AREA OF OVERFLOW

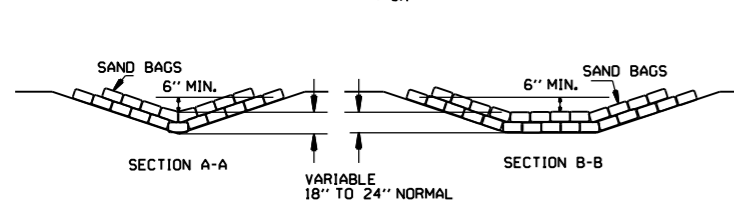


SAND BAG DITCH CHECK (E-5)

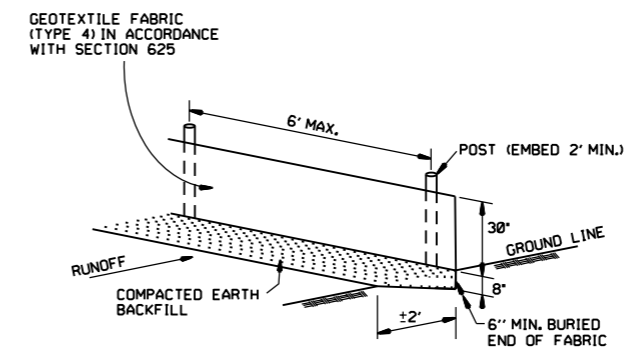

SILT FENCE (E-11)

GENERAL NOTES  
 GEOTEXTILE FABRIC SHALL BE SPLICED TOGETHER WITH A SEWN SEAM ONLY AT A SUPPORT POST OR TWO SECTIONS OF FENCE MAY BE OVERLAPPED INSTEAD. PAYMENT OF ADDITIONAL MATERIAL FOR OVERLAP WILL NOT BE MADE.

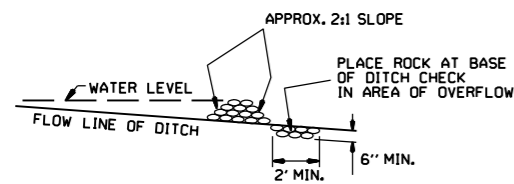

ROCK DITCH CHECK (E-6)

12-15-11	DELETED BALED STRAW DITCH CHECK & ADDED WATTLE DITCH CHECK	
11-18-98	ADDED NOTES	
7-02-98	ADDED BALED STRAW FILTER BARRIER (E-2)	
7-20-95	REVISED SILT FENCE E-4 AND E-11	7-20-95
7-15-94	REV. E-4 & E-11 MIN. 13" BURIED END OF FABRIC	
6-2-94	REVISED E-1, 4, 7 & 11; DELETED E-2 & 3	6-2-94
4-1-93	REDRAWN	
10-1-92	REDRAWN	
8-2-76	ISSUED R.D.M.	298-7-28-76
DATE	REVISION	FILMED

ARKANSAS STATE HIGHWAY COMMISSION  
 TEMPORARY EROSION CONTROL DEVICES  
 STANDARD DRAWING TEC-1




### CLEARING AND GRUBBING

CONSTRUCTION SEQUENCE

1. PLACE PERIMETER CONTROLS (I.E. SILT FENCES, DIVERSION DITCHES, SEDIMENT BASINS, ETC.)
2. PERFORM CLEARING AND GRUBBING OPERATION.

### EXCAVATION

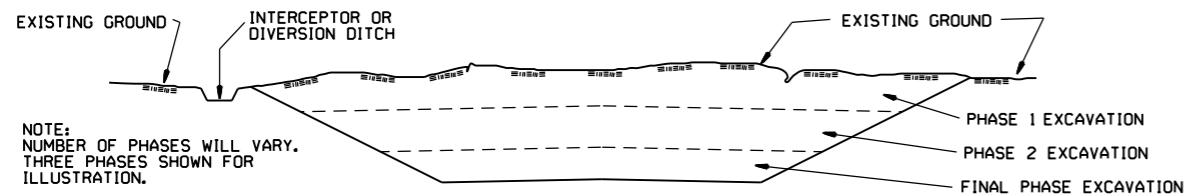

NOTE:  
NUMBER OF PHASES WILL VARY.  
THREE PHASES SHOWN FOR  
ILLUSTRATION.


GENERAL NOTE

ALL CUT SLOPES SHALL BE DRESSED, PREPARED, SEEDED, AND MULCHED AS THE WORK PROGRESSES. SLOPES SHALL BE EXCAVATED AND STABILIZED IN EQUAL INCREMENTS NOT TO EXCEED 25 FEET, MEASURED VERTICALLY.

CONSTRUCTION SEQUENCE

1. EXCAVATE AND STABILIZE INTERCEPTOR AND/OR DIVERSION DITCHES.
2. PERFORM PHASE 1 EXCAVATION. PLACE PERMANENT OR TEMPORARY SEEDING.
3. PERFORM PHASE 2 EXCAVATION. PLACE PERMANENT OR TEMPORARY SEEDING.
4. PERFORM FINAL PHASE OF EXCAVATION. PLACE PERMANENT OR TEMPORARY SEEDING. STABILIZE DITCHES. CONSTRUCT DITCH CHECKS, DIVERSION DITCHES, SEDIMENT BASINS, OR OTHER EROSION CONTROL DEVICES AS REQUIRED.

### EMBANKMENT

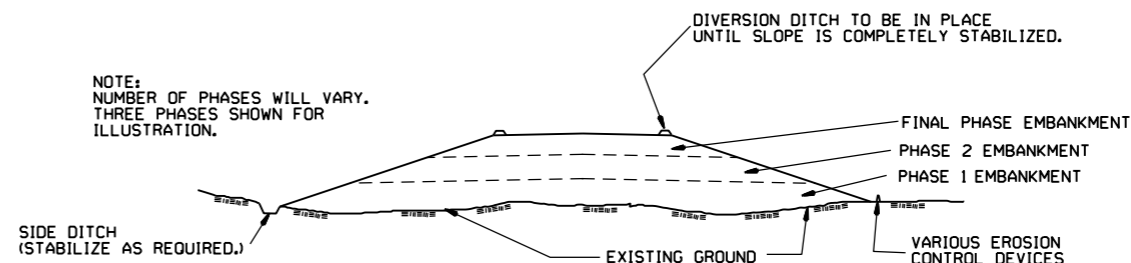

NOTE:  
NUMBER OF PHASES WILL VARY.  
THREE PHASES SHOWN FOR  
ILLUSTRATION.


GENERAL NOTE

ALL EMBANKMENT SLOPES SHALL BE DRESSED, PREPARED, SEEDED, AND MULCHED AS THE WORK PROGRESSES. SLOPES SHALL BE CONSTRUCTED AND STABILIZED IN EQUAL INCREMENTS NOT TO EXCEED 25 FEET, MEASURED VERTICALLY.


CONSTRUCTION SEQUENCE

1. CONSTRUCT DIVERSION DITCHES, DITCH CHECKS, SEDIMENT BASINS, SILT FENCES, OR OTHER EROSION CONTROL DEVICES AS SPECIFIED.
2. PLACE PHASE 1 EMBANKMENT WITH PERMANENT OR TEMPORARY SEEDING. PROVIDE DIVERSION DITCHES AND SLOPE DRAINS IF EMBANKMENT CONSTRUCTION IS TO BE TEMPORARILY ABANDONED FOR A PERIOD OF GREATER THAN 21 DAYS.
3. PLACE PHASE 2 EMBANKMENT WITH PERMANENT OR TEMPORARY SEEDING. PROVIDE DIVERSION DITCHES AND SLOPE DRAINS IF EMBANKMENT CONSTRUCTION IS TO BE TEMPORARILY ABANDONED FOR A PERIOD OF GREATER THAN 21 DAYS.
4. PLACE FINAL PHASE OF EMBANKMENT WITH PERMANENT OR TEMPORARY SEEDING. PLACE DIVERSION DITCHES AND SLOPE DRAINS AND MAINTAIN UNTIL ENTIRE SLOPE IS STABILIZED.

			ARKANSAS STATE HIGHWAY COMMISSION
			TEMPORARY EROSION CONTROL DEVICES
11-03-94	CORRECTED SPELLING		
6-2-94	Drawn & Issued		
DATE	REVISION	6-2-94	FILMED
			STANDARD DRAWING TEC-3

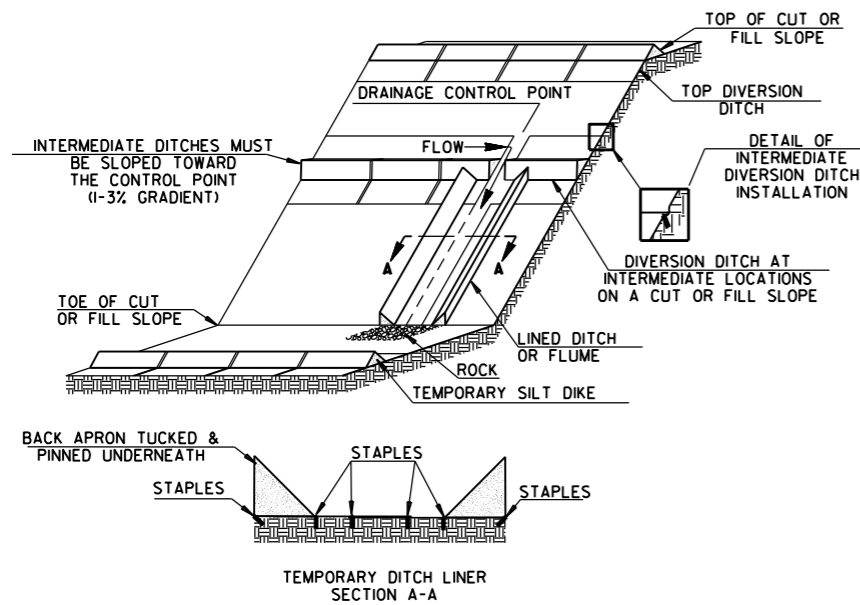


TRIANGULAR SILT DIKE INSTALLATION FOR DIVERSION DITCH AND/OR DITCH LINER

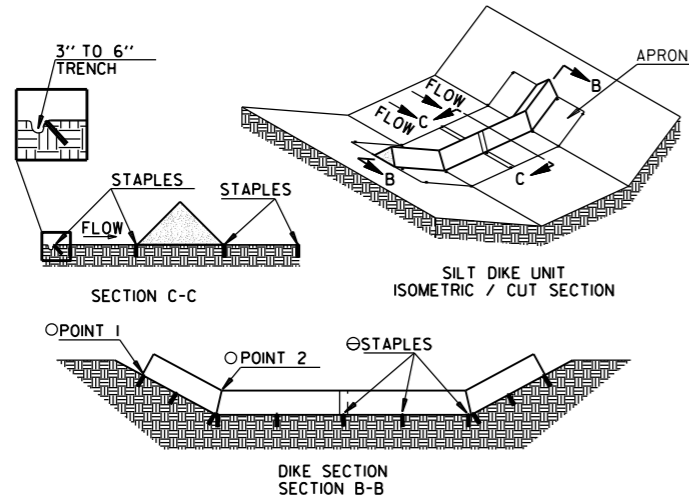


TRIANGULAR SILT DIKE INSTALLATION FOR ROADWAY DITCH OR DRAINAGE DITCH

○ POINT "1" MUST BE HIGHER THAN POINT "2" TO ENSURE THAT WATER FLOWS OVER THE DIKE AND NOT AROUND THE ENDS.


⊙ STAPLES SHALL BE PLACED WHERE THE UNITS OVERLAP AND IN THE CENTER OF THE UNIT AS SHOWN ON THE DIAGRAM.

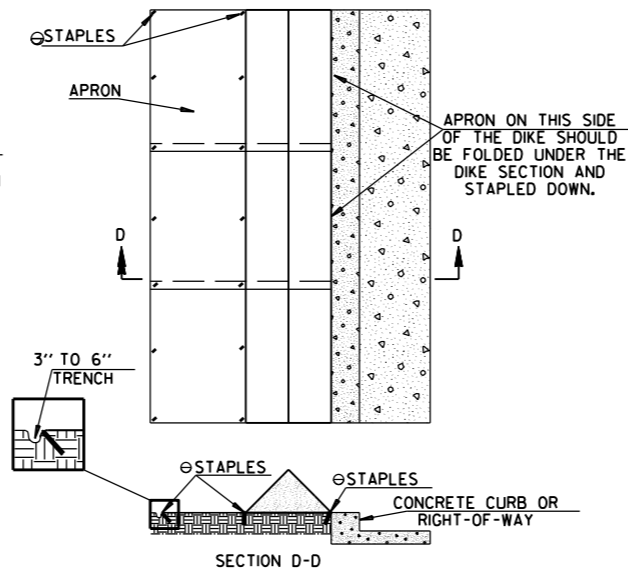

TRIANGULAR SILT DIKE INSTALLATION FOR CONTINUOUS BARRIER

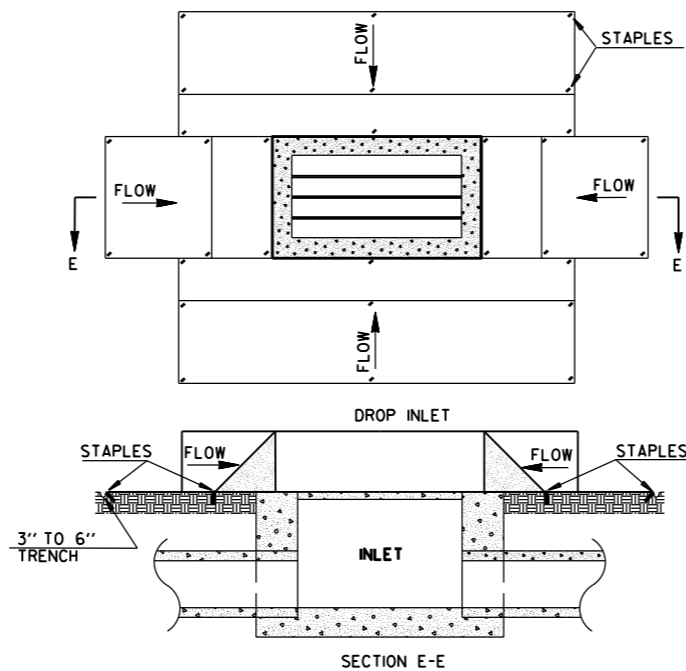

TRIANGULAR SILT DIKE INSTALLATION FOR DROP INLETS

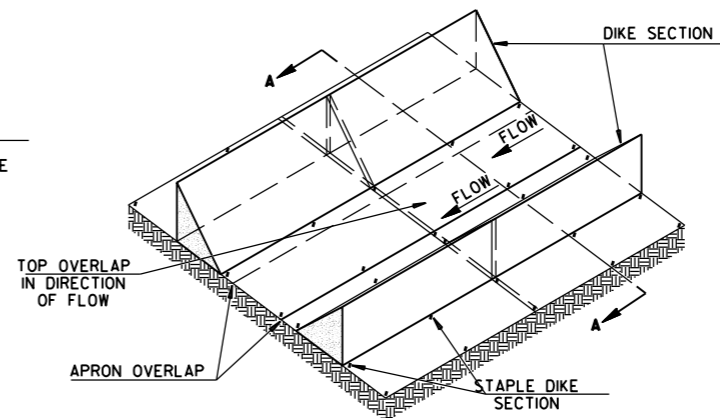

TRIANGULAR SILT DIKE INSTALLATION FOR TEMPORARY DITCH LINER

GENERAL NOTES

1. THIS WORK SHALL CONSIST OF FURNISHING, INSTALLING, AND MAINTAINING THE TRIANGULAR SILT DIKE. THE DIKES SHALL BE USED AS A CONTINUOUS LINE BARRIER AT THE TOE OF SLOPE OR ACROSS THE ROADWAY DITCH TO CONTAIN SEDIMENT AND MINIMIZE EROSION, OR AS DIRECTED BY THE ENGINEER. THESE DIKES SHALL BE INSTALLED AND LOCATED AS SOON AS CONSTRUCTION WILL ALLOW OR AS DIRECTED BY THE ENGINEER.
2. TRIANGULAR SILT DIKE SHALL BE TRIANGULAR SHAPED HAVING A HEIGHT OF AT LEAST 8" TO 10" IN THE CENTER WITH EQUAL SIDES AND A 16" TO 20" BASE. THE TRIANGULAR SHAPED INNER MATERIAL SHALL BE URETHANE FOAM. THE OUTER COVER SHALL BE A WOVEN GEOTEXTILE FABRIC PLACED AROUND THE INNER MATERIAL & ALLOWED TO EXTEND BEYOND BOTH SIDES OF THE TRIANGLE 24" TO 36". THIS FABRIC SHOULD BE MILDEW RESISTANT, ROT-PROOF AND RESISTANT TO HEAT AND ULTRAVIOLET RADIATION MEETING REQUIREMENTS FOR SEDIMENT CONTROL IN AASHTO M288. THE DIKES SHALL BE ATTACHED TO THE GROUND WITH WIRE STAPLES. THE STAPLES SHALL BE NO. 11 GAUGE WIRE AND BE AT LEAST 6" TO 8" LONG. STAPLES SHALL BE PLACED AS SHOWN ON THESE DETAILS.
3. ACCEPTED TRIANGULAR SILT DIKE, MEASURED AS PROVIDED ABOVE, WILL BE PAID FOR AT THE CONTRACT UNIT PRICE BID FOR TRIANGULAR SILT DIKE. PRICE BID WILL INCLUDE THE COST OF FURNISHING THE DIKES, INSTALLING, MAINTAINING AND REMOVAL WHEN DIRECTED BY THE ENGINEER.

SYMBOLY  
SYMBOL TO BE USED TO DENOTE  
DEVICE ON PLANS



NOTE: SILT DIKE SHOULD ONLY BE USED FOR DROP INLETS IN SUMP LOCATIONS.

		ARKANSAS STATE HIGHWAY COMMISSION	
		TEMPORARY EROSION CONTROL DEVICES	
7-26-12	REVISED GENERAL NOTE 2.		
12-15-11	ISSUED		
DATE	REVISION		FILMED

GENERAL NOTES:

STEEL LINE POSTS SHALL BE GALVANIZED, 7 FT. IN LENGTH.  
 TUBULAR END, CORNER, PULL, OR DIAGONAL BRACES MUST CONFORM TO THE DIMENSIONS AND WEIGHTS SPECIFIED ON STANDARD DRAWING WF-3 (CHAIN LINK).


THE CONTRACTOR SHALL FURNISH AT LEAST 25% OF WOOD LINE POSTS OF 7' LENGTHS IN ORDER TO PROVIDE SUFFICIENT SET IN SOFT GROUND OR SMALL DEPRESSIONS.

GATE HINGES AND LATCHES WITH LOCKS TO BE OF A TYPE APPROVED BY THE ENGINEER. DRIVEWAY GATES, EITHER SINGLE 12' OR 16' OR DOUBLE 6' TO 8' OPENINGS OF THE SAME TYPE AS THE PEDESTRIAN GATE, SHALL BE INSTALLED ON THE RIGHT SIDE OF EACH THROUGH LANE ROAD AT LARGE CULVERTS OR BRIDGE CROSS FENCE FOR USE BY MAINTENANCE EQUIPMENT. LOCATION OF GATES TO BE SHOWN ON THE PLANS OR AS DESIGNATED BY THE ENGINEER.



AT STREAM CROSSINGS THE FENCE SHALL NOT BE CONSTRUCTED ACROSS LARGE STREAMS. WHERE CLEARANCE IS SUFFICIENT FROM THE TOP OF BANK TO THE BRIDGE STRUCTURE, A CROSS CONNECTION SHALL BE CONSTRUCTED BETWEEN THE FENCE ON EACH SIDE OF THE ROAD. WHERE THE CLEARANCE IS NOT SUFFICIENT, THE FENCE SHALL BE TERMINATED WITH CROSS CONNECTIONS AND END POSTS ADJACENT TO THE BRIDGE ABUTMENTS OR CULVERT WINGWALLS.

SPLICE FOR WOVEN WIRE BETWEEN PULL POST SHALL BE BY THE "WESTERN UNION METHOD" AS DESCRIBED AS FOLLOWS: THE VERTICAL WIRES FOR EACH END OF THE FENCE FABRIC SHALL BE PLACED SIDE BY SIDE AND THE PROJECTING HORIZONTAL WIRES SHALL BE WRAPPED A MINIMUM OF 4 TIMES AROUND THE HORIZONTAL WIRES OF THE FIRST WEB.



SPLICE FOR BARBED WIRE BETWEEN PULL POST ASSEMBLY SHALL BE BY THE "EYE METHOD" AS DESCRIBED AS FOLLOWS: THE ENDS OF THE BARBED WIRE SHALL BE BENT TO FORM A LOOP. THE LOOPS SHALL BE CONNECTED. AFTER THE LOOPS ARE CONNECTED THE ENDS OF THE WIRE SHALL BE WRAPPED AROUND THE PROJECTING WIRE A MINIMUM OF 4 TIMES FOR EACH WIRE LOOP.

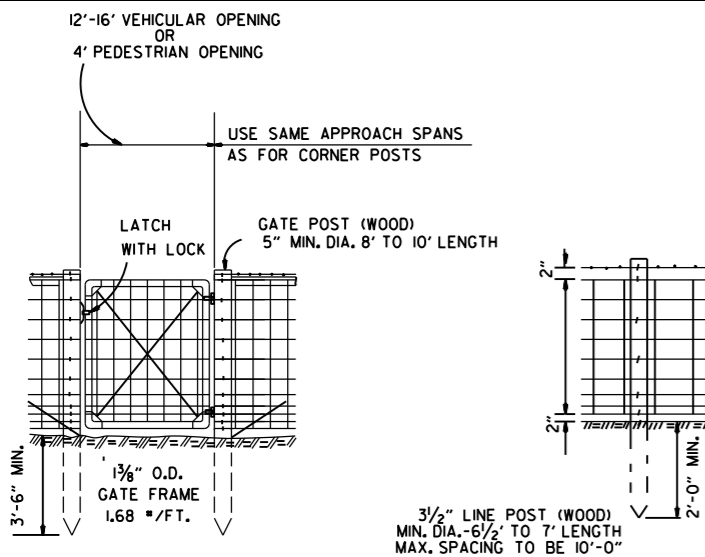


NOTE: STAPLE AT LEAST TOP, BOTTOM AND ALTERNATE WIRES OF WOVEN FABRIC FOR WOOD LINE POSTS.

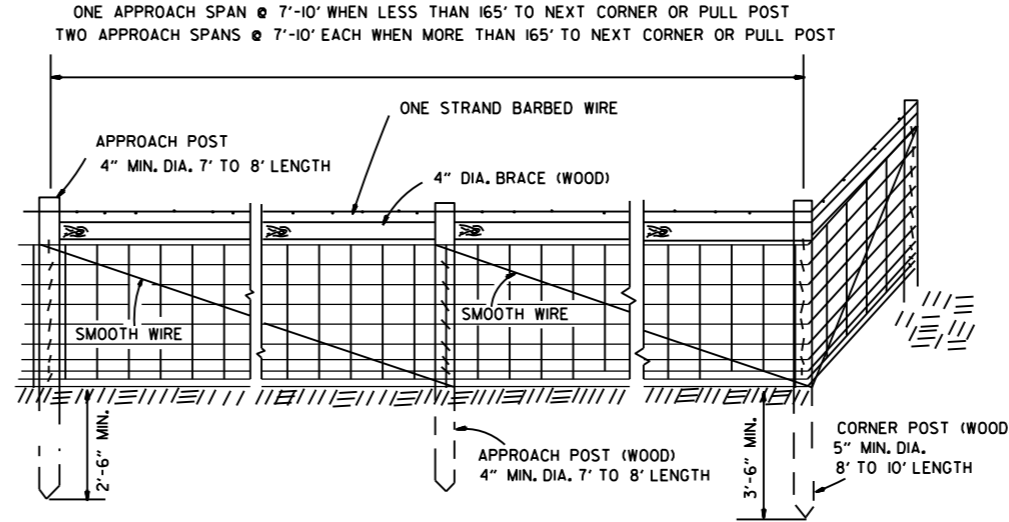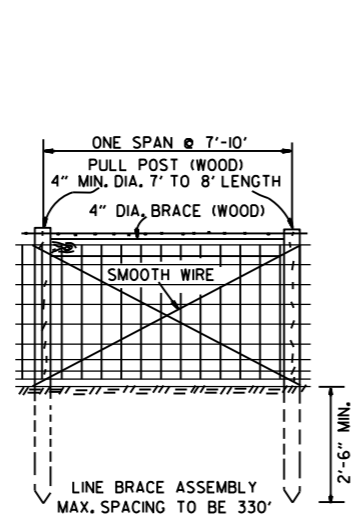

TYPE A FENCE (WOOD POSTS)

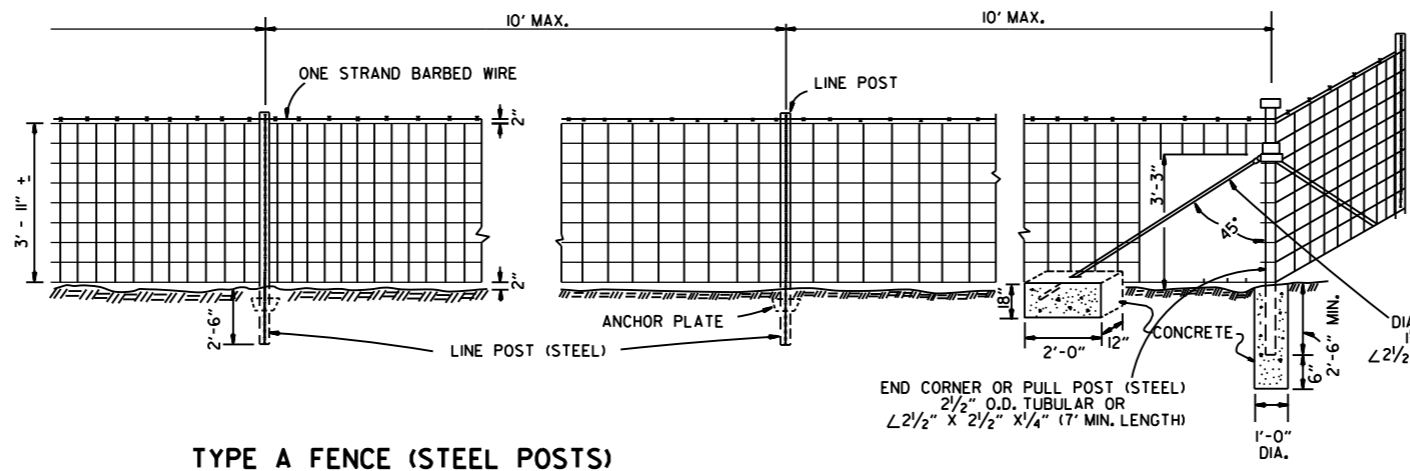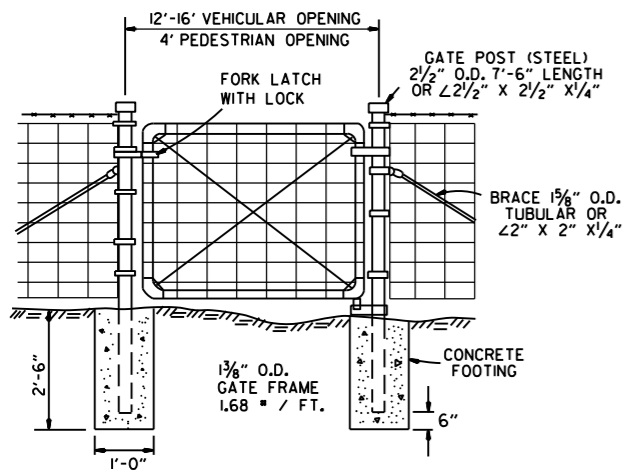


TYPE A FENCE (STEEL POSTS)

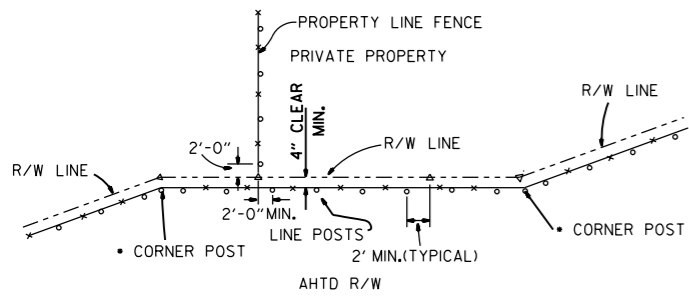

NOTE: RIGHT-OF-WAY MONUMENTS SHALL NOT BE DISTURBED BY FENCE CONSTRUCTION. CORNER POSTS SHALL BE CONSTRUCTED 2' FROM THE RIGHT-OF-WAY MONUMENT OR AS DIRECTED BY THE ENGINEER.



△ - R/W MONUMENTS  
 ○ - FENCE POSTS

RIGHT-OF-WAY FENCE LOCATION

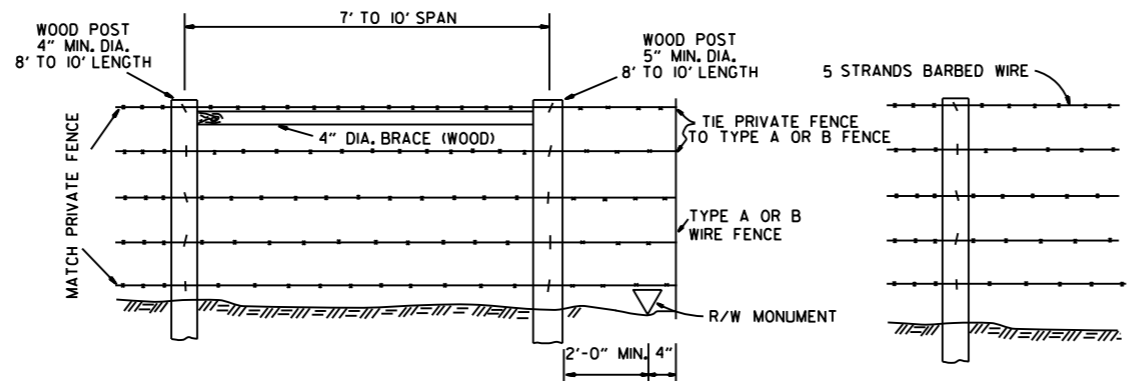

WHERE EXISTING PRIVATE FENCE CONSISTS OF STEEL POSTS, USE END POST ASSEMBLY AS SHOWN WITH TYPE A FENCE OR OTHER END POST ASSEMBLY AS APPROVED BY THE ENGINEER.

PRIVATE FENCE TERMINAL INSTALLATION

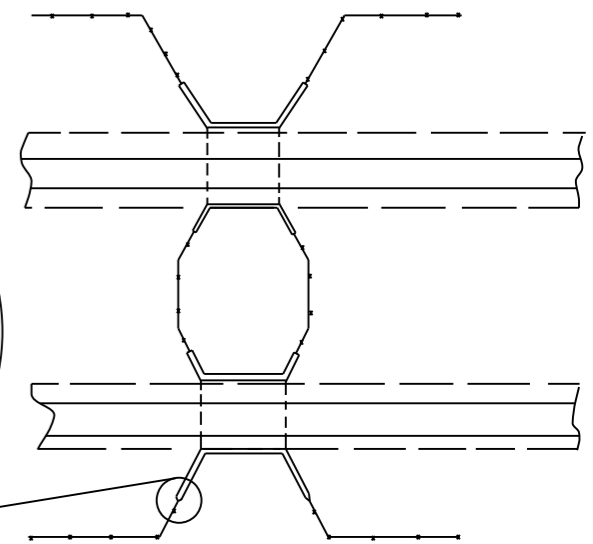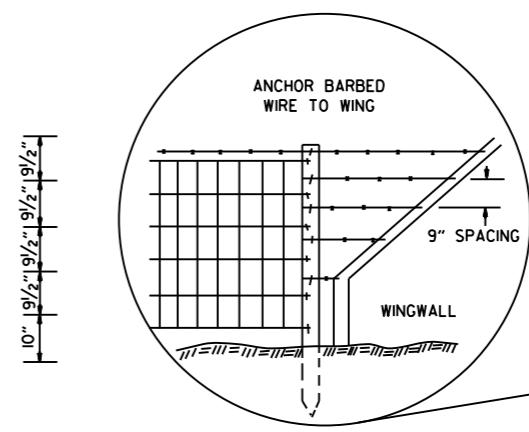

DETAIL OF FENCE CONSTRUCTION AT LARGE CULVERTS (5' IN HEIGHT AND OVER)

TYPE B FENCE


SPACING AND SIZE OF POSTS FOR TYPE B FENCE SHALL BE THE SAME AS TYPE A FENCE.

8-22-02	REVISED GENERAL NOTES	
10-18-96	REVISED ASTM REF. TO AASHTO	
11-22-95	REVISED R-O-W LOCATION DETAIL	
6-2-94	ADDED CORNER POST NOTE	6-2-94
8-5-93	REVISED R-O-W LOCATION DETAIL	8-5-93
10-1-92	ADDED STAPLE NOTE	
8-2-90	REV'D PULL POST LENGTH	
11-30-89	DELETED CLASS CONC.	
7-15-88	ADDED SPLICE NOTES	
7-15-88	ADDED HEIGHT DIMENSION	
4-3-87	REVISED VARIOUS NOTES	
	AND GENERAL NOTES	
11-84	MAX. POST SPACING	
1-4-83	MIN. DIA. LINE POST	
10-2-72	REVISED & REDRAWN	
DATE	REVISION	DATE FILMED

ARKANSAS STATE HIGHWAY COMMISSION

WIRE FENCE  
 TYPE A AND B

STANDARD DRAWING WF-1

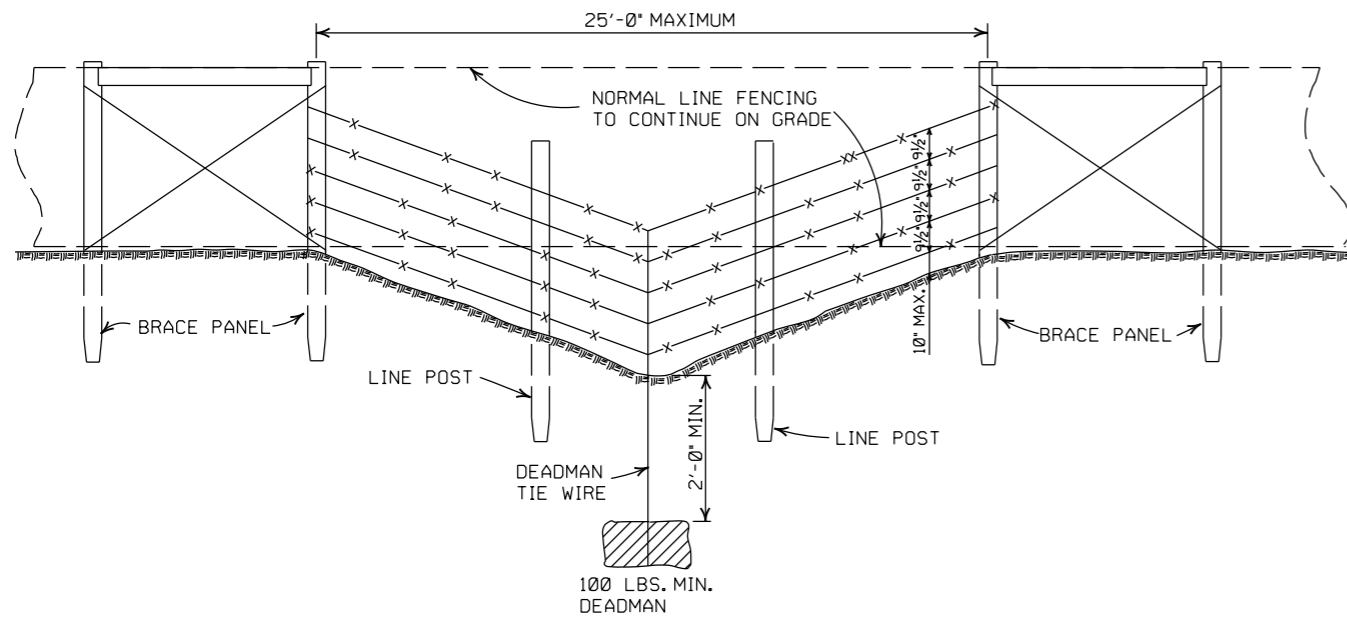



GENERAL NOTES:

THESE INSTALLATIONS TO BE USED WHERE NORMAL FENCING INSTALLATION WOULD CAUSE THE COLLECTING OF DRIFT IN THE CHANNEL OR THE DEPRESSION WILL NOT PERMIT NORMAL INSTALLATION. INSTALLATIONS WILL BE MADE ONLY WHERE DIRECTED BY THE ENGINEER.

WHEN A FENCE LINE APPROACHES A DITCH, GULLY OR DEPRESSION, THE LAST POST ON LEVEL GROUND SHALL BE PLACED CLOSE ENOUGH TO THE EDGE OF THE DROP OFF THAT THE FENCE MAY BE STRUNG TO THE POST IN THE DEPRESSION WITHOUT TOUCHING THE GROUND.

IN TERRAIN OF SUCH EXTREME IRREGULARITY THAT MINOR GRADING WILL NOT BE FEASIBLE, THE NORMAL FENCE SHALL CONTINUE ON GRADE AND THE GULLIES OR DEPRESSIONS TREATED BY AUXILIARY FENCES AS SHOWN.

PAYMENT FOR THE TYPE INSTALLATION USED WILL NOT BE MADE DIRECTLY BUT WILL BE INCLUDED IN THE CONTRACT UNIT PRICE BID FOR WIRE FENCE OR CHAIN LINK FENCE.

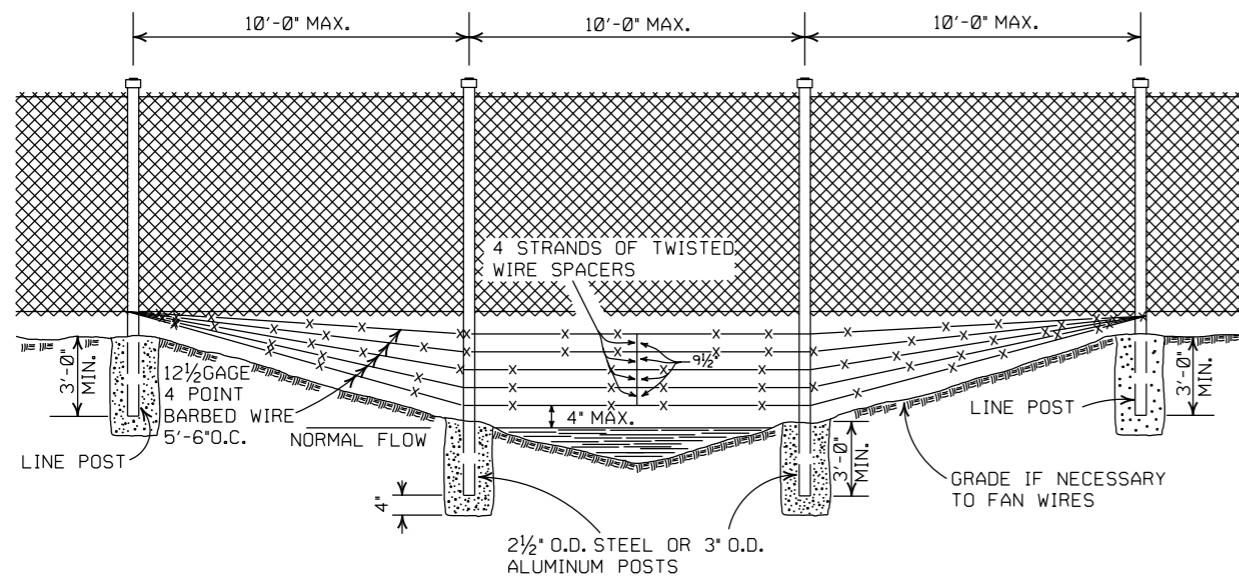
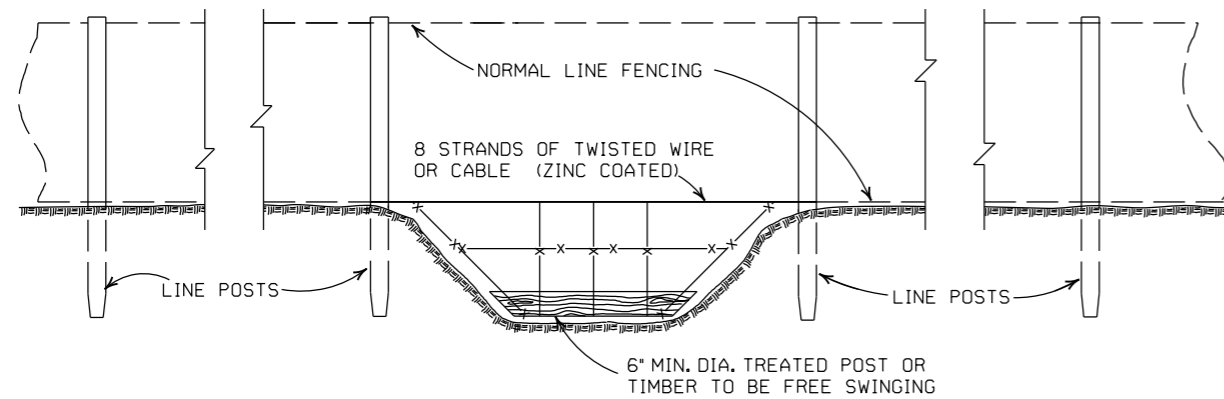


4-20-79	REVISED TOP RAIL & TENSION WIRE	696-4-20-79
10-2-72	REVISED AND REDRAWN	529-10-2-72
DATE	REVISION	FILMED

ARKANSAS STATE HIGHWAY COMMISSION

**WIRE FENCE WATER GAPS**

STANDARD DRAWING WF-2

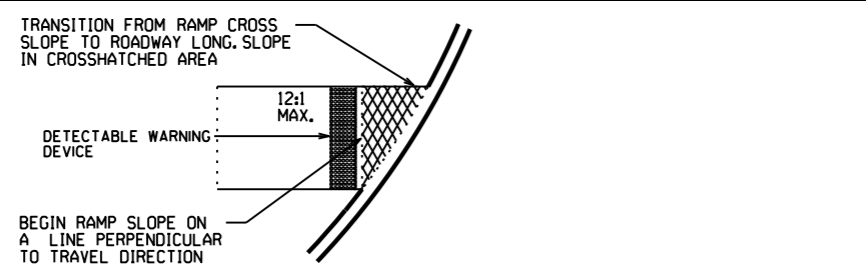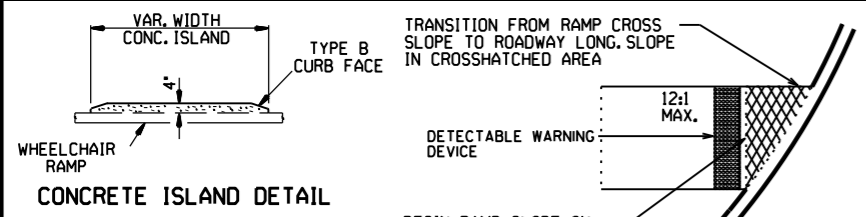


**TYPE 1 RAMP DIMENSIONS AND QUANTITIES**




RADIUS "R"	DISTANCE "X"	DISTANCE "Y"	LENGTH "L"	RAMP AREA "A"
FEET	FEET	FEET	FEET	SQ. YD.
15	11.67	18.82	32.18	26.21
20	11.52	22.28	35.46	30.07
25	11.43	26.60	38.77	33.80
30	11.37	30.26	40.93	36.90
35	11.33	33.51	43.11	39.77
40	11.30	36.45	45.26	42.45
45	11.27	39.16	47.34	44.97
50	11.25	41.69	49.36	47.35
55	11.24	44.07	51.31	49.63
60	11.22	46.33	53.21	51.80

**GENERAL NOTES FOR DETECTABLE WARNING DEVICES**


THE DETECTABLE WARNING DEVICE SHALL BE LOCATED SO THAT THE NEAREST EDGE OF THE DEVICE IS 6 TO 8 INCHES FROM THE FACE OF THE CURB. TRUNCATED DOMES IN THE DETECTABLE WARNING SURFACE SHALL MEET THE REQUIREMENTS OF THE GEOMETRIC CONFIGURATION SHOWN. DOMES SHALL BE ALIGNED ON A SQUARE GRID IN THE PREDOMINANT DIRECTION OF TRAVEL TO PERMIT WHEELS TO ROLL BETWEEN DOMES. DETECTABLE WARNING DEVICE SHALL BE 24 INCHES IN THE DIRECTION OF TRAVEL AND EXTEND THE FULL WIDTH OF THE CURB RAMP OR FLUSH SURFACE. DETECTABLE WARNING DEVICE SHALL BE ON THE AHTD QUALIFIED PRODUCTS LIST FOR CAST-IN-PLACE TACTILE PANELS (ADA DETECTABLE WARNING).

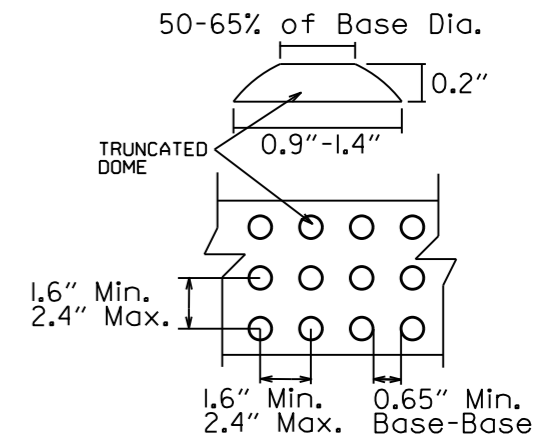

**DETECTABLE WARNING DEVICE DETAIL**

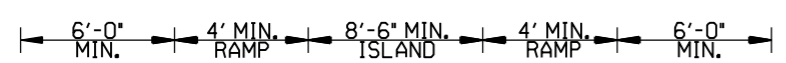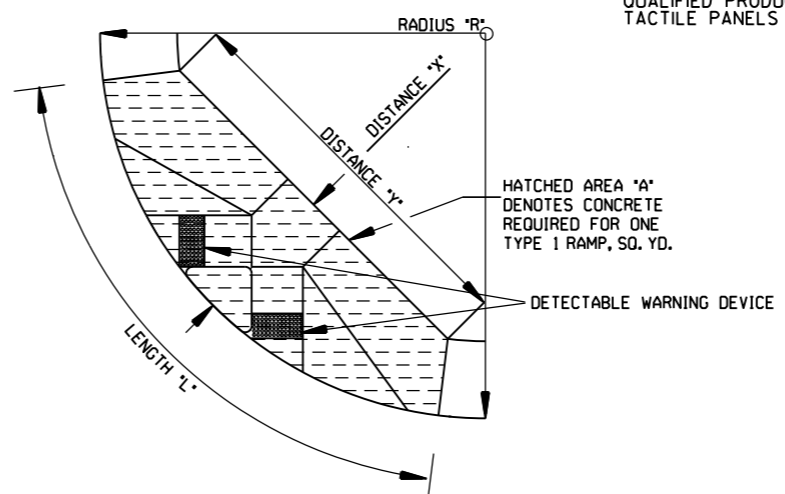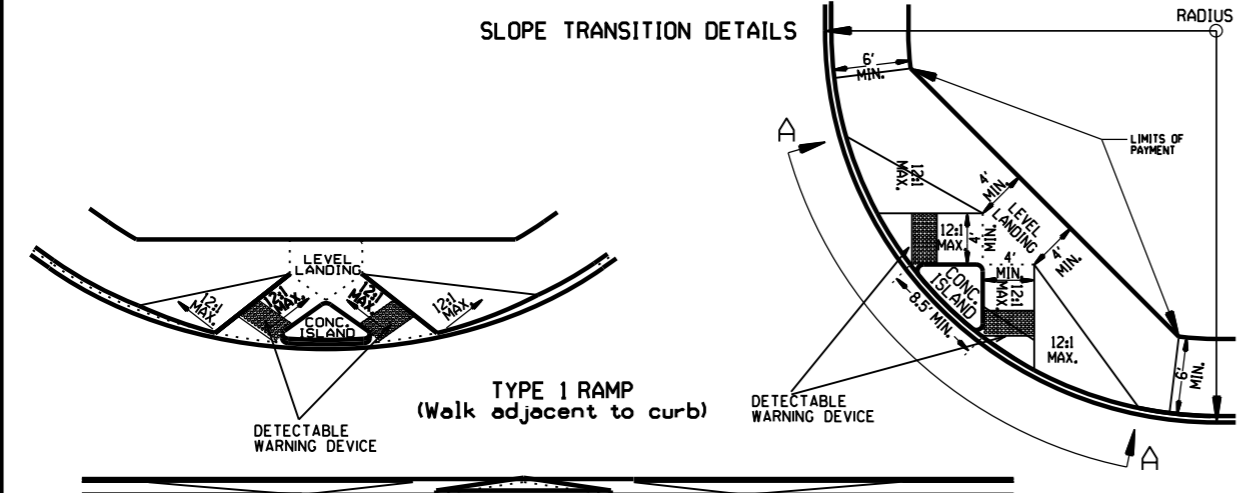


**SECTION A-A**

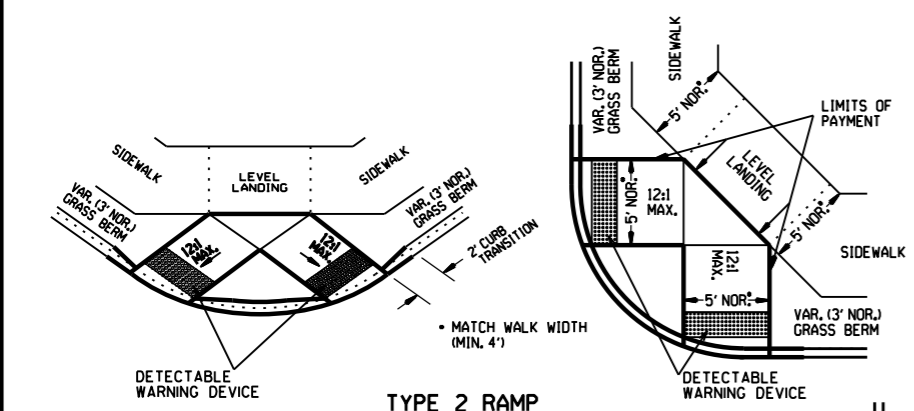


**TYPE 2 RAMP**


**NOTE:** THE CROSS SLOPE OF THE RAMPS, LEVEL LANDINGS, AND SIDEWALKS SHALL NOT EXCEED 2.0% UNLESS REQUIRED TO MATCH STREET LONGITUDINAL GRADE.

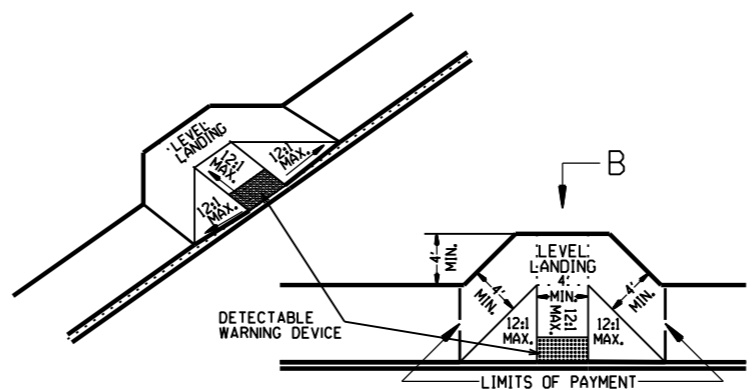

**TYPE 4 RAMP (Walk adjacent to curb)**

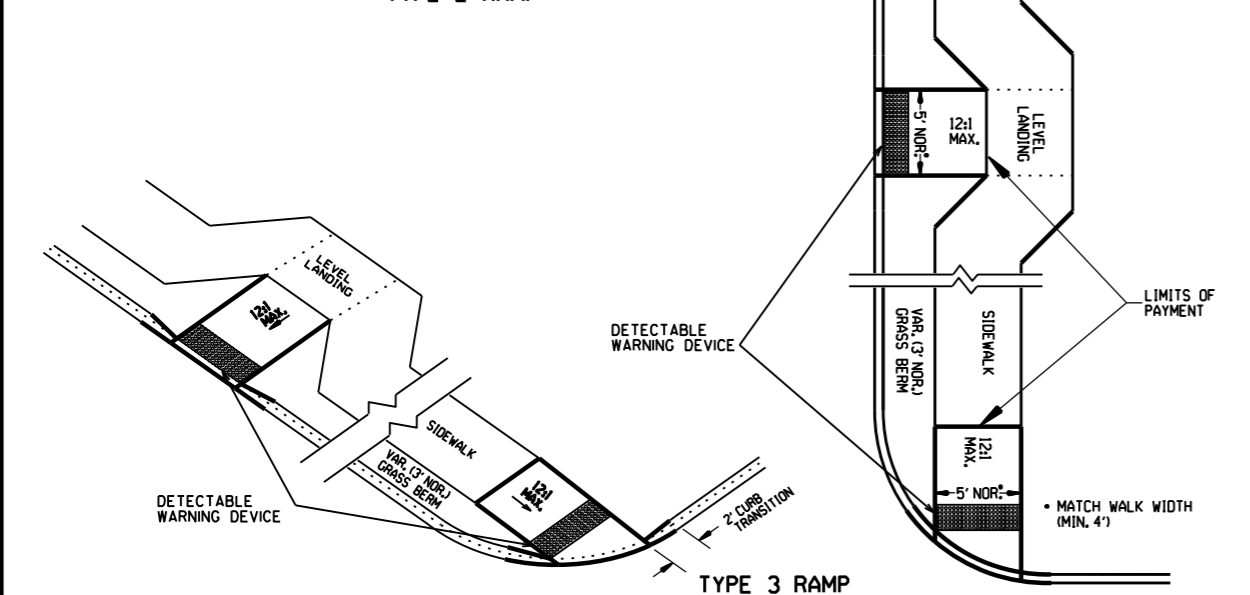

**TYPE 3 RAMP**

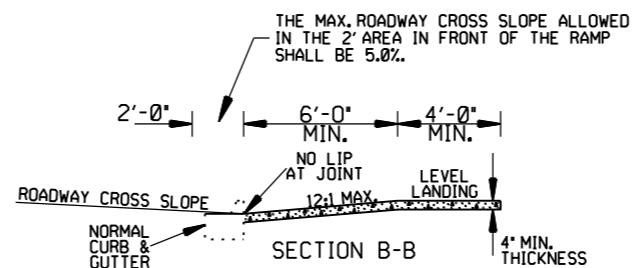

THE MAX. ROADWAY CROSS SLOPE ALLOWED IN THE 2' AREA IN FRONT OF THE RAMP SHALL BE 5.0%.

**RAMP SELECTION CRITERIA**

CHOICE	TYPE	DESCRIPTION
FIRST CHOICE	TYPE 1	CORNER LOCATIONS WITH THE WALK ADJACENT TO THE CURB (BOTH NEW CONSTRUCTION AND ALTERATIONS).
	TYPE 2	CORNER LOCATIONS WITH THE WALK OFFSET FROM THE CURB A DISTANCE INSUFFICIENT TO ALLOW THE REQUIRED RAMP SLOPE (BOTH NEW CONSTRUCTION AND ALTERATIONS).
	TYPE 3	CORNER LOCATIONS WITH THE WALK OFFSET FROM THE CURB A DISTANCE SUFFICIENT TO ALLOW THE REQUIRED RAMP SLOPE (BOTH NEW CONSTRUCTION AND ALTERATIONS).
	TYPE 4	TANGENT LOCATIONS (BOTH NEW CONSTRUCTION AND ALTERATIONS).
SECOND CHOICE	TYPE 5	TANGENT LOCATIONS (ALTERATIONS ONLY).
THIRD CHOICE	TYPE 6	CORNER LOCATIONS (ALTERATIONS ONLY). THIS RAMP MAY BE USED ONLY IF THE TYPE 5 RAMPS CANNOT BE PLACED AT THE ENDS OF THE RADIUS.
FOURTH CHOICE		IF SITE CONSTRAINTS PREVENT THE CONSTRUCTION OF ANY OF THE TYPES LISTED, THEN AND ONLY THEN CAN THE 12:1 MAX. SLOPE ON THE RAMP BE EXCEEDED TO PROVIDE ACCESS TO THE STREET LEVEL (ALTERATIONS ONLY). THE SLOPE CAN BE STEEPENED TO A 10:1 MAX. FOR A MAX. LENGTH OF 5' OR A 8:1 MAX. FOR A MAX. LENGTH OF 2'. SLOPES STEEPER THAN 8:1 ARE NOT ALLOWED UNDER ANY CIRCUMSTANCES.

**NOTE:** IN ALTERATIONS, THE SELECTION OF THE TYPE OF WHEELCHAIR RAMP TO BE CONSTRUCTED SHALL BE BASED ON THE AMOUNT OF RIGHT-OF-WAY AVAILABLE, AND ON THE PRESENCE OF OTHER SITE CONSTRAINTS (UTILITIES, BUILDINGS, ETC.). THE TABLE ABOVE LISTS THE ORDER IN WHICH THE RAMPS ARE TO BE CONSIDERED. AN ALTERATION IS DEFINED AS A PROJECT THAT CHANGES OR AFFECTS THE USE OF A PEDESTRIAN PATHWAY (OVERLAYS, SIGNALIZATION PROJECTS, ETC.) BUT DOES NOT REQUIRE THE PURCHASE OF ADDITIONAL RIGHT-OF-WAY. ALL PROJECTS THAT REQUIRE THE PURCHASE OF ADDITIONAL RIGHT-OF-WAY WILL USUALLY BE CONSIDERED NEW CONSTRUCTION FOR THE PURPOSES OF THE CHART ABOVE.

DATE	REVISION	DATE FILM
11-10-05	REVISED TO NEW SIDEWALK POLICY	
10-9-03	REVISED GEN. NOTES & ADDED NOTE	
4-10-03	REV. DETECTABLE WARNING DEVICES	
8-22-02	ADD DETECTABLE WARNING DEVICES	
3-30-00	ADD SLOPE TRANS. & REV. ISL. DIMS.	
11-18-98	REVISED NOTES	
8-12-98	REVISED TEXTURE	
7-02-98	REDRAWN & REISSUED	
10-18-96	CORRECTED DIMENSIONS	10-18-96
5-24-90	FROM 10:1 MAX. SLOPES	5-24-90
7-15-88	ADJUSTED MAX. SLOPE	652-7-15-88
7-14-88	INCL. "CONC. ISLD." IN PAY ITEM	
6-02-76	ISSUED-P.H.D.	299-7-28-76


**ARKANSAS STATE HIGHWAY COMMISSION**

**WHEELCHAIR RAMPS  
NEW CONSTRUCTION  
AND ALTERATIONS**

**STANDARD DRAWING WR-1**

DATE REVISED	DATE FILMED	DATE REVISED	DATE FILMED	FED. RD. DIST. NO.	STATE	FED. AID PROJ. NO.	SHEET NO.	TOTAL SHEETS
				6	ARK.			
				JOB NO.	080517	142	182	

2 CROSS SECTIONS

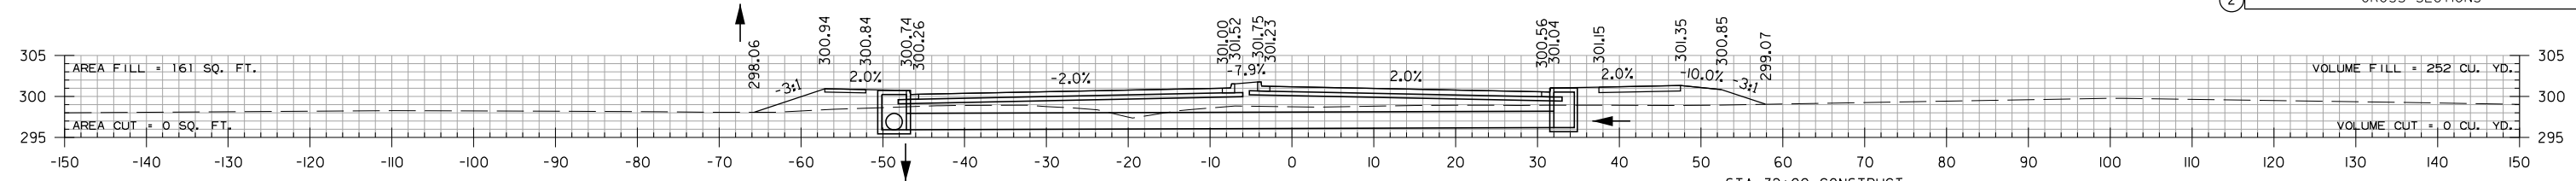


STA. 32+00 CONSTRUCT DROP INLET ON LT., H = 4'-10" W/ 24" X 166" R.C. PIPE CULVERT TO DROP INLET ON LT. TYPE MO INLET = 4'-0" DIA. TYPE C INLET = 4'-0" X 3'-0"


+00 LT. TOP = 300.74 INV. = 295.91

+00 RT. TOP = 301.04 INV. = 296.21


STA. 32+00 CONSTRUCT DROP INLET ON RT., H = 4'-10" W/ 8' EXT. AND 24" X 79" R.C. PIPE CULVERT TO DROP INLET ON LT. TYPE MO INLET = 4'-0" DIA. TYPE C INLET = 4'-0" X 2'-6"

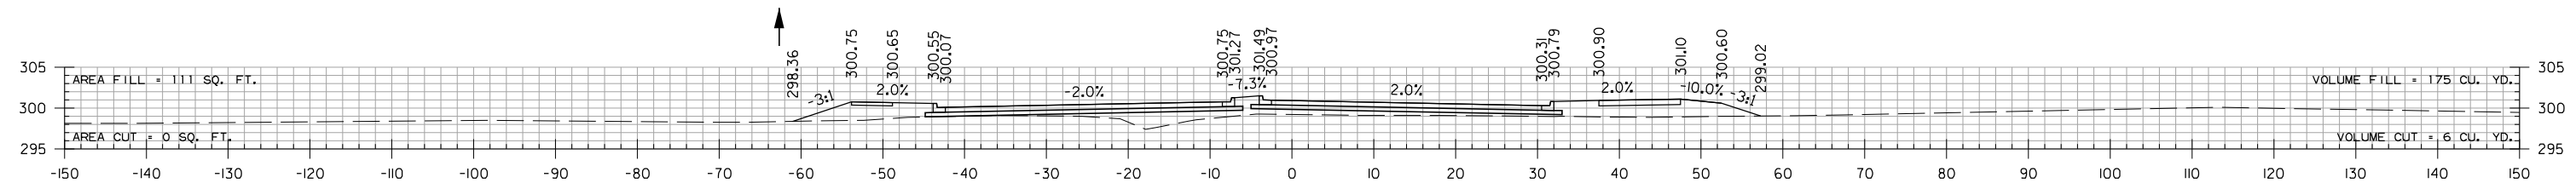


31+50.00

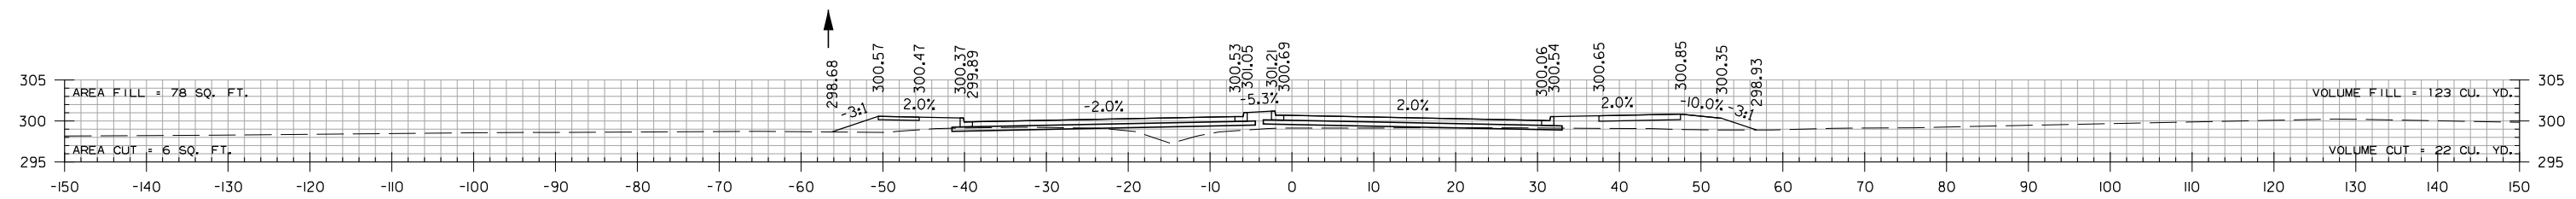

31+00.00

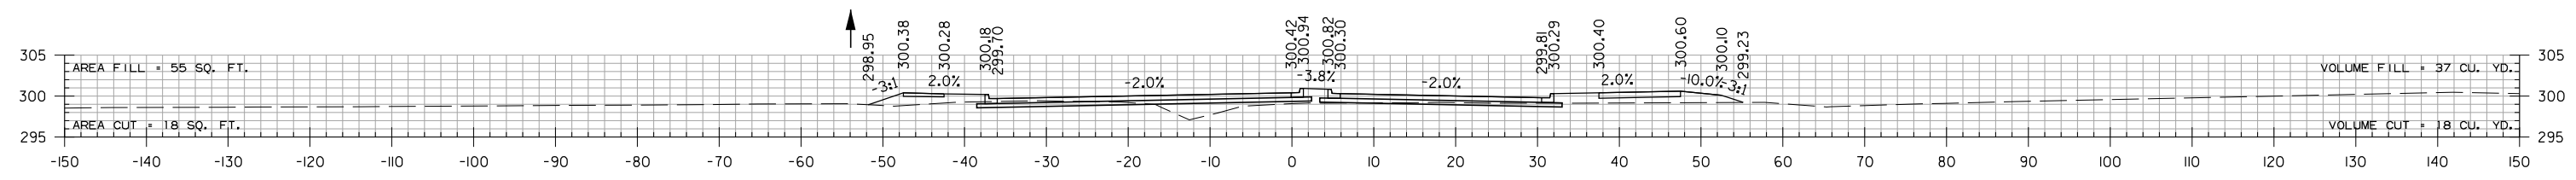

30+50.00

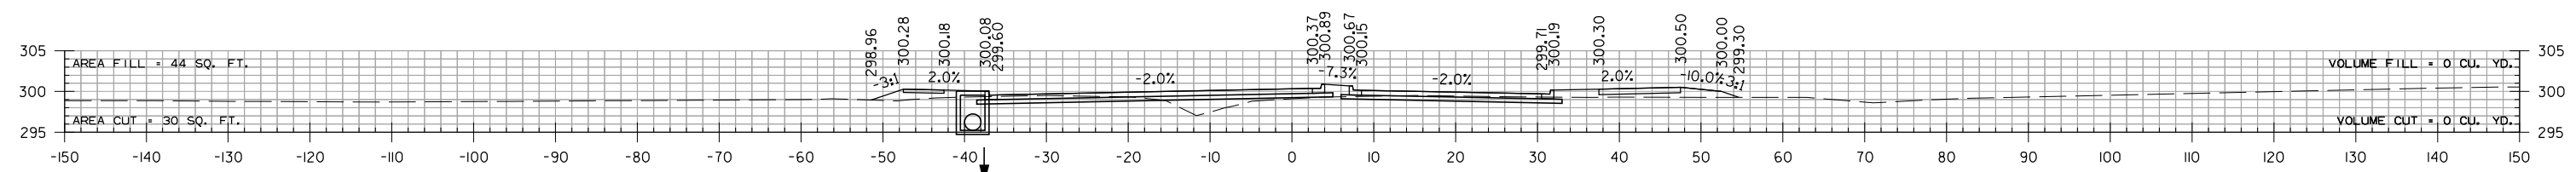

30+30.00

STA. 30+30 CONSTRUCT DROP INLET ON LT., H = 4'-10" MATCH CITY OF CONWAY PROJECT TYPE MO INLET = 4'-0" DIA. TYPE C INLET = 4'-0" X 3'-0"

+30 LT. TOP = 300.08 INV. = 295.25





STA. 30+30.00 BEGIN CONSTRUCTION

6TH STREET  
STA. 30+30 TO STA. 32+00

5/20/2015 7:13:41AM  
WORKSPACE: AHTD  
L:\2012\12015590 - Conrail\field Access\Drawings\6TH\_ST\6TH.CX.ALL.dgn  
REVISED DATE:


DATE REVISED	DATE FILMED	DATE REVISED	DATE FILMED	FED. RD. DIST. NO.	STATE	FED. AID PROJ. NO.	SHEET NO.	TOTAL SHEETS
				6	ARK.			
				JOB NO.	080517		143	182

2 CROSS SECTIONS

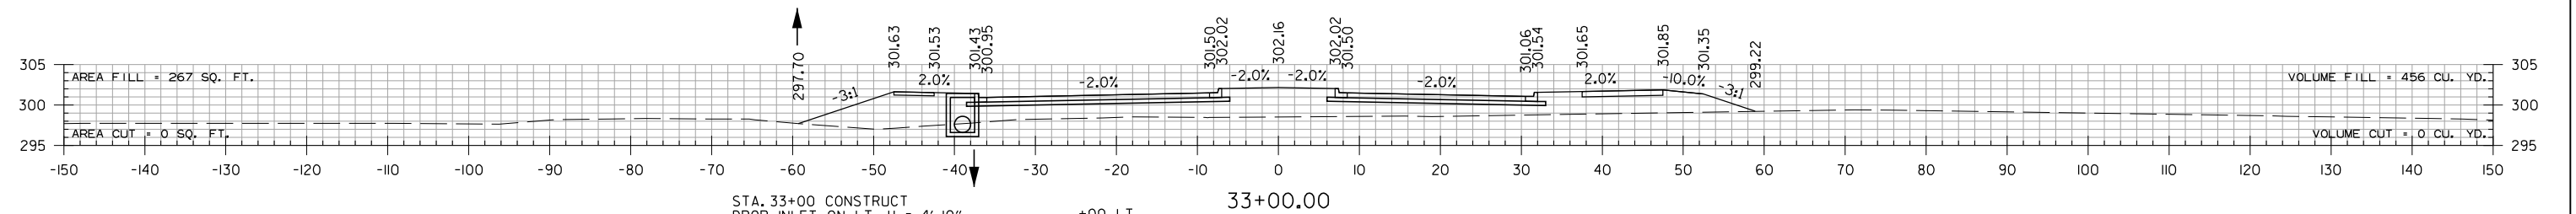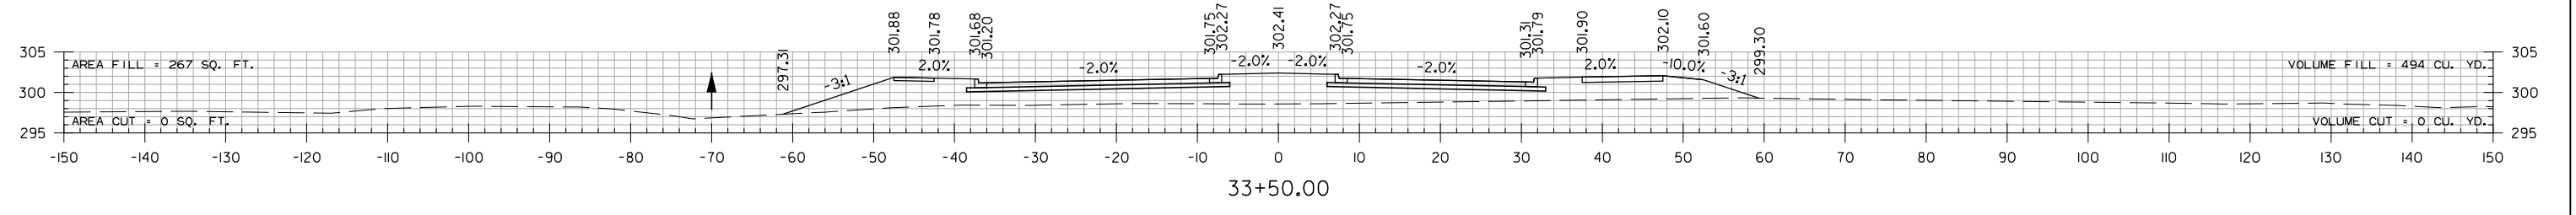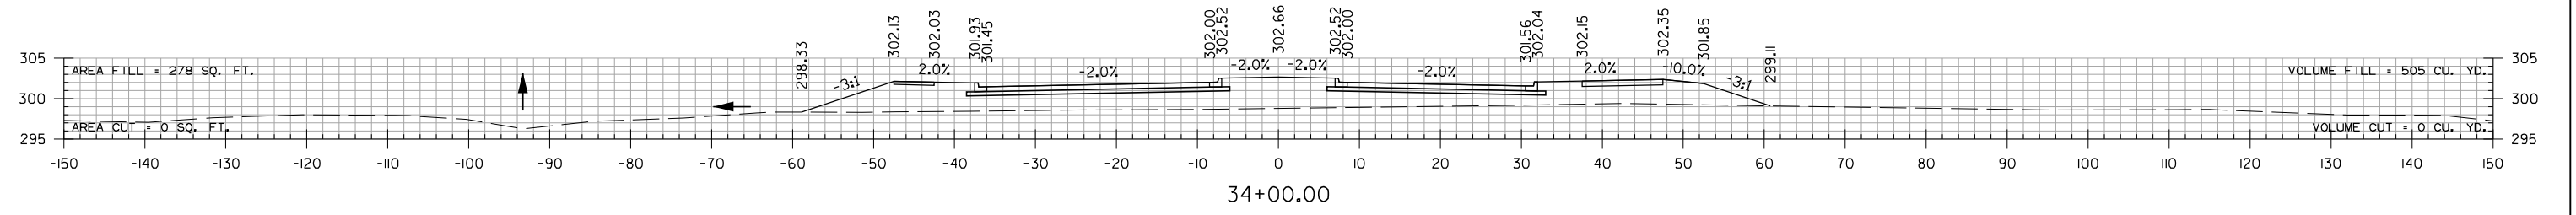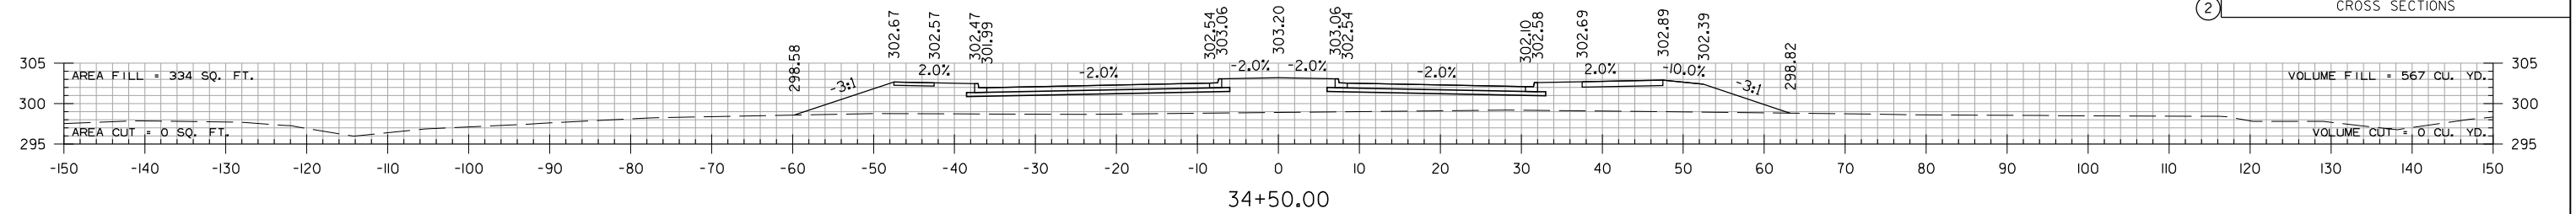

STA. 33+00 CONSTRUCT  
 DROP INLET ON LT., H = 4'-10"  
 W/ 8' EXT. AND 24" X 96"  
 R.C. PIPE CULVERT TO DROP INLET ON LT.  
 TYPE MO INLET = 4'-0" DIA.  
 TYPE C INLET = 4'-0" X 3'-0"

+00 LT.  
 TOP = 301.43  
 INV. = 296.60




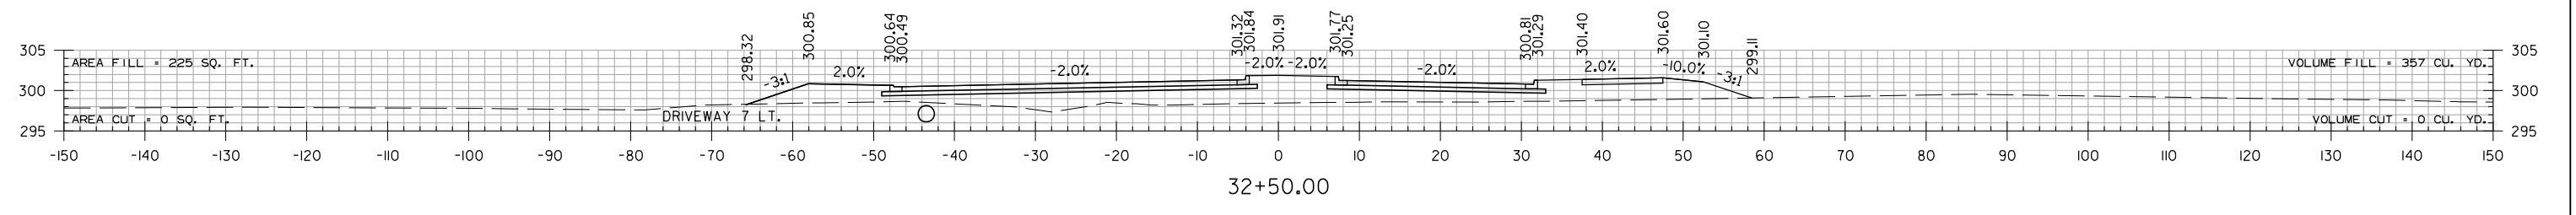


6TH STREET  
 STA. 32+50 TO STA. 34+50

5/20/2015 7:13:42 AM  
 WORKSPACE: AHTD  
 L:\2012\201590 - Contrail\field Access\Drawings\6TH STA\6TH.CX.ALL.dgn  
 REVISED DATE:

DATE REVISED	DATE FILMED	DATE REVISED	DATE FILMED	FED. RD. DIST. NO.	STATE	FED. AID PROJ. NO.	SHEET NO.	TOTAL SHEETS
				6	ARK.			
				JOB NO.	080517	144	182	

2 CROSS SECTIONS

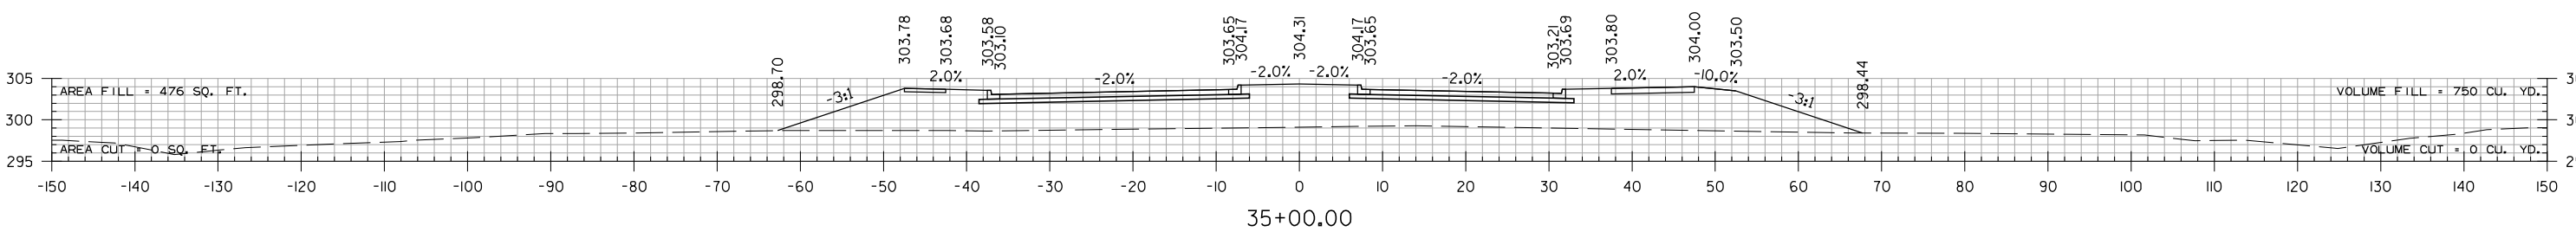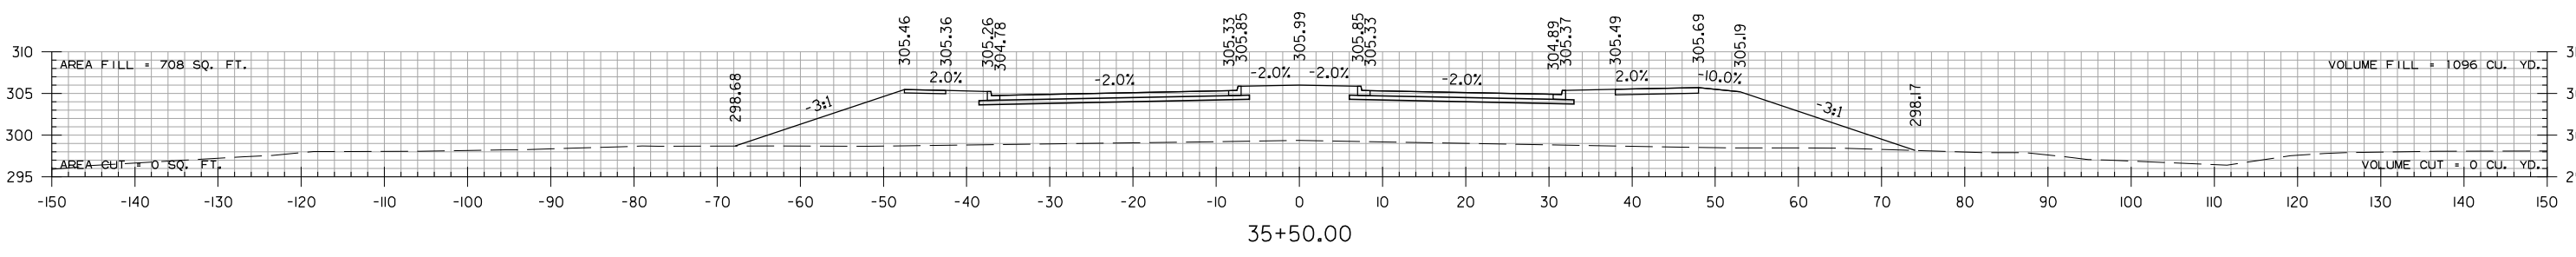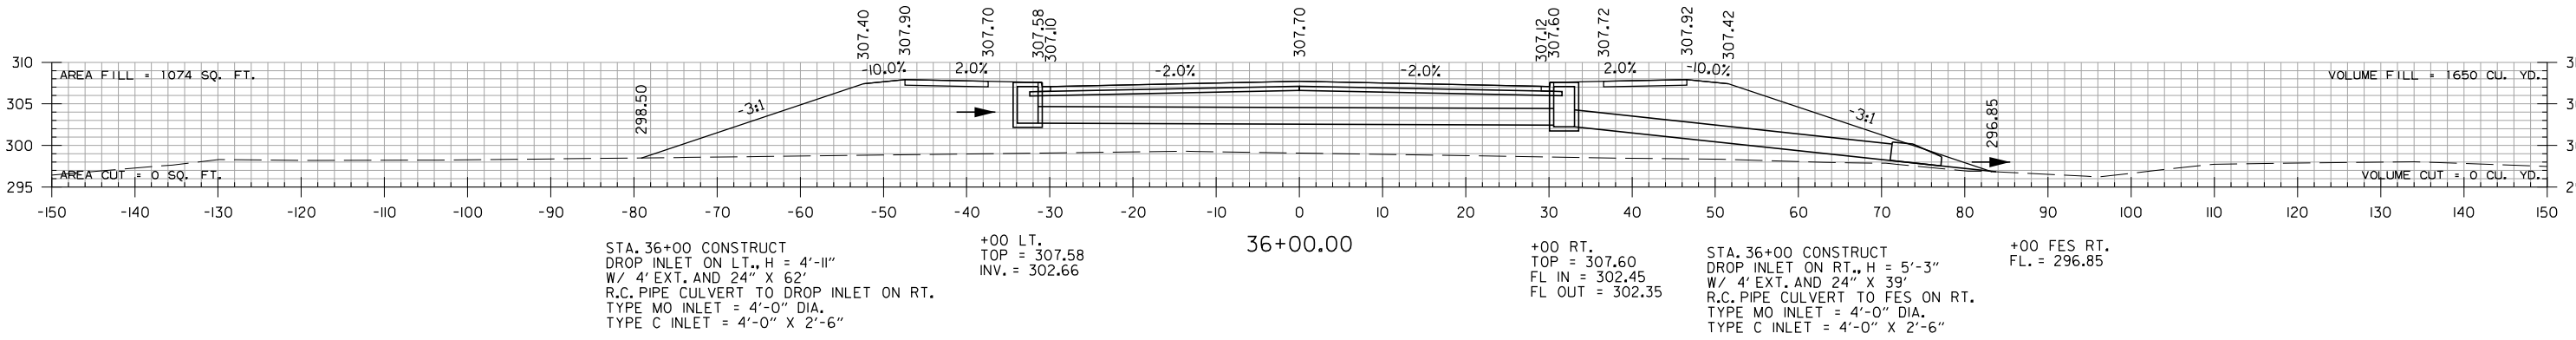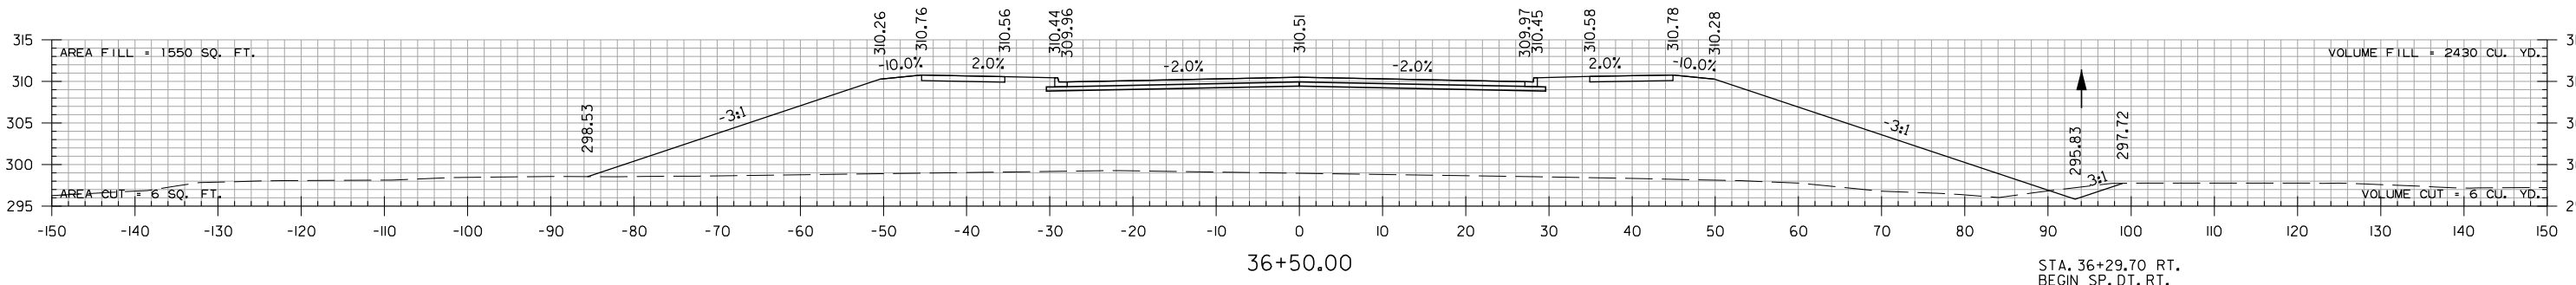



6TH STREET  
STA. 35+00 TO STA. 36+50

5/20/2015 7:13:42 AM  
WORKSPACE: AHTD  
L:\2012\201550 - Contrail\field Access\Drawings\6TH.STA\6TH.CX.ALL.dgn  
REVISED DATE:




DATE REVISED	DATE FILMED	DATE REVISED	DATE FILMED	FED. RD. DIST. NO.	STATE	FED. AID PROJ. NO.	SHEET NO.	TOTAL SHEETS
				6	ARK.			
				JOB NO.	080517	145	182	

2 CROSS SECTIONS

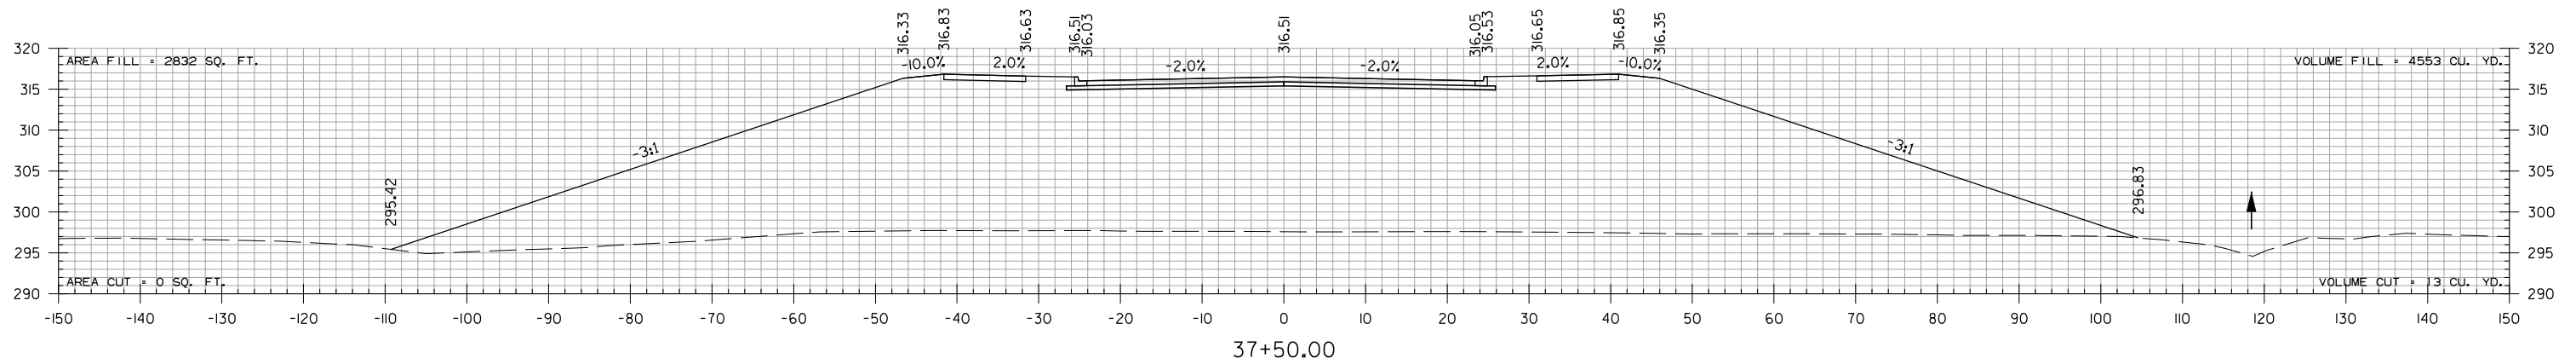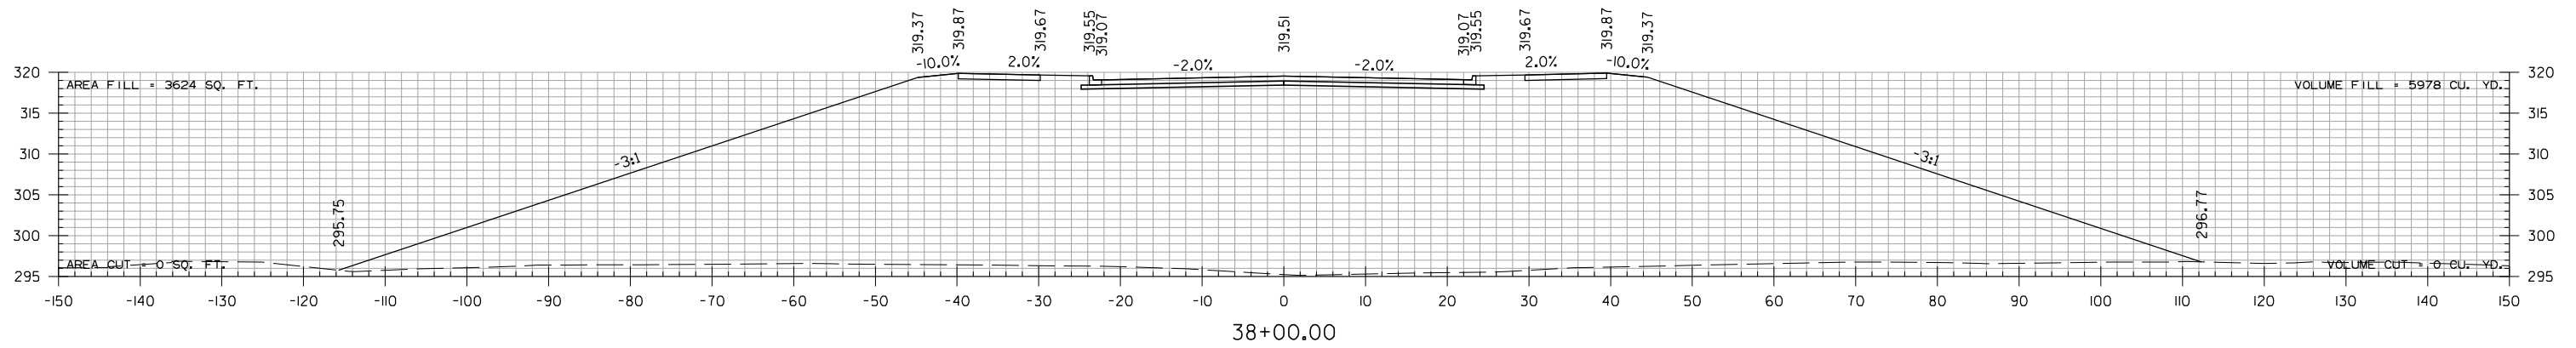



STA. 37+35.27 RT.  
END SP. DT. RT.  
ELEV. = 294.74

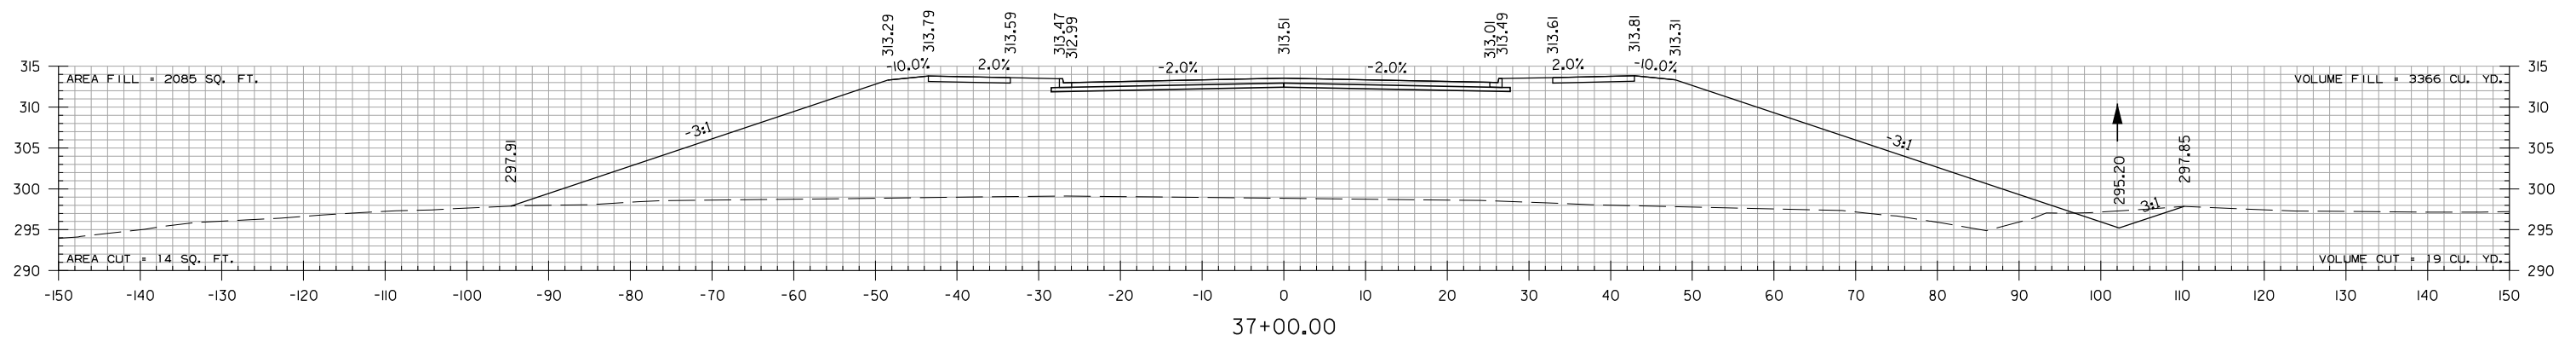

6TH STREET  
STA. 37+00 TO STA. 38+00

5/20/2015 7:13:42 AM  
rccorbyn  
WORKSPACE: AHTD  
L:\2012\201590 - Contrail\field Access\Drawings\6TH STA\6TH.CX.ALL.dgn  
REVISED DATE:


DATE REVISED	DATE FILMED	DATE REVISED	DATE FILMED	FED. RD. DIST. NO.	STATE	FED. AID PROJ. NO.	SHEET NO.	TOTAL SHEETS	
				6	ARK.				
				JOB NO.	080517	146	182		
(2)								CROSS SECTIONS	

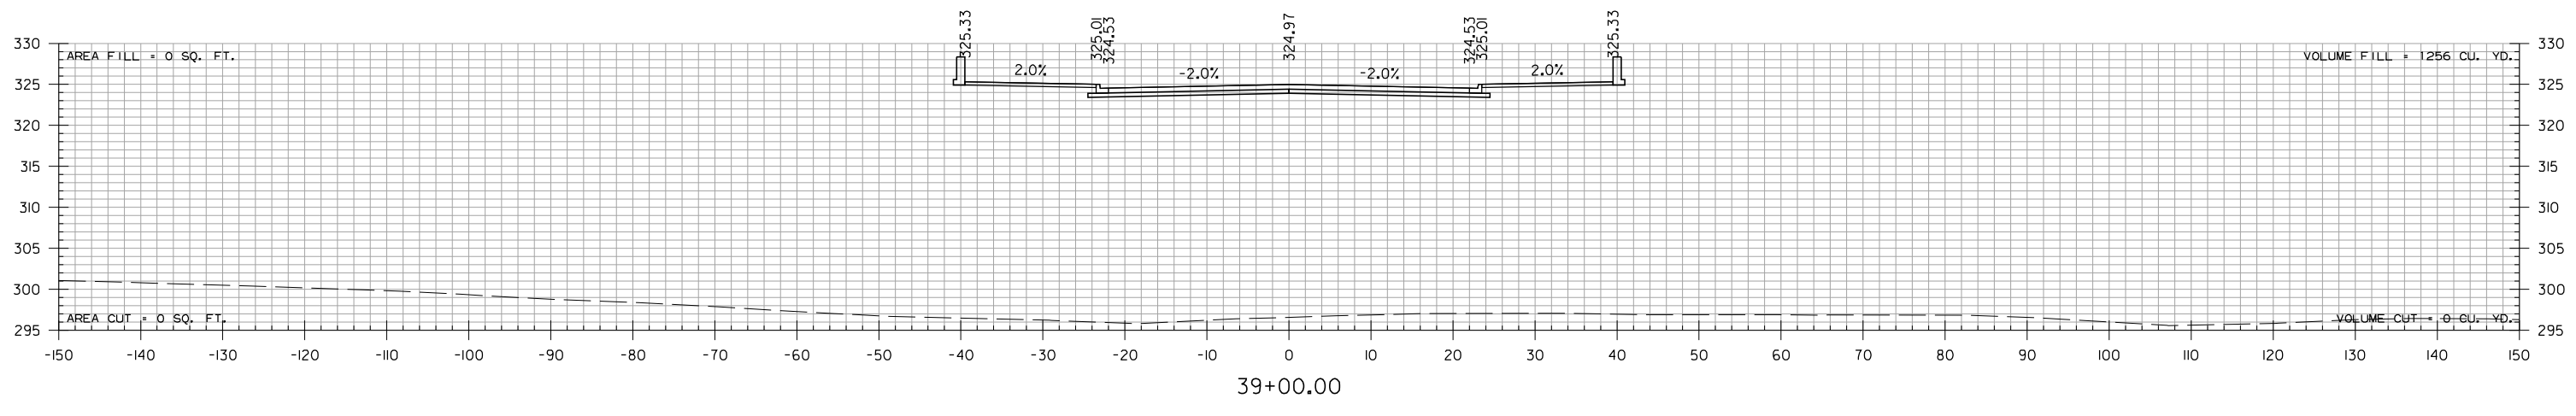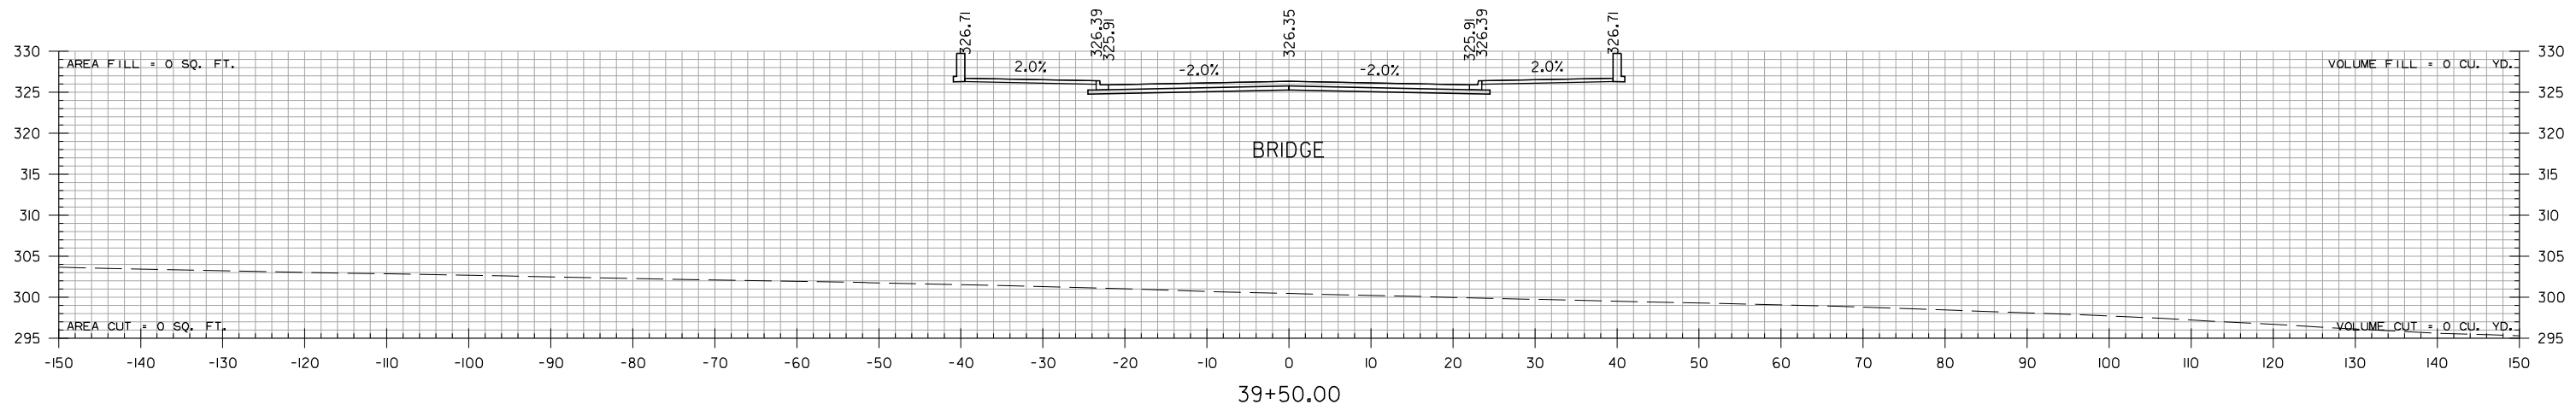

AREA FILL = 4237 SQ. FT.      VOLUME FILL = 5334 CU. YD.

AREA CUT = 0 SQ. FT.      VOLUME CUT = 0 CU. YD.

STA. 38+83.99 BEGIN BRIDGE


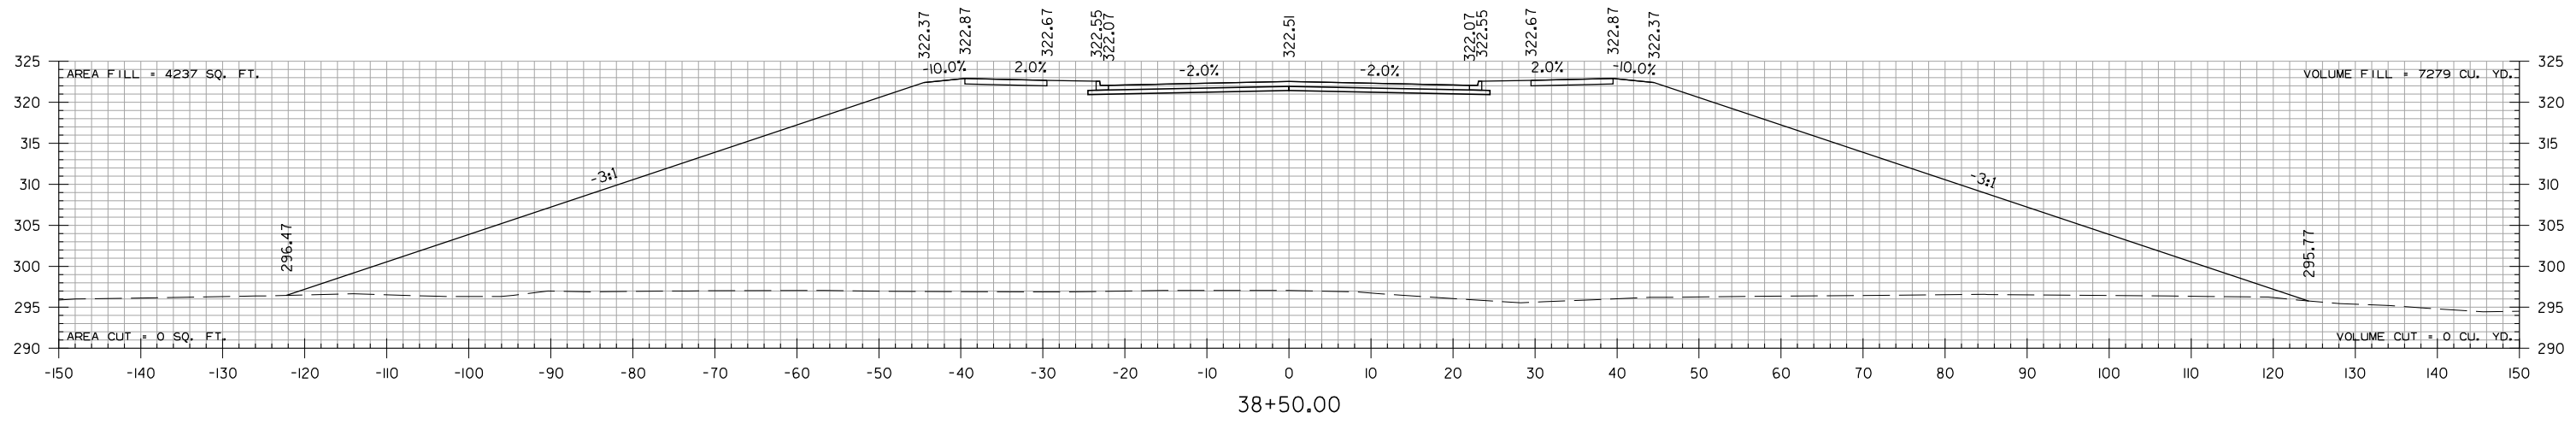


6TH STREET  
STA. 38+50 TO STA. 39+50

5/20/2015 7:13:42 AM  
 WORKSPACE: AHTD  
 L:\2012\1201590 - Contrail\field Access\Drawings\6TH\_ST\6TH.CX.ALL.dgn  
 REVISED DATE:

DATE REVISED	DATE FILMED	DATE REVISED	DATE FILMED	FED. RD. DIST. NO.	STATE	FED. AID PROJ. NO.	SHEET NO.	TOTAL SHEETS
				6	ARK.			
				JOB NO.	080517	147	182	


2 CROSS SECTIONS

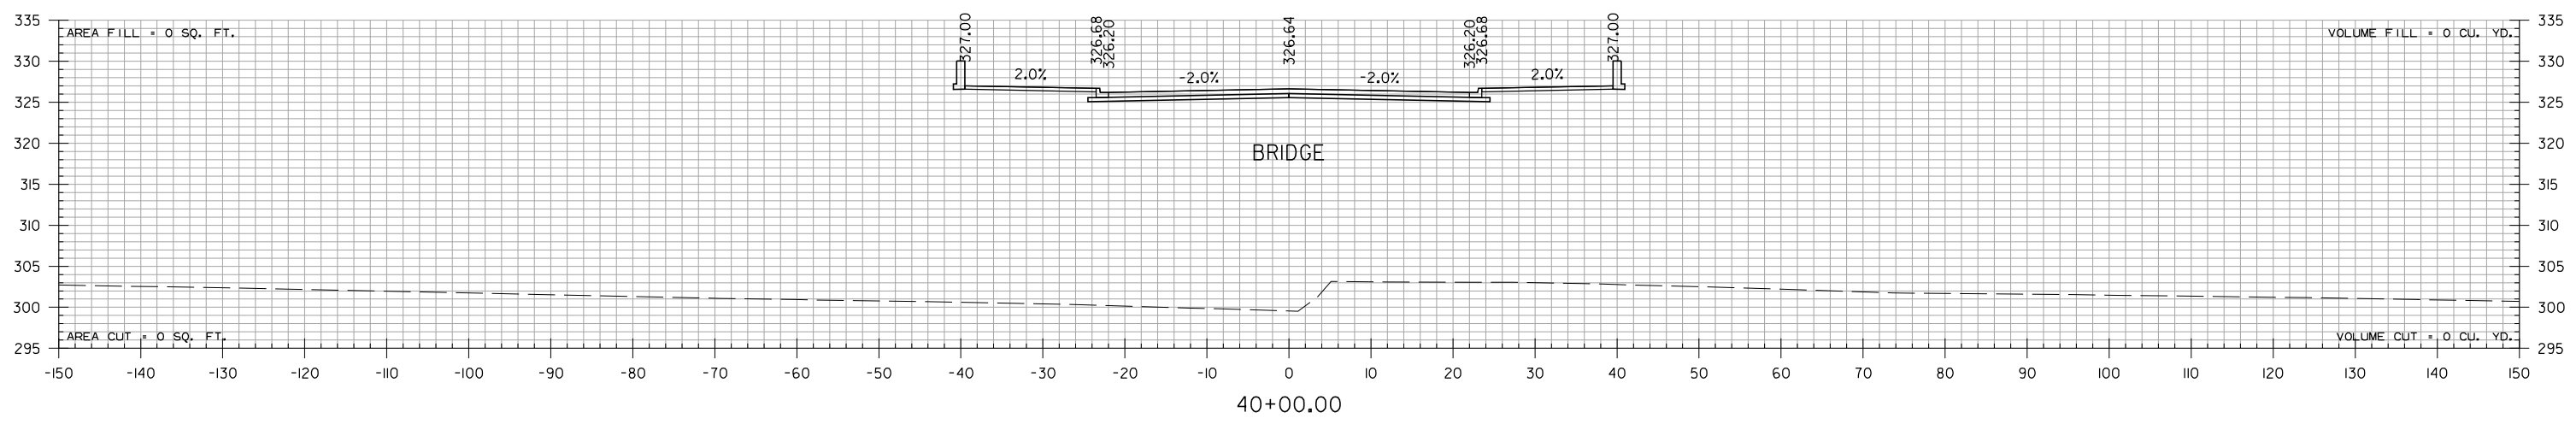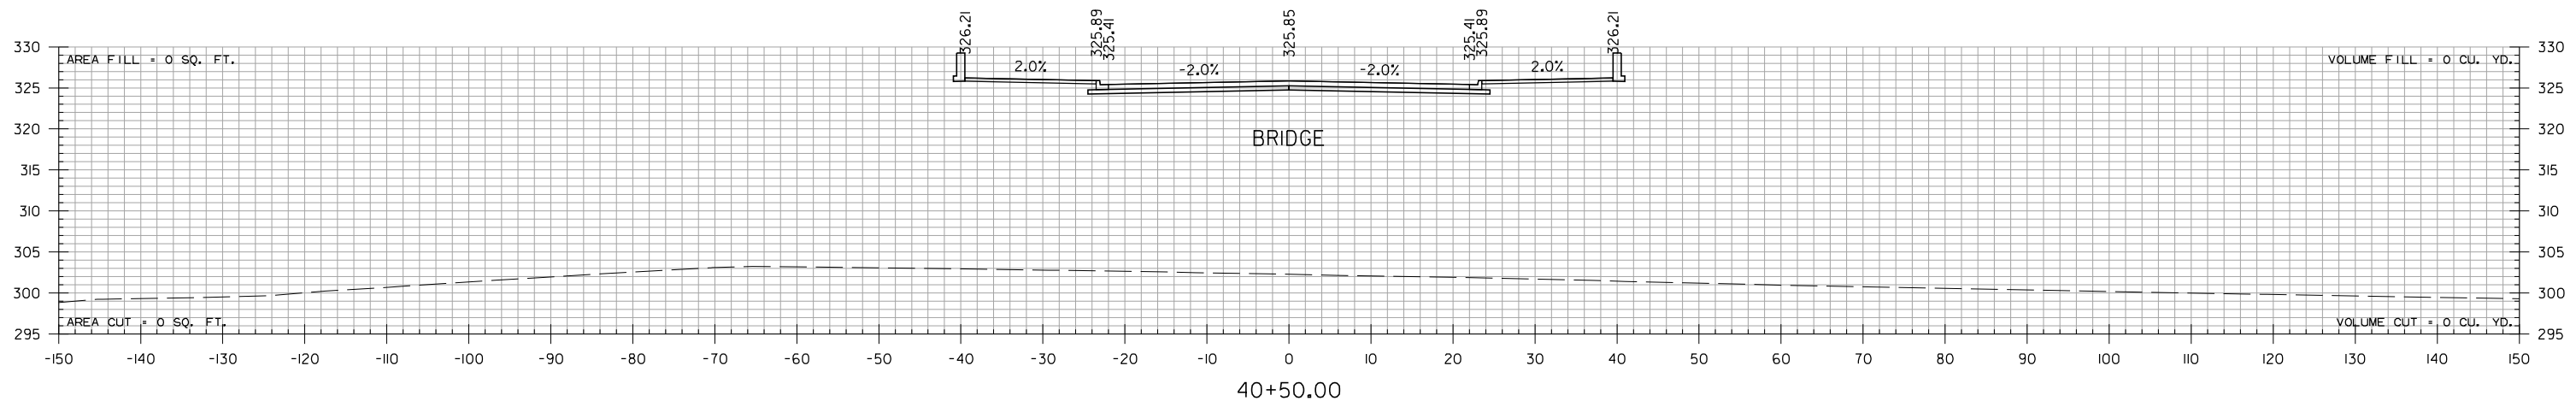


6TH STREET  
STA. 40+00 TO STA. 40+50

5/20/2015 7:13:43 AM  
rccorbyn  
WORKSPACE: AHTD  
L:\2012\201590 - CentrailField Access\Drawings\6TH\_ST\6TH.CX.ALL.dgn  
REVISED DATE:

DATE REVISED	DATE FILMED	DATE REVISED	DATE FILMED	FED. RD. DIST. NO.	STATE	FED. AID PROJ. NO.	SHEET NO.	TOTAL SHEETS
				6	ARK.			
				JOB NO.	080517	148	182	

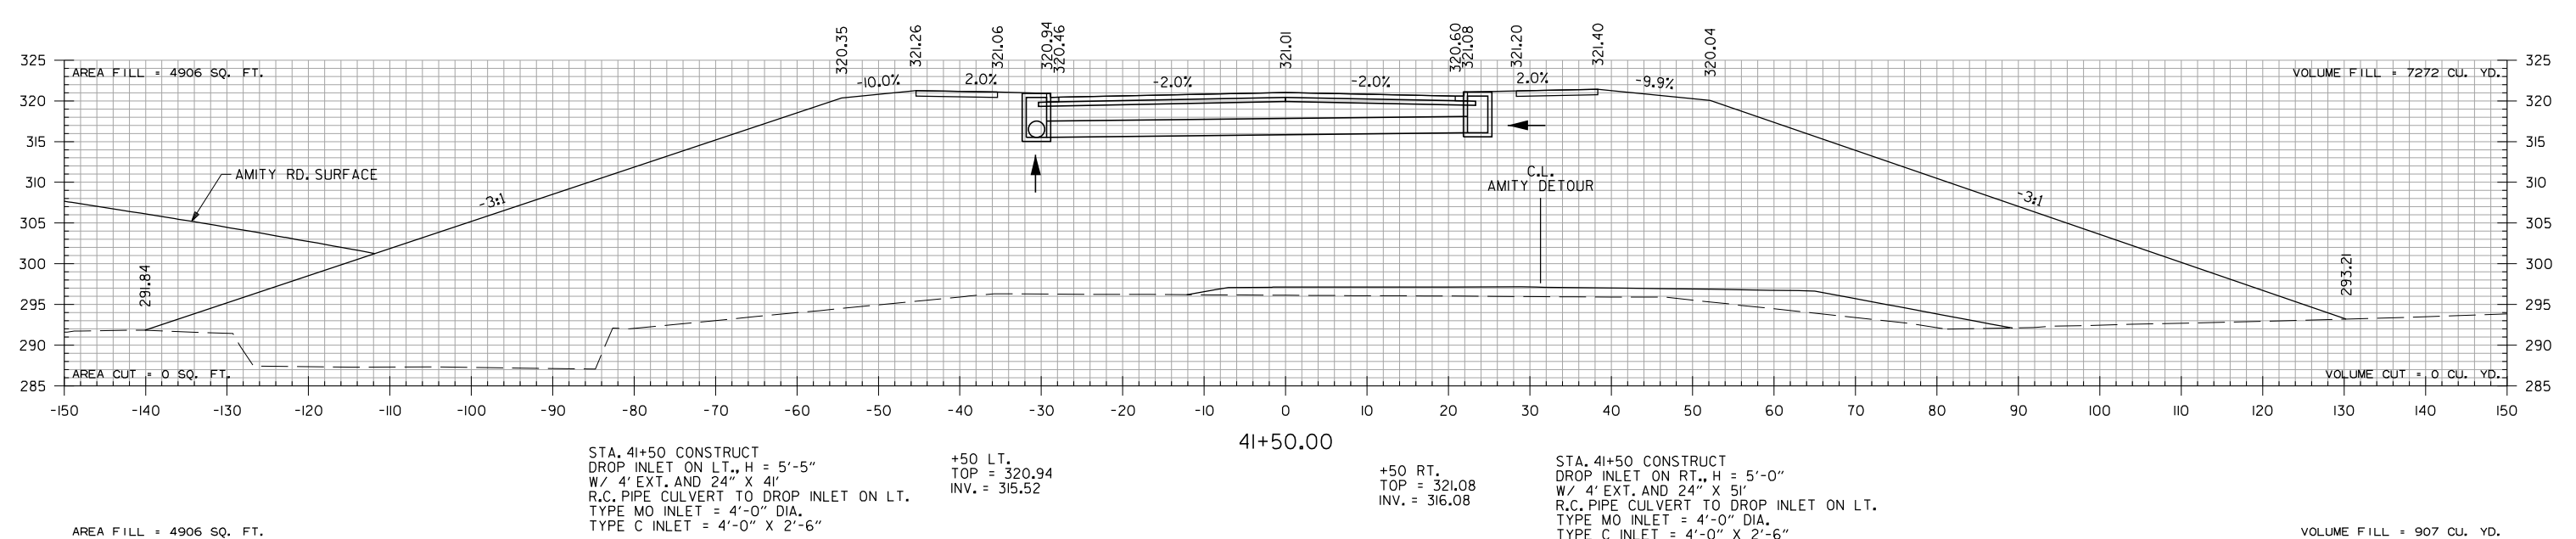




STA. 41+09.98 END BRIDGE

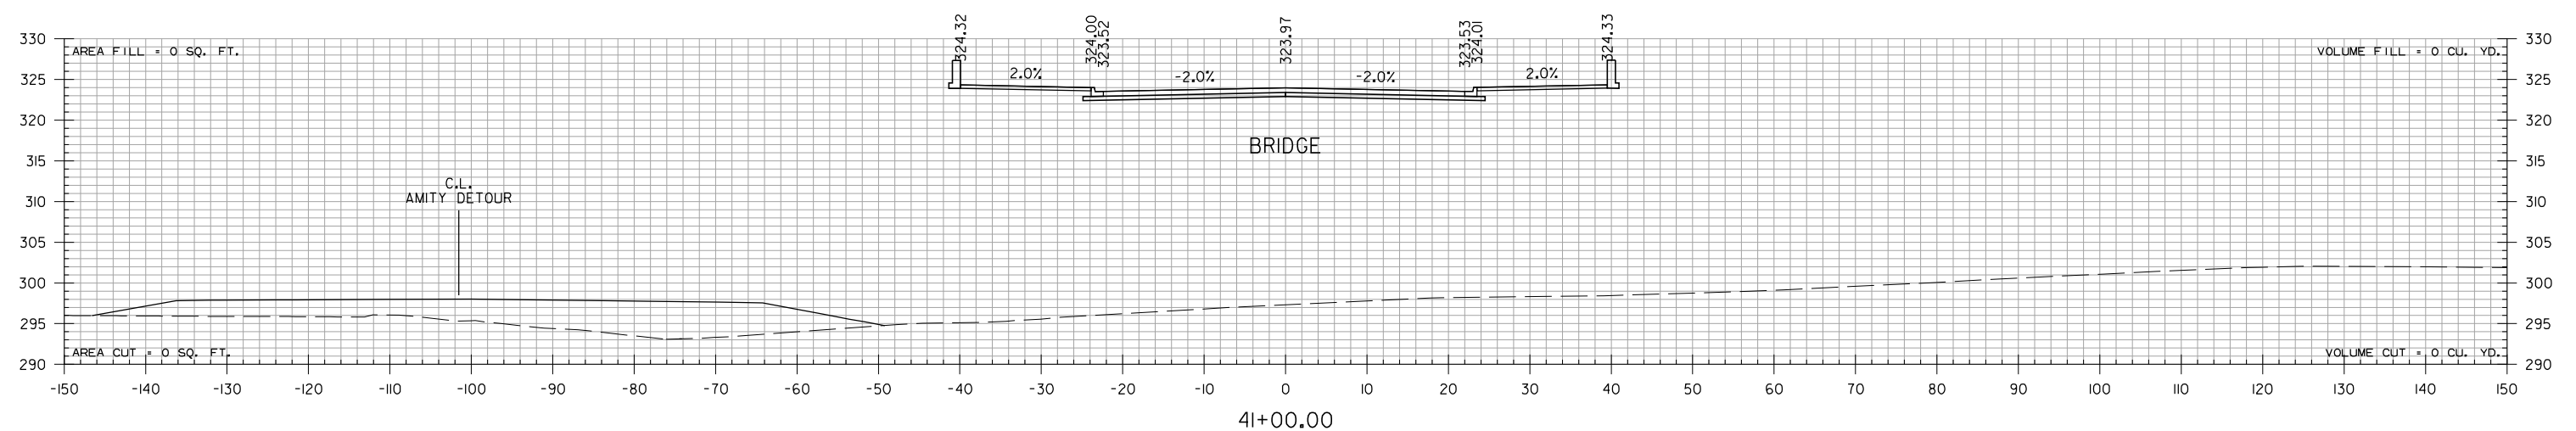

6TH STREET  
STA. 41+00 TO STA. 41+50

5/20/2015 7:13:43 AM  
 WORKSPACE: AHTD  
 L:\2012\1201590 - Conrail\field Access\Drawings\6TH.STA\6TH.CX.ALL.dgn  
 REVISED DATE:




DATE REVISED	DATE FILMED	DATE REVISED	DATE FILMED	FED. RD. DIST. NO.	STATE	FED. AID PROJ. NO.	SHEET NO.	TOTAL SHEETS
				6	ARK.			
				JOB NO.		080517	149	182
				2 CROSS SECTIONS				

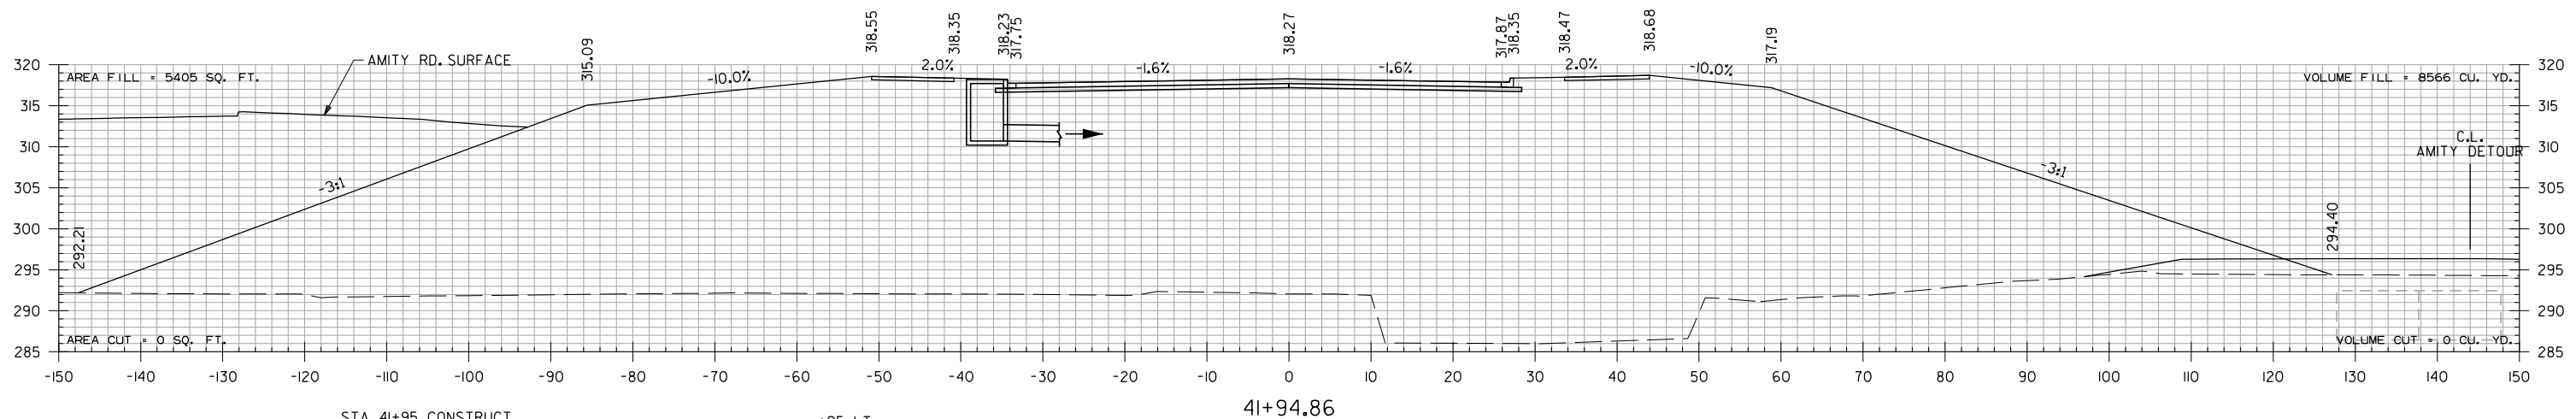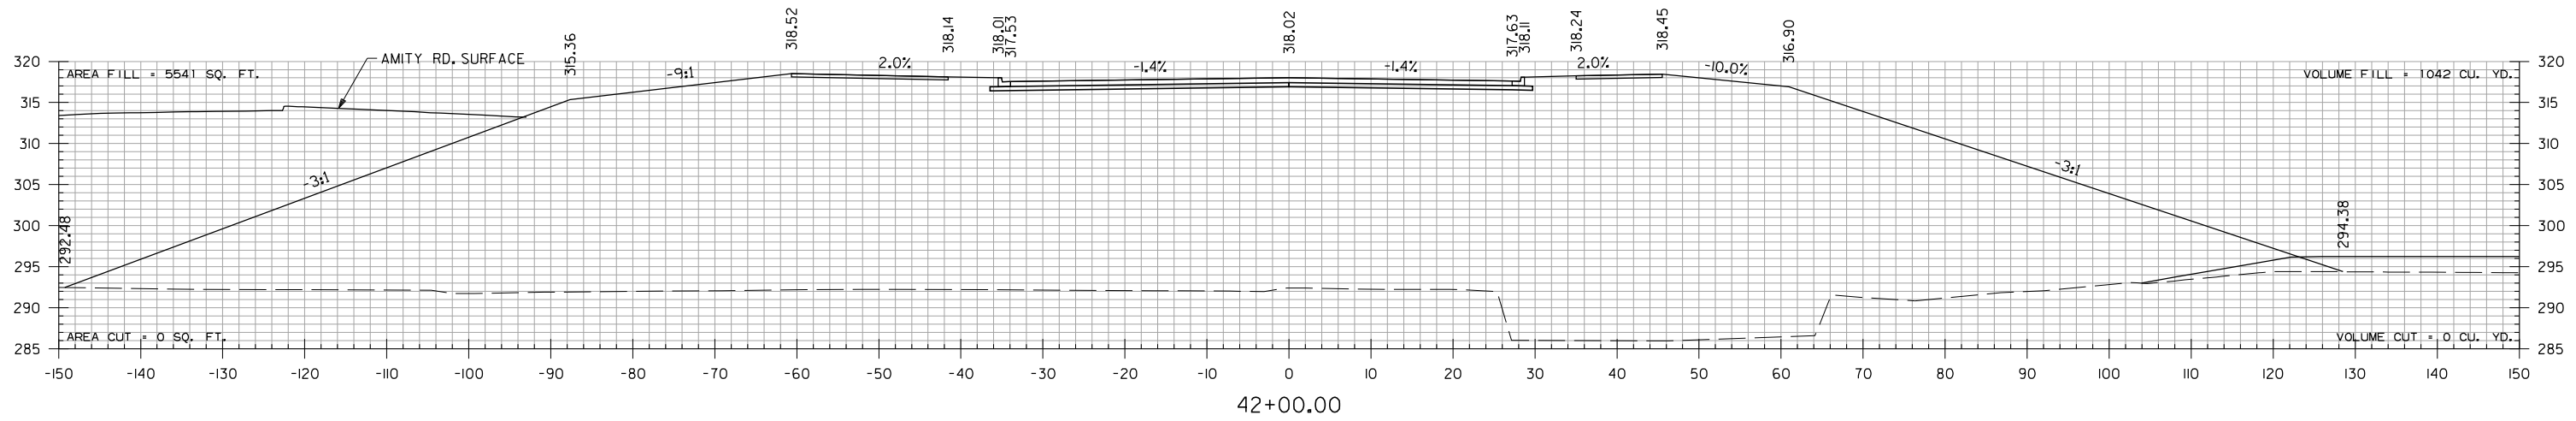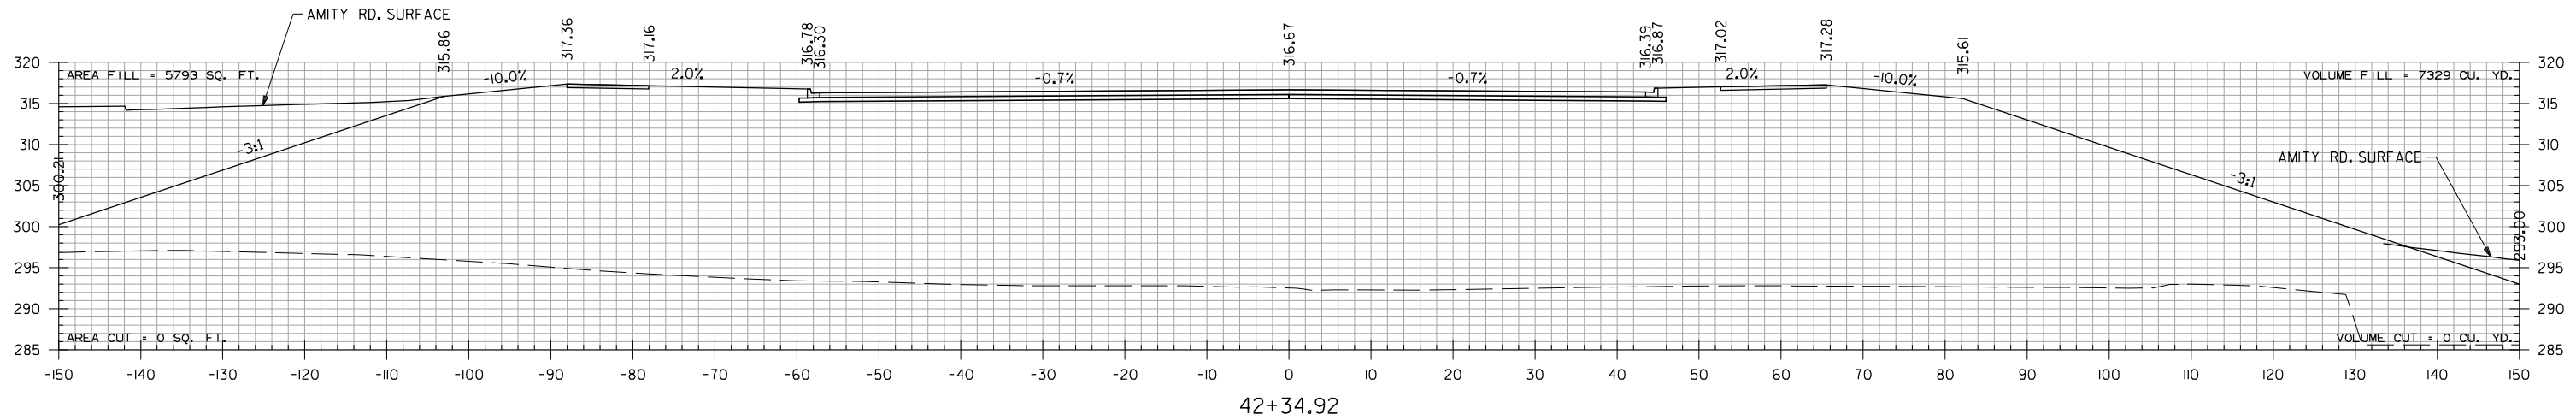

6TH STREET  
STA. 41+95 TO STA. 42+35

5/20/2015 7:13:43 AM  
WORKSPACE: AHTD  
L:\2012\1201590 - Conrail\field Access\Drawings\6TH.STA\6TH.CX.ALL.dgn  
REVISED DATE:

DATE REVISED	DATE FILMED	DATE REVISED	DATE FILMED	FED. RD. DIST. NO.	STATE	FED. AID PROJ. NO.	SHEET NO.	TOTAL SHEETS
				6	ARK.	080517	150	182
				(2) CROSS SECTIONS				

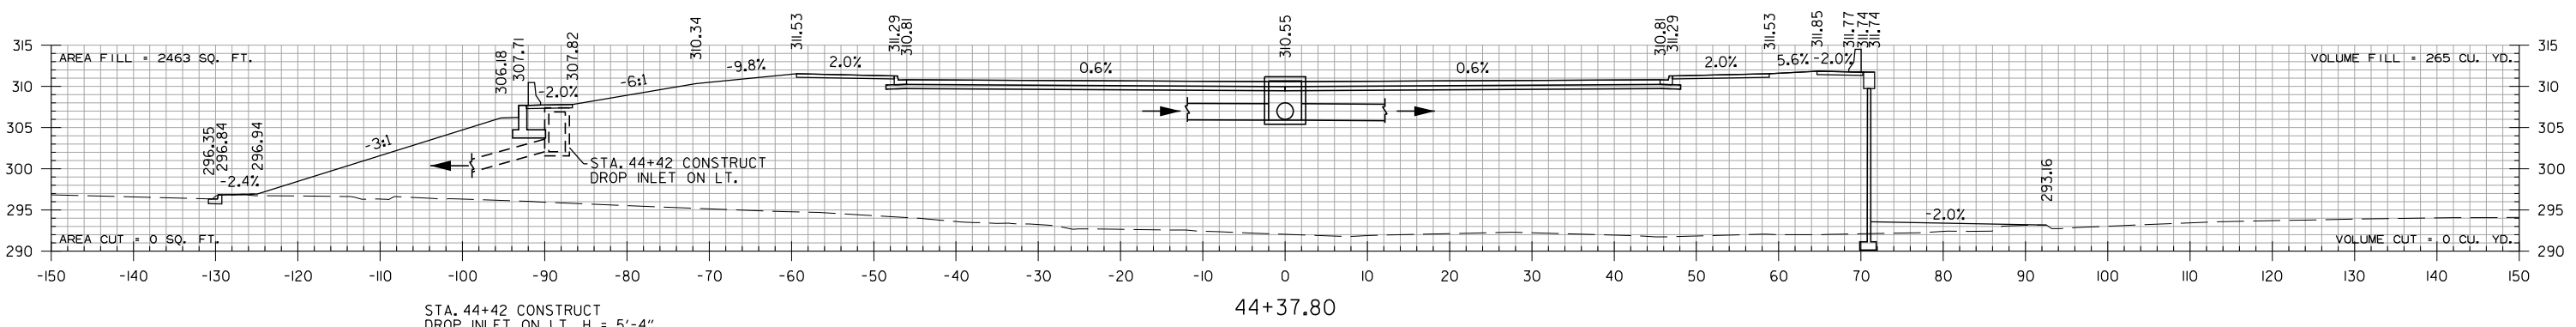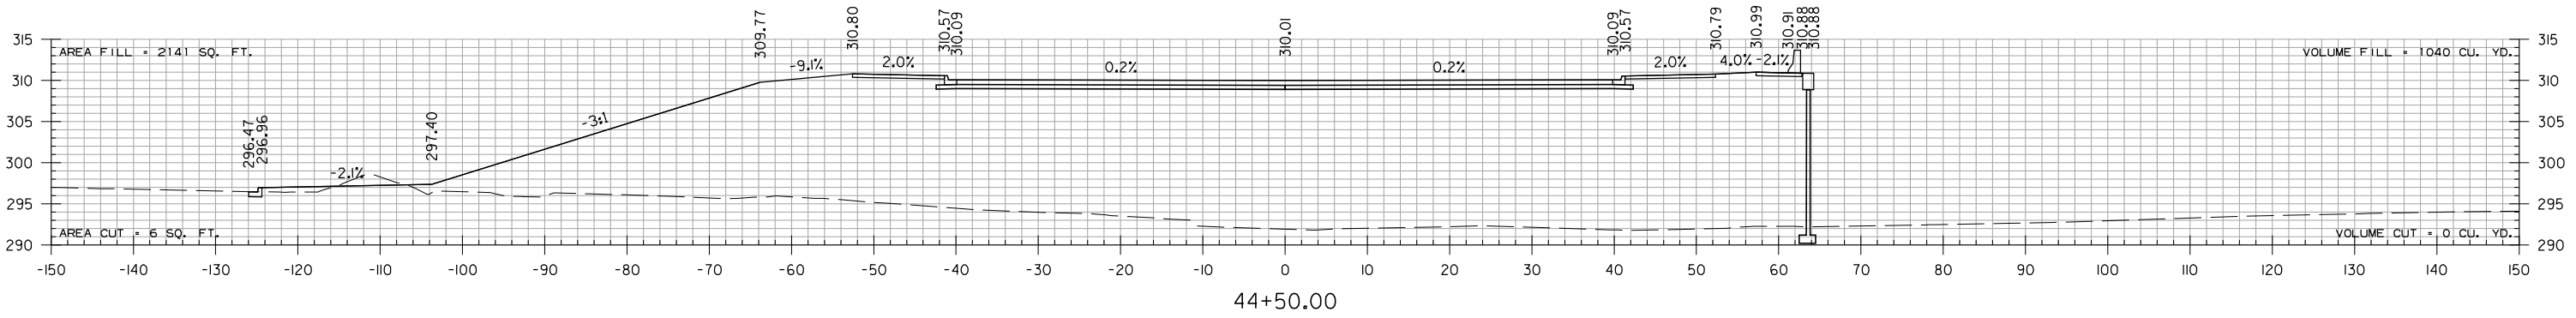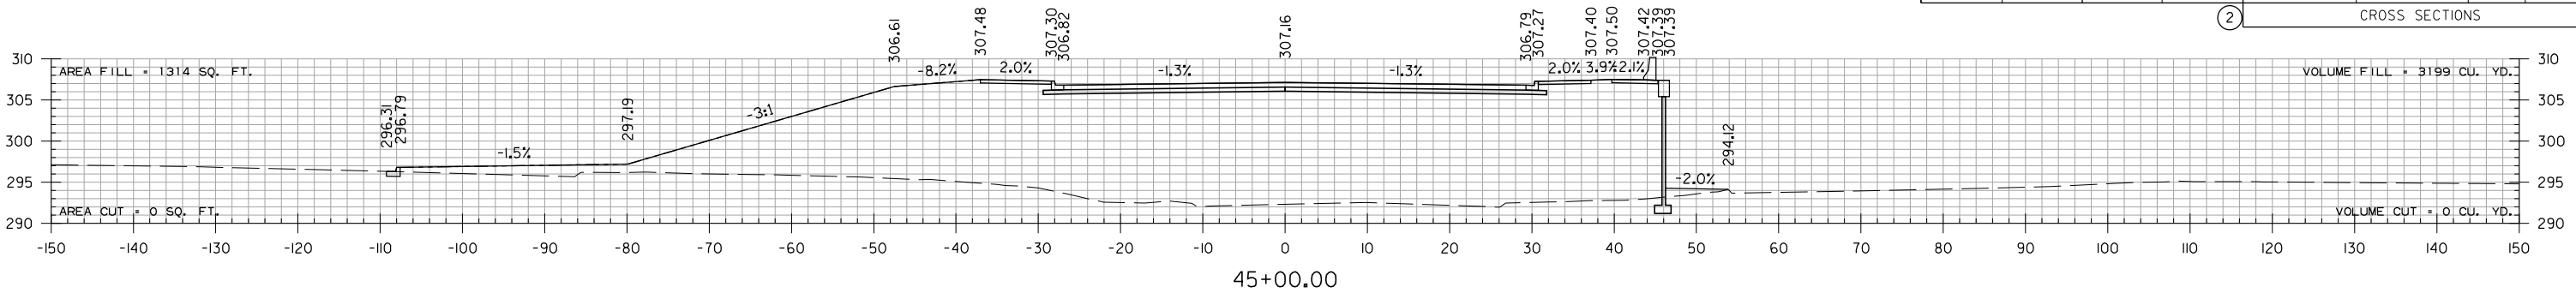


STA. 44+42 CONSTRUCT  
 DROP INLET ON LT., H = 5'-4"  
 W/ 18" X 4' R.C. PIPE CULVERT  
 TO DROP INLET ON LT.  
 TYPE E INLET = 3'-6" X 2'-0"

+42 LT.  
 TOP = 307.42  
 INV. = 302.07

+38 CL.  
 TOP = 311.17  
 FL. IN = 306.02  
 FL. IN = 305.92  
 FL. OUT = 305.92

STA. 44+38 CONSTRUCT  
 DROP INLET ON C.L., H = 5'-3"  
 W/ 24" X 77'  
 R.C. PIPE CULVERT TO DROP INLET ON RT.  
 TYPE M0 INLET = 4'-0" DIA.  
 TYPE C INLET = 4'-0" X 3'-6"

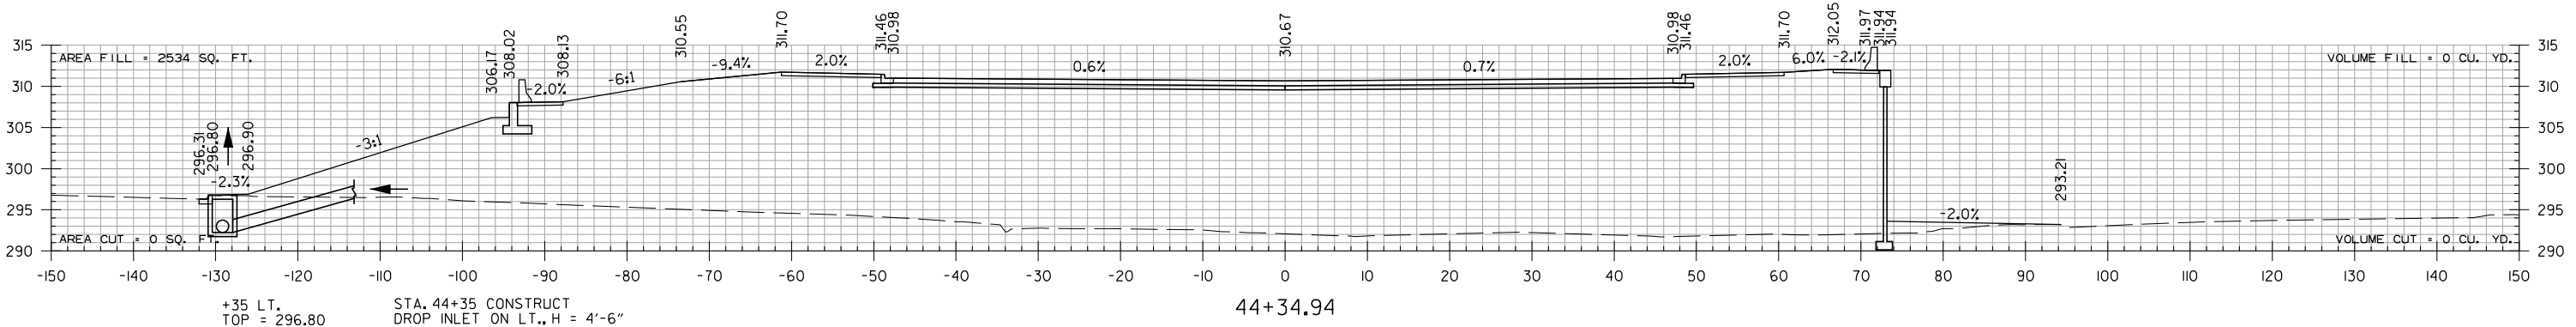

+35 LT.  
 TOP = 296.80  
 INV. = 292.27





STA. 44+35 CONSTRUCT  
 DROP INLET ON LT., H = 4'-6"  
 W/ DBL. 4' EXT. AND 18" X 143'  
 R.C. PIPE CULVERT TO DROP INLET ON LT.  
 TYPE M0 INLET = 4'-0" DIA.  
 TYPE C INLET = 4'-0" X 2'-6"

STA. 44+34.94 BEGIN ELSINGER BLVD.  
 ELSINGER BLVD.  
 STA. 44+35 TO STA. 45+00

5/20/2015 7:13:43 AM  
 WORKSPACE: AHTD  
 L:\2012\1015590 - ContrailField Access\Drawings\6TH\_STA\6TH.CX.ALL.dgn  
 REVISED DATE:

DATE REVISED	DATE FILMED	DATE REVISED	DATE FILMED	FED. RD. DIST. NO.	STATE	FED. AID PROJ. NO.	SHEET NO.	TOTAL SHEETS
				6	ARK.			
				JOB NO.	080517	151	182	

2 CROSS SECTIONS

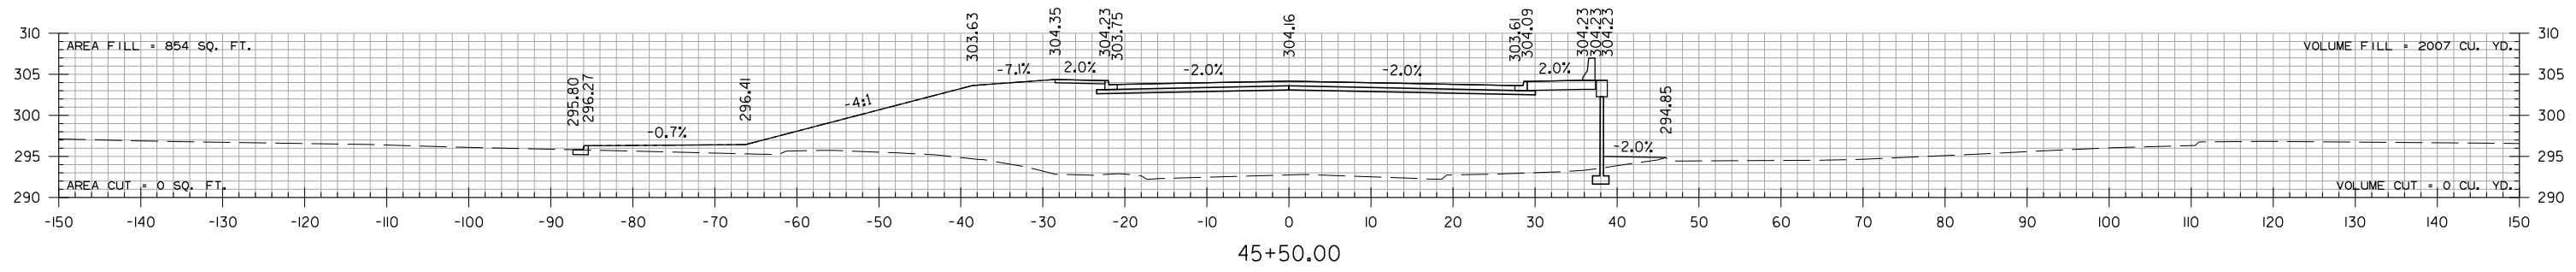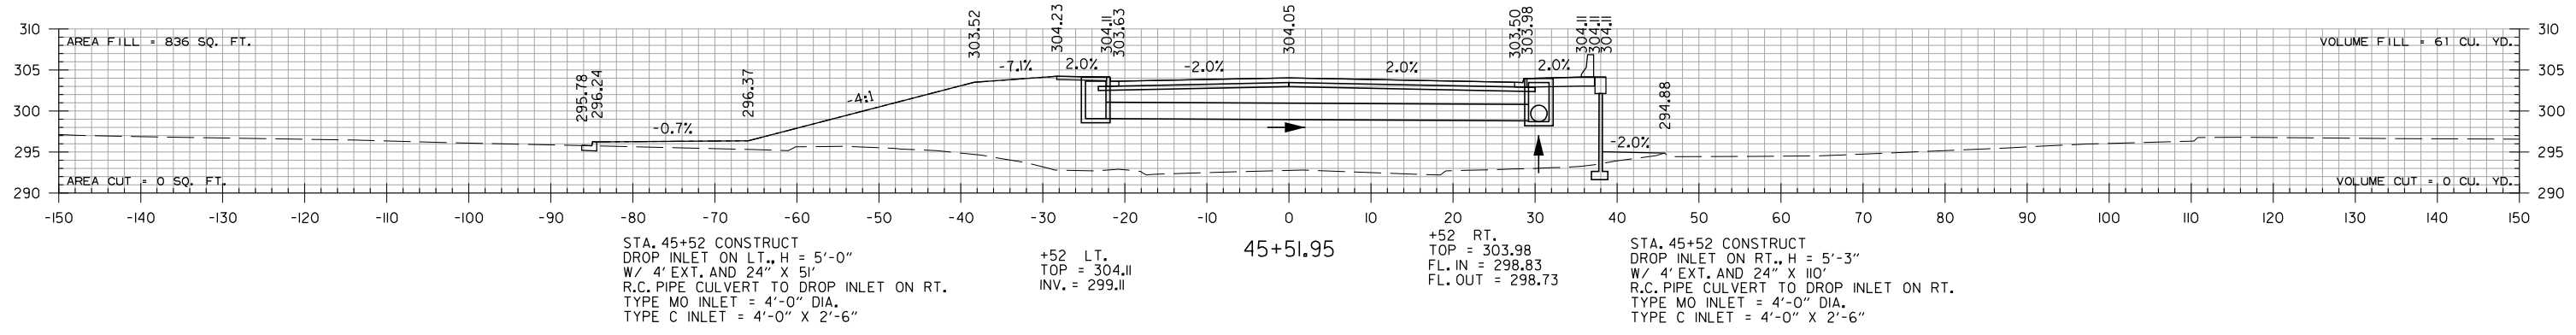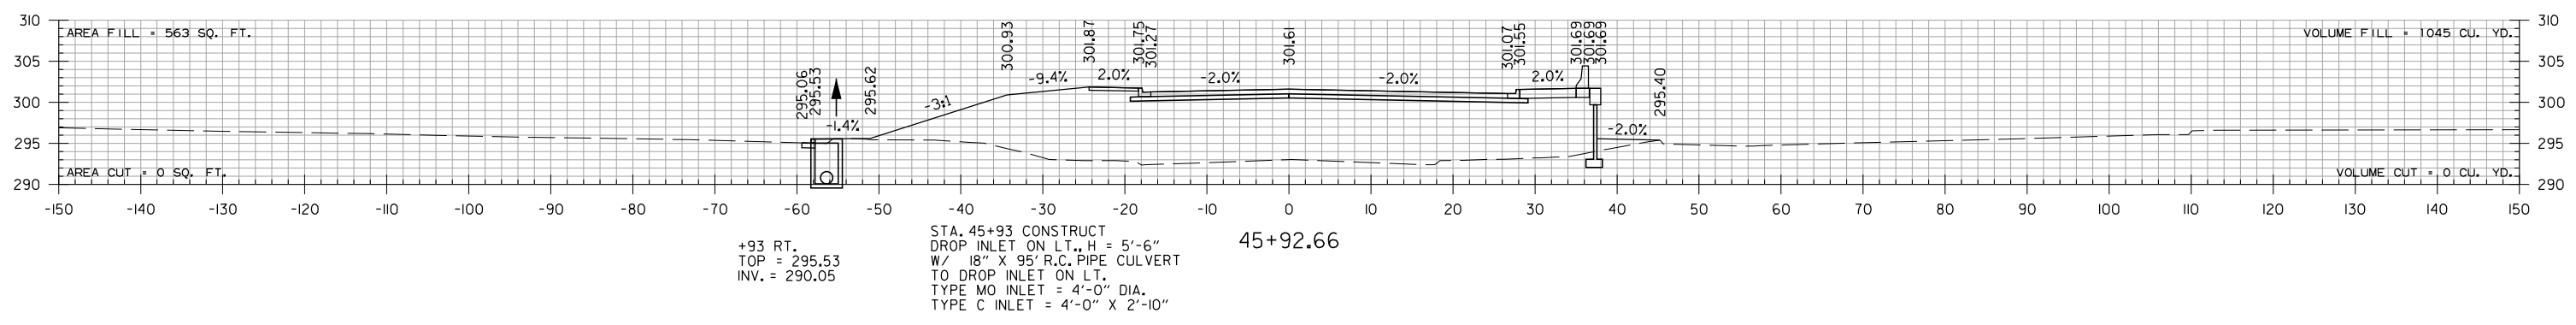
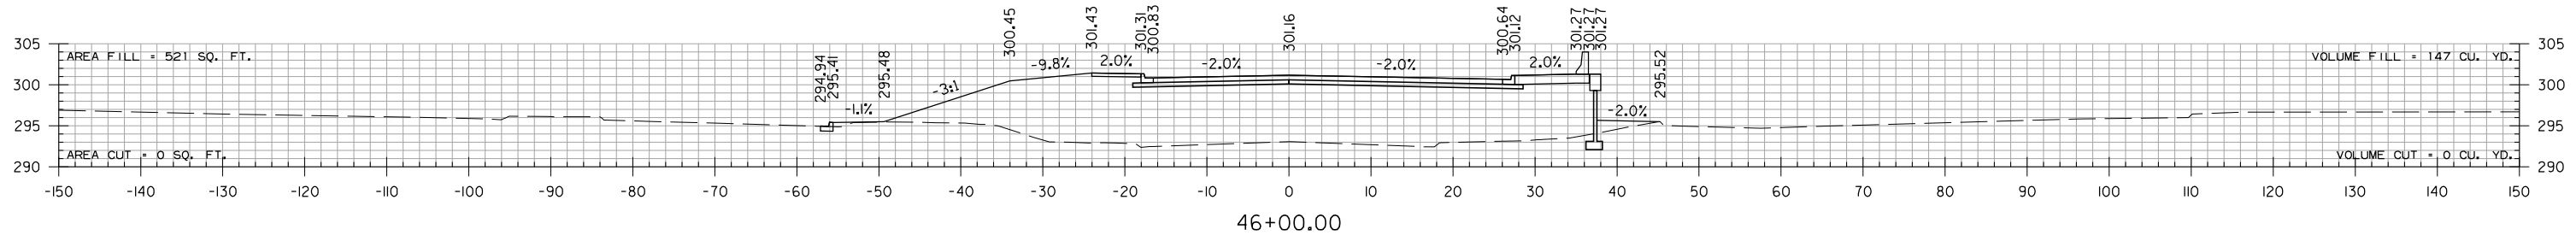


ELSINGER BLVD.  
STA. 45+50 TO STA. 46+00

5/20/2015 7:13:43 AM  
 WORKSPACE: AHTD  
 L:\2012\201550 - Contrail\field Access\Drawings\6TH STA\6TH.CX.ALL.dgn  
 REVISED DATE:


DATE REVISED	DATE FILMED	DATE REVISED	DATE FILMED	FED. RD. DIST. NO.	STATE	FED. AID PROJ. NO.	SHEET NO.	TOTAL SHEETS
				6	ARK.			
				JOB NO.	080517	152	182	

2 CROSS SECTIONS

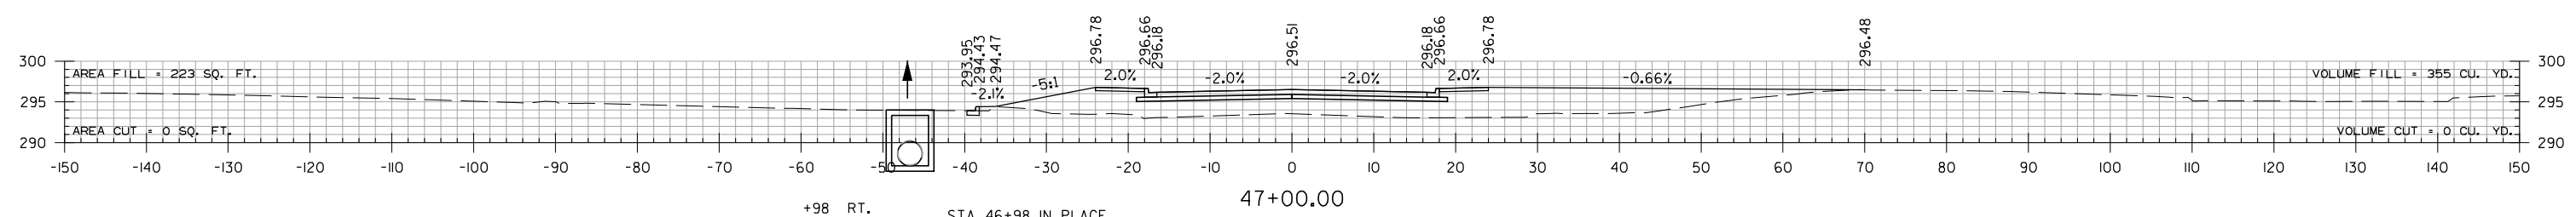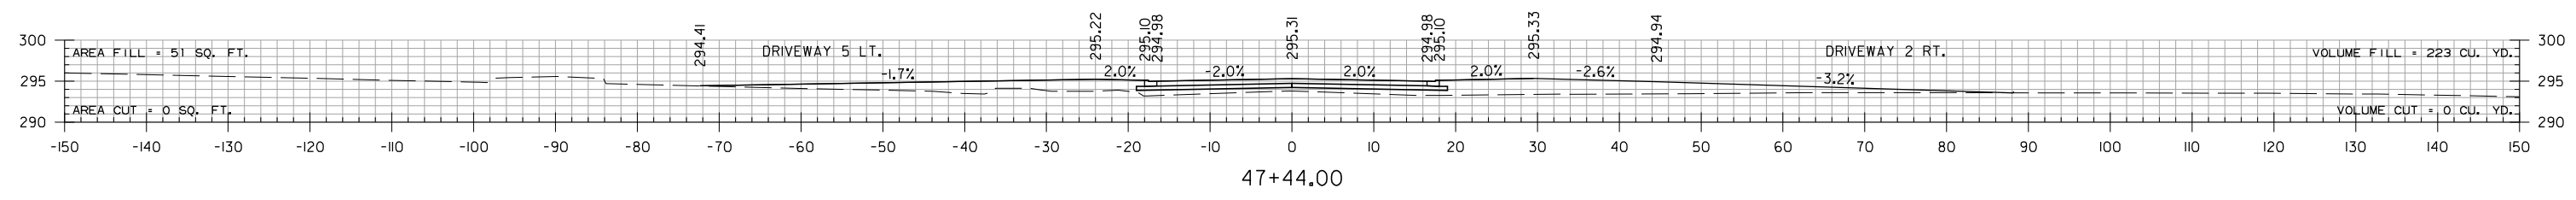


+98 RT.  
TOP = 293.84  
INV. = 287.17

STA. 46+98 IN PLACE  
36" X 157' R.C. PIPE CULVERT ON LT.  
REMOVE 40 L.F.  
CONSTRUCT  
DROP INLET ON LT., H=6'-8"  
W/ 36" X 103'  
R.C. PIPE CULVERT TO DROP INLET ON LT.  
TYPE ST. INLET = 3'-0" X 4'-6"  
CONNECT TO EXISTING 36" R.C. PIPE CULVERT

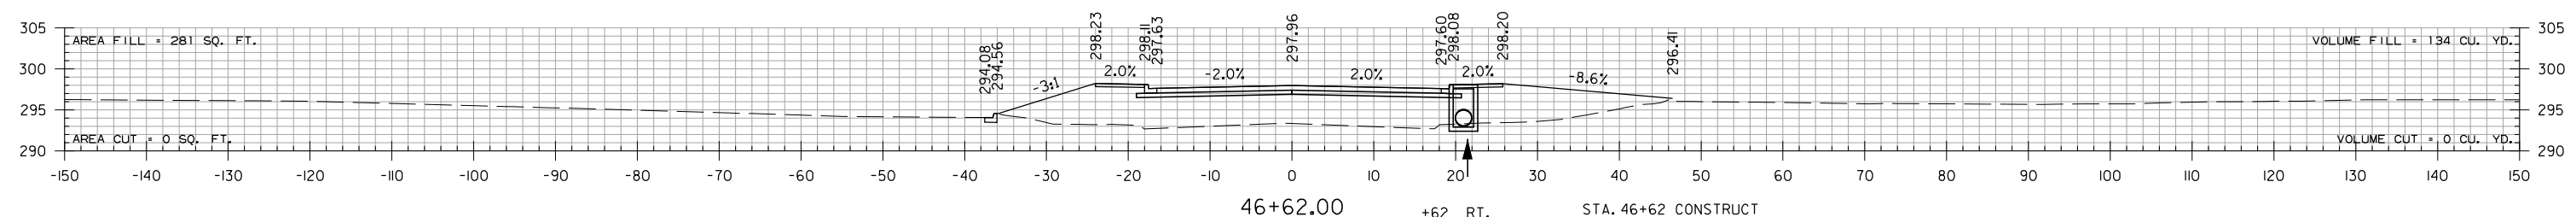

+62 RT.  
TOP = 298.08  
FL. IN = 293.10  
FL. OUT = 293.00

STA. 46+62 CONSTRUCT  
DROP INLET ON RT., H = 5'-11"  
W/ 24" X 152'  
R.C. PIPE CULVERT TO DROP INLET ON RT.  
TYPE C INLET = 4'-0" X 2'-6"

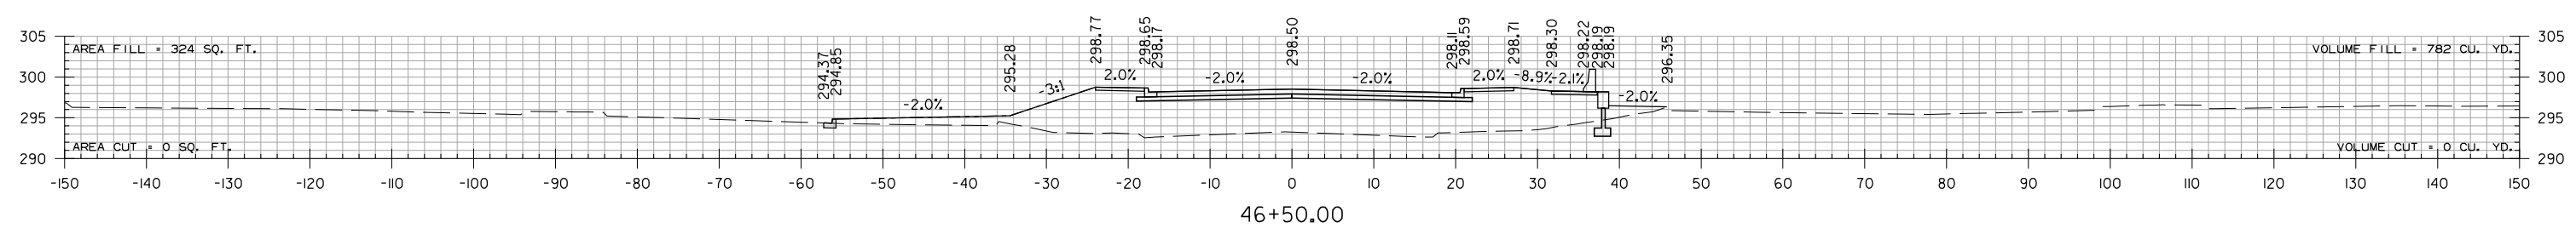

ELSINGER BLVD.  
STA. 46+50 TO STA. 47+44



5/20/2015 7:13:44 AM  
WORKSPACE: AHTD  
L:\2012\2015590 - Contrail\field Access\Drawings\6TH\_ST\6TH.CX.ALL.dgn  
REVISED DATE:



DATE REVISED	DATE FILMED	DATE REVISED	DATE FILMED	FED. RD. DIST. NO.	STATE	FED. AID PROJ. NO.	SHEET NO.	TOTAL SHEETS
				6	ARK.			
				JOB NO.	080517	153	182	

STA. 48+40.00 END ELSINGER BLVD.

2 CROSS SECTIONS

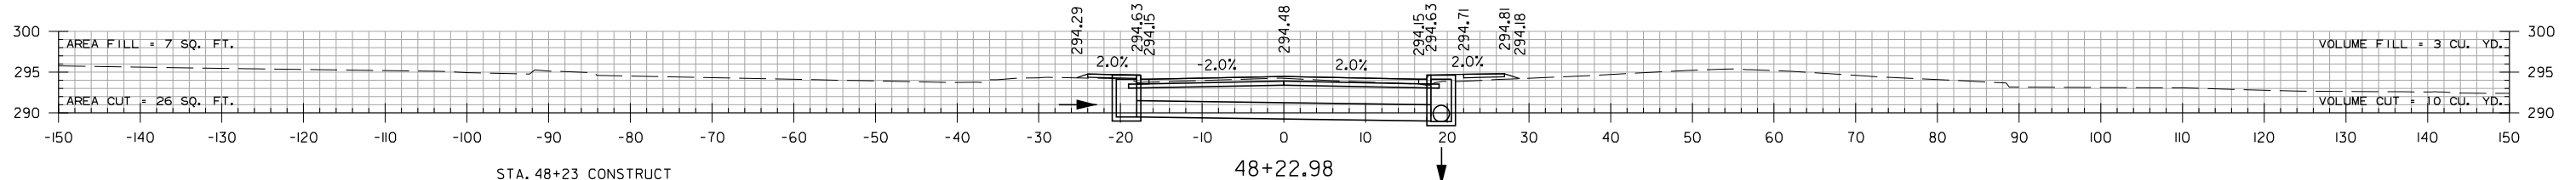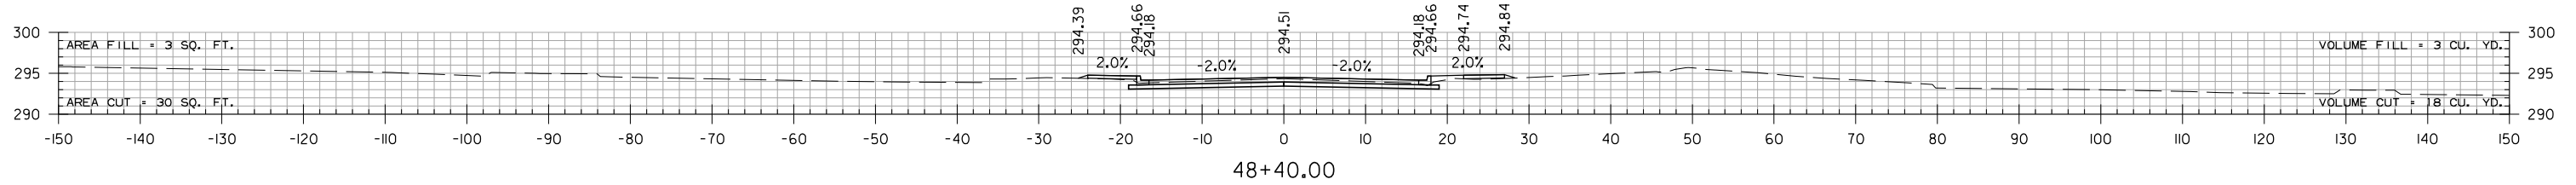


STA. 48+23 CONSTRUCT  
 DROP INLET ON LT., H = 5'-3"  
 W/ DBL. 8' EXT. AND 24" X 36'  
 R.C. PIPE CULVERT TO DROP INLET ON RT.  
 TYPE MO INLET = 4'-0" DIA.  
 TYPE C INLET = 4'-0" X 2'-6"

+23 LT.  
 TOP = 294.63  
 INV. = 289.40


+23 RT.  
 TOP = 294.63  
 FL. IN = 289.00  
 FL. OUT = 288.90

STA. 48+23 CONSTRUCT  
 DROP INLET ON RT., H = 5'-9"  
 W/ 4' EXT., AND 24" X 7'  
 R.C. PIPE CULVERT TO DROP INLET ON RT.  
 TYPE MO INLET = 4'-0" DIA.  
 TYPE C INLET = 4'-0" X 2'-6"

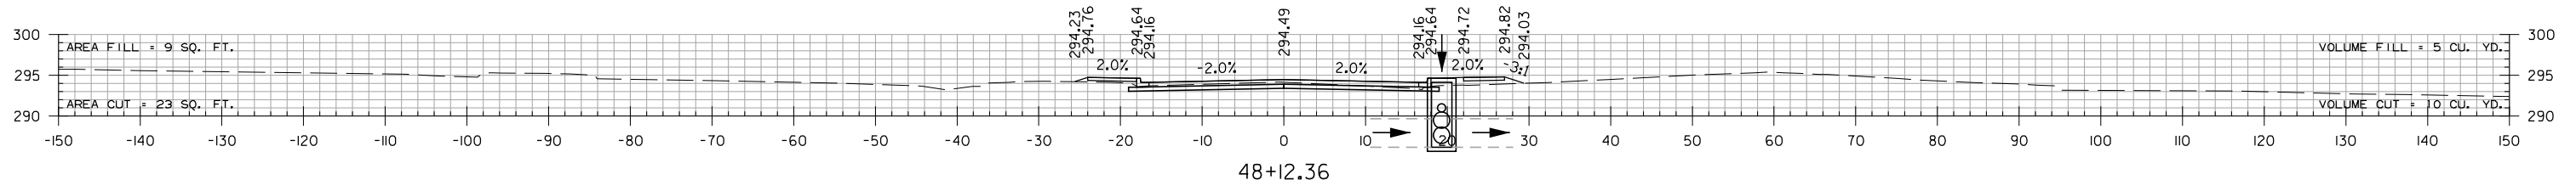


+12 RT.  
 TOP = 294.64  
 FL. IN = 290.50  
 FL. IN = 288.50  
 FL. IN = 286.66  
 FL. OUT = 286.18

STA. 48+12 IN PLACE  
 42" R.C. PIPE CULVERT - RETAIN  
 CONSTRUCT  
 DROP INLET ON RT., H = 8'-6"  
 TYPE MO INLET = 5'-0" DIA.  
 TYPE C INLET = 4'-4" X 2'-6"

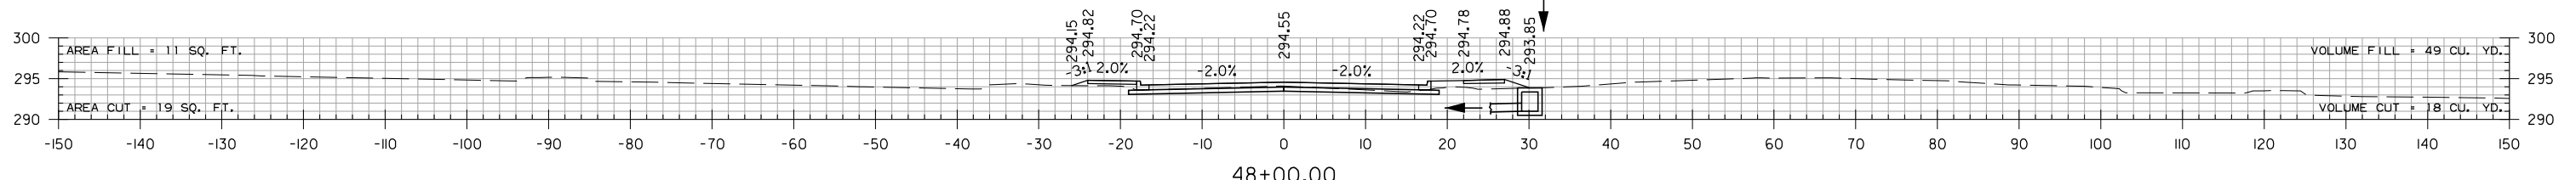

STA. 48+00 CONSTRUCT  
 YARD DRAIN ON RT.  
 TOP = 293.85, H=2'-10"  
 W/ 12" X 15' R.C. PIPE CULVERT  
 TO DROP INLET ON RT.


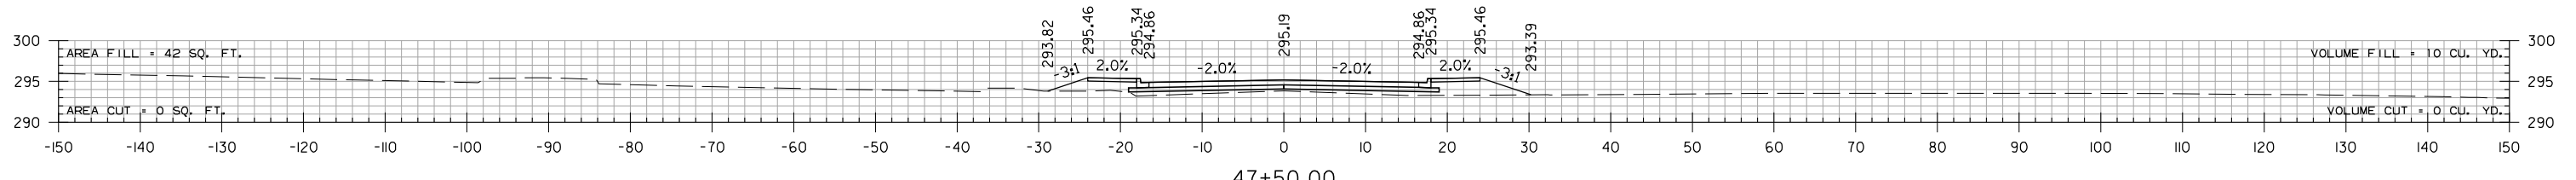


ELSINGER BLVD.  
 STA. 47+50 TO STA. 48+40

5/20/2015 7:13:44 AM  
 WORKSPACE: AHTD  
 L:\2012\1201590 - Contr-ell\field Access\Drawings\6TH\_ST\6TH.CX.ALL.dgn  
 REVISED DATE:


DATE REVISED	DATE FILMED	DATE REVISED	DATE FILMED	FED. RD. DIST. NO.	STATE	FED. AID PROJ. NO.	SHEET NO.	TOTAL SHEETS
2-10-2016				6	ARK.			
				JOB NO.	080517	154	182	

2 CROSS SECTIONS

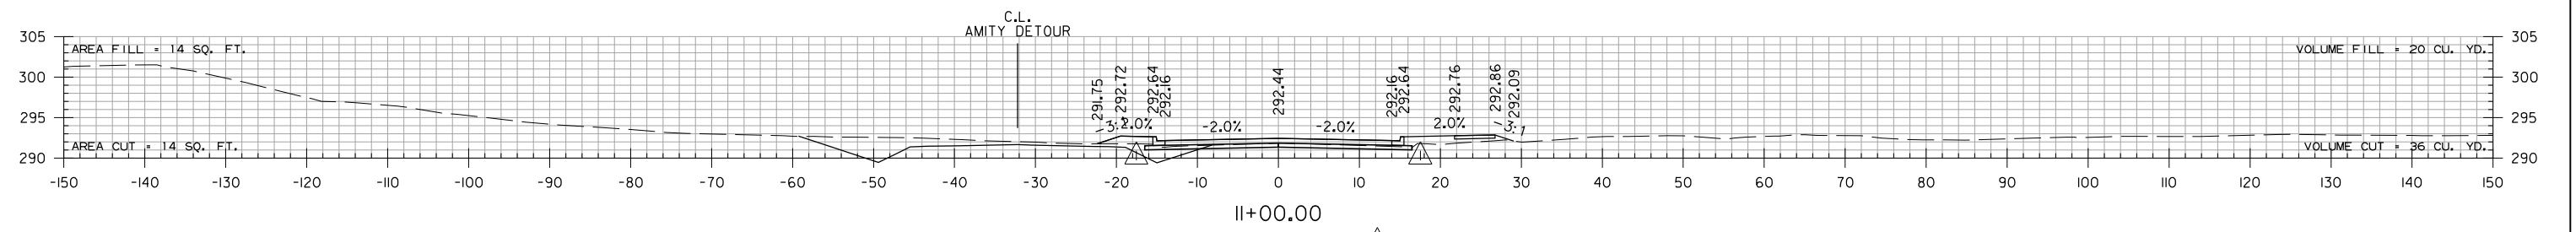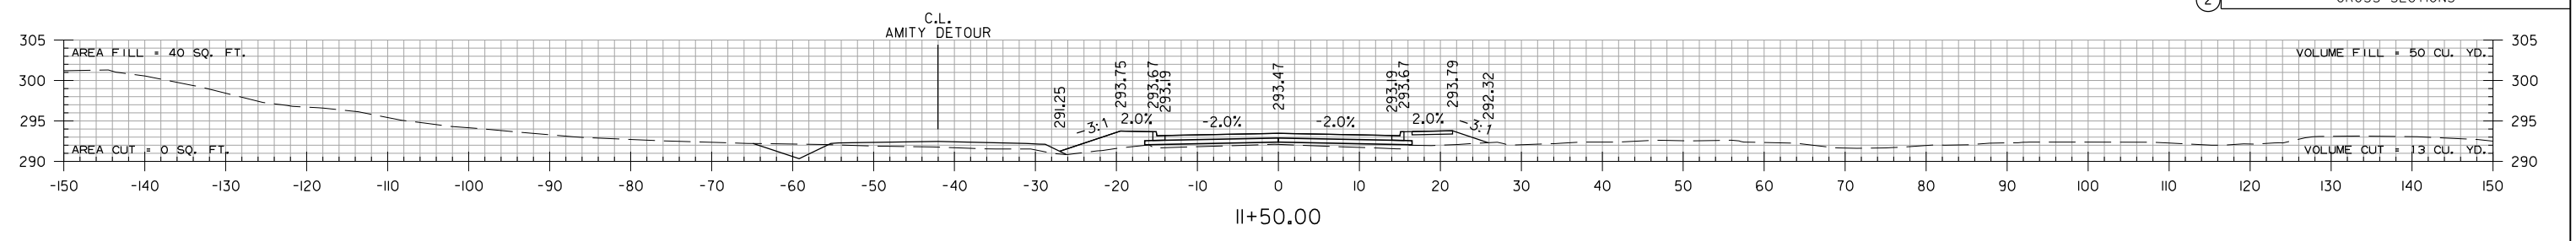

△ +00 LT.  
TOP = 292.64  
FL. IN = 287.57  
FL. OUT = 287.47

△ +00 RT.  
TOP = 292.64  
FL. IN = 287.57  
FL. OUT = 287.47

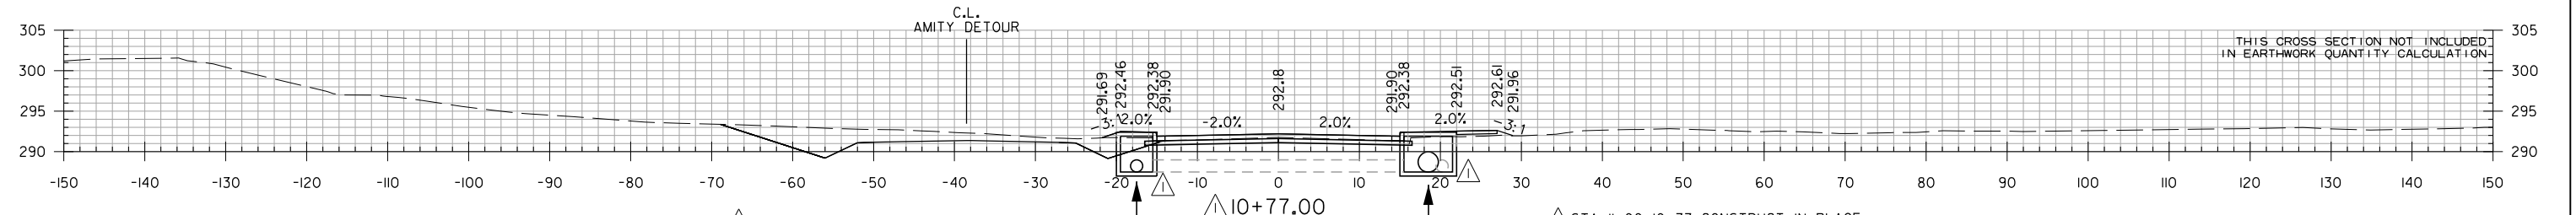


△ STA. II+00 10+75 CONSTRUCT IN PLACE DROP INLET ON LT., H = 5'-2" - RETAIN AND 18" X 34' R.C. PIPE CULVERT - RETAIN ADJUST DROP INLET TO GRADE W/ 18" X 95' R.C. PIPE CULVERT TO DROP INLET ON LT. TYPE MO INLET = 4'-0" MATCH EXISTING DIA. TYPE C INLET = 4'-0" X 2'-6"

△ +75 LT.  
EXIST TOP = 291.73  
PROP TOP = 292.38  
INV. = 287.47

△ +77 RT.  
EXIST TOP = 291.85  
PROP TOP = 292.38  
INV. = 287.45

△ STA. II+00 10+77 CONSTRUCT IN PLACE DROP INLET ON RT., H = 5'-2" - RETAIN AND 36" X 149' R.C. PIPE CULVERT - REMOVE ADJUST DROP INLET TO GRADE W/ 18" X 30" X 93' R.C. PIPE CULVERT TO DROP INLET ON RT. TYPE MO INLET = 4'-0" MATCH EXISTING DIA. TYPE C INLET = 4'-0" X 2'-6"

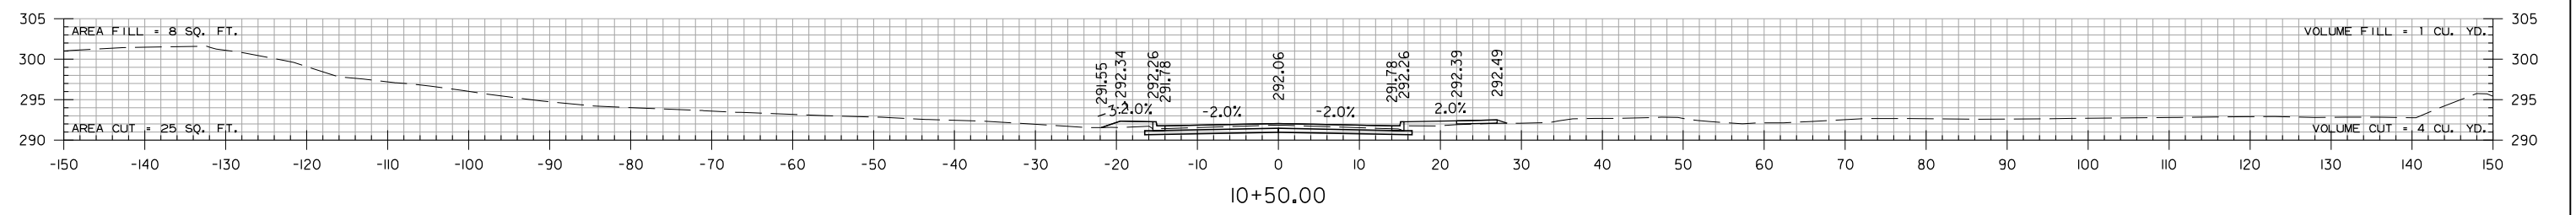

△ STA. 10+46 CONSTRUCT DROP INLET ON LT., H = 4'-3" 4'-8" W/ DBL. 4' EXT. AND 18" X 49' 24' R.C. PIPE CULVERT TO DROP INLET ON LT. TYPE MO INLET = 4'-0" DIA. TYPE C INLET = 4'-0" X 2'-6"

△ +46 LT.  
TOP = 292.26  
INV. = 288.01 287.62

△ STA. 10+46.18 BEGIN AMITY RD. SOUTH





△ +46 RT.  
TOP = 292.26  
INV. = 288.01 287.62

△ STA. 10+46 IN PLACE 18" R.C. PIPE CULVERT ON RT. REMOVE 4'-0" OF PIPE CONSTRUCT DROP INLET ON RT., H = 4'-3" 4'-8" W/ DBL. 4' EXT. AND 18" X 50' R.C. PIPE CULVERT TO DROP INLET ON RT. TYPE MO INLET = 4'-0" 5'-0" DIA. TYPE C INLET = 4'-0" X 2'-6" 6'-0"

AMITY RD.  
STA. 10+46 TO STA. II+50

2/10/2016 4:34:25 PM  
 WORKSPACE: AHTD  
 L:\2012\101590 - Contrail\field Access\Drawings\6TH STA\6TH.CX.ALL.dgn  
 REVISED DATE:



DATE REVISED	DATE FILMED	DATE REVISED	DATE FILMED	FED. RD. DIST. NO.	STATE	FED. AID PROJ. NO.	SHEET NO.	TOTAL SHEETS
2-10-2016				6	ARK.			
				JOB NO.		080517	155	182
				(2) CROSS SECTIONS				

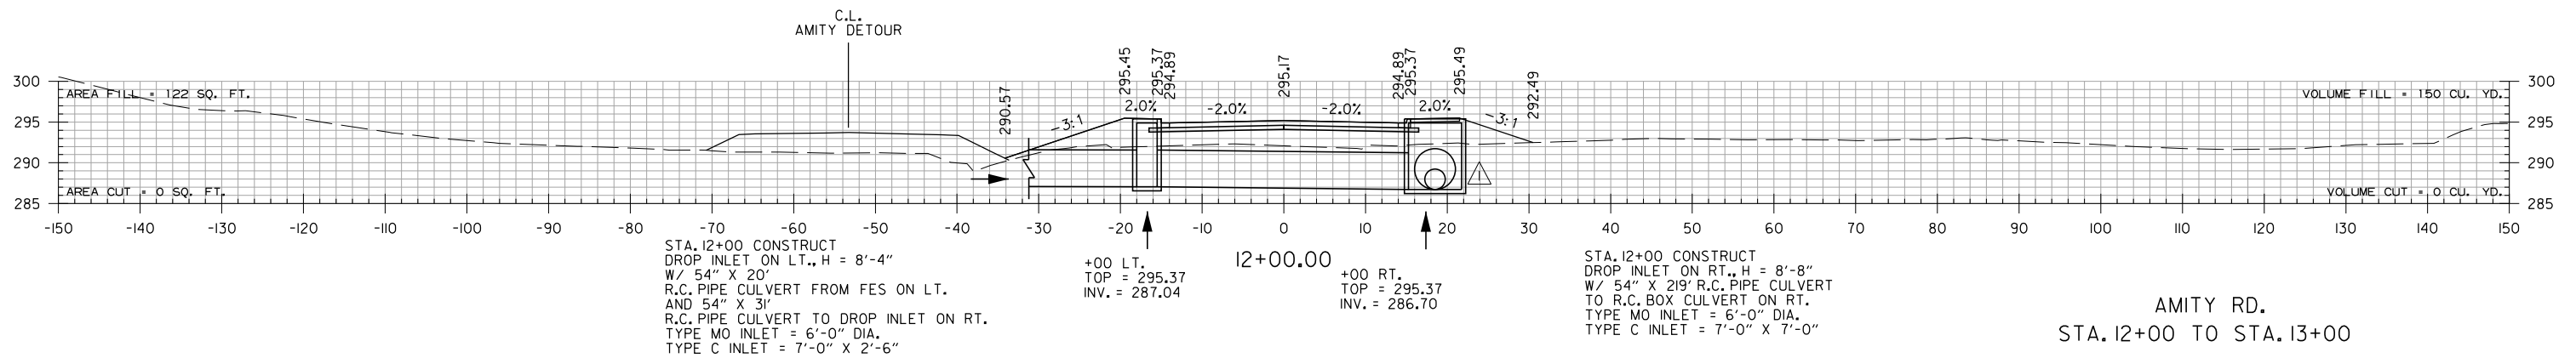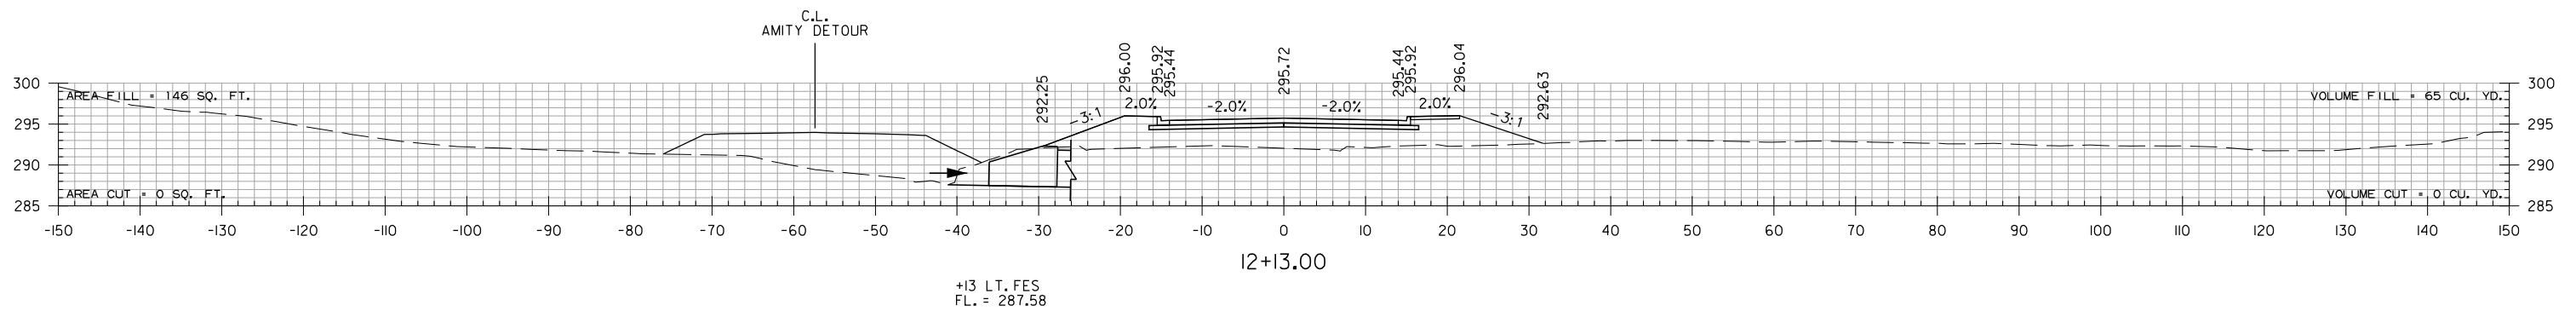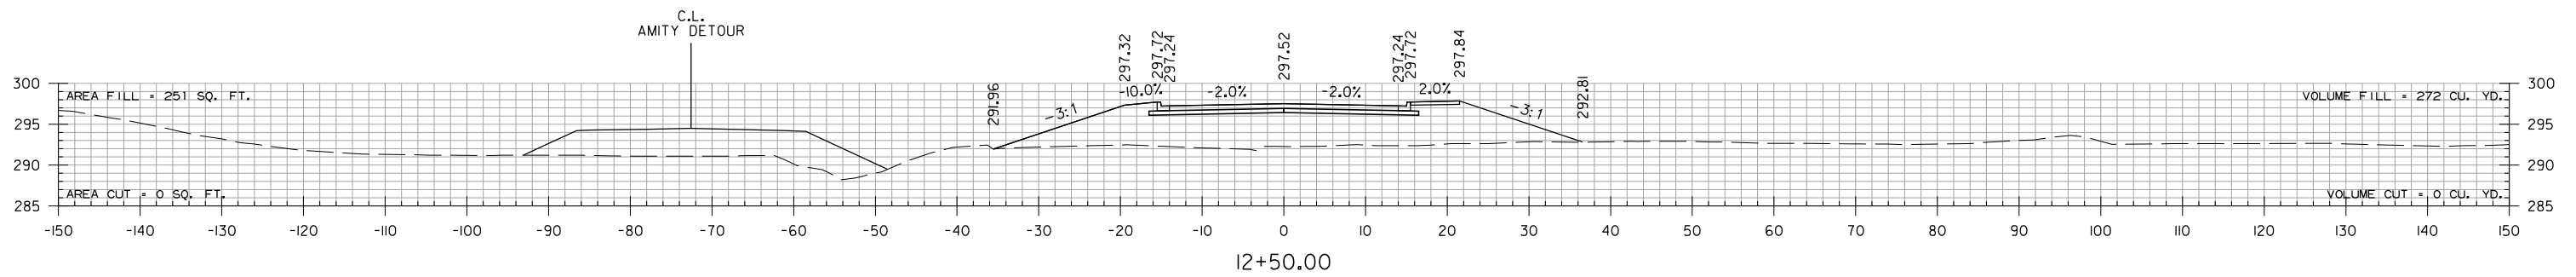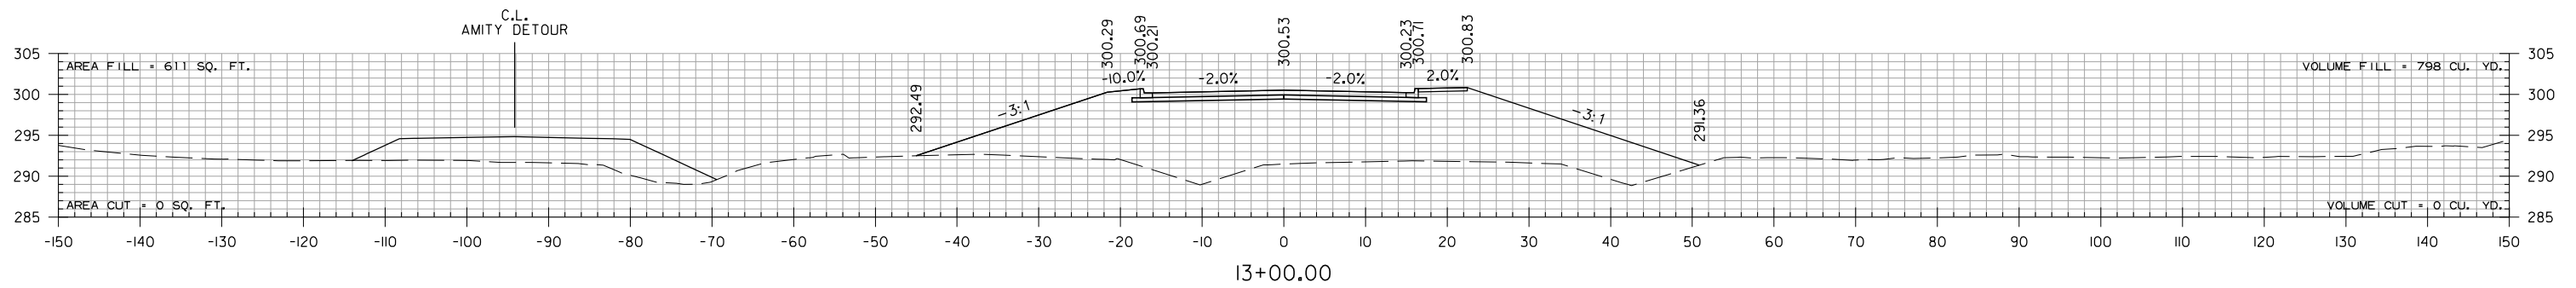

AMITY RD.  
STA. 12+00 TO STA. 13+00

DATE REVISED	DATE FILMED	DATE REVISED	DATE FILMED	FED. RD. DIST. NO.	STATE	FED. AID PROJ. NO.	SHEET NO.	TOTAL SHEETS
				6	ARK.			
				JOB NO.	080517		156	182

2 CROSS SECTIONS

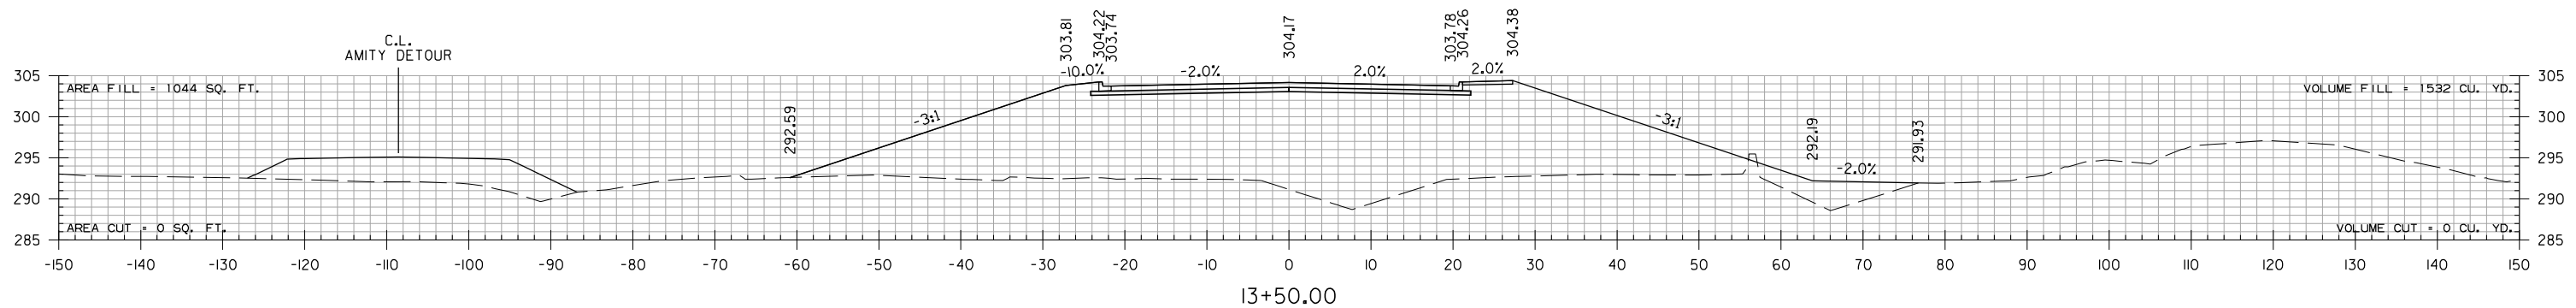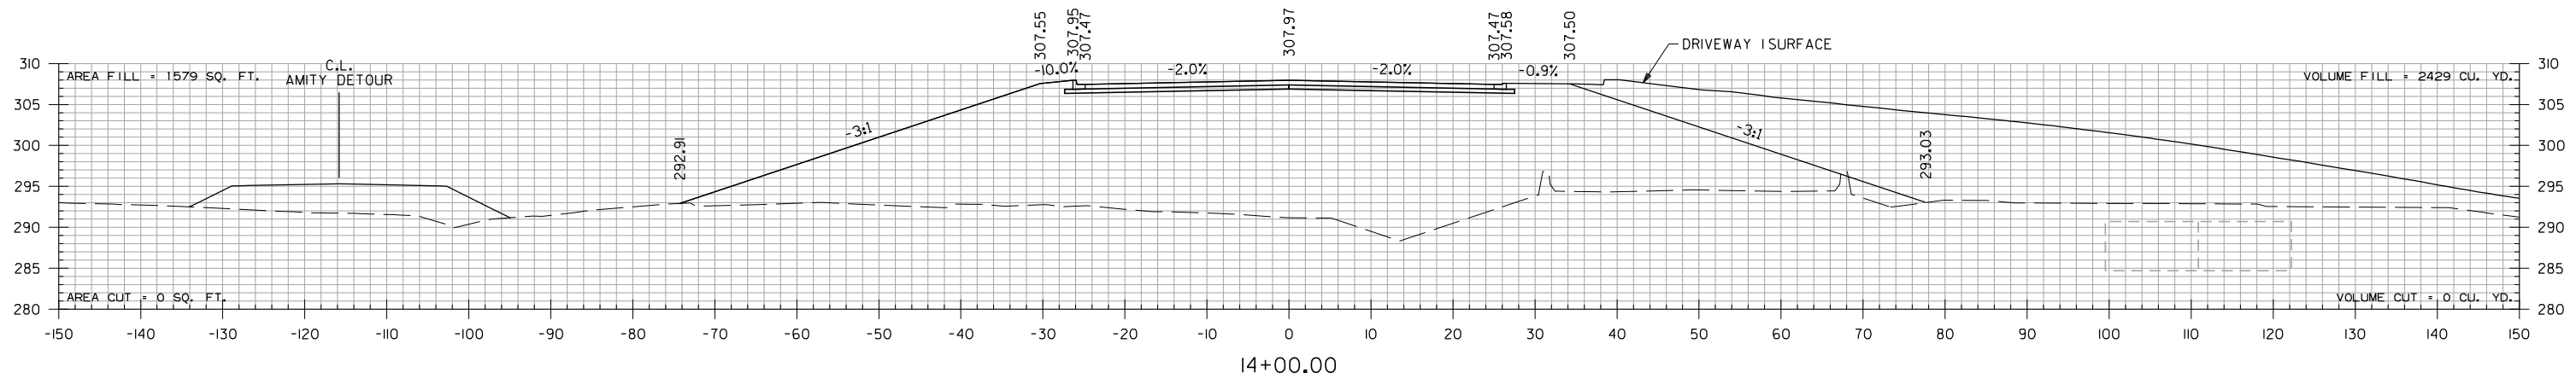


AMITY RD.  
STA. 13+50 TO STA. 14+20

5/20/2015 7:13:45 AM  
 WORKSPACE: AHTD  
 L:\2012\201590 - ConrailField Access\Drawings\6TH\_ST\6TH\_CX.ALL.dgn  
 REVISED DATE:

DATE REVISED	DATE FILMED	DATE REVISED	DATE FILMED	FED. RD. DIST. NO.	STATE	FED. AID PROJ. NO.	SHEET NO.	TOTAL SHEETS
6-1-2015				6	ARK.			
2-10-2016						080517	157	182

2 CROSS SECTIONS

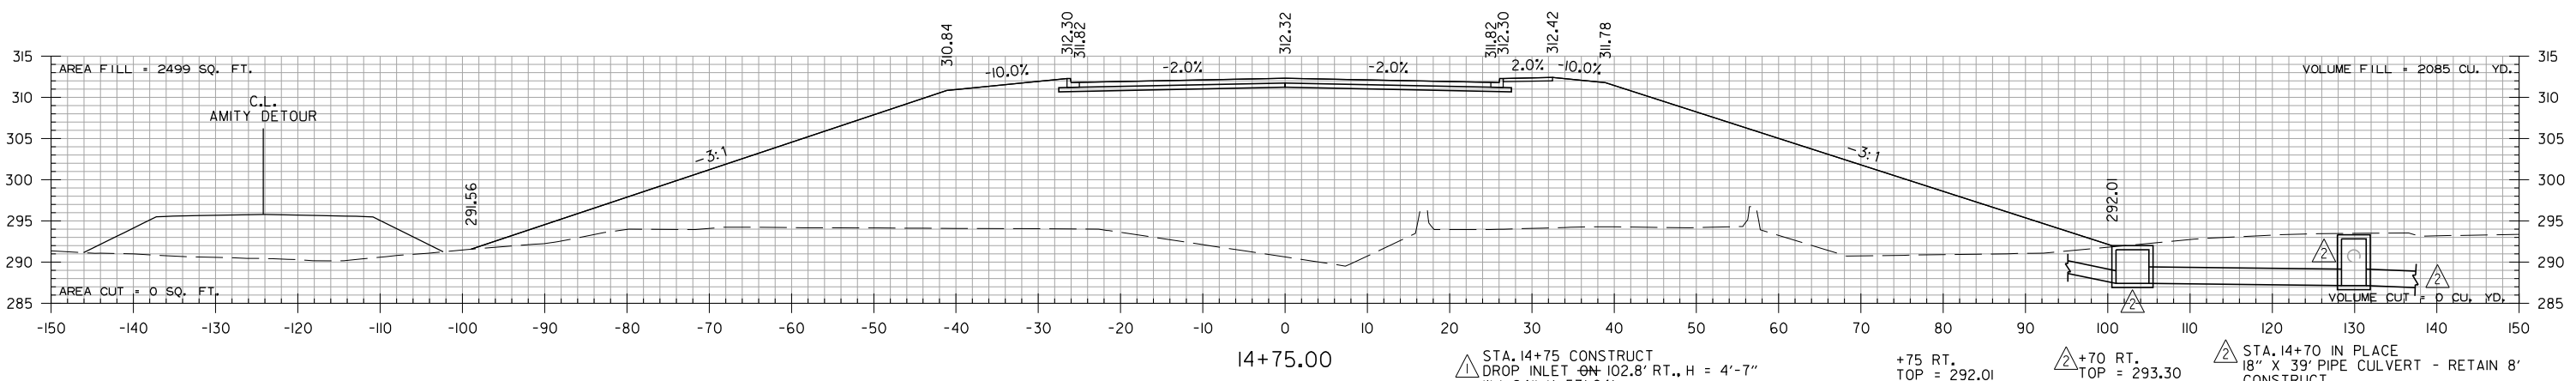



STA. 14+75 CONSTRUCT  
 DROP INLET  $\phi$  102.8' RT., H = 4'-7"  
 W/ 24" X 53' 24"  
 R.C. PIPE CULVERT TO R.C.B. CULVERT  
 JUNCTION BOX ON RT.  
 TYPE E INLET = 6'-0" X 4'-0"

+75 RT.  
 TOP = 292.01  
 FL. IN = 287.53  
 FL. IN = 287.53  
 FL. OUT = 287.43

+70 RT.  
 TOP = 293.30  
 FL. IN = 289.97  
 FL. IN = 287.13  
 FL. OUT = 287.13

STA. 14+70 IN PLACE  
 18" X 39' PIPE CULVERT - RETAIN 8'  
 CONSTRUCT  
 JUNCTION BOX 129.9' RT., H = 6'-2"  
 W/ 24" X 121' R.C. PIPE CULVERT TO  
 FES 210.0' RT.  
 TYPE E JUNCTION BOX = 4'-0" X 3'-0"

+87 RT. FES  
 FL. = 284.10

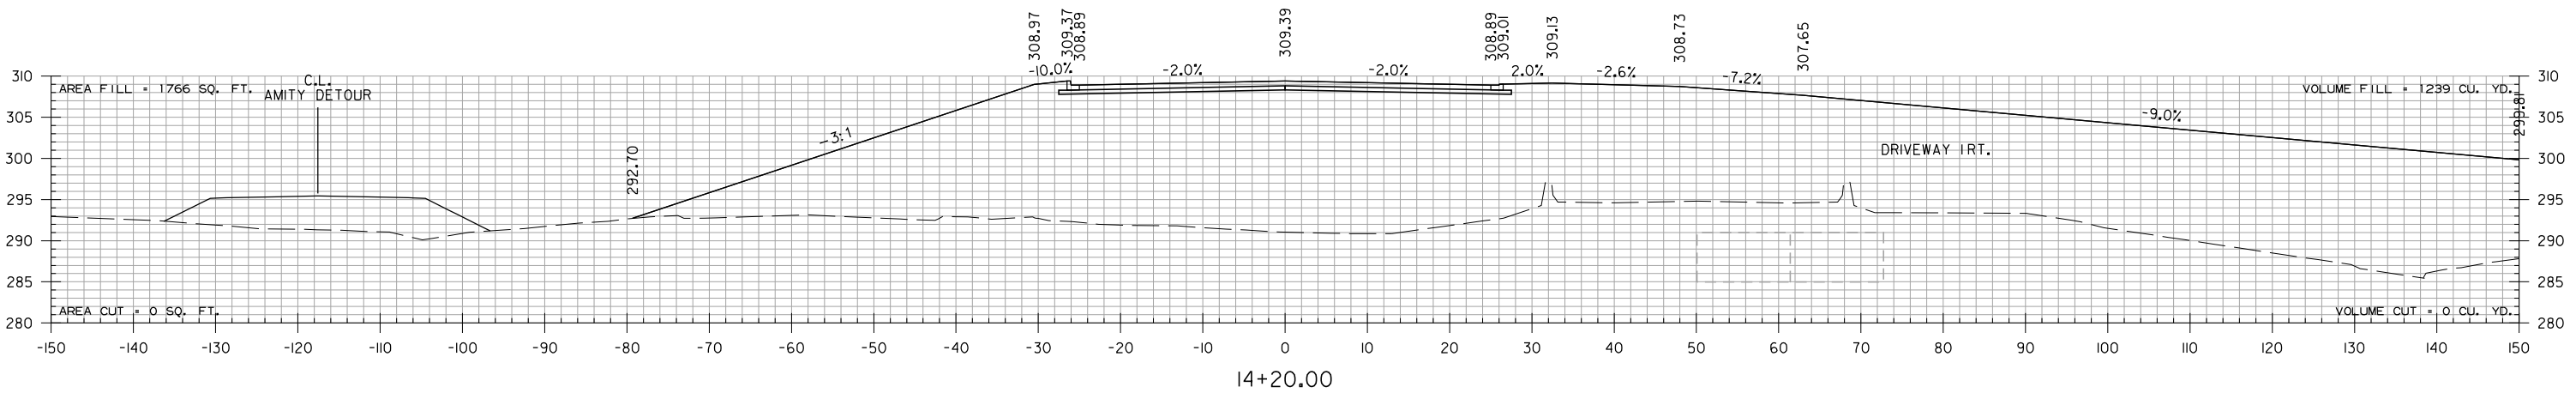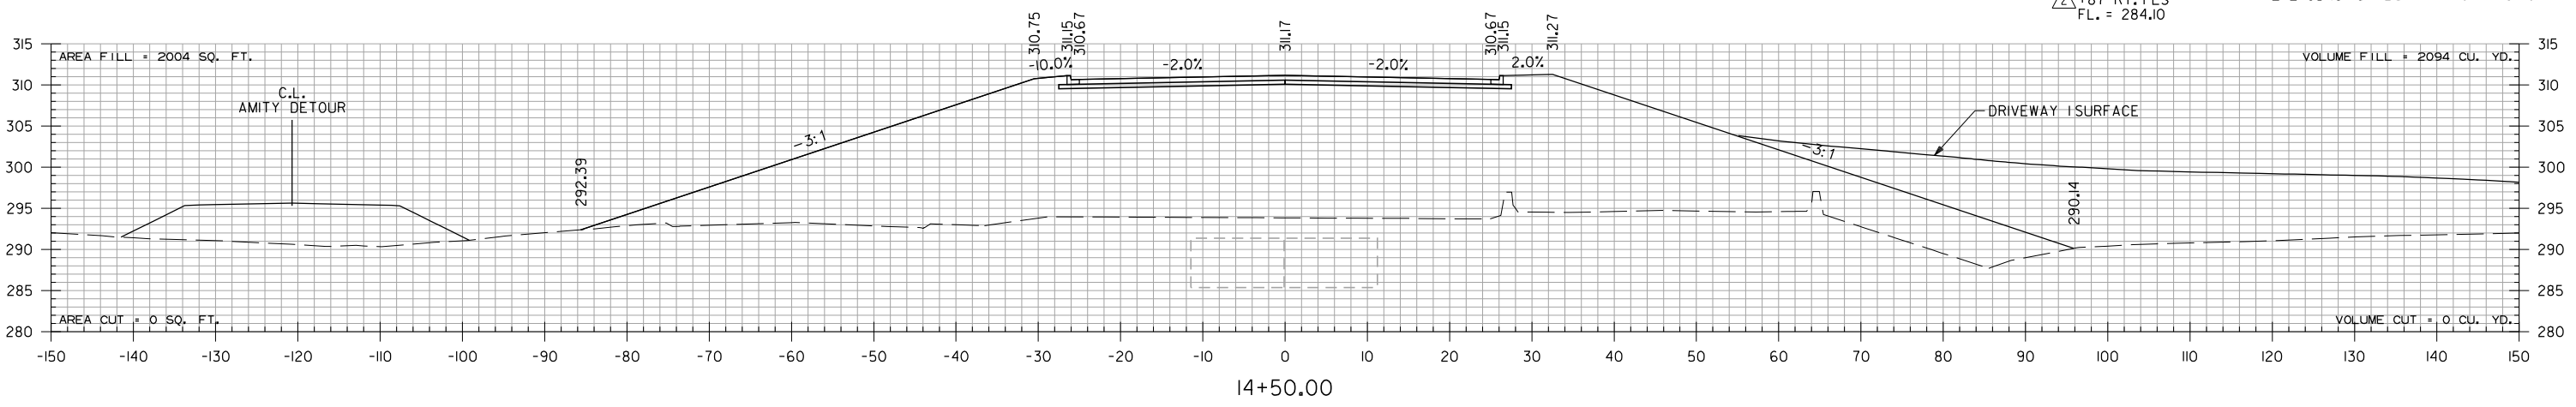


AMITY RD.  
STA. 14+50 TO STA. 14+75

2/10/2016 4:34:26 PM  
 WORKSPACE: AHTD  
 L:\2012\201590 - Contr-ell\field Access\Drawings\6TH STA\6TH.CX.ALL.dgn  
 REVISED DATE:

DATE REVISED	DATE FILMED	DATE REVISED	DATE FILMED	FED. RD. DIST. NO.	STATE	FED. AID PROJ. NO.	SHEET NO.	TOTAL SHEETS
				6	ARK.			
				JOB NO.	080517	158	182	

2 CROSS SECTIONS


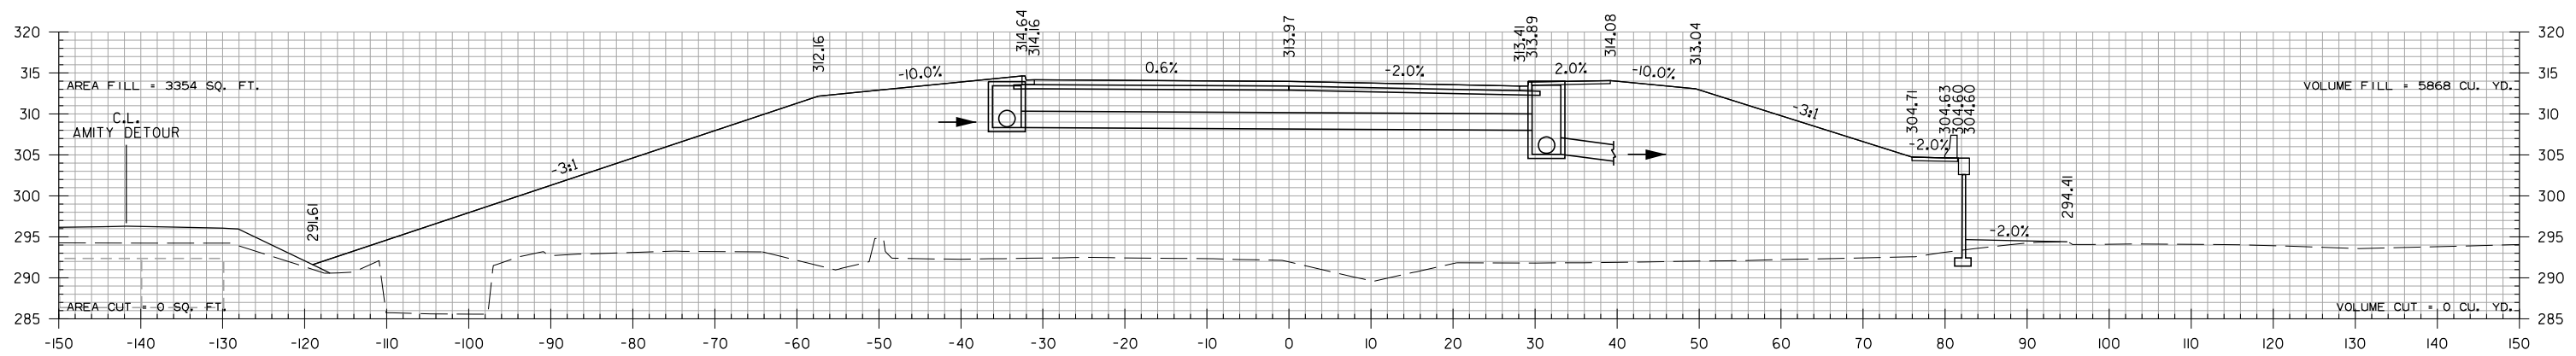


STA. 15+50 CONSTRUCT  
DROP INLET ON LT., H = 5'-8"  
W/ 24" X 62"  
R.C. PIPE CULVERT TO DROP INLET ON RT.  
TYPE MO INLET = 4'-0" DIA.  
TYPE C INLET = 4'-0" X 3'-3"

+50 LT.  
TOP = 314.64  
FL. IN = 309.07  
FL. OUT = 308.97

+50 RT.  
TOP = 313.89  
FL. IN = 308.00  
FL. IN = 305.16  
FL. OUT = 305.06

STA. 15+50 CONSTRUCT  
DROP INLET ON RT., H = 8'-10"  
W/ 24" X 102"  
R.C. PIPE CULVERT TO DROP INLET ON RT.  
TYPE MO INLET = 4'-0" DIA.  
TYPE C INLET = 4'-0" X 3'-3"

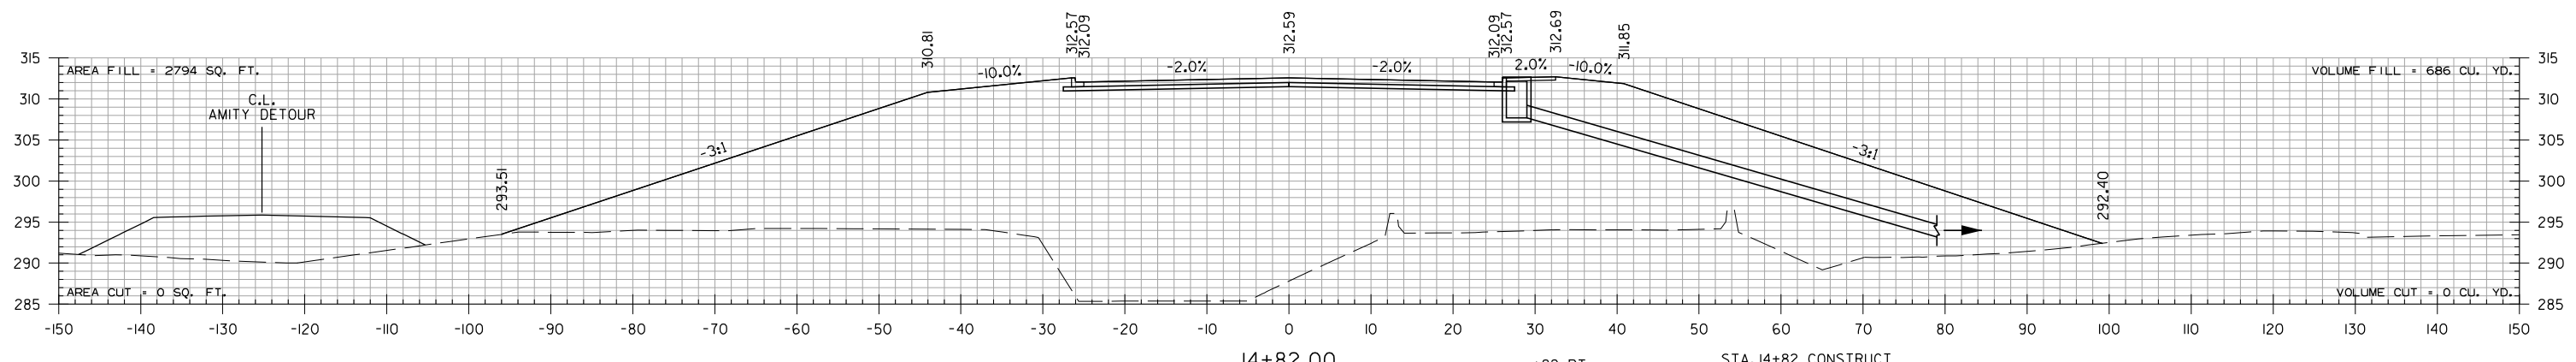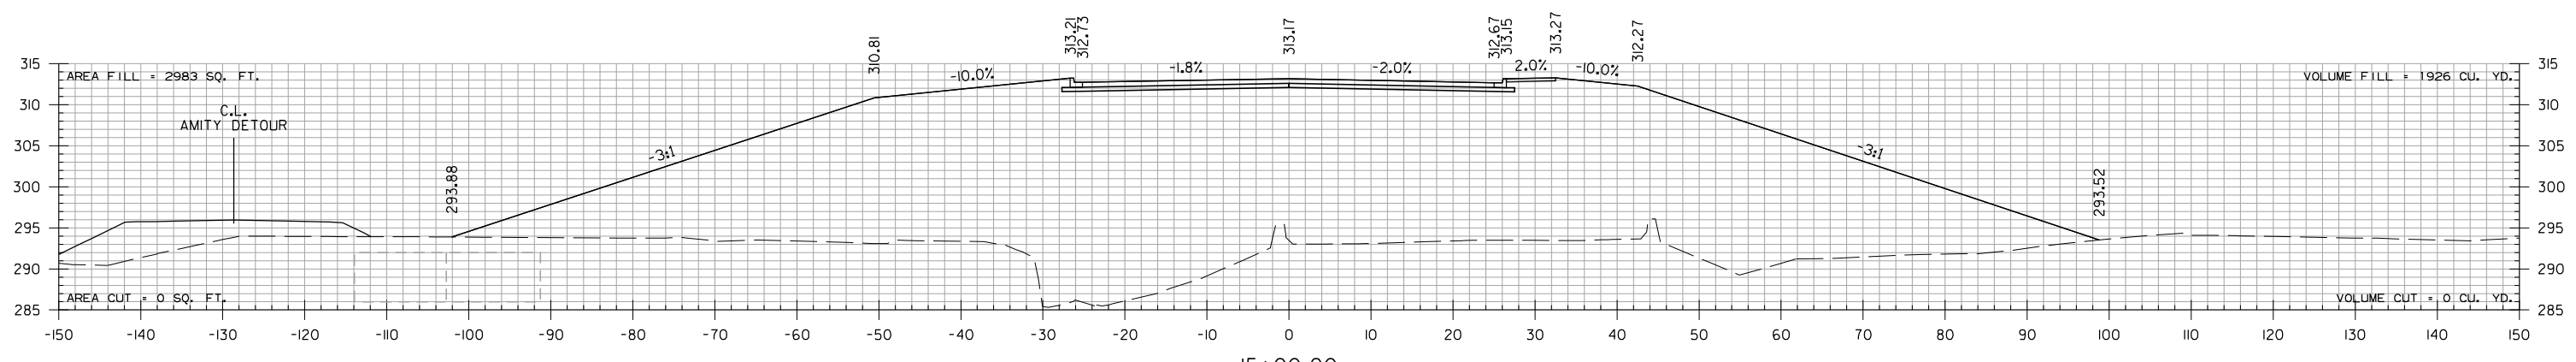

+82 RT.  
TOP = 312.57  
INV. = 307.65

STA. 14+82 CONSTRUCT  
DROP INLET ON RT., H = 4'-11"  
W/ 18" X 72"  
R.C. PIPE CULVERT TO DROP INLET ON RT.  
TYPE MO INLET = 4'-0" DIA.  
TYPE C INLET = 4'-0" X 2'-6"


AMITY RD.  
STA. 14+82 TO STA. 16+00

5/20/2015 7:13:45 AM  
WORKSPACE: AHTD  
L:\2012\1201590 - Contrail\field Access\Drawings\6TH\_ST\6TH.CX.ALL.dgn  
REVISED DATE:

DATE REVISED	DATE FILMED	DATE REVISED	DATE FILMED	FED. RD. DIST. NO.	STATE	FED. AID PROJ. NO.	SHEET NO.	TOTAL SHEETS
				6	ARK.			
				JOB NO.		080517	159	182

2 CROSS SECTIONS

STA. 16+00 END AMITY RD. SOUTH

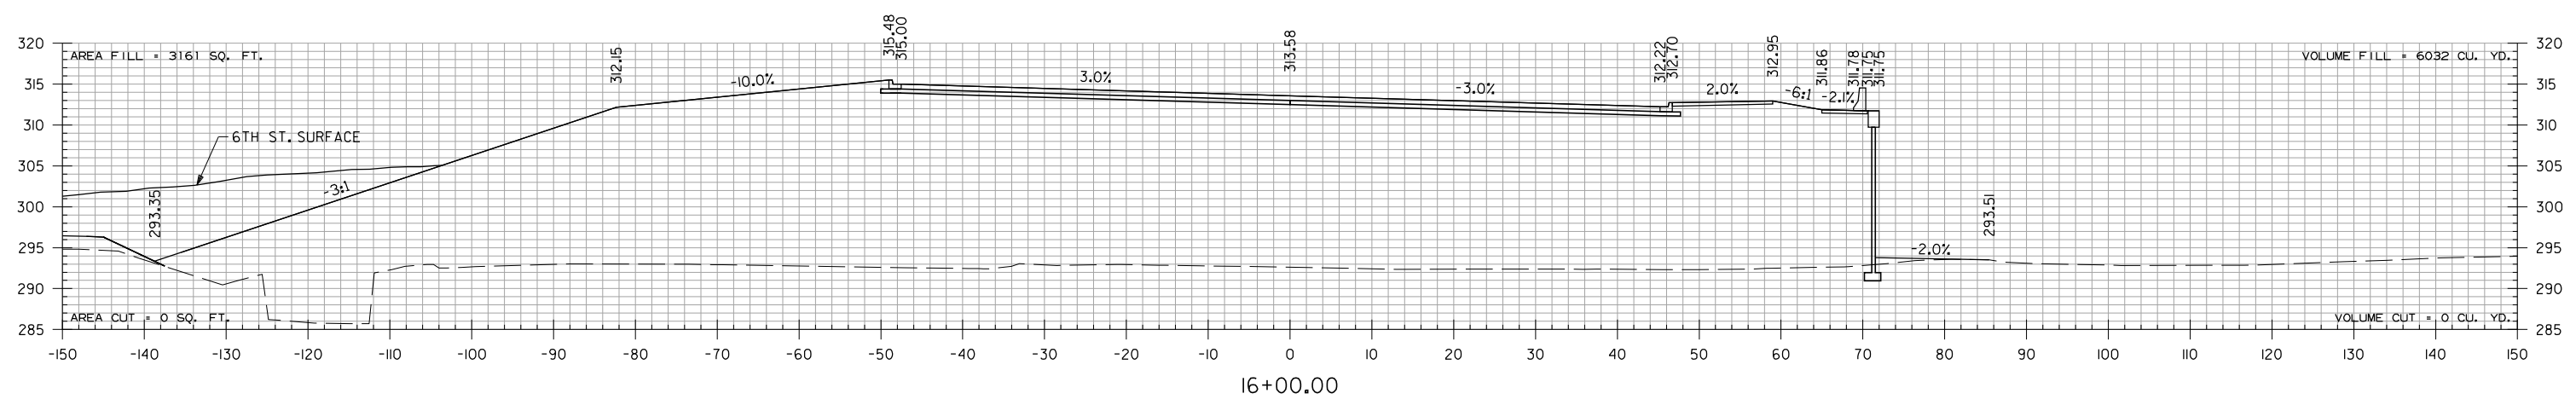



16+00.00

AMITY RD.  
STA. 16+00 TO STA. 16+00

5/20/2015 7:13:45 AM  
rccorbyn  
WORKSPACE: AHTD  
L:\2012\201550 - Conrail\field Access\Drawings\6TH ST\6TH.CX.ALL.dgn  
REVISED DATE:

DATE REVISED	DATE FILMED	DATE REVISED	DATE FILMED	FED. RD. DIST. NO.	STATE	FED. AID PROJ. NO.	SHEET NO.	TOTAL SHEETS
				6	ARK.			
				JOB NO.	080517	160	182	

2 CROSS SECTIONS

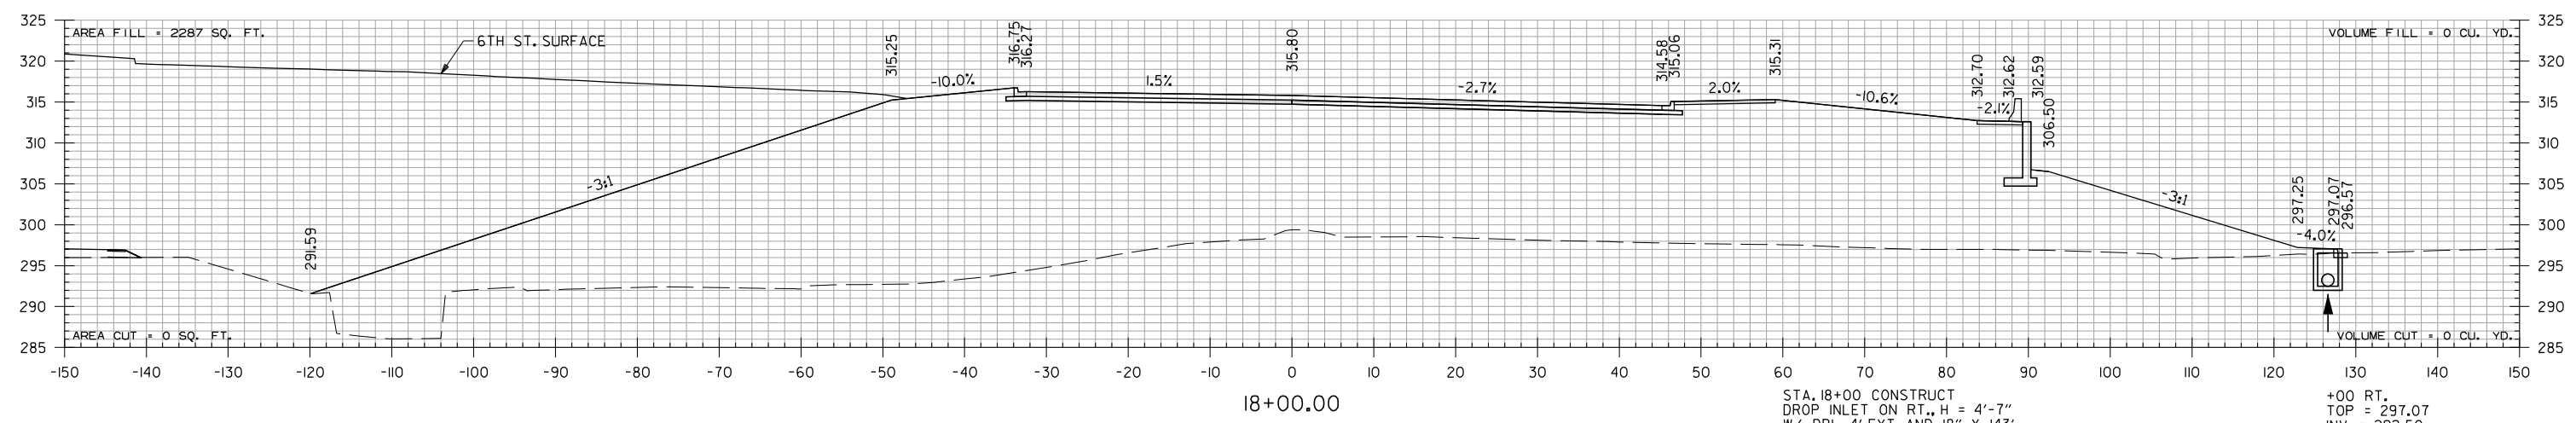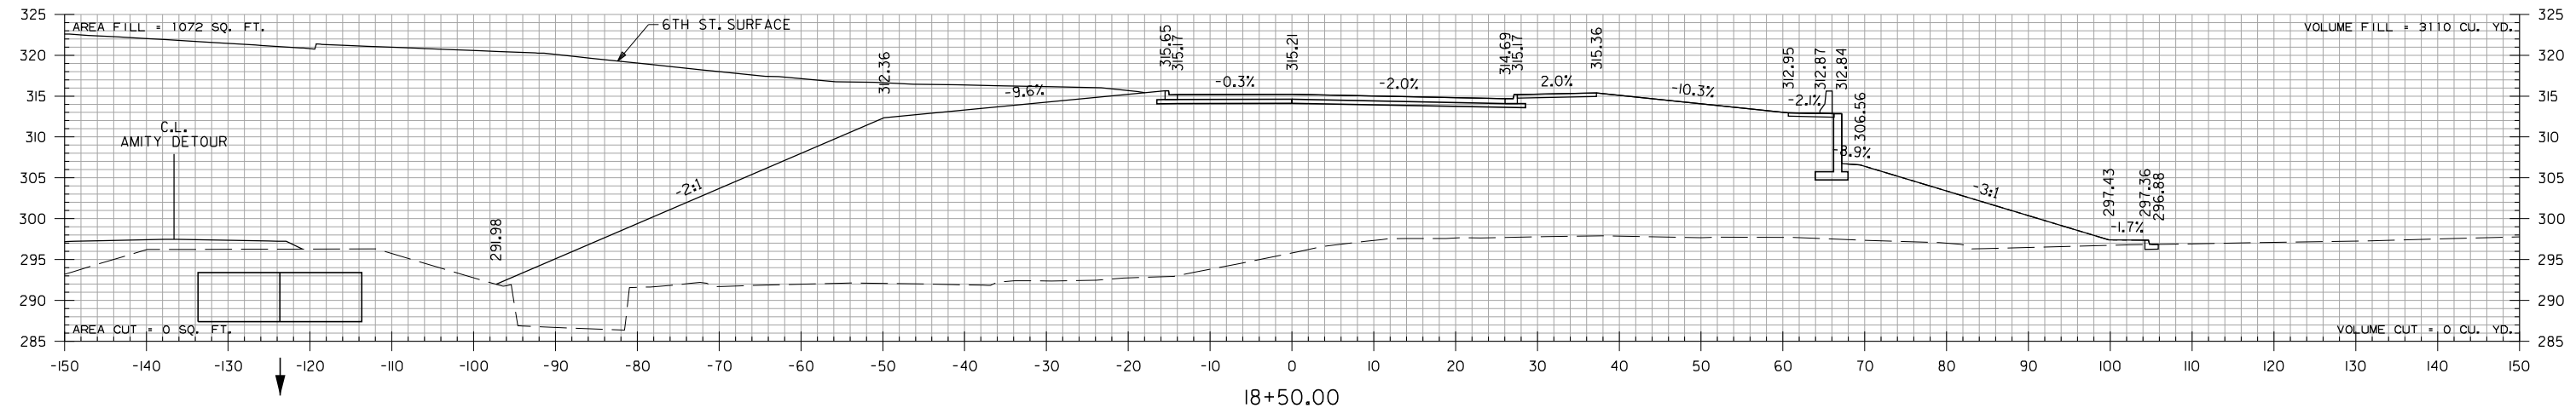

STA. 18+00 BEGIN AMITY RD. NORTH

STA. 18+00 CONSTRUCT  
 DROP INLET ON RT., H = 4'-7"  
 W/ DBL. 4' EXT. AND 18" X 143'  
 R.C. PIPE CULVERT TO DROP INLET ON RT.  
 TYPE MO INLET = 4'-0" DIA.  
 TYPE C INLET = 4'-0" X 2'-6"


+00 RT.  
 TOP = 297.07  
 INV. = 292.50

STA. 18+00 TO STA. 18+50


5/20/2015 7:13:45 AM  
 WORKSPACE: AHTD  
 L:\2012\1201590 - Contr\Rail\field Access\Drawings\6TH\_ST\6TH.CX.ALL.dgn  
 REVISED DATE:



DATE REVISED	DATE FILMED	DATE REVISED	DATE FILMED	FED. RD. DIST. NO.	STATE	FED. AID PROJ. NO.	SHEET NO.	TOTAL SHEETS
2-10-2016				6	ARK.	080517	161	182
				JOB NO.		080517	161	182
				2 CROSS SECTIONS				

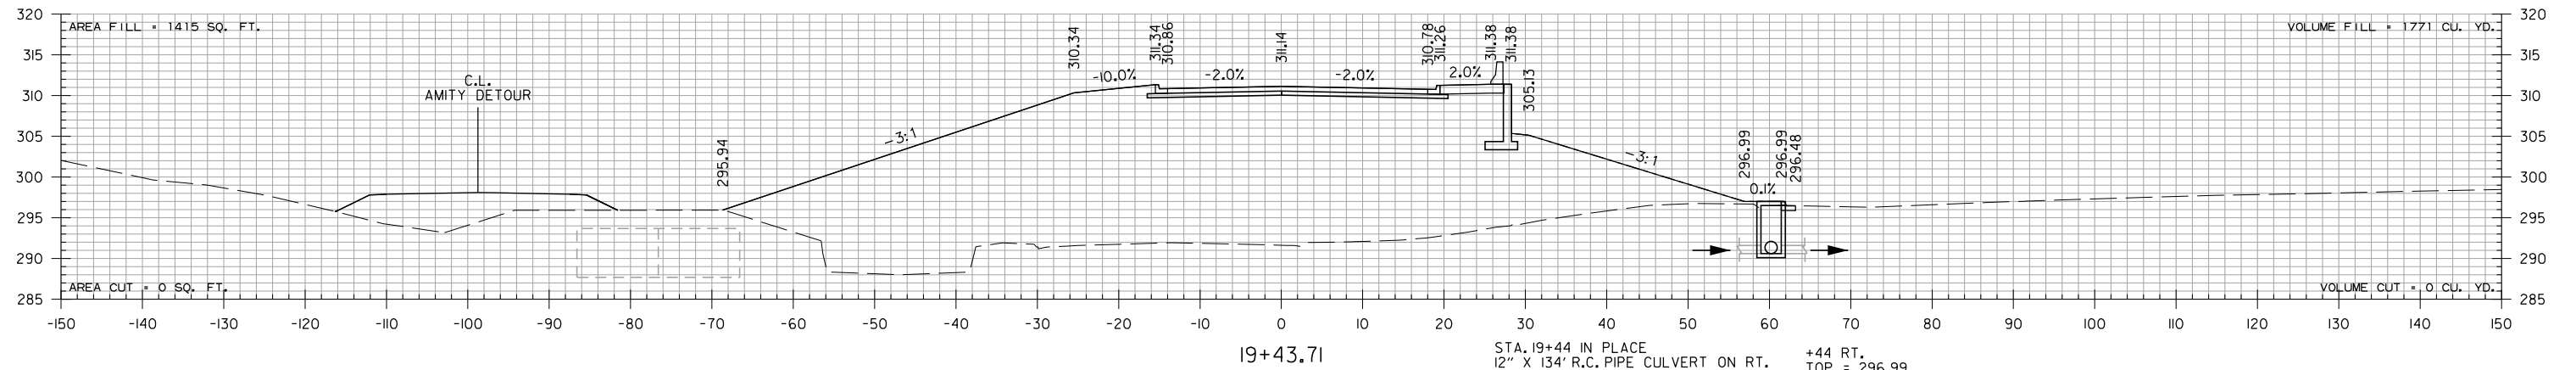

STA. 19+44 IN PLACE  
12" X 134' R.C. PIPE CULVERT ON RT. +44 RT.  
REMOVE 27' L.F. TOP = 296.99  
CONSTRUCT INV. = 290.60  
DROP INLET ON RT., H = 6'-5"  
W/ DBL. 4' EXT.  
TYPE ST INLET = 4'-0" X 2'-6"  
CONNECT TO EXISTING 12" R.C. PIPE CULVERT

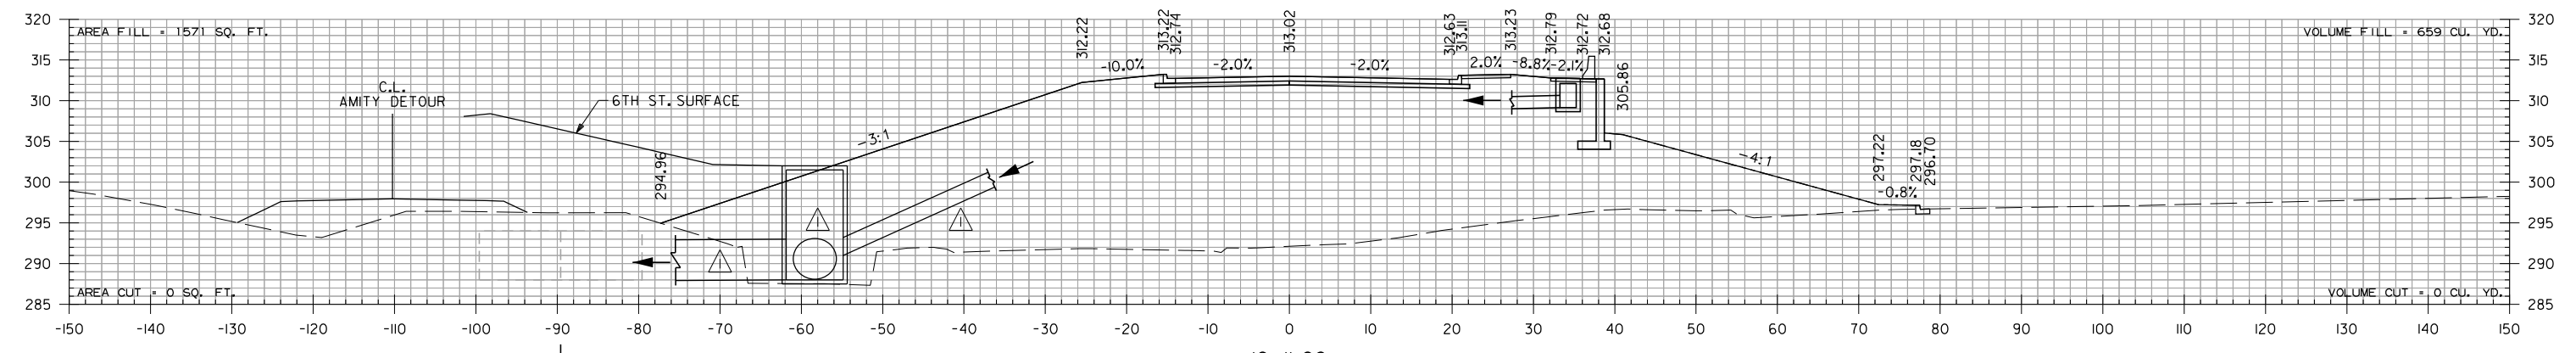


+14 LT. TOP = 302.00  
FL. IN = 291.00  
FL. IN = 288.10  
FL. OUT = 288.00

△ +20.64 LT. FL. IN = 290.50 287.90 (R.C.B.)

STA. 19+14 CONSTRUCT JUNCTION BOX ON LT., H = 14'-0"  
W/ 60" X 19' R.C. PIPE CULVERT TO R.C. CONCRETE BOX CULVERT ON LT.  
TYPE E JUNCTION BOX = 6'-6" X 7'-0"

19+12 CONSTRUCT DROP INLET ON RT., H = 3'-7"  
W/ 18" X 13' R.C. PIPE CULVERT TO DROP INLET ON RT.  
TYPE E INLET = 3'-0" X 2'-0"

+12 RT. TOP = 312.72  
INV. = 309.14

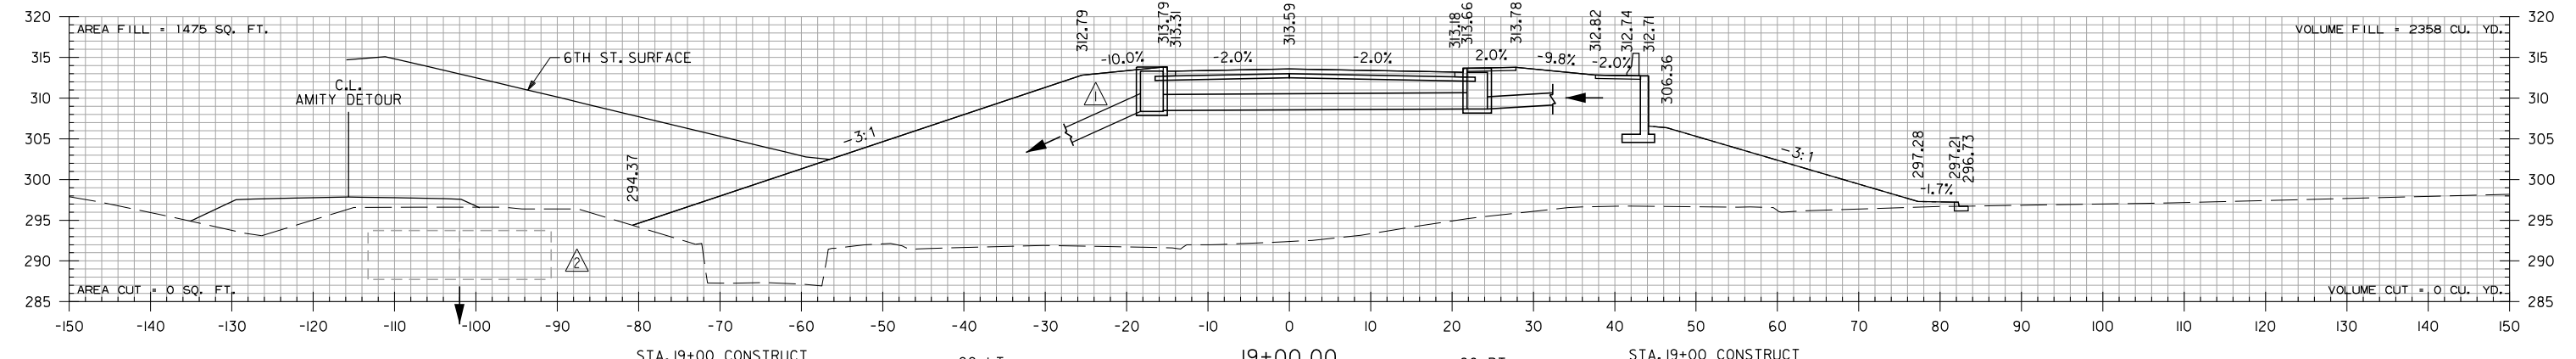

19+20.64 LT. FL. IN = 290.50 (R.C.B.)

STA. 19+00 CONSTRUCT DROP INLET ON LT., H = 5'-3"  
W/ 24" X 66' 44" R.C. PIPE CULVERT TO R.C. CONCRETE BOX CULVERT JUNCTION BOX ON LT.  
TYPE MO INLET = 4'-0" DIA.  
TYPE C INLET = 4'-0" X 2'-6"

+00 LT. TOP = 313.79  
FL. IN = 308.64  
FL. OUT = 308.54

19+00 RT. TOP = 313.66  
FL. IN = 309.01  
FL. OUT = 308.91




STA. 19+00 CONSTRUCT DROP INLET ON RT., H = 4'-9"  
W/ 24" X 37' R.C. PIPE CULVERT TO DROP INLET ON LT.  
TYPE MO INLET = 4'-0" DIA.  
TYPE C INLET = 4'-0" X 2'-6"

AMITY RD.  
STA. 19+00 TO STA. 19+44

2/10/2016 4:34:26 PM  
 WORKSPACE: AHTD  
 L:\2012\1201590 - Contrail\field Access\Drawings\6TH ST\6TH.CX.ALL.dgn  
 REVISION DATE:

DATE REVISED	DATE FILMED	DATE REVISED	DATE FILMED	FED. RD. DIST. NO.	STATE	FED. AID PROJ. NO.	SHEET NO.	TOTAL SHEETS
2-10-2016				6	ARK.			
						080517	162	182




2 CROSS SECTIONS

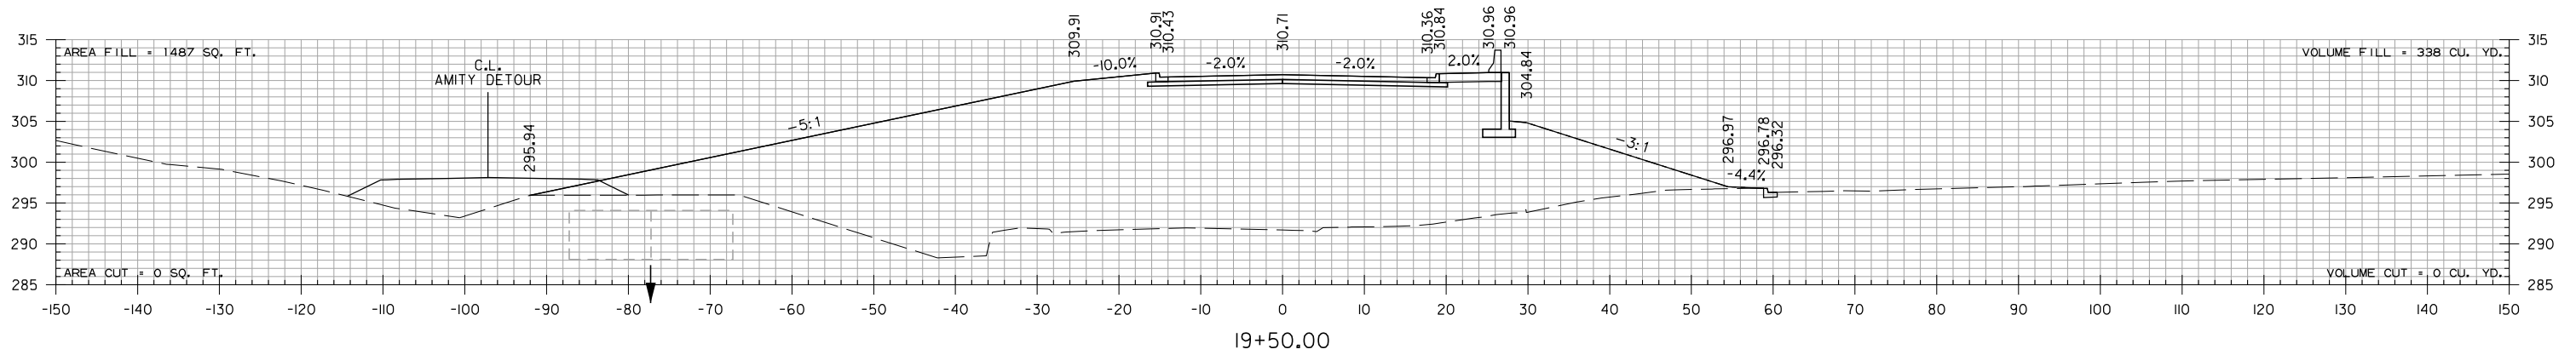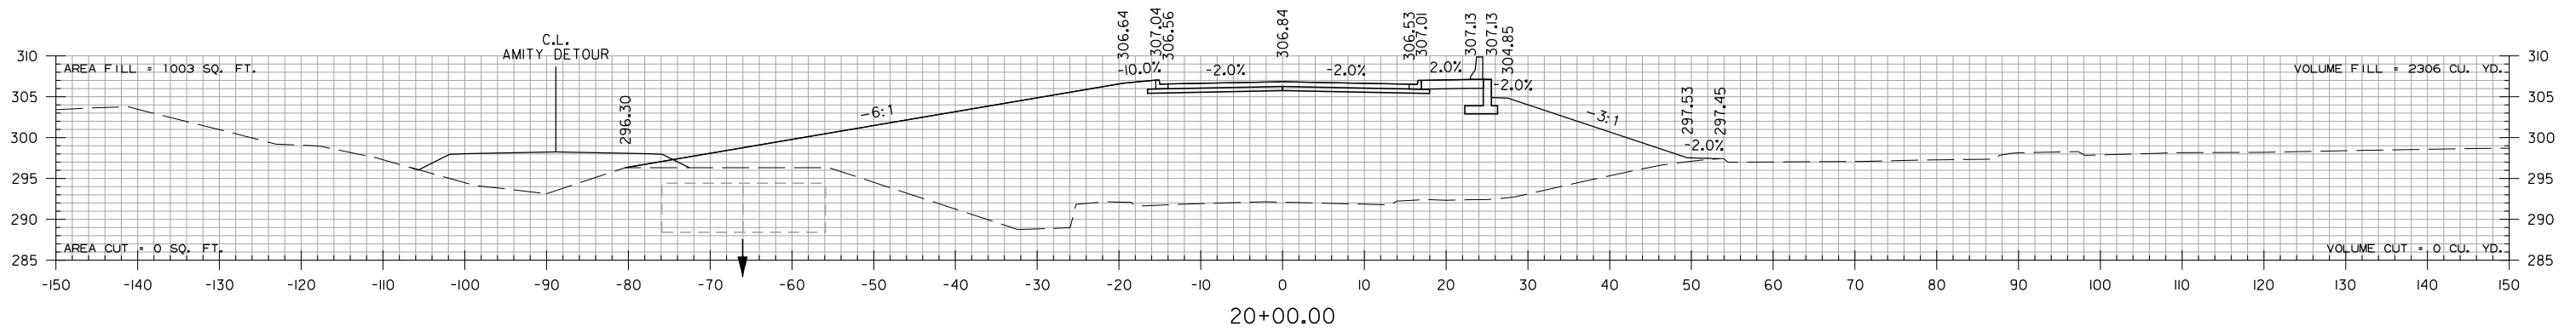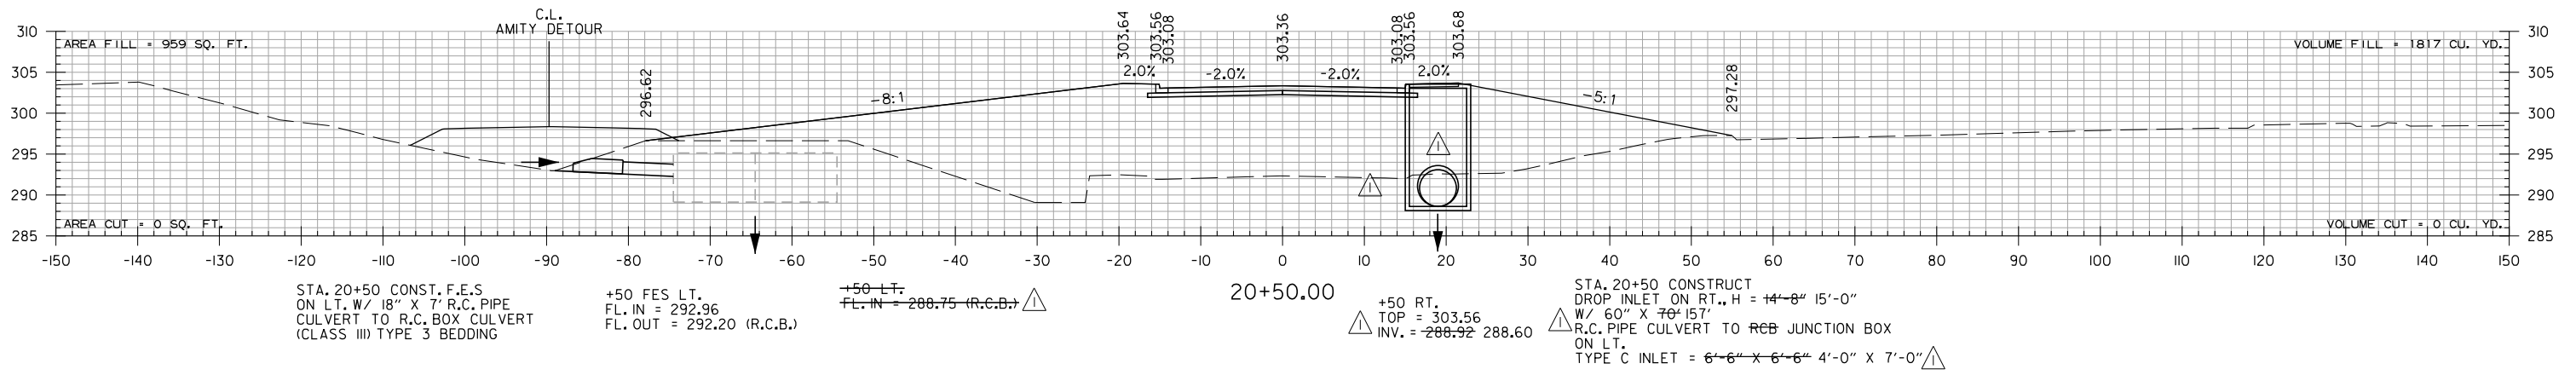

AMITY RD.  
STA. 20+00 TO STA. 20+70

2/10/2016 4:34:26 PM  
 WORKSPACE: AHTD  
 L:\2012\201590 - Contr-Rel\field Access\Drawings\6TH STA\6TH.CX.ALL.dgn  
 REVISED DATE:





DATE REVISED	DATE FILMED	DATE REVISED	DATE FILMED	FED. RD. DIST. NO.	STATE	FED. AID PROJ. NO.	SHEET NO.	TOTAL SHEETS
				6	ARK.			
				JOB NO.		080517	163	182
				2 CROSS SECTIONS				

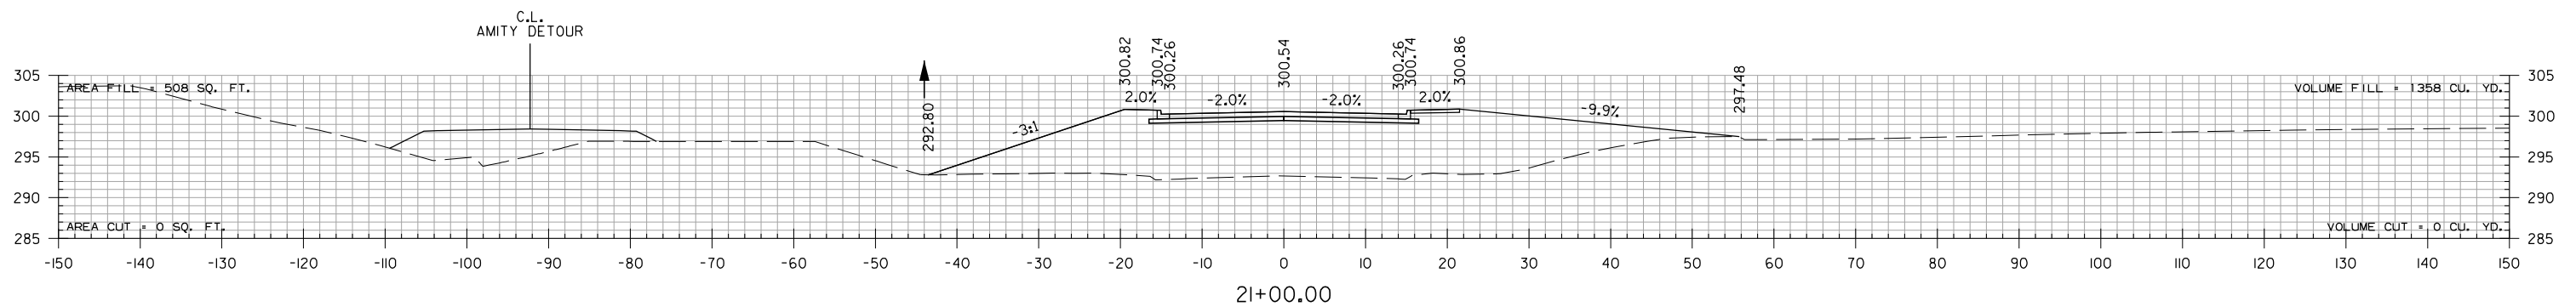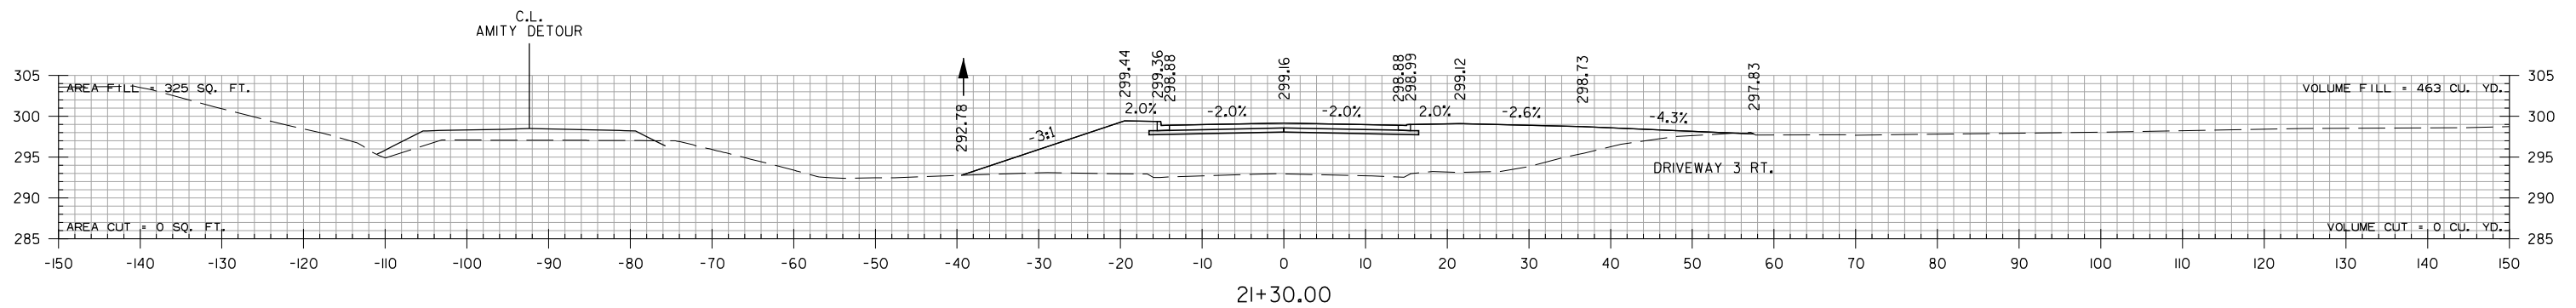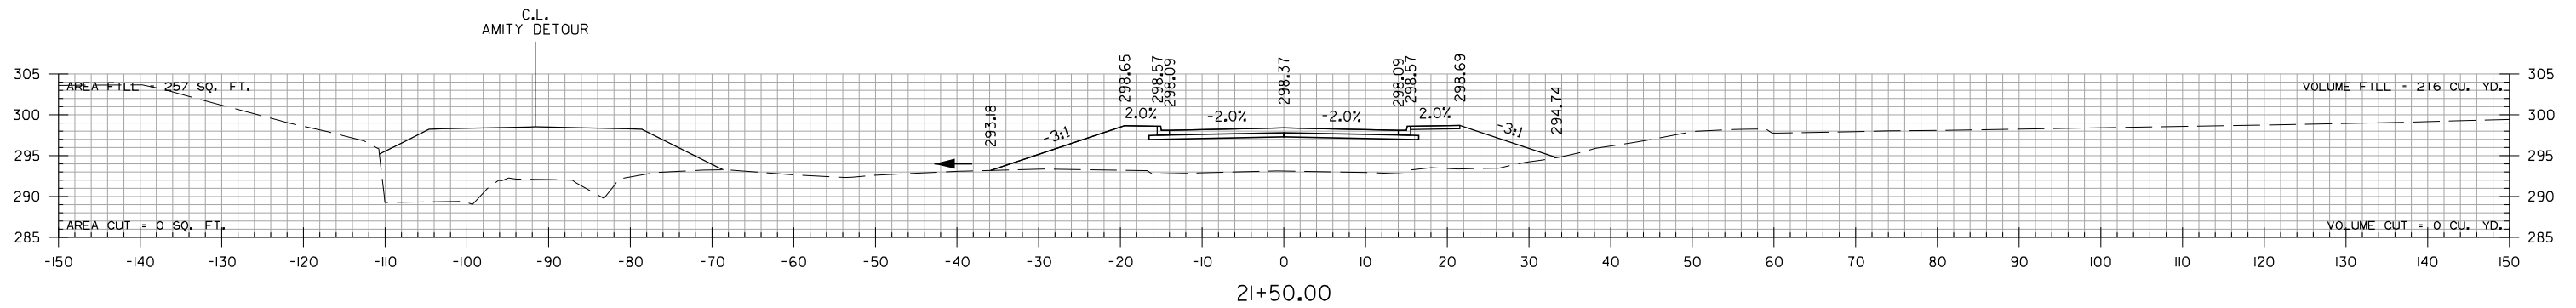

AMITY RD.  
STA. 20+81 TO STA. 21+50

5/20/2015 9:25 AM  
 WORKSPACE: AHTD  
 L:\2012\201590 - Contrail\field Access\Drawings\6TH.STA\6TH.CX.ALL.dgn  
 REVISED DATE:

DATE REVISED	DATE FILMED	DATE REVISED	DATE FILMED	FED. RD. DIST. NO.	STATE	FED. AID PROJ. NO.	SHEET NO.	TOTAL SHEETS
2-10-2016				6	ARK.			
						080517	164	182

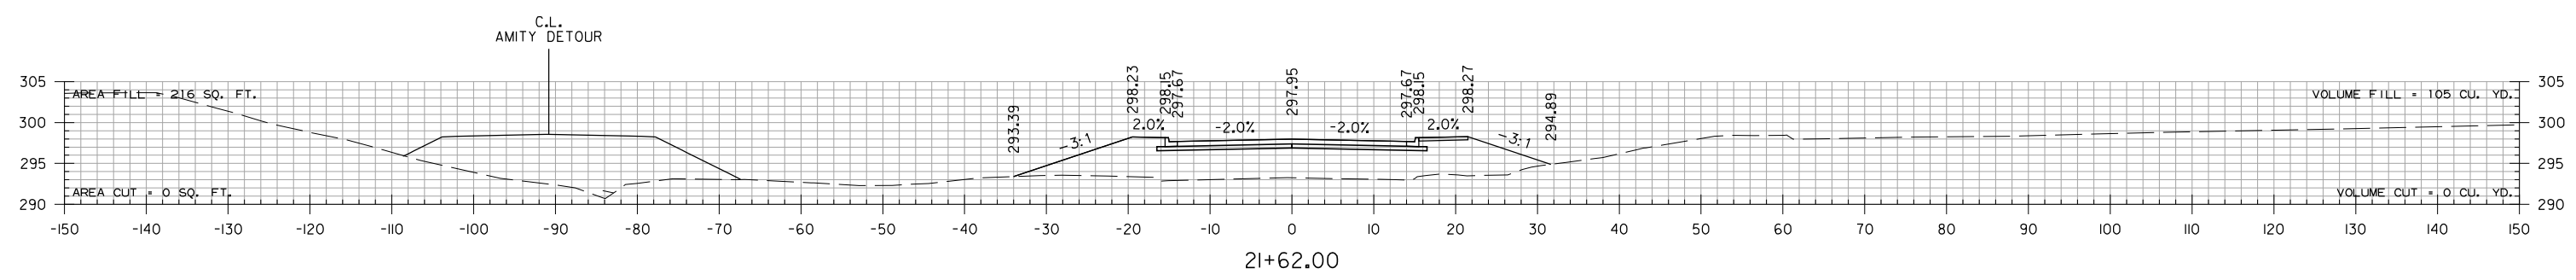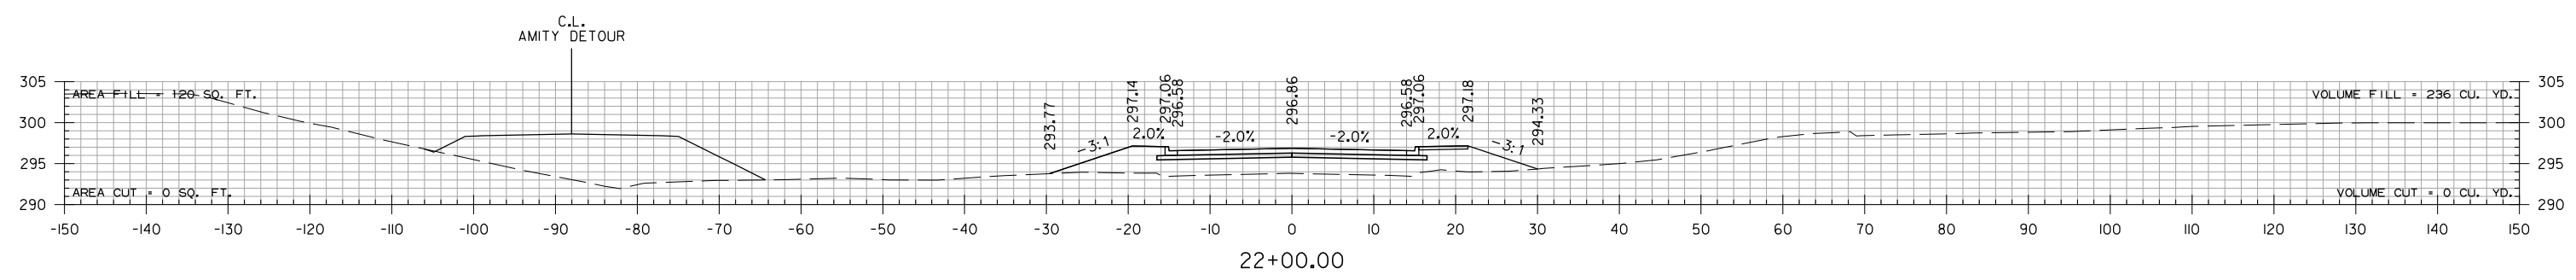
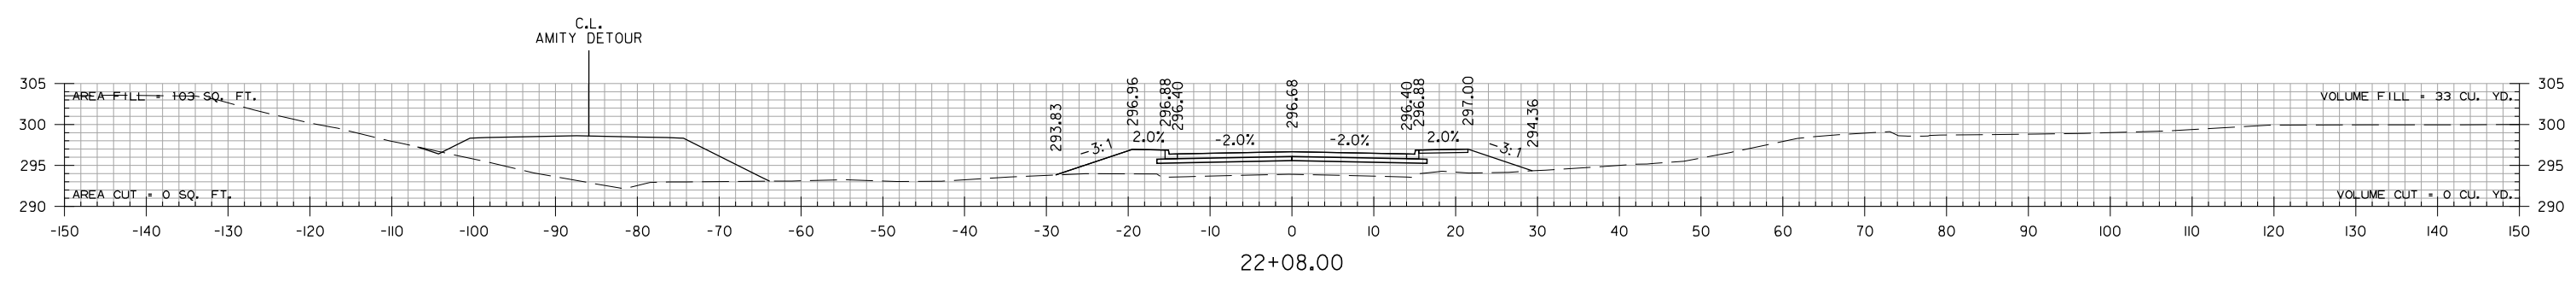
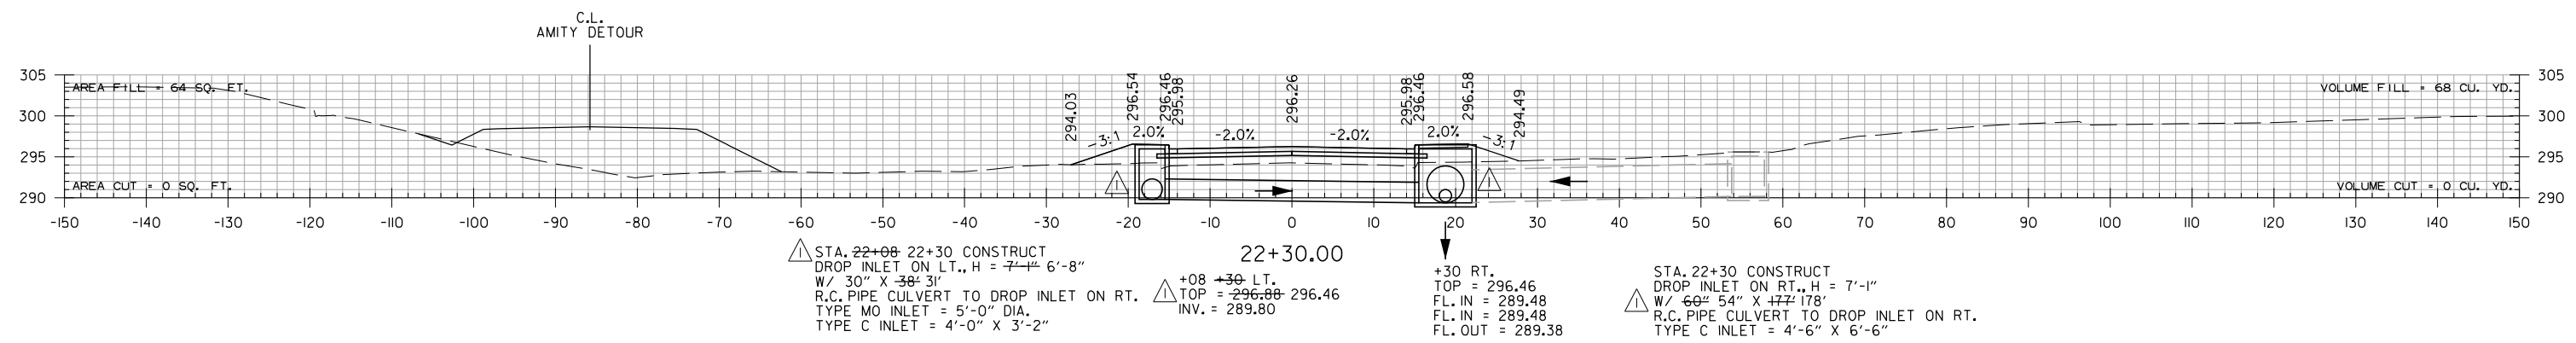


AMITY RD.  
STA. 21+62 TO STA. 22+30

2/10/2016 4:34:26 PM  
 WORKSPACE: AHTD  
 L:\2012\201590 - Contr\field Access\Drawings\6TH.STA\6TH.CX.ALL.dgn  
 REVISED DATE:

DATE REVISED	DATE FILMED	DATE REVISED	DATE FILMED	FED. RD. DIST. NO.	STATE	FED. AID PROJ. NO.	SHEET NO.	TOTAL SHEETS
2-10-2016				6	ARK.			
				JOB NO.	080517	165	182	

2 CROSS SECTIONS

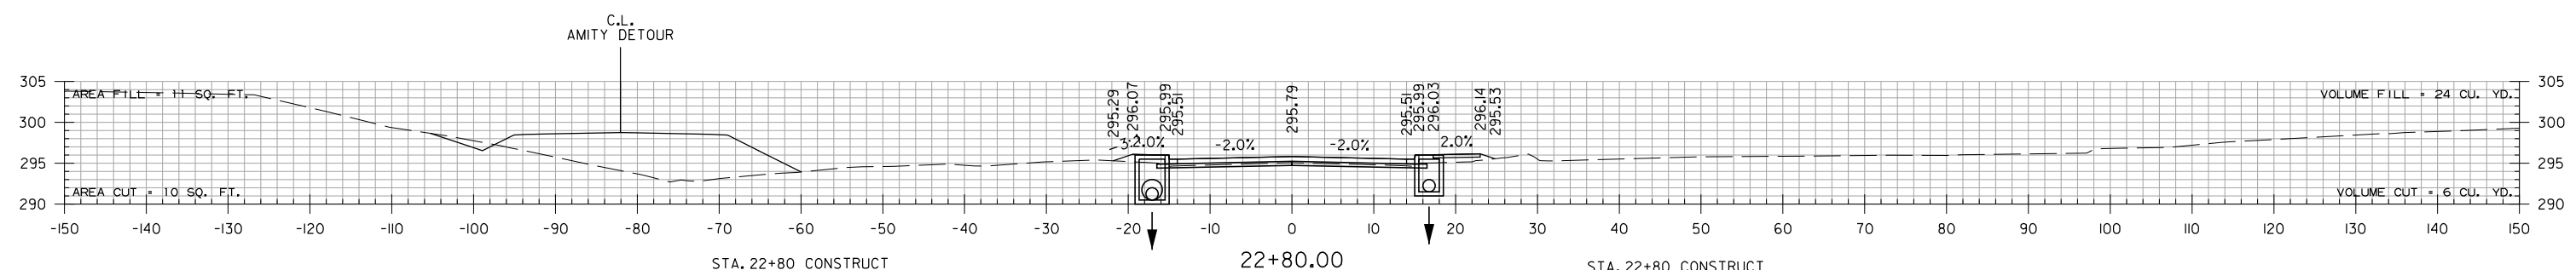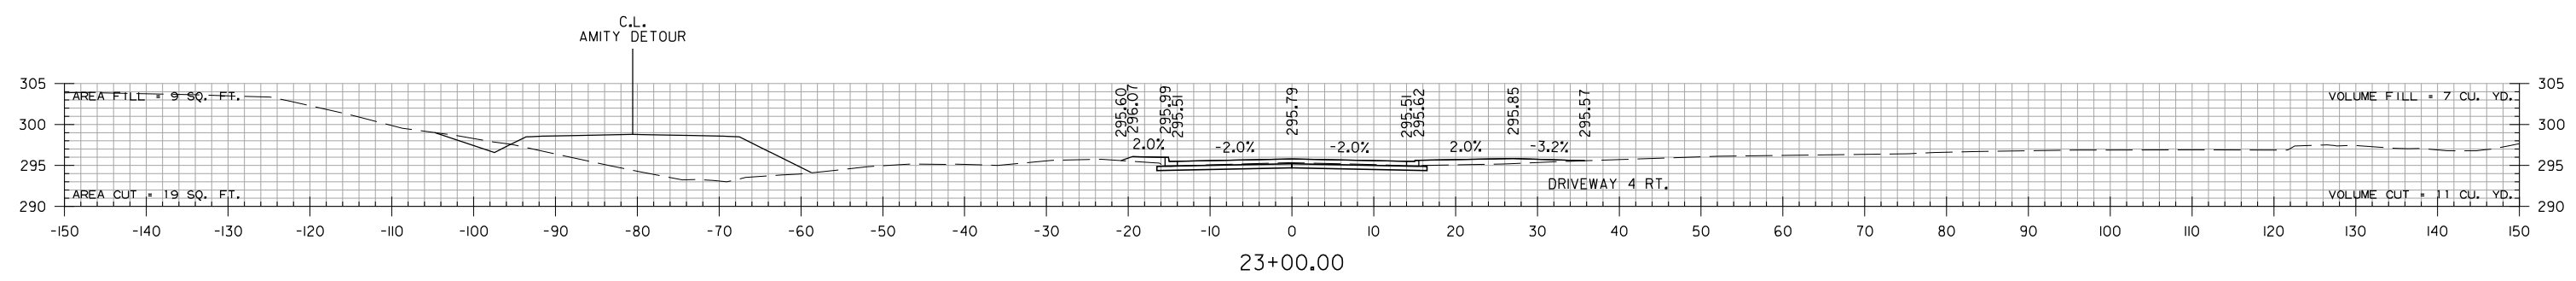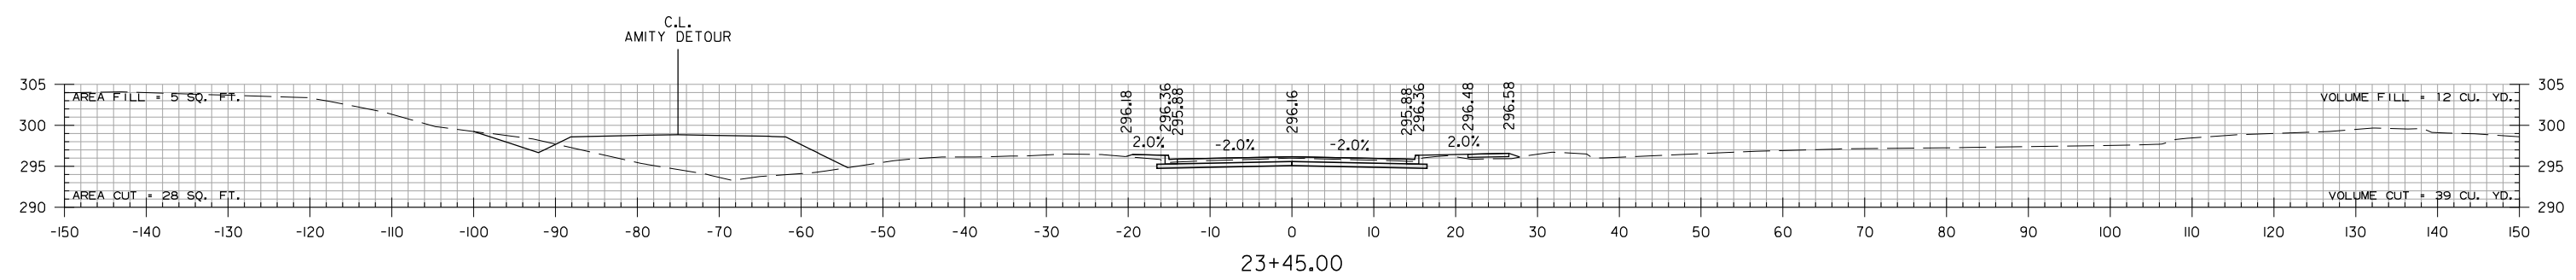


STA. 22+80 CONSTRUCT  
 DROP INLET ON LT., H = 5'-6"  
 W/ DBL. 4' EXT. AND 30" X 66' X 46'  
 R.C. PIPE CULVERT TO DROP INLET ON LT.  
 TYPE MO INLET = 5'-0" DIA.  
 TYPE C INLET = 4'-0" X 3'-2"

+80 LT.  
 TOP = 295.99  
 INV. = 290.49

+80 RT.  
 TOP = 295.99  
 INV. = 291.49

STA. 22+80 CONSTRUCT  
 DROP INLET ON RT., H = 4'-6"  
 W/ DBL. 4' EXT. AND 18" X 46'  
 R.C. PIPE CULVERT TO DROP INLET ON RT.  
 TYPE MO INLET = 4'-0" DIA.  
 TYPE C INLET = 4'-0" X 2'-6"

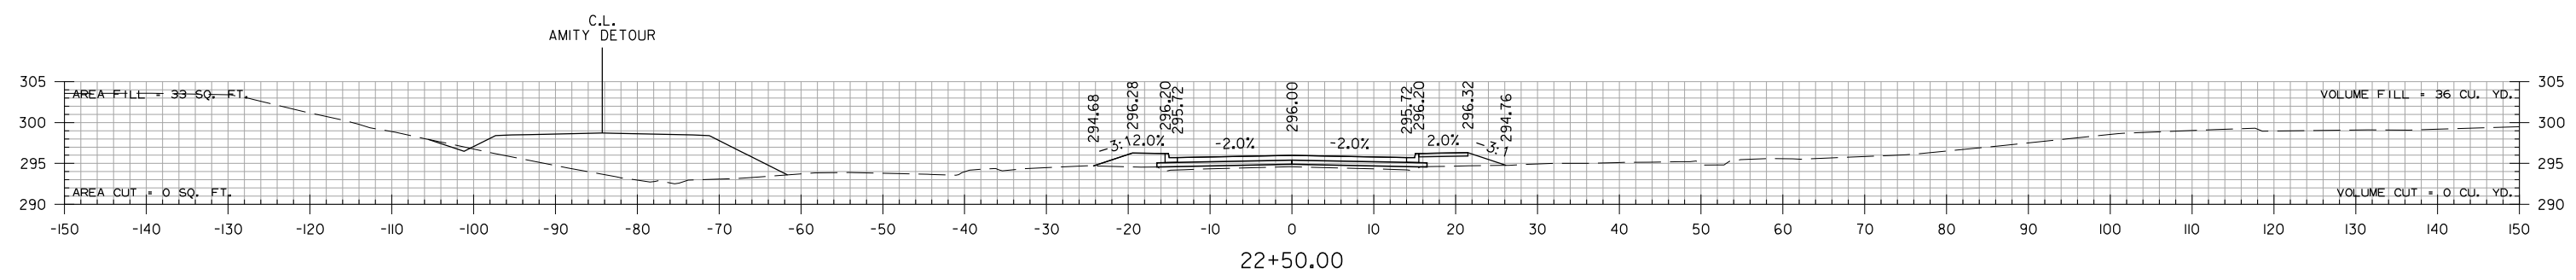


AMITY RD.  
 STA. 22+50 TO STA. 23+45


2/10/2016 4:34:27 PM  
 WORKSPACE: AHTD  
 L:\2012\201590 - Contr-ell\field Access\Drawings\6TH STA\6TH.CX.ALL.dgn  
 REVISED DATE:

DATE REVISED	DATE FILMED	DATE REVISED	DATE FILMED	FED. RD. DIST. NO.	STATE	FED. AID PROJ. NO.	SHEET NO.	TOTAL SHEETS
				6	ARK.			
				JOB NO.	080517	166	182	

2 CROSS SECTIONS

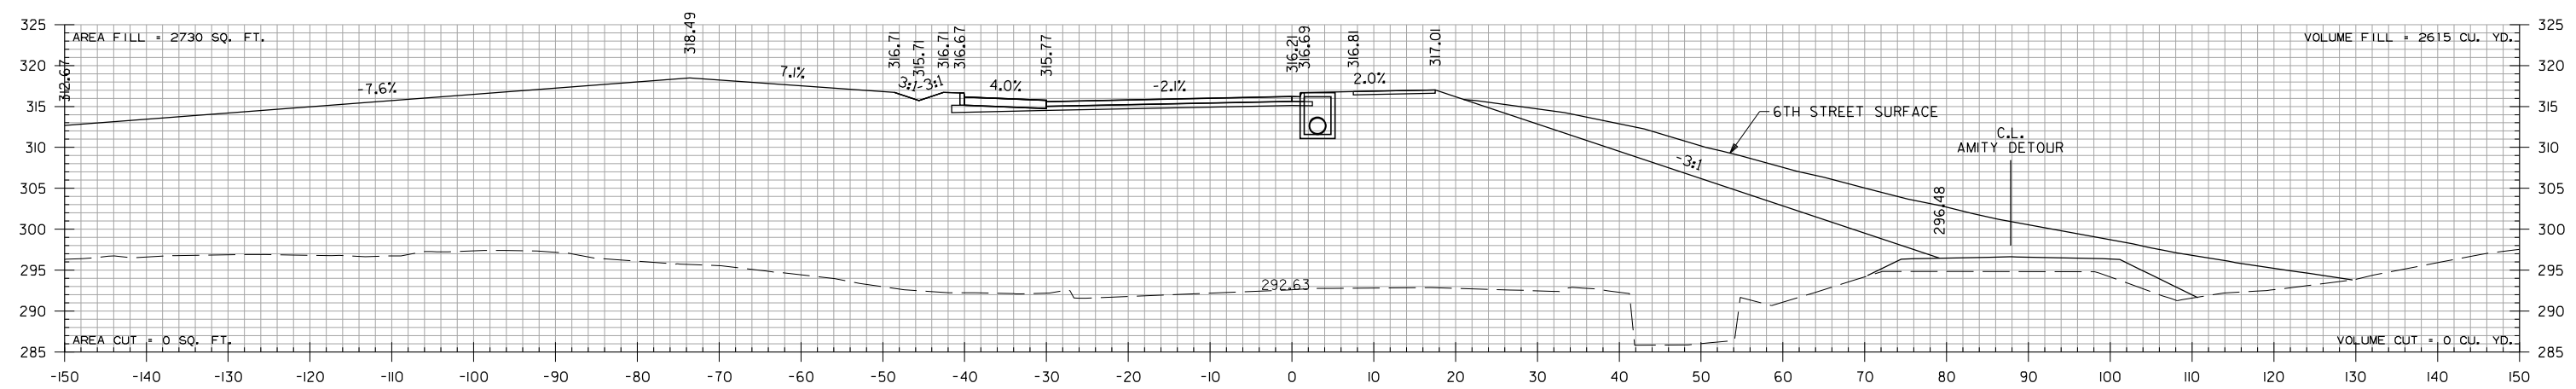

10+59.78  
 +50 RT.  
 TOP = 316.69  
 FL. IN = 311.71  
 FL. OUT = 311.61  
 STA. 42+50 CONSTRUCT  
 DROP INLET ON RT., H = 5'-1"  
 W/ 4' EXT. AND 24" X 105'  
 R.C. PIPE CULVERT TO DROP INLET ON RT.  
 TYPE M0 INLET = 4'-0" DIA.  
 TYPE C INLET = 4'-0" X 3'-3"

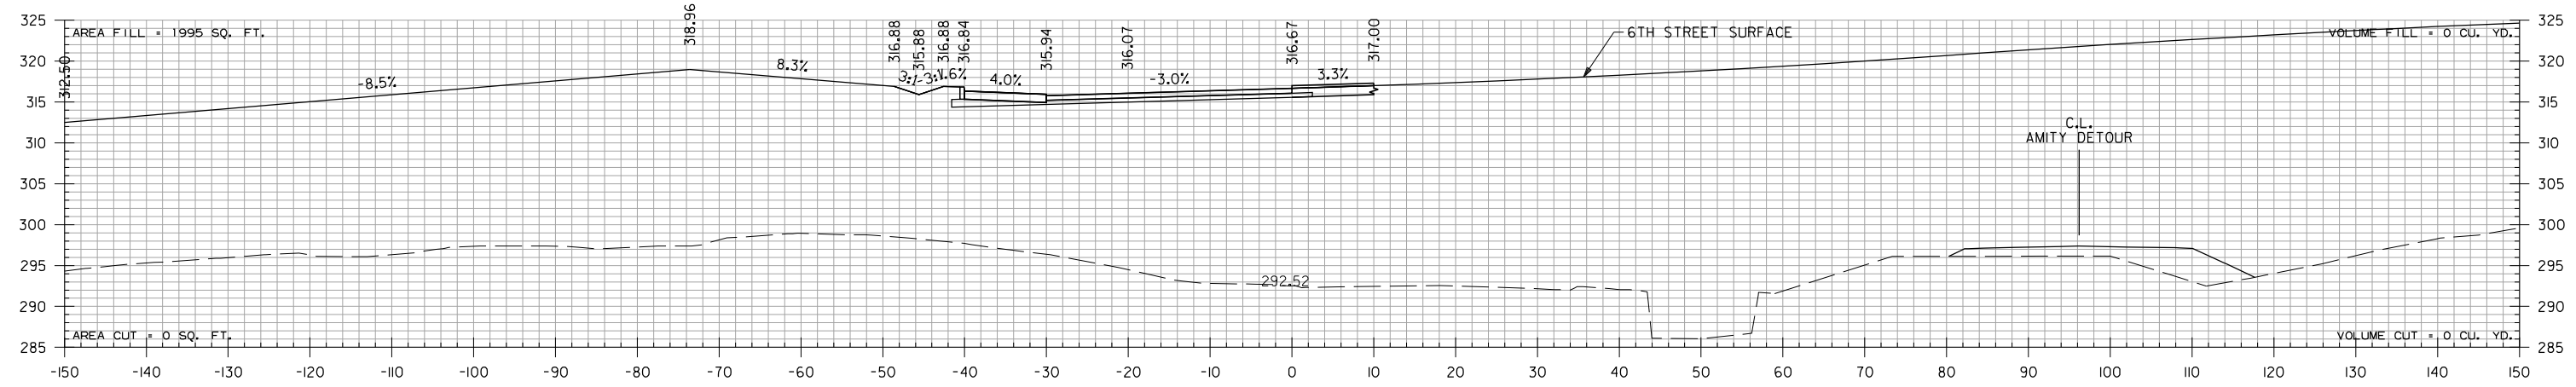


10+00.00  
 ROUNDABOUT  
 STA. 10+00 TO STA. 10+60

5/20/2015 7:13:47 AM  
 WORKSPACE: AHTD  
 L:\2012\101590 - Conrail\field Access\Drawings\6TH\_ST\6TH.CX.ALL.dgn  
 REVISED DATE:

DATE REVISED	DATE FILMED	DATE REVISED	DATE FILMED	FED. RD. DIST. NO.	STATE	FED. AID PROJ. NO.	SHEET NO.	TOTAL SHEETS
				6	ARK.			
				JOB NO.	080517	167	182	


2 CROSS SECTIONS

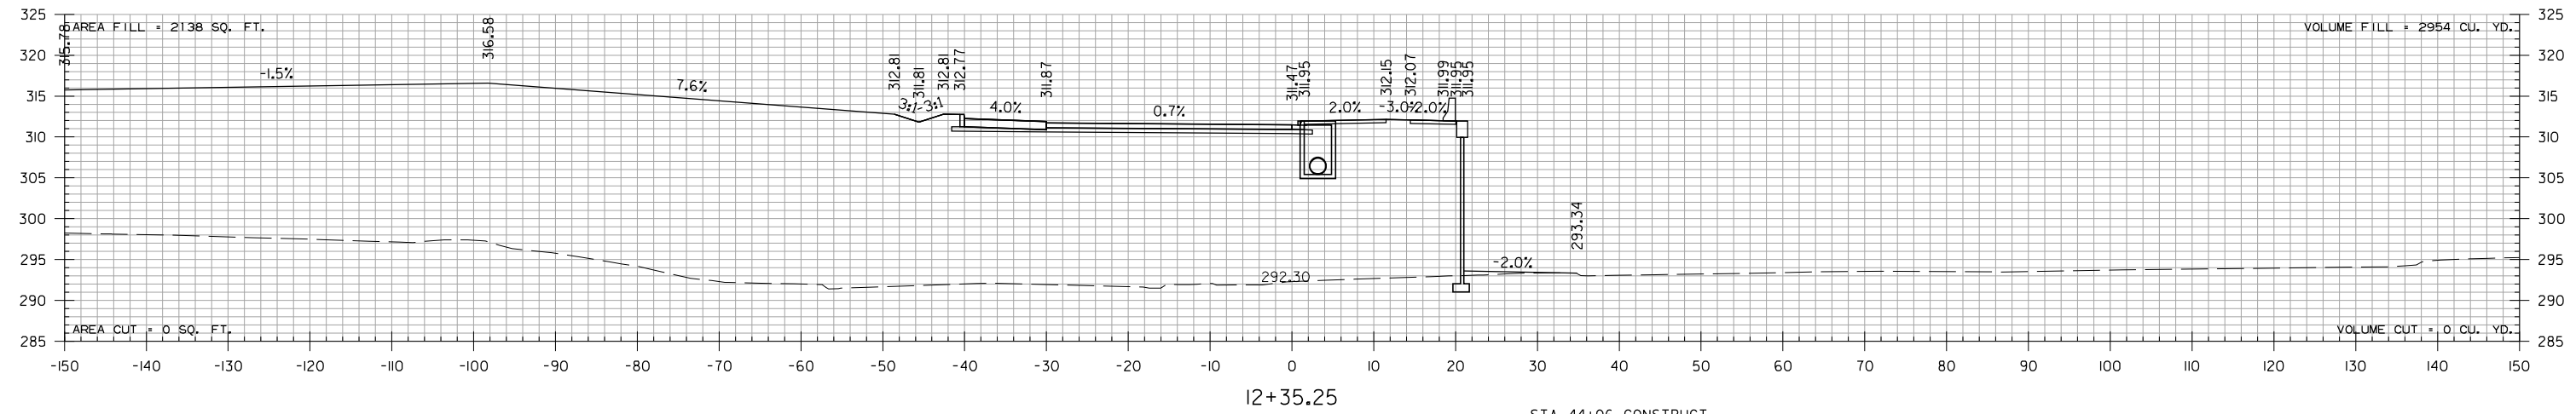

12+35.25

+06 RT.  
TOP = 311.95  
FL. IN = 305.47  
FL. OUT = 305.37

STA. 44+06 CONSTRUCT  
DROP INLET ON RT., H = 6'-7"  
W/ 24" X 8"  
R.C. PIPE CULVERT TO DROP INLET ON RT.  
TYPE MO INLET = 4'-0" DIA.  
TYPE C INLET = 4'-0" X 3'-4"

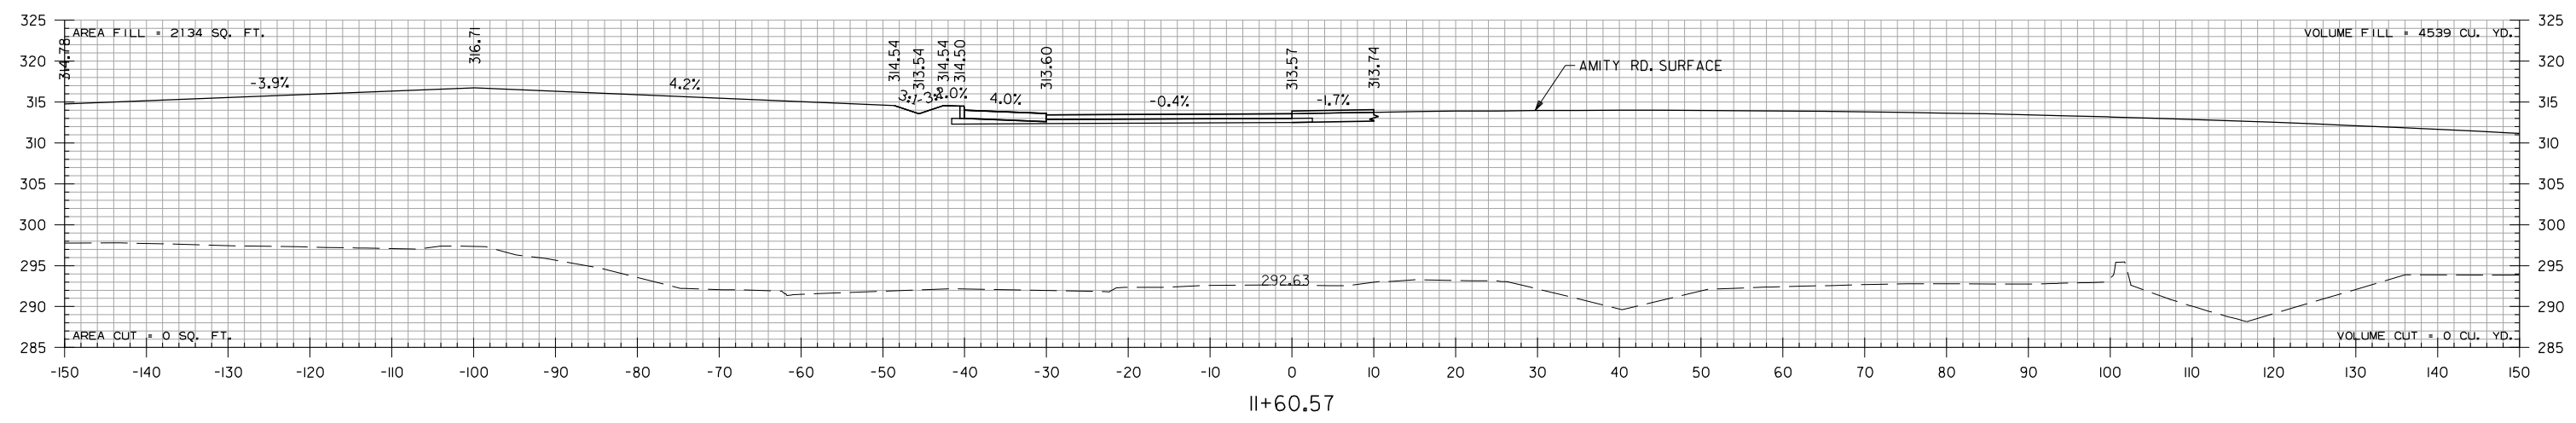


11+60.57

ROUNDABOUT  
STA. 11+61 TO STA. 12+35

5/20/2015 7:13:47 AM  
 WORKSPACE: AHTD  
 L:\2012\201590 - Contr\Rail\field Access\Drawings\6TH\_ST\6TH.CX.ALL.dgn  
 REVISED DATE:


DATE REVISED	DATE FILMED	DATE REVISED	DATE FILMED	FED. RD. DIST. NO.	STATE	FED. AID PROJ. NO.	SHEET NO.	TOTAL SHEETS
8-10-2016				6	ARK.			
				JOB NO.	080517	168	182	

2 CROSS SECTIONS

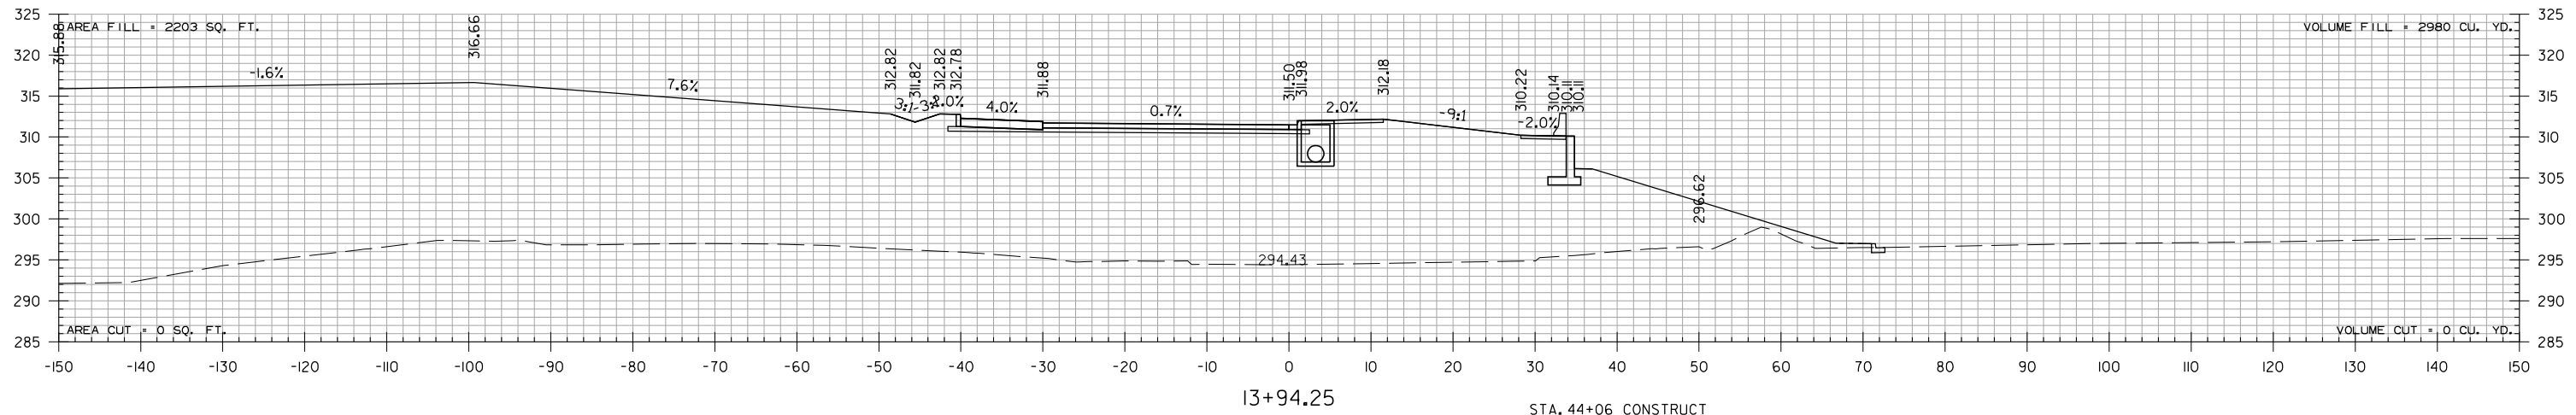

+06 LT.  
TOP = 311.98  
INV. = 306.98

STA. 44+06 CONSTRUCT  
DROP INLET ON LT., H = 5'-0"  
W/ 24" X 77"  
R.C. PIPE CULVERT TO DROP INLET ON RT.  
TYPE MO INLET = 4'-0" DIA.  
TYPE C INLET = 4'-0" X 3'-6"

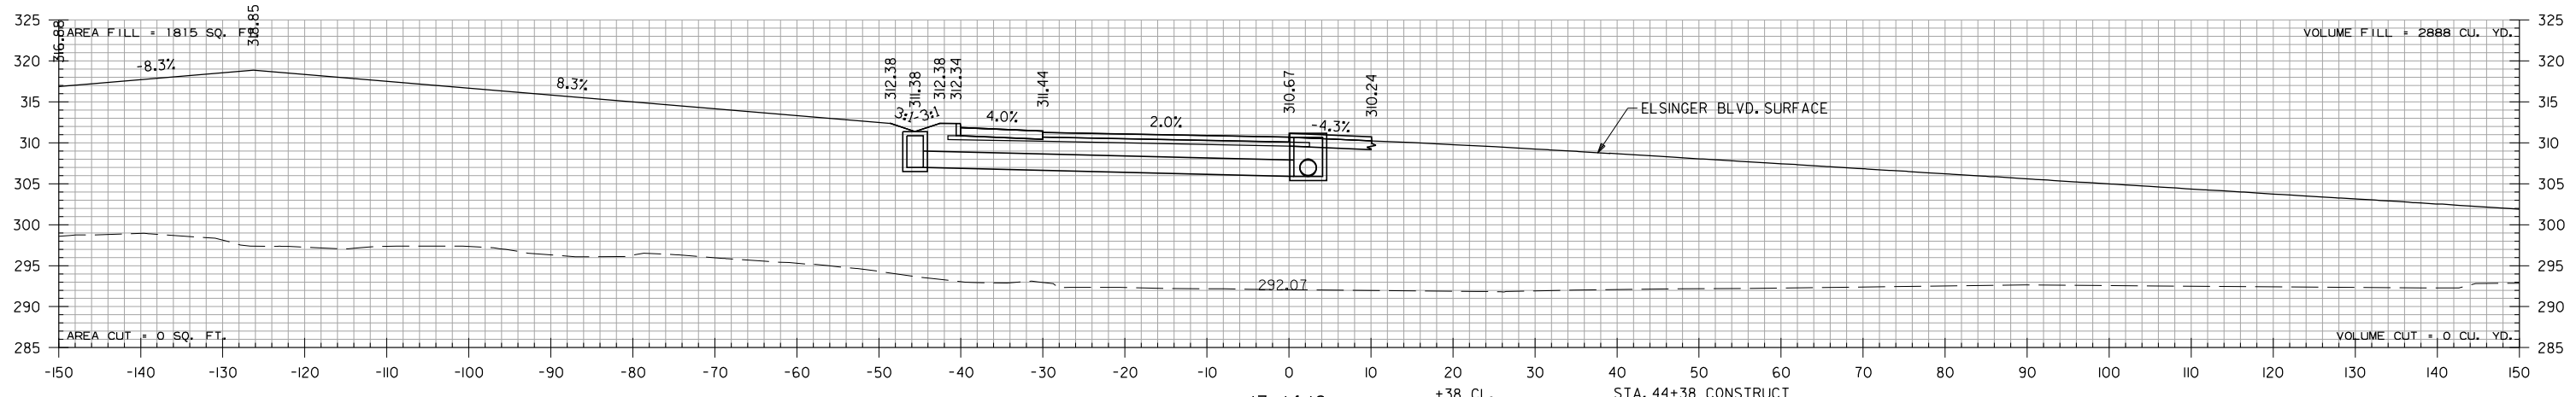

+93 +90 CL.  
TOP = 311.38  
INV. = 306.96

+38 CL.  
TOP = 311.17  
FL. IN = 306.02  
FL. IN = 305.92  
FL. OUT = 305.92

STA. 44+38 CONSTRUCT  
DROP INLET ON C.L., H = 5'-3"  
W/ 24" X 77"  
R.C. PIPE CULVERT TO DROP INLET ON RT.  
TYPE MO INLET = 4'-0" DIA.  
TYPE C INLET = 4'-0" X 3'-6"

△ STA. 43+93 43+90 CONSTRUCT  
DROP INLET ON C.L., H = 4'-5"  
W/ 24" X 45"  
R.C. PIPE CULVERT TO DROP INLET ON CL.  
TYPE E INLET = 3'-0" X 2'-0"



ROUNDABOUT  
STA. 13+14 TO STA. 13+94

USER: \$DATE\$\$TIME\$\$  
WORKSPACE: \$WORKSPACE\$\$  
FILE: \$FILE\$\$  
REVISED DATE:



DATE REVISED	DATE FILMED	DATE REVISED	DATE FILMED	FED. RD. DIST. NO.	STATE	FED. AID PROJ. NO.	SHEET NO.	TOTAL SHEETS
				6	ARK.			
				JOB NO.		080517	169	182

2 CROSS SECTIONS


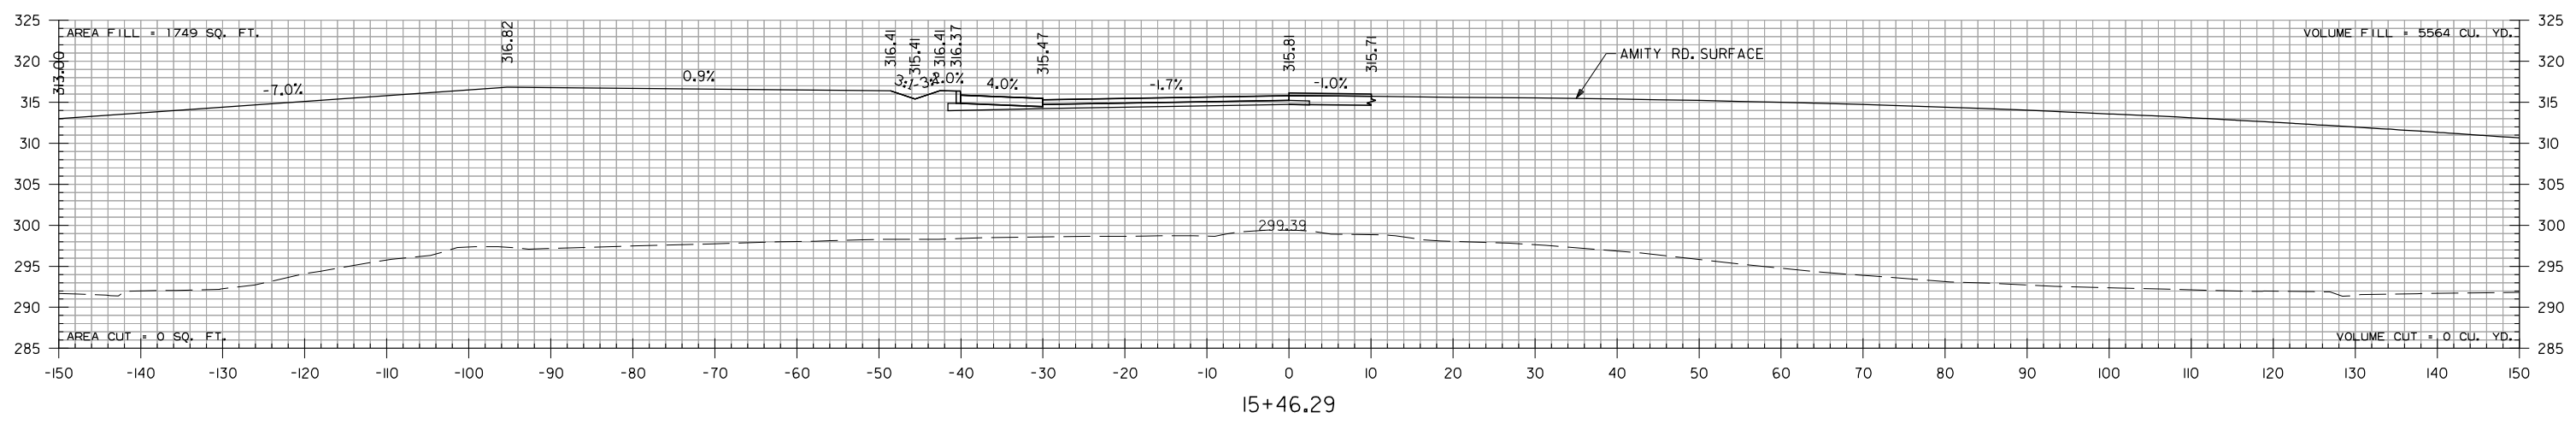
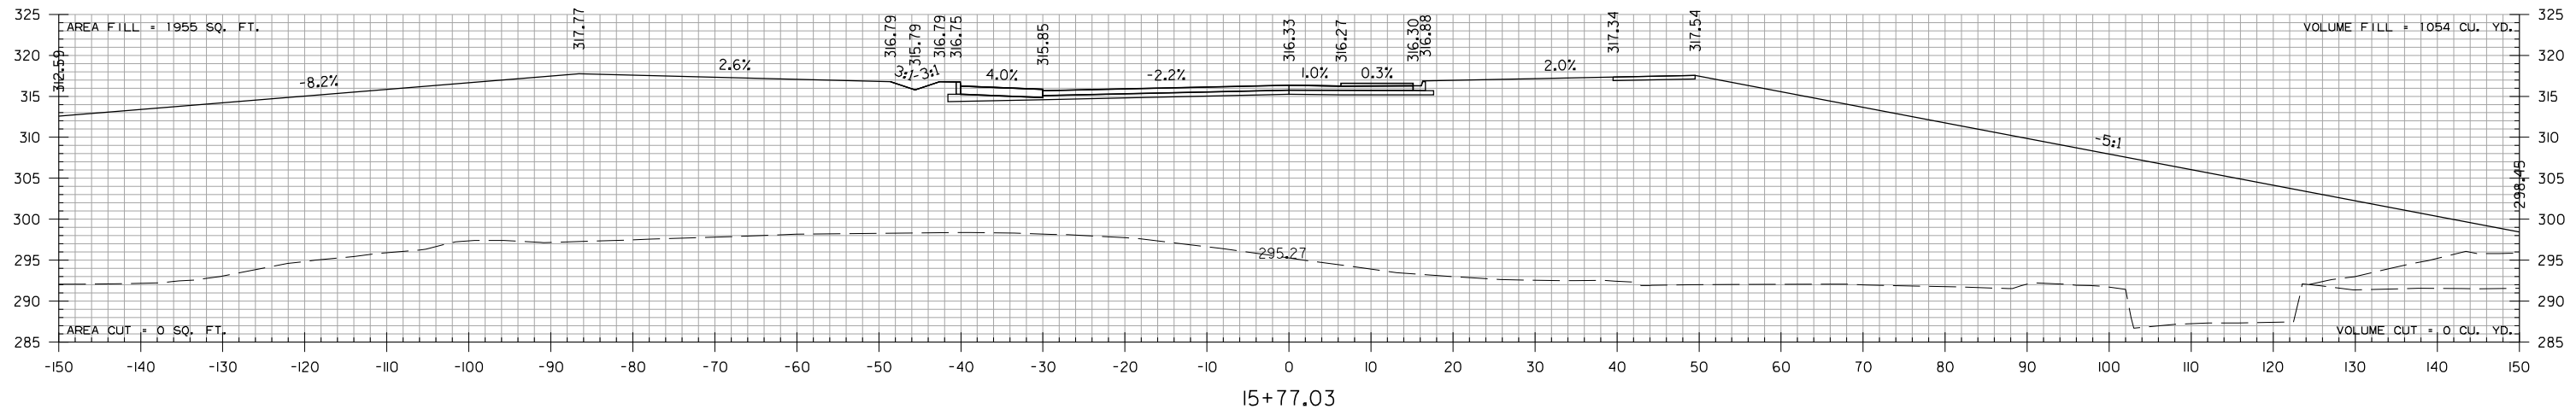


ROUNDABOUT  
STA. 15+46 TO STA. 15+77

5/20/2015 7:13:47 AM  
WORKSPACE: AHTD  
L:\2012\201590 - Centrail\field Access\Drawings\6TH.STA\6TH.CX.ALL.dgn  
REVISED DATE:

DATE REVISED	DATE FILMED	DATE REVISED	DATE FILMED	FED. RD. DIST. NO.	STATE	FED. AID PROJ. NO.	SHEET NO.	TOTAL SHEETS
2-10-2016				6	ARK.			
				JOB NO.	080517	170	182	

2 CROSS SECTIONS

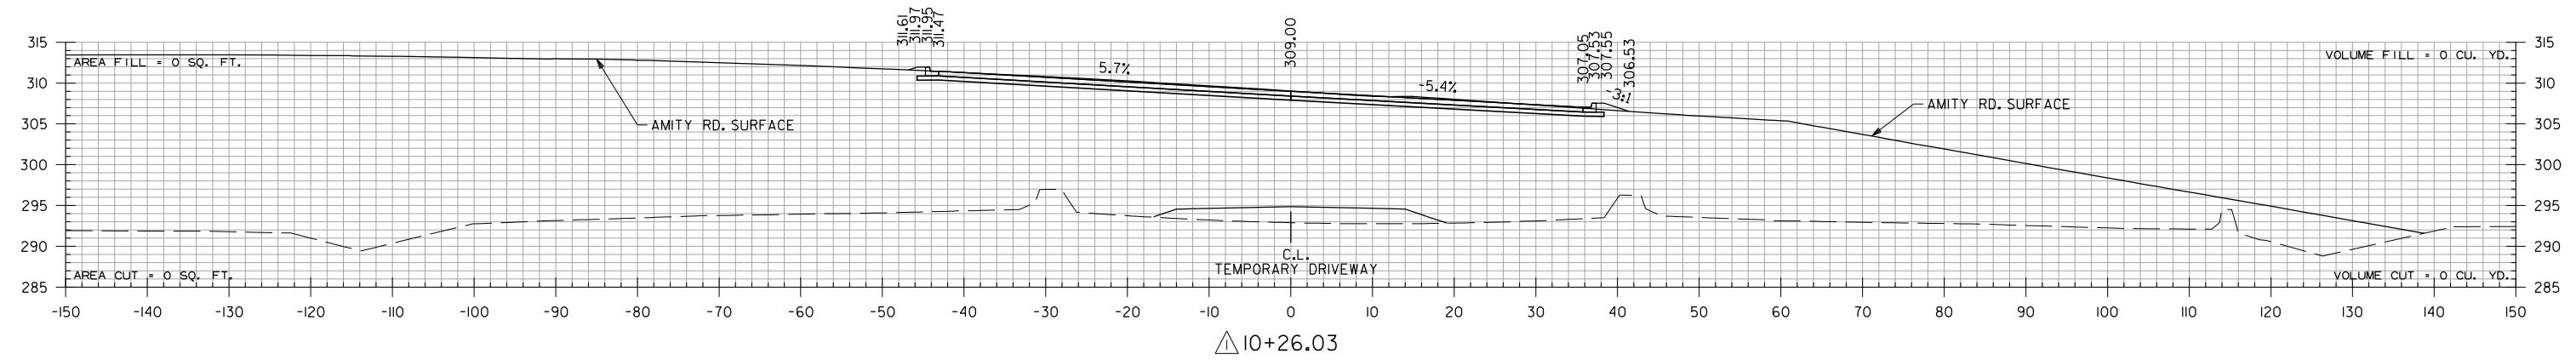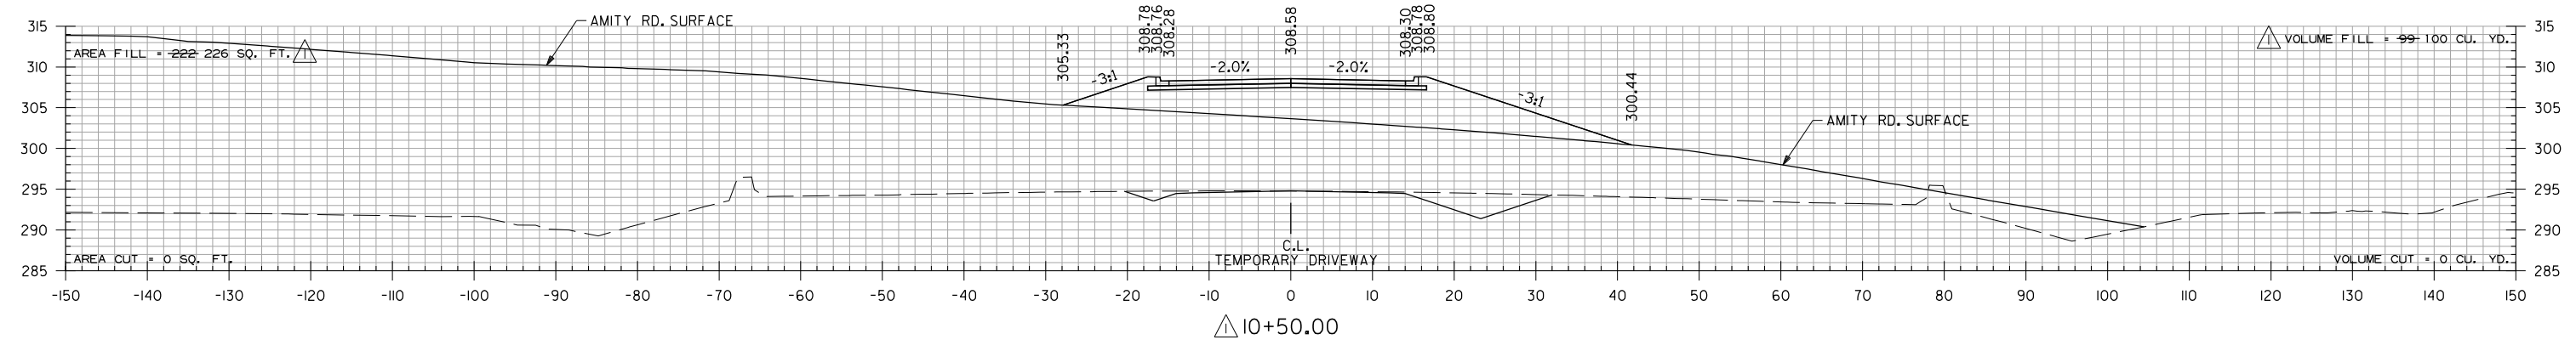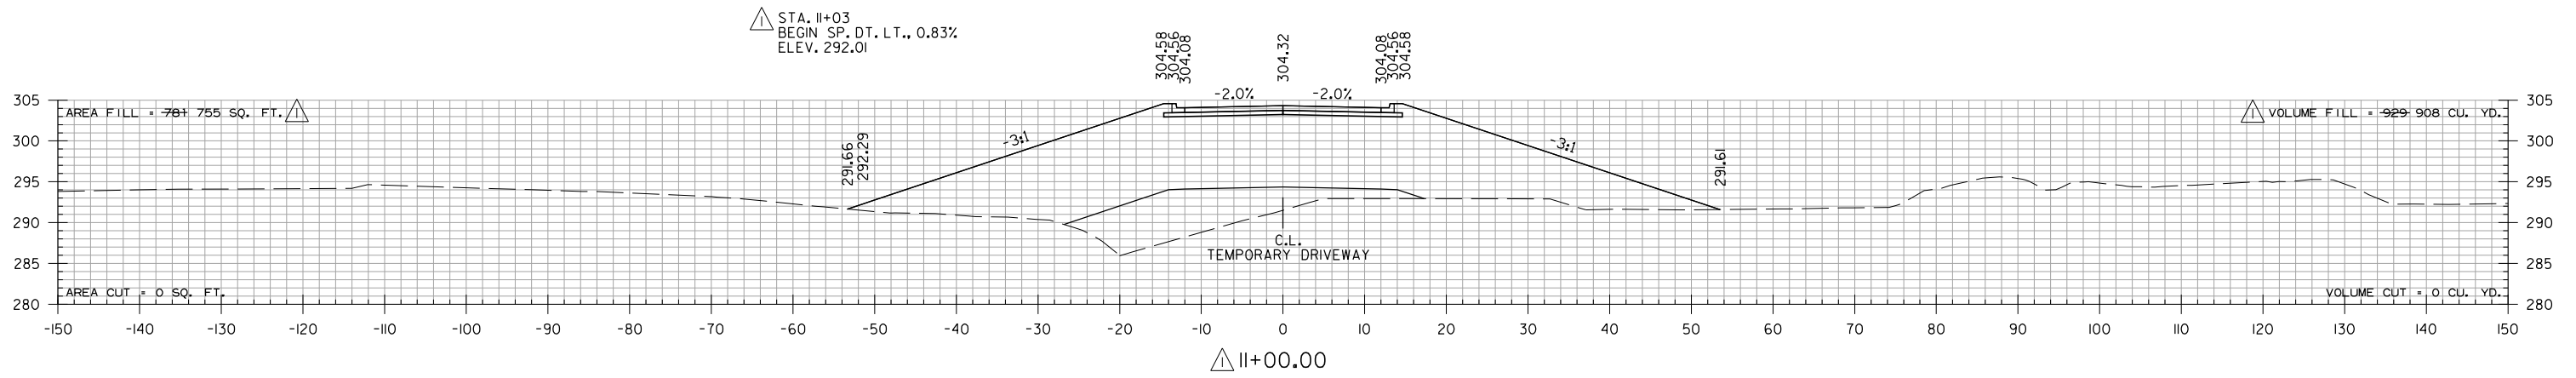


STA. IO+25.96 BEGIN DRIVEWAY I

DRIVEWAY I  
STA. IO+26 TO STA. II+00


2/10/2016 4:34:27 PM  
 WORKSPACE: AHTD  
 L:\2012\1201590 - ContrlField Access\Drawings\6TH\_ST\6TH.CX.ALL.dgn  
 REVISION DATE:

DATE REVISED	DATE FILMED	DATE REVISED	DATE FILMED	FED. RD. DIST. NO.	STATE	FED. AID PROJ. NO.	SHEET NO.	TOTAL SHEETS
2-10-2016				6	ARK.			
							JOB NO. 080517	171
							CROSS SECTIONS	


2

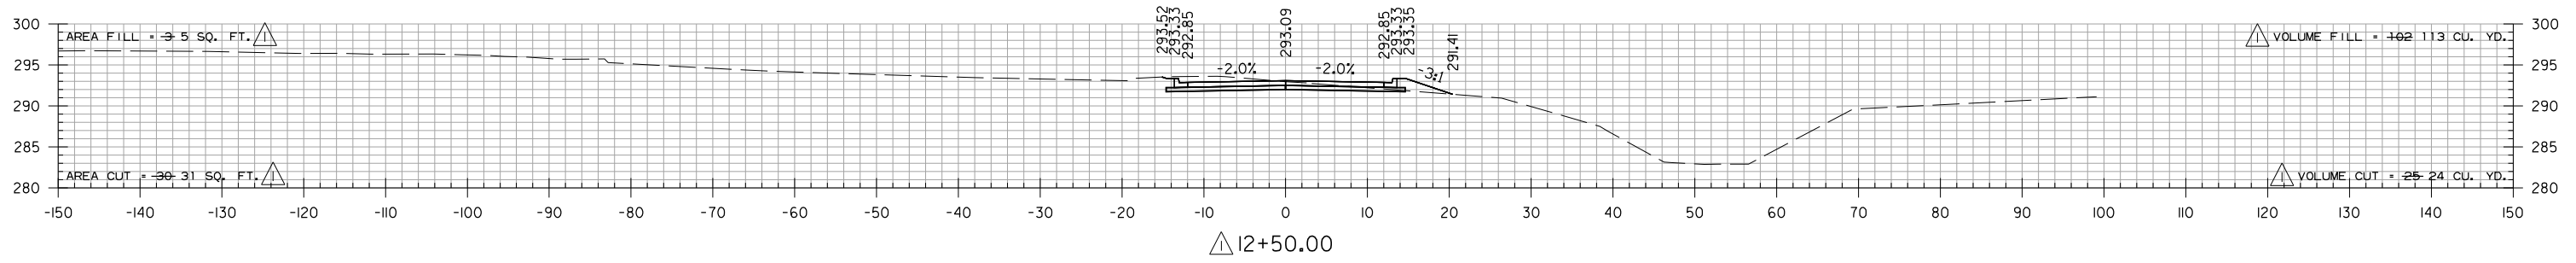


△ 12+50.00

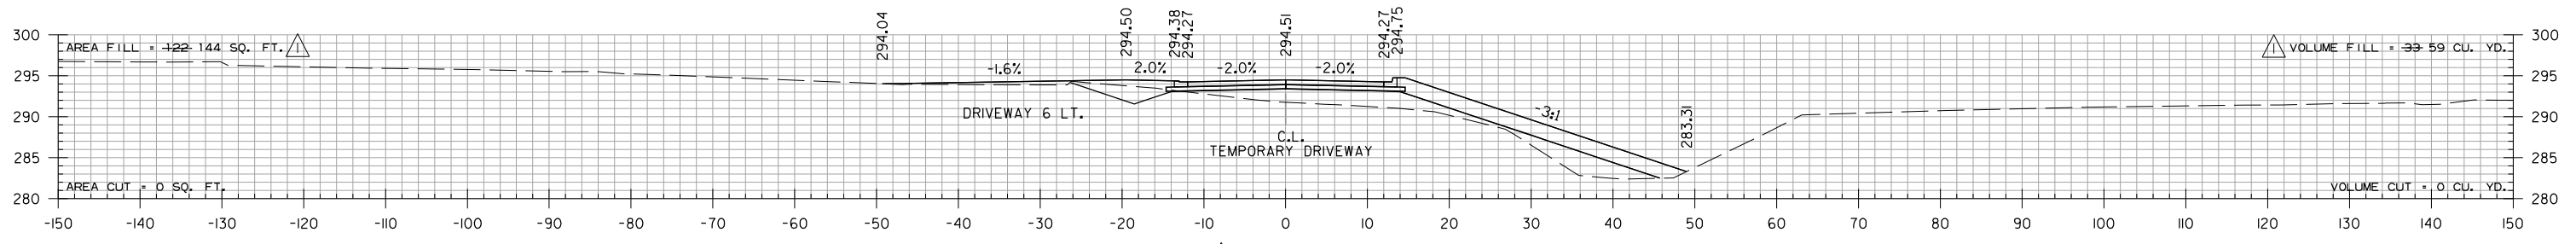

△ 12+09.00

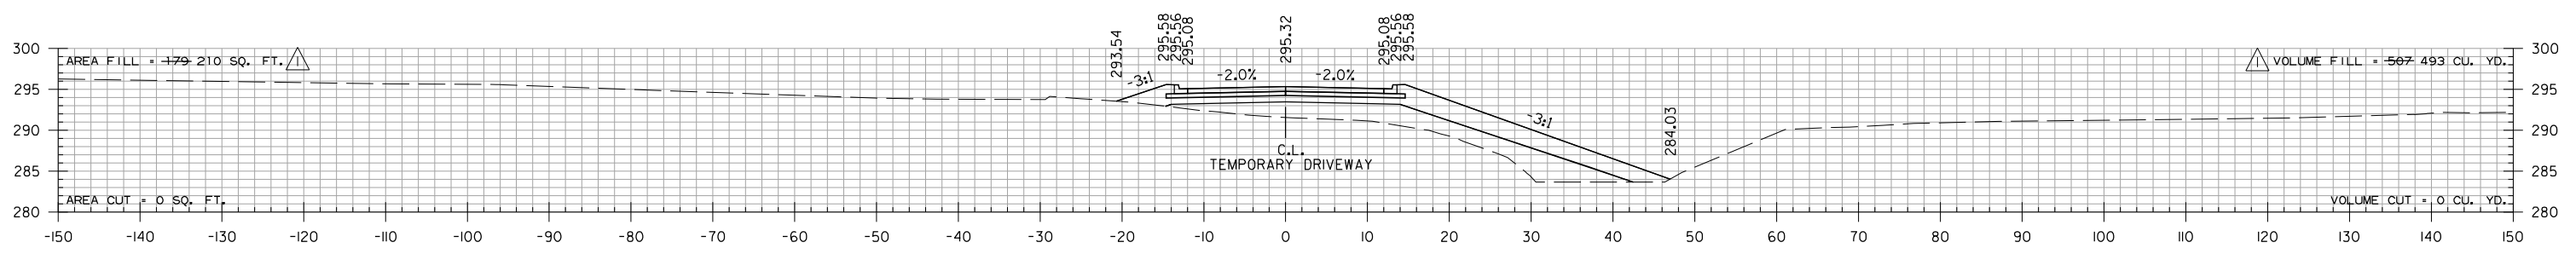

△ 12+00.00

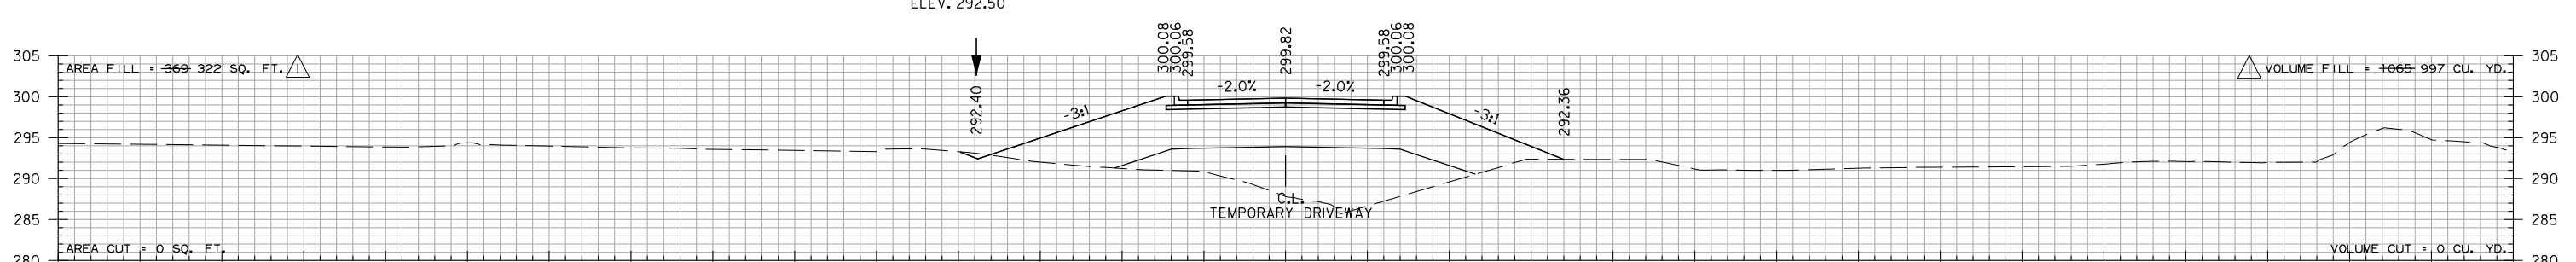

△ 11+50.00


△ STA. 11+62  
END SP. DT. LT., 0.83%  
ELEV. 292.50

DRIVEWAY I  
STA. 11+50 TO STA. 12+50


2/10/2016 4:34:27 PM  
 WORKSPACE: AHTD  
 L:\2012\1201590 - Contrl\ell\field Access\Drawings\6TH STA\6TH.CX.ALL.dgn  
 REVISED DATE:

DATE REVISED	DATE FILMED	DATE REVISED	DATE FILMED	FED. RD. DIST. NO.	STATE	FED. AID PROJ. NO.	SHEET NO.	TOTAL SHEETS
2-10-2016				6	ARK.	080517	172	182
				JOB NO.		080517	172	182
				(2) CROSS SECTIONS				


△ STA. 14+6.74 14+13.75 END DRIVEWAY I

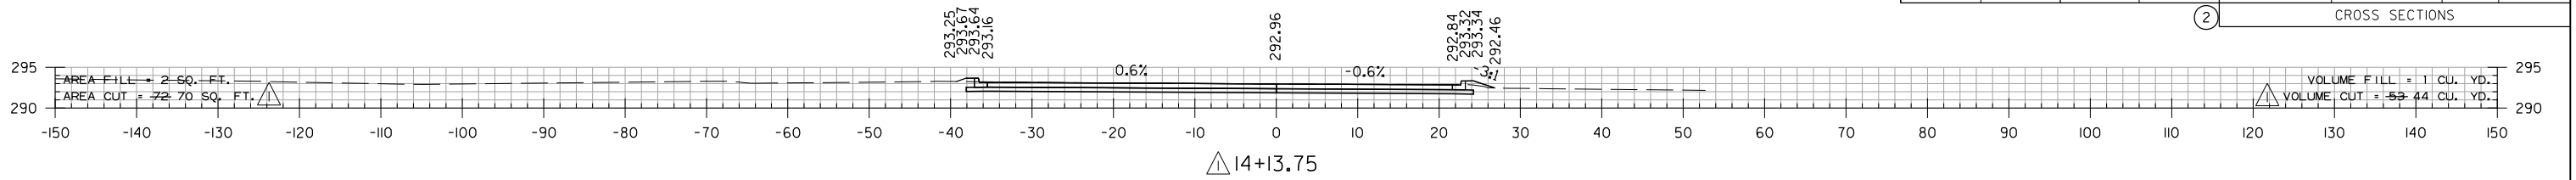


△ 14+13.75

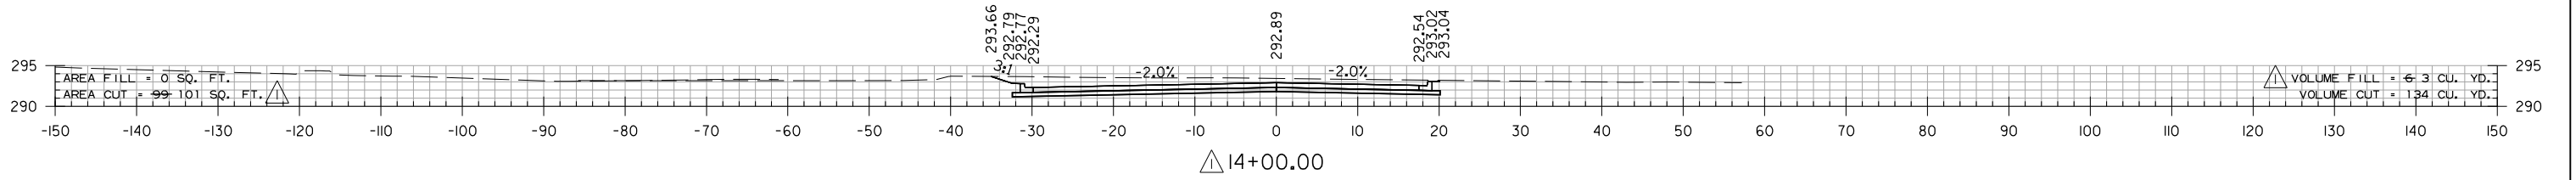

△ 14+00.00

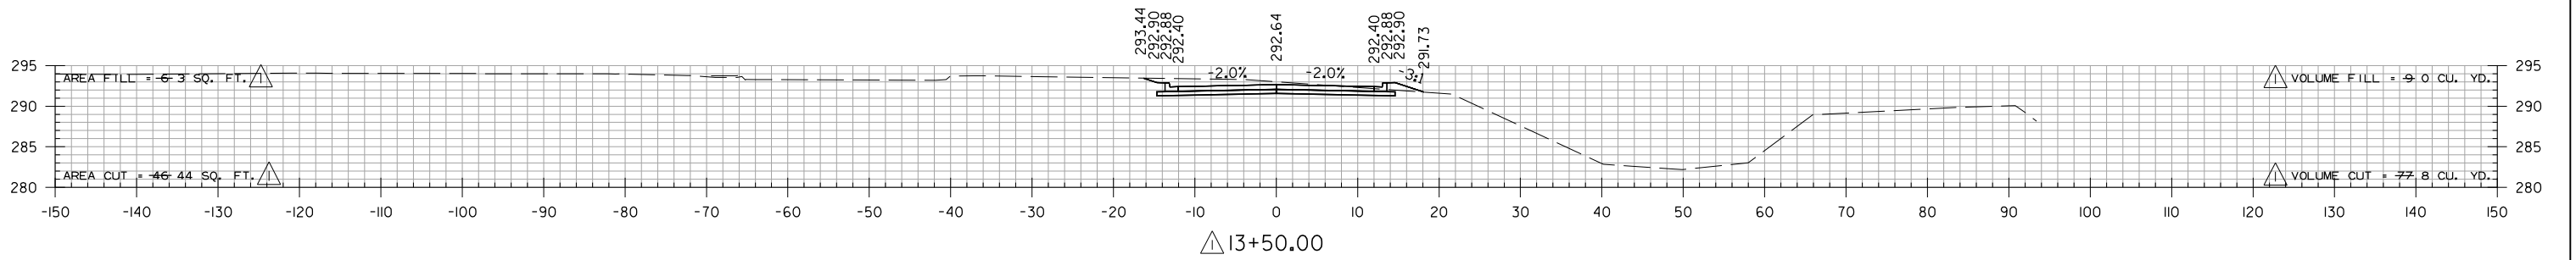

△ 13+50.00

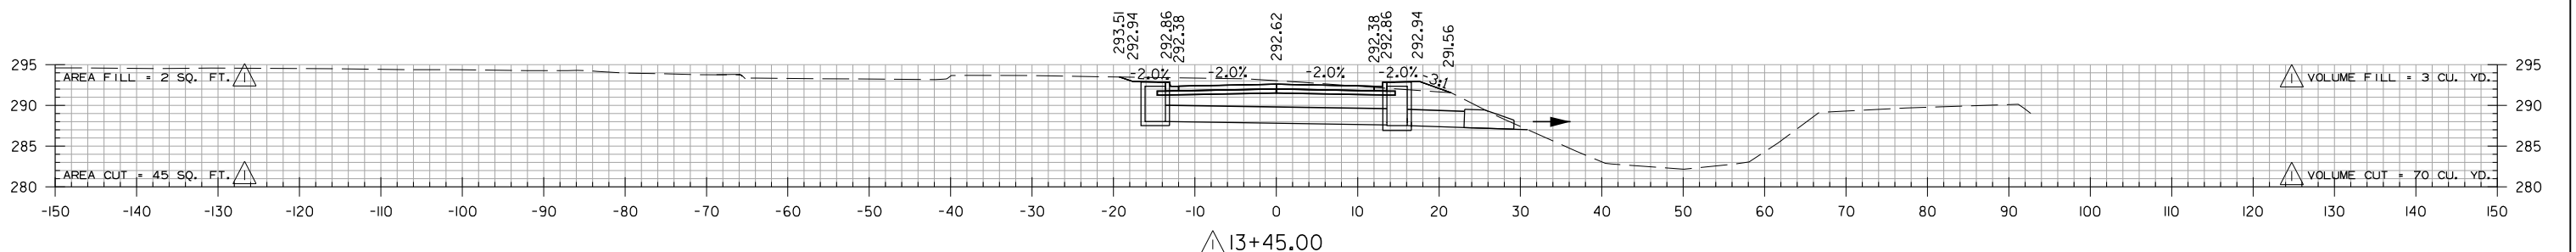

△ 13+45.00


△ STA. 13+50 13+45 CONSTRUCT DROP INLET ON LT, H = 4'-11" W/ DBL. 4' EXT. AND 24" X 27' R.C. PIPE CULVERT TO DROP INLET ON RT. TYPE MO INLET = 4'-0" DIA. TYPE C INLET = 4'-0" X 2'-6"

△ +50 +45 LT. TOP = 292.93 292.86 INV. = 288.01 288.02

△ +50 +45 RT. TOP = 292.93 292.86 FL. IN = 287.53 287.62 FL. OUT = 287.43 287.52

△ +50 +45 FES RT. FL. OUT = 287.00 287.02

△ STA. 13+50 13+45 CONSTRUCT DROP INLET ON RT, H = 5'-6" 5'-4" W/ DBL. 4' EXT. AND 24" X 7' R.C. PIPE CULVERT TO FES ON RT. TYPE MO INLET = 4'-0" DIA. TYPE C INLET = 4'-0" X 2'-6"

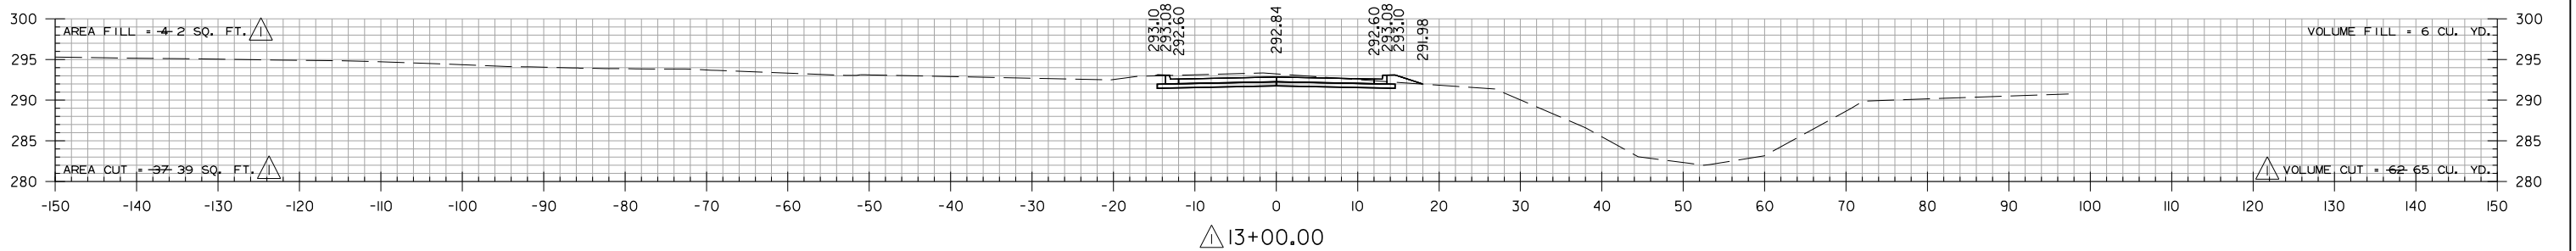





△ 13+00.00

DRIVEWAY I  
STA. 13+00 TO STA. 14+14

rccorbyn  
 WORKSPACE: AHTD  
 L:\2012\1201550 - Contr-ell\field Access\Drawings\6TH\_STA\6TH.CX.ALL.dgn  
 2/10/2016 4:34:27 PM  
 REVISED DATE:

DATE REVISED	DATE FILMED	DATE REVISED	DATE FILMED	FED. RD. DIST. NO.	STATE	FED. AID PROJ. NO.	SHEET NO.	TOTAL SHEETS
2-10-2016				6	ARK.			
				JOB NO.	080517	173	182	

2 CROSS SECTIONS

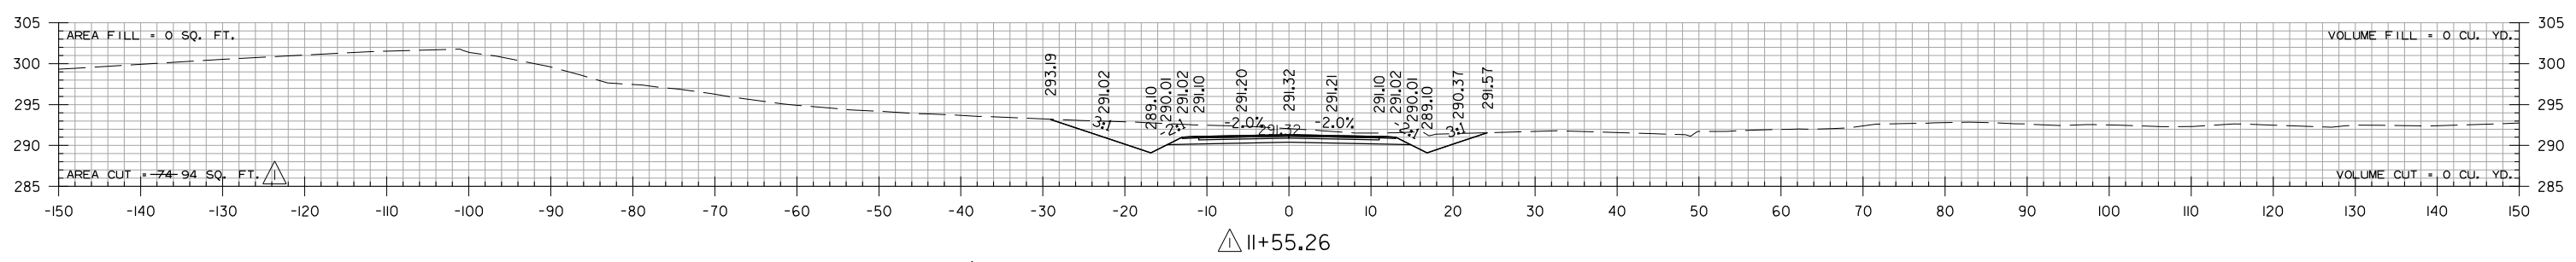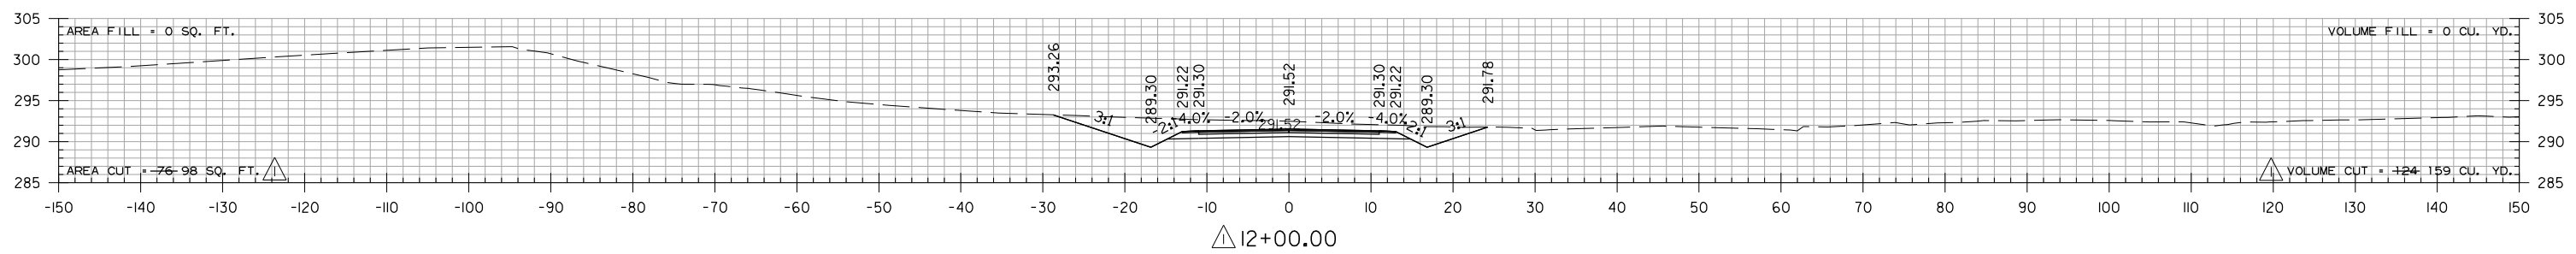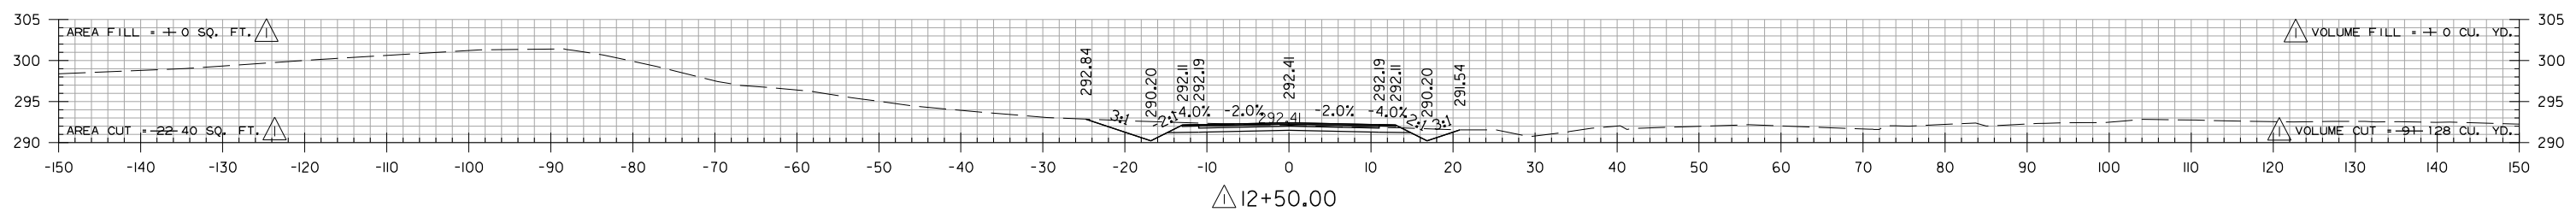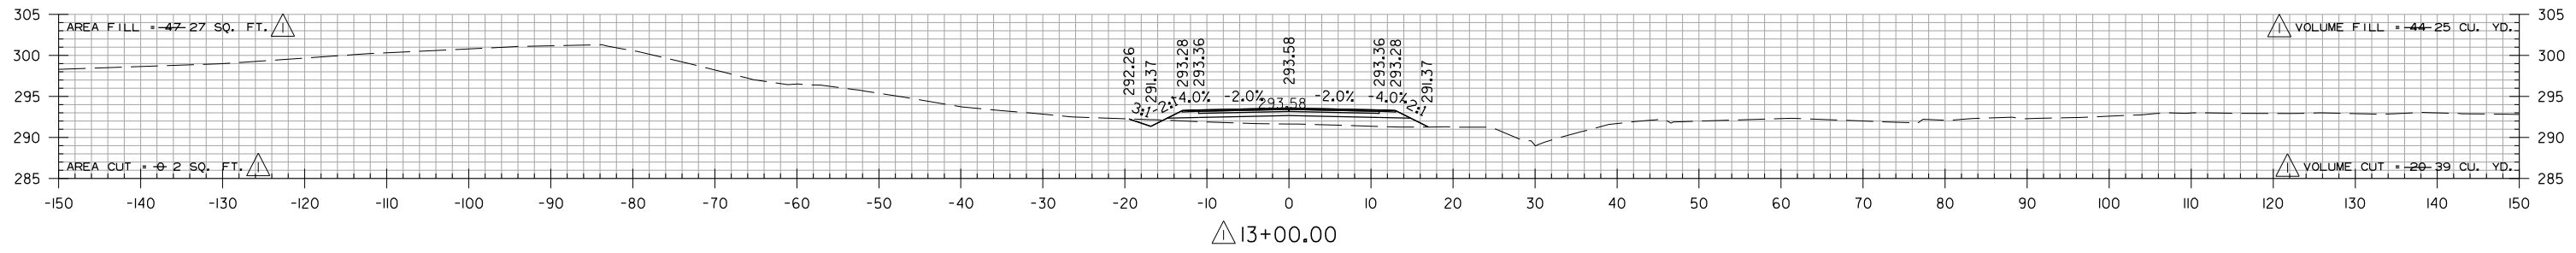





△ STA. 11+55.26 - 11+20.96 BEGIN AMITY RD. DETOUR

AMITY RD. DETOUR  
△ STA. 11+55 - 11+21 TO STA. 13+00

2/10/2016 4:34:28 PM  
 WORKSPACE: AHTD  
 L:\2012\1201590 - Conrail\field Access\Drawings\6TH.STA\6TH.CX.ALL.dgn  
 REVISION DATE:

DATE REVISED	DATE FILMED	DATE REVISED	DATE FILMED	FED. RD. DIST. NO.	STATE	FED. AID PROJ. NO.	SHEET NO.	TOTAL SHEETS
2-10-2016				6	ARK.			
				JOB NO.		080517	174	182

2 CROSS SECTIONS

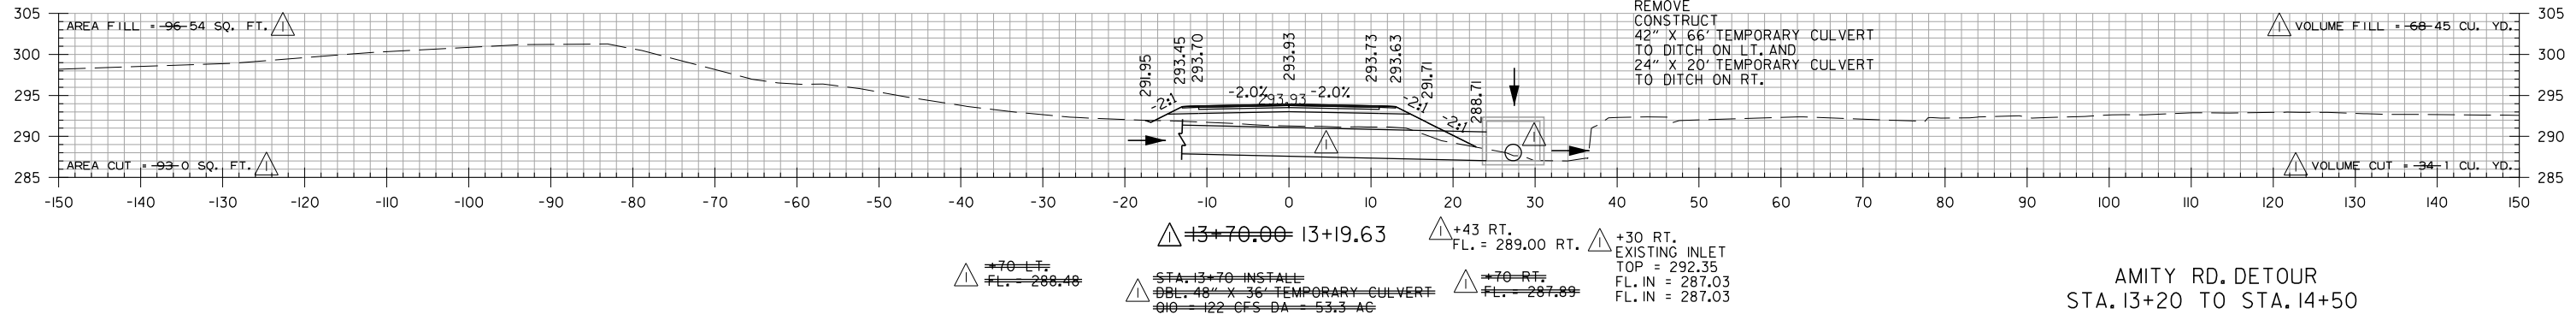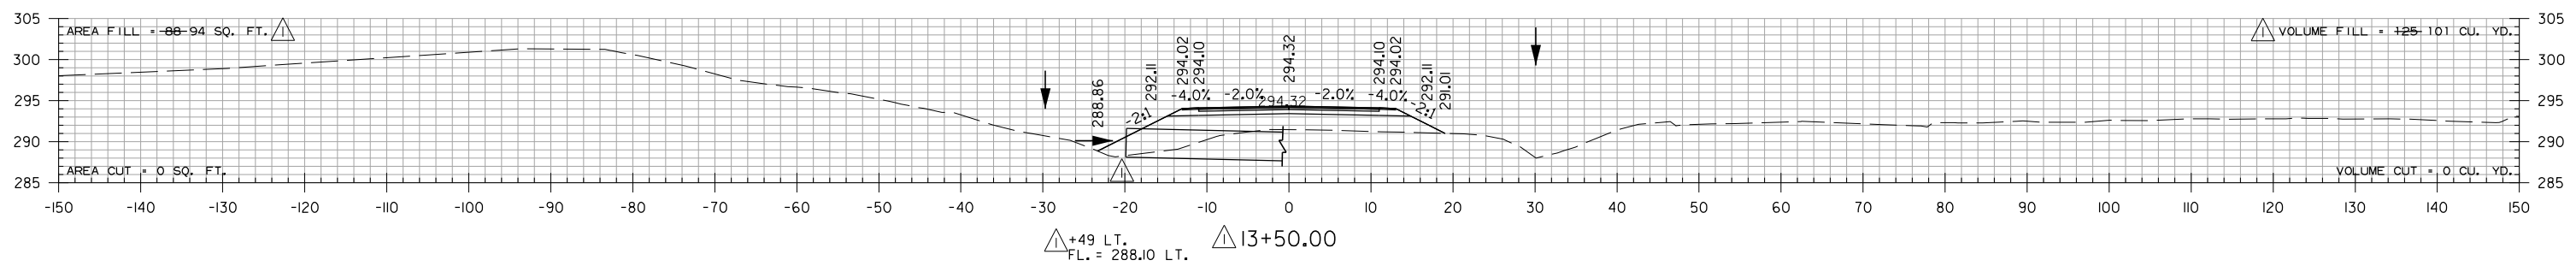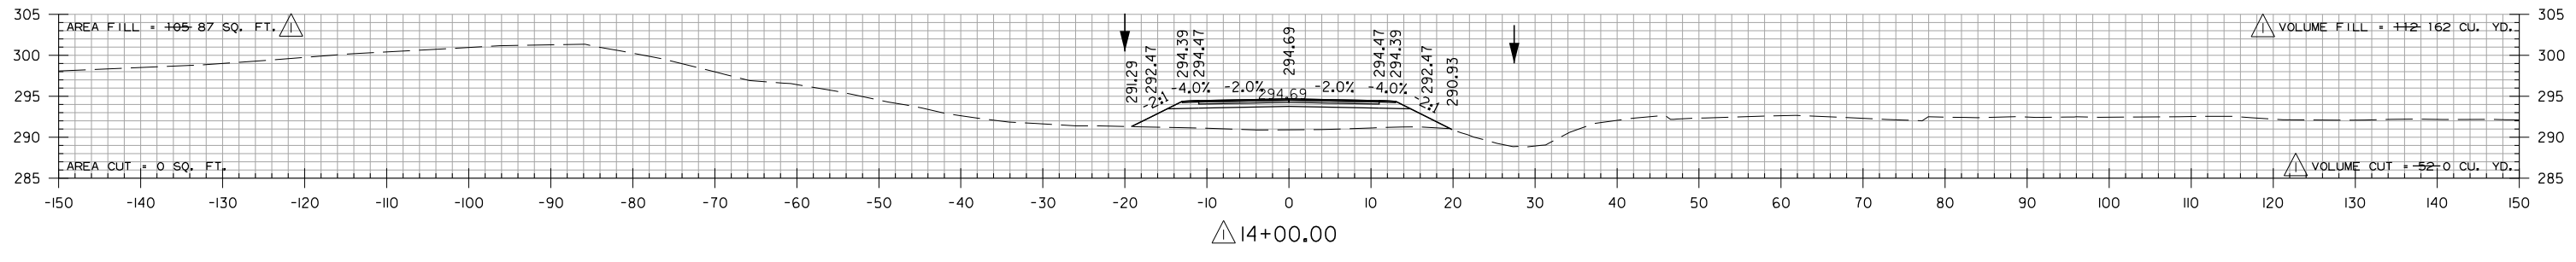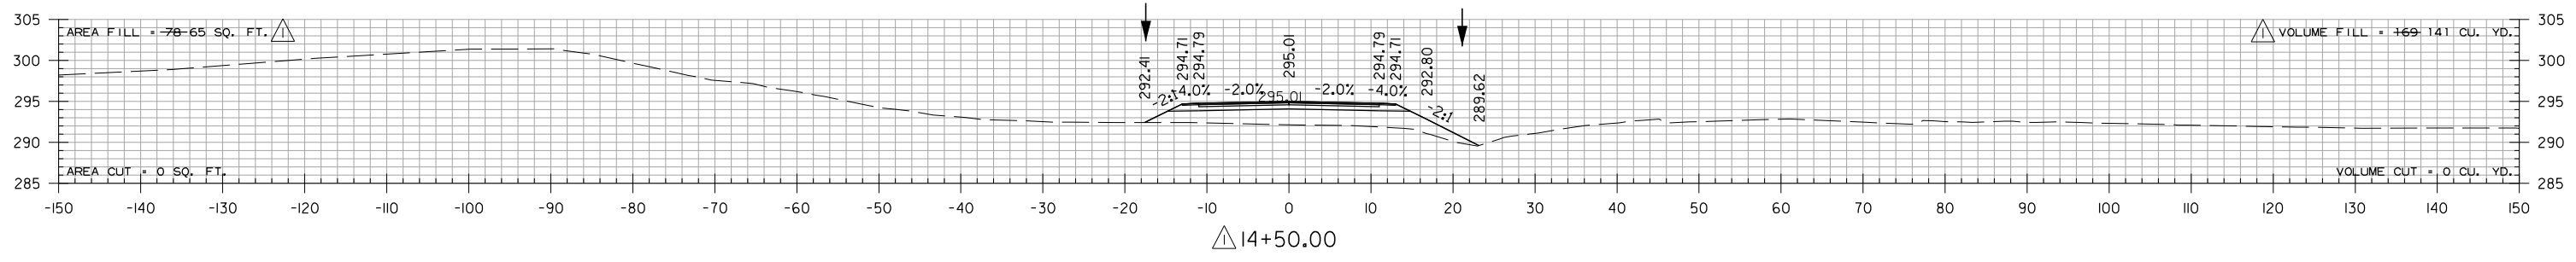

AMITY RD. DETOUR  
 STA. I3+20 IN PLACE  
 DROP INLET ON RT.  
 RETAIN WITH 48" X 3' PIPE TO FES  
 REMOVE CONSTRUCT  
 42" X 66" TEMPORARY CULVERT  
 TO DITCH ON LT. AND  
 24" X 20" TEMPORARY CULVERT  
 TO DITCH ON RT.





~~70 LT. FL. = 288.48~~  
~~70 RT. FL. = 287.89~~  
 +43 RT. FL. = 289.00 RT.  
 +30 RT. EXISTING INLET TOP = 292.35 FL. IN = 287.03 FL. IN = 287.03  
 STA. I3+70 INSTALL DBL. 48" X 36" TEMPORARY CULVERT TO DITCH ON LT. AND 24" X 20" TEMPORARY CULVERT TO DITCH ON RT. Q10 I22 GFS DA = 53.3 AG

AMITY RD. DETOUR  
 STA. I3+20 TO STA. I4+50

2/10/2016 4:34:28 PM  
 WORKSPACE: AHTD  
 L:\2012\1201590 - Contrail\field Access\Drawings\6TH.STA\6TH.CX.ALL.dgn  
 REVISED DATE:

DATE REVISED	DATE FILMED	DATE REVISED	DATE FILMED	FED. RD. DIST. NO.	STATE	FED. AID PROJ. NO.	SHEET NO.	TOTAL SHEETS
2-10-2016				6	ARK.			
				JOB NO.	080517	175	182	

2 CROSS SECTIONS

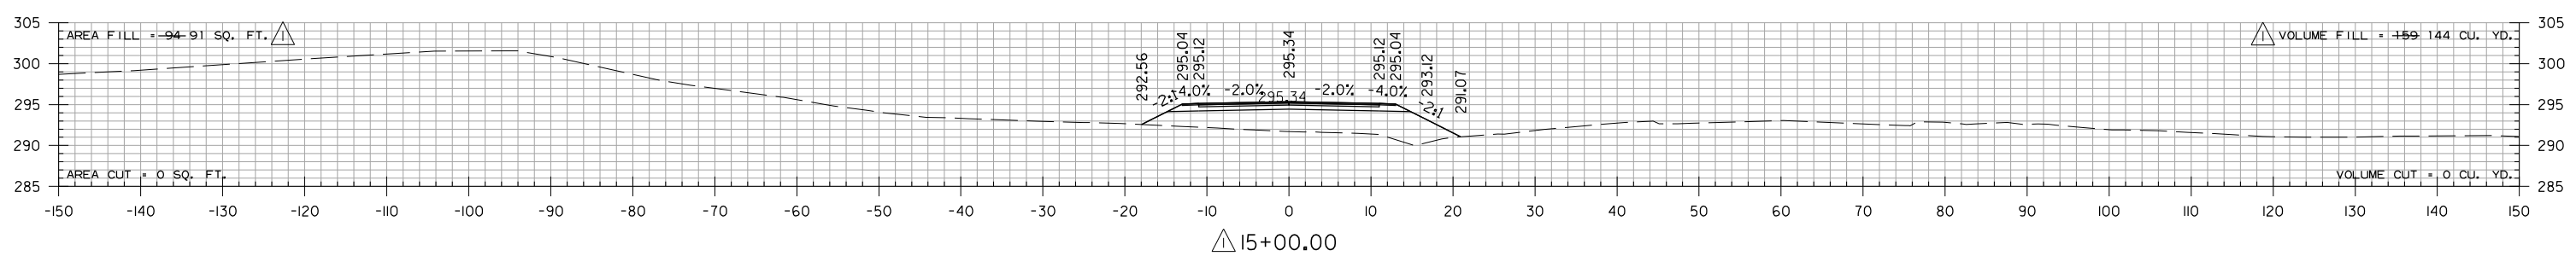
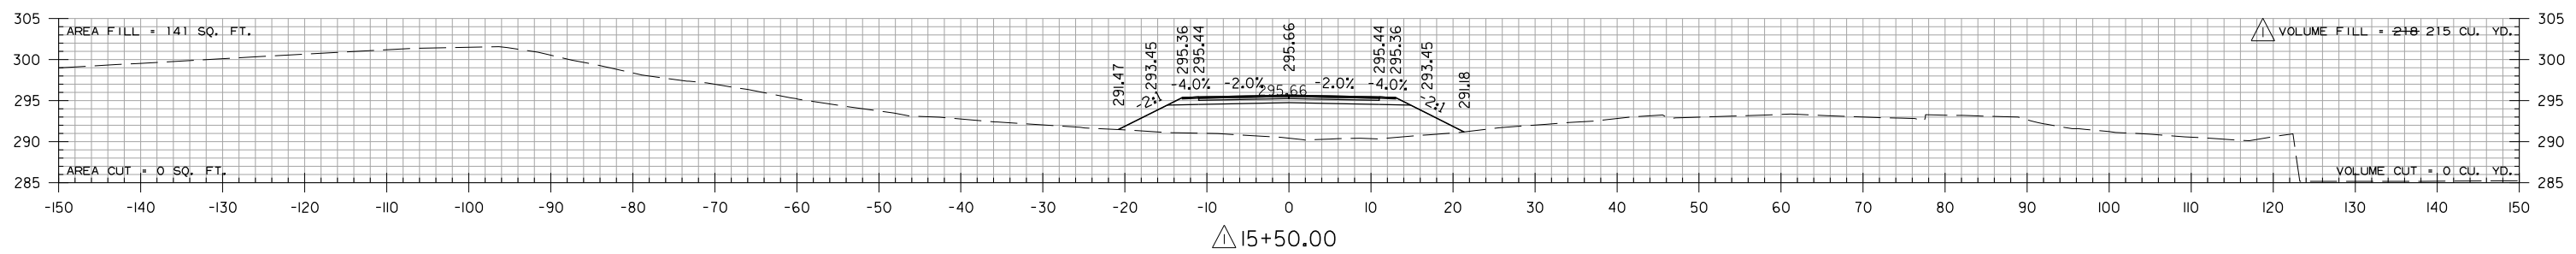
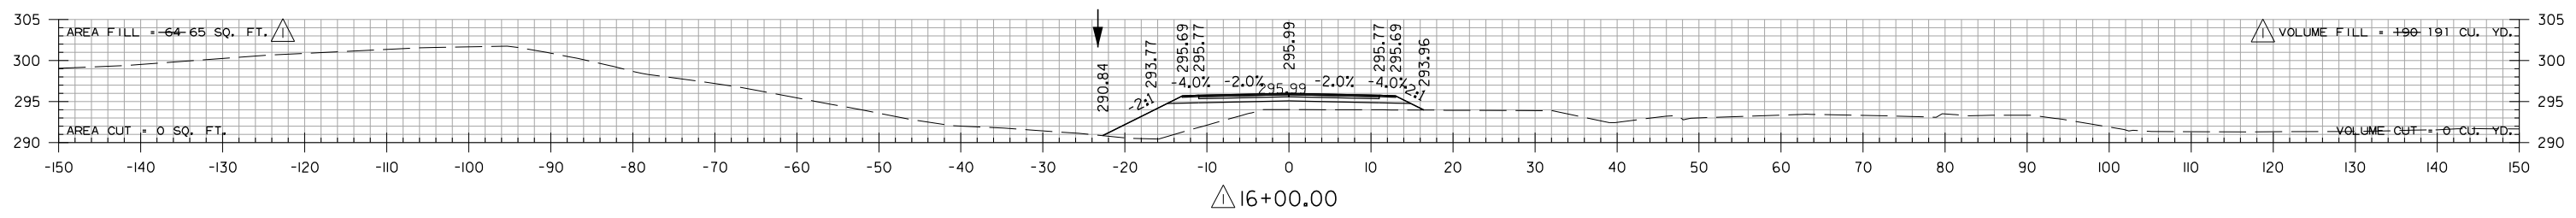
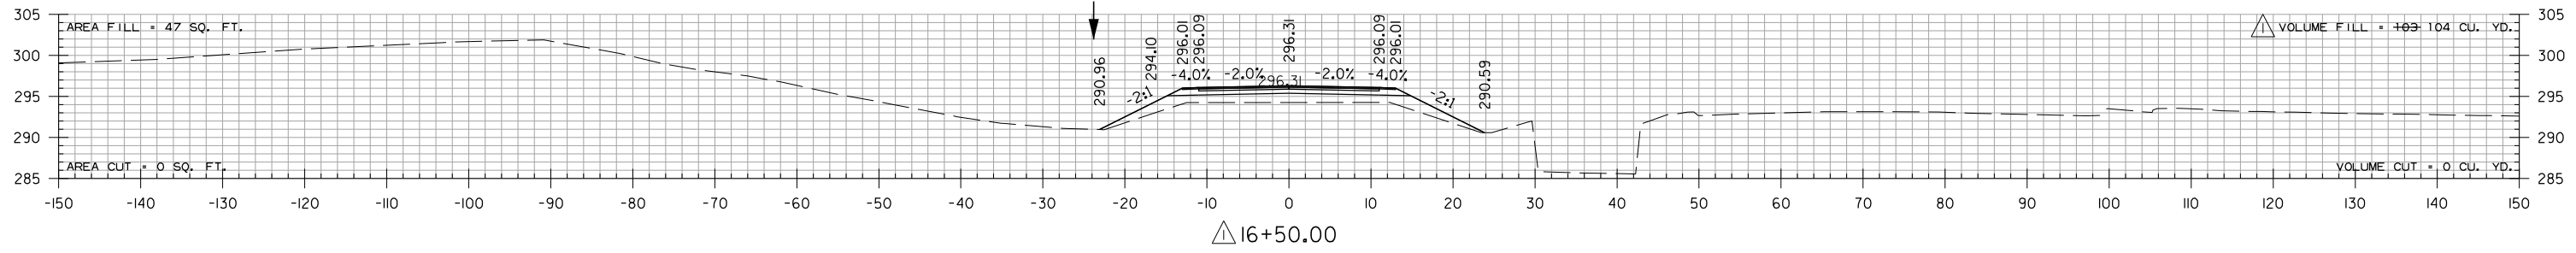


AMITY RD. DETOUR  
STA. 15+00 TO STA. 16+50

2/10/2016 4:34:28 PM  
 WORKSPACE: AHTD  
 L:\2012\1201590 - ContrailField Access\Drawings\6TH\_ST\6TH.CX.ALL.dgn  
 REVISED DATE:

DATE REVISED	DATE FILMED	DATE REVISED	DATE FILMED	FED. RD. DIST. NO.	STATE	FED. AID PROJ. NO.	SHEET NO.	TOTAL SHEETS
				6	ARK.			
				JOB NO.	080517	176	182	

2 CROSS SECTIONS

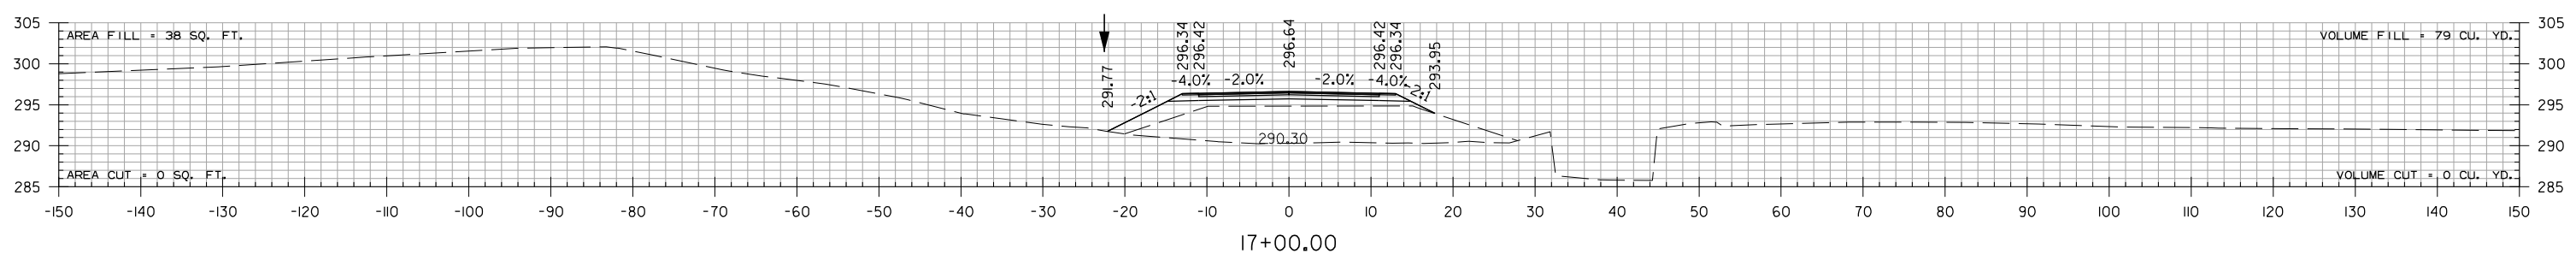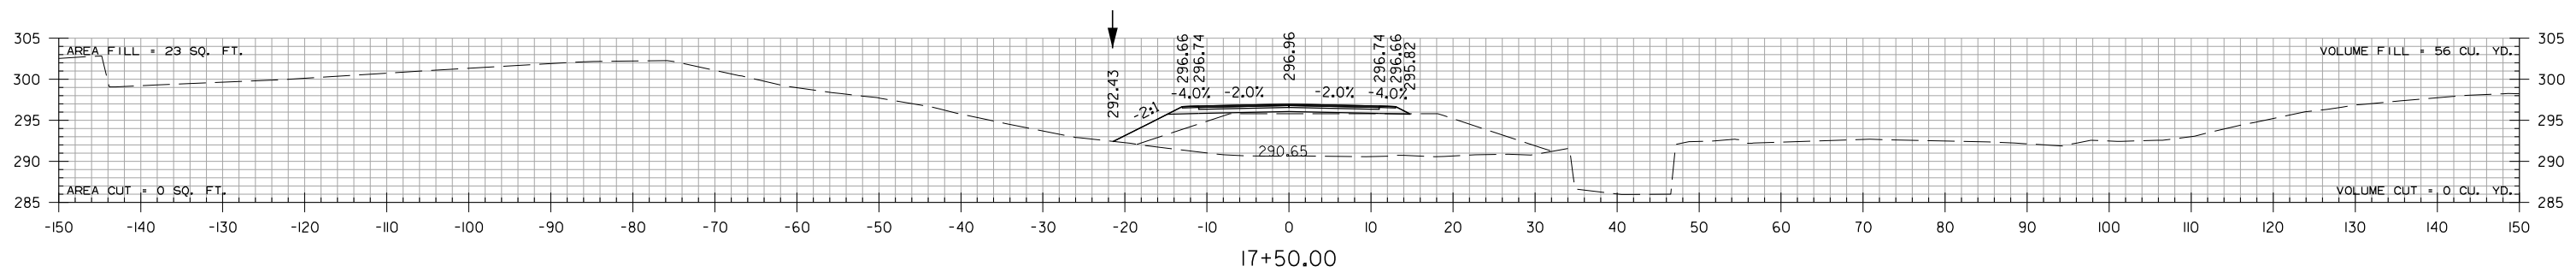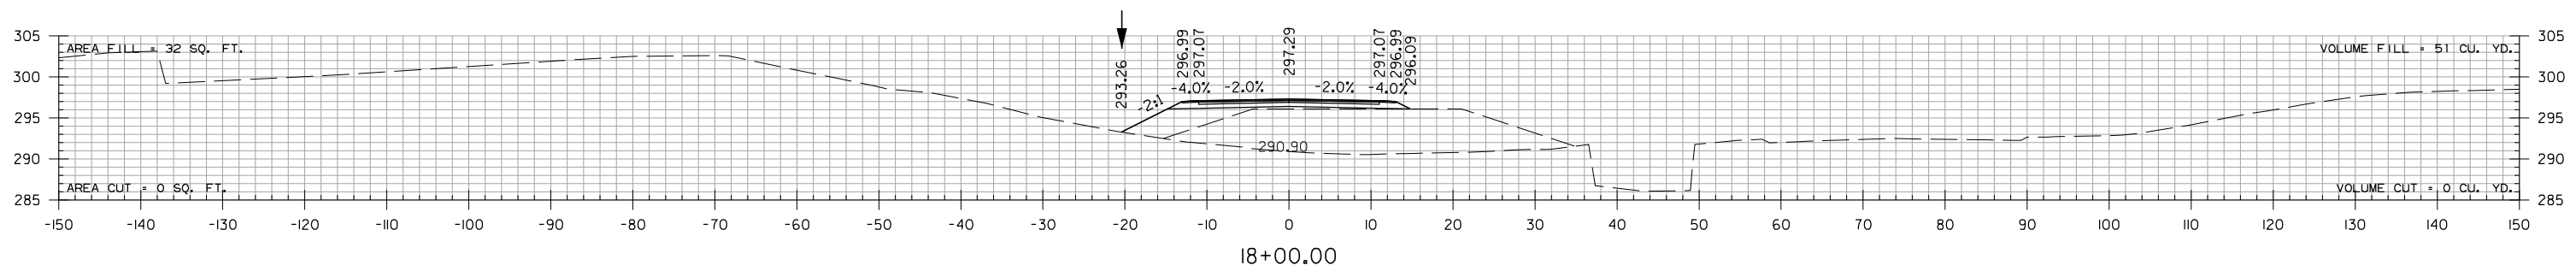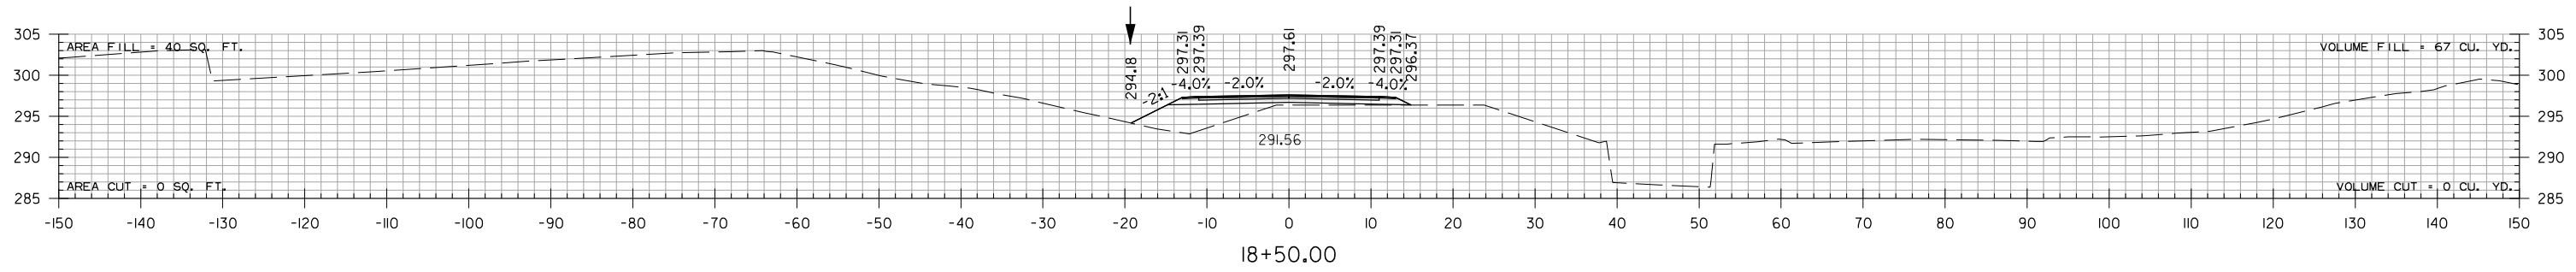





AMITY RD. DETOUR  
STA. 17+00 TO STA. 18+50

5/20/2015 7:13:49 AM  
 WORKSPACE: AHTD  
 L:\2012\1201590 - Contrail\field Access\Drawings\6TH\_ST\6TH.CX.ALL.dgn  
 REVISED DATE:



DATE REVISED	DATE FILMED	DATE REVISED	DATE FILMED	FED. RD. DIST. NO.	STATE	FED. AID PROJ. NO.	SHEET NO.	TOTAL SHEETS
				6	ARK.			
				JOB NO.	080517	177	182	

2 CROSS SECTIONS

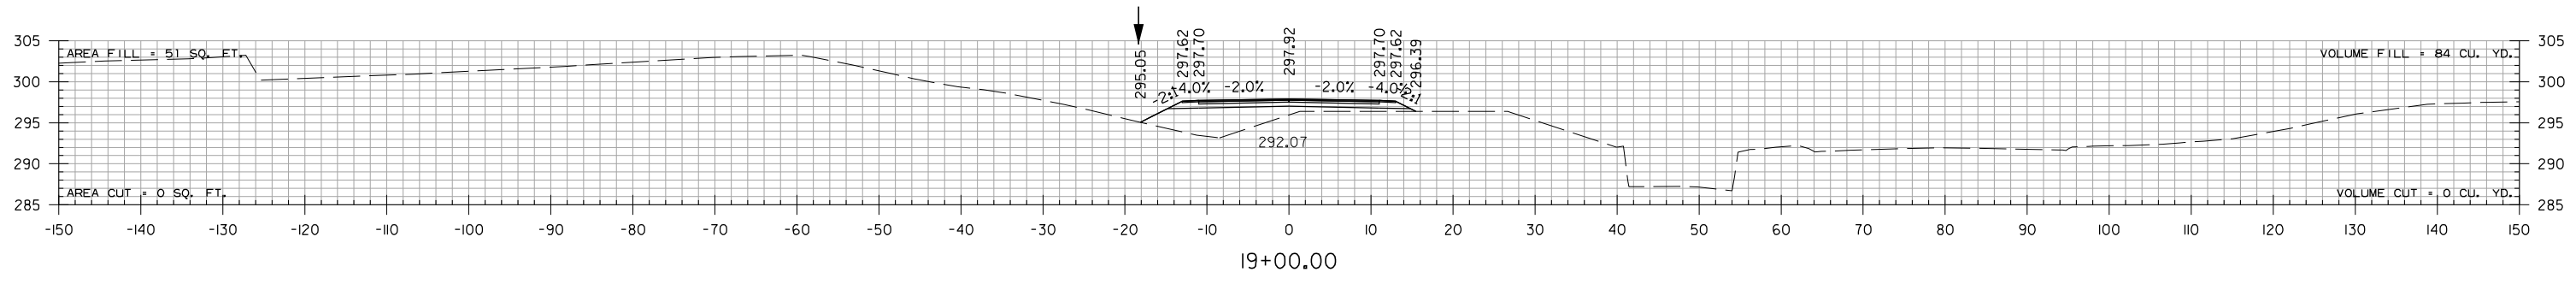
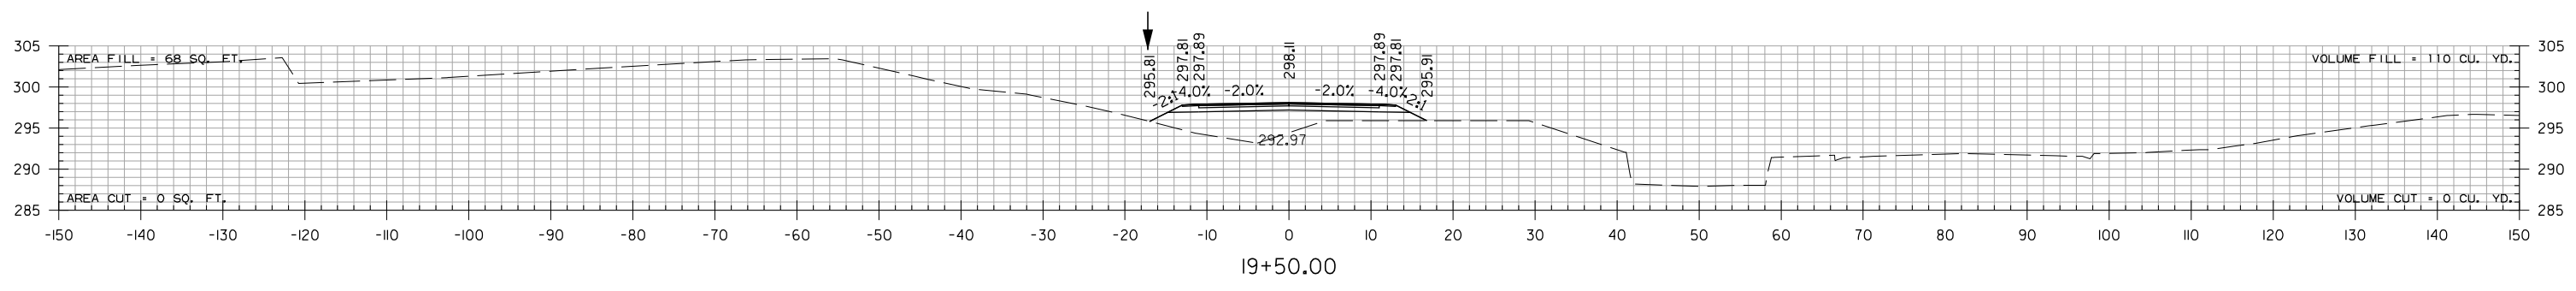
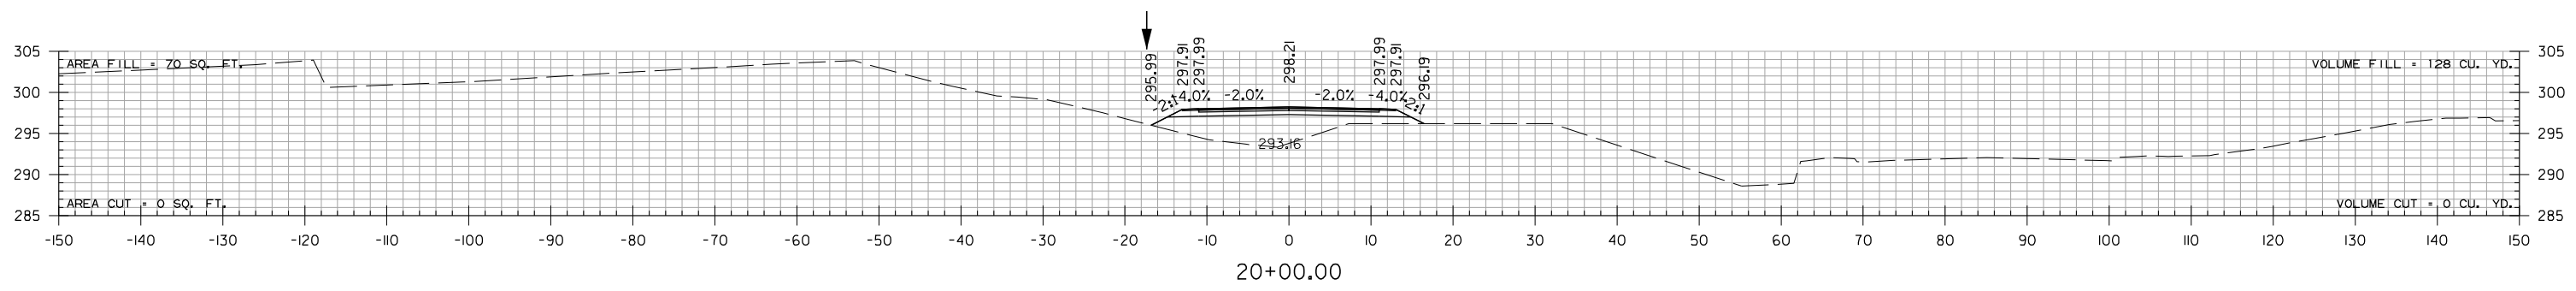
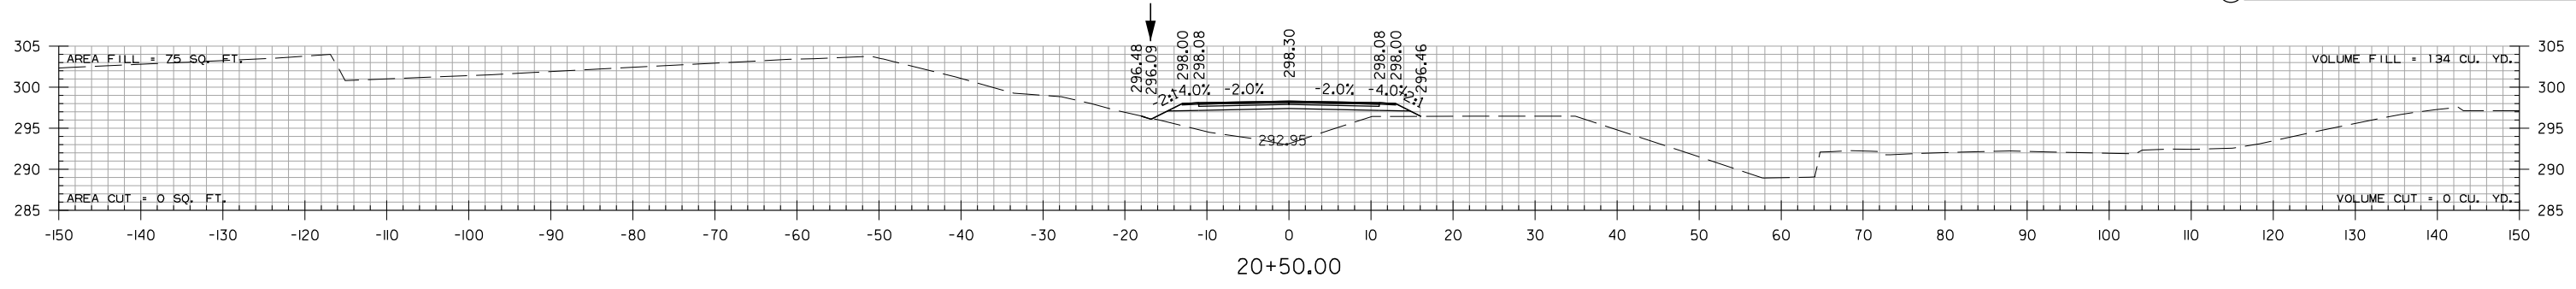


AMITY RD. DETOUR  
STA. 19+00 TO STA. 20+50

5/20/2015 7:13:49 AM  
rccorbyn  
WORKSPACE: AHTD  
L:\2012\201590 - Conrail\field Access\Drawings\6TH\_ST\6TH.CX.ALL.dgn  
REVISED DATE:

DATE REVISED	DATE FILMED	DATE REVISED	DATE FILMED	FED. RD. DIST. NO.	STATE	FED. AID PROJ. NO.	SHEET NO.	TOTAL SHEETS
				6	ARK.			
				JOB NO.	080517	178	182	

2 CROSS SECTIONS

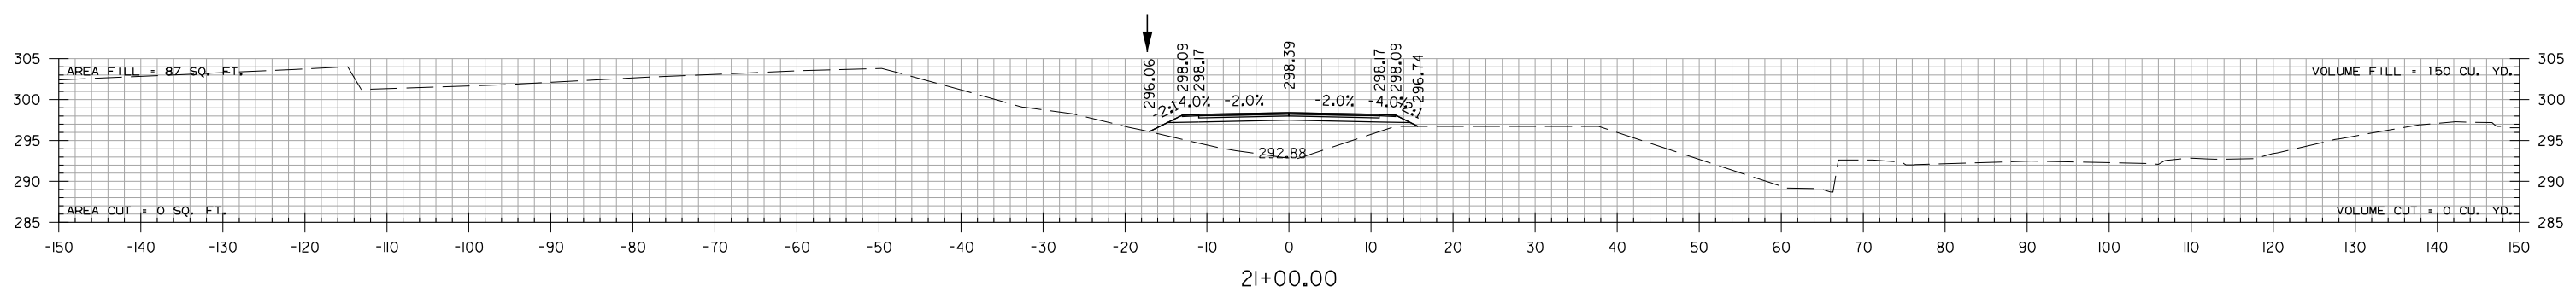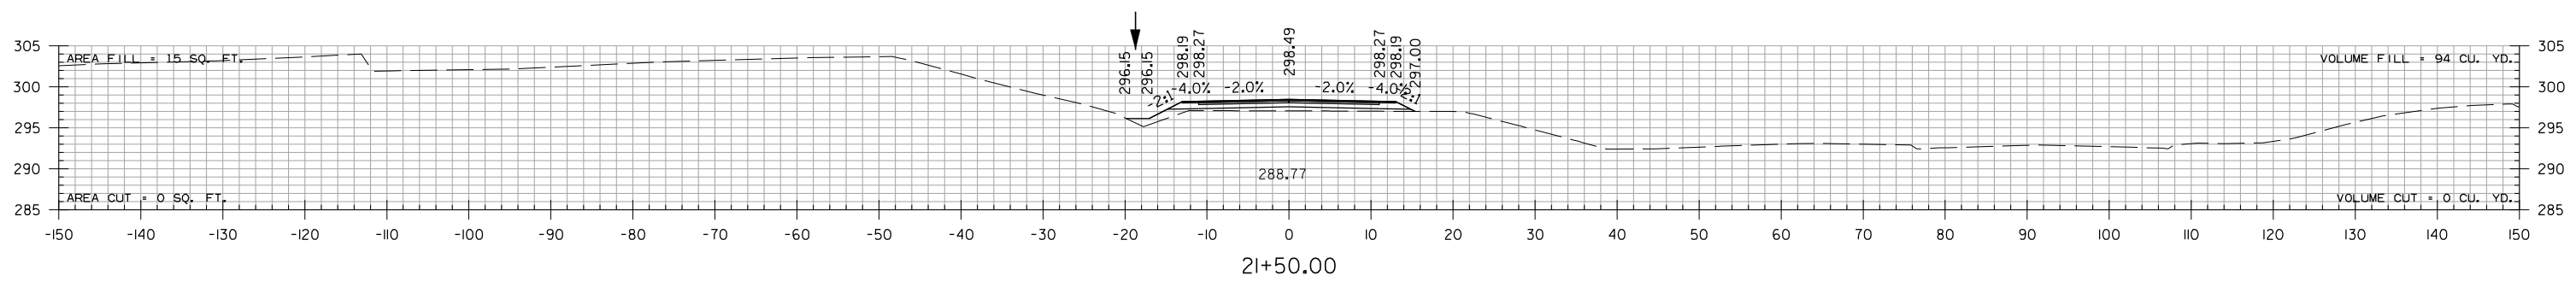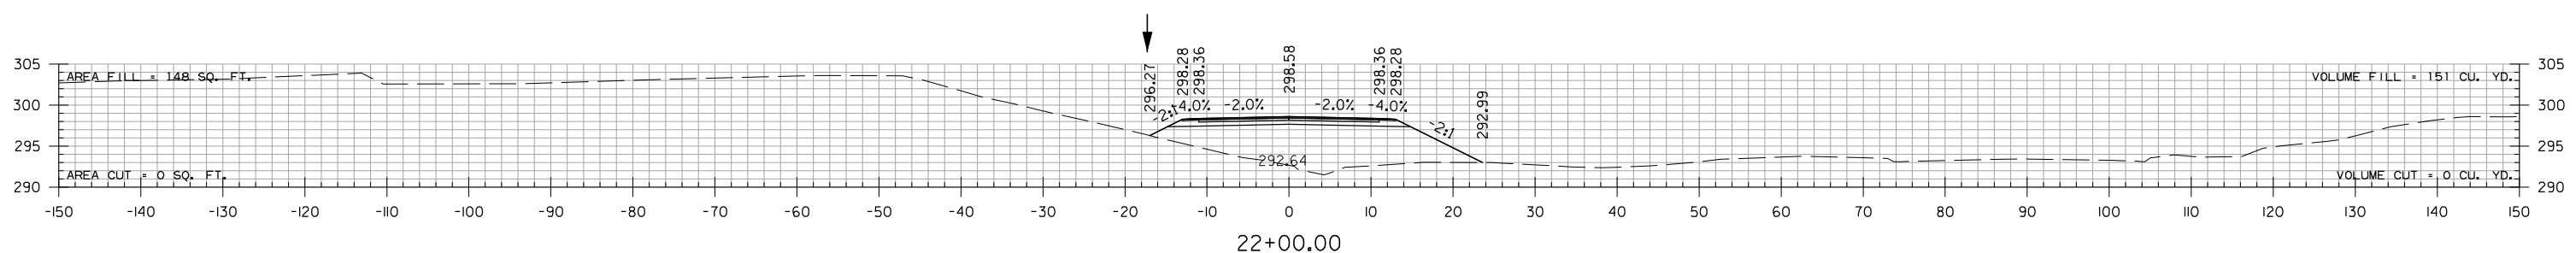
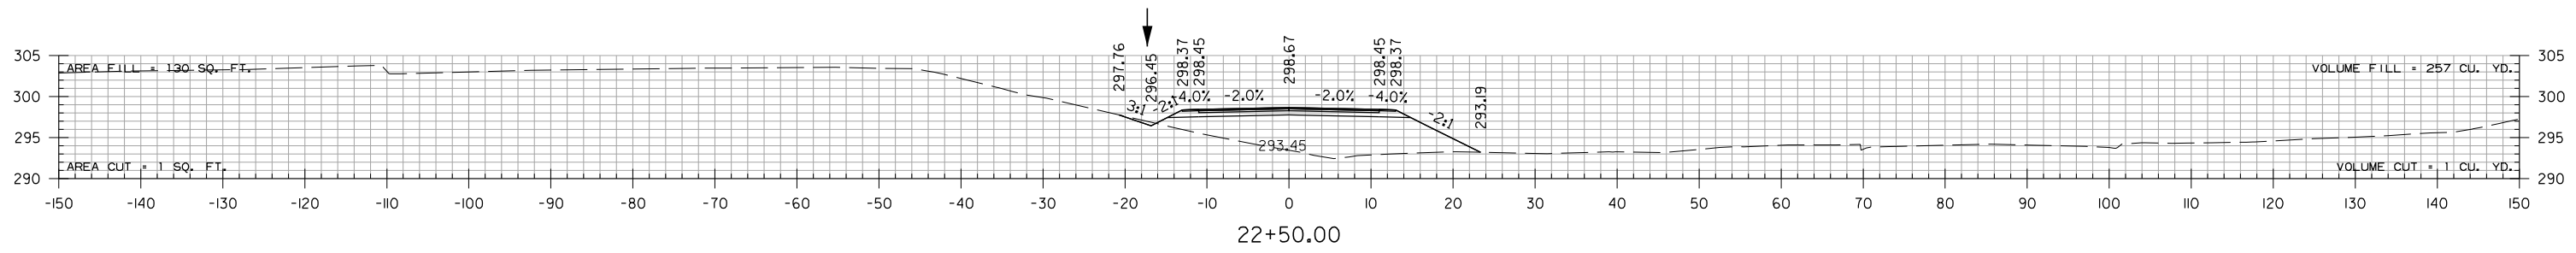


AMITY RD. DETOUR  
STA. 21+00 TO STA. 22+50



5/20/2015 7:13:49 AM  
WORKSPACE: AHTD  
L:\2012\201550 - Contrail\field Access\Drawings\6TH\_ST\6TH.CX.ALL.dgn  
REVISED DATE:

DATE REVISED	DATE FILMED	DATE REVISED	DATE FILMED	FED. RD. DIST. NO.	STATE	FED. AID PROJ. NO.	SHEET NO.	TOTAL SHEETS
				6	ARK.			
				JOB NO.		080517	179	182

2 CROSS SECTIONS

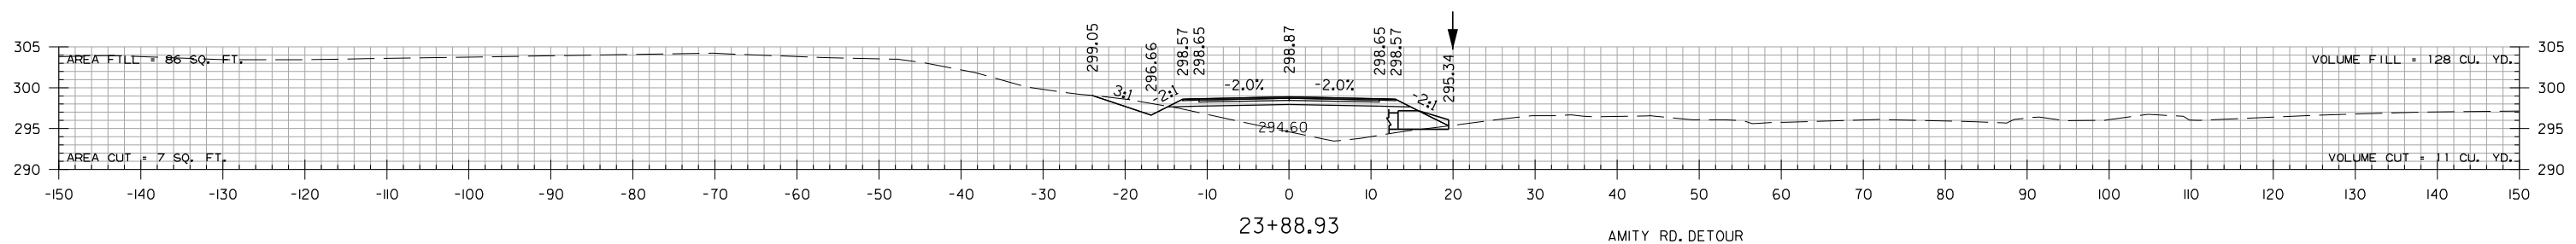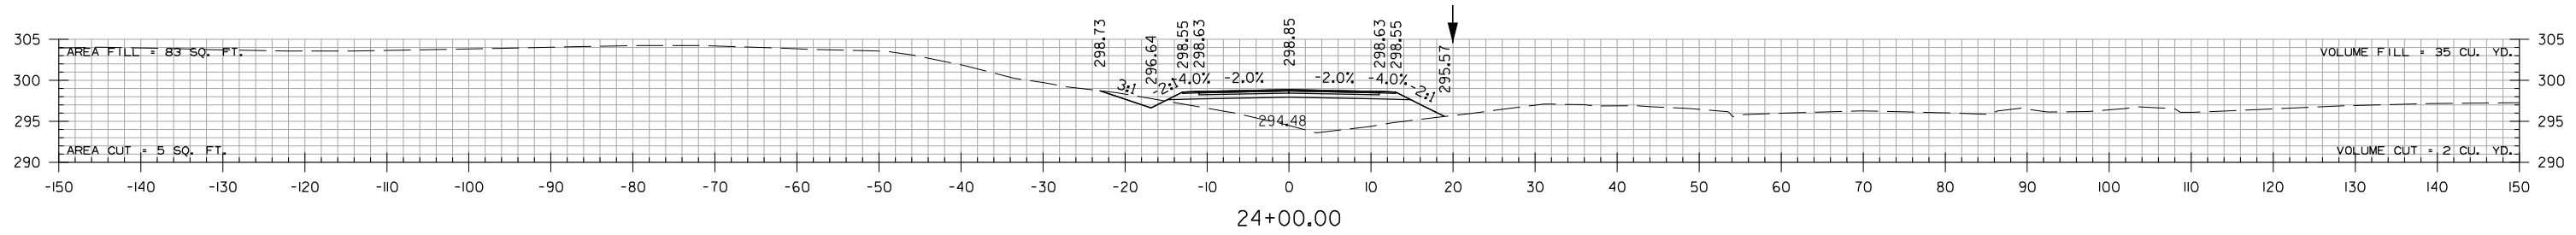

FL. = 294.27 RT.  
AMITY RD. DETOUR  
STA. 24+52 CONSTRUCT  
DBL. 36" X 22" X 115' TEMPORARY ARCH CULVERT  
Q10 = 35 CFS DA = 25.0 ACRES

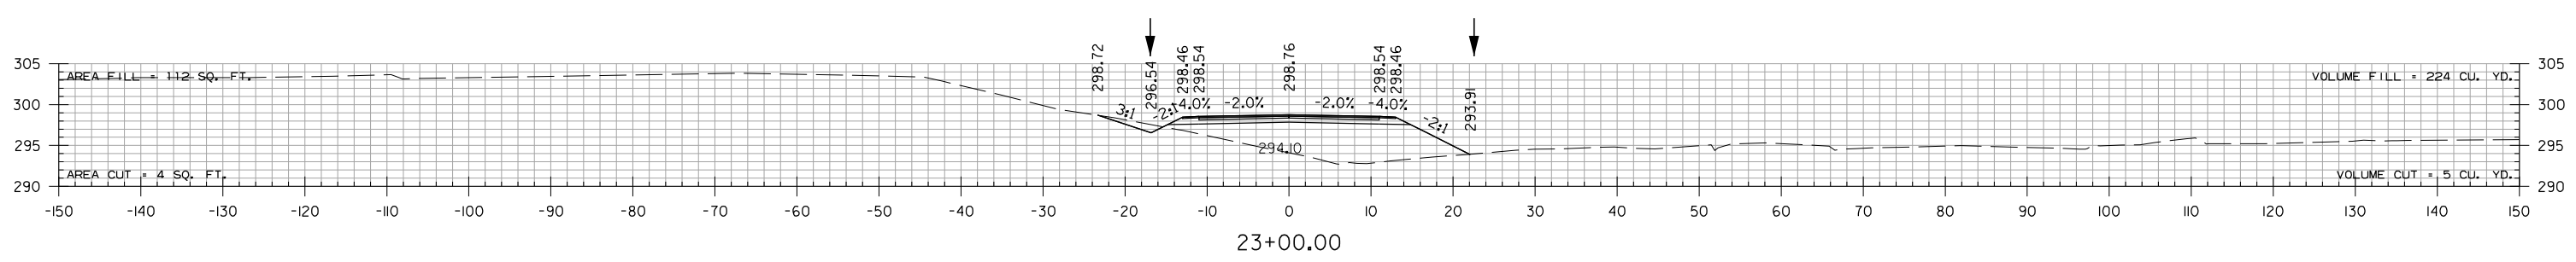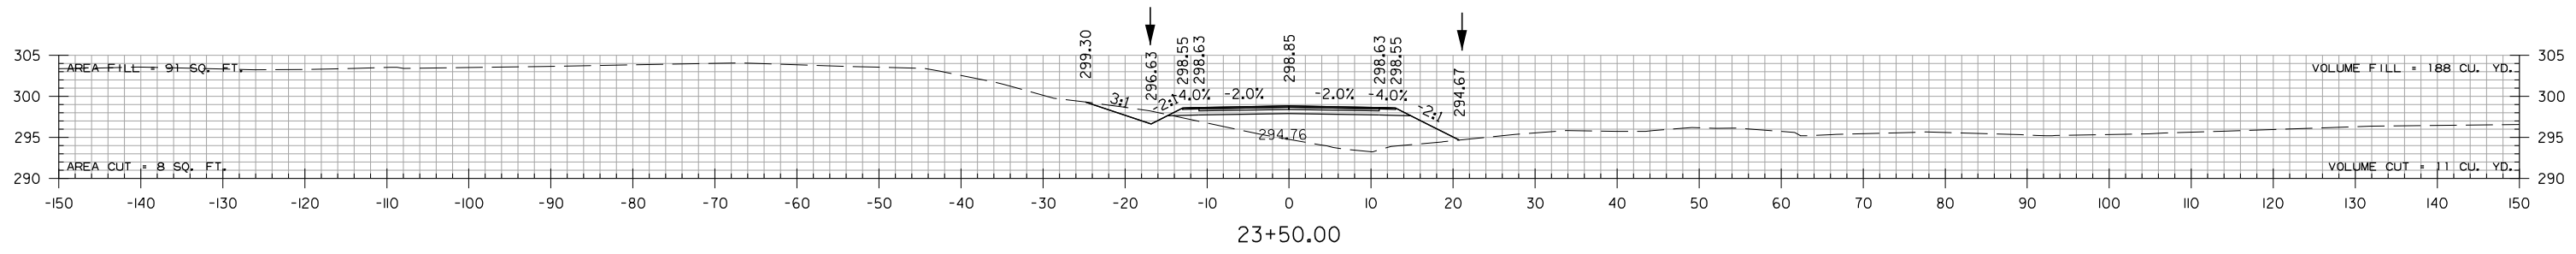





AMITY RD. DETOUR  
STA. 23+00 TO STA. 24+00

5/20/2015 7:13:49 AM  
WORKSPACE: AHTD  
L:\2012\1201590 - Centrail\field Access\Drawings\6TH STA\6TH.CX.ALL.dgn  
REVISED DATE:

DATE REVISED	DATE FILMED	DATE REVISED	DATE FILMED	FED. RD. DIST. NO.	STATE	FED. AID PROJ. NO.	SHEET NO.	TOTAL SHEETS
				6	ARK.			
				JOB NO.	080517	180	182	

2 CROSS SECTIONS






STA. 25+68.21 END AMITY RD. DETOUR

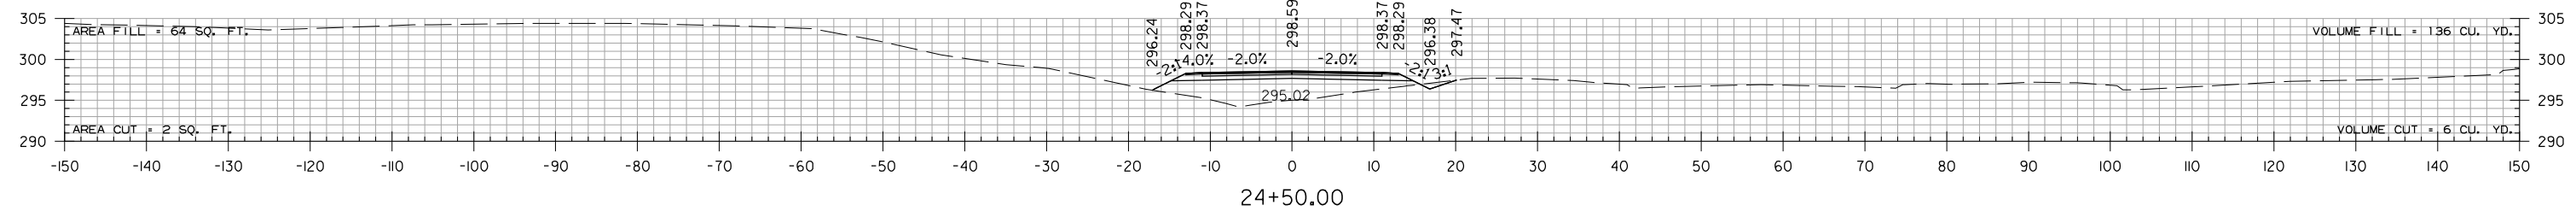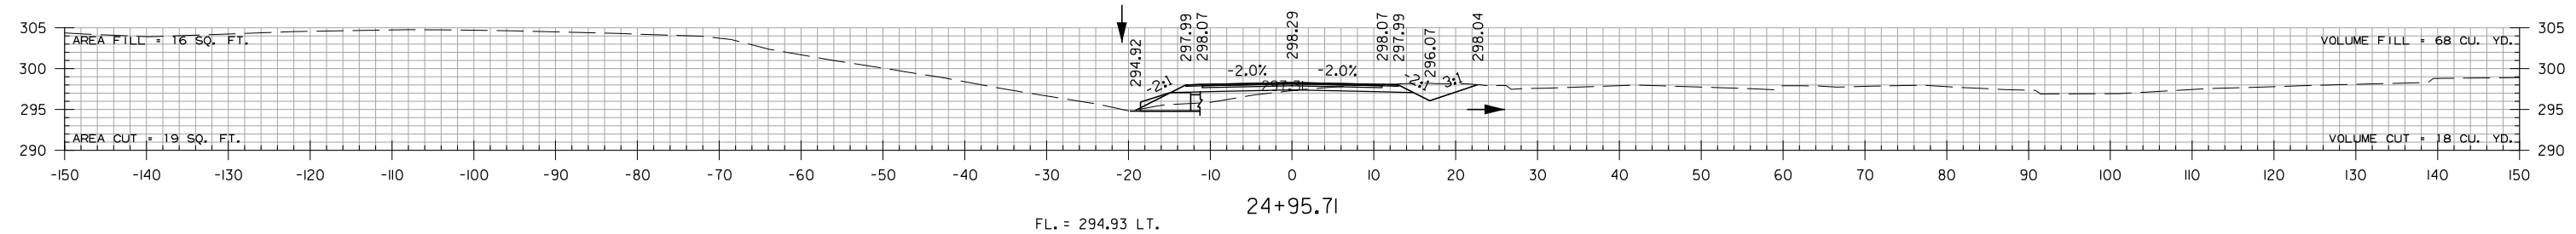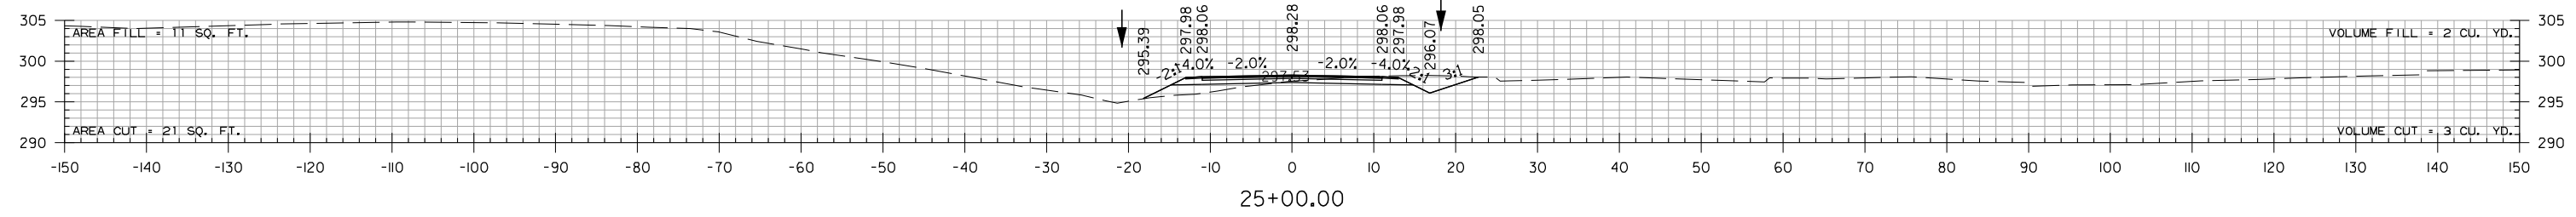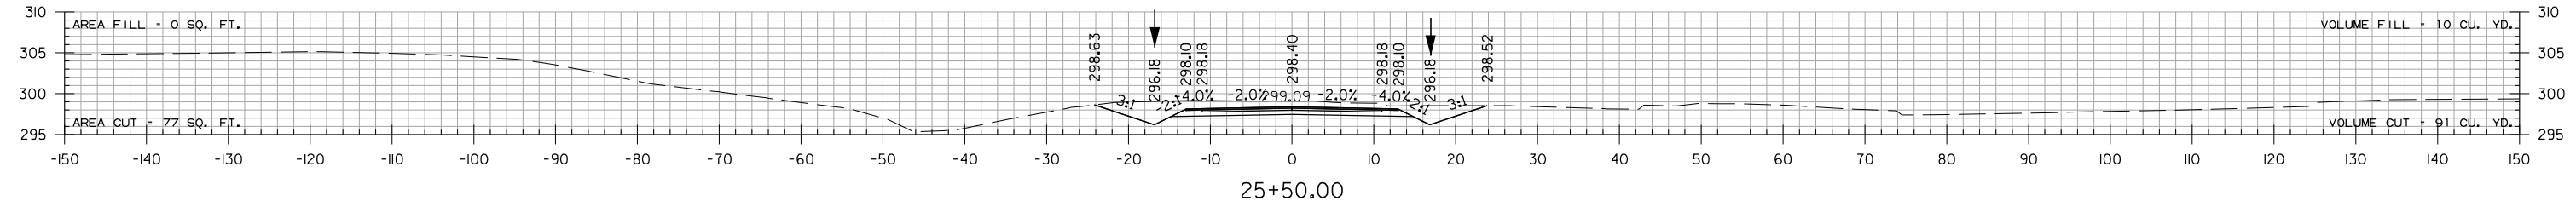

AMITY RD. DETOUR  
STA. 24+50 TO STA. 25+50

5/20/2015 7:13:50 AM  
 WORKSPACE: AHTD  
 L:\2012\201550 - Centrail\field Access\Drawings\6TH. STA.\6TH.CX.ALL.dgn  
 REVISED DATE:

DATE REVISED	DATE FILMED	DATE REVISED	DATE FILMED	FED. RD. DIST. NO.	STATE	FED. AID PROJ. NO.	SHEET NO.	TOTAL SHEETS
2-10-2016				6	ARK.			
				JOB NO.	080517	181	182	
								CROSS SECTIONS

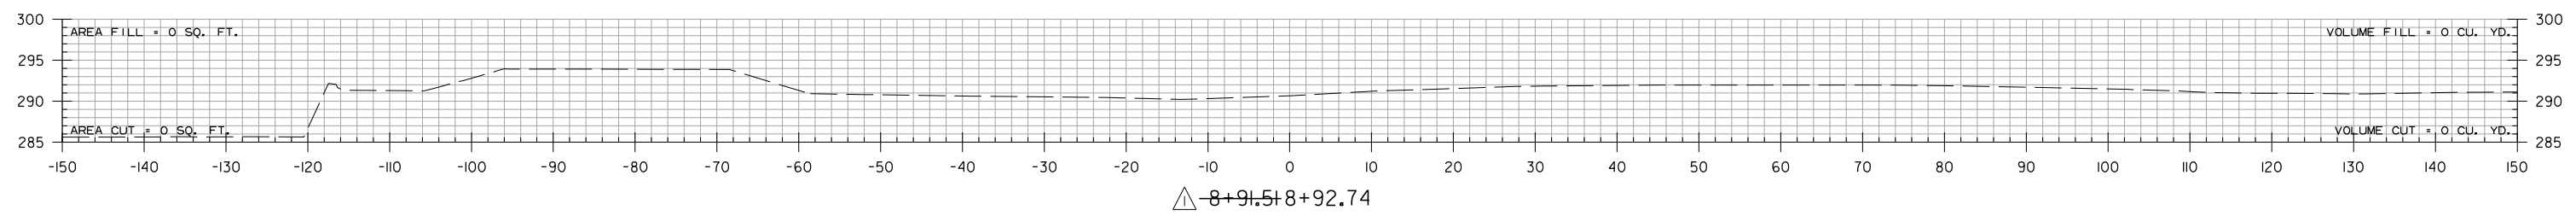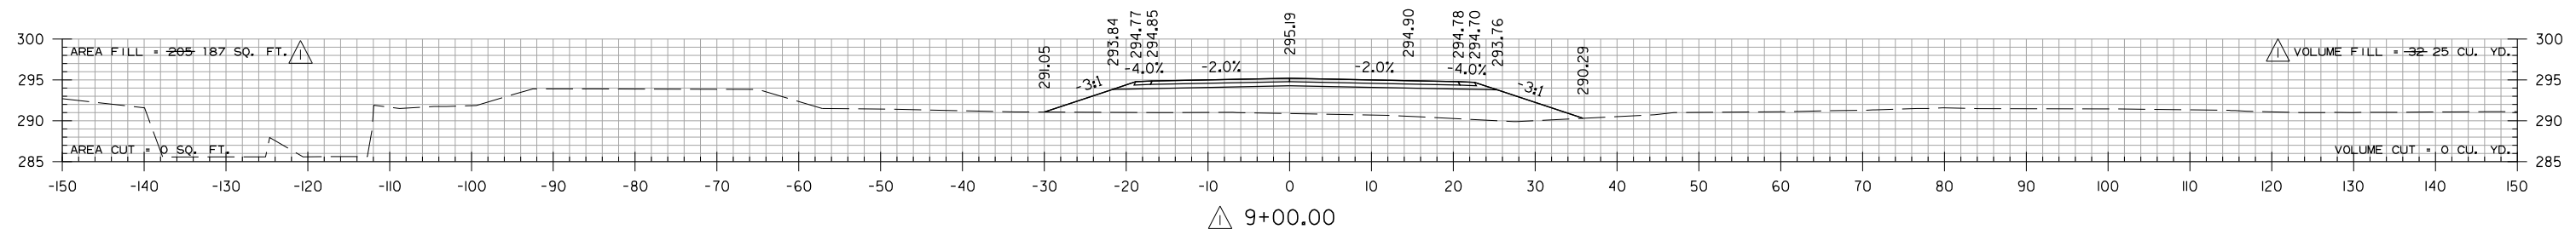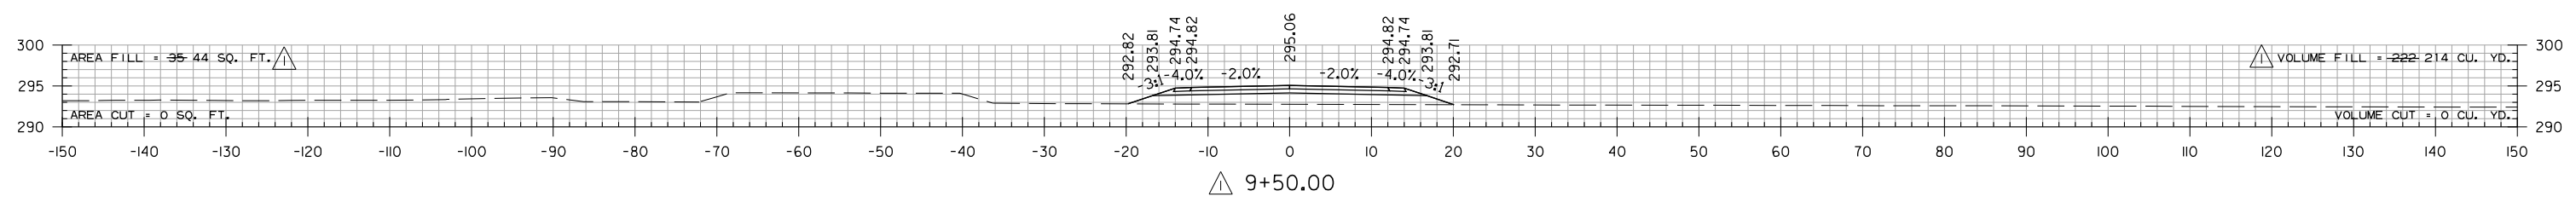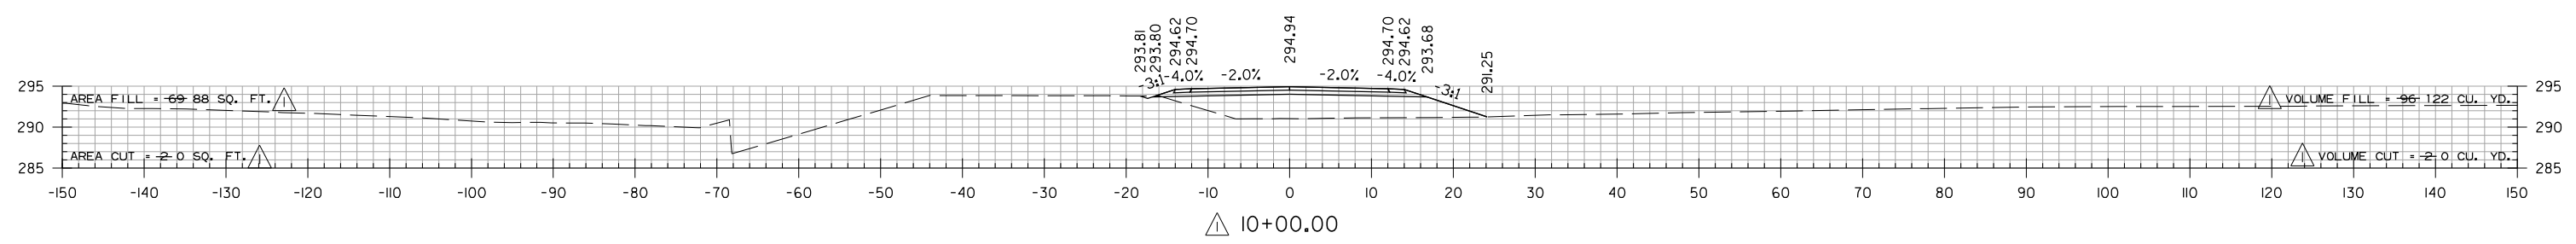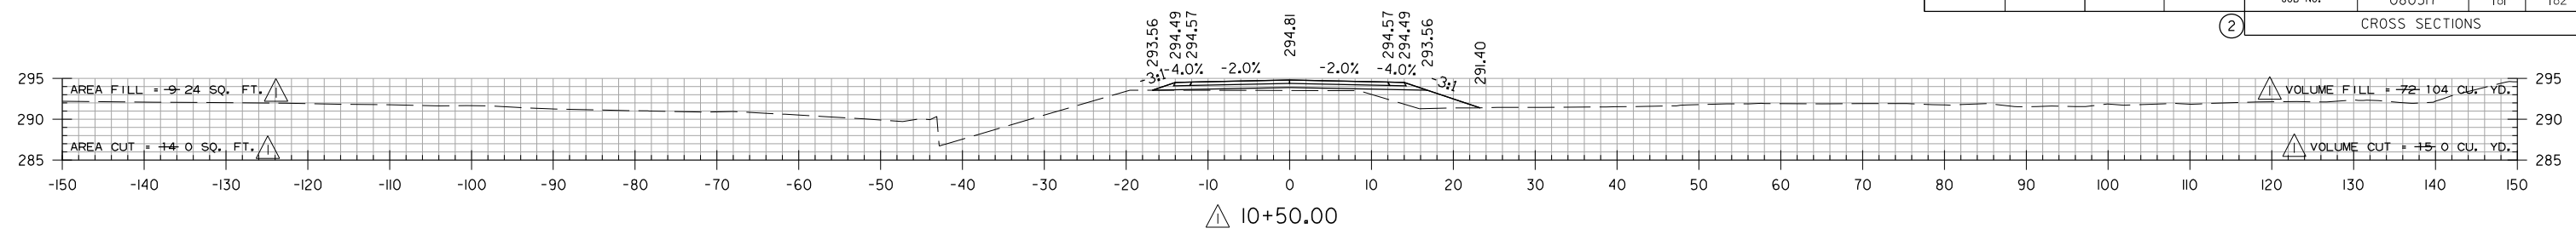

△ STA. 8+91.51 8+92.75 BEGIN TEMPORARY DRIVEWAY


TEMPORARY DRIVEWAY  
STA. 8+92 TO STA. 10+50

2/10/2016 4:34:28 PM  
 WORKSPACE: AHTD  
 L:\2012\1201590 - Contr-Field Access\Drawings\6TH. STA\6TH.CX.ALL.dgn  
 REVISED DATE:


DATE REVISED	DATE FILMED	DATE REVISED	DATE FILMED	FED. RD. DIST. NO.	STATE	FED. AID PROJ. NO.	SHEET NO.	TOTAL SHEETS
2-10-2016				6	ARK.			
				JOB NO.	080517	182	182	

2 CROSS SECTIONS


△ STA. 12+30.00 12+31.36 END TEMPORARY DRIVEWAY

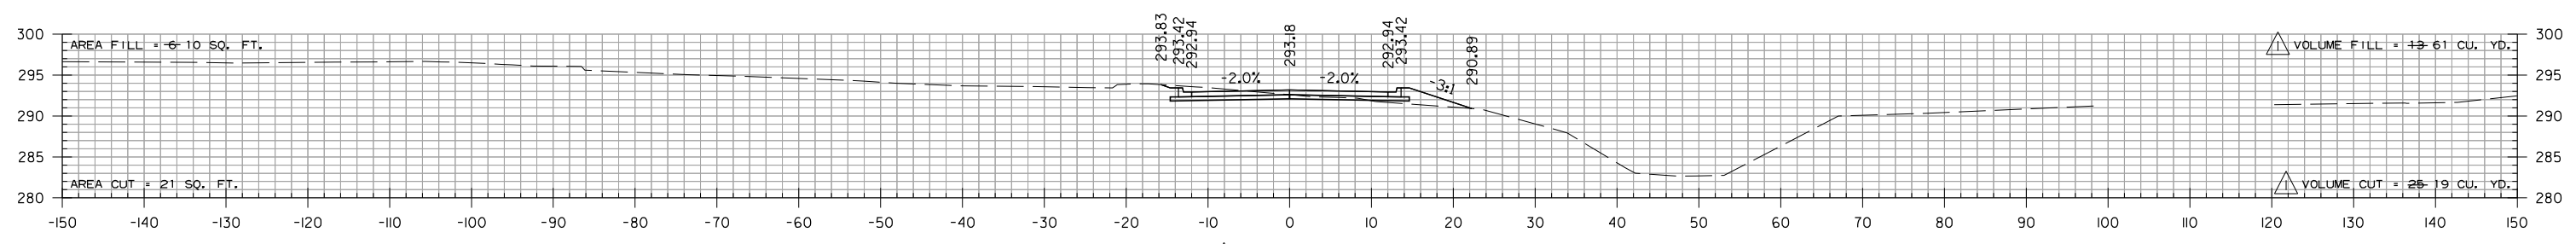


△ 12+31.36

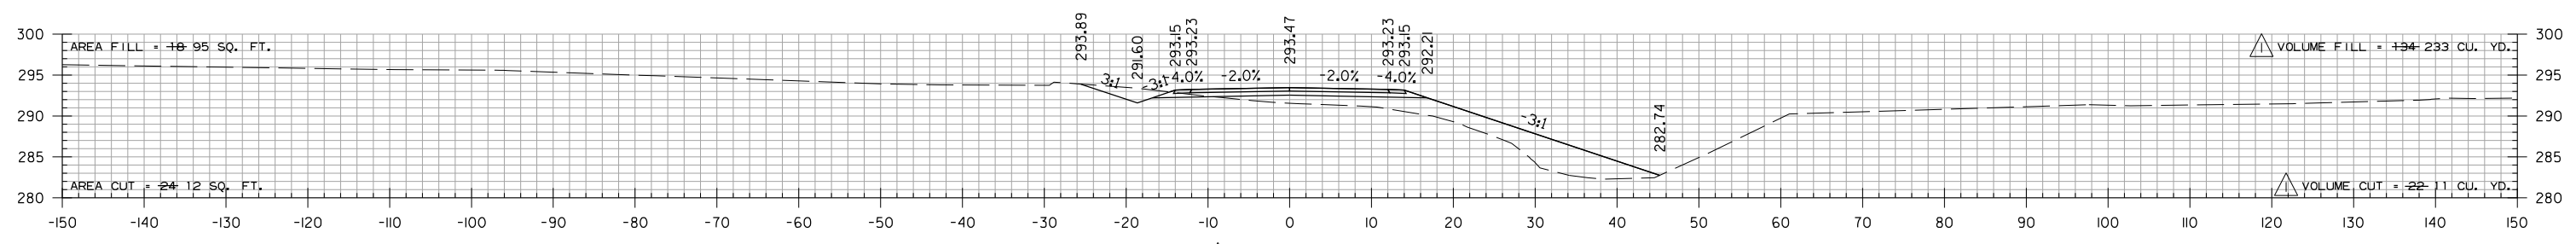

△ 12+00.00

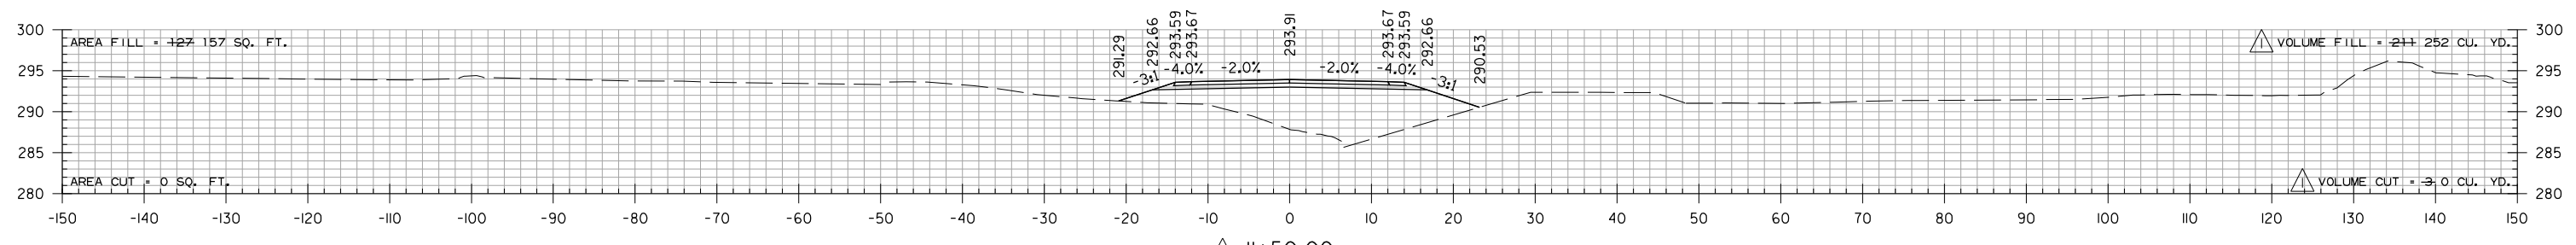

△ 11+50.00

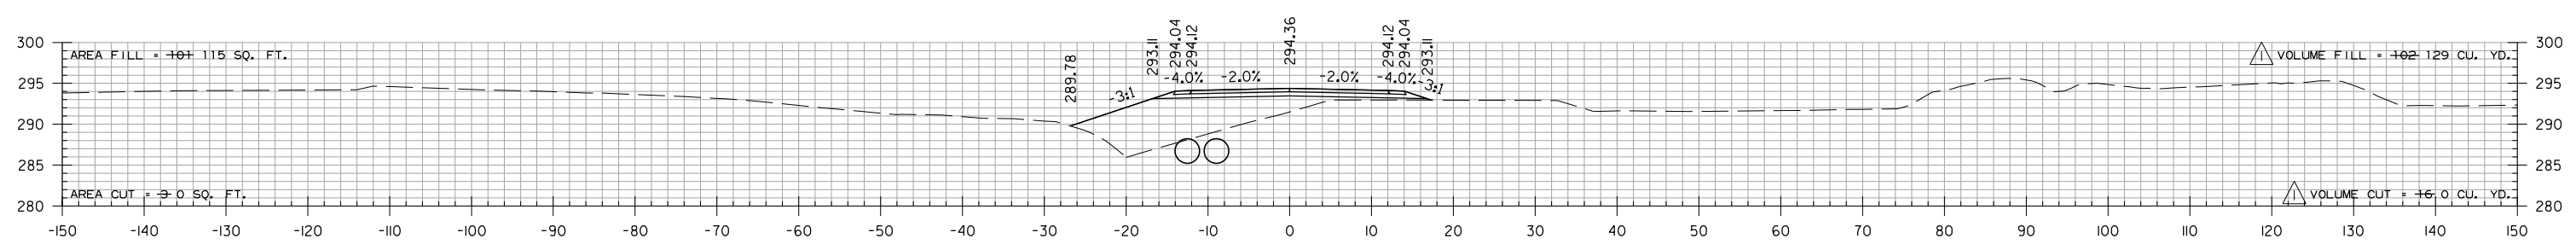

△ 11+00.00

TEMPORARY DRIVEWAY  
 STA. 11+11 CONSTRUCT  
 DBL. 36" X 139' TEMP. CULVERT  
 Q10 = 152 CFS DA = 80.3 ACRES

TEMPORARY DRIVEWAY  
 STA. 11+00 TO STA. 12+30 12+31 △

2/10/2016 4:34:28 PM  
 WORKSPACE: AHTD  
 L:\2012\1201590 - ContrailField Access\Drawings\6TH STA\6TH.CX.ALL.dgn  
 REVISED DATE: